



24 - ANCHOR BOLTS - 8AB1

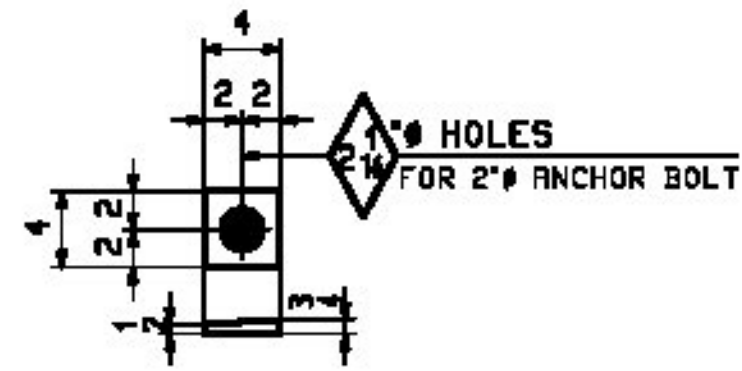

24 - PLATE WASHERS - 8M1
 △ PLACE A MARK ON THE WASHER TO INDICATE THE HIGH POINT AND TOP OF WASHER

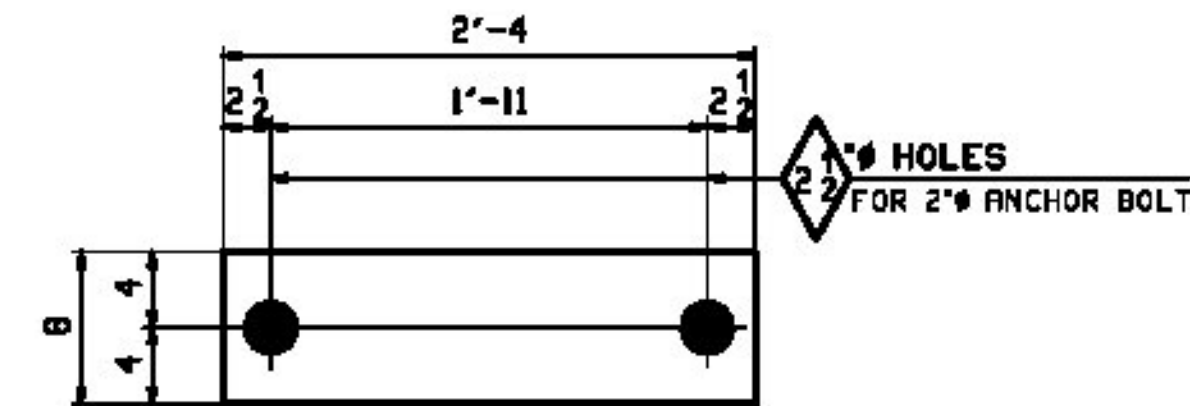

△ 12 - BEARING PLATES - 8M2

JOB NO.		DRAWING NO.		REV.			
849-1		8		△			
PKG. LING	MARK	QTY	MATERIAL	LENGTH	REMARKS	MT	PROCUREMENT NOTES
				FT			
	8AB1	24	ANCHOR BOLTS			34	
2	L	24	2 # 800	2 8	F1024-S2	28	
2	M	48	2 # 8MM		(SEE GNI)	3	
			BEV. PLATE WASHERS				
2	N 8M1	24	PL 4x4	4	(SEE GNI)	3	
			BEARING PLATES				
2	K 8M2	12	PL 2x8	2 4		127	

NOTE:
 FOR GENERAL NOTES SEE DRAWING GNI.

△	5/4/16	APPROVAL COMMENTS	JTB	LWD		
□						
REV.	DATE	REMARKS	DWN	CHK	APVL	SHOP
MATERIAL:		SURFACE PREP. & PAINT:		HOLES:		SHOP BOLTS:
M270-S0W (LN)		SEE DWG GNI		AS NOTED		NONE
DESCRIPTION: ANCHOR BOLTS						
		CASCO BAY STEEL STRUCTURES, INC. 1 WALLACE AVE. PHONE (207) 780-6722 SOUTH PORTLAND, ME 04106 FAX (207) 780-6726				
STRUCTURE: TH-4 OVER WHITNEY BROOK			DRAWN:	DATE:		
ROUTE NO: TH-4, RURAL MINOR COLLECTOR			JTB	02/25		
BRIDGE REPLACEMENT			CHKD:	DATE:		
COUNTY OF ORLEANS			LWD	03/02		
LOCATION: TOWN OF CRAFTSBURY, VERMONT			JOB NO.	DWG NO.		
PROJ NO. 80 1449(34)			849-1	8		
CUSTOMER: CCS CONSTRUCTORS INC.				REV. △		

Vermont Agency of Transportation
RECEIVED
 CK'D BY RSF/SMC OK'D BY WDL
 May 19, 2016
 RESUBMIT No Approved AsNoted
 BY RSY DATE 05/26/2016

USR 1000 Rev 4.0 08/11/10 11/17/16 11/17/16