

INDEX OF SHEETS


PLAN SHEETS

- 1 TITLE SHEET
- 2 PROJECT NOTES
- 3 QUANTITY SHEET
- 4 CONVENTIONAL SYMBOLOGY LEGEND
- 5 LAYOUT PLAN
- 6 BRIDGE RAIL DETAILS
- 7 REPAIR DETAILS
- 8 TRAFFIC CONTROL PLAN
- 9 1928 REFERENCE PLAN

STANDARDS LIST


G-1	STEEL BEAM GUARDRAIL DETAILS	11-10-2015
G-1D	STEEL BEAM GUARDRAIL APPROACH TERMINAL DETAILS	02-10-2014
T-1	TRAFFIC CONTROL GENERAL NOTES	08-06-2012
T-10	CONVENTIONAL ROADS CONSTRUCTION APPROACH SIGNING	08-06-2012
T-28	CONSTRUCTION SIGN DETAILS	08-06-2012
T-45	SQUARE TUBE SIGN POST AND ANCHOR	01-02-2013
T-56	STANDARD SIGN PLACEMENT	10-26-2015

STATE OF VERMONT AGENCY OF TRANSPORTATION

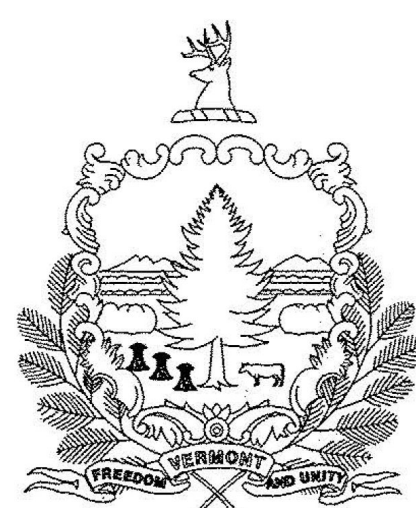


PROPOSED IMPROVEMENT

BRIDGE PROJECT TOWN OF MORRISTOWN COUNTY OF LAMOILLE CADYS FALLS ROAD (T.R. #2) MAJOR COLLECTOR BRIDGE NO. 8

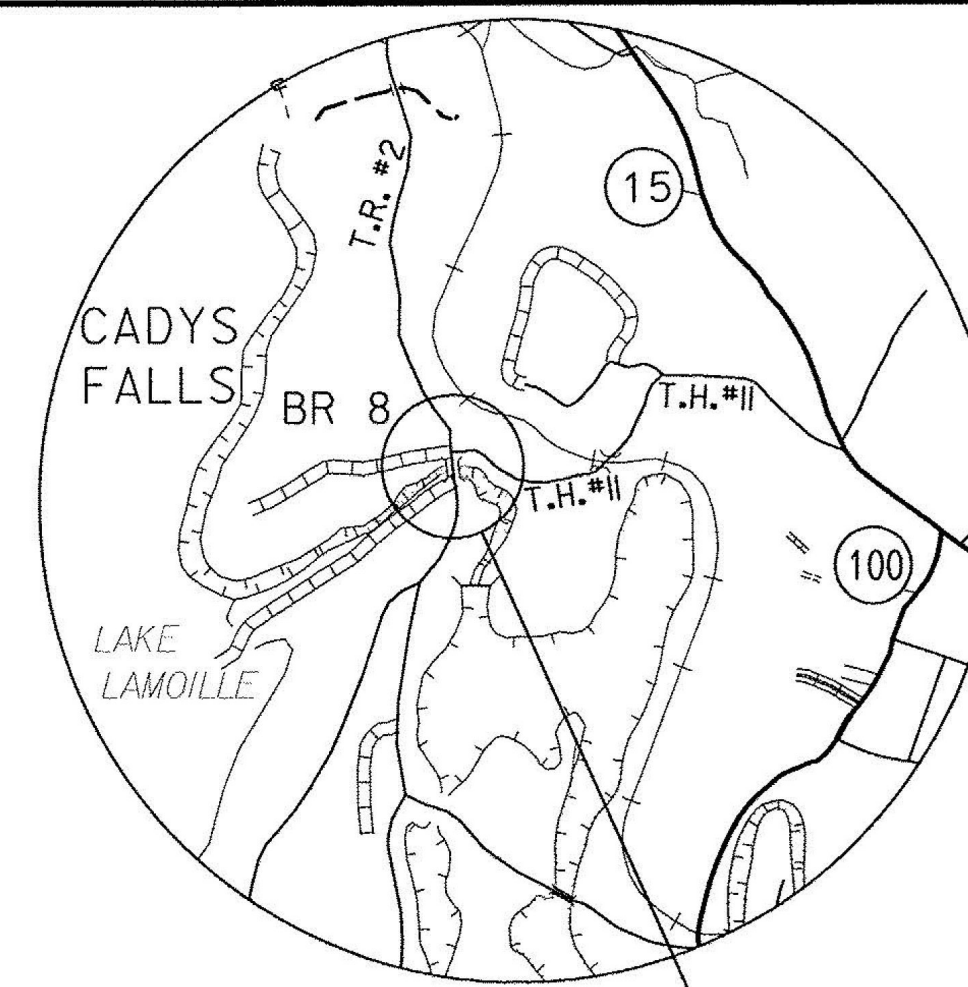

LOCATION MAP
NOT TO SCALE

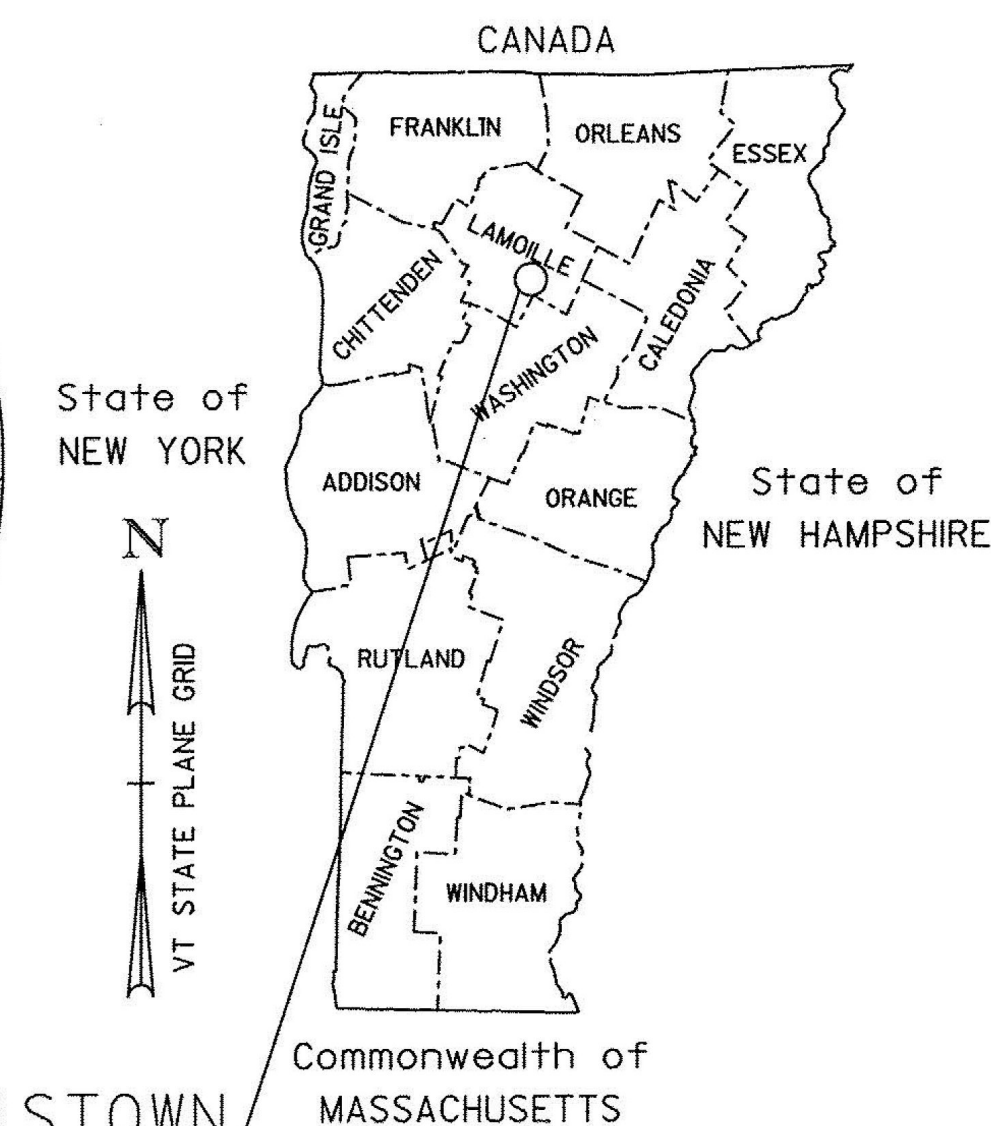


MORRISTOWN
BF 0239 (3)

PROJECT LOCATION: BEGINNING AT A POINT ON CADYS FALLS ROAD (T.R. #2) APPROXIMATELY 68 FEET NORTH OF THE INTERSECTION WITH DUHAMEL ROAD (T.H. #10) AND EXTENDING NORTHERLY ALONG CADYS FALLS ROAD FOR APPROXIMATELY 124 FEET.


PROJECT DESCRIPTION: INCLUDES CLEANING AND PAINTING THE EXISTING STRUCTURAL STEEL SUPERSTRUCTURE, MINOR REPAIRS AND ASSOCIATED WORK.

LENGTH OF STRUCTURE: 124.00 FEET
LENGTH OF ROADWAY: 000.00 FEET
LENGTH OF PROJECT: 124.00 FEET

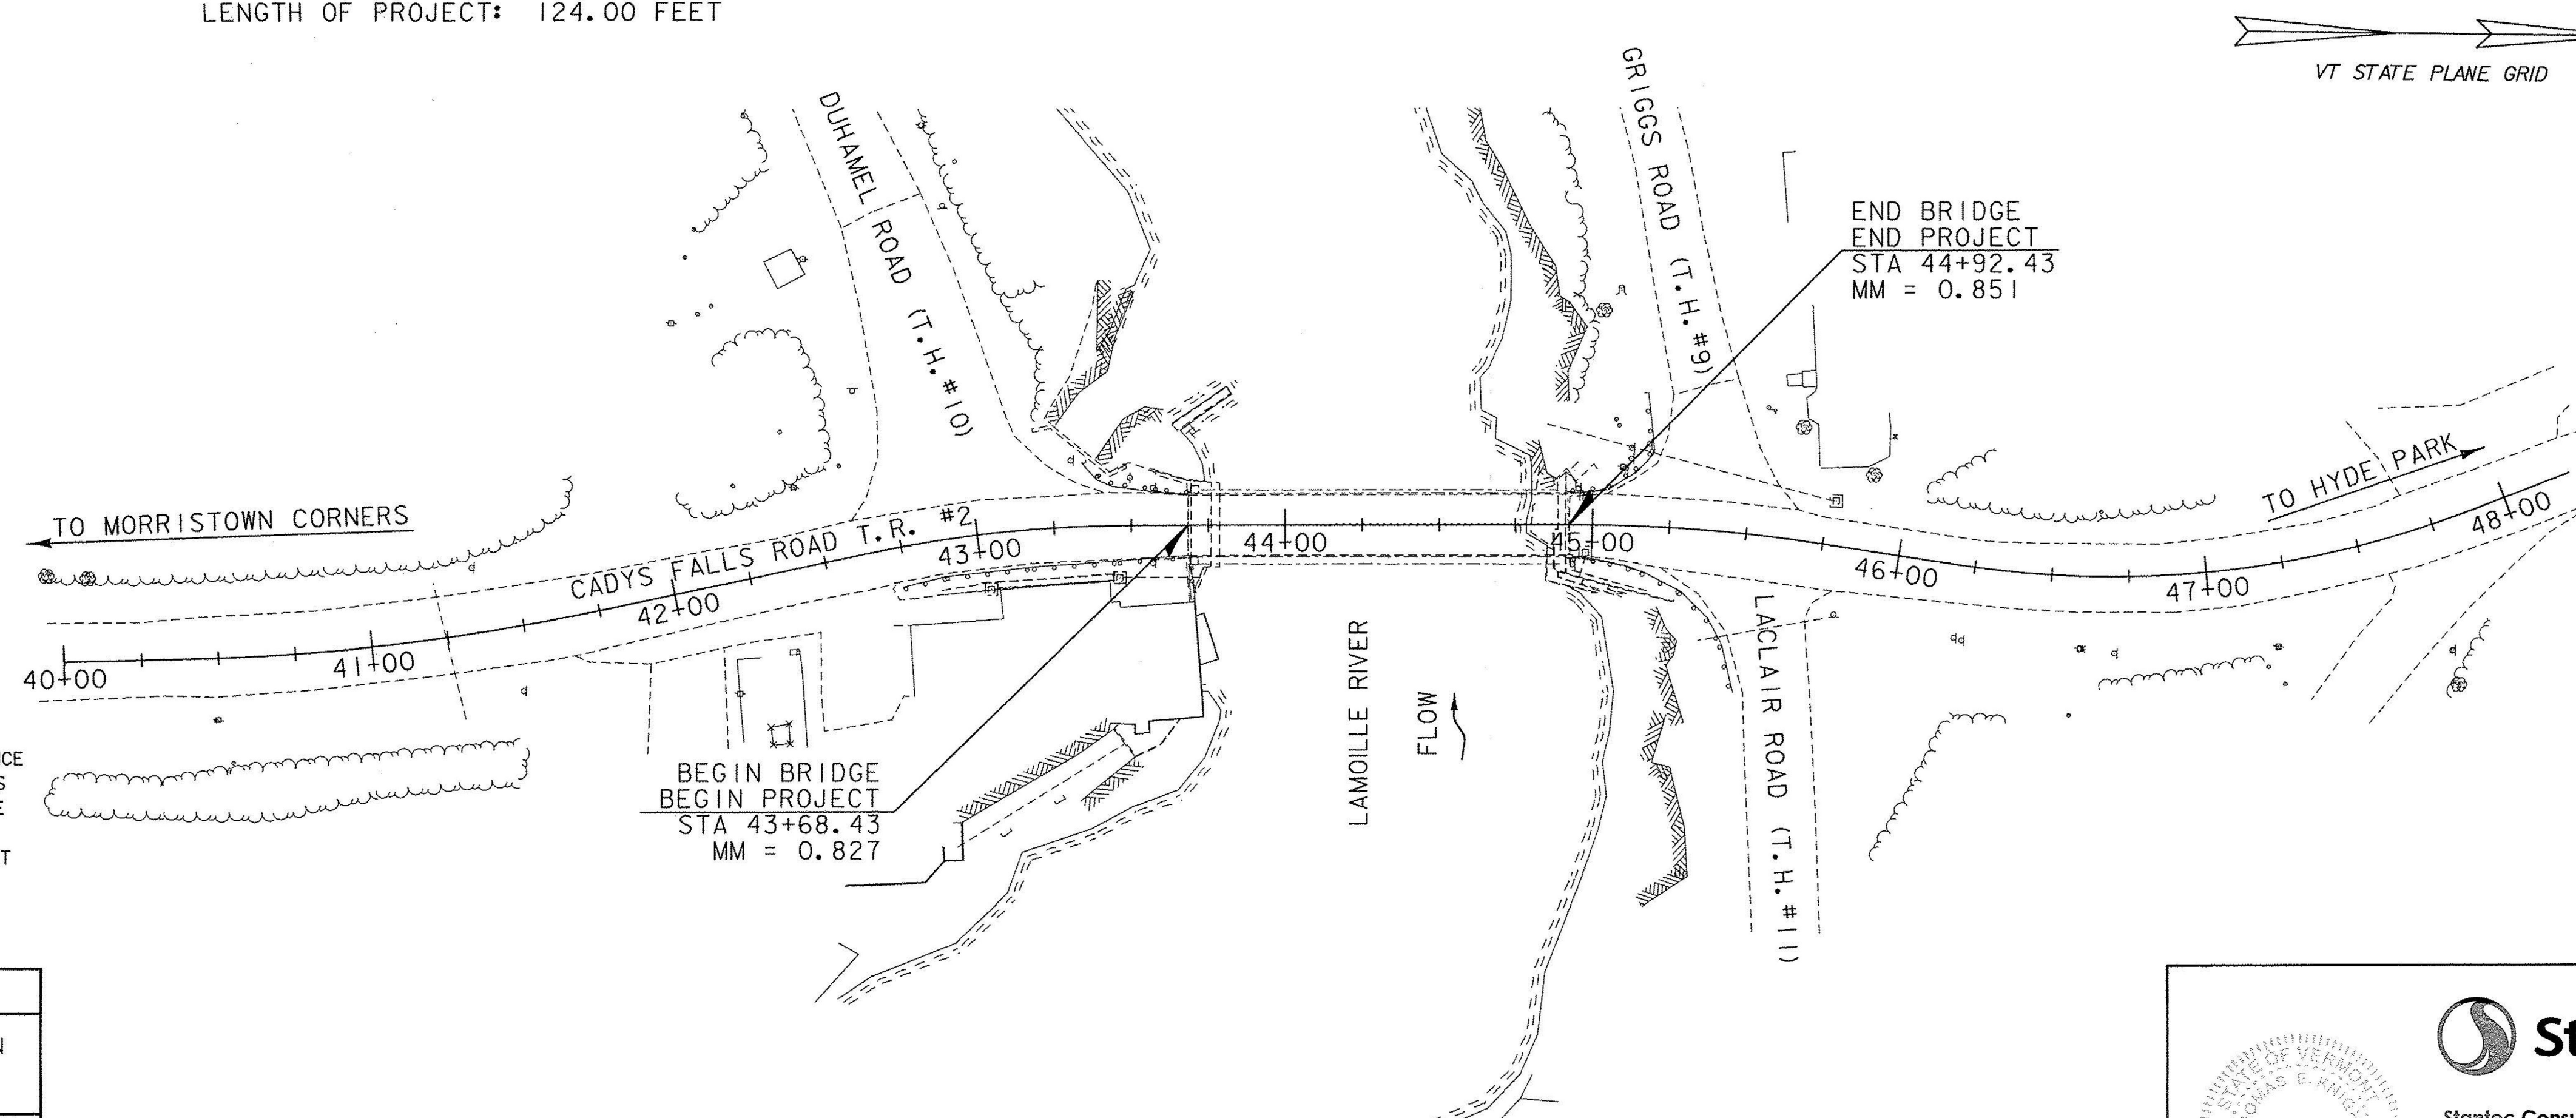

CONSTRUCTION IS TO BE CARRIED ON IN ACCORDANCE WITH THESE PLANS AND THE STANDARD SPECIFICATIONS FOR CONSTRUCTION DATED 2011, AS APPROVED BY THE FEDERAL HIGHWAY ADMINISTRATION ON JULY 20, 2011 FOR USE ON THIS PROJECT, INCLUDING ALL SUBSEQUENT REVISIONS AND SUCH REVISED SPECIFICATIONS AND SPECIAL PROVISIONS AS ARE INCORPORATED IN THESE PLANS.

QUALITY ASSURANCE PROGRAM : LEVEL 3	
SURVEYED BY :	VTRANS - CYR/GILMAN
SURVEYED DATE :	01/27/2014
DATUM	
VERTICAL	NAVD88
HORIZONTAL	NAD 83 (92)

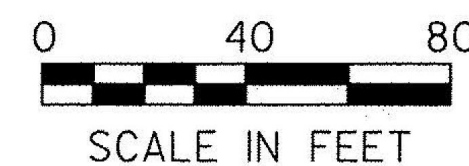

Record Plans
Contractor: MODERN PROTECTIVE COATINGS, INC.
Resident Engineer: SCOTT WHEATLEY
Construction Began: JUNE 20, 2016
Construction Complete: NOVEMBER 17, 2016
Record Plans By: SCOTT WHEATLEY & JESSE IVES

I hereby certify that all construction required by this set of drawings has been accomplished as indicated herein.

BY: e-Signed by Scott Wheatley on 2016-09-05 11:23:04 GMT Resident Engineer

Date: September 05, 2016

NOTE: Any further information concerning final quantities, amounts or other details relative to this project may be found at Central Files in the electronic archives.

BUILT AS DESIGNED

<p>Stantec Stantec Consulting Services Inc. 55 Green Mountain Drive South Burlington VT U.S.A. 05403 Phone: (802) 864-0223 Fax: (802) 864-0165 www.stantec.com</p>	DIRECTOR OF PROJECT DELIVERY
	APPROVED DATE 3/4/2016
	PROJECT MANAGER : MARK SARGENT
	PROJECT NAME : MORRISTOWN PROJECT NUMBER : BF 0239 (3)
SHEET 1 OF 9 SHEETS	