

INDEX OF SHEETS

PLAN SHEETS

- 1 TITLE SHEET
- 2 PROJECT NOTES
- 3 QUANTITY SHEET
- 4 CONVENTIONAL SYMBOLOGY LEGEND
- 5 LAYOUT PLAN
- 6 BRIDGE RAIL DETAILS
- 7 REPAIR DETAILS
- 8 TRAFFIC CONTROL PLAN
- 9 1928 REFERENCE PLAN

STANDARDS LIST


G-1	STEEL BEAM GUARDRAIL DETAILS	11-10-2015
G-1D	STEEL BEAM GUARDRAIL APPROACH TERMINAL DETAILS	02-10-2014
T-1	TRAFFIC CONTROL GENERAL NOTES	08-06-2012
T-10	CONVENTIONAL ROADS CONSTRUCTION APPROACH SIGNING	08-06-2012
T-28	CONSTRUCTION SIGN DETAILS	08-06-2012
T-45	SQUARE TUBE SIGN POST AND ANCHOR	01-02-2013
T-56	STANDARD SIGN PLACEMENT	10-26-2015

**STATE OF VERMONT
AGENCY OF TRANSPORTATION**




PROPOSED IMPROVEMENT

**BRIDGE PROJECT
TOWN OF MORRISTOWN
COUNTY OF LAMOILLE
CADYS FALLS ROAD (T.R. #2) MAJOR COLLECTOR
BRIDGE NO. 8**

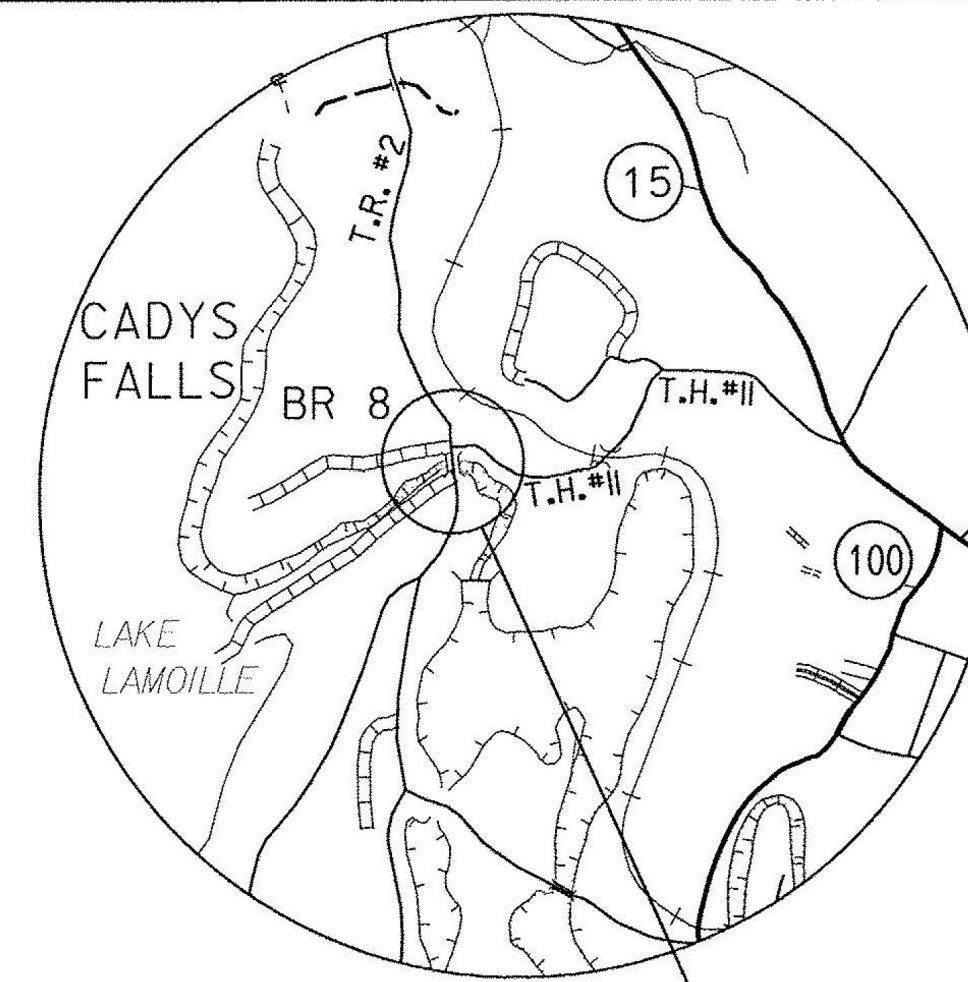

LOCATION MAP
NOT TO SCALE

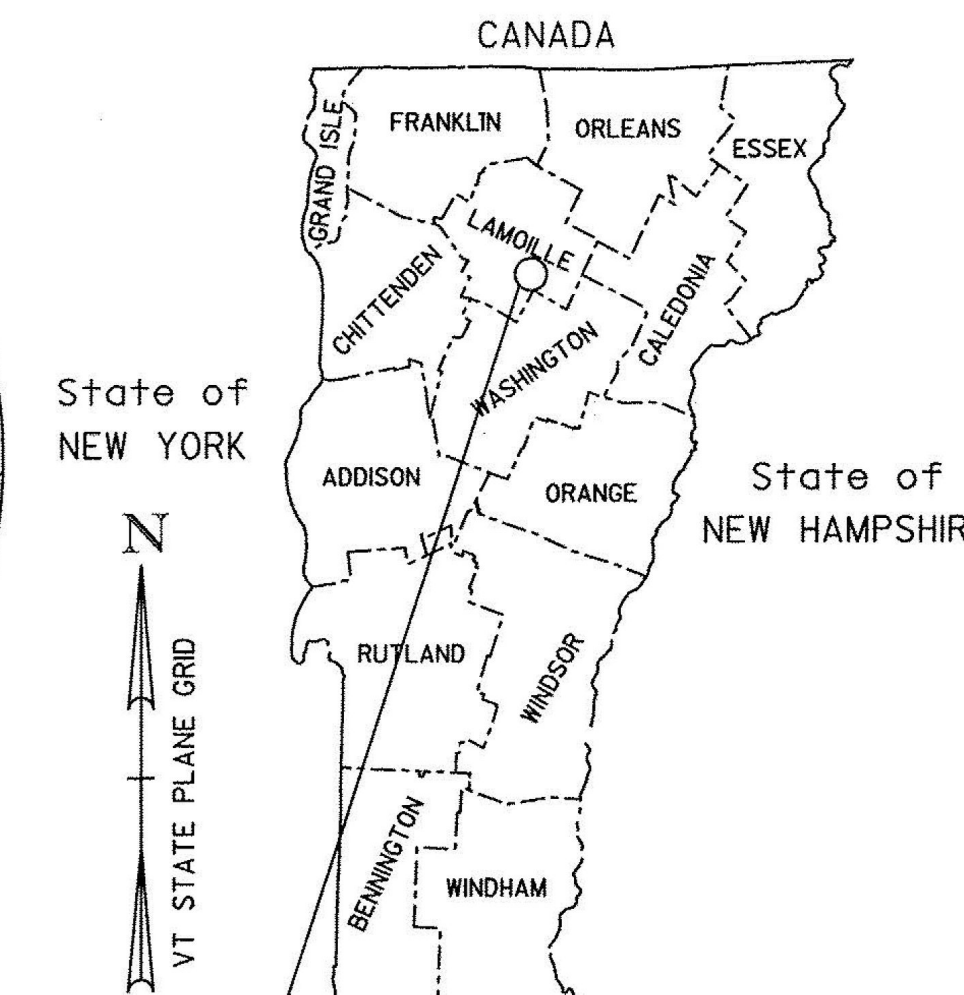


MORRISTOWN
BF 0239 (3)

PROJECT LOCATION: BEGINNING AT A POINT ON CADYS FALLS ROAD (T.R. #2) APPROXIMATELY 68 FEET NORTH OF THE INTERSECTION WITH DUHAMEL ROAD (T.H. #10) AND EXTENDING NORTHERLY ALONG CADYS FALLS ROAD FOR APPROXIMATELY 124 FEET.

PROJECT DESCRIPTION: INCLUDES CLEANING AND PAINTING THE EXISTING STRUCTURAL STEEL SUPERSTRUCTURE, MINOR REPAIRS AND ASSOCIATED WORK.

LENGTH OF STRUCTURE: 124.00 FEET
LENGTH OF ROADWAY: 000.00 FEET
LENGTH OF PROJECT: 124.00 FEET

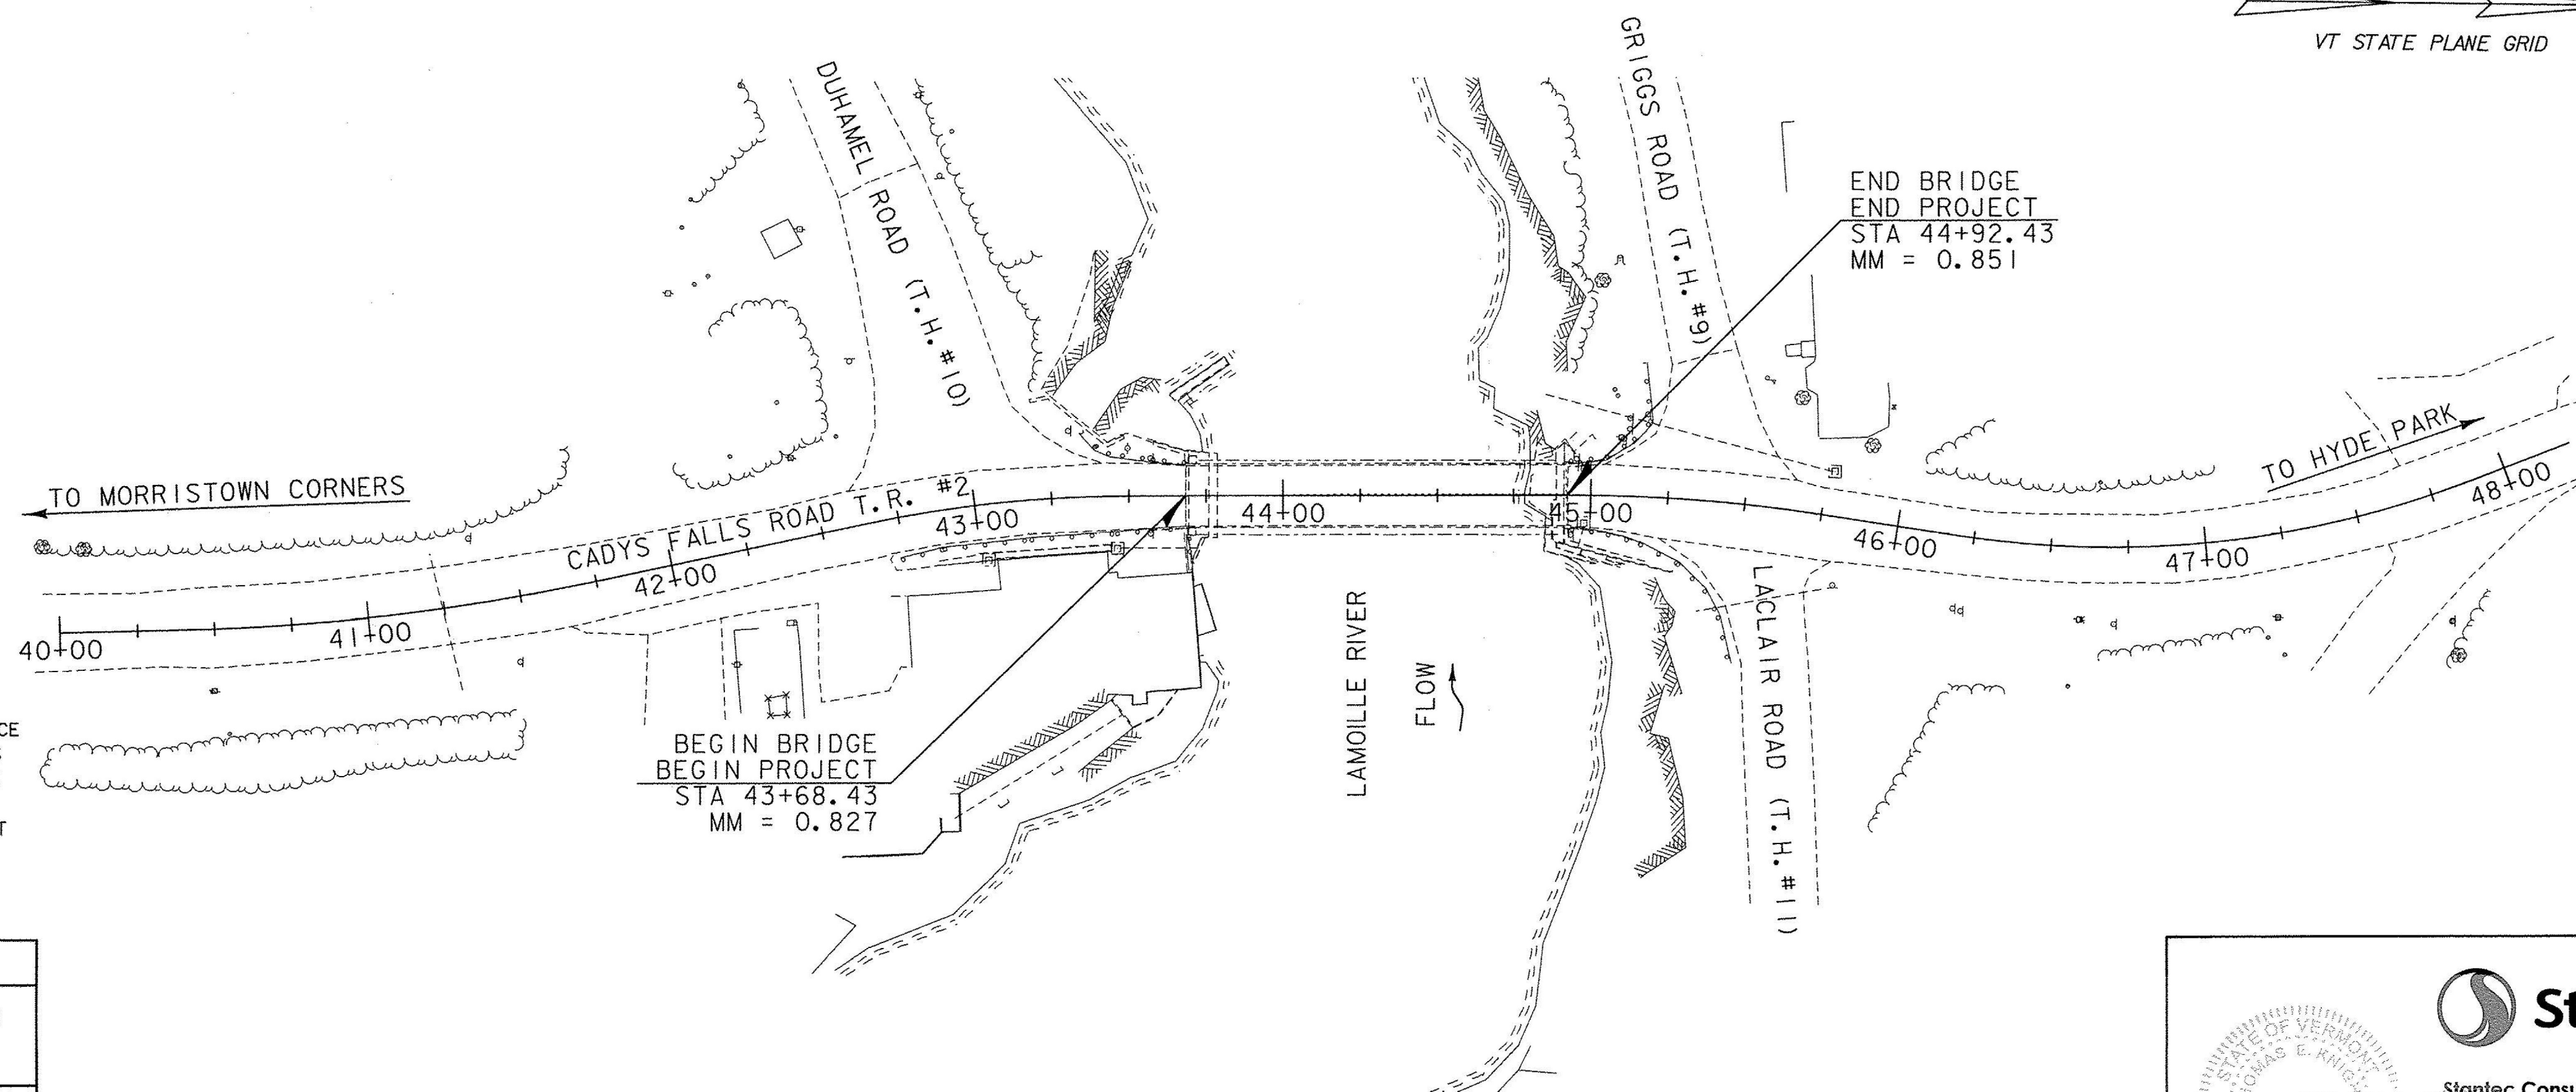


BEGIN BRIDGE
BEGIN PROJECT
STA 43+68.43
MM = 0.827

END BRIDGE
END PROJECT
STA 44+92.43
MM = 0.851

CONSTRUCTION IS TO BE CARRIED ON IN ACCORDANCE WITH THESE PLANS AND THE STANDARD SPECIFICATIONS FOR CONSTRUCTION DATED 2011, AS APPROVED BY THE FEDERAL HIGHWAY ADMINISTRATION ON JULY 20, 2011 FOR USE ON THIS PROJECT, INCLUDING ALL SUBSEQUENT REVISIONS AND SUCH REVISED SPECIFICATIONS AND SPECIAL PROVISIONS AS ARE INCORPORATED IN THESE PLANS.

QUALITY ASSURANCE PROGRAM : LEVEL 3	
SURVEYED BY :	VTRANS - CYR/GILMAN
SURVEYED DATE :	01/27/2014
DATUM	
VERTICAL	NAVD88
HORIZONTAL	NAD 83 (92)

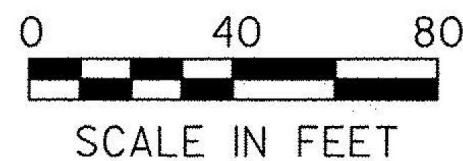

Record Plans
Contractor: MODERN PROTECTIVE COATINGS, INC.
Resident Engineer: SCOTT WHEATLEY
Construction Began: JUNE 20, 2016
Construction Complete: NOVEMBER 17, 2016
Record Plans By: SCOTT WHEATLEY & JESSE IVES

I hereby certify that all construction required by this set of drawings has been accomplished as indicated herein.

BY: e-Signed by Scott Wheatley on 2016-09-05 11:23:04 GMT Resident Engineer

Date: September 05, 2016

NOTE: Any further information concerning final quantities, amounts or other details relative to this project may be found at Central Files in the electronic archives.

BUILT AS DESIGNED

<p>Stantec Stantec Consulting Services Inc. 55 Green Mountain Drive South Burlington VT U.S.A. 05403 Phone: (802) 864-0223 Fax: (802) 864-0165 www.stantec.com</p>	DIRECTOR OF PROJECT DELIVERY
	APPROVED DATE 3/4/2016
	PROJECT MANAGER : MARK SARGENT
	PROJECT NAME : MORRISTOWN PROJECT NUMBER : BF 0239 (3)
SHEET 1 OF 9 SHEETS	

PROJECT NOTES

GENERAL

1. ALL MATERIALS AND CONSTRUCTION SHALL CONFORM TO THE STATE OF VERMONT AGENCY OF TRANSPORTATION 2011 STANDARD SPECIFICATIONS FOR CONSTRUCTION AND ITS LATEST REVISIONS AND THE 7TH EDITION OF THE AASHTO LRFD BRIDGE DESIGN SPECIFICATION AND ITS LATEST REVISIONS.
2. ALL WORK AND ANY ASSOCIATED ACTIVITY ON THIS PROJECT SHALL BE PERFORMED WITHIN THE EXISTING RIGHT-OF-WAY.
3. THE CONTRACTOR SHALL TAKE PRECAUTIONS TO AVOID DAMAGE TO THE EXISTING BRIDGE DECK AND APPROACH PAVEMENT. THE CONTRACTOR SHALL BE RESPONSIBLE FOR THE RESTORATION OF ANY PROPERTY WHICH HAS BEEN DAMAGED DURING THE PROSECUTION OF WORK.
4. DIMENSIONS SHOWN ON EXISTING DETAILS ARE TAKEN FROM THE EXISTING PLANS AND LIMITED FIELD MEASUREMENTS AND ARE NOT GUARANTEED. THE CONTRACTOR SHALL VERIFY ALL DIMENSIONS AND EXISTING DETAILS NECESSARY FOR THE COMPLETION OF ALL WORK BY FIELD MEASUREMENT. THE CONTRACTOR SHALL BE RESPONSIBLE FOR THE ADEQUACY AND ACCURACY THEREOF, AND SHALL NOT ORDER ANY MATERIAL OR COMMENCE ANY FABRICATION UNTIL THE REQUIRED MEASUREMENTS ON THE EXISTING STRUCTURE HAVE BEEN OBTAINED. FOR EMPHASIS ONLY, SOME PROPOSED DIMENSIONS ARE NOTED AS "VERIFY IN FIELD" OR "VIF", THIS DOES NOT RELIEVE THE CONTRACTOR OF THE RESPONSIBILITY TO VERIFY ALL DIMENSIONS AND DETAILS.

PROTECTIVE COATINGS

5. ALL EXISTING STEEL SHALL BE CLEANED AND PAINTED IN ACCORDANCE WITH ITEM 900.645 SPECIAL PROVISION (QC/QA CLEAN AND PAINT EXISTING STEEL STRUCTURES, BARE STEEL). THE SURFACE PREPARATION OF THE EXISTING STEEL SHALL INCLUDE 100% REMOVAL OF THE EXISTING PAINT SYSTEM. NEW STEEL AND RAILING MEMBERS EXCEPT W-BEAM SHALL BE SHOP PRIMED AND FIELD PAINTED WITH THE SAME TOPCOAT AS THE EXISTING STEEL.
6. THE COLOR OF THE FINAL COAT OF PAINT SHALL BE GREEN (FEDERAL CHIP NO. 14062) IN ACCORDANCE WITH THE FEDERAL STANDARD NO. 595.
7. THE EXISTING STRUCTURAL STEEL ON THIS PROJECT WAS PAINTED WITH A MATERIAL WHICH MAY CONTAIN LEAD. THE CONTRACTOR SHALL INDEMNIFY AND HOLD THE STATE, ITS OFFICERS AND EMPLOYEES HARMLESS CONCERNING THE CONTRACTOR'S USE OR DISPOSITION OF THE STRUCTURAL STEEL. TEN DAYS PRIOR TO COMMENCING WORK WHICH INVOLVES THE HANDLING OR DISTURBANCE OF PAINTED COMPONENTS, THE CONTRACTOR SHALL PROVIDE DOCUMENTS TO THE ENGINEER, AS REFERENCED IN THE SPECIAL PROVISIONS.
8. A COAT OF GREASE RUSTPROOFING COMPOUND SHALL BE APPLIED TO THE LOWER PORTION OF THE ENDS OF THE TRUSS AND FLOOR FRAMING (BELOW THE TOP OF THE BRIDGE DECK WITHIN SIX FEET OF THE ENDS OF THE BRIDGE). PAYMENT WILL BE INCLUDED IN ITEM 900.645 SPECIAL PROVISION (QA/QC CLEAN AND PAINT EXISTING STEEL STRUCTURES, BARE STEEL).

UTILITIES

9. EXISTING UTILITIES WILL BE RELOCATED BY OTHERS IN ADVANCE OF THE PROJECT AS DEPICTED ON THE LAYOUT SHEET. REFER TO UTILITY SPECIAL PROVISIONS FOR ADDITIONAL INFORMATION. UTILITY RELOCATION IS ANTICIPATED TO BE COMPLETE BY JUNE 1ST, 2016.

BRIDGE REPAIRS AND MODIFICATIONS

10. EXISTING BRIDGE RAILING SHALL BE REMOVED IN ACCORDANCE WITH ITEM 525.10 REMOVAL OF EXISTING BRIDGE RAILING AND REPLACED WITH NEW BRIDGE RAIL AND WILL BE PAID UNDER ITEM 900.640 SPECIAL PROVISION (BRIDGE RAILING, TRUSS). REFER TO SHEET 6 FOR DETAILS.
11. PARTIAL REMOVAL AND DISASSEMBLY ASSOCIATED WITH THE REPAIR OR REPLACEMENT OF STRUCTURAL STEEL WILL BE CONSIDERED INCIDENTAL TO ITEM 506.60 STRUCTURAL STEEL.

STRUCTURAL STEEL

15. ALL STRUCTURAL COMPONENTS OF THE BRIDGE SHALL BE INSPECTED BY THE CONTRACTOR AND THE ENGINEER TO IDENTIFY ADDITIONAL AREAS IN NEED OF REPAIR NOT SHOWN ON THE CONTRACT DOCUMENTS. ANY ADDITIONAL REPAIRS SHALL BE MADE AT THE DISCRETION OF THE ENGINEER AND SHALL BE APPROVED BY THE ENGINEER. ADDITIONAL REPAIRS WILL BE PAID UNDER CONTRACT ITEM 506.60 STRUCTURAL STEEL. 1,000 POUNDS OF ADDITIONAL STEEL HAS BEEN INCLUDED IN THE ESTIMATED QUANTITY FOR ITEM 506.60 STRUCTURAL STEEL ANTICIPATING ADDITIONAL REPAIRS.
16. FOR REPAIRS AS DETAILED ON THE PLANS OR AS DIRECTED BY THE ENGINEER, ALL NEW CONNECTIONS SHALL BE MADE WITH 3/8" DIAMETER HIGH STRENGTH BOLTS MEETING AASHTO M-164 TYPE 1 GALVANIZED. CONNECTIONS NOT DETAILED IN THE PLANS SHALL BE DETAILED BY THE FABRICATOR AND SUBMITTED TO THE ENGINEER FOR APPROVAL.
17. ANY EXISTING RIVETS THAT ARE MISSING OR REMOVED FOR REPAIRS AS DETAILED ON THE PLANS OR AS DIRECTED BY THE ENGINEER SHALL BE REPLACED WITH 3/8" DIAMETER HIGH STRENGTH BOLTS. WHERE RIVET HEADS ARE IN DIRECT CONTACT WITH MEMBERS TO BE RETAINED, TORCHES AND/OR THE USE OF FLAME CUTTING WILL NOT BE PERMITTED FOR ANY PORTION OF THE RIVET REMOVAL. THE CONTRACTOR SHALL VERIFY THAT THE EXISTING HOLE DIAMETER IS 3/8" AND BRING ANY DISCREPANCIES TO THE ATTENTION OF THE ENGINEER. COST OF BOLTS WILL NOT BE PAID DIRECTLY, BUT WILL BE CONSIDERED INCIDENTAL TO ITEM 506.60 "STRUCTURAL STEEL".
18. ALL STRUCTURAL STEEL PAID UNDER THE ITEM 506.60, STRUCTURAL STEEL SHALL CONFORM TO AASHTO M 270M/M 270 GRADE 36 EXCEPT ALL STRUCTURAL TUBING SHALL CONFORM TO SUBSECTIONS 714.11 UNLESS NOTED OTHERWISE.
19. ALL FAYING SURFACES BETWEEN THE EXISTING STEEL AND THE NEW FILLER PLATES SHALL BE BLAST CLEANED AND PRIMED WITH A ZINC PRIMER. MEETING THE CLASS B SLIP COEFFICIENT VALUE OF NOT LESS THAN 0.50 AS SPECIFIED BY AASHTO THE PRIMER COATING WILL REMAIN IN THE ASSEMBLED CONNECTION.
20. THE BOTTOM CHORD OF THE TRUSS IS A FRACTURE CRITICAL TENSION MEMBER. ALL STRUCTURAL STEEL ASSOCIATED WITH REPAIRS AND/OR REINFORCEMENT OF THE BOTTOM CHORD SHALL BE CHARPY V-NOTCH (CVN) TESTED UNLESS NOTED OTHERWISE.

TRAFFIC CONTROL/STAGING

21. THE TOWN OF MORRISTOWN WILL BE RESPONSIBLE FOR SELECTING, SIGNING AND MAINTAINING A DETOUR ROUTE. THE TOWN SHALL SIGN THE DETOUR ROUTE IN CONFORMANCE WITH 23 VSA SECTION 1025 AND THE LATEST EDITION OF THE MANUAL ON UNIFORM TRAFFIC CONTROL DEVICES.
22. THE CONTRACTOR WILL BE RESPONSIBLE FOR WARNING SIGNS INDICATING THE BRIDGE CLOSURE AND CONSTRUCTION ZONE ON T.R. #2 AND THE ADJACENT SIDE ROADS IN ACCORDANCE WITH TRAFFIC CONTROL STANDARDS AND THE LATEST EDITION OF THE MANUAL ON UNIFORM TRAFFIC CONTROL DEVICES. THE CONTRACTOR SHALL COORDINATE WITH TOWN HIGHWAY OFFICIALS AT LEAST FOUR WEEKS PRIOR TO ROAD CLOSURE.
23. A CONCEPTUAL TRAFFIC CONTROL PLAN FOR CLOSING T.R. #2 IN THE VICINITY OF CONSTRUCTION IS SHOWN ON SHEET 8. THE CONTRACTOR SHALL DEVELOP A SITE SPECIFIC TRAFFIC CONTROL PLAN IN ACCORDANCE WITH THE CURRENT MUTCD AND SUBMIT THE PLAN FOR REVIEW BY THE ENGINEER. THE CONTRACTOR SHALL ALLOW THE ENGINEER 14 DAYS TO REVIEW AND ACCEPT THE PLAN BEFORE IT IS IMPLEMENTED. CONSTRUCTION SHALL NOT BE PERMITTED TO COMMENCE UNTIL THE TRAFFIC CONTROL PLAN HAS BEEN APPROVED BY THE ENGINEER IN WRITING. DEVELOPMENT AND IMPLEMENTATION OF THE PLAN INCLUDING SIGNS, CHANNELIZING DEVICES, OTHER INCIDENTALS WILL BE PAID FOR UNDER ITEM 900.645 SPECIAL PROVISION (TRAFFIC CONTROL, ALL-INCLUSIVE).
24. THE EXISTING BRIDGE IS RATED FOR A MAXIMUM LOAD OF TEN TONS. CONSTRUCTION EQUIPMENT SHALL NOT EXCEED THIS LOAD LIMIT. HEAVY EQUIPMENT FOR CLEANING AND PAINTING SHALL NOT BE POSITIONED ON THE BRIDGE.
25. THE CONTRACTOR MAY USE THE EXISTING ROADWAY (T.R. #2) NORTH OF THE EXISTING BRIDGE FOR STAGING OF EQUIPMENT; HOWEVER, ACCESS TO EXISTING DRIVES AND SIDE STREETS MUST BE MAINTAINED AT ALL TIMES THROUGHOUT CONSTRUCTION.
26. INSTALLING, MAINTAINING, AND REMOVING THE SIGNS, TEMPORARY TRAFFIC BARRIERS AND BARRICADES IN THE SITE SPECIFIC TRAFFIC CONTROL PLAN AS NECESSARY TO MEET PROJECT CONDITIONS WILL BE INCLUDED FOR PAYMENT UNDER CONTRACT ITEM 900.645 SPECIAL PROVISION (TRAFFIC CONTROL, ALL-INCLUSIVE). PCMS WILL BE PAID SEPARATELY UNDER PAY ITEM 641.15.
27. "ROAD CLOSED" SIGNS SHALL BE MOUNTED AND MAINTAINED ON LIGHTED TYPE III BARRICADES.
28. TYPE III CONSTRUCTION BARRICADES SHALL BE PLACED SO AS TO PHYSICALLY EXCLUDE TRAFFIC FROM THE ENTIRE ROADWAY WIDTH OR AT THE DISCRETION OF THE ENGINEER.

SUMMARY OF ANTICIPATED STEEL REPAIRS

1. STATIONING FOR REPAIR LOCATION 0+00 AT CL BRG. ABUTMENT 1
2. ALL REPAIRS EXCEPT DRILLING AND GROUTING RAIL POST ANCHORS AND BRIDGE PLAQUE REPLACEMENT ARE TO BE PAID FOR UNDER ITEM 506.60 "STRUCTURAL STEEL"
3. REFER TO DETAILS ON SHEETS 6 & 7.

<u>REPLACE RAIL POST</u>				<u>DRILL AND GROUT RAIL POST DECK ANCHORS, REFER TO TYPICAL RAIL SECTION DETAIL</u>			
<u>ANTICIPATED LOCATION:</u>				<u>ANTICIPATED LOCATION:</u>			
STA.	0+10	LT.		12 LOCATIONS, 2 ANCHORS PER LOCATION			
STA.	0+31	LT.					
STA.	0+10	RT.		<u>REMOVE AND REPLACE STAY PLATE</u>			
STA.	0+31	RT.		<u>ANTICIPATED LOCATION:</u>			
STA.	0+50	RT.		STA.	0+26	LT.	
STA.	0+71	RT.		STA.	0+36	LT.	
				STA.	0+38	LT.	
<u>REPLACE MISSING STAY PLATE</u>				STA.	0+63	LT.	
<u>ANTICIPATED LOCATION:</u>				STA.	0+84	LT.	
STA.	0+42	LT.		STA.	0+92	LT.	
STA.	0+59	LT.		STA.	0+96	LT.	
STA.	0+79	LT.		STA.	1+07	LT.	
STA.	0+84	LT.		STA.	1+20	LT.	
STA.	0+15	RT.		STA.	0+88	RT.	
STA.	0+19	RT.		STA.	1+14	RT.	
STA.	0+22	RT.		STA.	1+17	RT.	
STA.	0+26	RT.					
STA.	0+30	RT.		<u>NEW SPLICE PLATE, REFER TO DETAIL E</u>			
STA.	0+42	RT.		<u>ANTICIPATED LOCATION:</u>			
STA.	0+59	RT.		STA.	0+38	LT.	
STA.	0+59	RT.		STA.	0+38	RT.	
STA.	0+63	RT.					
STA.	0+63	RT.		<u>REPLACE END COVER PLATE, REFER TO DETAIL A</u>			
STA.	0+66	RT.		STA.	0+00	LT.	(REPLACE BOLTS ONLY)
STA.	0+66	RT.		STA.	1+19	LT.	
STA.	0+69	RT.		STA.	0+00	RT.	
STA.	0+69	RT.		STA.	1+19	RT.	
STA.	0+70	RT.					
				<u>REPLACE EXISTING BRIDGE PLAQUE, REFER TO DETAIL F</u>			
				ITEM 900.620 SPECIAL PROVISION (BRIDGE PLAQUE, CAST BRONZE)			
				<u>NEW BOTTOM CHORD REPAIR, REFER TO DETAIL C</u>			
				STA.	0+03	LT.	(INSIDE CHORD).
				<u>EXTEND BRIDGE SCUPPER, REFER TO DETAIL D</u>			
				6 LOCATIONS			
				<u>INSTALL NEW LACING BARS, REFER TO DETAIL G</u>			
				STA.	0+00	RT.	2 BARS.



PROJECT NAME:	MORRISTOWN	PLOT DATE:	3/9/2016
PROJECT NUMBER:	BF 0239(3)	DRAWN BY:	J. SOTER
FILE NAME:	z13j274frm.dgn	CHECKED BY:	G. BOGUE
PROJECT LEADER:	T. KNIGHT	SHEET	2 OF 9
DESIGNED BY:	T. KNIGHT		
PROJECT NOTES			

QUANTITY SHEET

SUMMARY OF ESTIMATED QUANTITIES										TOTALS		DESCRIPTIONS				DETAILED SUMMARY OF QUANTITIES		
								BRIDGE	FULL C.E. ITEMS	GRAND TOTAL	FINAL	UNIT	ITEMS	ITEM NUMBER	ROUND	QUANTITIES	UNIT	ITEMS
								1		1		CY	TRENCH EXCAVATION OF EARTH, EXPLORATORY (N.A.B.I.)	204.22				
								2800		2800		LB	STRUCTURAL STEEL	506.60				
								24		24		LF	DRILLING AND GROUTING DOWELS	507.16				
								250		250		LF	REMOVAL OF EXISTING BRIDGE RAILING	525.10				
								50		50		LF	REMOVE AND RESET GUARDRAIL	621.75				
								80		80		HR	FLAGGERS	630.15				
									1	1		LS	FIELD OFFICE, ENGINEERS	631.10				
									1	1		LS	TESTING EQUIPMENT, PROTECTIVE COATINGS	631.18				
									3000	3000		DL	FIELD OFFICE TELEPHONE (N.A.B.I.)	631.26				
								1		1		LS	MOBILIZATION/DEMOBILIZATION	635.11				
								2		2		EACH	PORTABLE CHANGEABLE MESSAGE SIGN	641.15				
								1		1		EACH	SPECIAL PROVISION (BRIDGE PLAQUE, CAST BRONZE)	900.620				
								250		250		LF	SPECIAL PROVISION (BRIDGE RAILING, TRUSS)	900.640				
								1		1		LS	SPECIAL PROVISION (CONTAINMENT AND DISPOSAL OF LEAD PAINT CLEANING RESIDUES)	900.645				
								1		1		LS	SPECIAL PROVISION (QC/QA CLEAN AND PAINT EXISTING STEEL STRUCTURES, BARE STEEL)	900.645				
								1		1		LS	SPECIAL PROVISION (TRAFFIC CONTROL, ALL INCLUSIVE)	900.645				

PROJECT NAME: MORRISTOWN
 PROJECT NUMBER: BF 0239(3)
 FILE NAME: z13j274frm.dgn
 PROJECT LEADER: T. KNIGHT
 DESIGNED BY: D. YOULEN
 QUANTITY SHEET
 PLOT DATE: 3/9/2016
 DRAWN BY: J. SOTER
 CHECKED BY: N. TIRK
 SHEET 3 OF 9



GENERAL INFORMATION

SYMBOLGY LEGEND NOTE

THE SYMBOLGY ON THIS SHEET IS INTENDED TO COVER STANDARD CONVENTIONAL SYMBOLGY. THE SYMBOLGY IS USED FOR EXISTING & PROPOSED FEATURES WITH HEAVIER LINEWEIGHT, IN COMBINATION WITH PROJECT ANNOTATION, AS NOTED ON PROJECT PLAN SHEETS. THIS LEGEND SHEET COVERS THE BASICS. SYMBOLGY ON PLANS MAY VARY, PLAN ANNOTATIONS AND NOTES SHOULD BE USED TO CLARIFY AS NEEDED.

R. O. W. ABBREVIATIONS (CODES) & SYMBOLS

POINT	CODE	DESCRIPTION
	CH	CHANNEL EASEMENT
	CONST	CONSTRUCTION EASEMENT
	CUL	CULVERT EASEMENT
	D&C	DISCONNECT & CONNECT
	DIT	DITCH EASEMENT
	DR	DRAINAGE EASEMENT
	DRIVE	DRIVEWAY EASEMENT
	EC	EROSION CONTROL
	HWY	HIGHWAY EASEMENT
	I&M	INSTALL & MAINTAIN EASEMENT
	LAND	LANDSCAPE EASEMENT
	R&RES	REMOVE & RESET
	R&REP	REMOVE & REPLACE
	SR	SLOPE RIGHT
	UE	UTILITY EASEMENT
	(P)	PERMANENT EASEMENT
	(T)	TEMPORARY EASEMENT
■	BNDNS	BOUND SET
▣	BNDNS	BOUND TO BE SET
●	IPNS	IRON PIN SET
⊙	IPNS	IRON PIN TO BE SET
⊠	CALC	EXISTING ROW POINT
○	PROW	PROPOSED ROW POINT
[LENGTH]		LENGTH CARRIED ON NEXT SHEET

COMMON TOPOGRAPHIC POINT SYMBOLS

POINT	CODE	DESCRIPTION
⊠	APL	BOUND APPARENT LOCATION
□	BM	BENCHMARK
▣	BND	BOUND
▣	CB	CATCH BASIN
⊕	COMB	COMBINATION POLE
▣	DITHR	DROP INLET THROATED DNC
⊕	EL	ELECTRIC POWER POLE
○	FPOLE	FLAGPOLE
○	GASFIL	GAS FILLER
○	GP	GUIDE POST
×	GSO	GAS SHUT OFF
○	GUY	GUY POLE
○	GUYW	GUY WIRE
×	GV	GATE VALUE
⊕	H	TREE HARDWOOD
△	HCTRL	CONTROL HORIZONTAL
△	HVCTRL	CONTROL HORIZ. & VERTICAL
◇	HYD	HYDRANT
●	IP	IRON PIN
●	IPIPE	IRON PIPE
⊕	LI	LIGHT - STREET OR YARD
⊕	MB	MAILBOX
○	MH	MANHOLE (MH)
□	MM	MILE MARKER
●	PM	PARKING METER
□	PMK	PROJECT MARKER
○	POST	POST STONE/WOOD
⊕	RRSIG	RAILROAD SIGNAL
⊕	RRSL	RAILROAD SWITCH LEVER
⊕	S	TREE SOFTWOOD
⊕	SAT	SATELLITE DISH
⊕	SHRUB	SHRUB
⊕	SIGN	SIGN
⊕	STUMP	STUMP
○	TEL	TELEPHONE POLE
○	TIE	TIE
⊕	TSIGN	SIGN W/DOUBLE POST
⊕	VCTRL	CONTROL VERTICAL
○	WELL	WELL
×	WSO	WATER SHUT OFF

THESE ARE COMMON VAOT SURVEY POINT SYMBOLS FOR EXISTING FEATURES, ALSO USED FOR PROPOSED FEATURES WITH HEAVIER LINEWEIGHT, IN COMBINATION WITH PROPOSED ANNOTATION.

PROPOSED GEOMETRY CODES

CODE	DESCRIPTION
PC	POINT OF CURVATURE
PI	POINT OF INTERSECTION
CC	CENTER OF CURVE
PT	POINT OF TANGENCY
PCC	POINT OF COMPOUND CURVE
PRC	POINT OF REVERSE CURVE
POB	POINT OF BEGINNING
POE	POINT OF ENDING
STA	STATION PREFIX
AH	AHEAD STATION SUFFIX
BK	BACK STATION SUFFIX
D	CURVE DEGREE OF (100FT)
R	CURVE RADUIS OF
T	CURVE TANGENT LENGTH
L	CURVE LENGTH OF
E	CURVE EXTERNAL DISTANCE

UTILITY SYMBOLGY

UNDERGROUND UTILITIES	
— UGU —	UTILITY (GENERIC-UNKNOWN)
— UT —	TELEPHONE
— UE —	ELECTRIC
— UC —	CABLE (TV)
— UEC —	ELECTRIC+CABLE
— UET —	ELECTRIC+TELEPHONE
— UCT —	CABLE+TELEPHONE
— UECT —	ELECTRIC+CABLE+TELEP.
— G —	GAS LINE
— W —	WATER LINE
— S —	SANITARY SEWER (SEPTIC)

ABOVE GROUND UTILITIES (AERIAL)	
— AGU —	UTILITY (GENERIC-UNKNOWN)
— T —	TELEPHONE
— E —	ELECTRIC
— C —	CABLE (TV)
— EC —	ELECTRIC+CABLE
— ET —	ELECTRIC+TELEPHONE
— AER E&T —	ELECTRIC+TELEPHONE
— CT —	CABLE+TELEPHONE
— ECT —	ELECTRIC+CABLE+TELEP.
— — —	UTILITY POLE GUY WIRE

PROJECT CONSTRUCTION SYMBOLGY	
— — — CZ — — —	CLEAR ZONE
— — — — —	PLAN LAYOUT MATCHLINE

PROJECT CONSTRUCTION FEATURES	
▲ — — — — —	TOP OF CUT SLOPE
⊕ — — — — —	TOE OF FILL SLOPE
⊕ ⊕ ⊕ ⊕ ⊕ ⊕	STONE FILL
— — — — —	BOTTOM OF DITCH
— — — — —	CULVERT PROPOSED
— — — — —	STRUCTURE SUBSURFACE
PDF — — — — — PDF	PROJECT DEMARCATION FENCE
BF — — — — — BF	BARRIER FENCE
XXXXXXXXXXXXXXXXXXXX	TREE PROTECTION ZONE (TPZ)
//// //// //// ////	STRIPING LINE REMOVAL
~~~~ ~~~~ ~~~~ ~~~~	SHEET PILES

CONVENTIONAL BOUNDARY SYMBOLGY	
— — — — —	TOWN BOUNDARY LINE
— — — — —	COUNTY BOUNDARY LINE
— — — — —	STATE BOUNDARY LINE
— — — — —	PROPOSED STATE R.O.W. (LIMITED ACCESS)
— — — — —	PROPOSED STATE R.O.W.
— — — — —	STATE ROW (LIMITED ACCESS)
— — — — —	STATE ROW
— — — — —	TOWN ROW
— — — — —	PERMANENT EASEMENT LINE (P)
— — — — —	TEMPORARY EASEMENT LINE (T)
— — — — —	SURVEY LINE
P — — — — — P	PROPERTY LINE (P/L)
SR — — — — — SR	SLOPE RIGHTS
6f — — — — — 6f	6F PROPERTY BOUNDARY
4f — — — — — 4f	4F PROPERTY BOUNDARY
HAZ — — — — — HAZ	HAZARDOUS WASTE

**EPSC LAYOUT PLAN SYMBOLGY**

EPSC MEASURES	
ONNOONNOONNO	FILTER CURTAIN
— — — — —	SILT FENCE
— — — — —	SILT FENCE WOVEN WIRE
— — — — —	CHECK DAM
— — — — —	DISTURBED AREAS REQUIRING RE-VEGETATION
— — — — —	EROSION MATTING


ENVIRONMENTAL RESOURCES	
— — — — —	WETLAND BOUNDARY
— — — — —	RIPARIAN BUFFER ZONE
— — — — —	WETLAND BUFFER ZONE
— — — — —	SOIL TYPE BOUNDARY
— — — — —	THREATENED & ENDANGERED SPECIES
HAZ — — — — — HAZ	HAZARDOUS WASTE AREA
AG — — — — —	AGRICULTURAL LAND
HABITAT — — — — —	FISH & WILDLIFE HABITAT
FLOOD PLAIN — — — — —	FLOOD PLAIN
OHW — — — — —	ORDINARY HIGH WATER (OHW)
— — — — —	STORM WATER
— — — — —	USDA FOREST SERVICE LANDS
— — — — —	WILDLIFE HABITAT SUIT/CONN

ARCHEOLOGICAL & HISTORIC	
— — — — —	ARCHEOLOGICAL BOUNDARY
— — — — —	HISTORIC DISTRICT BOUNDARY
— — — — —	HISTORIC AREA
(H)	HISTORIC STRUCTURE

CONVENTIONAL TOPOGRAPHIC SYMBOLGY	
— — — — —	EXISTING FEATURES
— — — — —	ROAD EDGE PAVEMENT
— — — — —	ROAD EDGE GRAVEL
— — — — —	DRIVEWAY EDGE
— — — — —	DITCH
— — — — —	FOUNDATION
— — — — —	FENCE (EXISTING)
— — — — —	FENCE WOOD POST
— — — — —	FENCE STEEL POST
— — — — —	GARDEN
— — — — —	ROAD GUARDRAIL
— — — — —	RAILROAD TRACKS
— — — — —	CULVERT (EXISTING)
— — — — —	STONE WALL
— — — — —	WALL
— — — — —	WOOD LINE
— — — — —	BRUSH LINE
— — — — —	HEDGE
— — — — —	BODY OF WATER EDGE
— — — — —	LEDGE EXPOSED

PROJECT NAME: MORRISTOWN  
 PROJECT NUMBER: BF 0239(3)  
 FILE NAME: z13j274legend.dgn PLOT DATE: 3/3/2016  
 PROJECT LEADER: T. KNIGHT DRAWN BY: VTRANS  
 DESIGNED BY: VTRANS CHECKED BY: T. KNIGHT  
 CONVENTIONAL SYMBOLGY LEGEND SHEET 4 OF 9



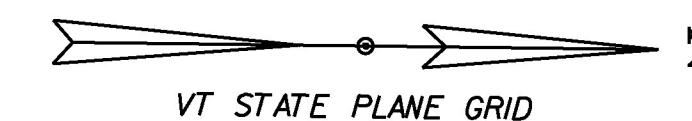

UTILITY RELOCATION IS ANTICIPATED TO BE COMPLETE BY JUNE 1ST, 2016.

**REMOVAL OF EXISTING BRIDGE RAIL**

STA. 43+68.43 TO STA. 44+92.43 LT. & RT.

**SPECIAL PROVISION (BRIDGE RAILING, TRUSS)**

STA. 43+68.43 TO STA. 44+92.43 LT. & RT.


**STRUCTURAL STEEL/DOWEL DRILL & GROUT/BRIDGE PLAQUE**

REFER TO SUMMARY OF ANTICIPATED STEEL REPAIRS ON THE PROJECT NOTES SHEET.

**ITEM 621.75 - REMOVE AND RESET GUARDRAIL**


STA. 43+55.93 TO STA. 43+68.43 LT. & RT.


STA. 44+92.43 TO STA. 45+04.93 LT. & RT.

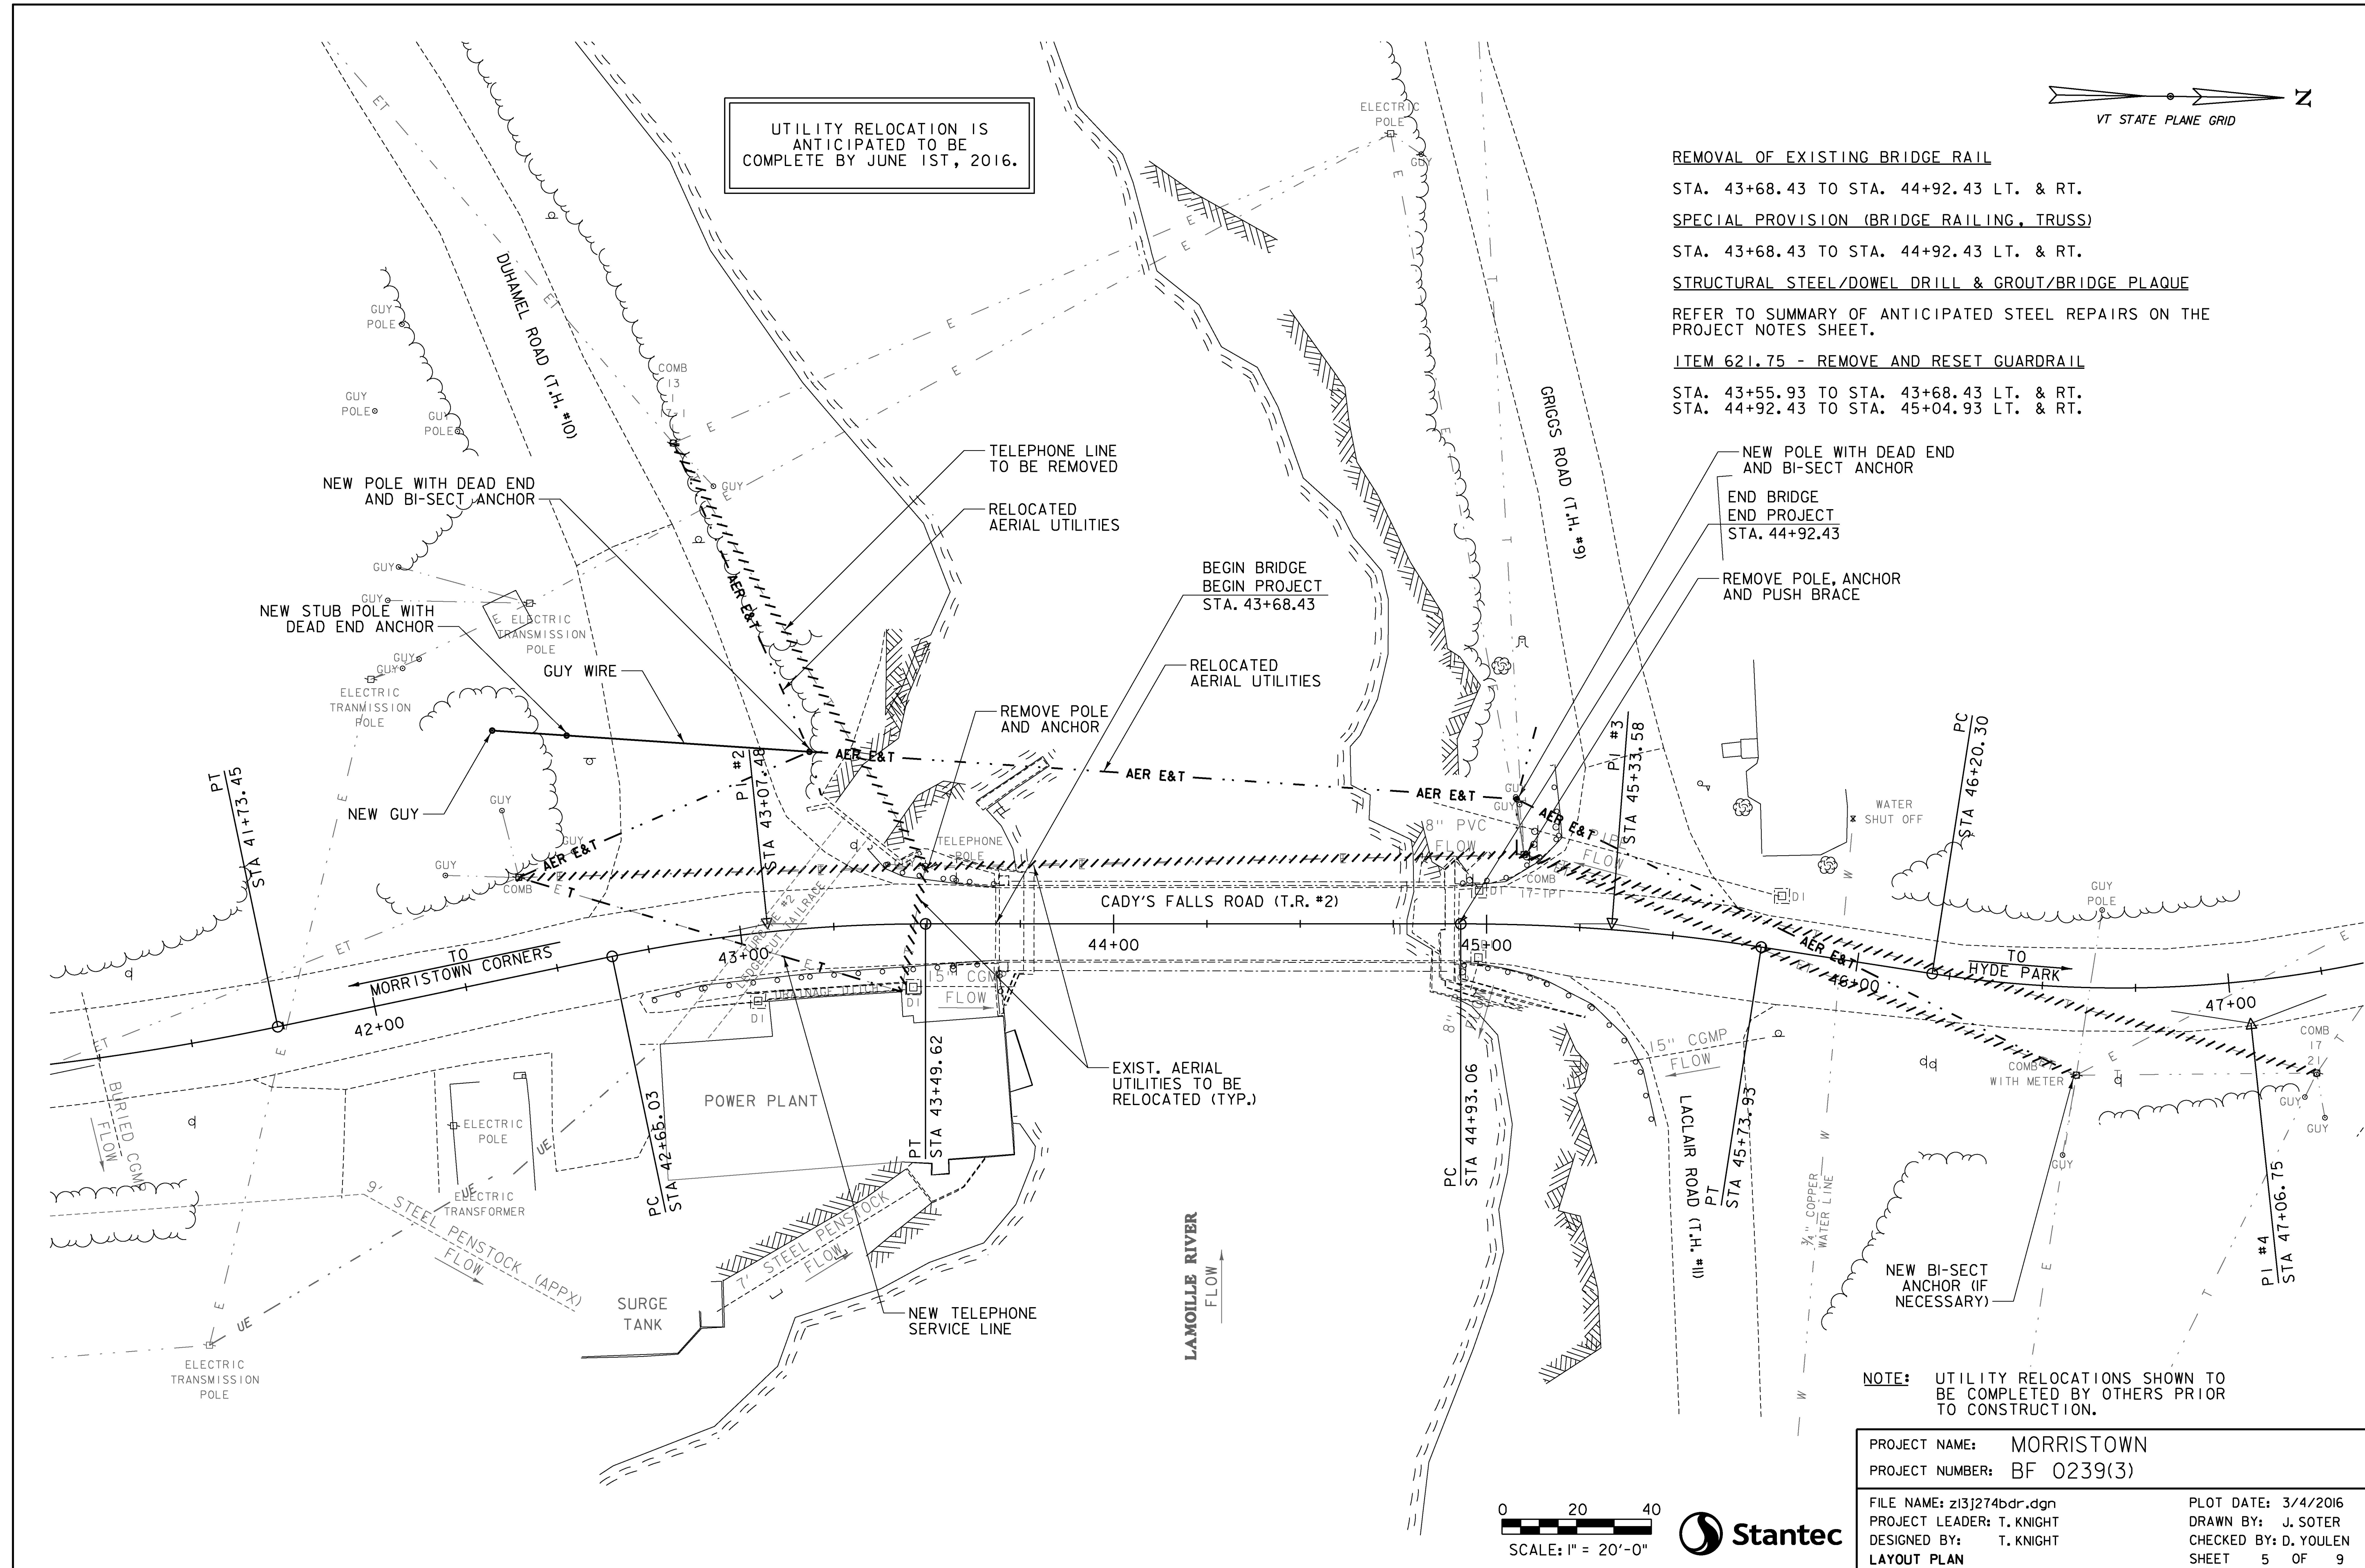


**NOTE:** UTILITY RELOCATIONS SHOWN TO BE COMPLETED BY OTHERS PRIOR TO CONSTRUCTION.

PROJECT NAME: MORRISTOWN	
PROJECT NUMBER: BF 0239(3)	
FILE NAME: z13j274bdr.dgn	PLOT DATE: 3/4/2016
PROJECT LEADER: T. KNIGHT	DRAWN BY: J. SOTER
DESIGNED BY: T. KNIGHT	CHECKED BY: D. YOULEN
LAYOUT PLAN	SHEET 5 OF 9

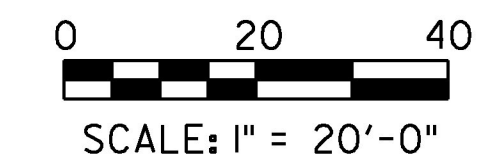


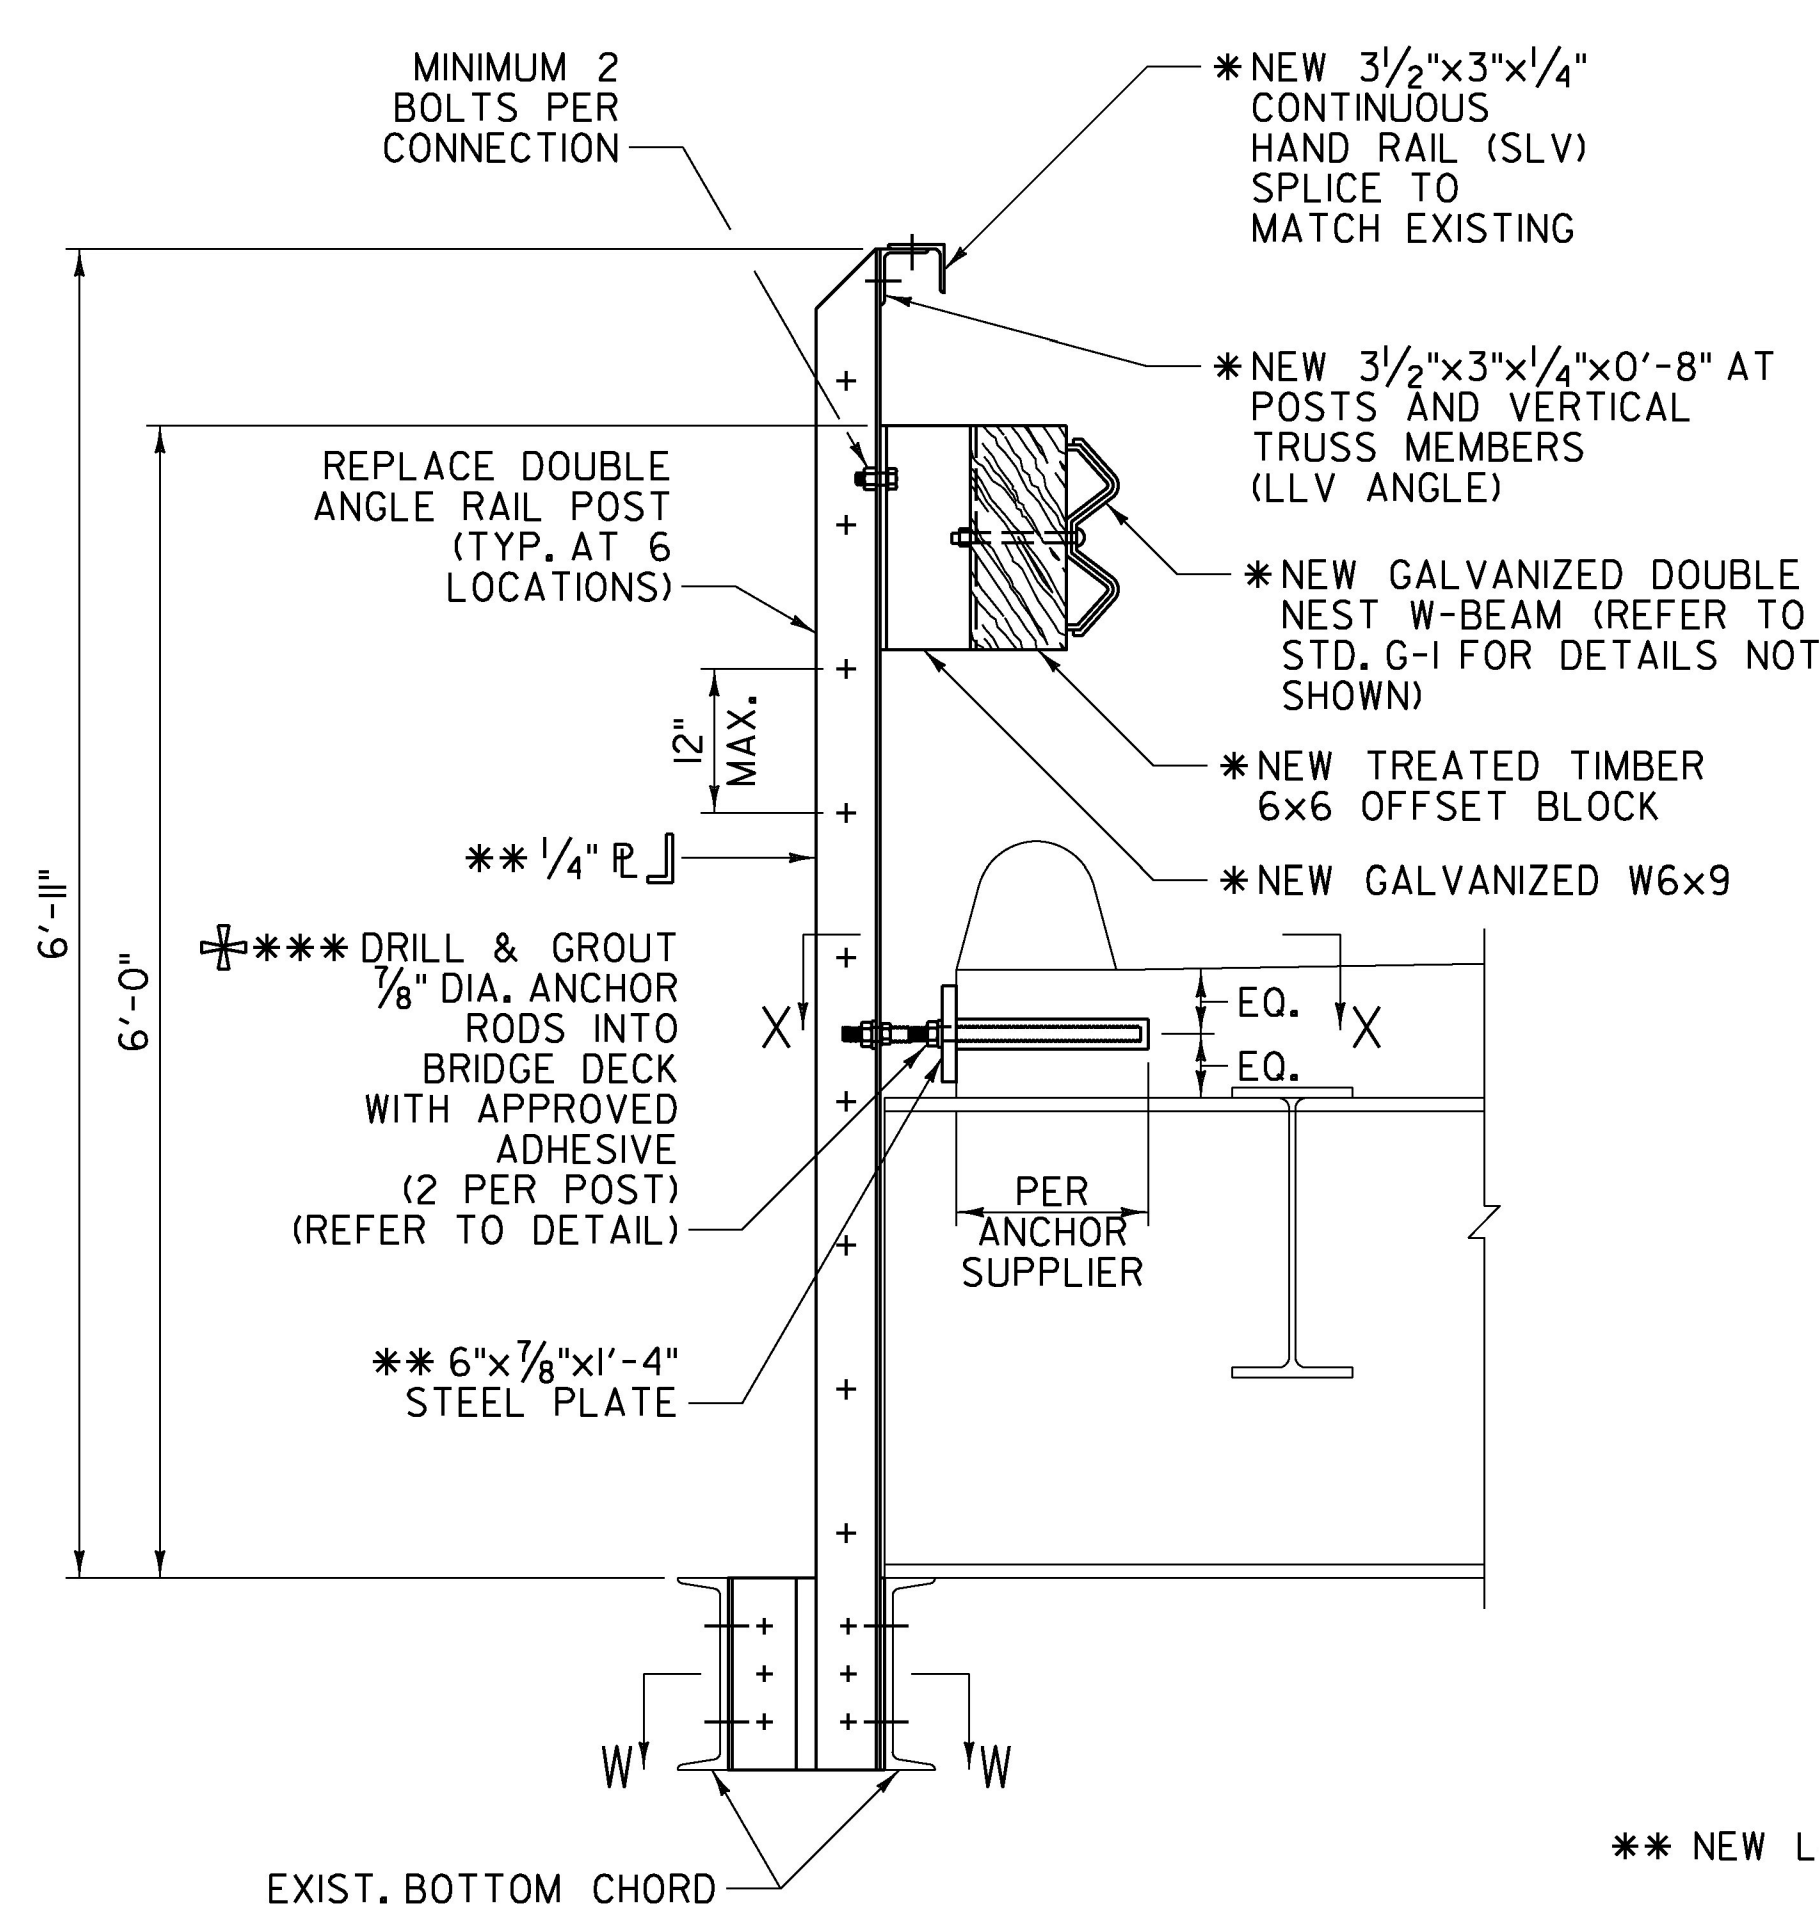


TYPICAL RAIL SECTION  
SCALE: 1" = 1'-0"

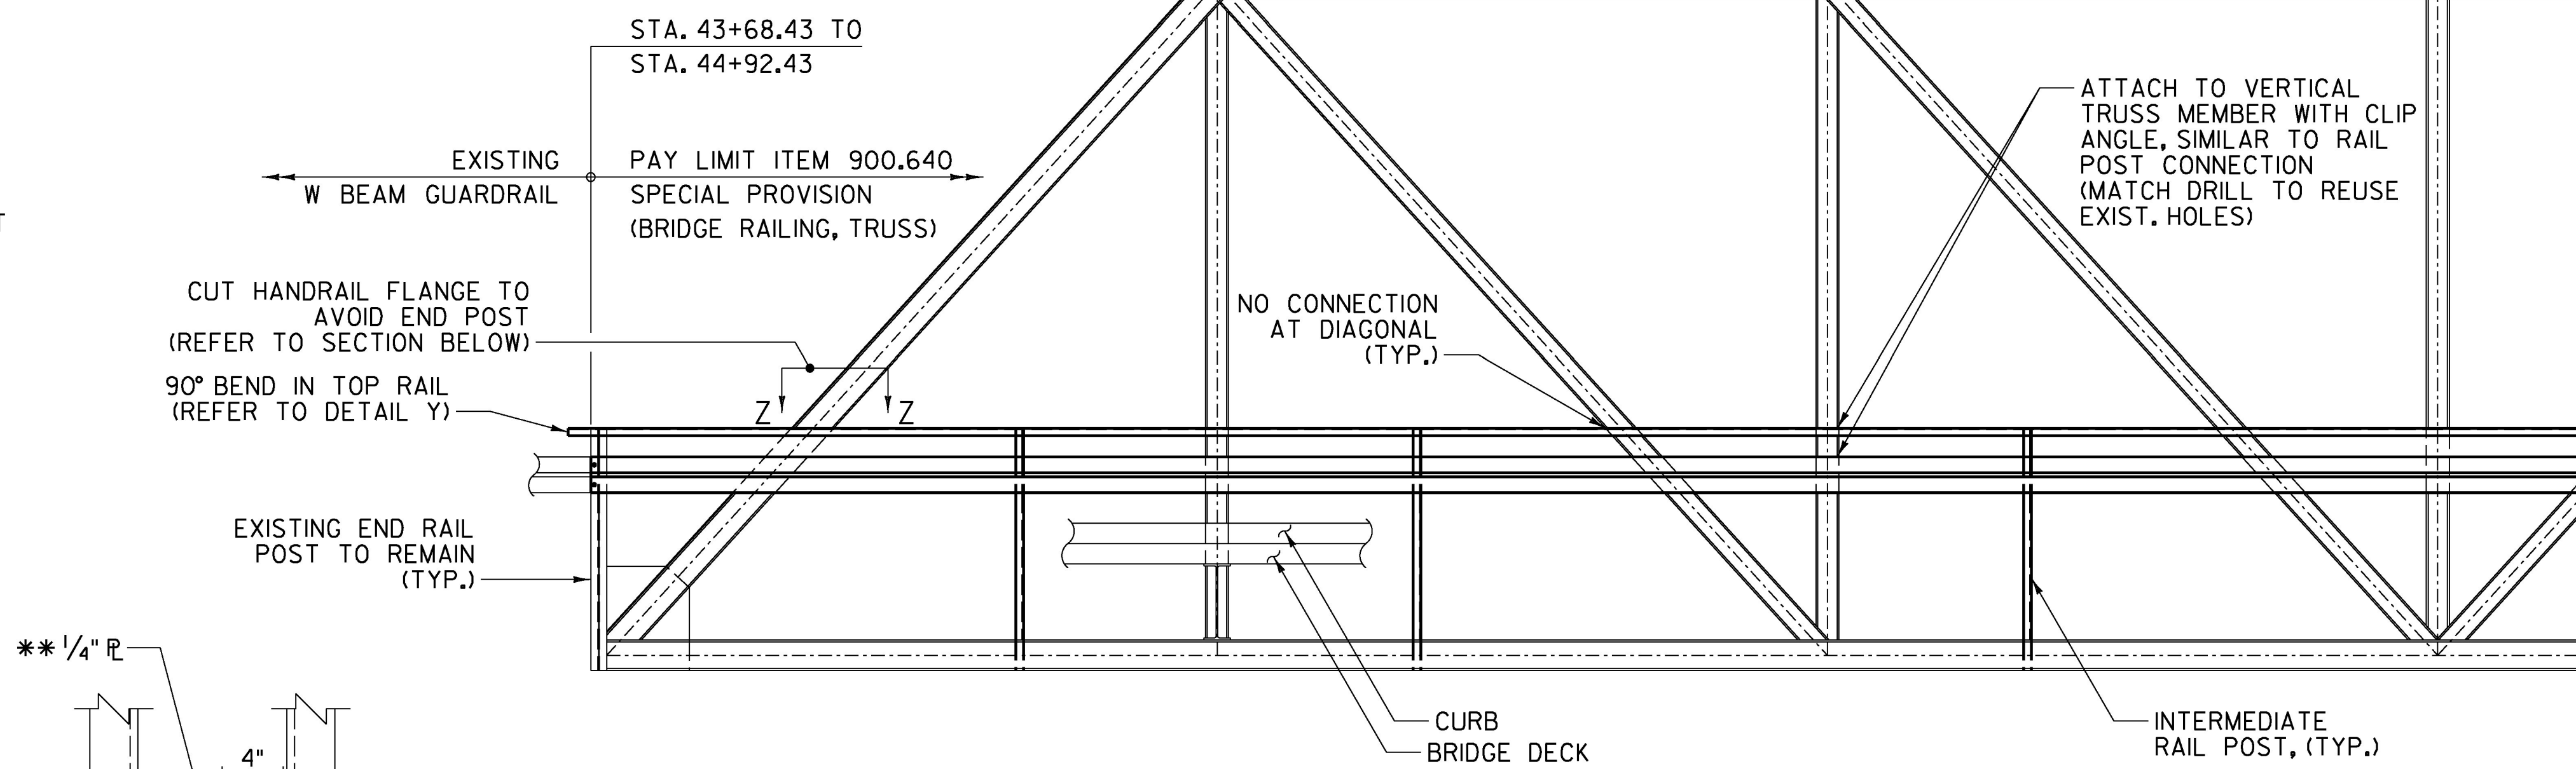


ELEVATION  
SCALE: 1/4" = 1'-0"

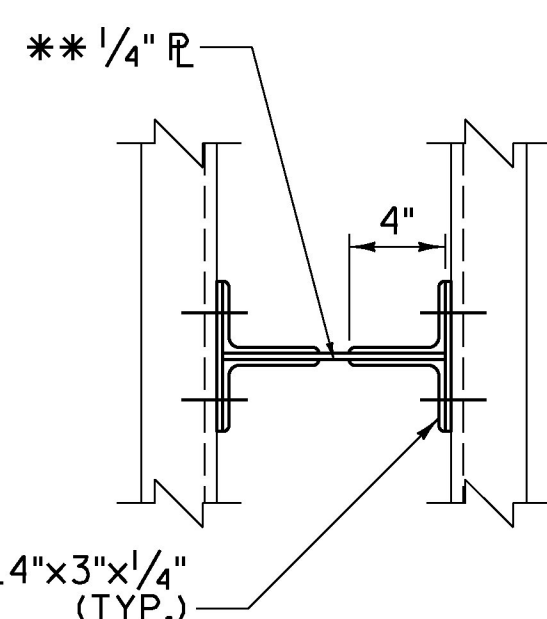

SECTION W-W  
SCALE: 1 1/2" = 1'-0"

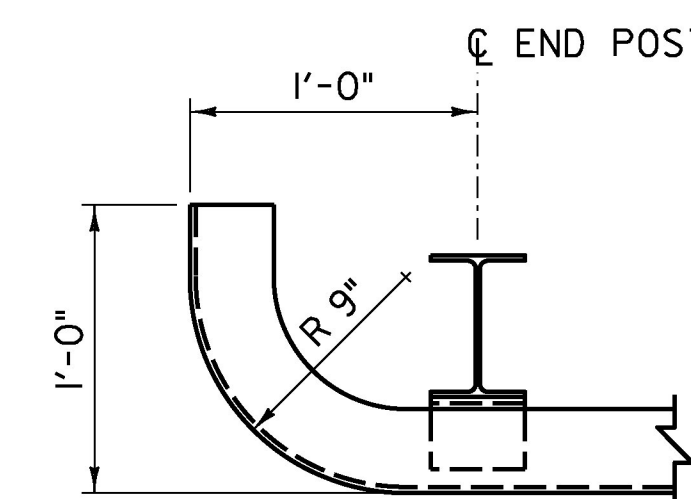


DETAIL Y  
*90° BEND IN TOP RAIL AT END POST  
SCALE: 1 1/2" = 1'-0"

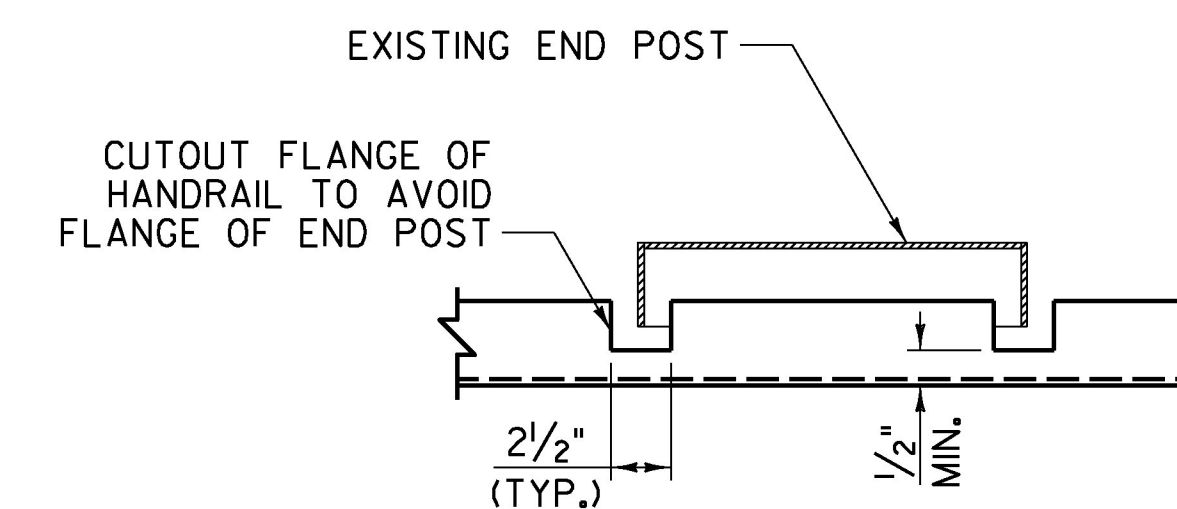

SECTION Z-Z  
HANDRAIL FLANGE CUTOUT  
SCALE: 1 1/2" = 1'-0"

NOTES:




- * HAND RAIL, OFFSET BLOCKS, CLIP ANGLE, SPLICES AND ASSOCIATED HARDWARE SHALL BE FURNISHED AND INSTALLED. PAYMENT WILL BE CONSIDERED INCIDENTAL TO ITEM 900.640 SPECIAL PROVISION (BRIDGE RAILING, TRUSS).
- ** REPLACEMENT OF BRIDGE RAIL POSTS WILL BE PAID UNDER ITEM 506.60.
- *** HARDWARE AND ANCHOR SHALL BE IN ACCORDANCE WITH SECTION 506 AND SUBSECTION 714.07, PAYMENT WILL BE INCIDENTAL TO ITEM 507.16.
- **** REQUIRED ULTIMATE BOND STRENGTH OF 54 KIPS PER ANCHOR; HOLE SIZE AND EMBEDMENT PER ANCHOR SUPPLIER.

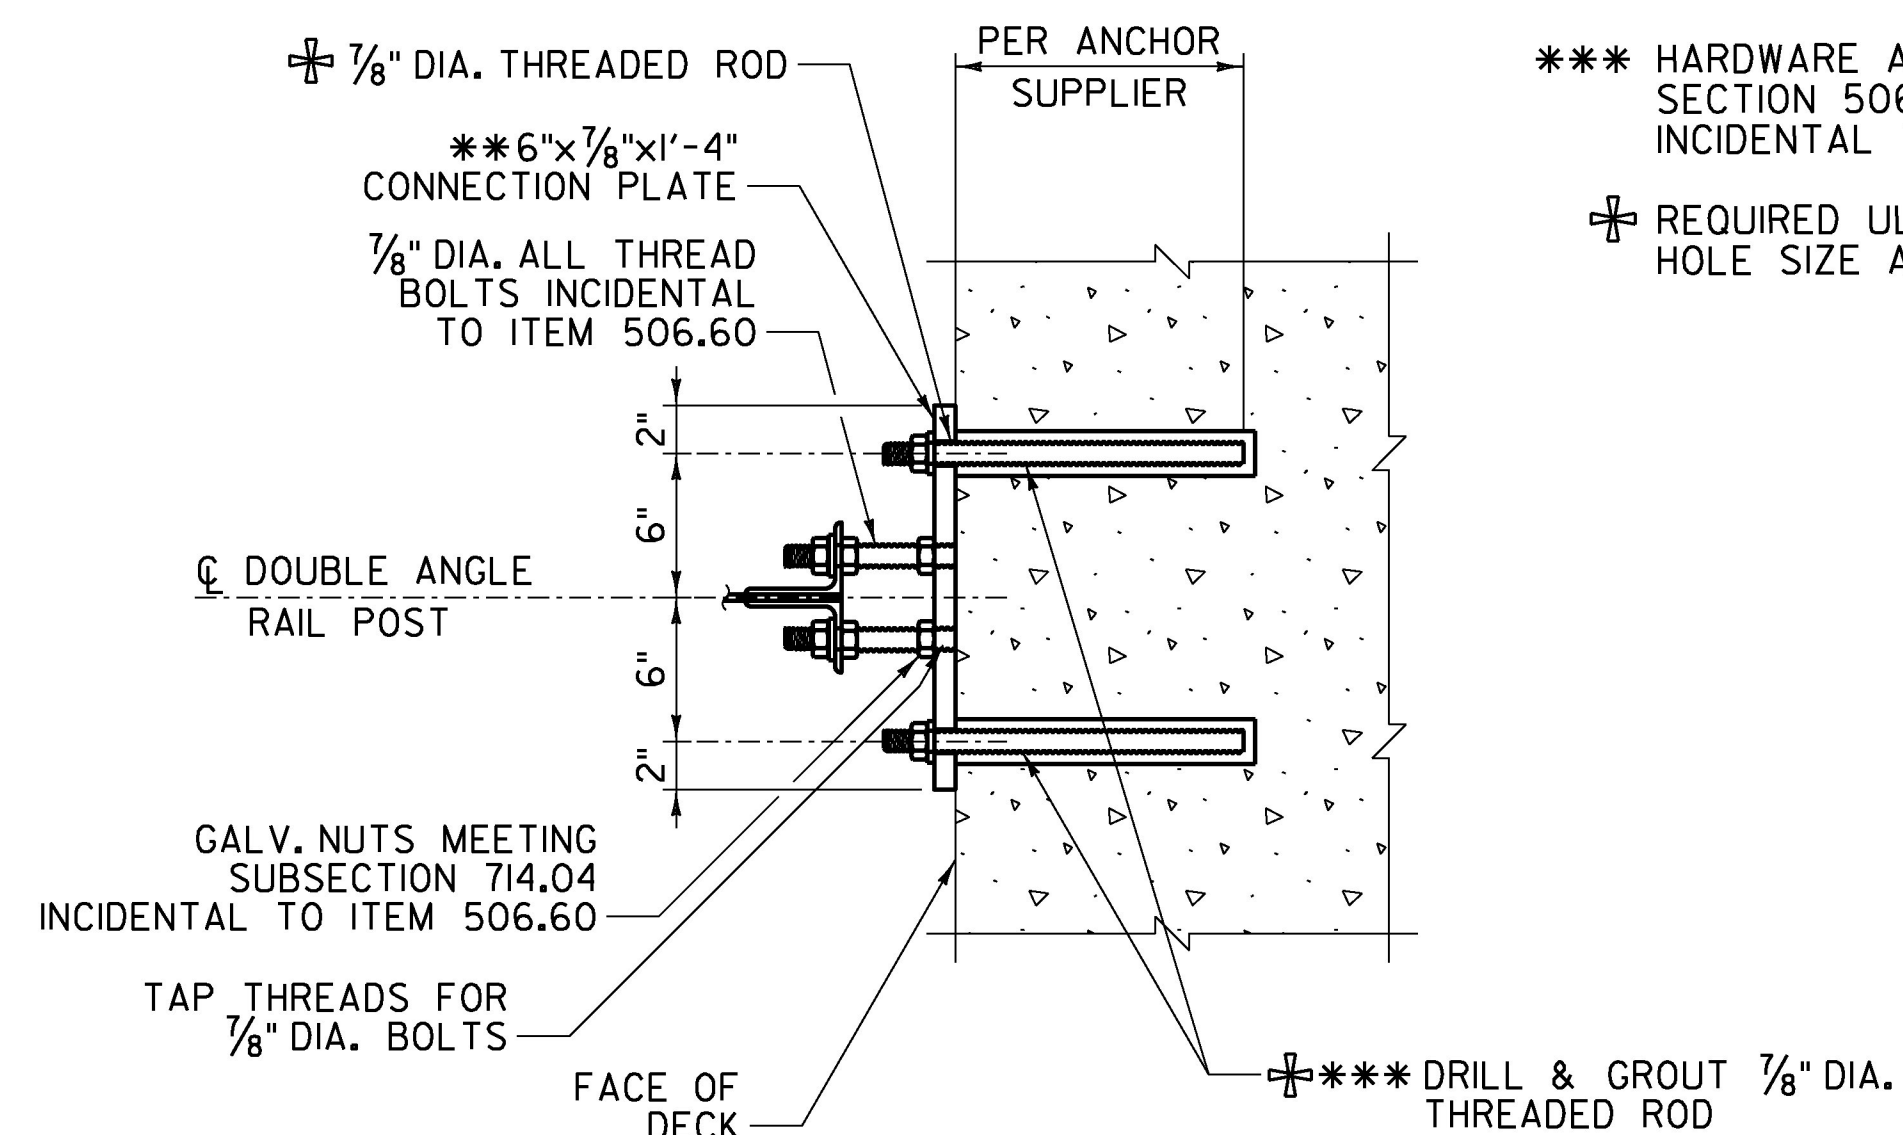

SECTION X-X  
SCALE: 1 1/2" = 1'-0"





PROJECT NAME:	MORRISTOWN
PROJECT NUMBER:	BF 0239(3)
FILE NAME:	z13j274typ.dgn
PROJECT LEADER:	T. KNIGHT
DESIGNED BY:	T. KNIGHT
BRIDGE RAIL DETAILS	
PLOT DATE:	3/9/2016
DRAWN BY:	J. SOTER
CHECKED BY:	G. BOGUE
SHEET	6 OF 9



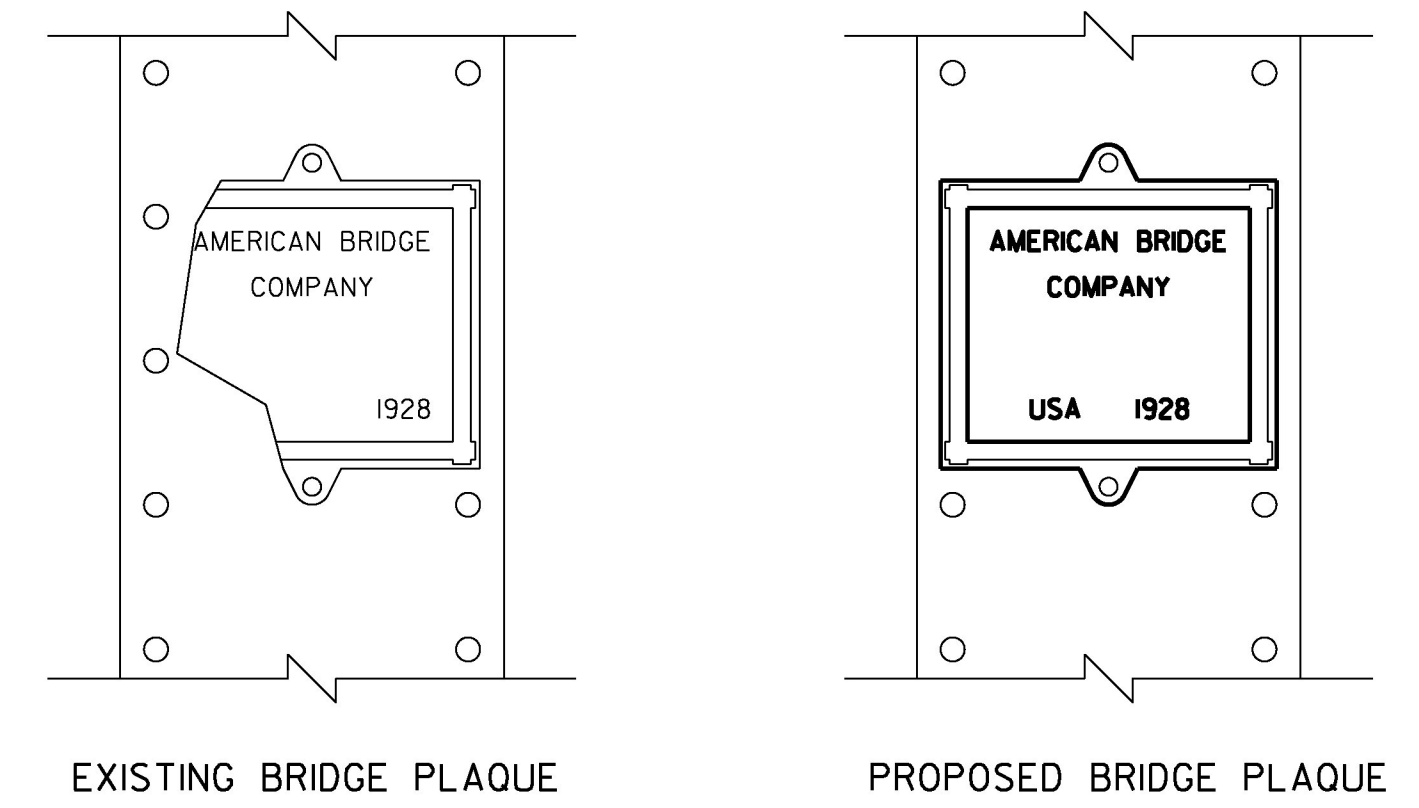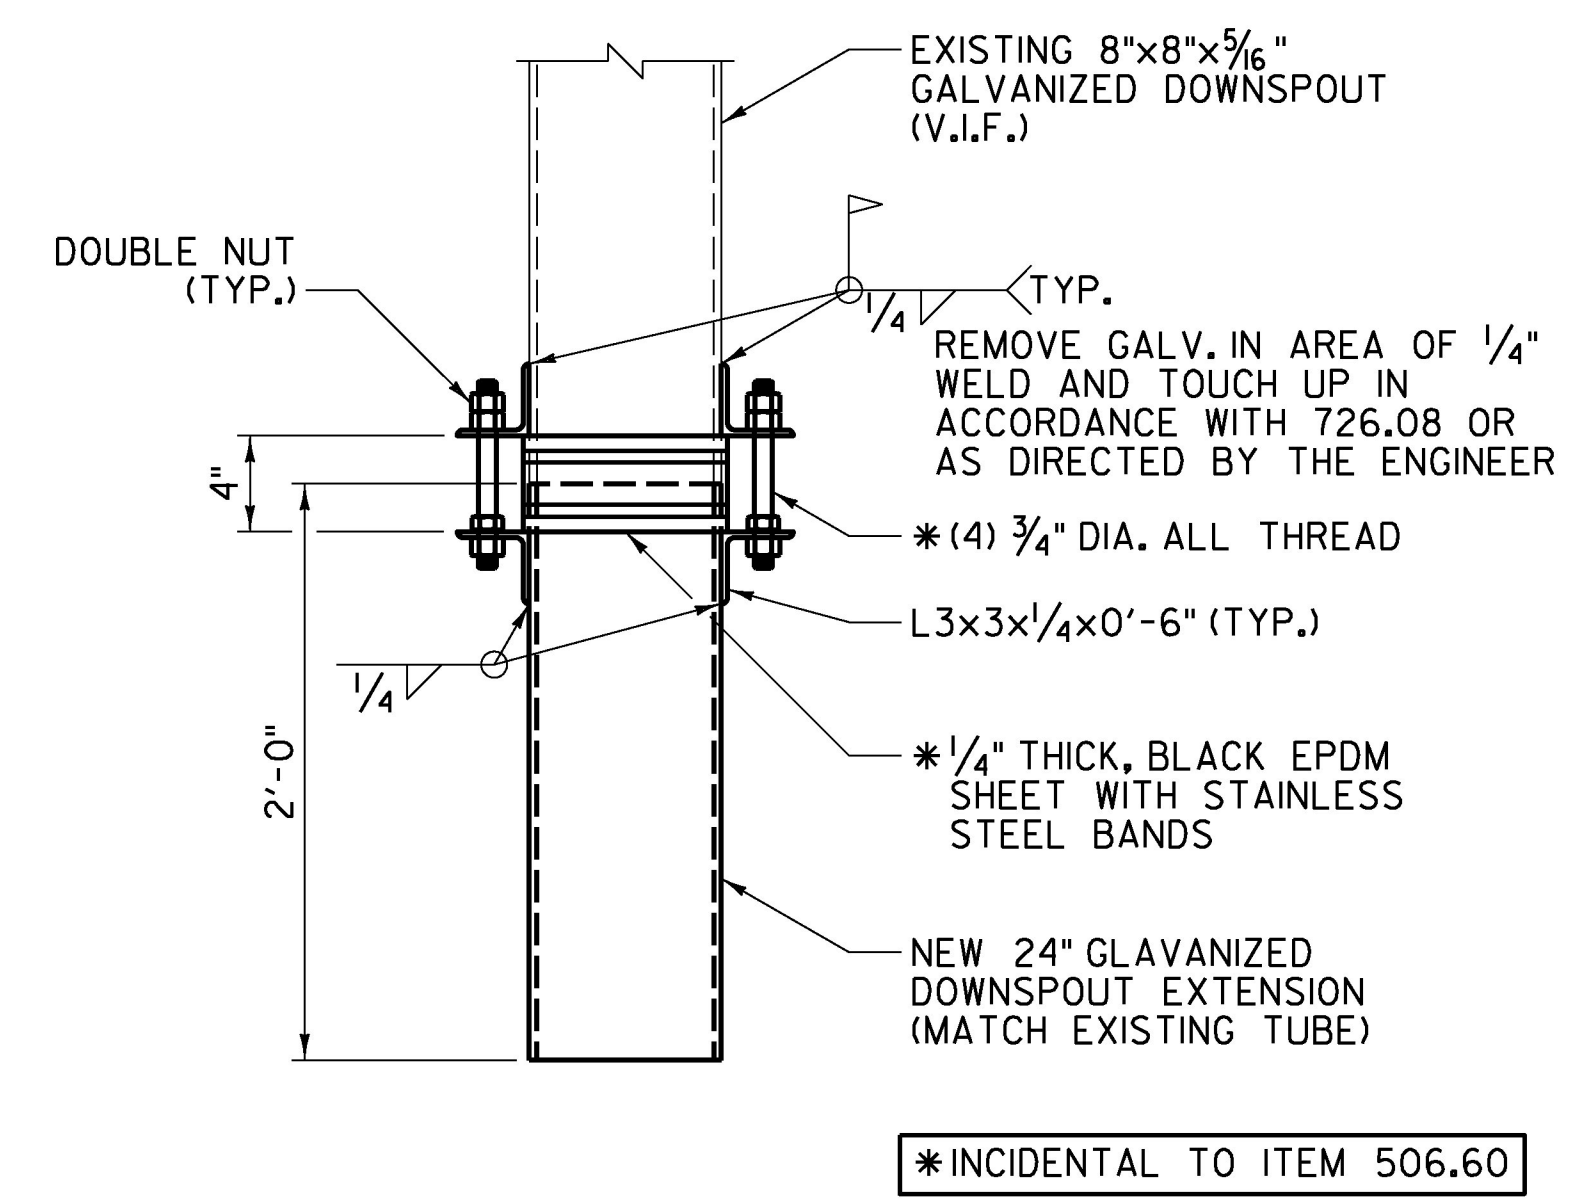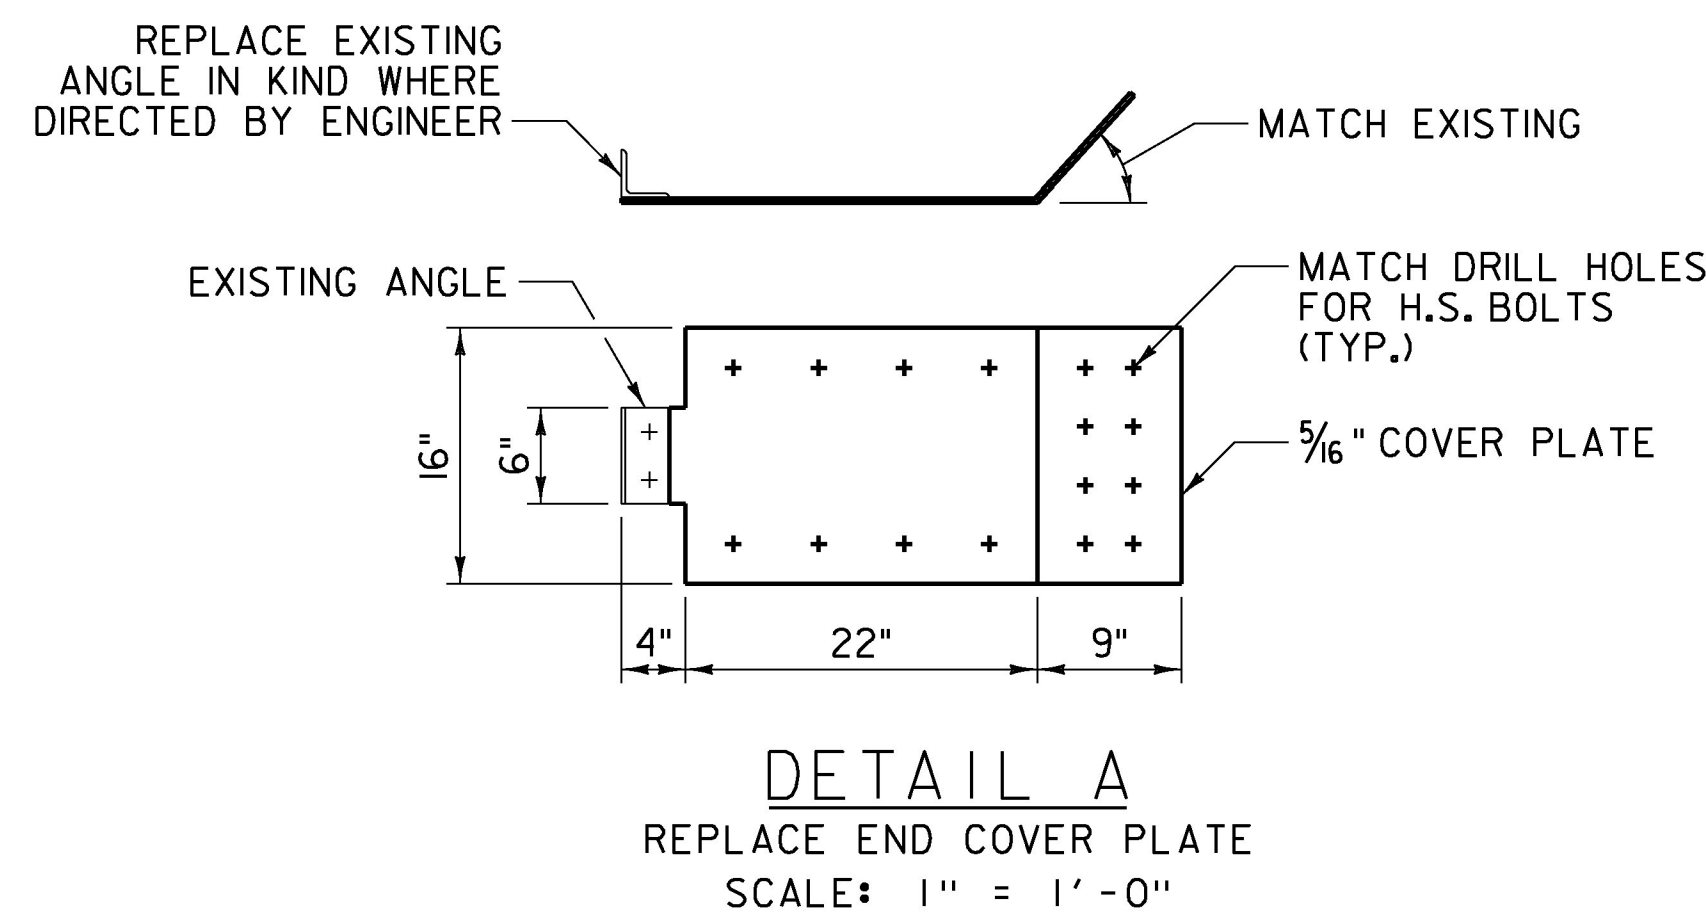

**NOTE:** REPLACE EXISTING BRIDGE PLAQUE WITH NEW BRONZE PLAQUE. REFER TO SPECIAL PROVISION (BRIDGE PLAQUE, CAST BRONZE)



**DETAIL F**  
NOT TO SCALE

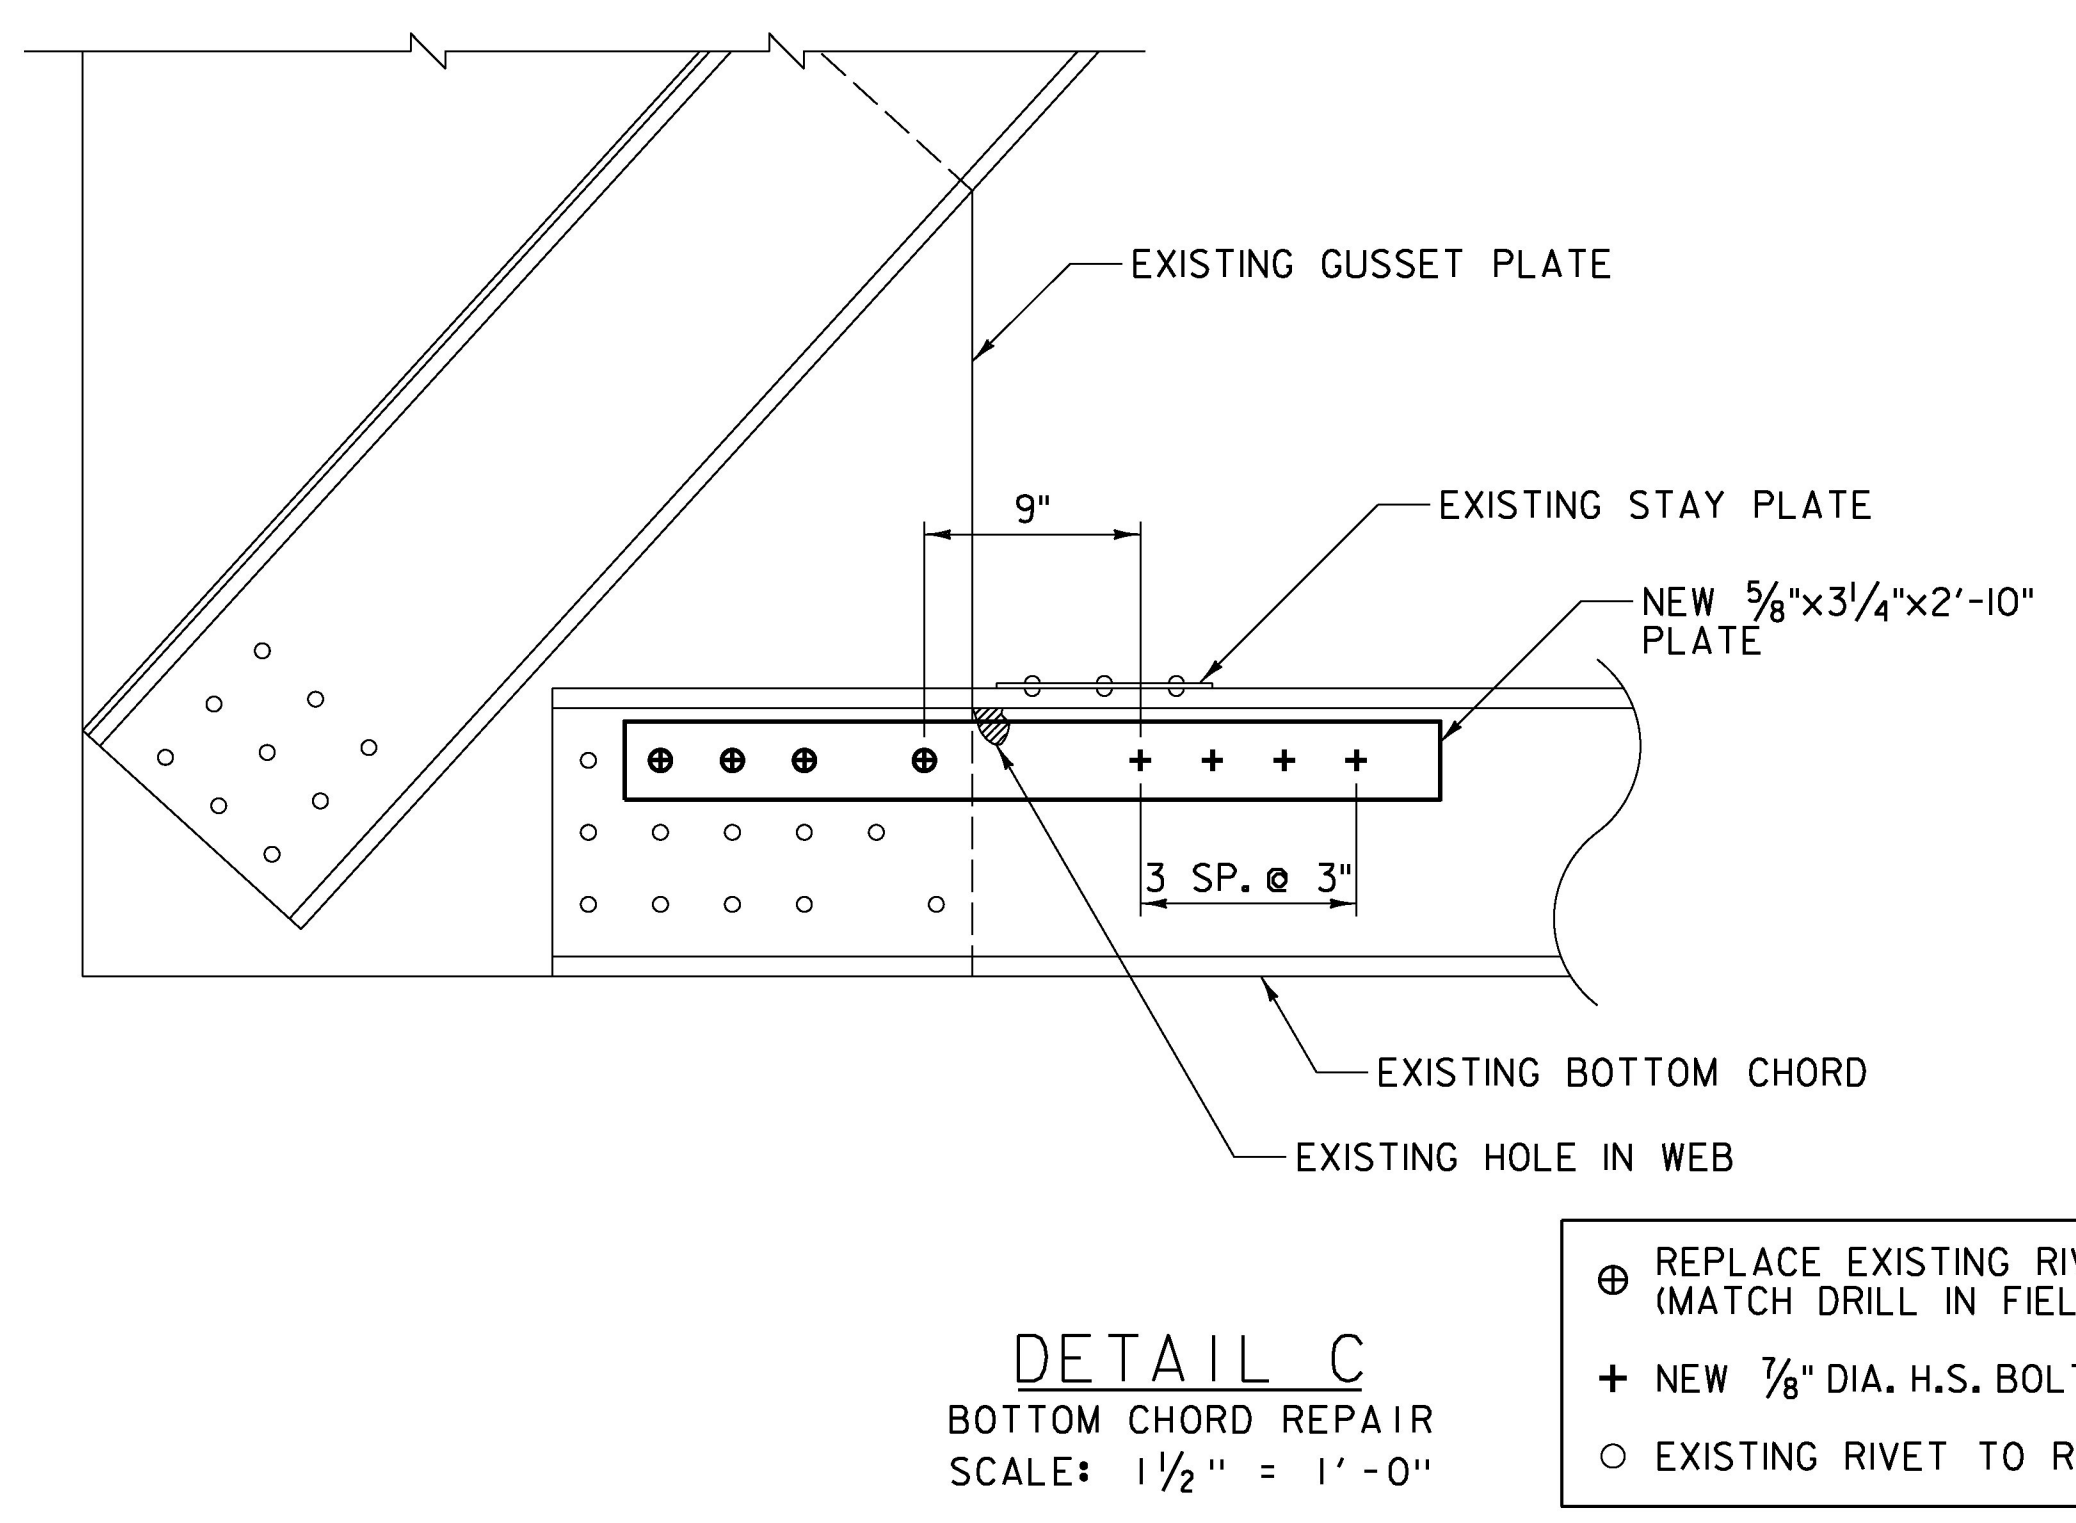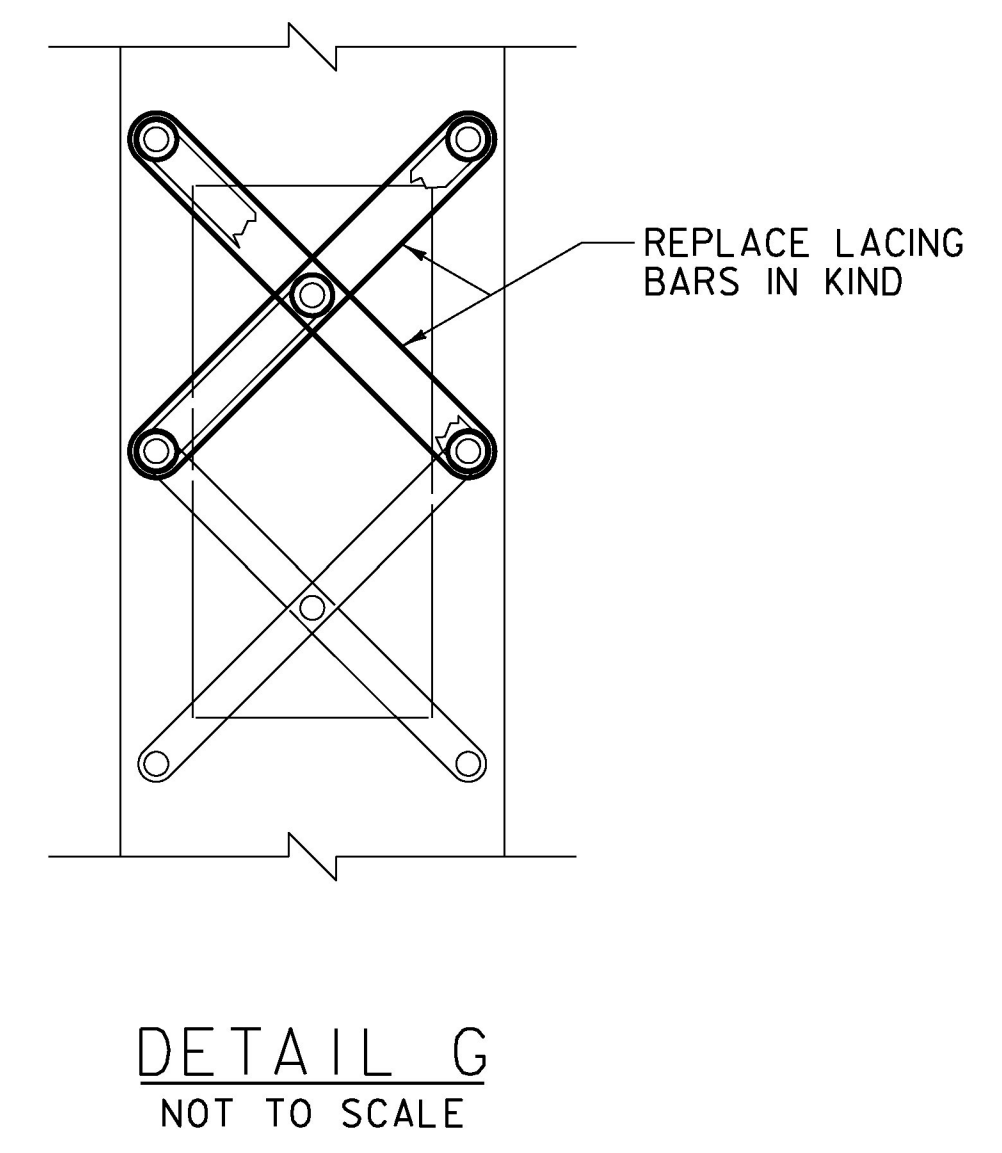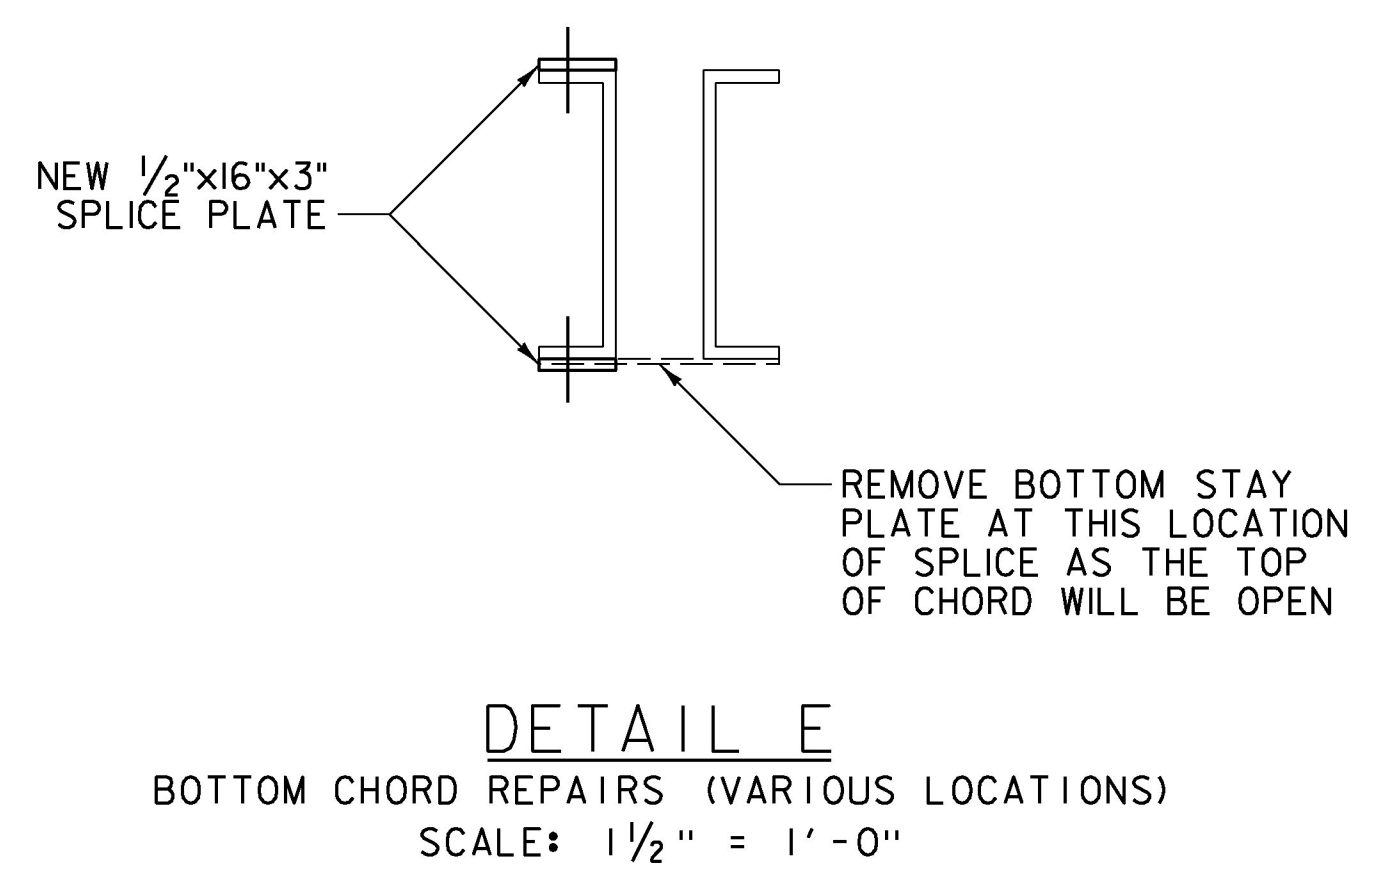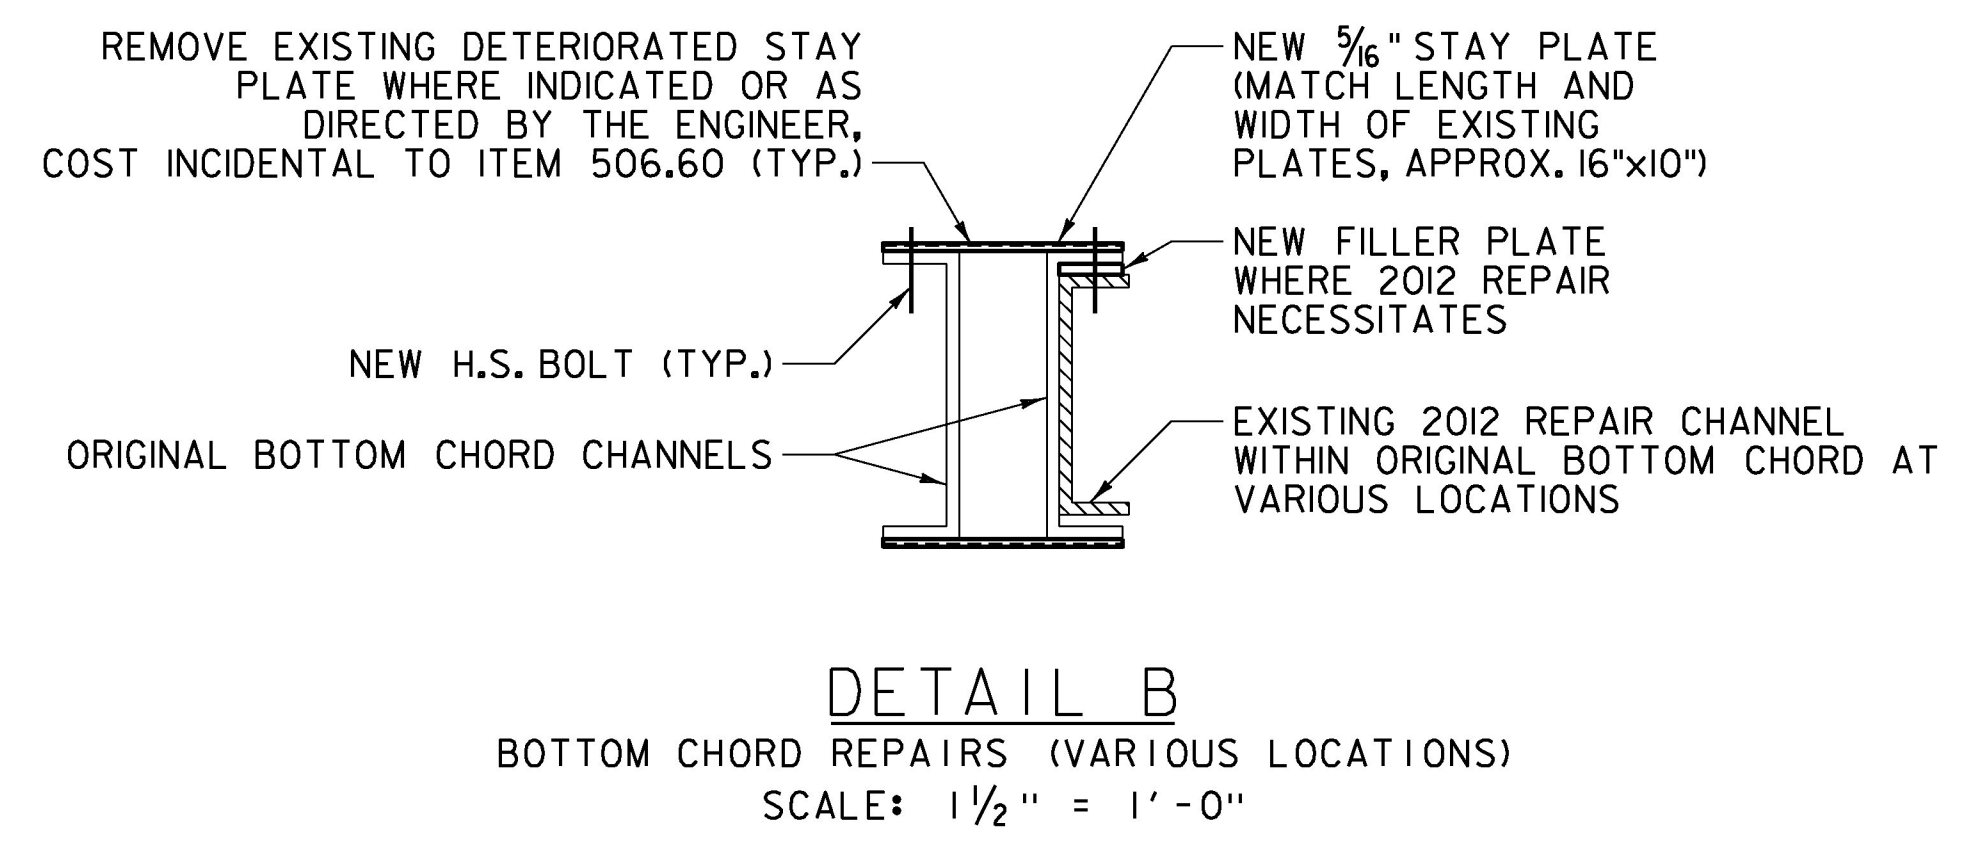

- ⊕ REPLACE EXISTING RIVET WITH H.S. BOLT (MATCH DRILL IN FIELD)
- + NEW 7/8" DIA. H.S. BOLT
- EXISTING RIVET TO REMAIN



PROJECT NAME:	MORRISTOWN	PLOT DATE:	3/3/2016
PROJECT NUMBER:	BF 0239(3)	DRAWN BY:	J. SOTER
FILE NAME:	z13j274typ.dgn	DESIGNED BY:	T. KNIGHT
REPAIR DETAILS		CHECKED BY:	G. BOGUE
		SHEET	7 OF 9

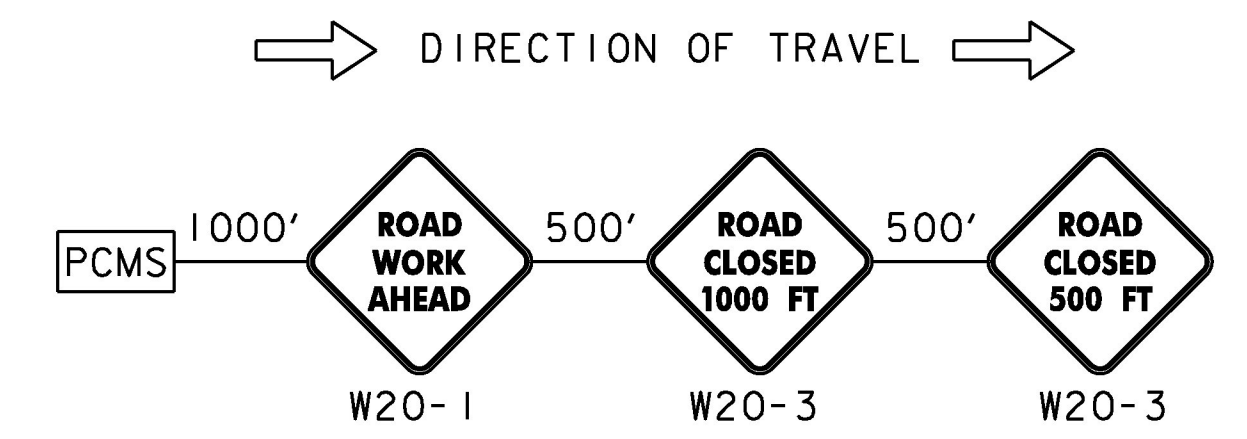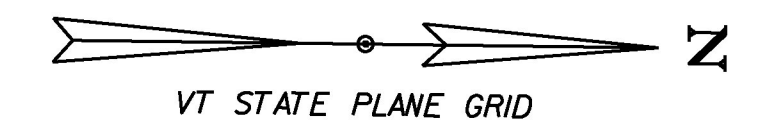

**T.R. #2 TRAFFIC CONTROL APPROACH SIGN PACKAGE**

**APPROACH SIGN NOTES:**

1. ALL SIGNS ARE TO BE LOCATED ON THE RIGHT SIDE OF THE ROAD APPROACHING THE CONSTRUCTION AREA UNLESS OTHERWISE NOTED.
2. SIGN SPACING MAY BE ADJUSTED AS NECESSARY AT THE DISCRETION OF THE ENGINEER.

**TRAFFIC CONTROL NOTES:**

1. SEE PROJECT NOTES SHEET FOR ADDITIONAL TRAFFIC CONTROL NOTES.
2. TEMPORARY TRAFFIC BARRIER SHALL BE FURNISHED IN ACCORDANCE WITH SECTION 621 AND WILL BE PAID UNDER CONTRACT PAY ITEM 900.645 SPECIAL PROVISION (TRAFFIC CONTROL, ALL-INCLUSIVE).

**MESSAGES FOR PORTABLE CHANGEABLE MESSAGE SIGNS (PCMS)**

STARTING 2 WEEK (S) PRIOR TO CLOSURE



<b>BRIDGE CLOSED</b>	
PHASE 1	<b>ON CADY'S FALLS ROAD</b>
	<b>XX/XX/XX - XX/XX/XX</b>
PHASE 2	<b>SEEK ALTERNATE ROUTES</b>
	_____
	_____



**LEGEND**

	TYPE III BARRICADE
	TEMPORARY TRAFFIC BARRIER




**NOTE:** UTILITY RELOCATIONS SHOWN TO BE COMPLETED BY OTHERS PRIOR TO CONSTRUCTION.

PROJECT NAME:	MORRISTOWN	PLOT DATE:	3/9/2016
PROJECT NUMBER:	BF 0239(3)	DRAWN BY:	J. SOTER
FILE NAME:	z13j274bdr_+tc.dgn	DESIGNED BY:	T. KNIGHT
PROJECT LEADER:	T. KNIGHT	CHECKED BY:	D. YOULEN
TRAFFIC CONTROL PLAN			SHEET 8 OF 9

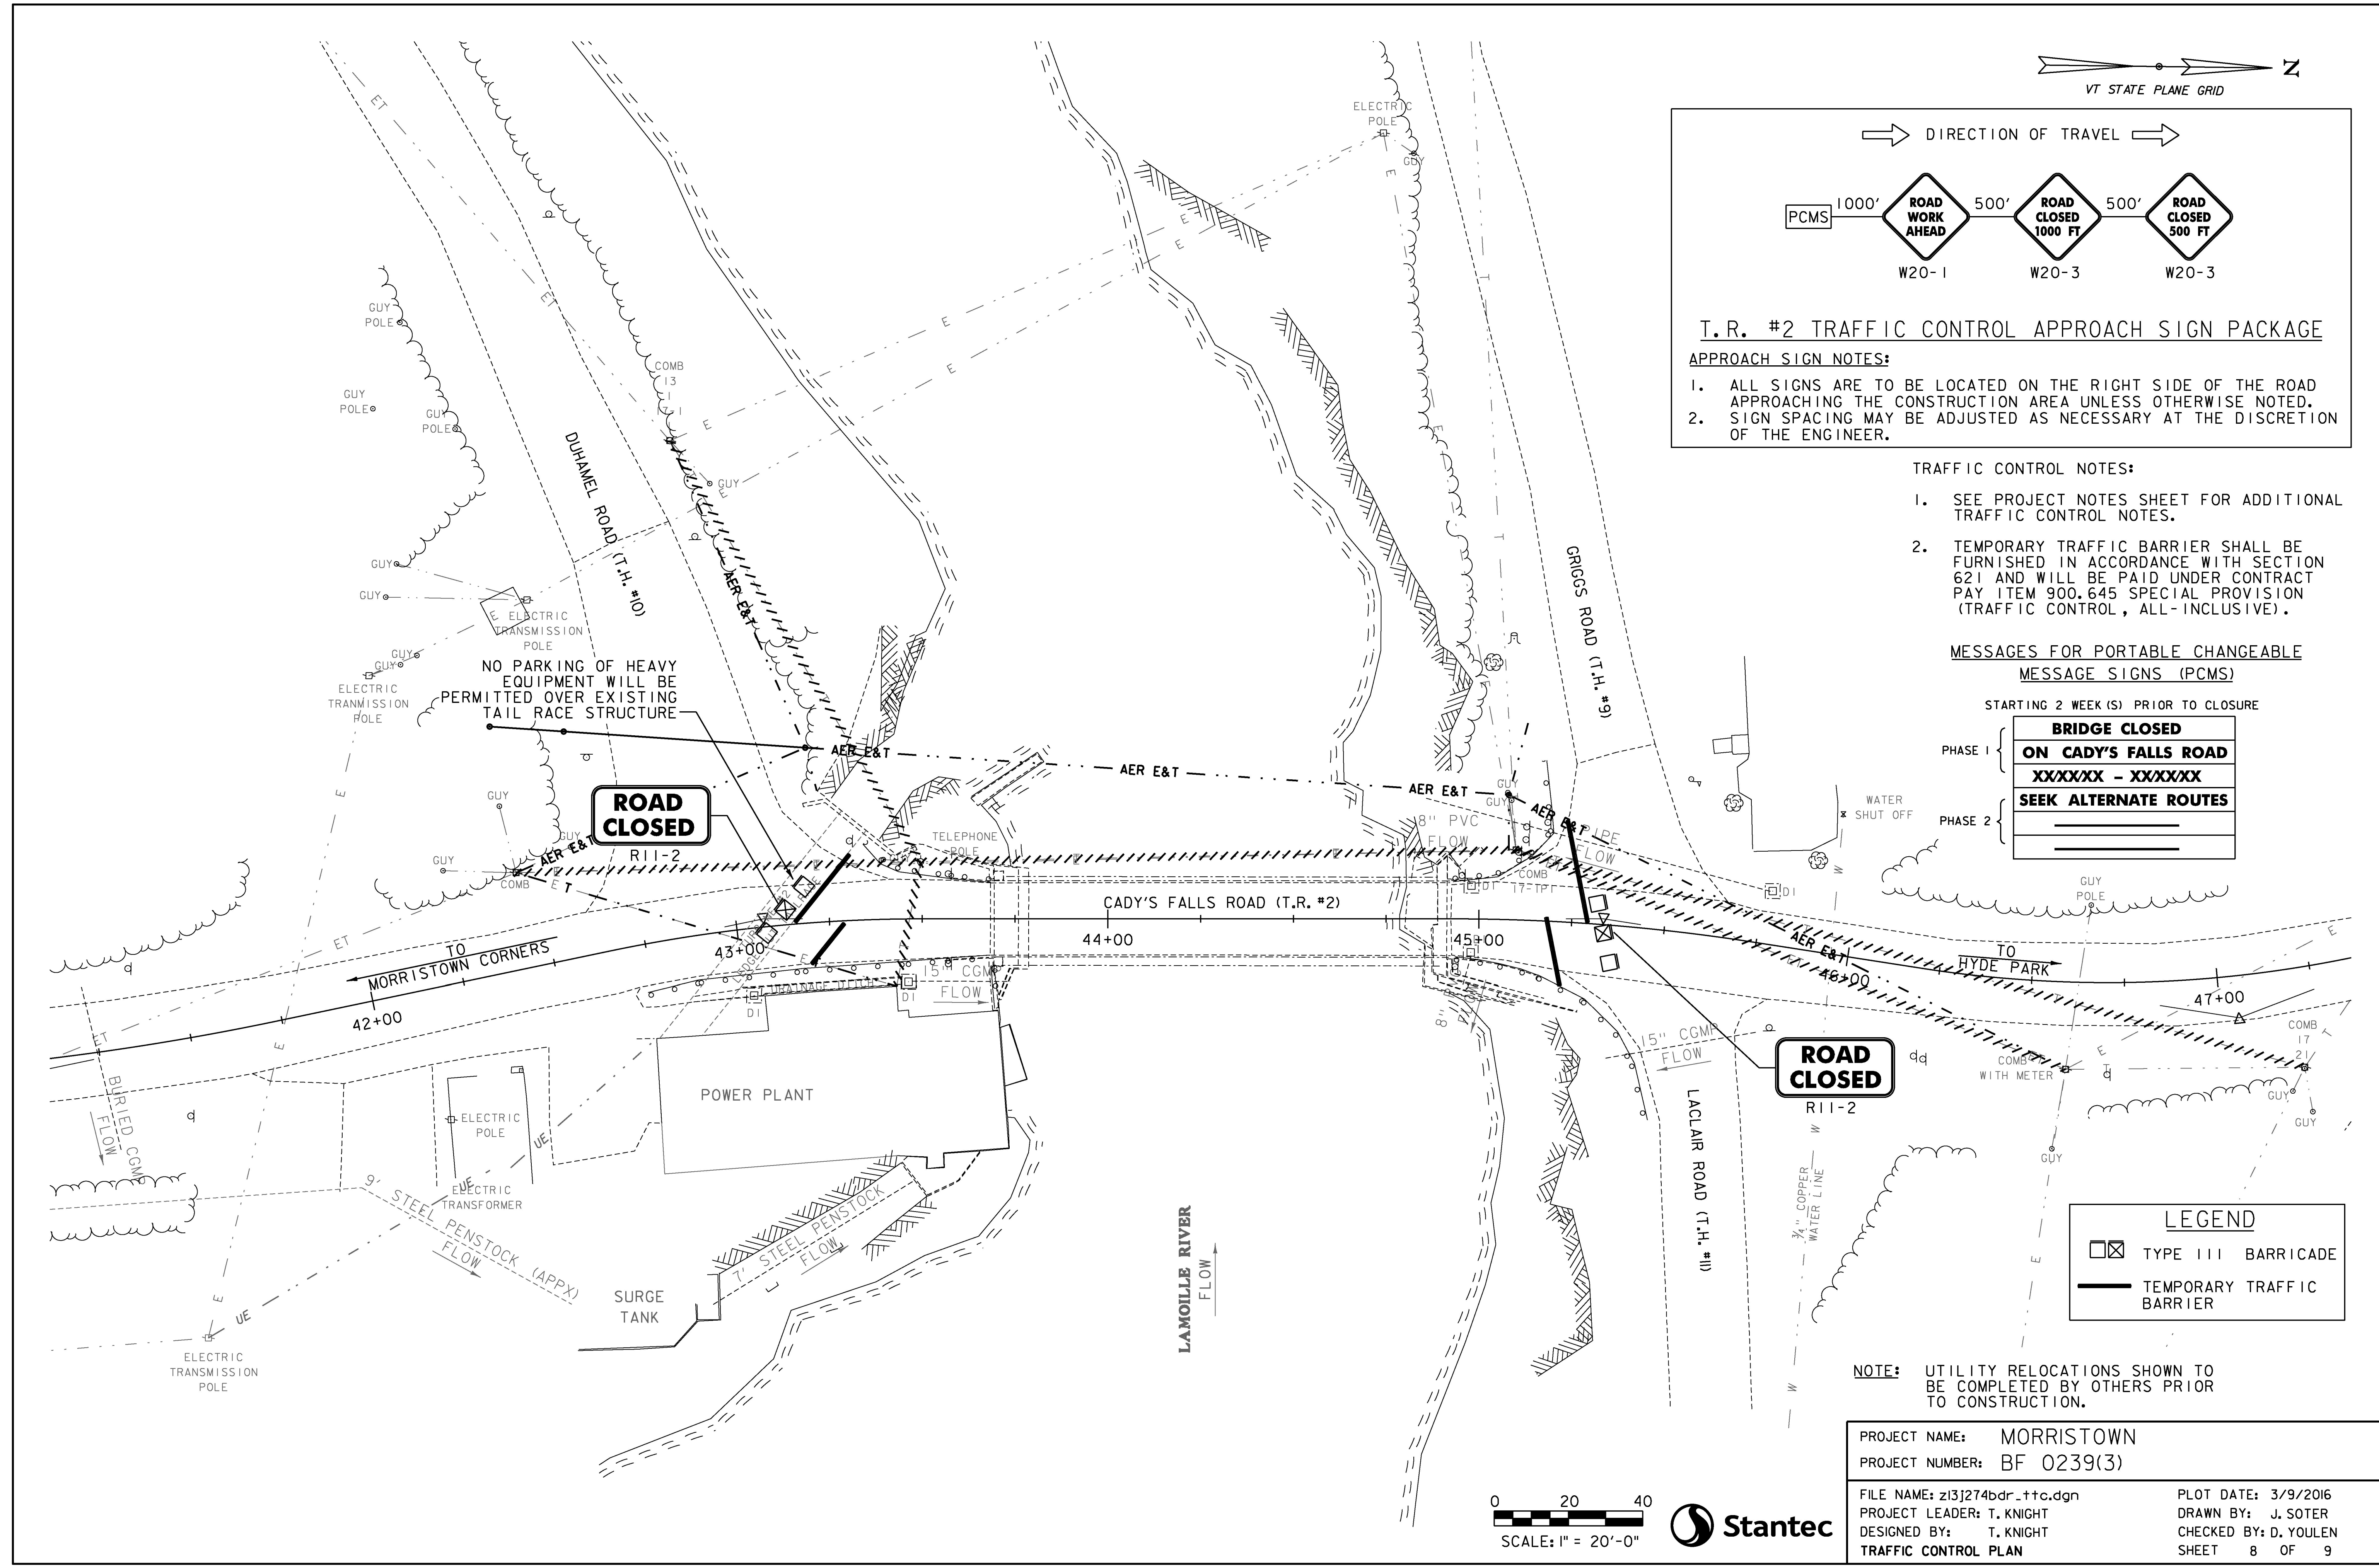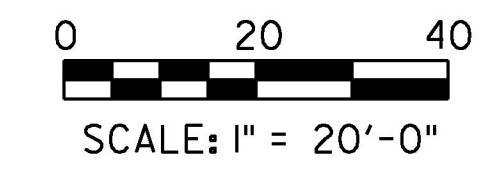

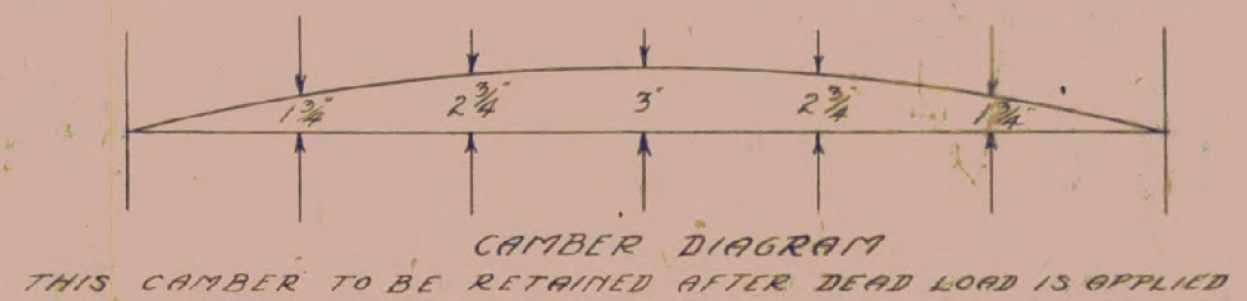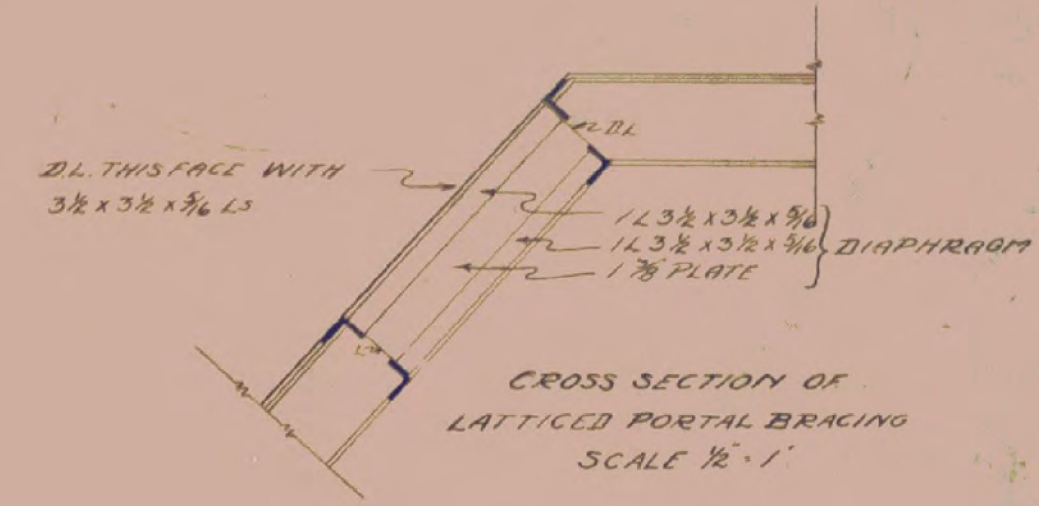



STRINGERS	
MOMENT	SHEAR
DL - 388,000 IN LBS	6,800
LL - 817,000 IN LBS	15,700
TOTAL - 1,205,000 IN LBS	22,500

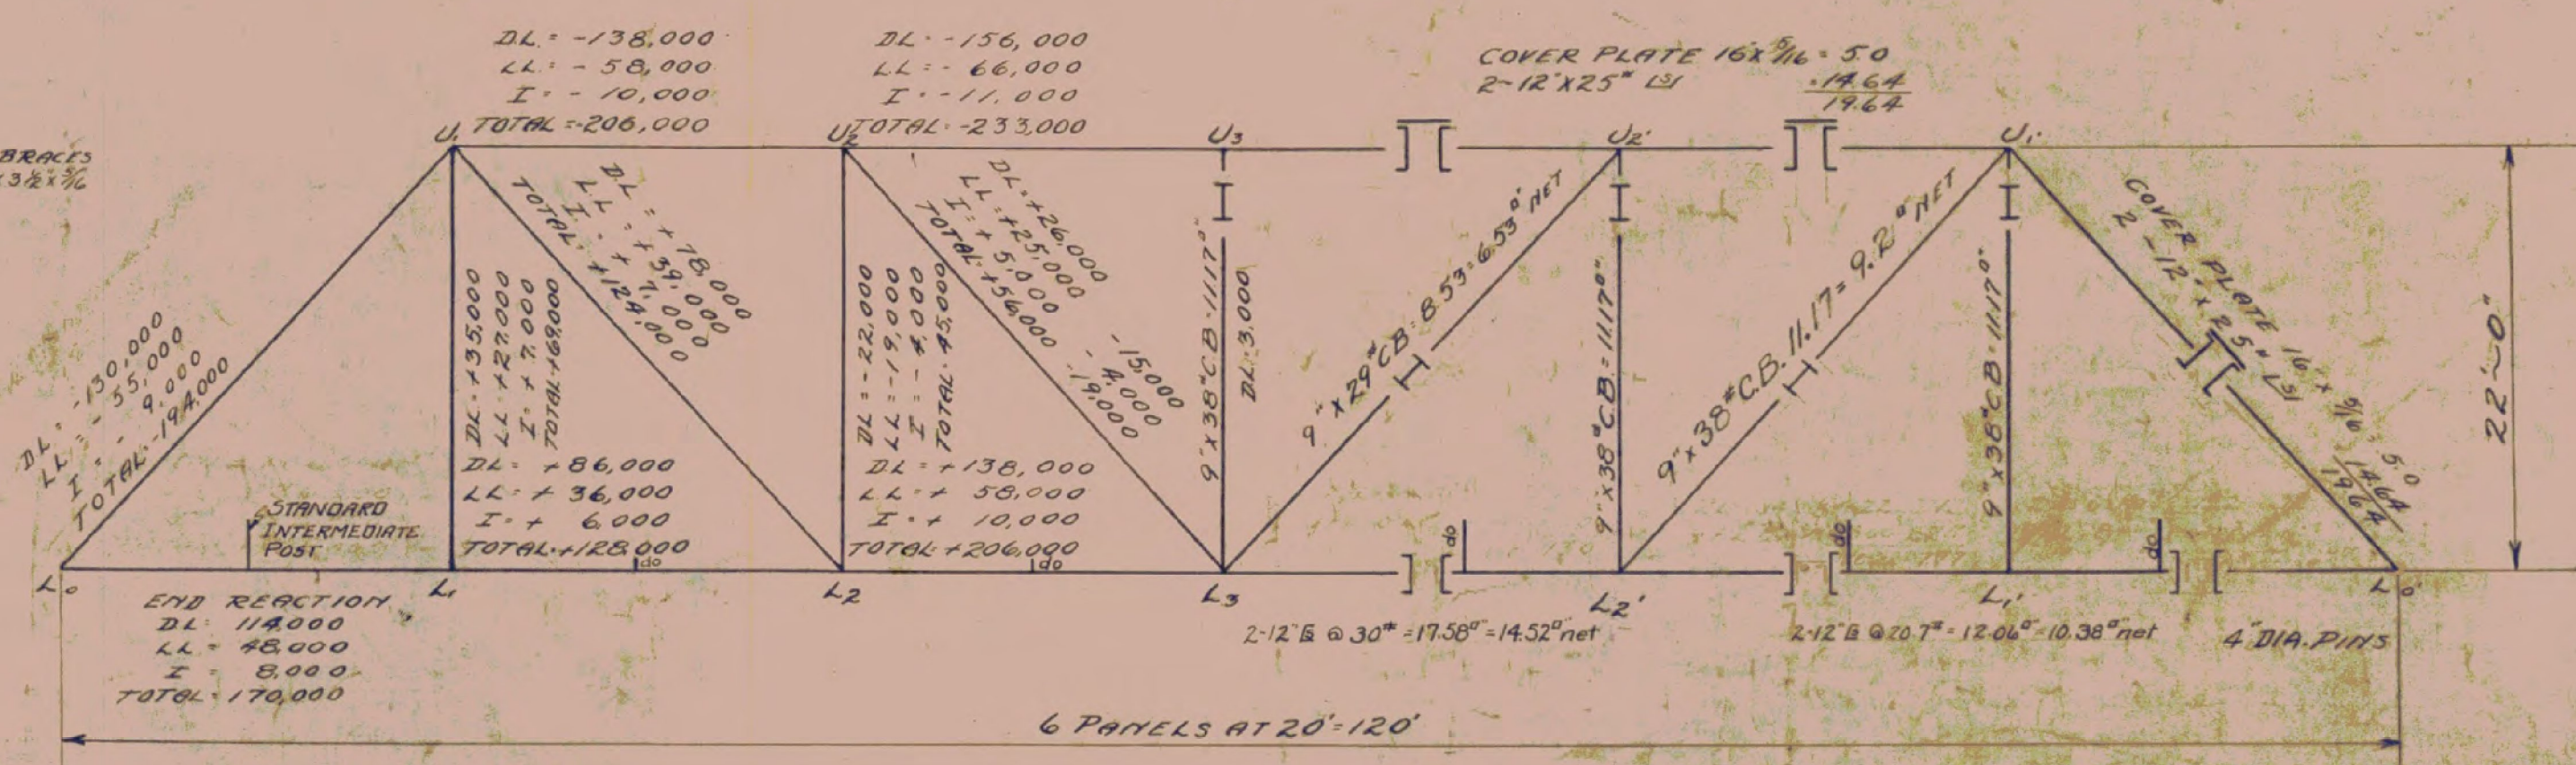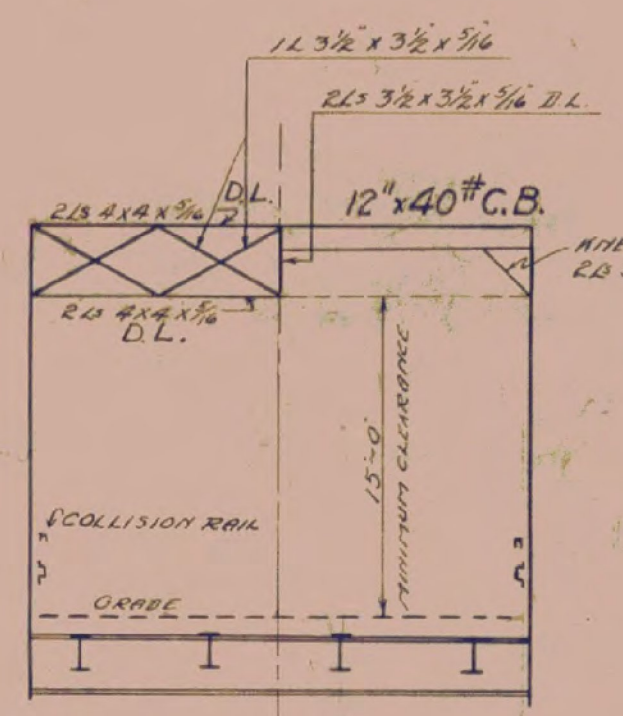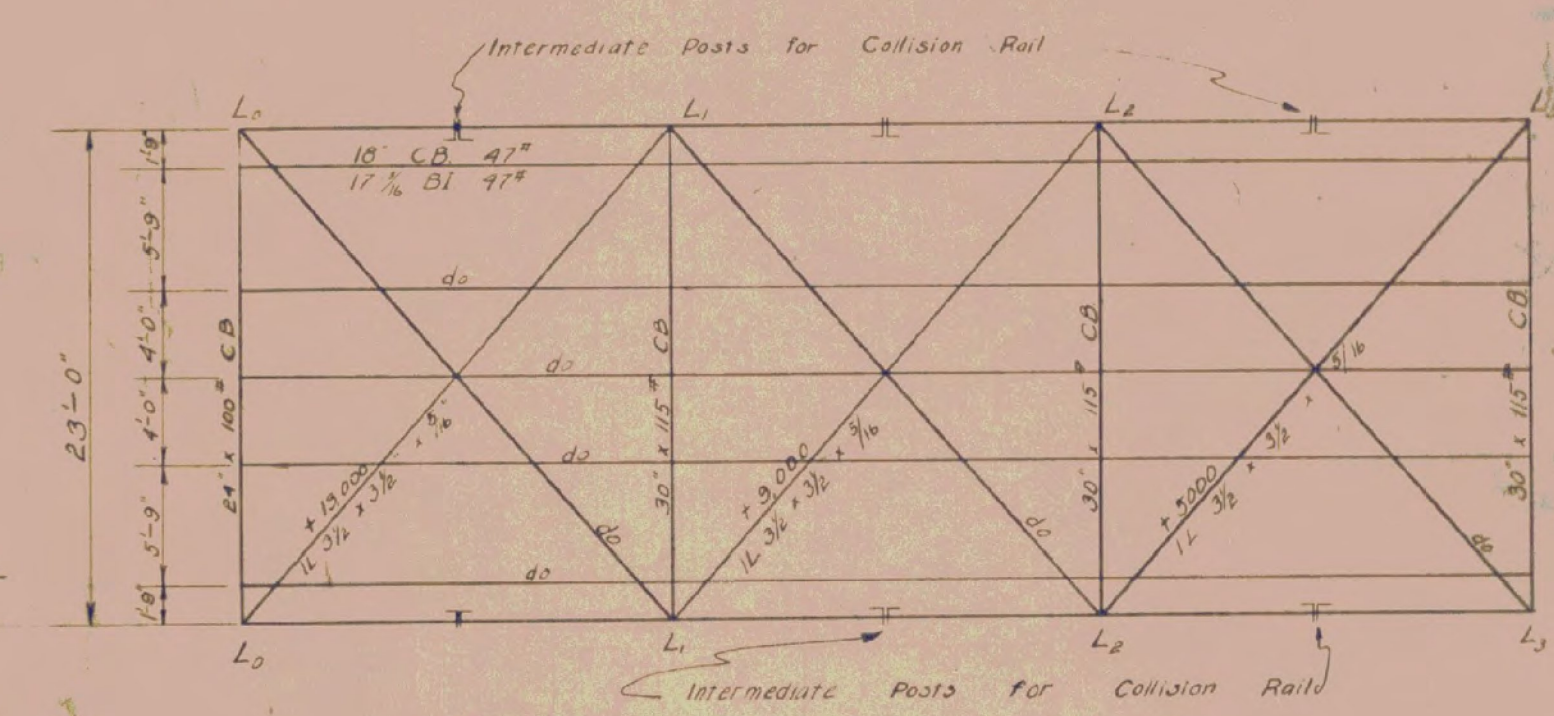

STRINGERS	
MOMENT	SHEAR
DL - 400,000 IN LBS	8,000
LL - 918,000 IN LBS	16,000
TOTAL - 1,318,000 IN LBS	24,000

FLOOR BEAMS	
MOMENT	SHEAR
DL - 2148,000 IN LBS	32,000
LL - 2114,000 IN LBS	27,000
TOTAL - 4,262,000 IN LBS	59,000

END FLOOR BEAM	
MOMENT	SHEAR
DL - 1074,000 IN LBS	16,000
LL - 817,000 IN LBS	15,700
TOTAL - 1,891,000 IN LBS	31,700

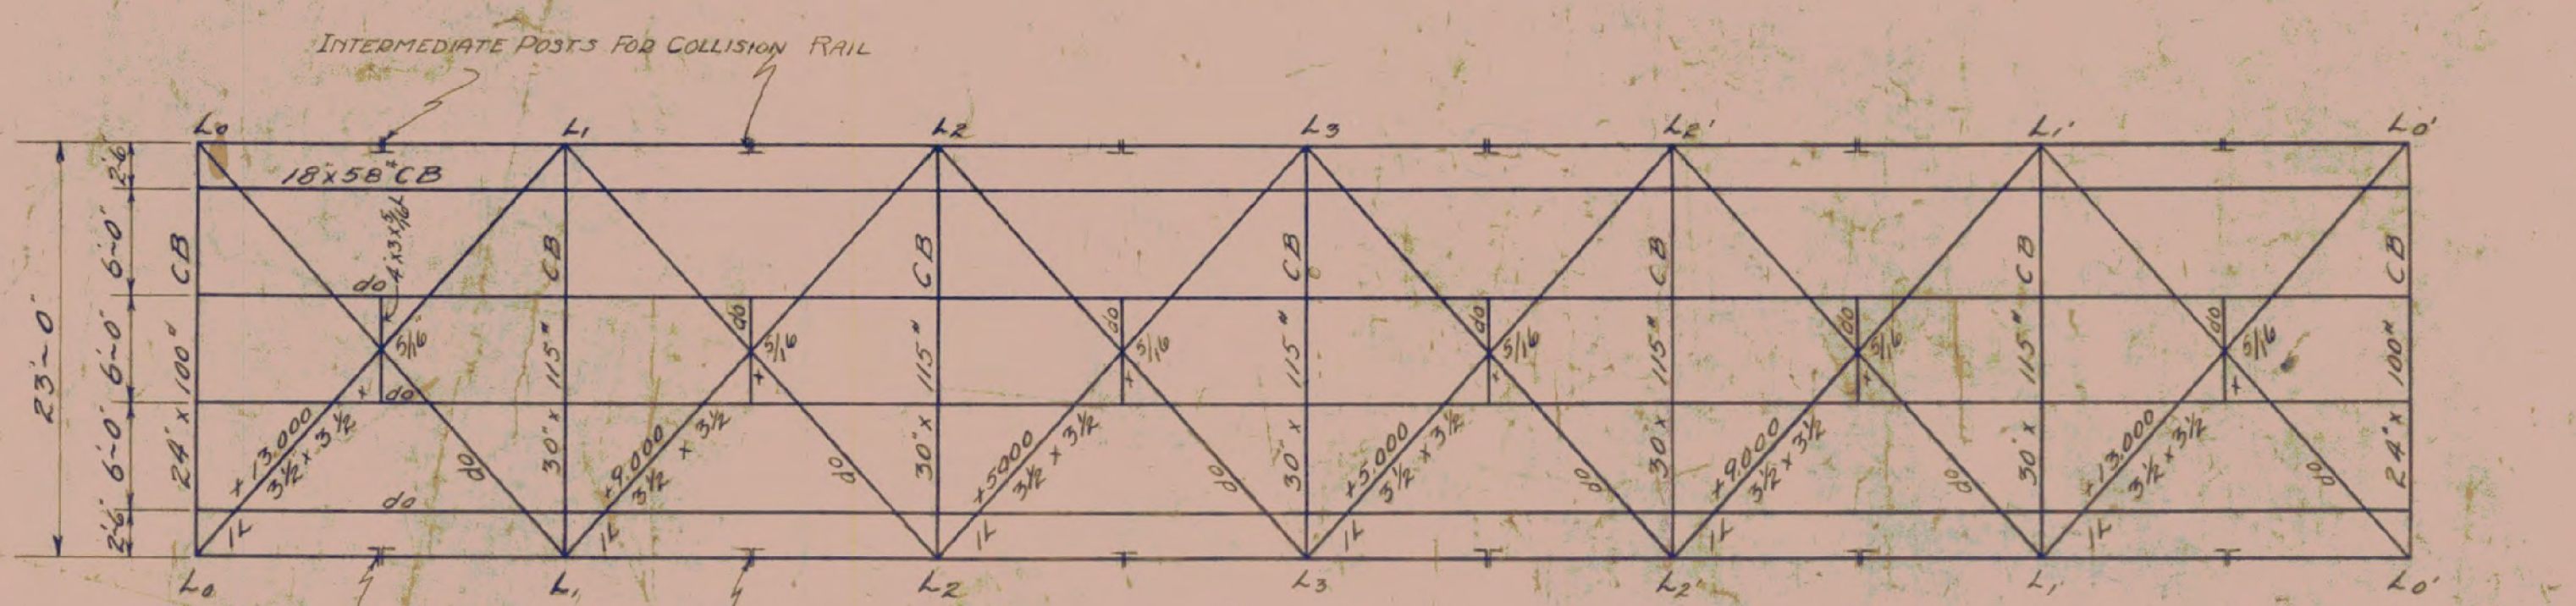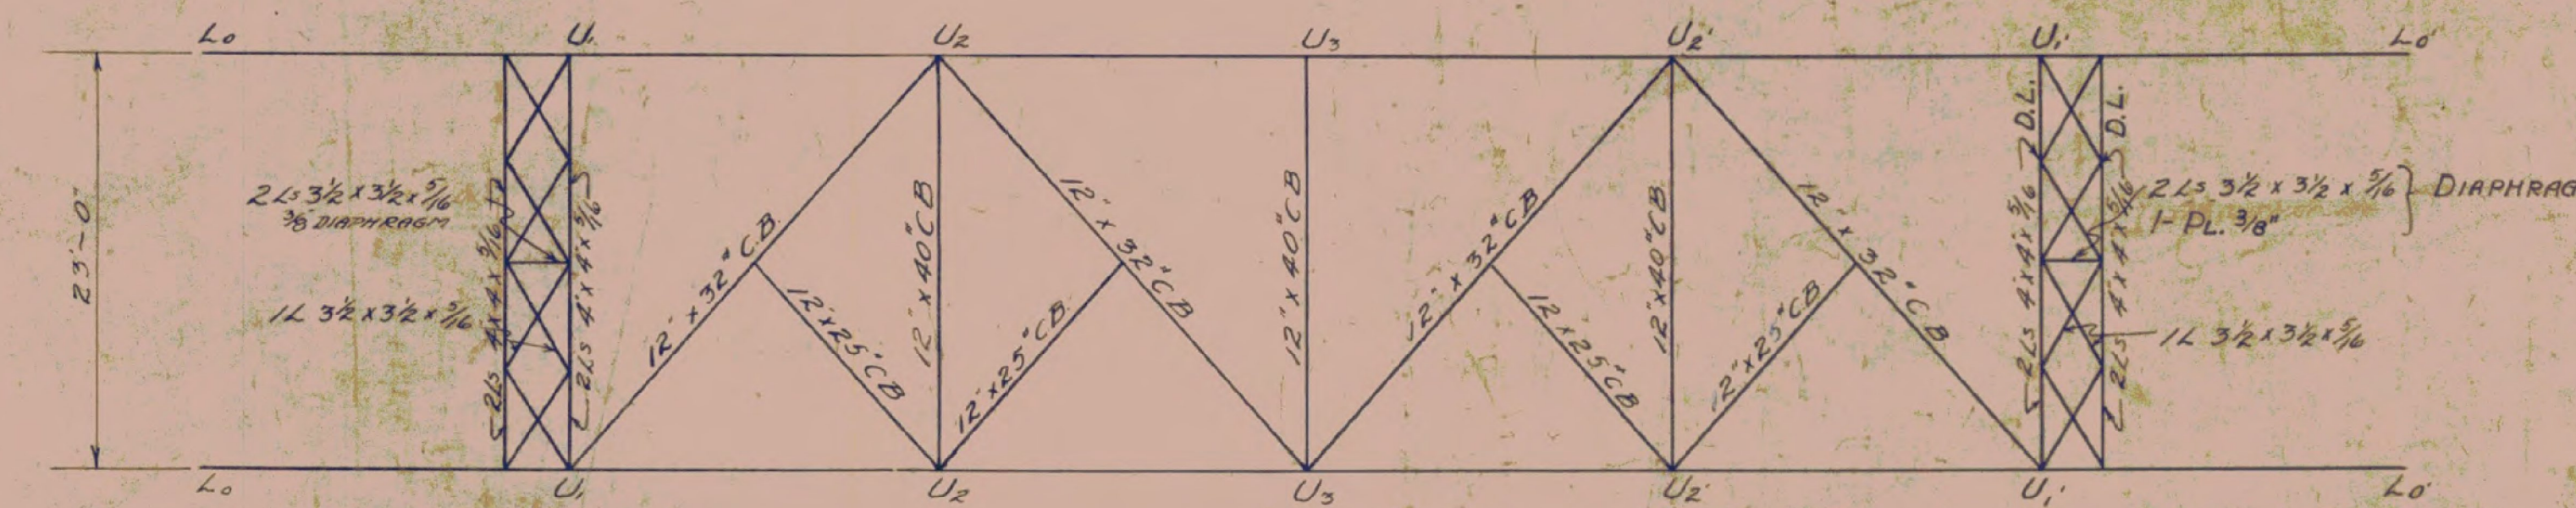

To be used when base is poured full width  
NOTE: SUPPORT LATERAL BRACINGS FROM 431780 CONNECTED TO STRINGER WEBS  
DO NOT CONNECT LATERAL BRACINGS TO BOTTOM FLANGE OF STRINGERS

NOTES

FLOOR DESIGNED FOR DEAD LOAD - 8" CONCRETE SLAB + 2.5" PAVING ALLOWANCE - HEIGHT OF STEEL  
LIVE LOAD - ROADWAY - 215 TON TRUCKS  
14'-0" HALLS - 6'-0" WHEELS  
B50% OF LOAD ON REAR AXLE  
IMPACT - STRINGERS AS 30% FLOOR BEAMS - 25% END FLOOR BEAMS - 35%  
TRUSS DESIGNED FOR DEAD LOAD - CONCRETE FLOOR AND PAVING  
1350' STEEL 550' 1900' PER LIFT  
LIVE LOAD - TWO LANES - HIS AASHTO SPEC 1922  
IMPACT - LL 250  
101,500 WHERE APPROPRIATE LOADED LENGTH  
GUSSET PLATE 3/8" AT L₀ - 3/8" ELSEWHERE  
RIVETS - 3/8" DIA  
SPECIFICATIONS  
STANDARD SPECIFICATIONS FOR STEEL HIGHWAY BRIDGES - U.S.D.A. BULLETIN NO. 1237 - SHALL APPLY TO ALL WORKMANSHIP AND DETAILS AS REFERRED TO IN U.S. STANDARD ROAD AND BRIDGE SPECIFICATIONS  
REFERENCES  
FOR THIS BRIDGE USE THE FOLLOWING STANDARD DETAILS AND TYPES SHOWN ON SHEET SB 1 - STANDARD DETAILS 1705, S-2, S-5, S-6, S-10, S-12, S-13, S-15, S-21  
WHEN BRIDGE CONSISTS OF MORE THAN ONE SPAN USE STANDARD DETAIL S11 AT PIERS

*The original of this sheet is in Bridge Div. File No. 47*

MORRISTOWN  
BF 0239(3)  
SHEET 9 OF 9  
FOR REFERENCE ONLY

STEEL SUPERSTRUCTURE  
120' W BEARING  
20' ROADWAY

Correct  
A.B.R. - shop  
Bridge Engineer


2 - H 15

ESTIMATED QUANTITIES FOR ONE SPAN


THIS SHEET USED FOR -	THIS SHEET USED FOR -	ESTIMATED QUANTITIES FOR ONE SPAN
NO. 2	NO. 1	STRUCTURAL STEEL (NO. 1) 133,500 LBS
		CLASS 1 - 1.8" CONCRETE 73 CU YDS
		REINFORCING STEEL NO. 1 12,100 LBS
		STRUCTURAL STEEL (NO. 2) 404,600 LBS
		Reinforcing Steel (No 2) 13,120 LBS

Surveyed by	
Designed by	SHOEMAKER
Drawn by	KBW
Traced by	KBW
Checked by	M. J. U. [Signature]
Series	SB 20 No. 120
Sheet	9


"W" BEAM GUARDRAIL WITH STEEL POSTS

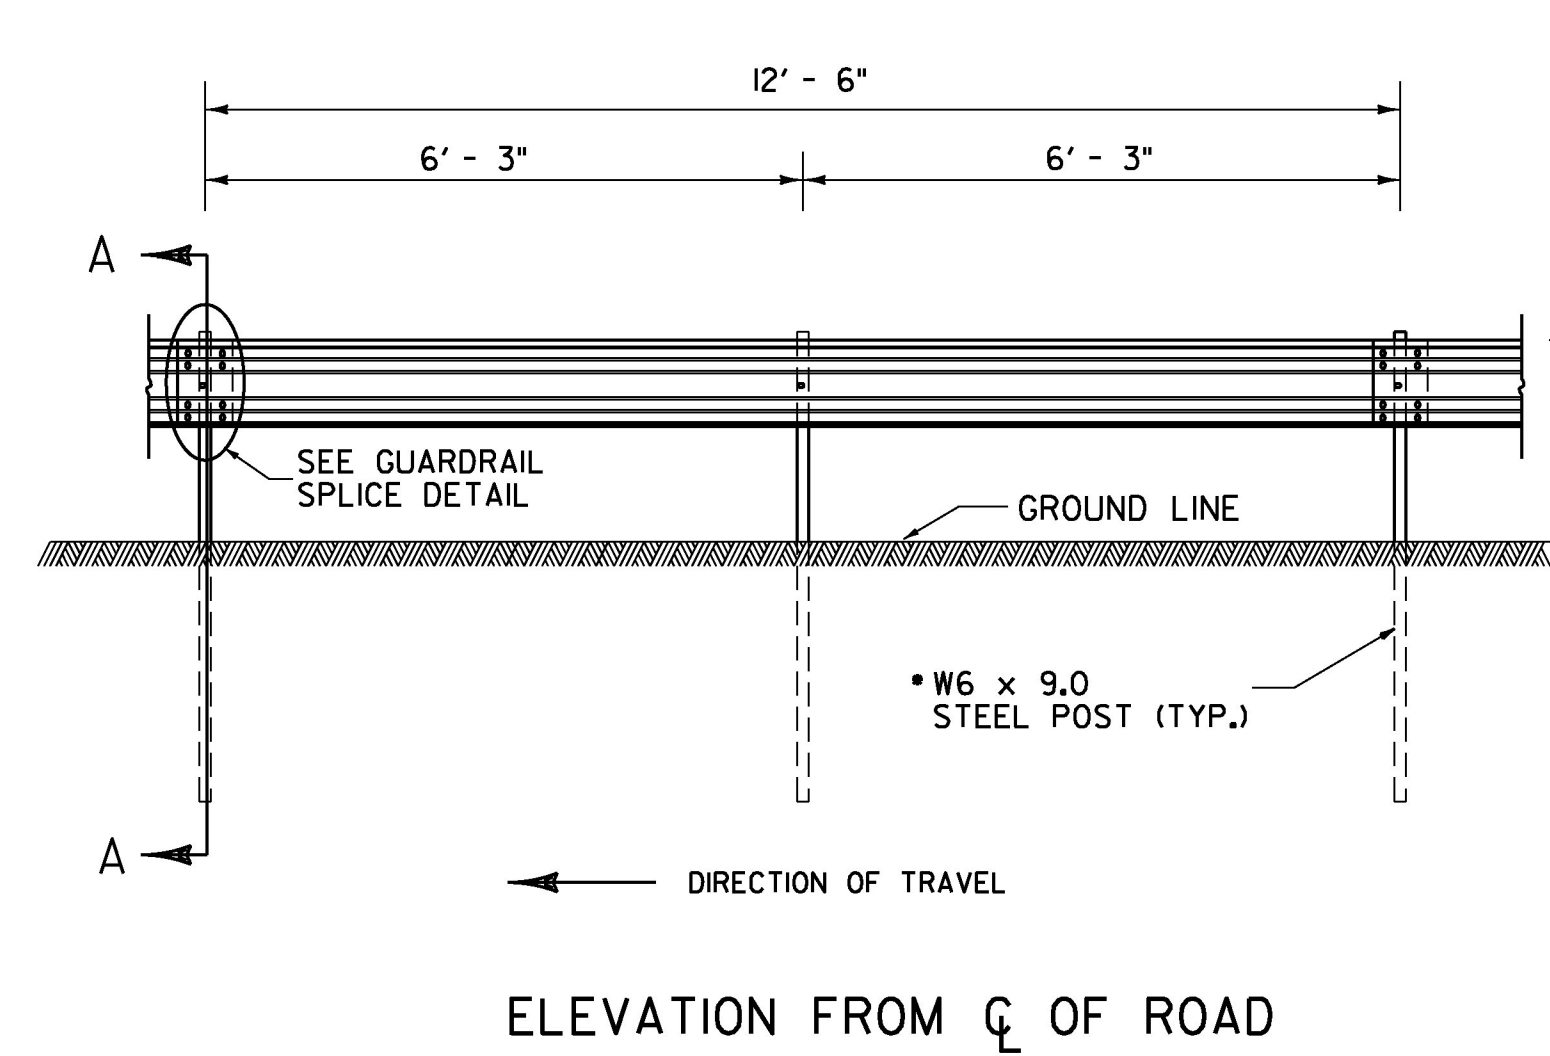


ELEVATION FROM CL OF ROAD

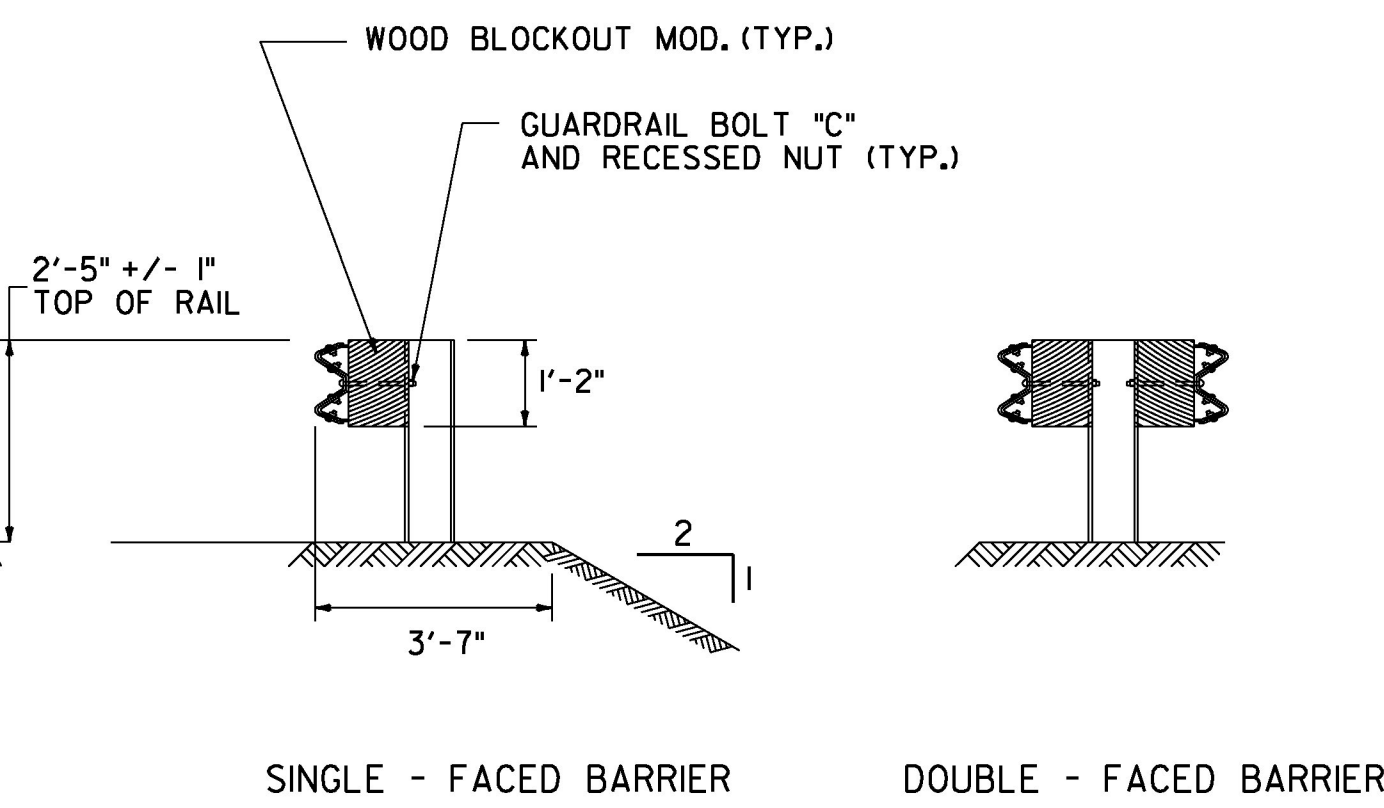

SECTION A - A

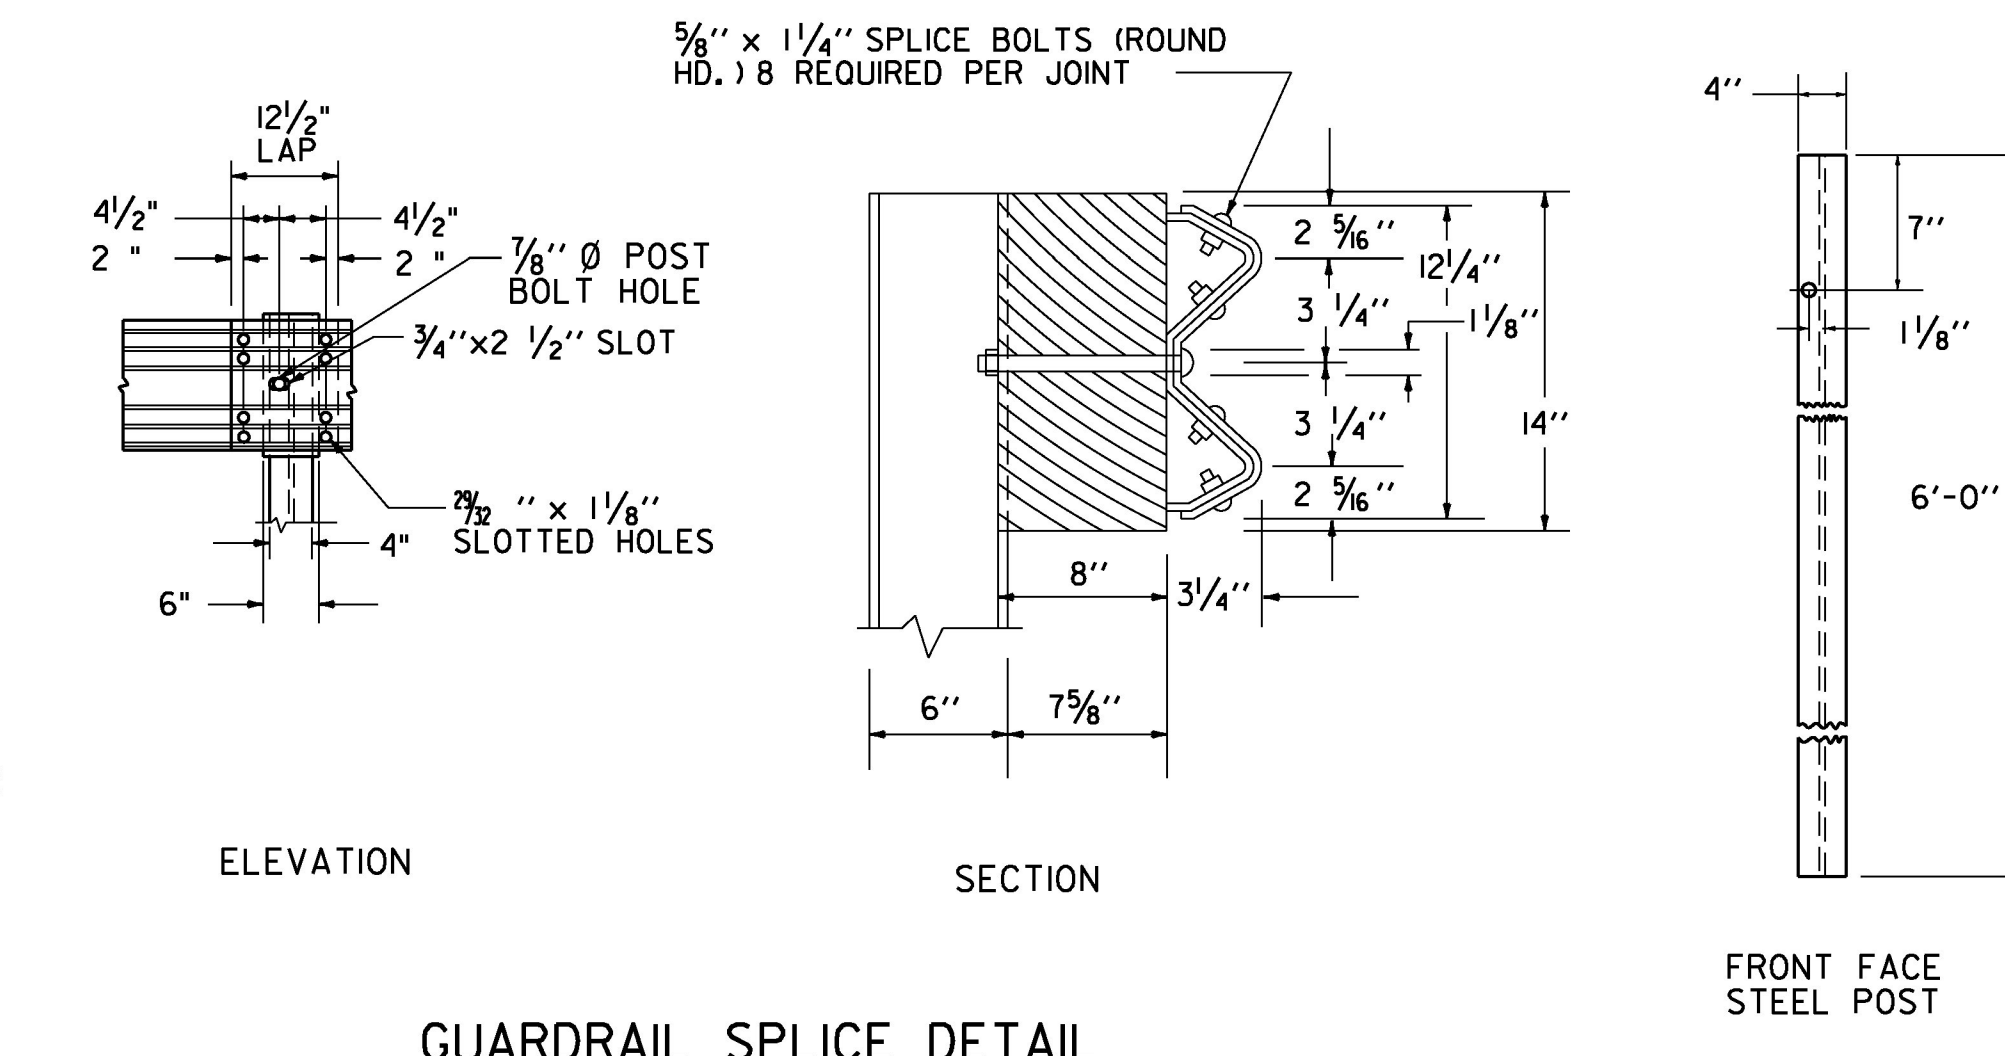


GUARDRAIL SPLICE DETAIL

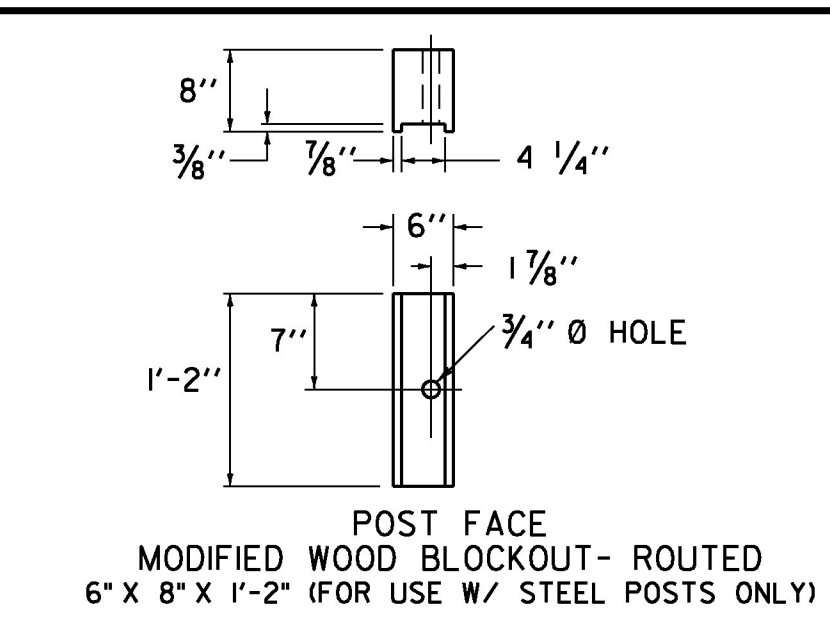


POST FACE MODIFIED WOOD BLOCKOUT- ROUTED 6" X 8" X 1'-2" (FOR USE W/ STEEL POSTS ONLY)

- NOTES:
- BLOCKS SHALL BE MADE OF TIMBER WITH A STRESS GRADE OF 1200 PSI OR MORE. TESTING SHALL BE IN ACCORDANCE WITH WEST COAST LUMBER INSPECTION BUREAU, SOUTHERN PINE INSPECTION BUREAU OR OTHER APPROPRIATE ASSOCIATION. TIMBER FOR BLOCKS SHALL BE ROUGH SAWN (UNPLANED) WITH DIMENSIONS INDICATED. THE SIZE TOLERANCE OF ROUGH SAWN BLOCKS IN THE DIRECTION OF THE BOLT HOLES SHALL BE NOT MORE THAN +/- 1/4".
  - SUPPLY WOOD BLOCKS PER AASHTO M 168.
  - TREAT WITH PRESERVATIVE PER AASHTO M 133.
  - BLOCKOUTS MAY ALSO BE MADE OF APPROVED ALTERNATIVE MATERIAL.


"W" BEAM GUARDRAIL WITH WOOD POSTS

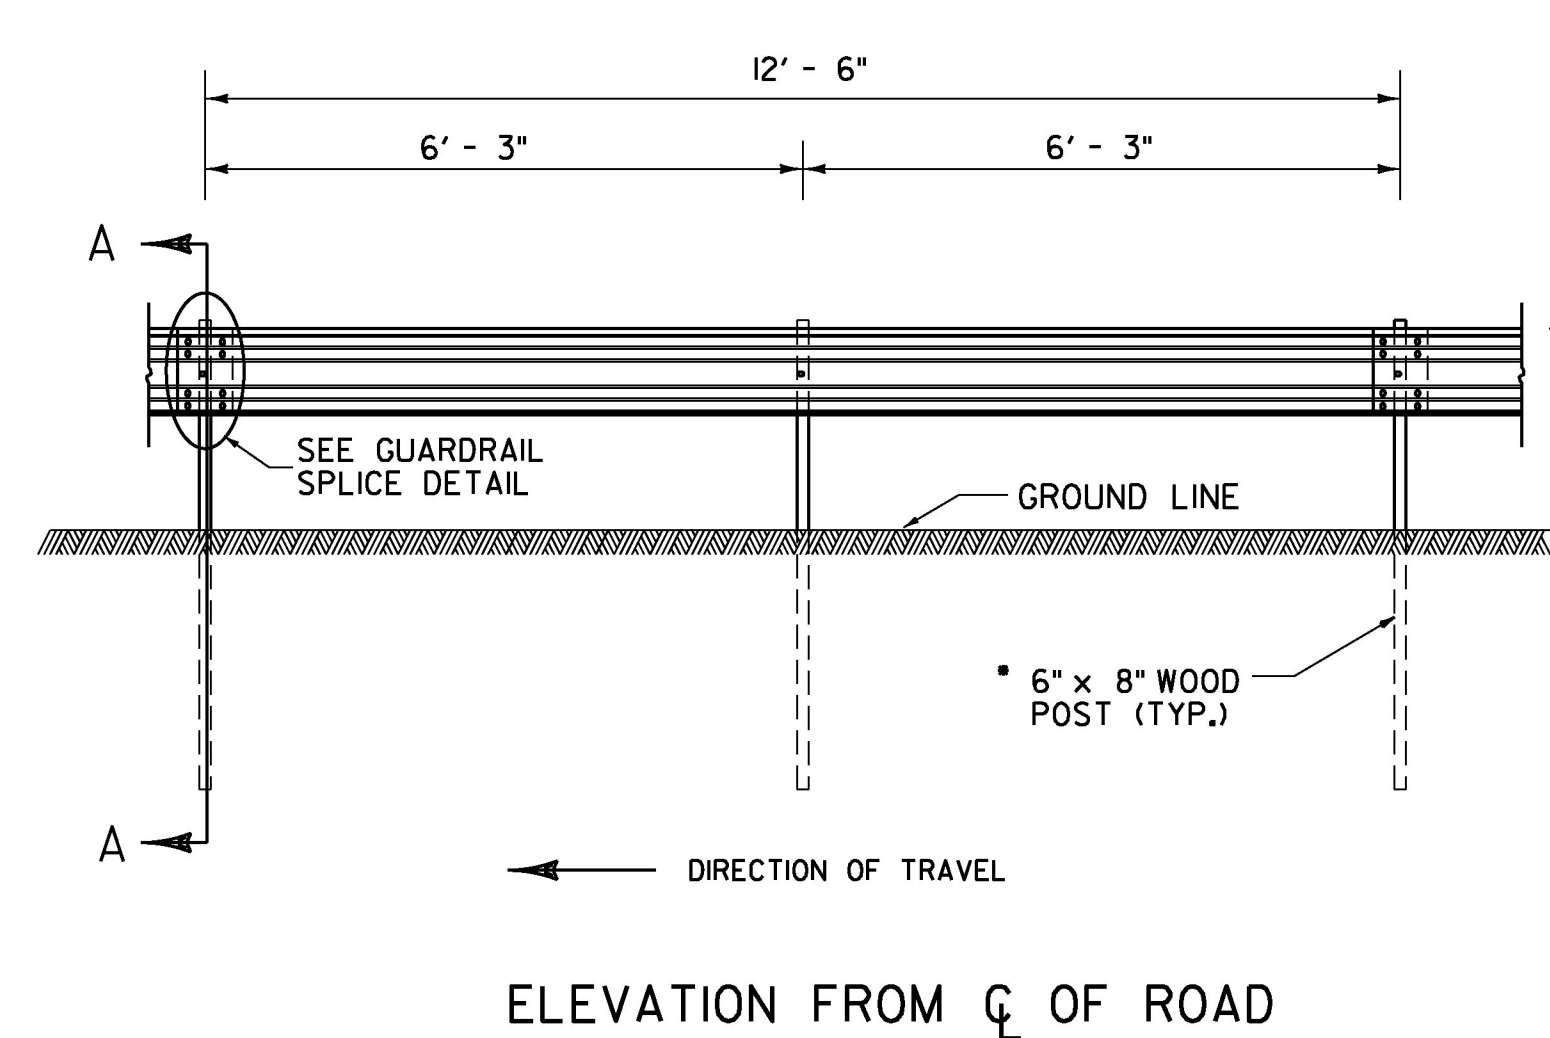


ELEVATION FROM CL OF ROAD

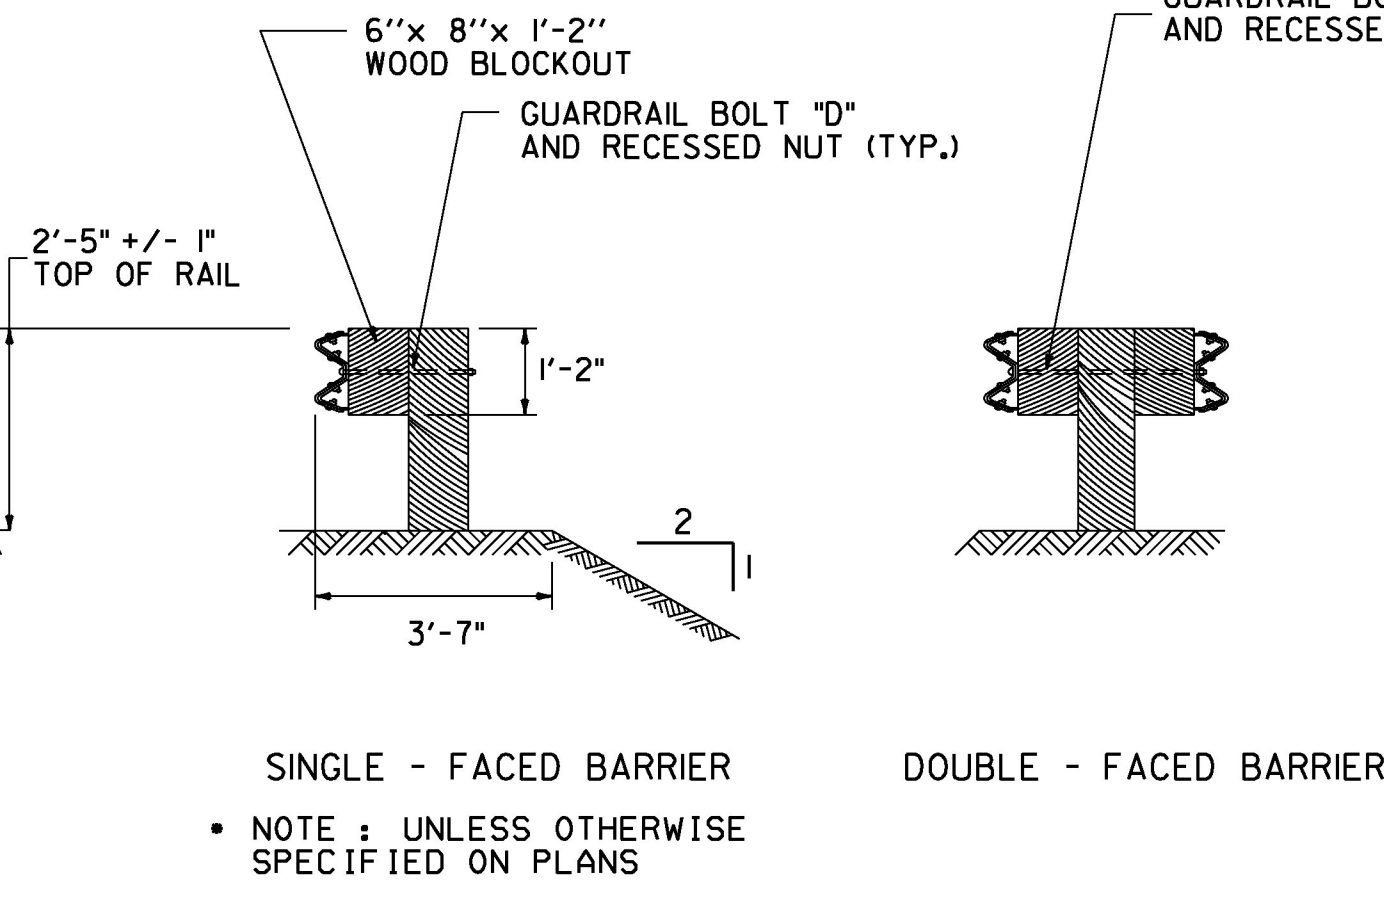

SECTION A - A

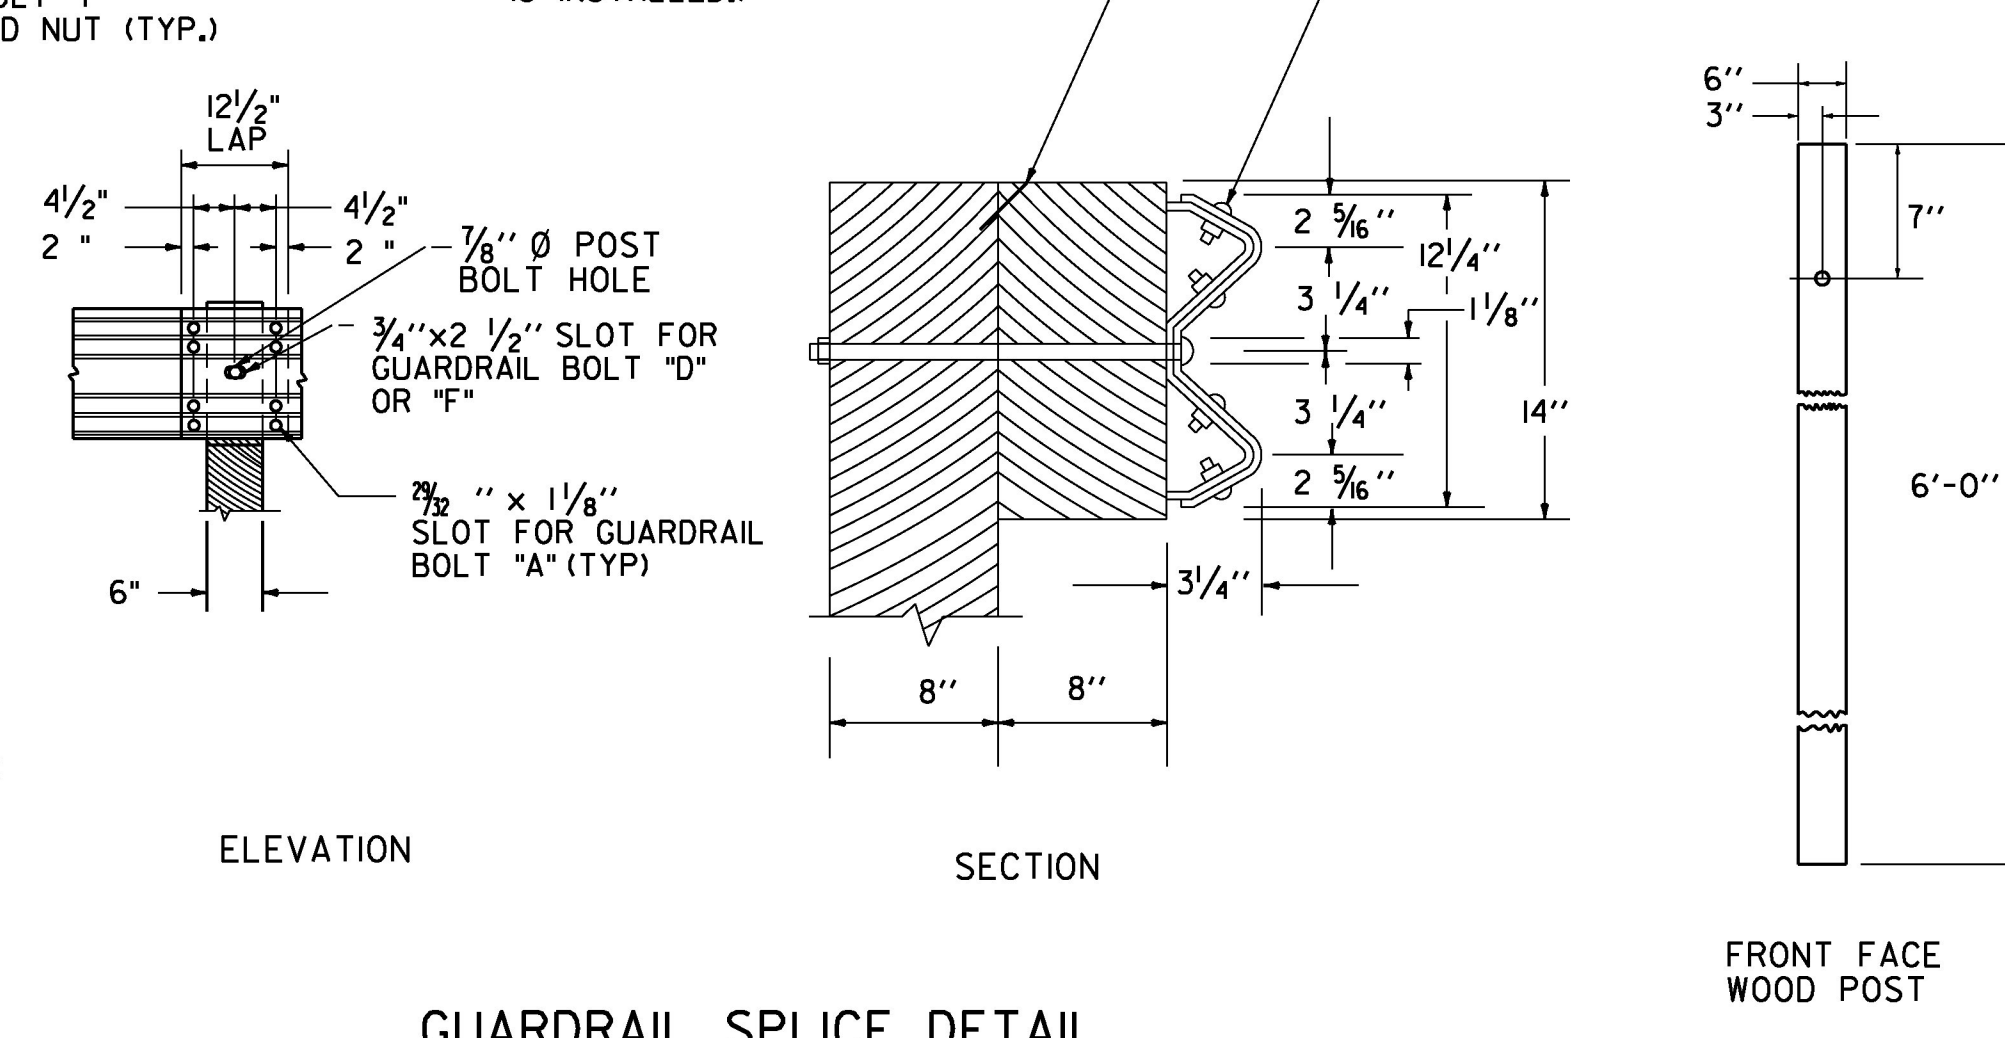


GUARDRAIL SPLICE DETAIL

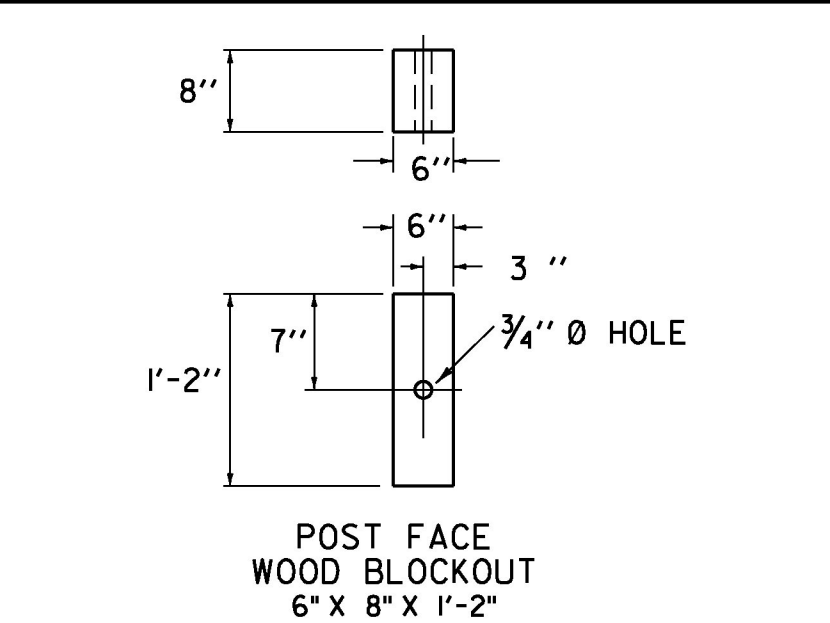

POST FACE WOOD BLOCKOUT 6" X 8" X 1'-2"


- NOTES:
- BLOCKS SHALL BE MADE OF TIMBER WITH A STRESS GRADE OF 1200 PSI OR MORE. TESTING SHALL BE IN ACCORDANCE WITH WEST COAST LUMBER INSPECTION BUREAU, SOUTHERN PINE INSPECTION BUREAU OR OTHER APPROPRIATE ASSOCIATION. TIMBER FOR BLOCKS SHALL BE ROUGH SAWN (UNPLANED) WITH DIMENSIONS INDICATED. THE SIZE TOLERANCE OF ROUGH SAWN BLOCKS IN THE DIRECTION OF THE BOLT HOLES SHALL BE NOT MORE THAN +/- 1/4".
  - SUPPLY WOOD BLOCKS PER AASHTO M 168.
  - TREAT WITH PRESERVATIVE PER AASHTO M 133.
  - BLOCKOUTS MAY ALSO BE MADE OF APPROVED ALTERNATIVE MATERIAL.

GUARDRAIL DELINEATOR

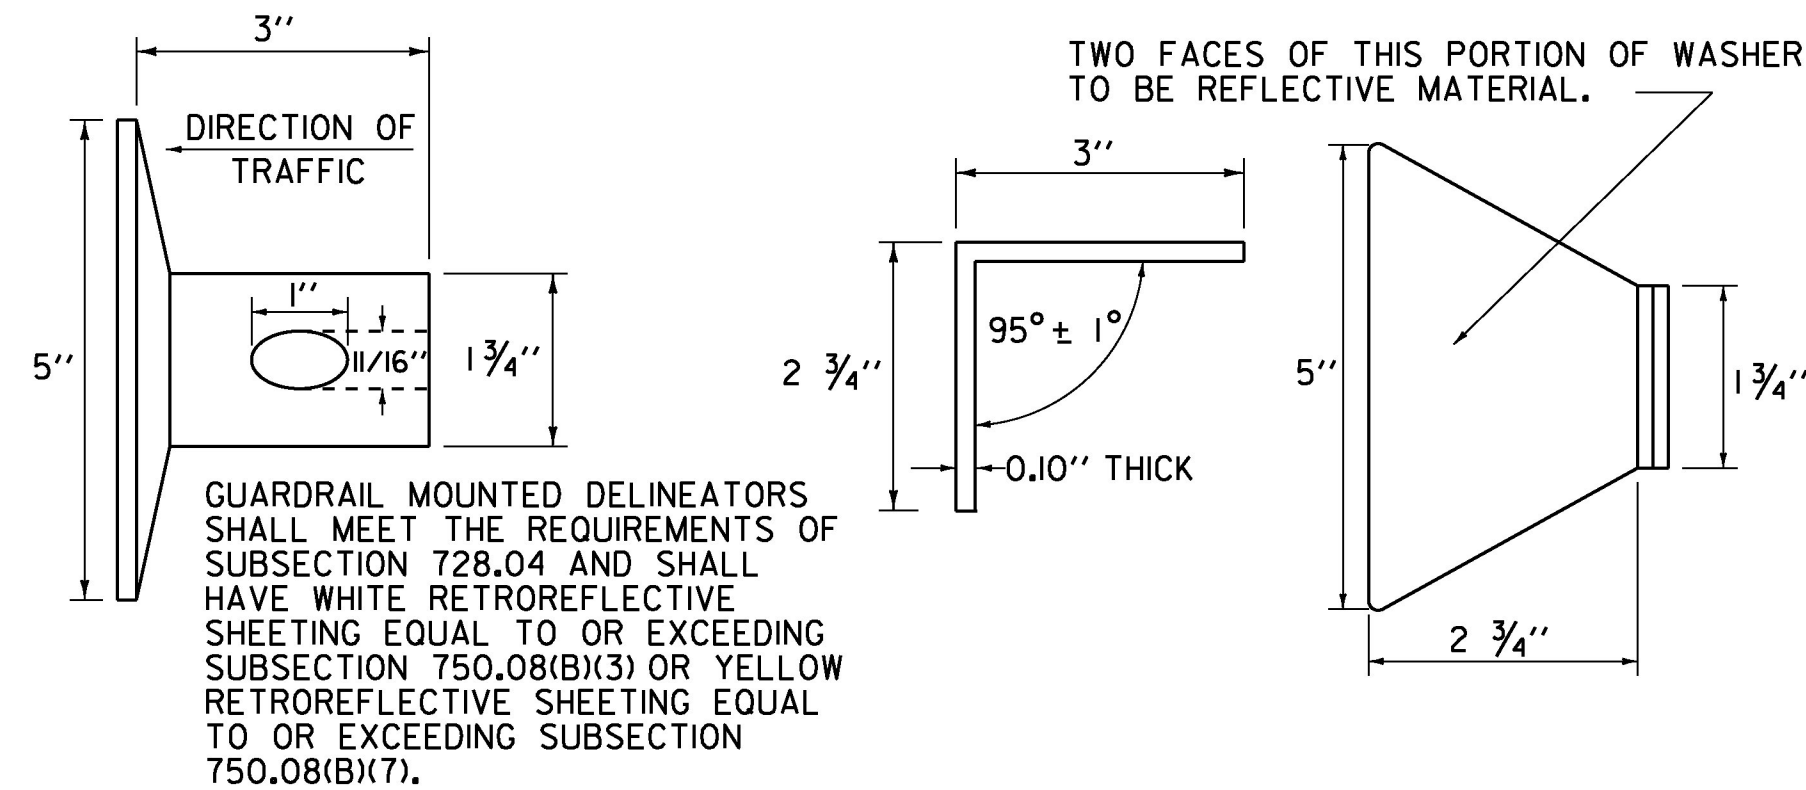


GUARDRAIL MOUNTED DELINEATORS SHALL MEET THE REQUIREMENTS OF SUBSECTION 728.04 AND SHALL HAVE WHITE RETROREFLECTIVE SHEETING EQUAL TO OR EXCEEDING SUBSECTION 750.08(B)(3) OR YELLOW RETROREFLECTIVE SHEETING EQUAL TO OR EXCEEDING SUBSECTION 750.08(B)(7).

THIS REFLECTORIZED ALUMINUM WASHER IS TO BE PLACED IN VALLEY OF BEAM WHEN MOUNTING BEAM ONTO EACH FIFTH POST. WASHER SHALL MEET SPECIFICATION REQUIREMENTS FOR A.S.T.M. B-209 ALLOY 5052-H32.

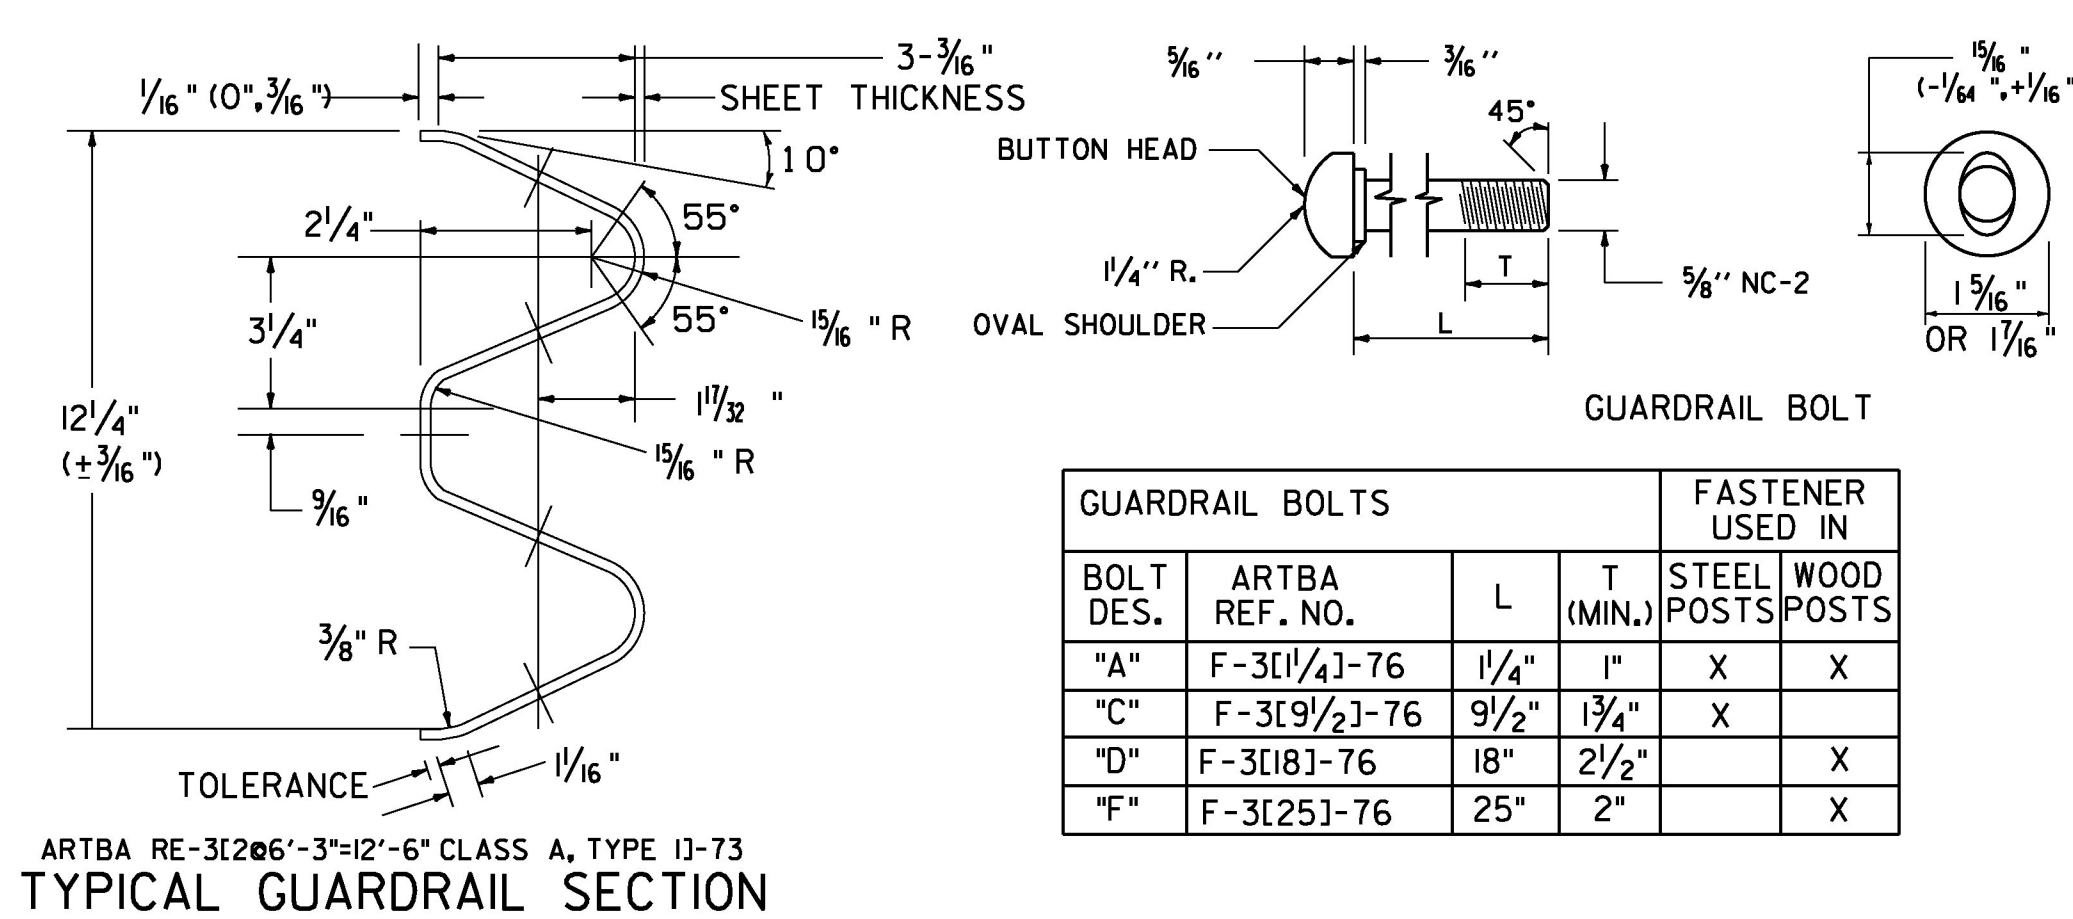

GUARDRAIL BOLTS		FASTENER USED IN	
BOLT DES.	ARTBA REF. NO.	L	T (MIN.)
"A"	F-3(11/4)-76	1 1/4"	1"
"C"	F-3(9/2)-76	9/2"	1 3/4"
"D"	F-3(181)-76	18"	2 1/2"
"F"	F-3(251)-76	25"	2"

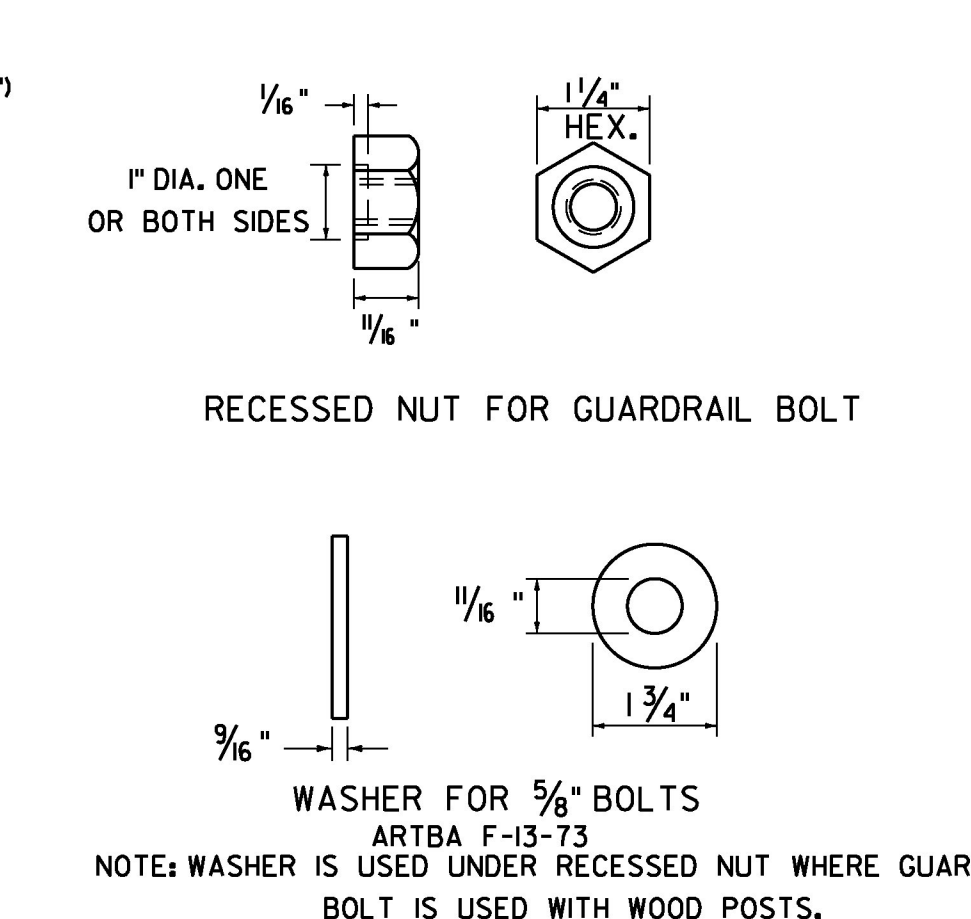


- GENERAL NOTES:
- GUARDRAIL SHALL MEET THE REQUIREMENTS OF AASHTO M 180, CLASS A, TYPE 1, UNLESS OTHERWISE DESIGNATED.
  - GUARDRAIL SHALL BE SINGLE FACED UNLESS OTHERWISE DESIGNATED.
  - GUARDRAIL SECTIONS SHALL BE LAPPED IN THE DIRECTION OF TRAFFIC FLOW FOR THE LANE NEAREST THE GUARDRAIL.
  - FOR DESCRIPTION AND SPECIFICATION OF PARTS IDENTIFIED BY (ARTBA ...) AND OTHER DETAILS OF BOLTS, POST ACCESSORIES, FASTENERS & RAIL ELEMENTS, SEE AASHTO-AGC-ARTBA JOINT TASK FORCE NO. 13, TITLED "A GUIDE TO STANDARDIZED HIGHWAY BARRIER HARDWARE", LATEST EDITION.
  - STANDARD STEEL BEAM TO BE 1/8" AND THE HEAVY DUTY TO BE 3/4" THICK.


REV.	DATE	DESCRIPTION
--	JAN. 3, 2000	UPDATED TO REFLECT METRIC STD. CHANGES
--	FEB. 10, 2014	UPDATED TO REFLECT GUARDRAIL HEIGHT OF 29"; FHWA LETTER (MAY 17, 2010)
--	NOV. 10, 2015	UPDATED DELINEATOR RETROREFLECTIVE SHEETING NOTES
OTHER STANDARDS REQUIRED: G-ID		
VTRANS AND FHWA APPROVAL ON FILE WITH CONTRACT ADMINISTRATION		

STEEL BEAM GUARDRAIL WITH STEEL POSTS  
STEEL BEAM GUARDRAIL WITH WOOD POSTS



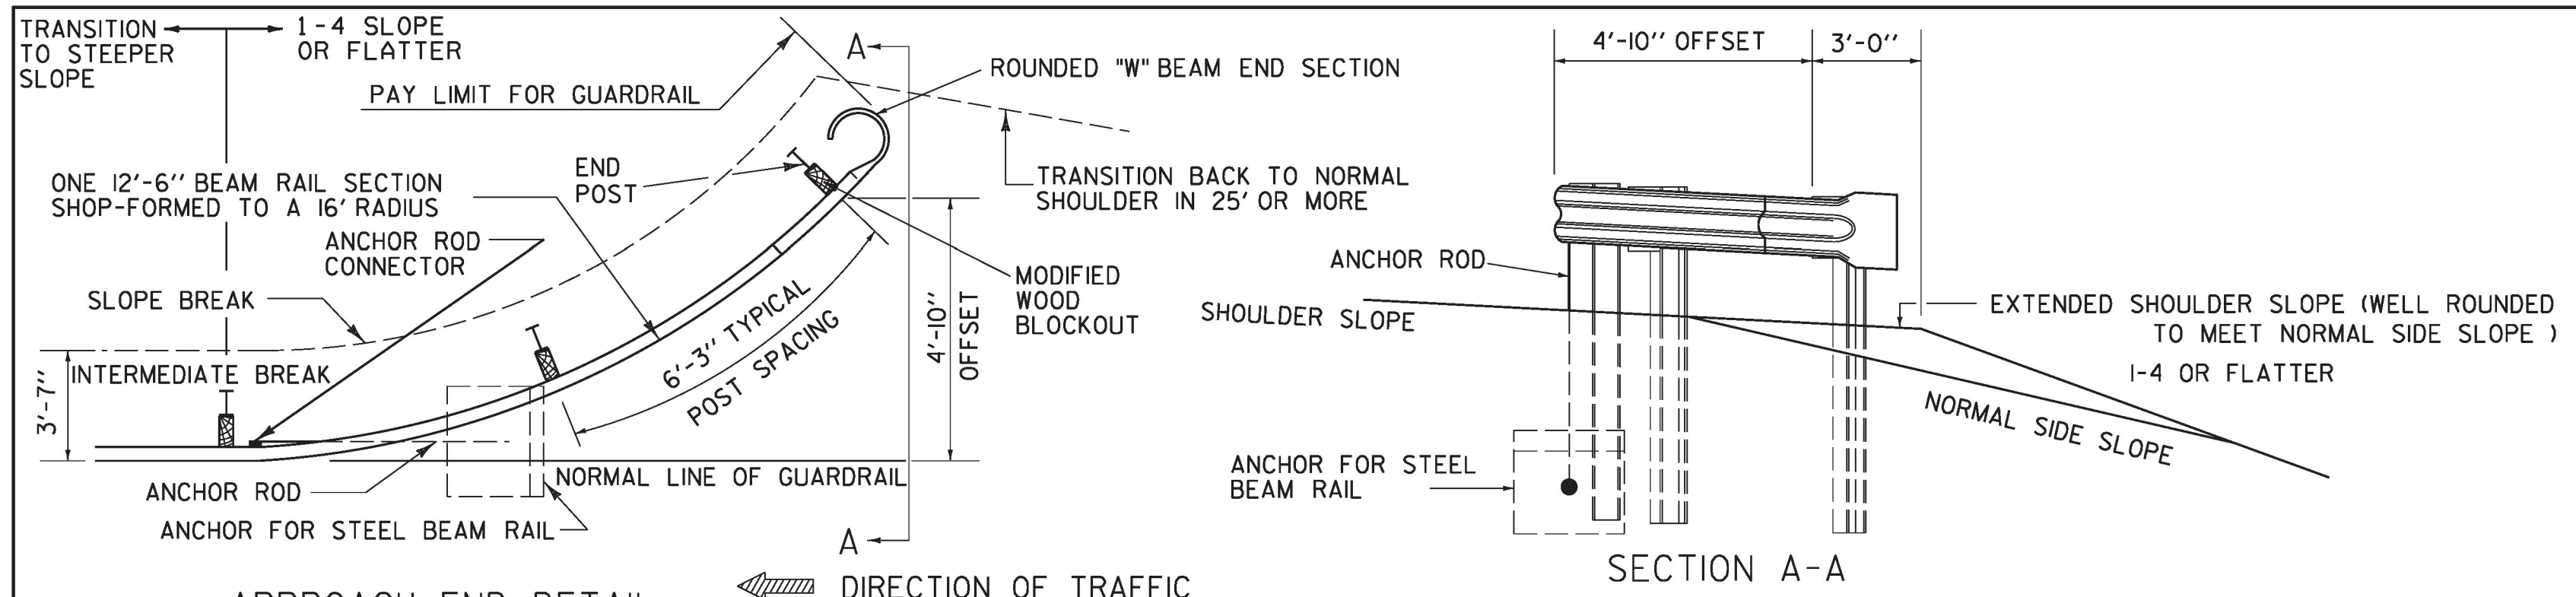

**APPROACH END DETAIL**  
 NHS APPROVED FOR USE WHERE DESIGN SPEED IS 40 OR LESS MPH  
 NON-NHS APPROVED FOR USE WHERE DESIGN SPEED IS 50 OR LESS MPH

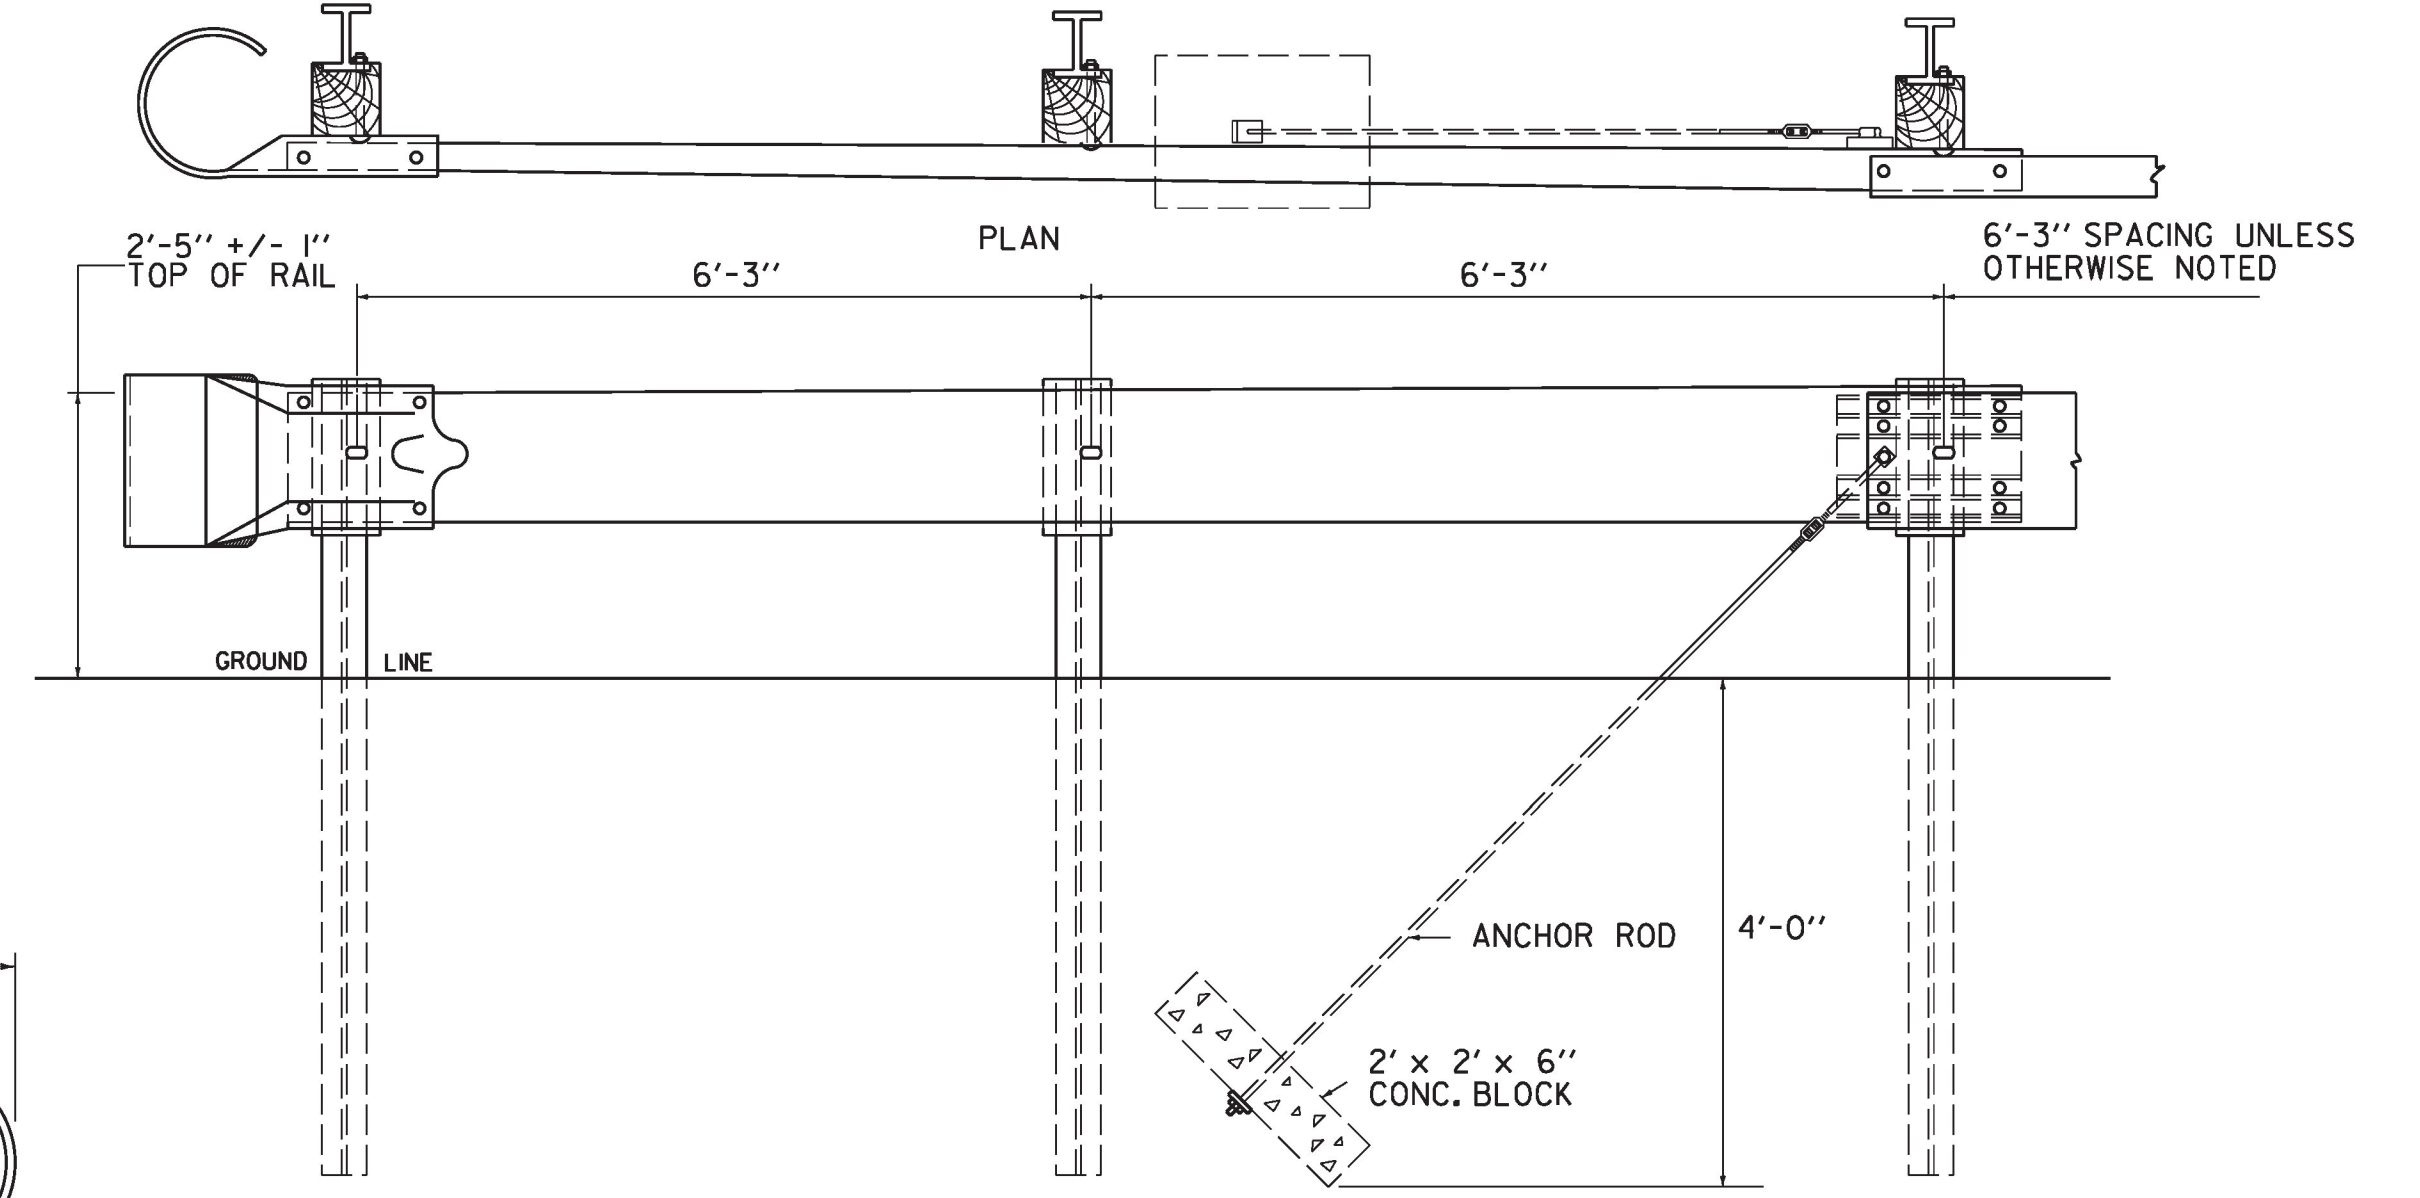


ASSEMBLY ELEVATION


TRAILING END TERMINAL FOR USE ON ONE-WAY HIGHWAYS

**GENERAL NOTES:**

1. ALL METAL PARTS SHALL BE GALVANIZED
2. ALL WOOD POSTS SHALL BE GIVEN A PRESERVATIVE TREATMENT
3. DETAILS PERTINENT TO THE STANDARD INSTALLATION OF "W" BEAM SECTIONS WILL BE FOUND ON STANDARD DRAWING G-1
4. FOR DESCRIPTION AND SPECIFICATIONS OF PARTS IDENTIFIED BY "ARTBA..." AND OTHER DETAILS OF POSTS, POST ACCESSORIES, FASTENERS AND RAIL ELEMENTS, SEE AASHTO-AGC-ARTBA JOINT TASK FORCE NO. 13, TITLED "A GUIDE TO STANDARDIZED HIGHWAY BARRIER HARDWARE", LATEST EDITION.
5. THE TRANSITION FROM THE APPROACH END TO THE STANDARD STEEL BEAM GUARDRAIL SHALL BE 25'-0" UNLESS OTHERWISE SPECIFIED.
6. WHEN STANDARD STEEL BEAM CONNECTS TO BRIDGE APPROACH RAIL OF A DIFFERENT HEIGHT THE LENGTH NEEDED TO TRANSITION THE HEIGHT OF STANDARD STEEL BEAM TO MATCH THE BRIDGE APPROACH RAIL SHALL BE 25'-0" UNLESS OTHERWISE SPECIFIED.
7. WHEN STANDARD STEEL BEAM CONNECTS TO A MANUFACTURED TERMINAL SECTION OF A DIFFERENT HEIGHT THE LENGTH NEEDED TO TRANSITION THE HEIGHT OF STANDARD STEEL BEAM TO MATCH THE MANUFACTURED TERMINAL SECTION SHALL BE 25'-0" UNLESS OTHERWISE SPECIFIED.

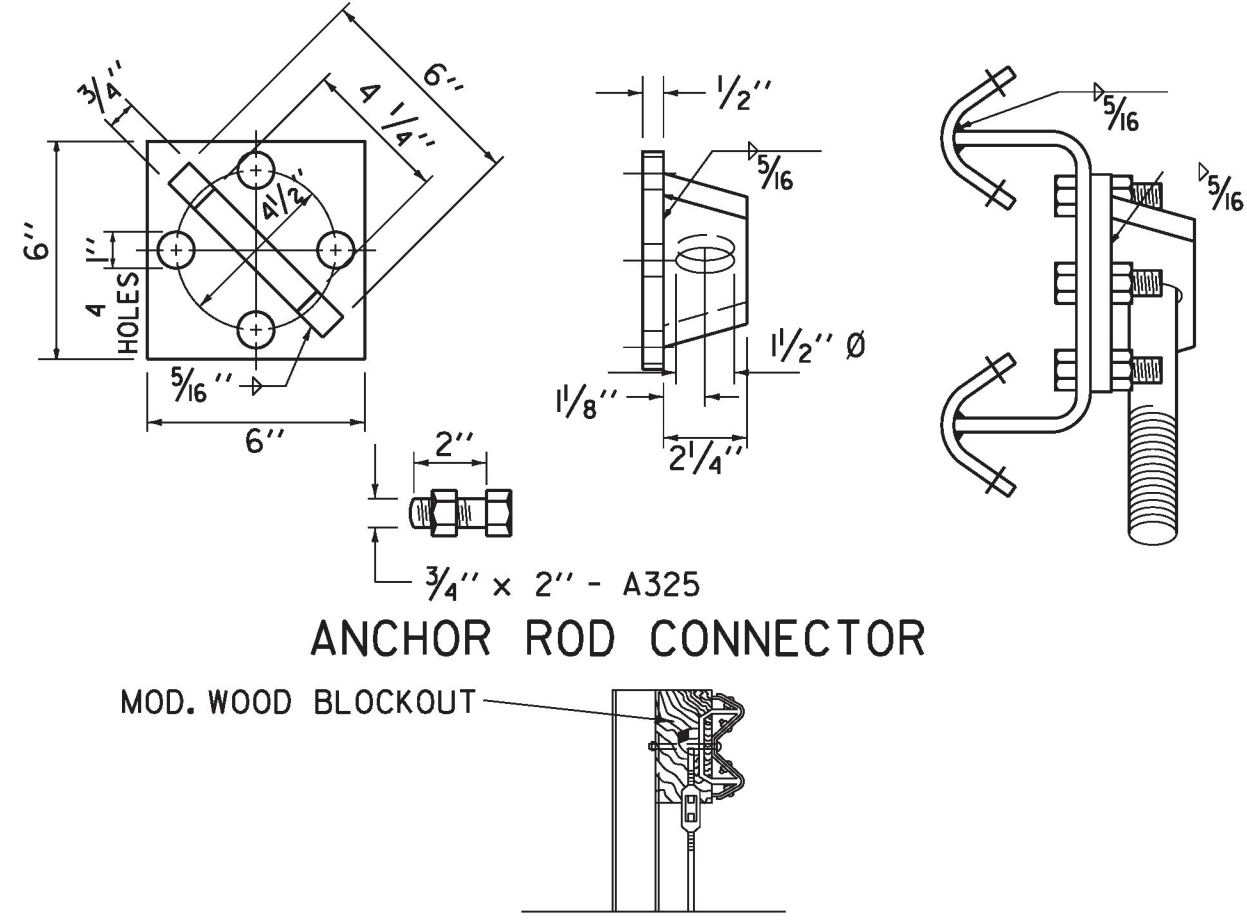


ANCHOR ROD CONNECTOR

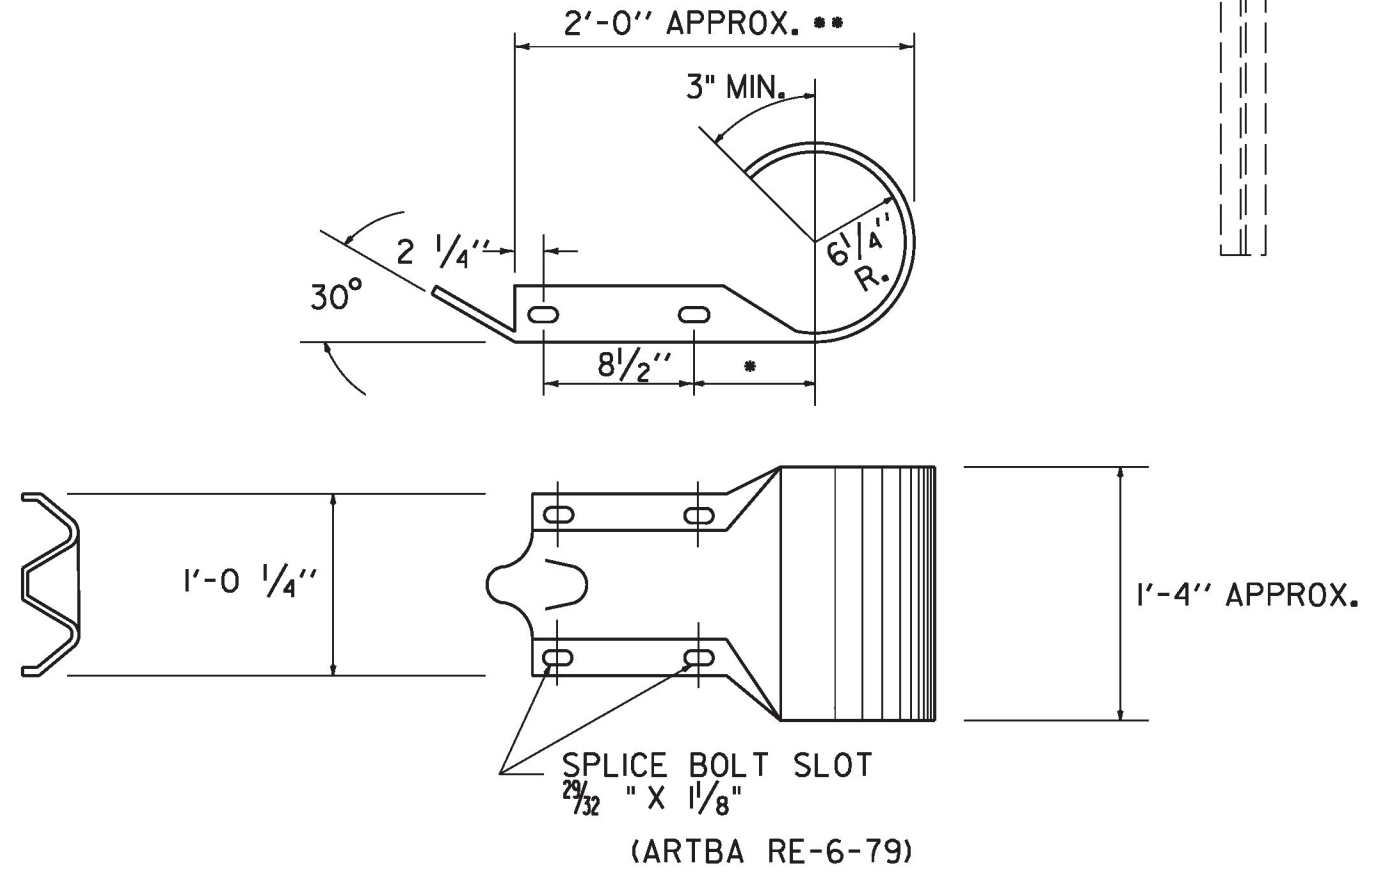

ROUNDED "W" BEAM END SECTION


* THIS DIMENSION IS 7 1/2" INRE-7-79. IF THE DIMENSION IS USED IN THIS PART, IT WILL GIVE AN ACCEPTABLE OVERALL LENGTH (**) OF APPROXIMATELY 2'-11/2."

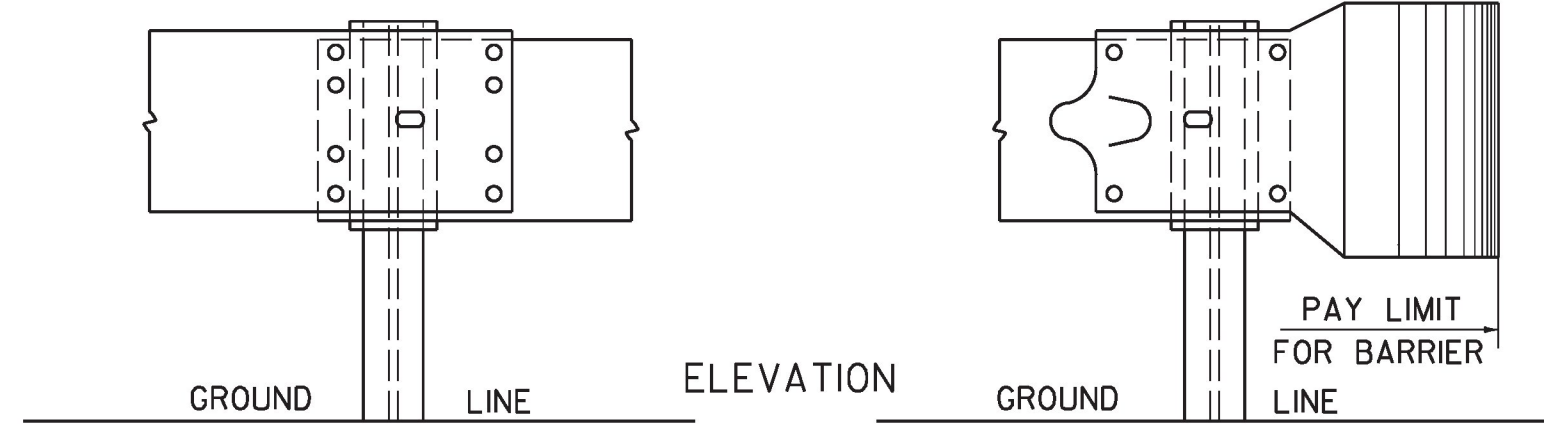


STEEL BEAM MEDIAN BARRIER

NOTE: TO BE USED OUTSIDE CLEAR ZONE ONLY.

**OTHER STANDARD REQUIRED: G-1**

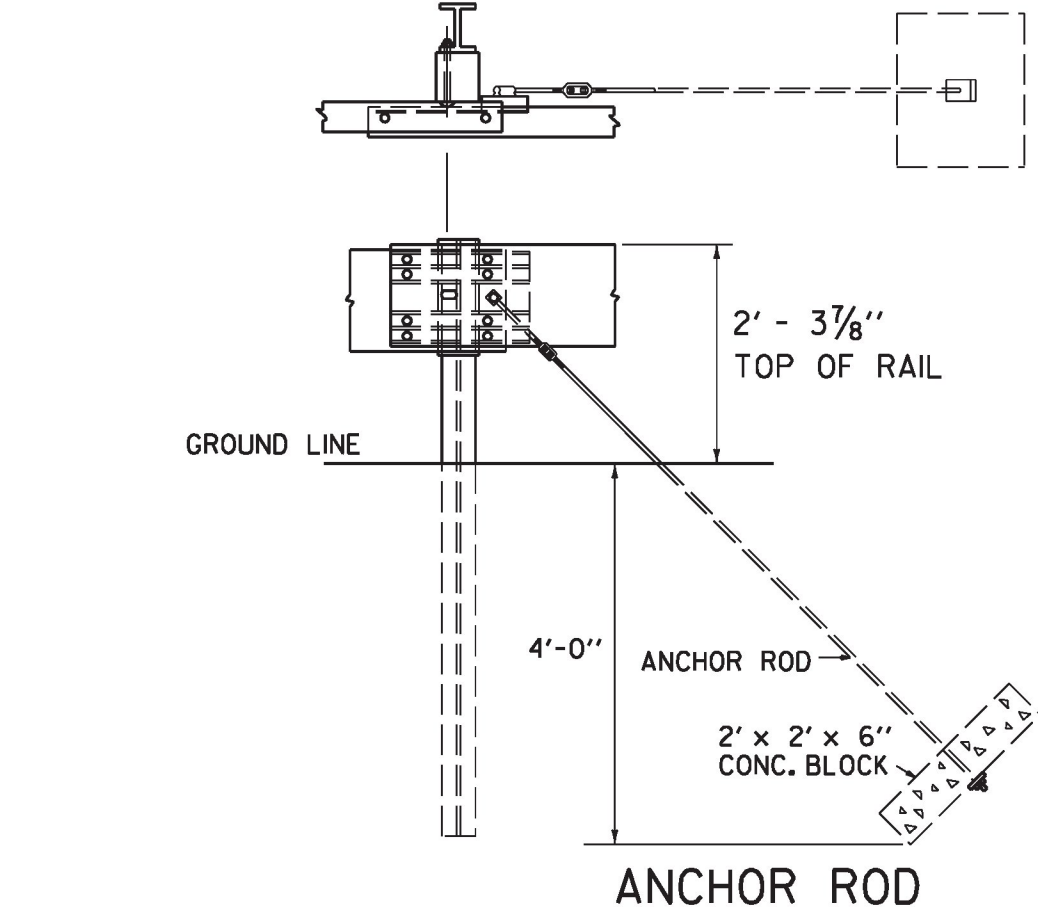


ANCHOR ROD

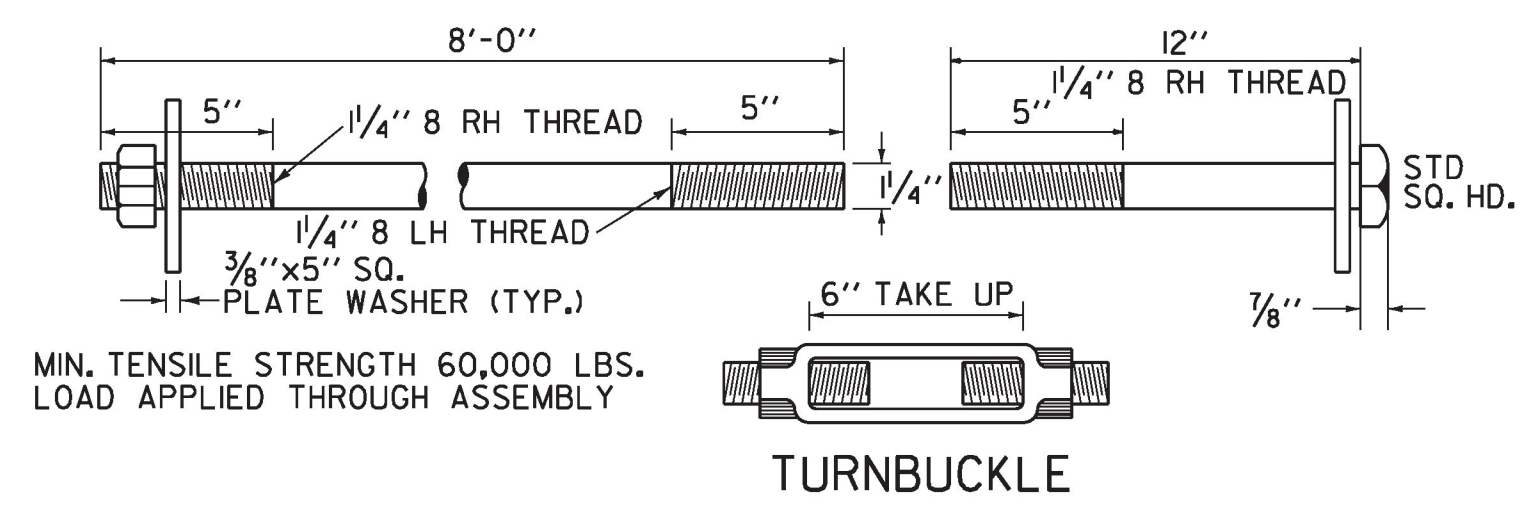


TURNBUCKLE


MIN. TENSILE STRENGTH 60,000 LBS. LOAD APPLIED THROUGH ASSEMBLY

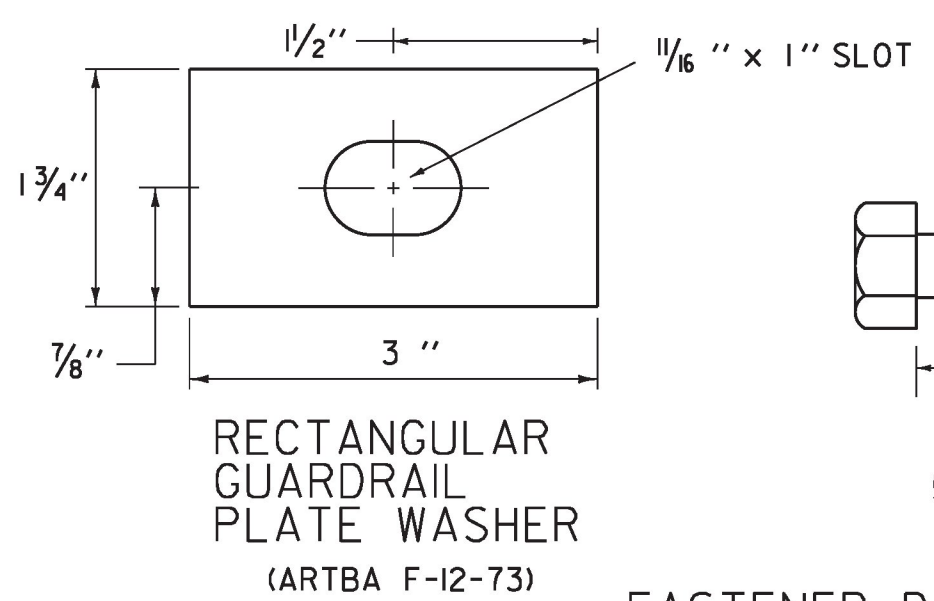

RECTANGULAR GUARDRAIL PLATE WASHER

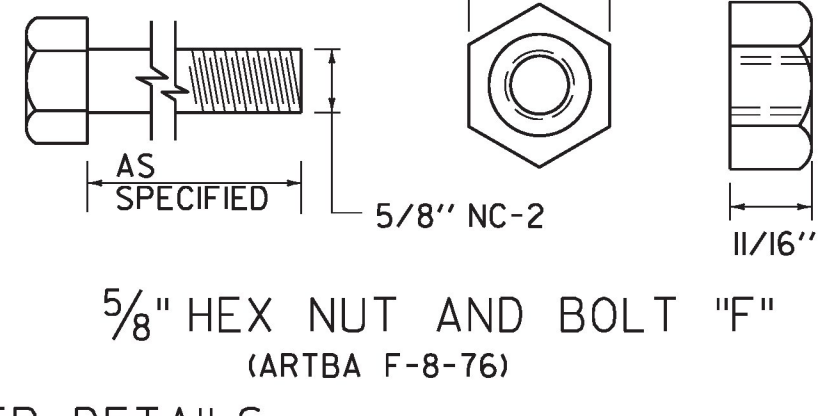

FASTENER DETAILS

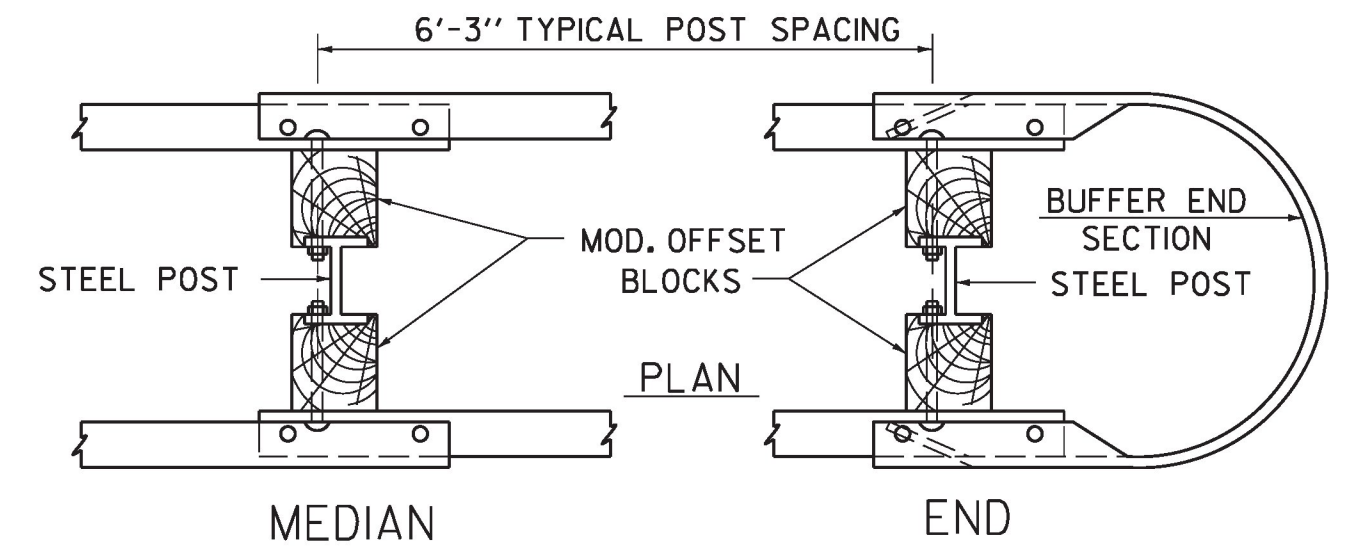


STEEL BEAM MEDIAN BARRIER

**REVISIONS AND CORRECTIONS**  
 JUNE 1, 1994 - REISSUED, WITHOUT CHANGE, UNDER NEW SIGNATURES.  
 JAN. 3, 2000 - UPDATED TO REFLECT METRIC STD. CHANGES  
 FEB. 10, 2014 - UPDATED TO REFLECT GUARDRAIL HEIGHT OF 29"; AS NOTED IN FHWA LETTER DATED MAY 17, 2010

APPROVED  
*[Signature]*  
 HIGHWAY SAFETY & DESIGN ENGINEER  
*[Signature]*  
 DIRECTOR OF PROGRAM DEVELOPMENT  
*[Signature]*  
 FEDERAL HIGHWAY ADMINISTRATION

**STEEL BEAM GUARDRAIL APPROACH END TERMINAL**  
**STEEL BEAM GUARDRAIL TRAILING END TERMINAL**  
**ANCHOR FOR STEEL BEAM GUARDRAIL**  
**STEEL BEAM MEDIAN BARRIER**

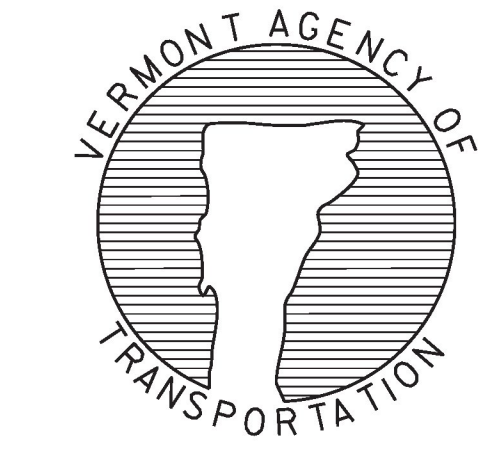

**STANDARD**  
**G-1d**


1. TRAFFIC CONTROL DEVICES NOT DETAILED IN THE VERMONT AGENCY OF TRANSPORTATION (VAOT) "STANDARD DRAWINGS" OR THE PROJECT PLANS SHALL BE IN ACCORDANCE WITH THE "MANUAL ON TRAFFIC CONTROL DEVICES" (MUTCD) AND THE "STANDARD HIGHWAY SIGNS AND MARKINGS" BOOK (SHSM) PUBLISHED BY THE FEDERAL HIGHWAY ADMINISTRATION (FHWA).
2. CONSTRUCTION SIGNS SHALL BE ERECTED BEFORE THE START OF ANY WORK AND SHALL BE COVERED UNTIL WORK COMMENCES, DURING PERIODS OF INACTIVITY OR UPON COMPLETION OF THE WORK. EACH SIGN SHALL BE ERECTED IN A NEAT AND WORKMANLIKE MANNER.
3. CONSTRUCTION SIGN COVERS SHALL CONSIST OF A PANEL, PAINTED FLAT BLACK, THE SAME SIZE AS THE SIGN IT COVERS. THE PANEL SHALL BE OF WOOD, PLYWOOD, HARDBOARD OR ANY MATERIAL SATISFACTORY TO THE ENGINEER. NO MATERIAL WILL BE APPROVED THAT WILL DETERIORATE BY EXPOSURE TO THE WEATHER DURING THE PROJECT. MOUNTING OF THE PANEL SHALL BE DONE IN SUCH A WAY AS NOT TO DAMAGE THE SIGN FACE MATERIAL.
4. SIGNS SHALL BE MAINTAINED IN A CLEAN AND LEGIBLE CONDITION SATISFACTORY TO THE ENGINEER. THEY SHALL BE KEPT PLUMB AND LEVEL, AND ALWAYS PRESENT A NEAT APPEARANCE. DAMAGED, DEFACED OR DIRTY SIGNS SHALL BE REPAIRED, CLEANED OR REPLACED AS ORDERED BY THE ENGINEER.
5. NO CROSS-BRACING OR BACK-BRACING TO KEEP POSTS PLUMB WILL BE ALLOWED. CONCRETE FOUNDATIONS, COLLARS OR SOIL BEARING PLATES ARE NOT PERMITTED. CONSTRUCTION SIGNS SHALL BE PLACED ON TWO POSTS.
6. CONSTRUCTION SIGNS INSTALLED ON POSTS SHALL BE SET SECURELY IN THE GROUND. THE BOTTOM OF A SIGN SHALL BE AT LEAST FIVE FEET ABOVE THE EDGE OF PAVEMENT AND THE NEAREST EDGE OF A SIGN SHALL BE AT LEAST SIX FEET OUTSIDE THE SHOULDER POINT, FOUR FEET OUTSIDE GUARDRAIL, OR TWO FEET OUTSIDE CURBING OR SIDEWALK. THE INSTALLATION OF SIGNS SHALL BE SUBJECT TO APPROVAL OF THE ENGINEER. IN URBAN AREAS, THE BOTTOM OF THE SIGN SHALL BE AT LEAST SEVEN FEET ABOVE THE SIDEWALK OR EDGE OF PAVEMENT, WHICHEVER IS HIGHER.
7. PORTABLE SIGNS SHALL BE PLACED ON THE EDGE OF ROADWAY AND A MINIMUM OF ONE FOOT ABOVE THE TRAVELED WAY. ALL VEGETATION THAT INTERFERES WITH VISIBILITY OF THE SIGNS SHALL BE REMOVED. WHEN PLACED BEHIND GUARDRAIL, THE BOTTOM OF THE SIGN FACE SHALL BE ABOVE THE TOP OF THE GUARDRAIL.
8. SIGNS SHALL BE REMOVED UPON COMPLETION OF THE WORK AT THE DISCRETION OF THE ENGINEER.
9. ROLL UP CONSTRUCTION SIGNS SHALL HAVE RETROREFLECTIVE SHEETING EQUAL TO OR EXCEEDING THE "AMERICAN ASSOCIATION OF STATE HIGHWAY AND TRANSPORTATION OFFICIALS" (AASHTO) M 268 ["AMERICAN SOCIETY FOR TESTING AND MATERIALS" (ASTM) D 4956] TYPE VI AND TYPE VII UNLESS OTHERWISE NOTED.
10. SOLID SUBSTRATE CONSTRUCTION SIGNS SHALL HAVE RETROREFLECTIVE SHEETING EQUAL TO OR EXCEEDING THE "AMERICAN ASSOCIATION OF STATE HIGHWAY AND TRANSPORTATION OFFICIALS" (AASHTO) M 268 ["AMERICAN SOCIETY FOR TESTING AND MATERIALS" (ASTM) D 4956] TYPE VIII OR IX REQUIREMENTS UNLESS OTHERWISE NOTED.
11. WHERE CONSTRUCTION SIGN INSTALLATIONS ARE NOT PROTECTED BY GUARDRAIL OR OTHER APPROVED TRAFFIC BARRIERS, ALL SIGN STANDS AND POST INSTALLATIONS SHALL MEET "NATIONAL COOPERATIVE HIGHWAY RESEARCH PROGRAM" (NCHRP) REPORT 350 OR THE AASHTO "MANUAL FOR ASSESSING SAFETY HARDWARE" (MASH). THE APPROPRIATE RESOURCE SHALL BE DETERMINED AS DESCRIBED IN THE MASH PUBLICATION. NO SIGN POSTS SHALL EXTEND OVER THE TOP OF THE SIGN INSTALLED ON SAID POSTS. WHEN ANCHORS ARE INSTALLED, STUBS SHALL NOT BE GREATER THAN FOUR INCHES ABOVE EXISTING GROUND.
12. ROADWAY AND SHOULDER WIDTHS DEPICTED ON THE STANDARD DRAWINGS MAY VARY.
13. THESE STANDARD DRAWINGS ARE INTENDED TO SERVE AS VTRANS STANDARD OPERATING PROCEDURE. IT IS NOTED THAT COMPONENT PARTS OF A TEMPORARY TRAFFIC CONTROL WORK ZONE MAY BE MODIFIED DUE TO FIELD CONDITIONS, AT THE DISCRETION OF THE ENGINEER.

OTHER STDS. REQUIRED: **NONE**

REVISIONS AND CORRECTIONS  
AUG. 6, 2012 - ORIGINAL APPROVAL DATE



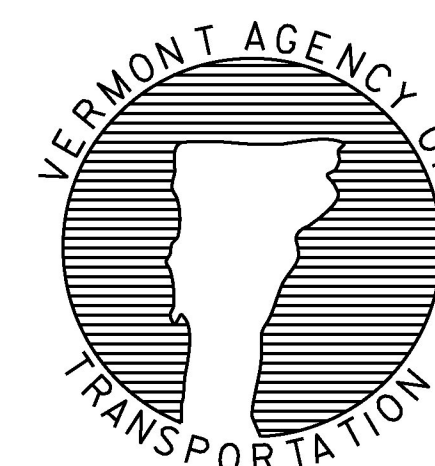


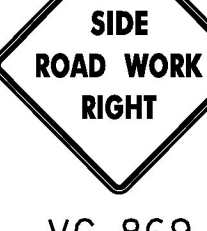
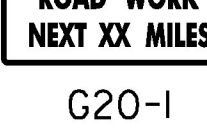
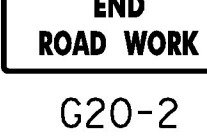
APPROVED  
*H.A.C.M.*  
HIGHWAY SAFETY & DESIGN ENGINEER  
*Rudon F. Thwait*  
DIRECTOR OF PROGRAM DEVELOPMENT  
*Mark D. Richter*  
FEDERAL HIGHWAY ADMINISTRATION


## TRAFFIC CONTROL GENERAL NOTES



STANDARD  
T-1


**LEGEND**

- (A)  ROAD WORK AHEAD  
W20-1
- (B)  ROAD WORK 500 FT  
W20-1
- (C)  SIDE ROAD WORK AHEAD  
VC-869
- (D)  SIDE ROAD WORK 500 FT  
VC-869
- (E)  SIDE ROAD WORK LEFT  
VC-869
- (F)  SIDE ROAD WORK RIGHT  
VC-869
- (G)  ROAD WORK NEXT XX MILES  
G20-1
- (H)  END ROAD WORK  
G20-2

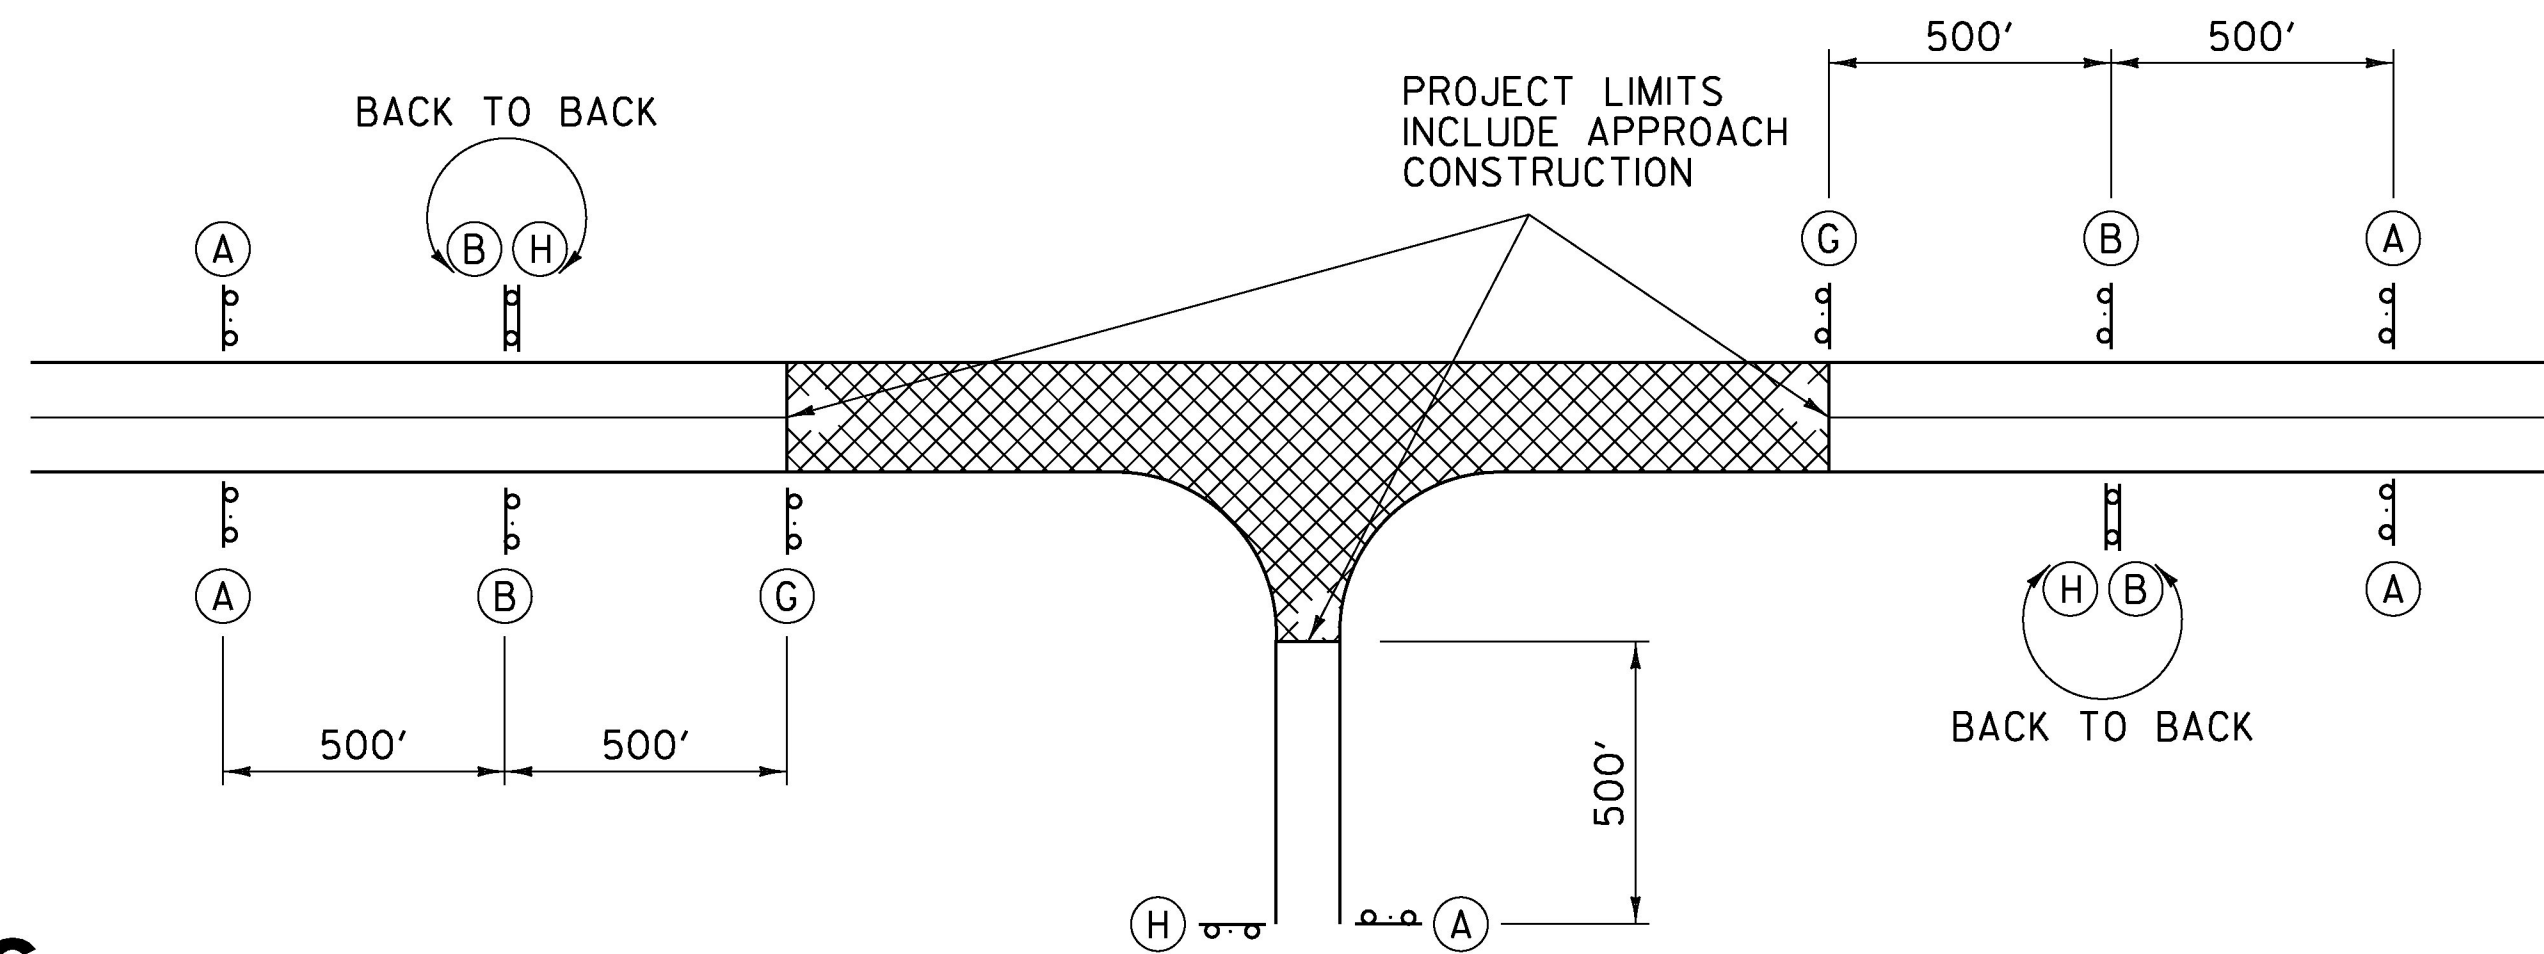

**TYPICAL APPROACH SIGNING**

FIELD CONDITIONS MAY DICTATE THE ACTUAL PLACEMENT.

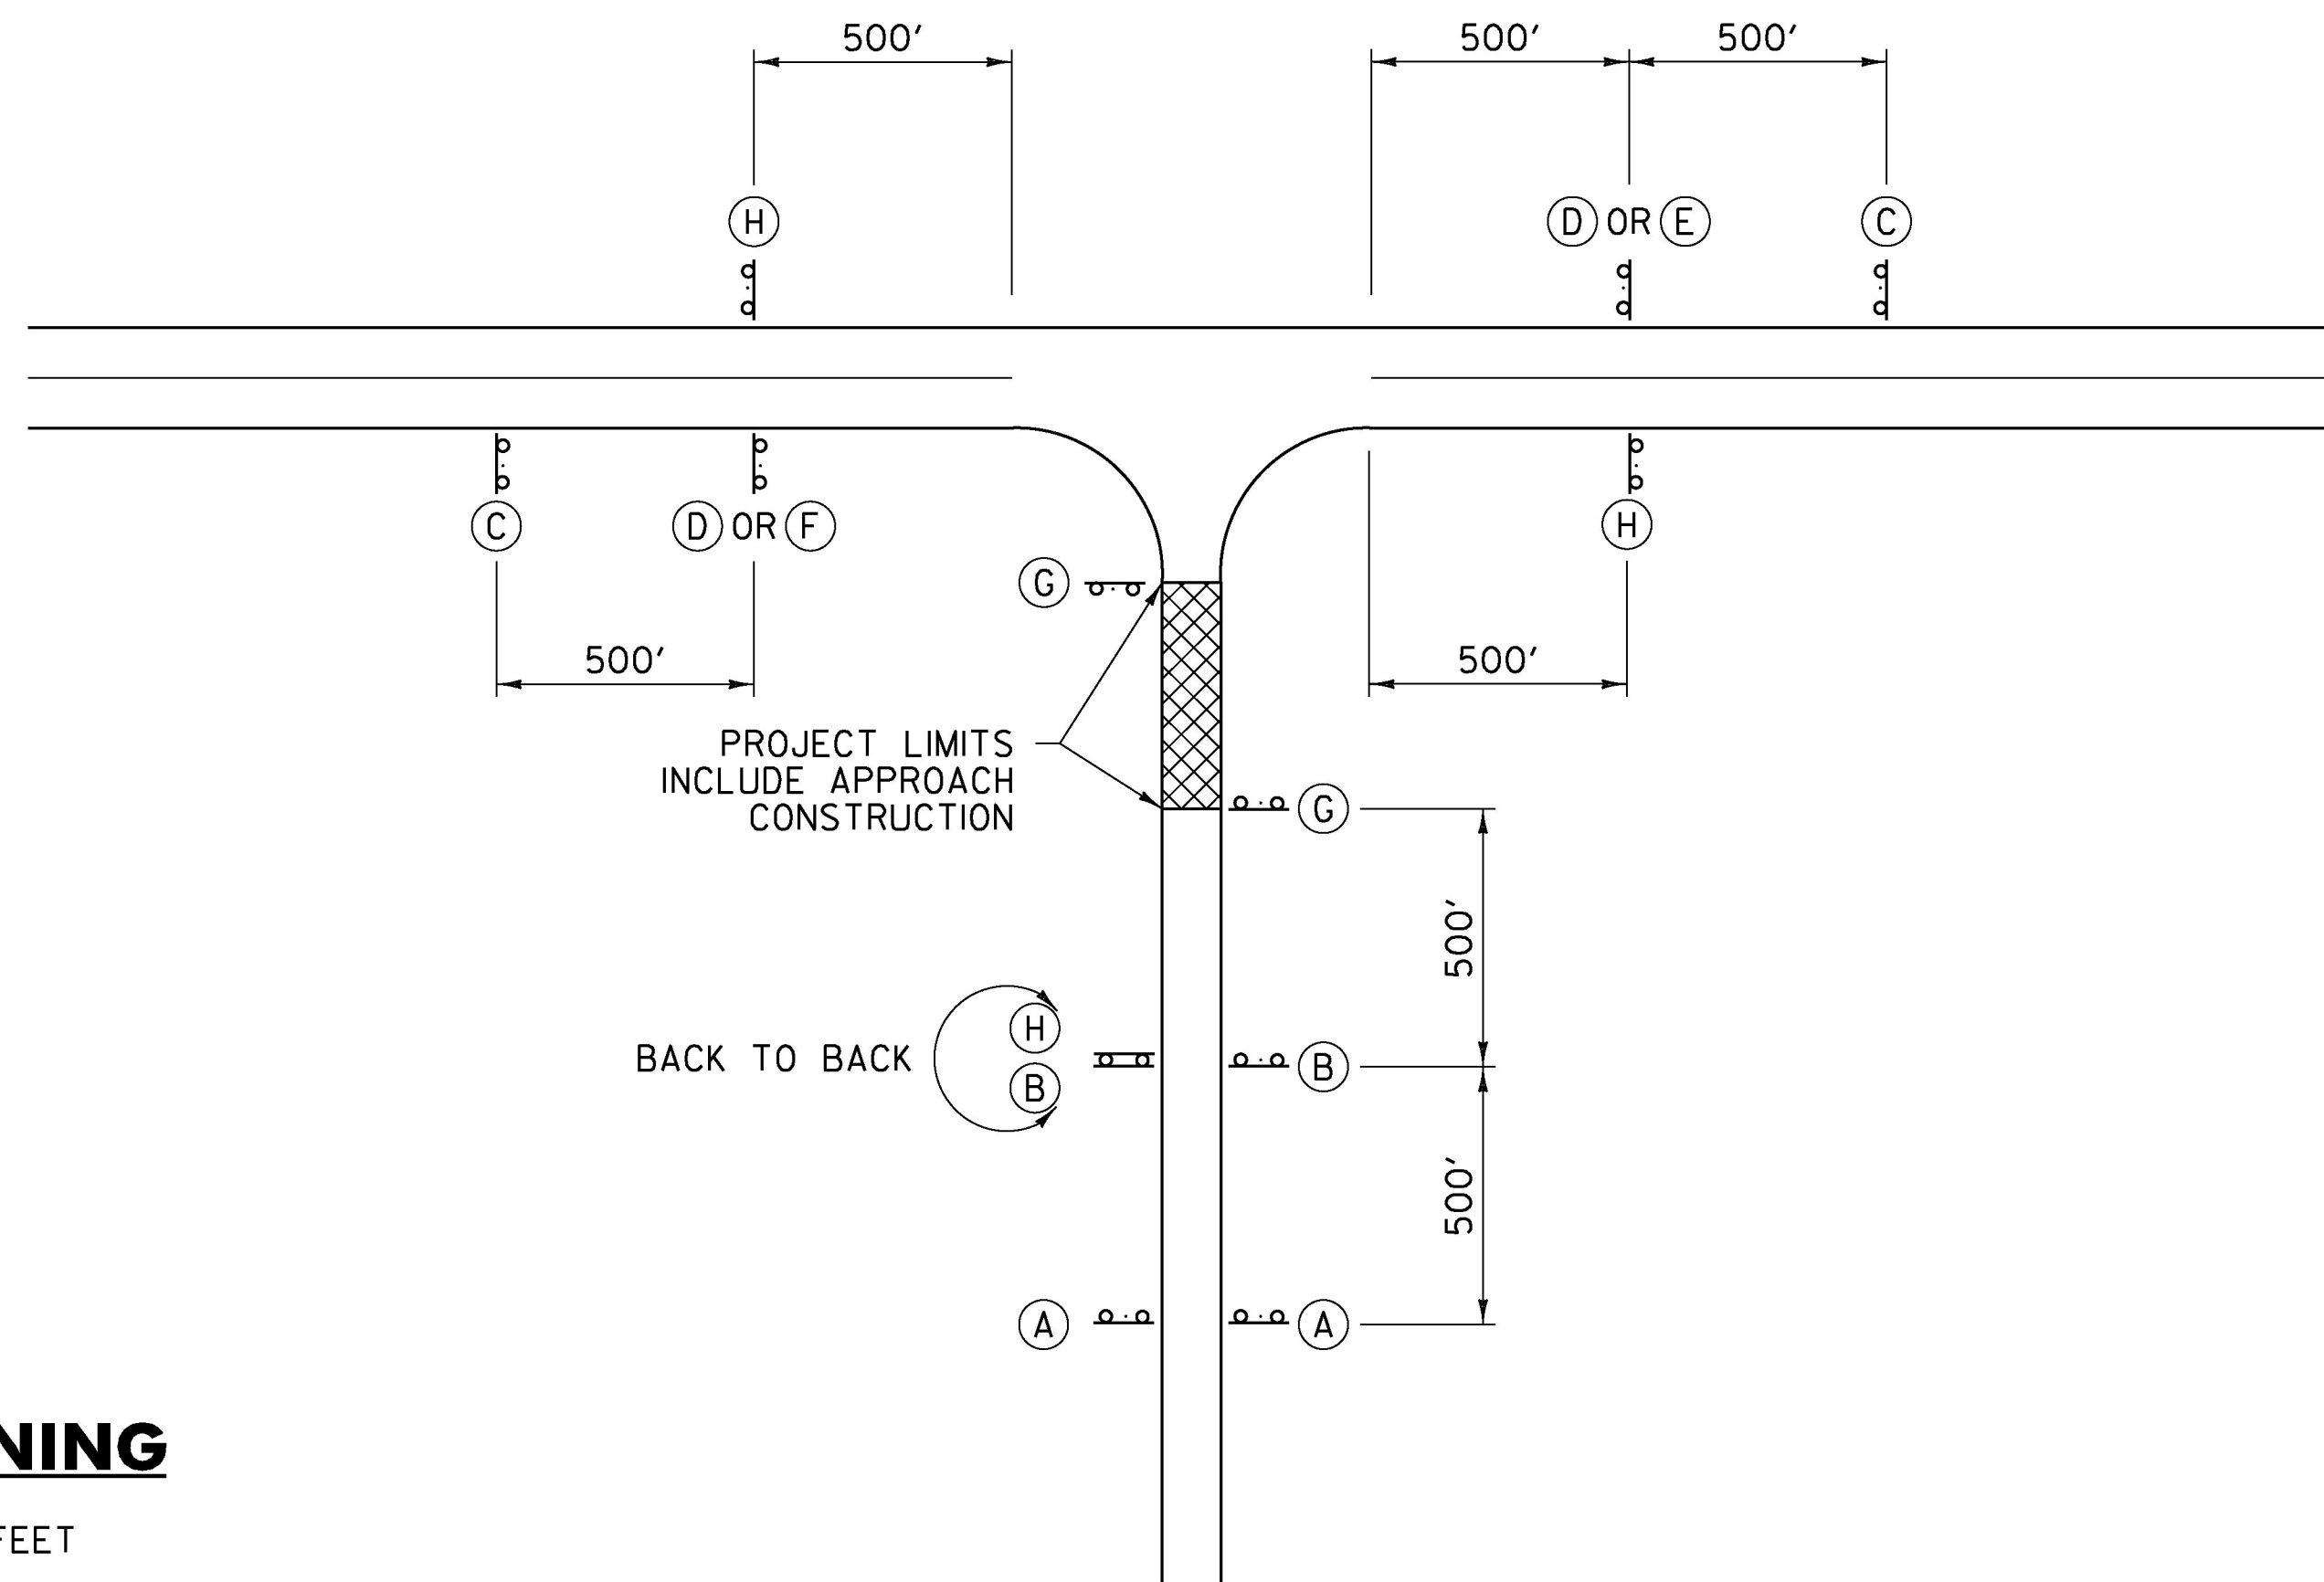

**SIDE ROAD APPROACH SIGNING**

TO BE USED WHEN CONSTRUCTION IS UP TO 1000 FEET FROM THE INTERSECTION. FIELD CONDITIONS MAY DICTATE THE ACTUAL PLACEMENT.

**GENERAL NOTES:**


1. SIGNS SHOWN ON THIS SHEET ARE INTENDED FOR USE IN PROVIDING ADVANCE WARNING AND INFORMATION ON CONSTRUCTION PROJECTS OVER WHICH TRAFFIC WILL BE MAINTAINED. WHEN ADDITIONAL APPROACH SIGNS OR OTHER TYPES OF ADVANCE SIGNING OR CONTROL ARE NECESSARY, THE PLANS AND/OR THE SPECIFICATIONS FOR THAT PROJECT WILL GIVE THE DETAILS OF THE SIGNS AND DEVICES REQUIRED. FOR ON-PROJECT CONSTRUCTION SIGNS, REFER TO APPROPRIATE STANDARD SHEETS.
2. THE "ROAD WORK NEXT XX MILES" SIGN (G20-1) SHALL BE INSTALLED IN ADVANCE OF TEMPORARY TRAFFIC CONTROL ZONES THAT ARE MORE THAN TWO MILES IN LENGTH OR AS DIRECTED BY THE ENGINEER. DISTANCES SHALL BE STATED TO THE NEAREST WHOLE MILE.
3. SIGNS SHALL BE LOCATED AS DETAILED ON THIS SHEET OR AS OTHERWISE SHOWN ON THE PLANS. THEY SHALL APPEAR AT EACH END OF THE HIGHWAY UNDER CONSTRUCTION AND ON ALL INTERSECTING PUBLIC HIGHWAYS. THE ENGINEER SHALL DETERMINE THE EXACT LOCATIONS.

**OTHER STDS. REQUIRED: T-1, T-28**


REVISIONS AND CORRECTIONS  
AUG. 6, 2012 - ORIGINAL APPROVAL DATE

APPROVED  
*[Signature]*  
HIGHWAY SAFETY & DESIGN ENGINEER  
*[Signature]*  
DIRECTOR OF PROGRAM DEVELOPMENT  
*[Signature]*  
Mark D. Richter  
FEDERAL HIGHWAY ADMINISTRATION


**CONVENTIONAL ROADS  
CONSTRUCTION APPROACH  
SIGNING**

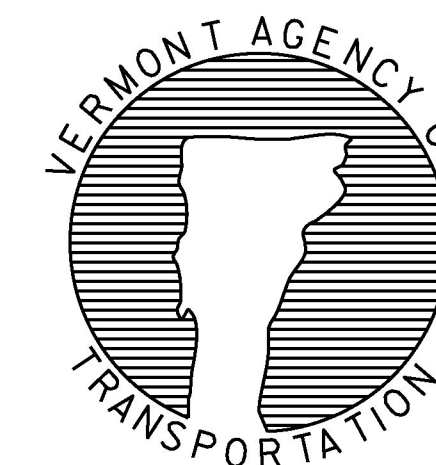


**STANDARD  
T-10**

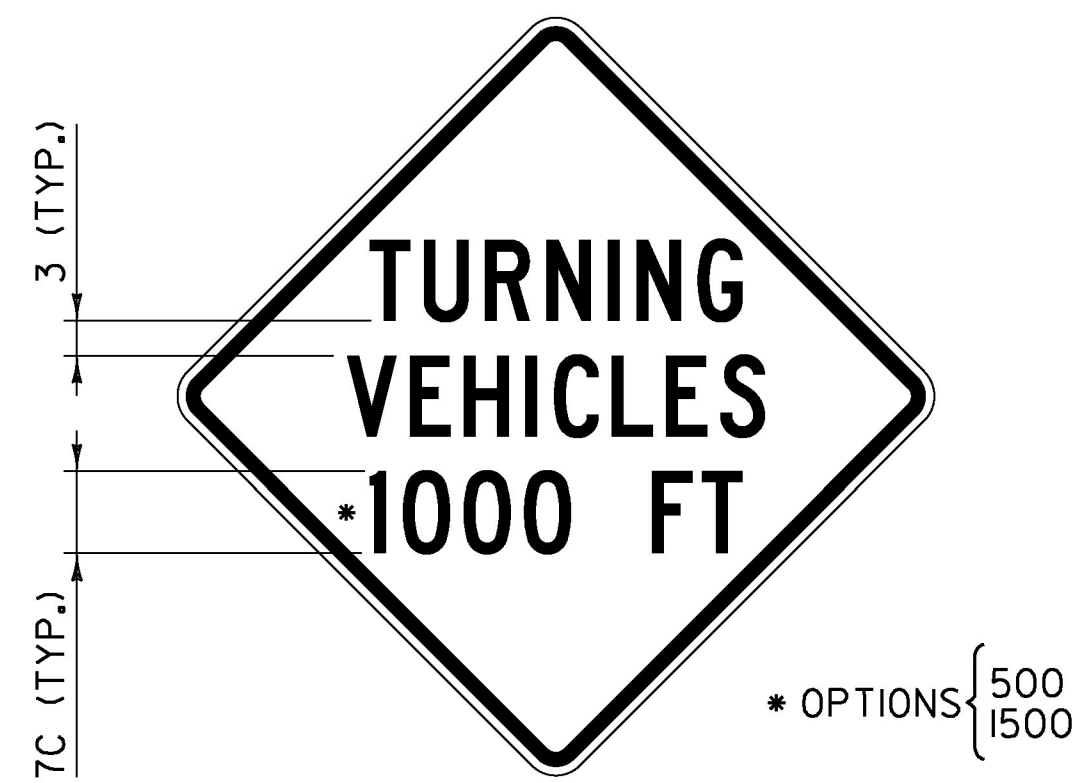


**VC-001**

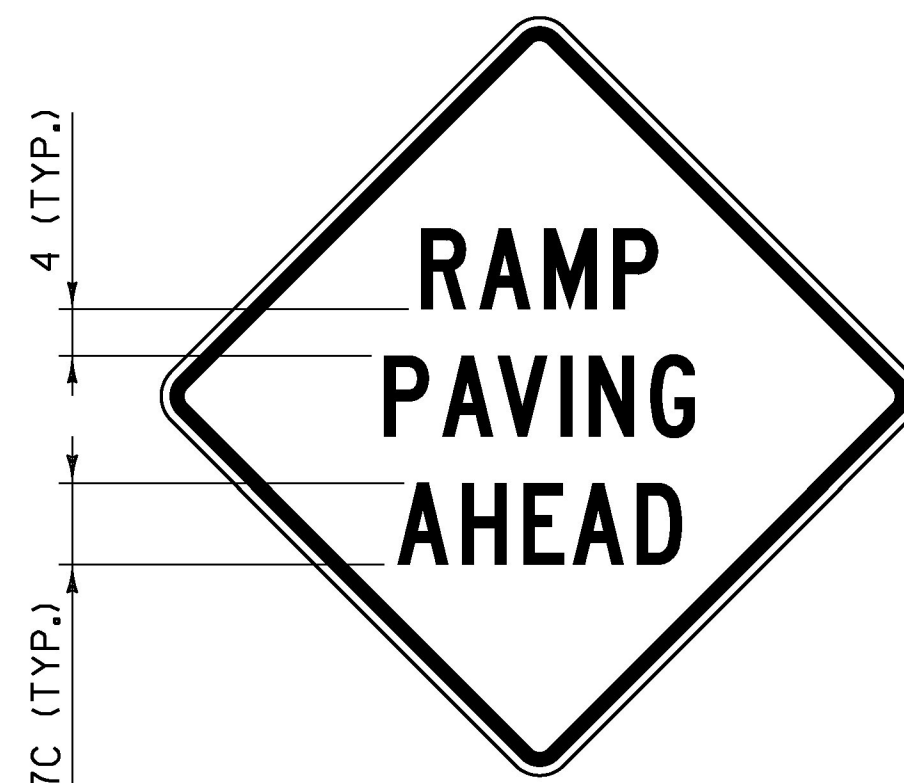


**VC-003**

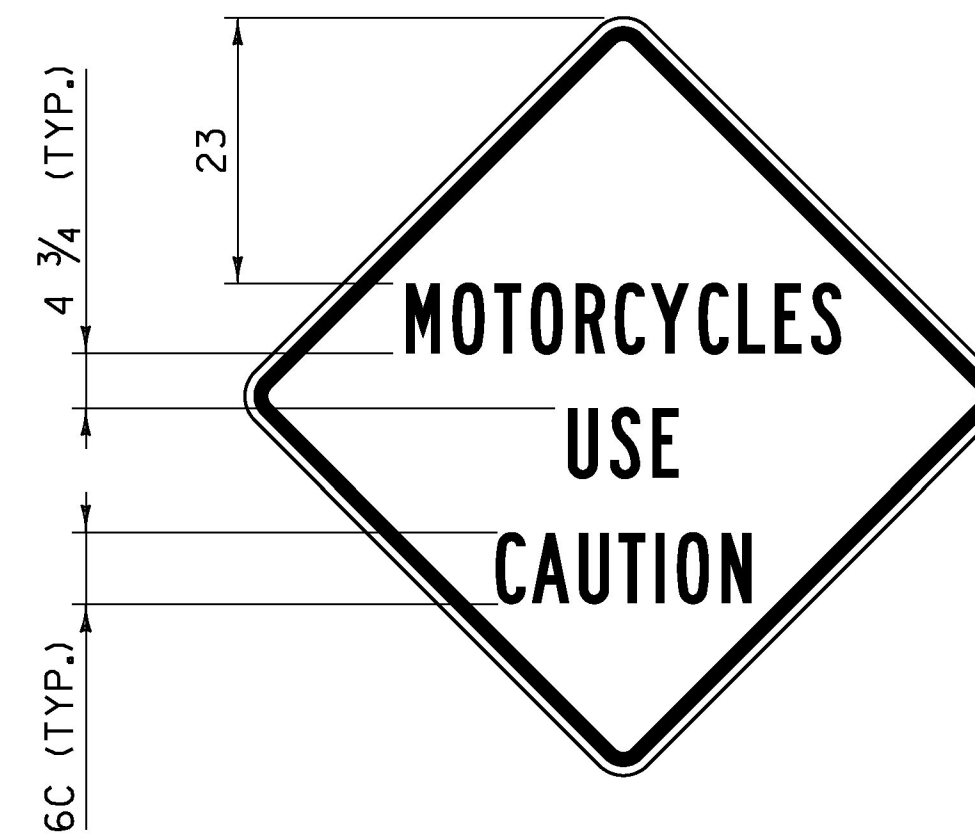


**VC-004**

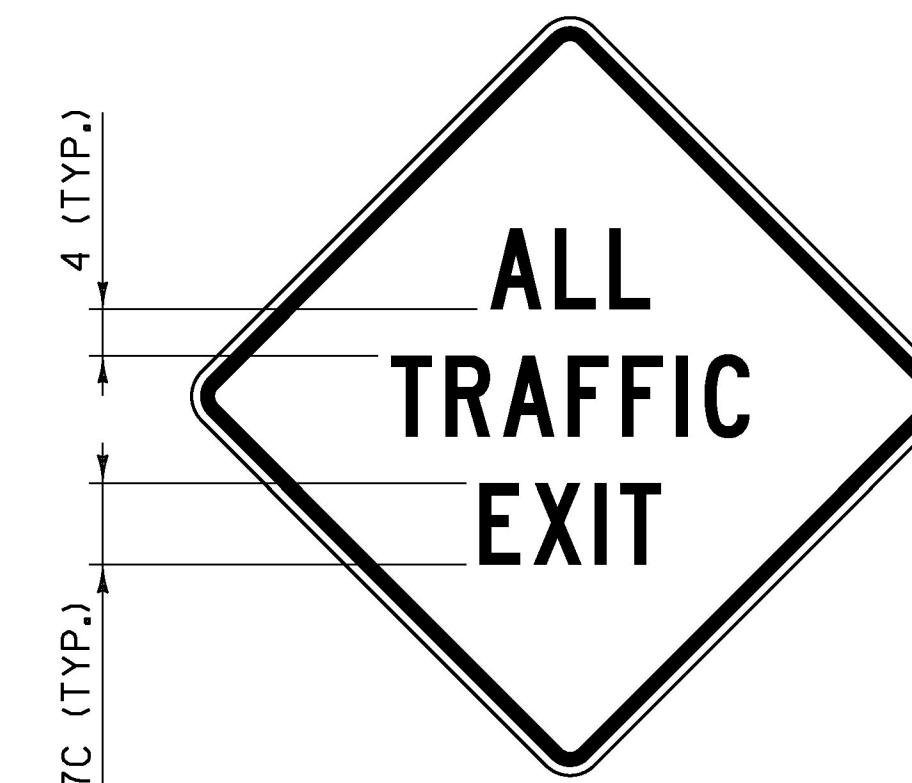

**VC-008**

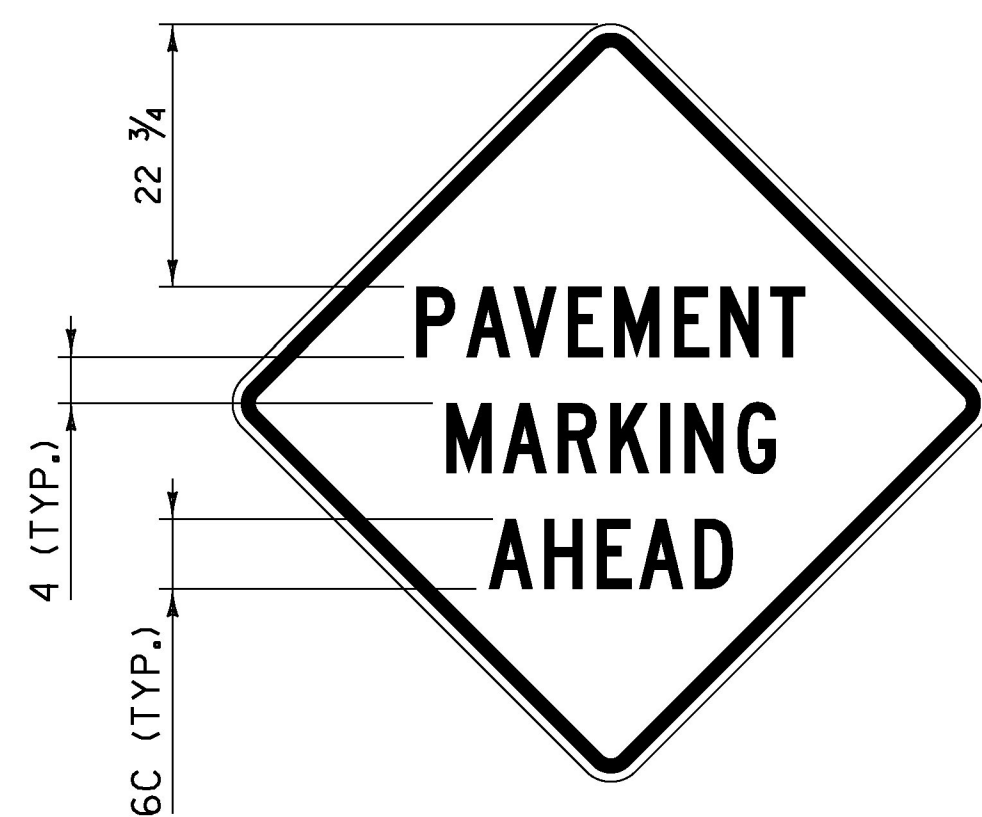

**VC-813**

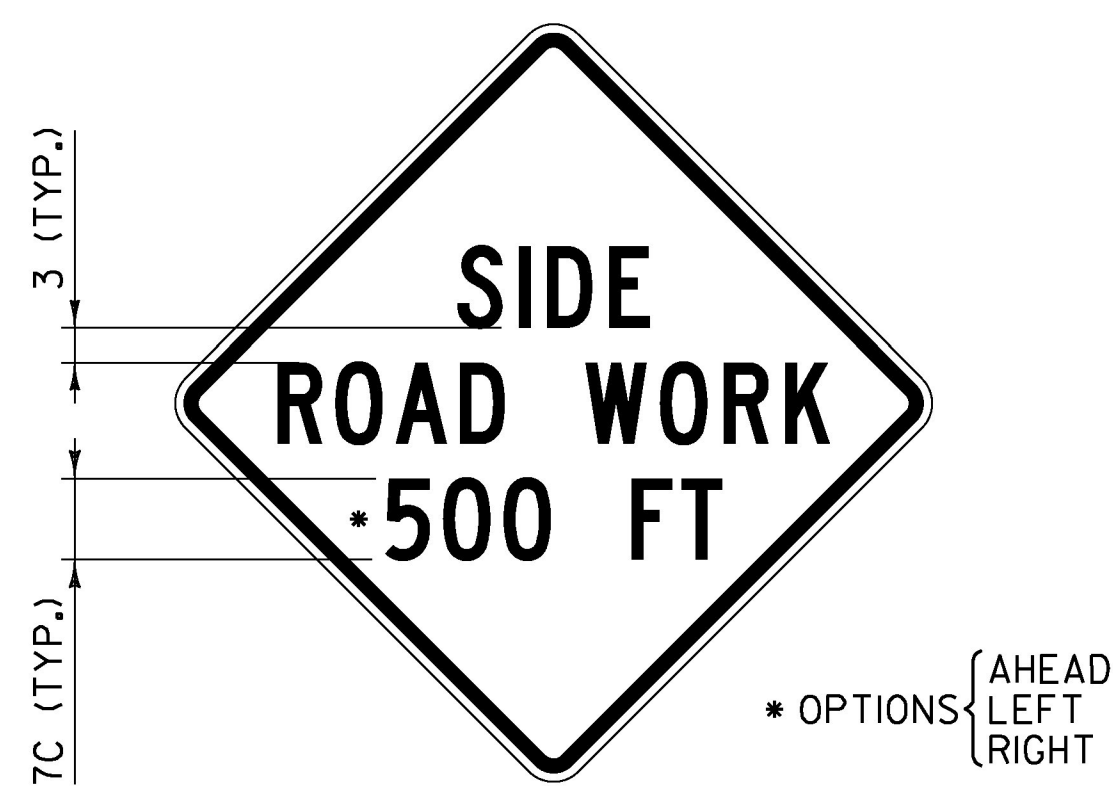

**VC-869**



**VC-874**

**GENERAL NOTES:**

1. COLORS FOR SIGNS SHALL BE BLACK LEGEND AND BORDER ON FLUORESCENT ORANGE BACKGROUND.
2. CONSTRUCTION SIGNS SHALL BE 48 INCH BY 48 INCH. IF SOLID SUBSTRATE SIGNS ARE USED, SIGNS SHALL HAVE CORNERS ROUNDED TO A THREE INCH RADIUS.
3. SIGNS SHALL HAVE 1 1/4 INCH WIDE BORDERS THAT ARE INDENTED 3/4 INCH FROM THE EDGE OF THE SIGN.
4. SIGNS SHALL HAVE THE LEGEND CENTERED HORIZONTALLY AND VERTICALLY ON THE SIGN UNLESS OTHERWISE INDICATED.
5. ALL DIMENSIONS SHOWN IN INCHES.

**OTHER STDS. REQUIRED: T-1**

REVISIONS AND CORRECTIONS  
AUG. 6, 2012 - ORIGINAL APPROVAL DATE

APPROVED  
*W.A.G. Pl.*  
HIGHWAY SAFETY & DESIGN ENGINEER  
*Ruben Fleuret*  
DIRECTOR OF PROGRAM DEVELOPMENT  
*Mark D. Richter*  
FEDERAL HIGHWAY ADMINISTRATION

CONSTRUCTION SIGN  
DETAILS



STANDARD  
T-28


### POST AND ANCHOR SELECTION CHART

POST SIZE (IN.)	POST THICKNESS (IN.)	POST WEIGHT (LBS./FT.)	POST GAGE	SECTION MODULUS (IN. ³ )	ONE POST SV	TWO POST SV	THREE POST SV	POSTS PERMITTED IN 8' PATH	ANCHOR SIZE (IN.)	ANCHOR GAGE	MINIMUM ANCHOR LENGTH
1.75	.083	1.88	14	0.222	45	90	135	TWO	2.00	12	30
2.00	.109	2.42	12	0.393	80	160	240	TWO	2.25	12	48
2.50	.109	3.35	12	0.673	137	274	411	ONE	3.00	7	48

#### NOTES:

- ALL SIGN POSTS SHALL HAVE  $\frac{1}{16}$  INCH HOLES EVERY ONE INCH ON CENTER (ALL FOUR SIDES).
- THE NUMBER OF SIGN POSTS PERMITTED WITHIN AN EIGHT FOOT PATH ASSUMES THAT THE SIGN ASSEMBLY IS NOT PROTECTED BY GUARDRAIL OR IS LOCATED WITHIN A GUARDRAIL'S DEFLECTION DISTANCE DETERMINED PER THE CURRENT "AMERICAN ASSOCIATION OF STATE HIGHWAY AND TRANSPORTATION OFFICIALS" (AASHTO) ROADSIDE DESIGN GUIDE. ADDITIONAL POSTS MAY BE INSTALLED USING SLIP BASES THAT MEET "NATIONAL COOPERATIVE HIGHWAY RESEARCH PROGRAM" (NCHRP) REPORT 350 OR THE AASHTO "MANUAL FOR ASSESSING SAFETY HARDWARE" (MASH). THE APPROPRIATE RESOURCE SHALL BE DETERMINED AS DESCRIBED IN THE MASH PUBLICATION.
- TO USE THE SELECTION VALUE (SV) COLUMNS IN THE TABLE ABOVE, MULTIPLY A SIGN'S SURFACE AREA IN SQUARE FEET ( $H \times L$ ) BY THE SIGN'S HEIGHT IN FEET MEASURED FROM THE GROUND TO THE CENTROID OF THE SIGN ASSEMBLY ( $h$ ). THIS RESULT MUST BE LESS THAN OR EQUAL TO THE CORRESPONDING SELECTION VALUE. NOTE THAT FOR SIGNS WITH MULTIPLE POSTS, THE LARGEST HEIGHT DIMENSION SHALL BE USED TO CALCULATE THE POST SELECTION VALUE.
- THE DESIGN CRITERIA UTILIZED IN SIGN POST AND ANCHOR SELECTION IS AS FOLLOWS: WIND SPEED OF 70 MPH (10 YEAR MEAN RECURRENCE INTERVAL), WIND PRESSURE OF 19 PSF, STEEL MINIMUM YIELD OF 55,000 PSI, AND AN ALLOWABLE STRESS OF 1.4 (0.60 FY).


### CORNER BOLT INSTALLATION DETAIL

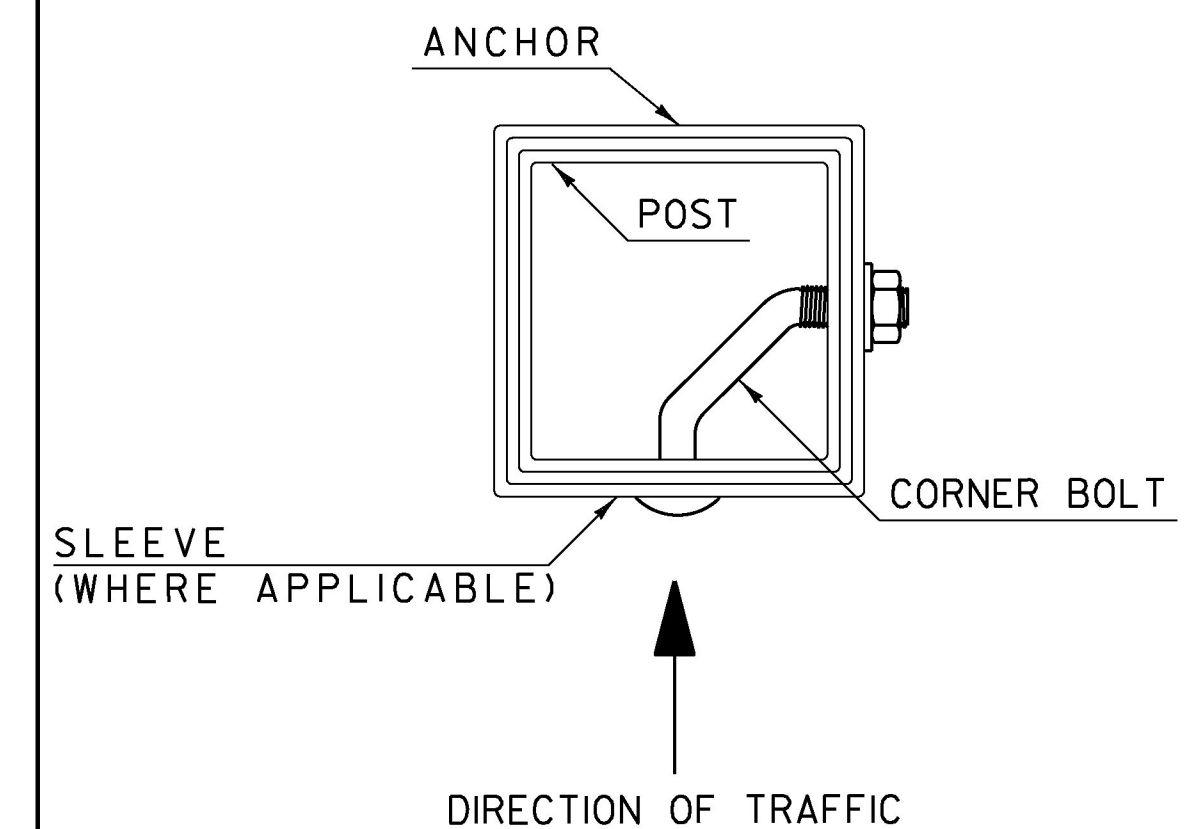

#### NOTES:

- CORNER BOLTS SHALL BE  $\frac{5}{16}$  INCH DIAMETER WITH 18 THREADS PER INCH AND DIMENSIONS SHALL BE DETERMINED BASED ON THE OUTERMOST DIMENSION OF THE SLEEVE, ANCHOR OR POST. THREAD EXPOSURE MUST EXCEED THE CORRESPONDING NUT WIDTH. THE CORNER BOLT AND CORRESPONDING HARDWARE SHALL BE ZINC PLATED, MEETING OR EXCEEDING THE REQUIREMENTS OF THE "AMERICAN SOCIETY FOR TESTING AND MATERIALS" (ASTM) A307.

### SLEEVE /ANCHOR INSTALLATION DETAIL

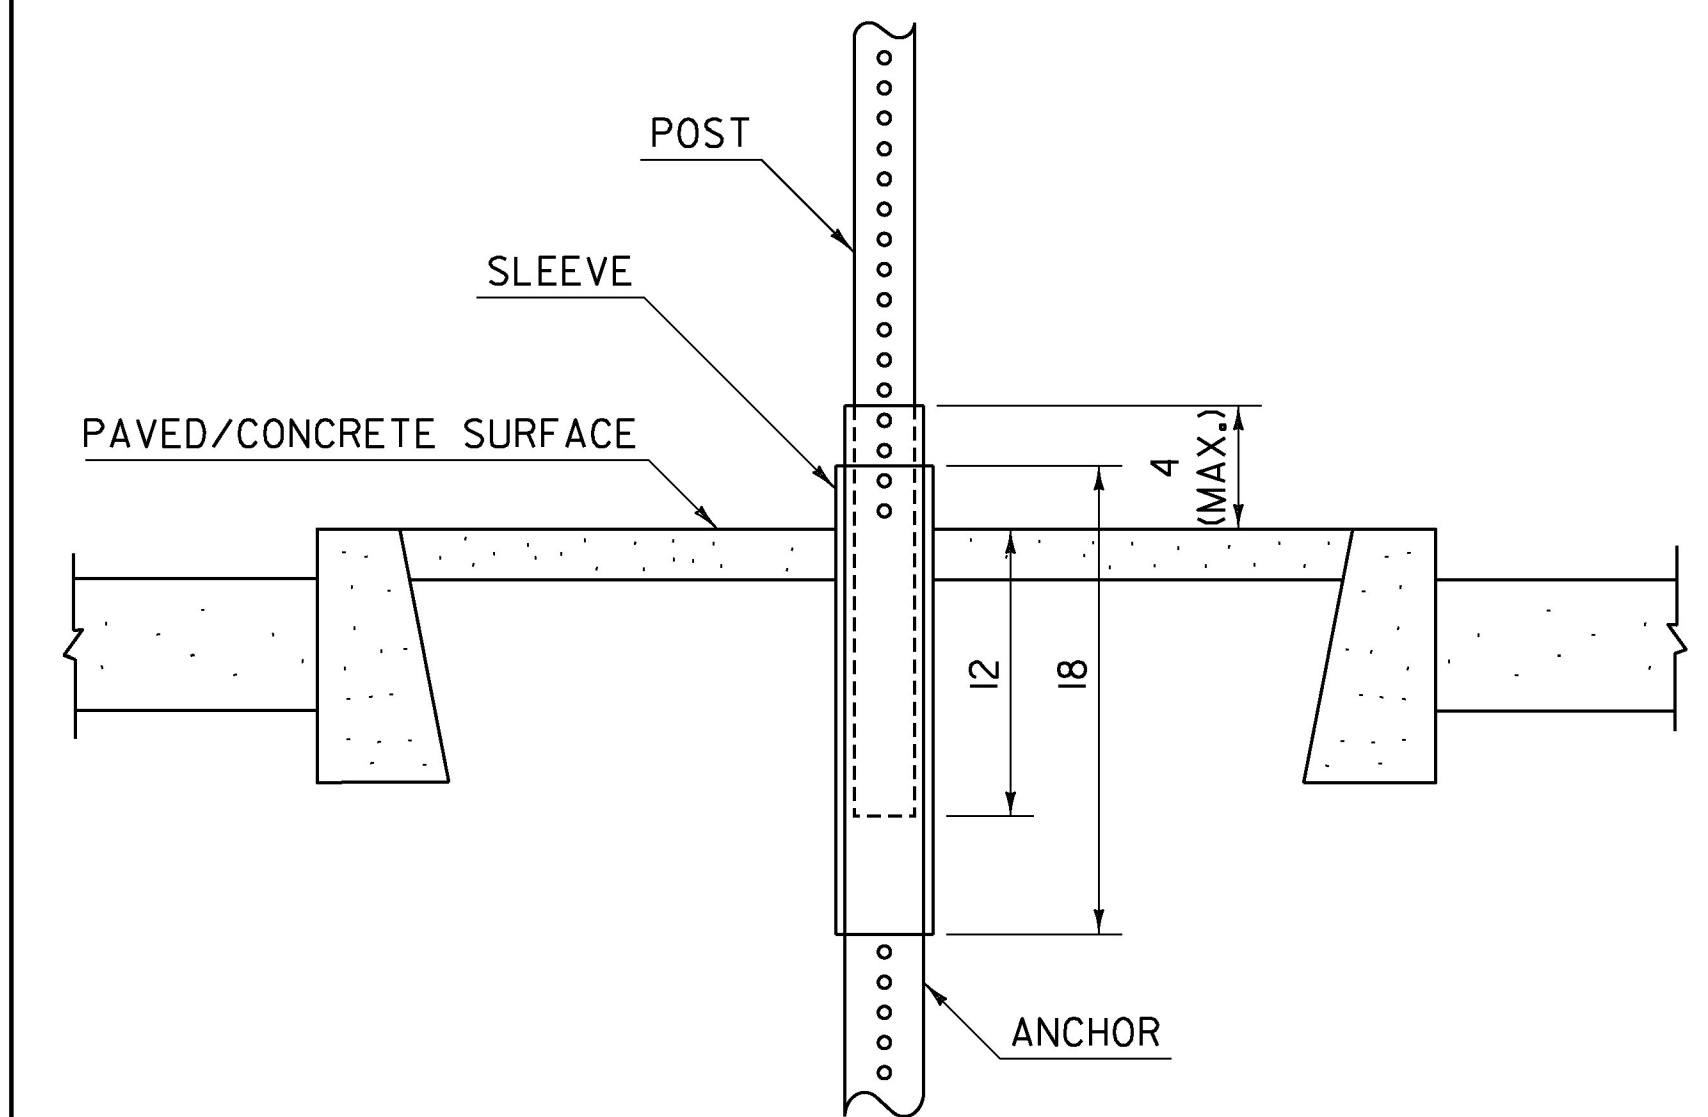

#### NOTES:


- A SLEEVE SHALL BE INSTALLED FOR SIGN INSTALLATIONS IN CONCRETE OR PAVEMENT.
- THE SLEEVE SHALL BE 18 INCHES MINIMUM IN LENGTH.
- THREE INCH SLEEVES THAT DO NOT HAVE HOLES WILL REQUIRE THAT  $\frac{1}{16}$  INCH HOLES ARE DRILLED TO FACILITATE CONNECTIONS.
- REFER TO CURRENT EDITION OF THE "VERMONT AGENCY OF TRANSPORTATION STANDARD SPECIFICATIONS FOR CONSTRUCTION" FOR MATERIAL REQUIREMENTS.

#### GENERAL NOTES:

- ALL SQUARE TUBE STEEL POSTS AND ANCHORS SHALL BE FORMED INTO A SIZE AND SHAPE IN SUCH A MANNER THAT NEITHER FLASH NOR WELD SHALL INTERFERE WITH THE TELESCOPING PROPERTIES, NOR DAMAGE THE GALVANIZING.
- ANCHORS MAY BE DRIVEN OR SET INTO A DUG HOLE AND BACKFILLED. IF DRIVEN, A DRIVING CAP SHALL BE USED. THE DUG HOLE INSTALLATION METHOD SHALL BE UTILIZED IN AREAS WITH POOR SOIL CONDITIONS OR AS DIRECTED BY THE ENGINEER. BACKFILL SHALL BE COMPACTED AS DIRECTED BY THE ENGINEER.
- THE TOPS OF SIGN POSTS SHALL BE AT OR NEAR THE TOP OF SIGN. THE POST SHALL NOT EXTEND ABOVE THE TOP OF SIGN.
- SIGN POSTS SHALL BE INSTALLED A MINIMUM OF ONE FOOT BELOW GROUND, INSIDE THE ANCHOR. THE LENGTH OF ANCHOR EXPOSED ABOVE GROUND SHALL NOT EXCEED FOUR INCHES.
- ALL DIMENSIONS SHOWN IN INCHES.

OTHER STDS. REQUIRED: **NONE**

### POST SPACING DETAILS

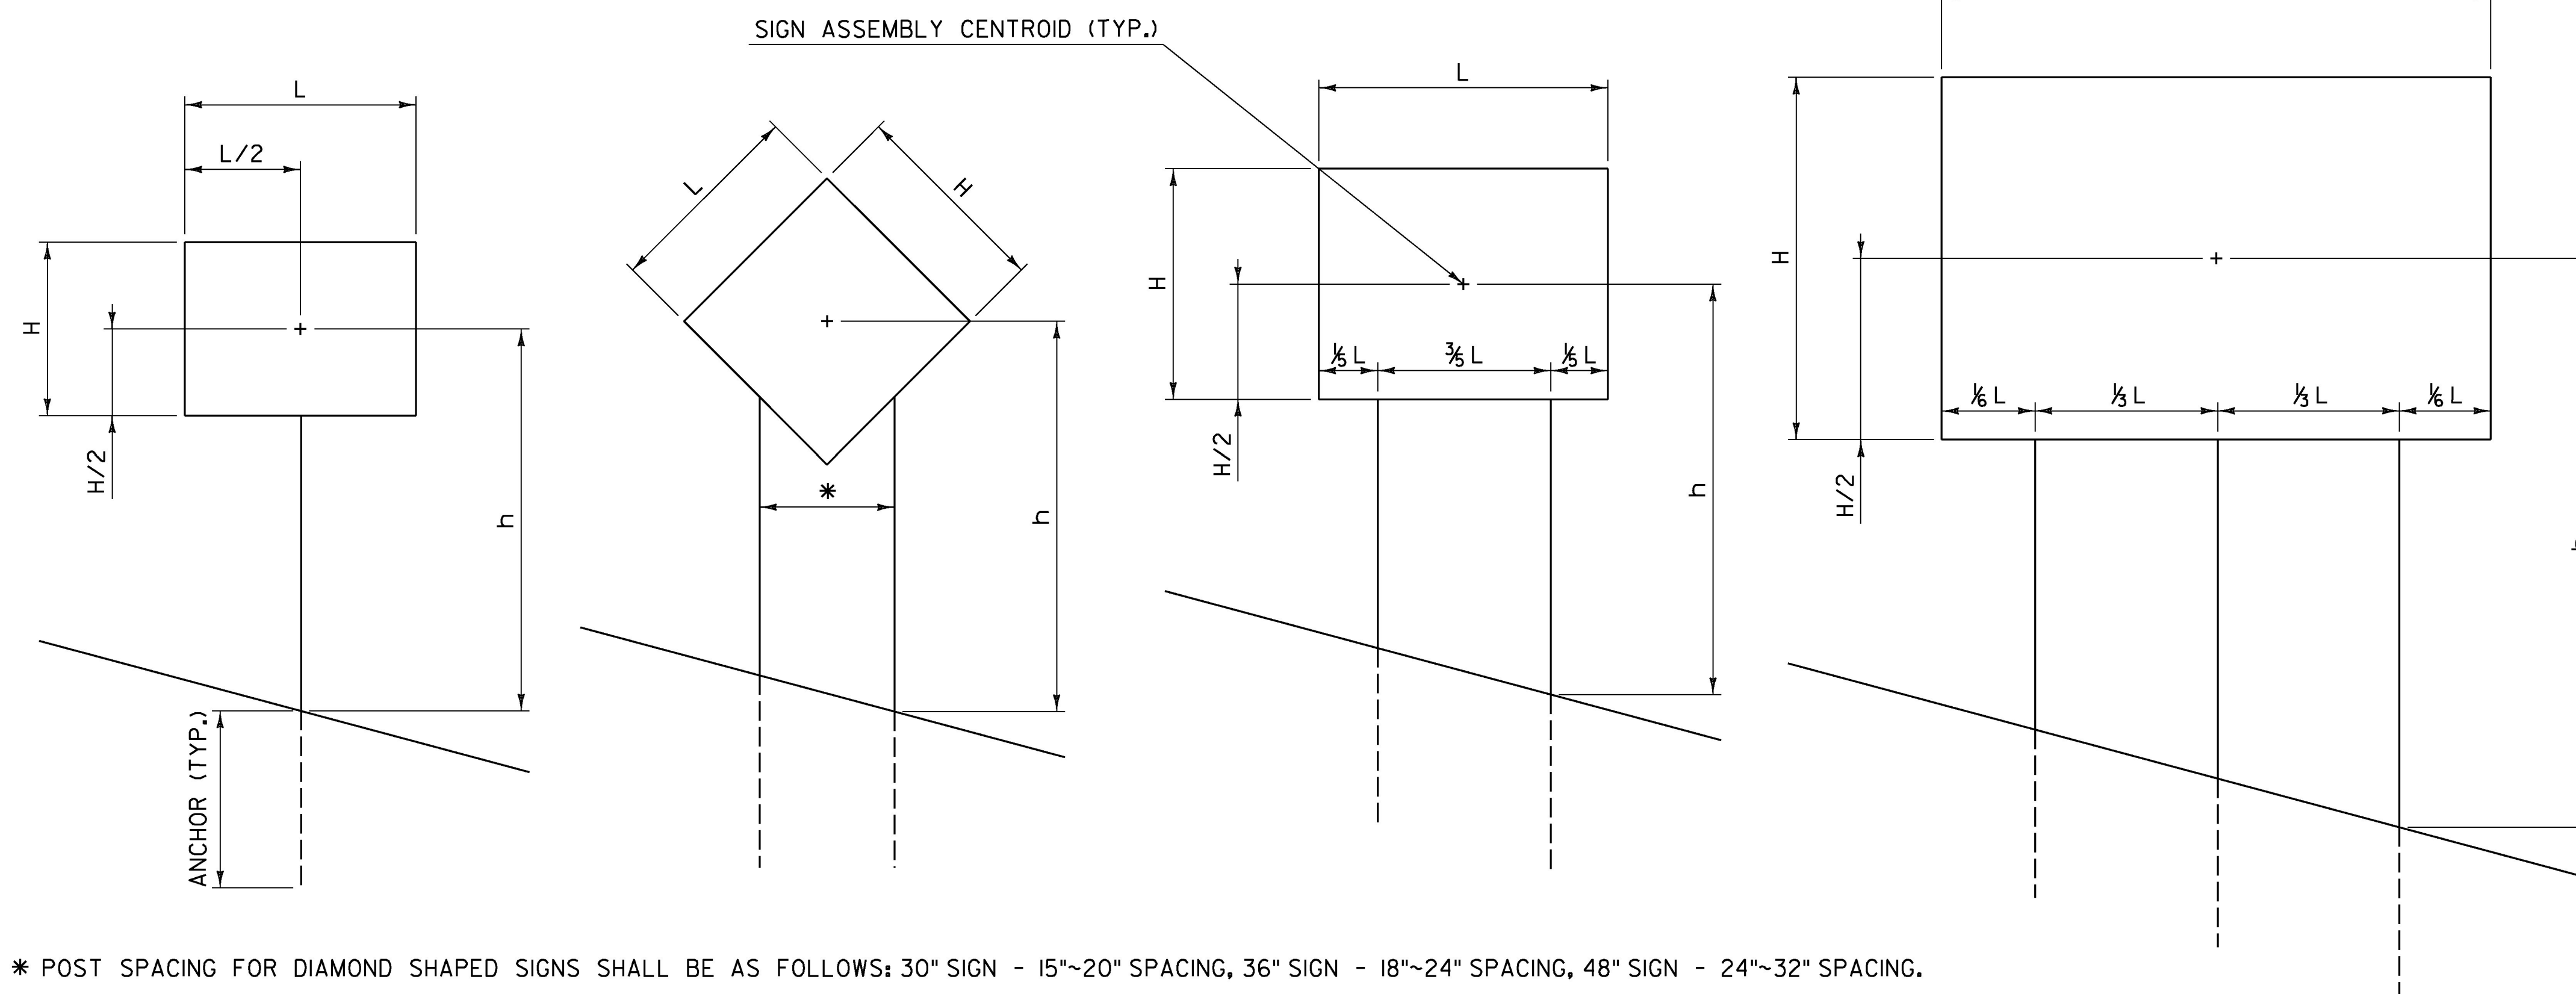


* POST SPACING FOR DIAMOND SHAPED SIGNS SHALL BE AS FOLLOWS: 30" SIGN - 15"-20" SPACING, 36" SIGN - 18"-24" SPACING, 48" SIGN - 24"-32" SPACING.



REVISIONS AND CORRECTIONS  
JAN. 2, 2013 - ORIGINAL APPROVAL DATE

APPROVED  
*W.A.C.*  
HIGHWAY SAFETY & DESIGN ENGINEER  
*Rickard*  
DIRECTOR OF PROGRAM DEVELOPMENT  
*Mark D. Richter*  
FEDERAL HIGHWAY ADMINISTRATION

## SQUARE TUBE SIGN POST AND ANCHOR

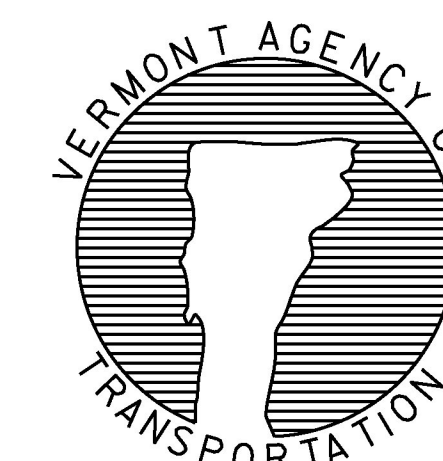

STANDARD  
T-45

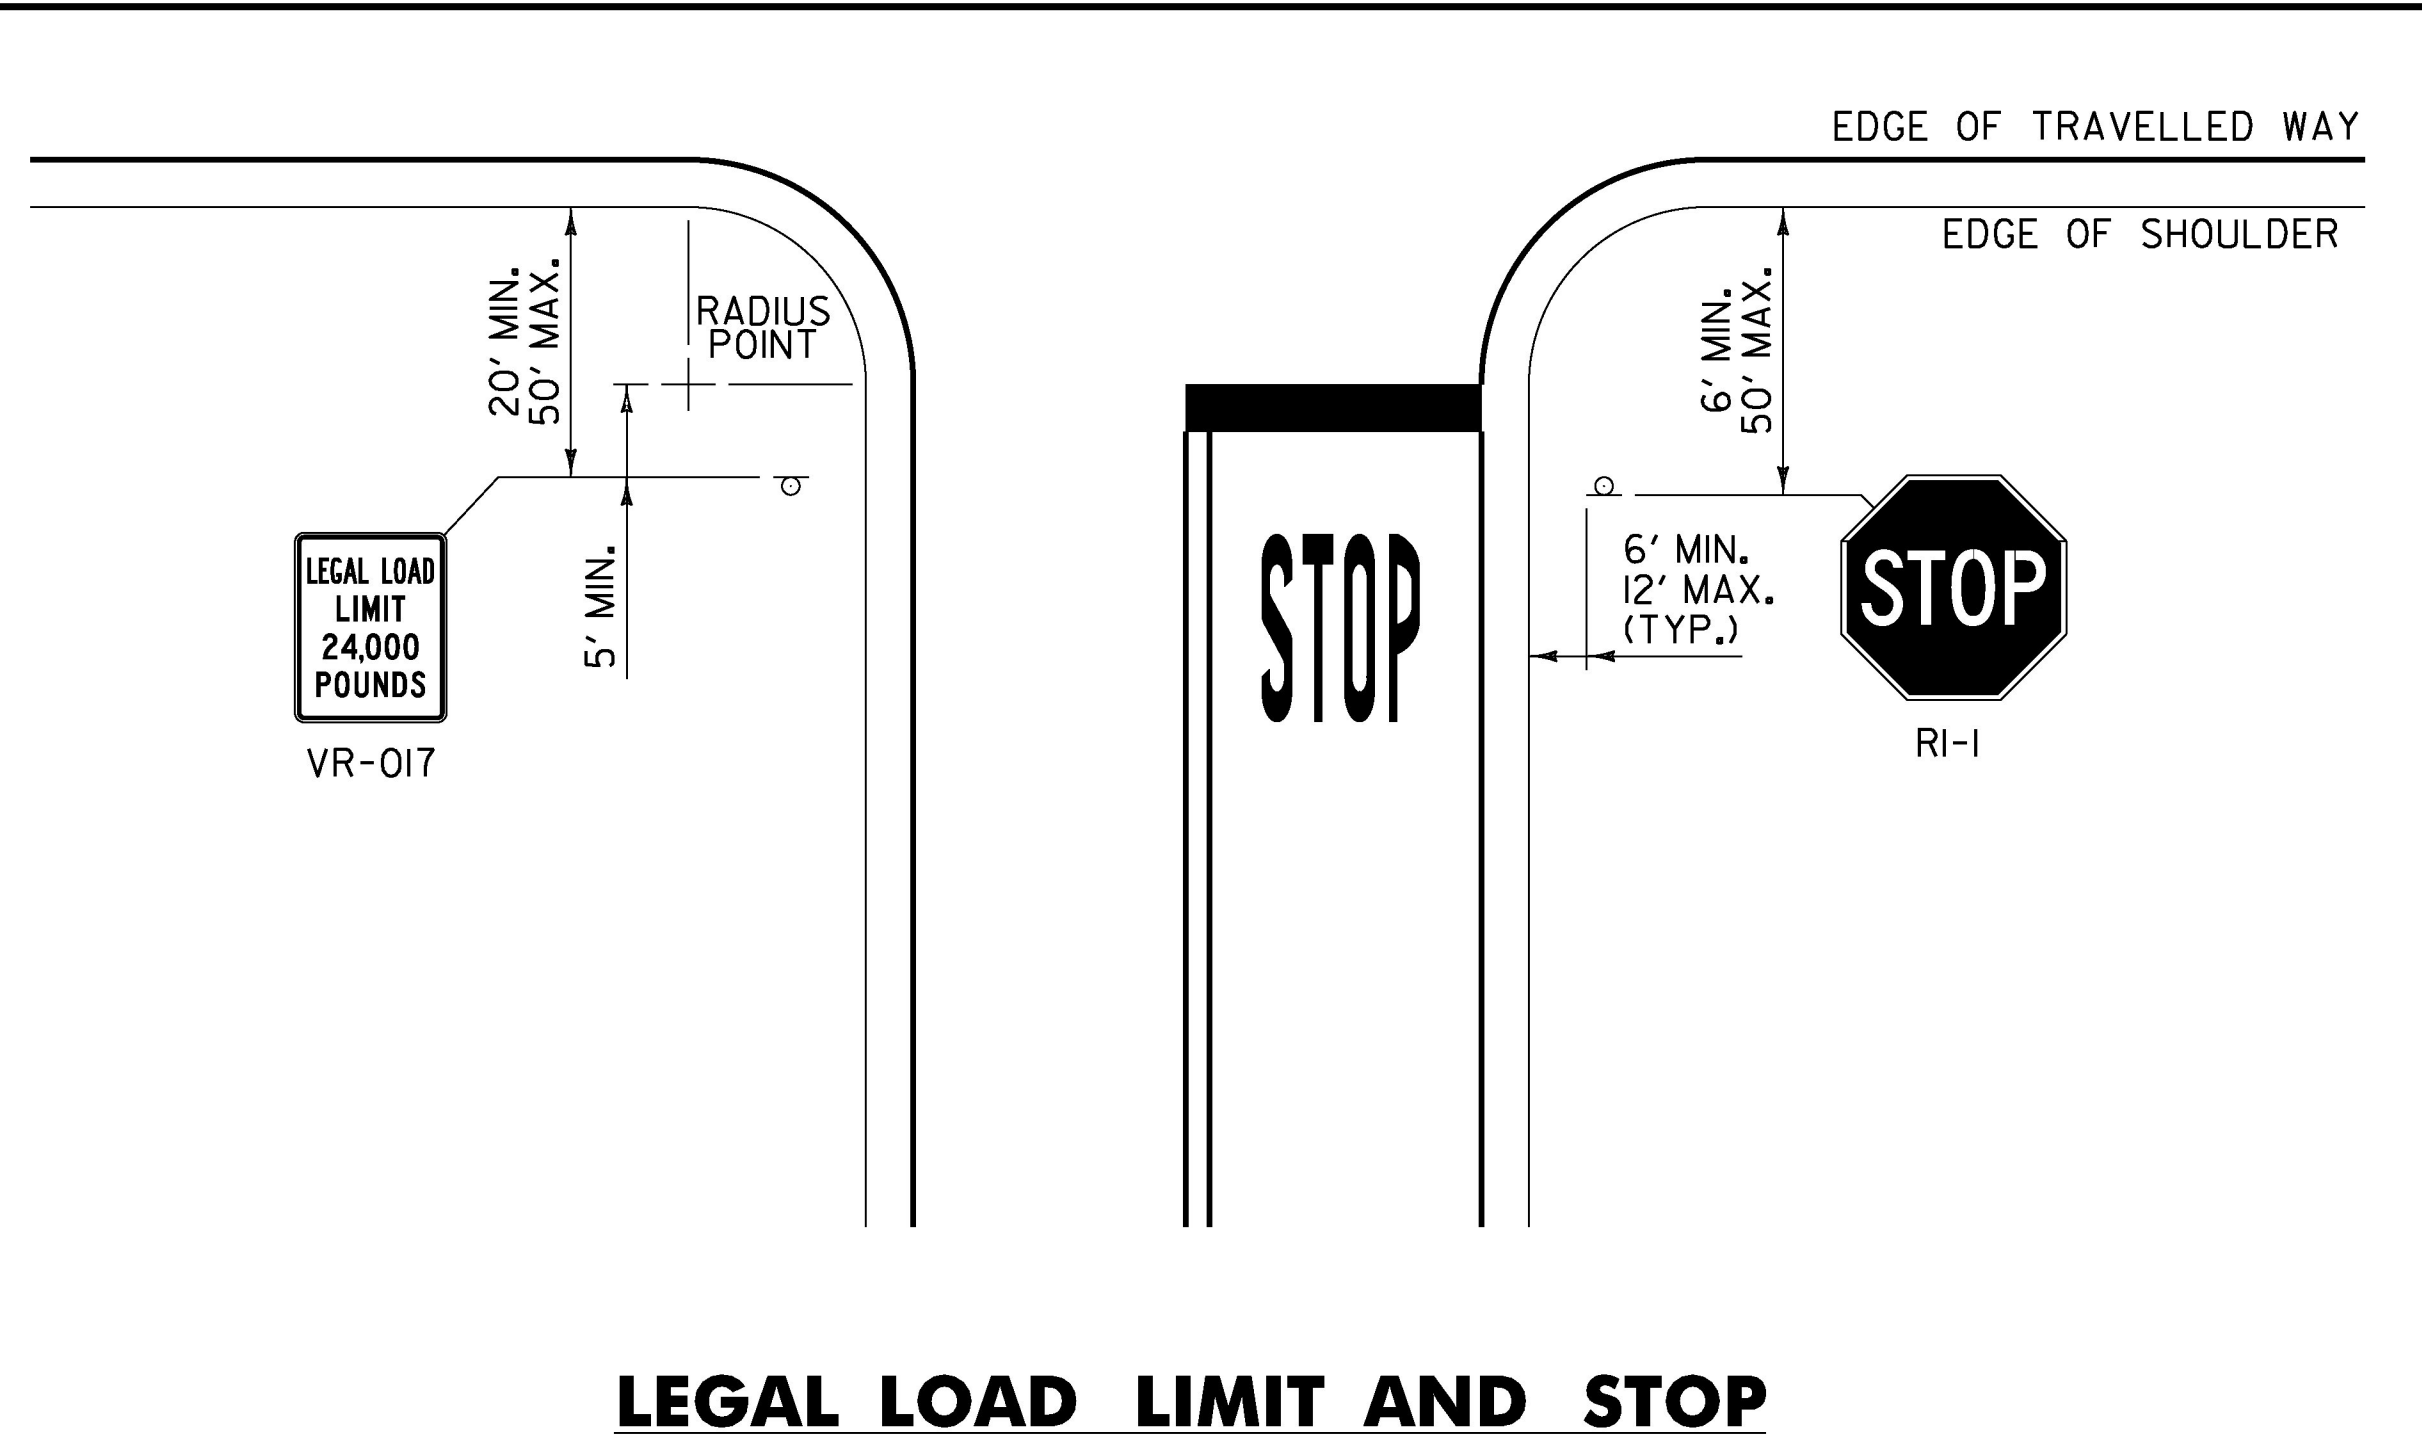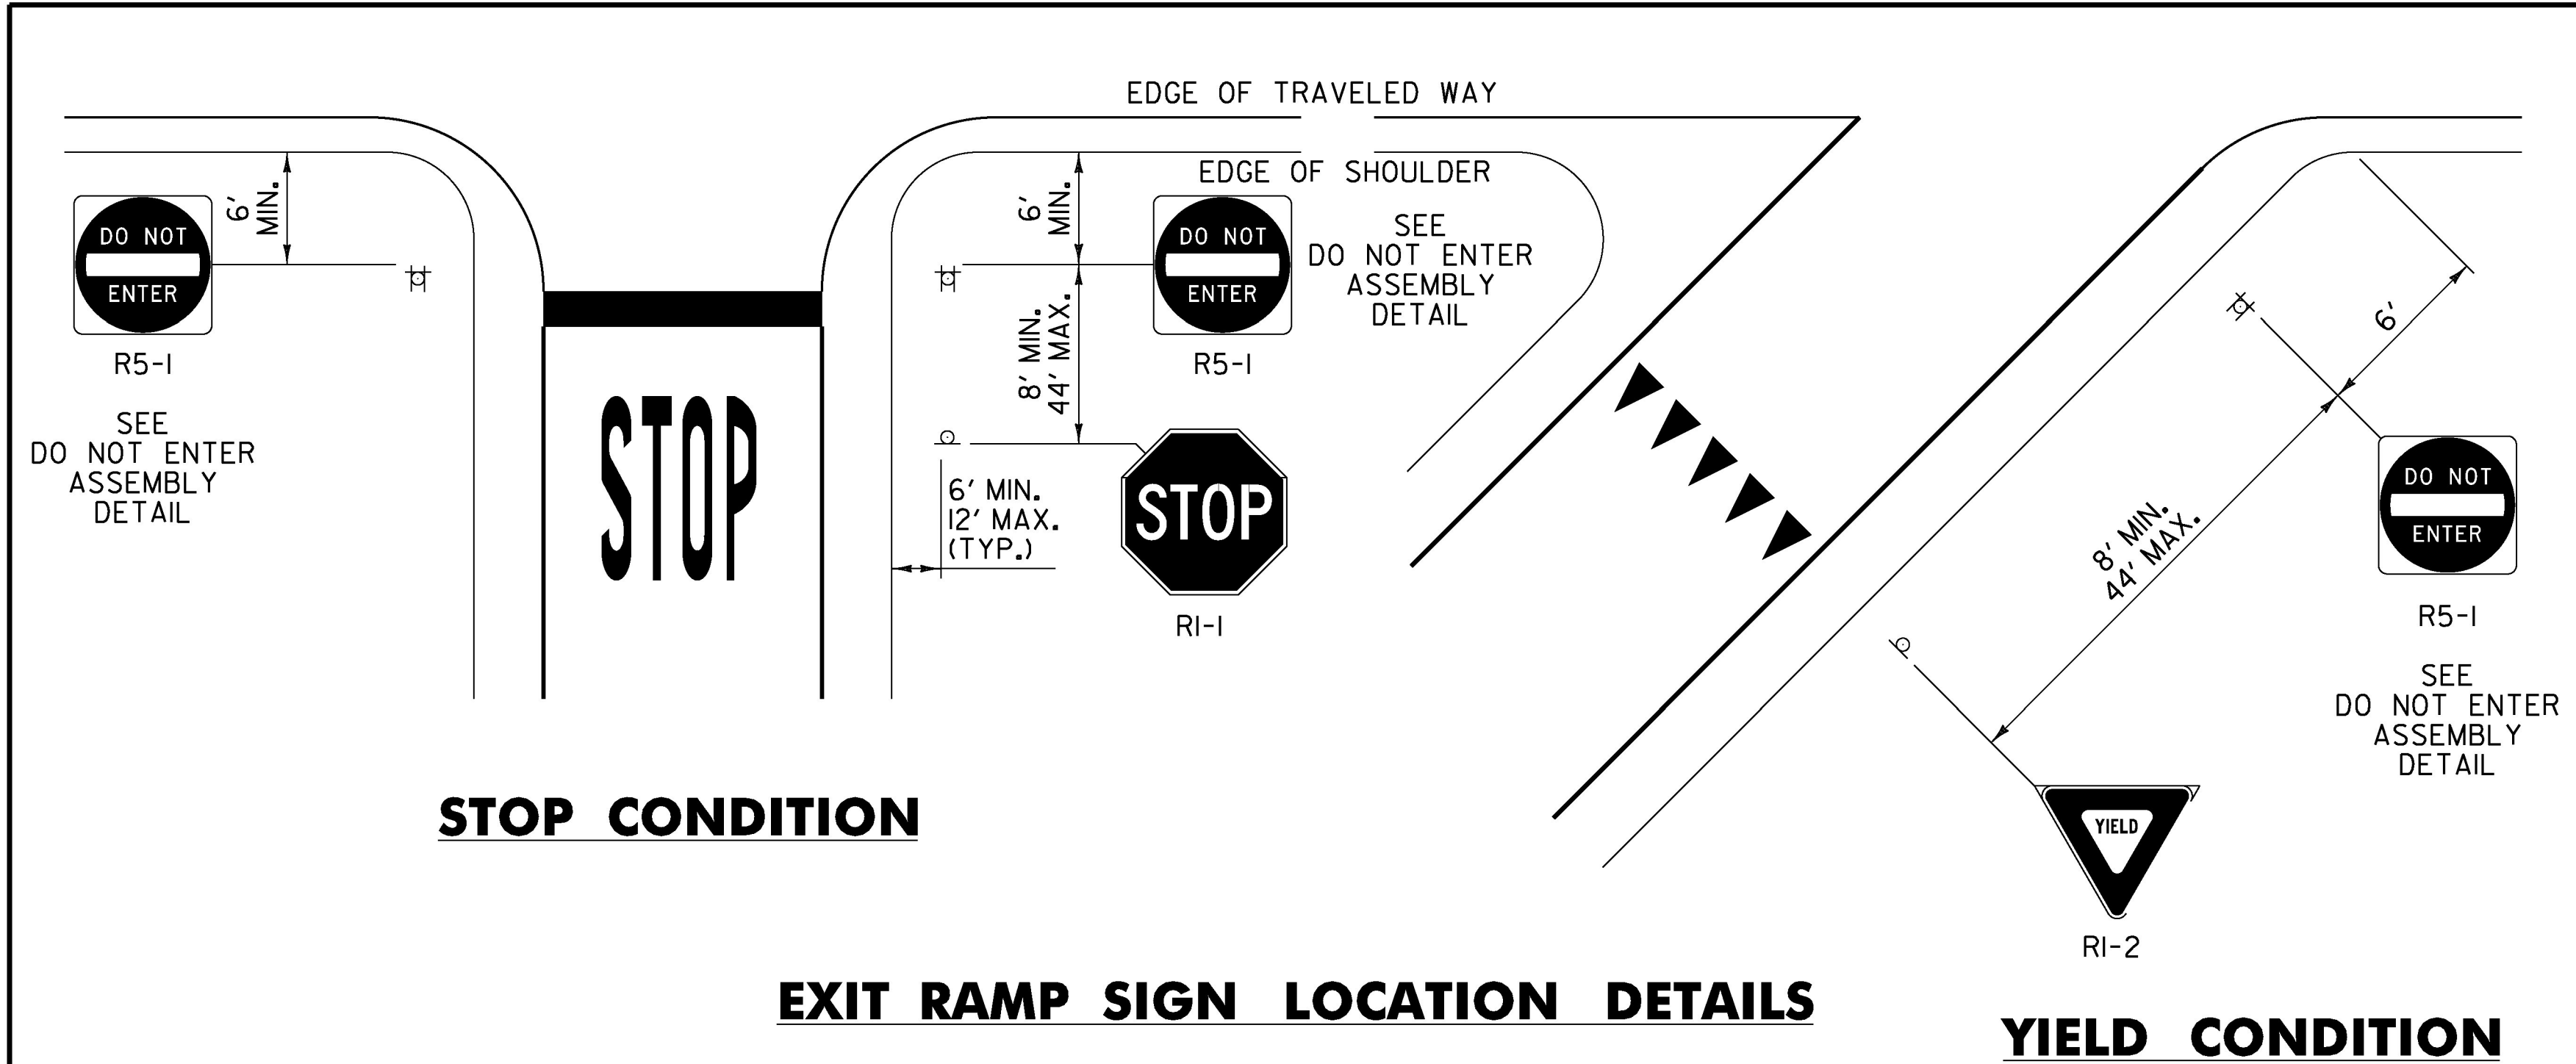


**NOTES:**

1. THE "STOP" (RI-1) SIGN SHOULD BE PLACED AS NEAR TO THE STOP BAR AS PRACTICAL. THE SIGN SHOULD BE PLACED TO MAXIMIZE VISIBILITY WITHIN THE RANGE OF OFFSETS SHOWN.
2. THE "YIELD" (RI-2) SIGN SHOULD BE PLACED AS NEAR TO THE YIELD MARKINGS AS PRACTICAL. THE SIGN SHOULD BE PLACED TO MAXIMIZE VISIBILITY WITHIN THE RANGE OF OFFSETS SHOWN.

**NOTES:**

1. THE "STOP" (RI-1) SIGN SHOULD BE PLACED AS NEAR TO THE STOP BAR AS PRACTICAL. THE SIGN SHOULD BE PLACED TO MAXIMIZE VISIBILITY WITHIN THE RANGE OF OFFSETS SHOWN.

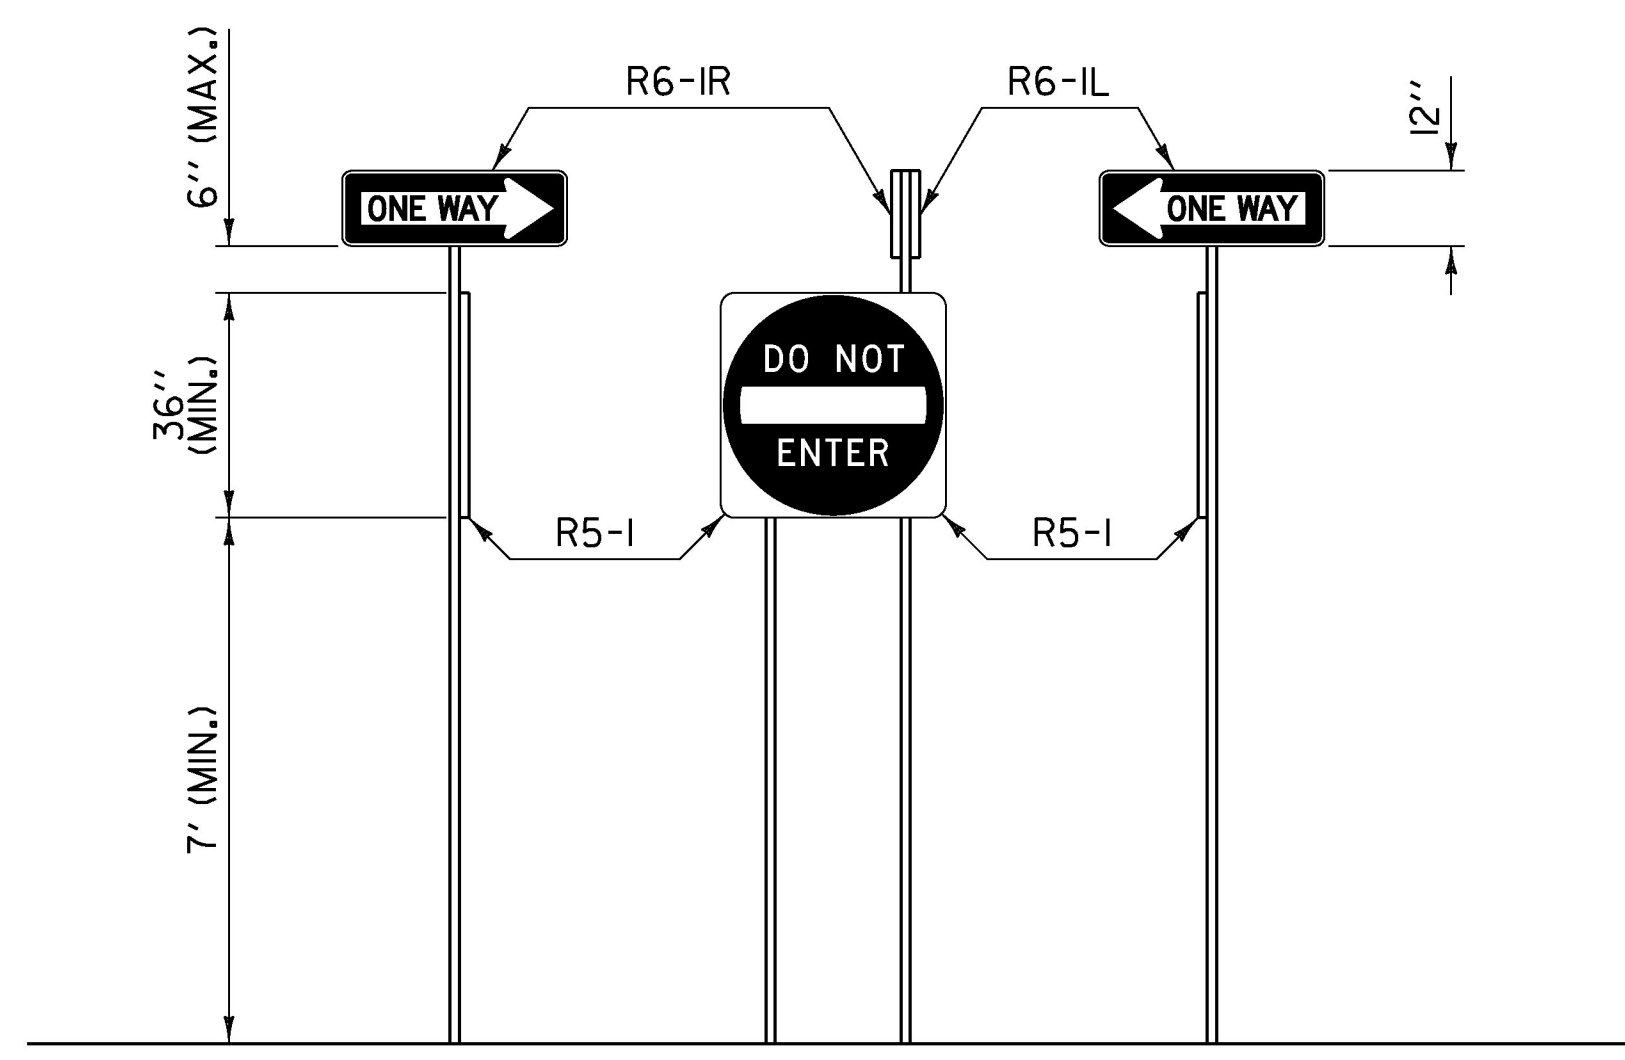

**GENERAL NOTES:**

1. WHEN INSTALLED, STREET NAME SIGNS SHOULD BE INSTALLED PERPENDICULAR TO APPROACHING MAINLINE TRAFFIC AND SHALL BE POSITIONED IN SUCH A WAY AS TO ENSURE THE BEST POSSIBLE VISIBILITY TO APPROACHING MAINLINE TRAFFIC FROM EACH DIRECTION. STREET NAME SIGNS MAY BE INSTALLED ABOVE SIDE ROAD STOP SIGN. IN CASES WHERE THE SIDE ROAD STOP SIGN POSITION WOULD NOT BE SUITABLE FOR A TOP-MOUNTED STREET NAME SIGN, OR OTHER SITE-SPECIFIC CONSTRAINTS, THE STREET NAME SIGN MAY BE INSTALLED INDEPENDENTLY ON EITHER CORNER OF THE INTERSECTION. THE STREET NAME SIGNS SHALL BE INSTALLED A MINIMUM OF SIX FEET FROM EDGE OF PAVEMENT ON THE MAINLINE ROUTE TO THE NEAREST EDGE OF SIGN.
2. STREET NAME SIGNS WITH A LENGTH EXCEEDING 42 INCHES SHALL BE INSTALLED ON TWO POSTS. NO MORE THAN TWO POSTS SHALL OCCUPY AN EIGHT FOOT TRAVEL PATH, UNLESS PROTECTED BY BARRIER.
3. THE "STOP" (RI-1) SIGN SHALL NOT BE MOUNTED LESS THAN FIVE FEET IN HEIGHT TO THE BOTTOM OF THE SIGN.

REV.	DATE	DESCRIPTION
0	OCT. 26, 2015	ORIGINAL APPROVAL
OTHER STANDARDS REQUIRED: NONE		
VTRANS AND FHWA APPROVAL ON FILE WITH CONTRACT ADMINISTRATION		

**STANDARD SIGN PLACEMENT**



**STANDARD  
T-56**

APPROVED: Approval of drawings and/or procedures indicates concurrence with the information presented and does not relieve the Contractor or Fabricator of compliance with all specifications and code requirements

APPROVED AS NOTED

REVISE AND RESUBMIT

NOT REVIEWED


Date: 8/23/16

By: George Bogue


This review by Stantec Consulting Services Inc. is for the sole purpose of ascertaining conformance with the general design concept. This review shall not mean that Stantec Consulting Services Inc. approves the detail design inherent in the shop drawings, responsibility for which shall remain with the Contractor. Submitting same, and such review shall not relieve the Contractor of his responsibility for errors or omissions in the shop drawing or of his responsibility for meeting all requirements of the Contract Documents. The contractor is responsible for dimensions to be confirmed and correlated at the job site, for information that pertains solely to the fabrication processes or to techniques of construction and installation and for coordination of the work of all subtrades.




BILL OF MATERIALS				
QTY	MARK	SHAPE	LENGTH	REMARKS
1	1R1	BRIDGE RAIL ASSEMBLY		
16	1a1	L 4 x 3 x 1/4	7'-10 1/2"	
16	1a2	L 4 x 3 x 1/4	7'-10 1/2"	
16	1b1	Bar 1/4 x 4	6'-9 1/2"	
16	2w1	W6 x 9	1'-2"	
16	2a4	L 3 1/2 x 3 x 1/4	0'-8"	
16	2A1	ANCHOR ASSEMBLY		
14	2B1	BASE ASSEMBLY		
2	2B2	BASE ASSEMBLY		
10	3R1	BRIDGE RAIL		
2	3R2	BRIDGE RAIL		
2	3R3	BRIDGE RAIL		
96		5/8" Hex Head Bolt x 1 1/2" lg with Nut and Washer		
240		5/8" Hex Head Bolt x 1 1/2" lg with Nut and Washer		

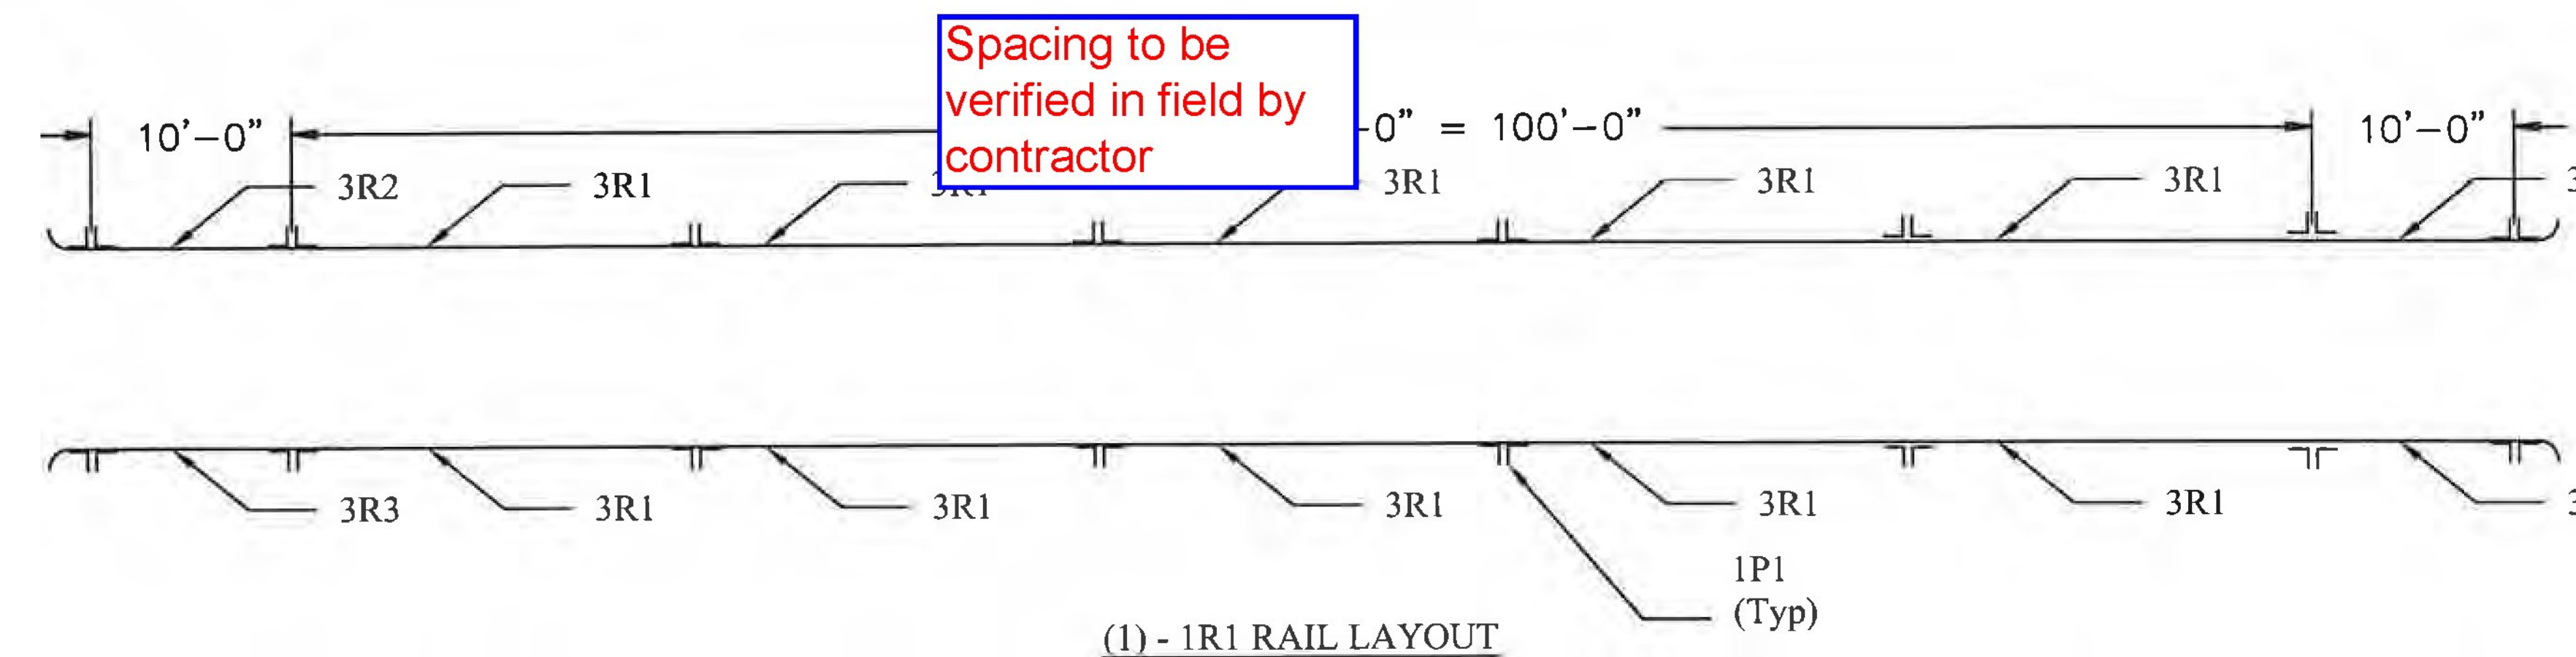


Vermont Agency of Transportation  
**RECEIVED**  
 ON: September 13, 2016  
 and Checked for  
**CONFORMANCE**  
 BY: Mark Sargent DATE: 09/13/2016

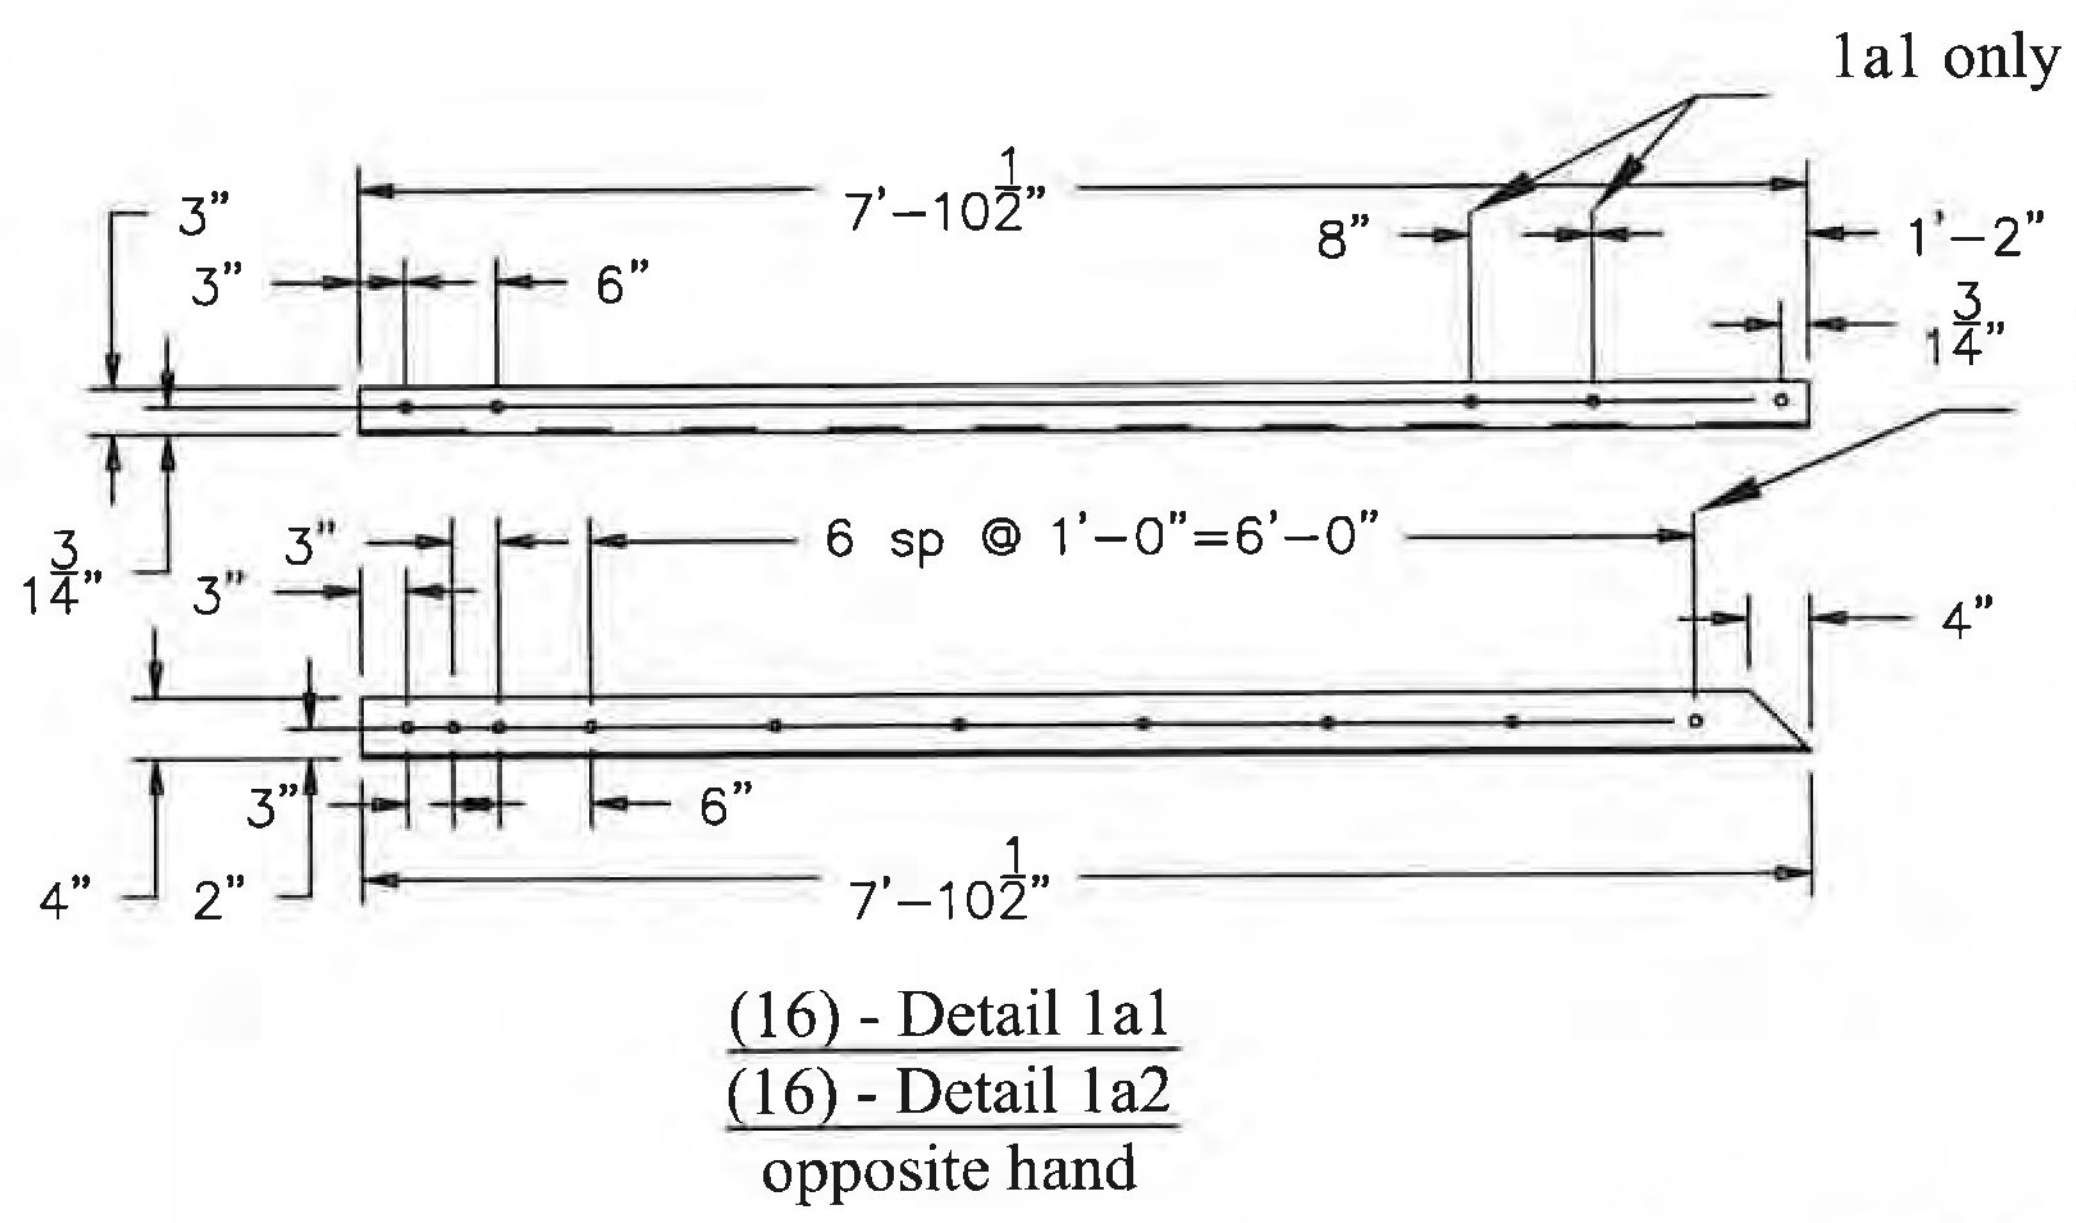




(16) - Detail 1a1  
 (16) - Detail 1a2  
 opposite hand

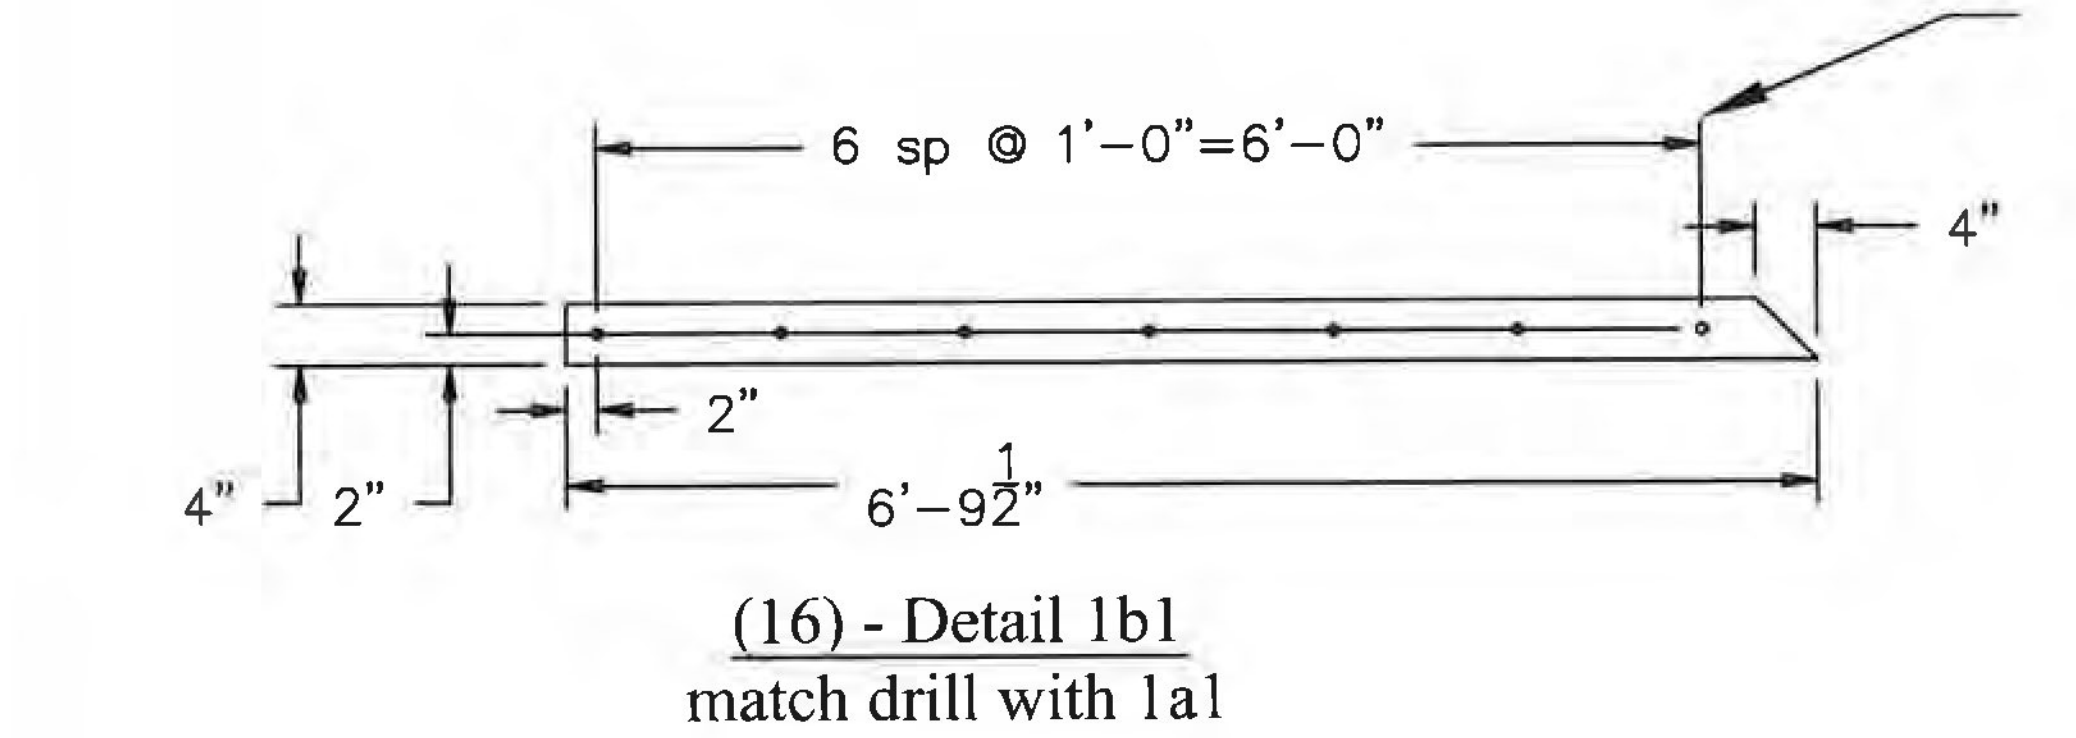

(16) - Detail 1b1  
 match drill with 1a1

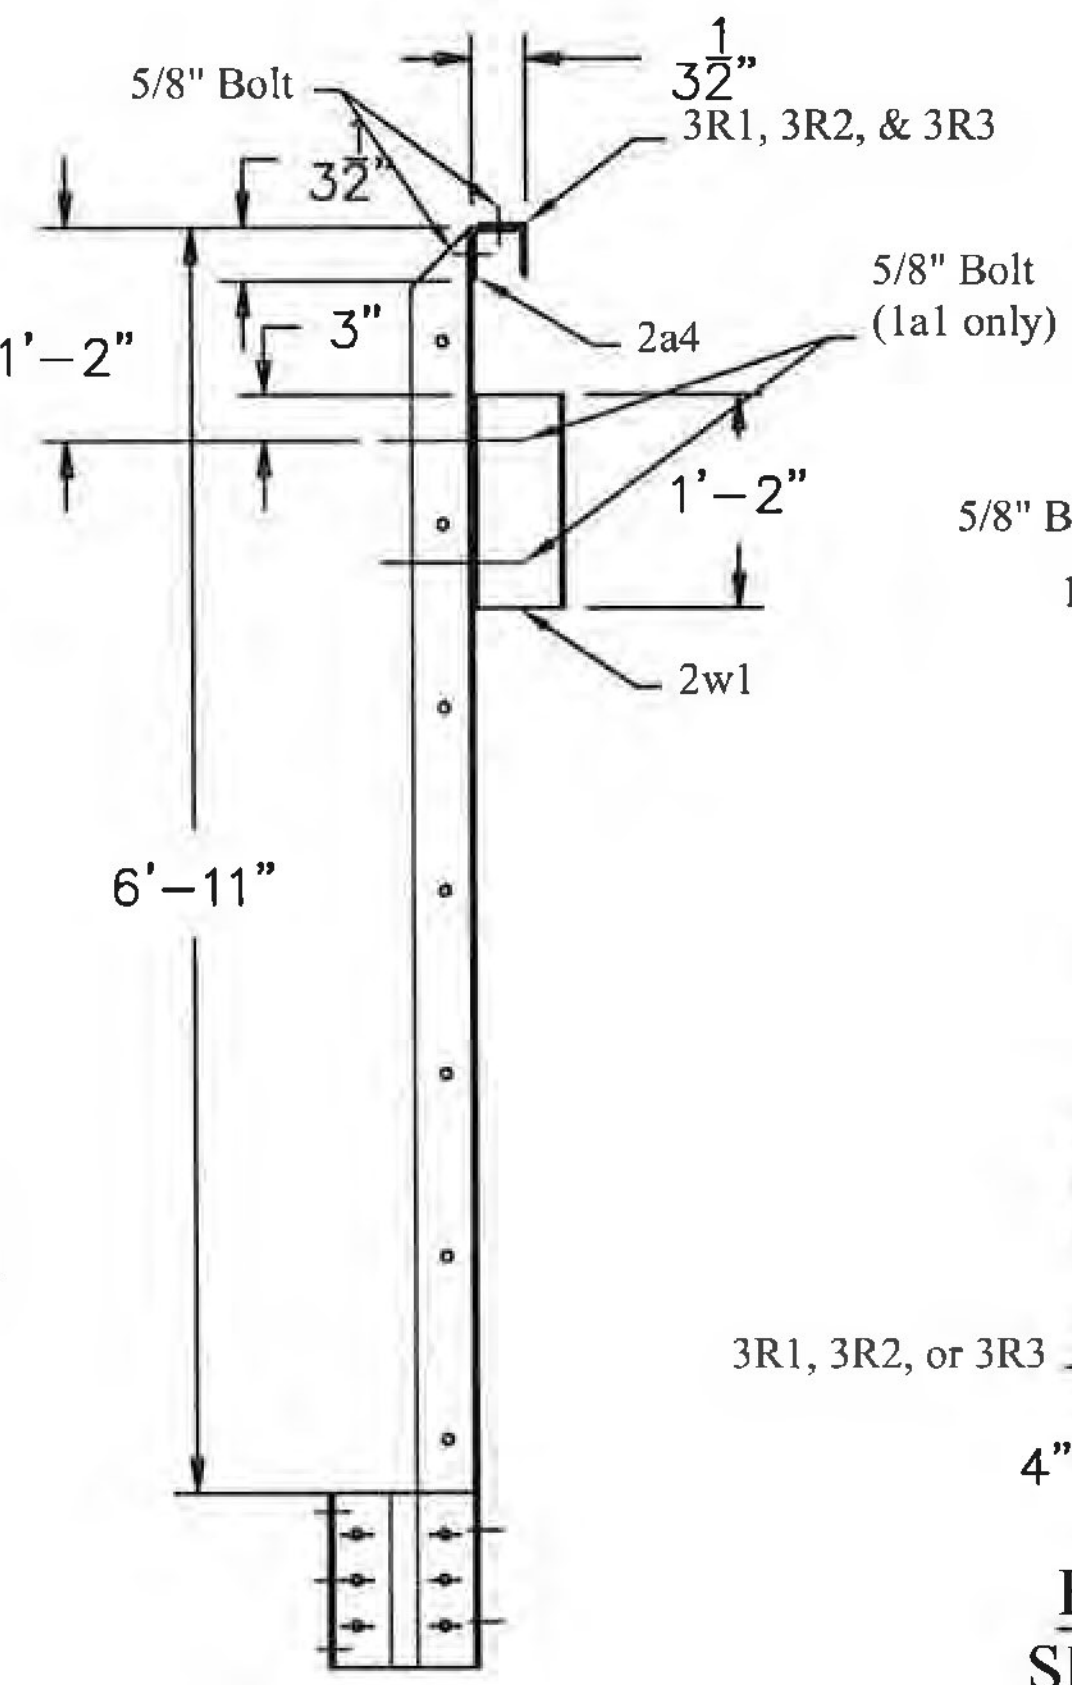

(16) - POST ASSEMBLY

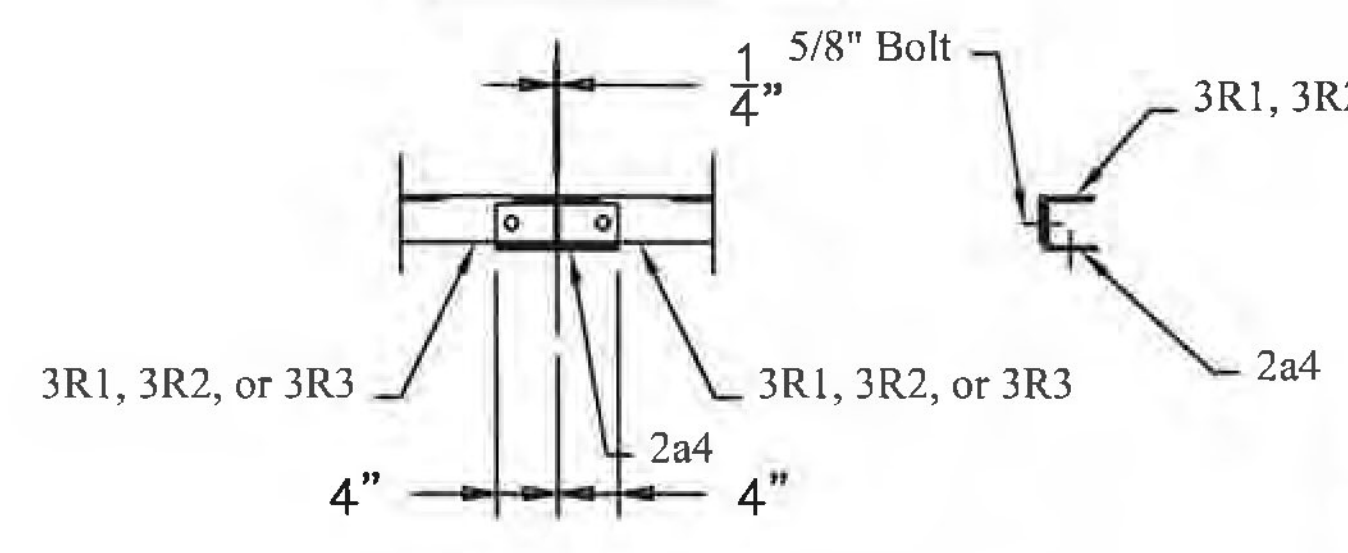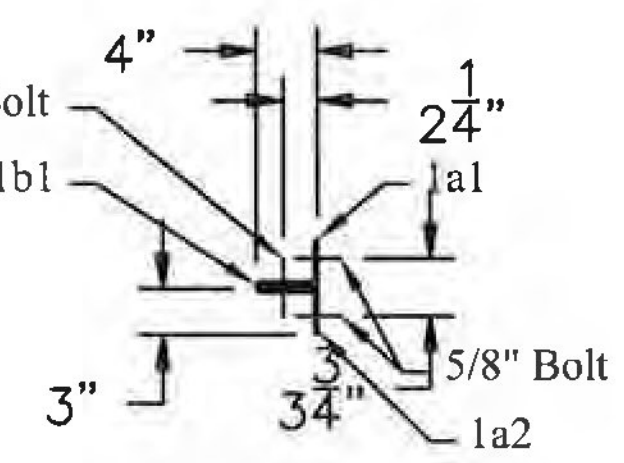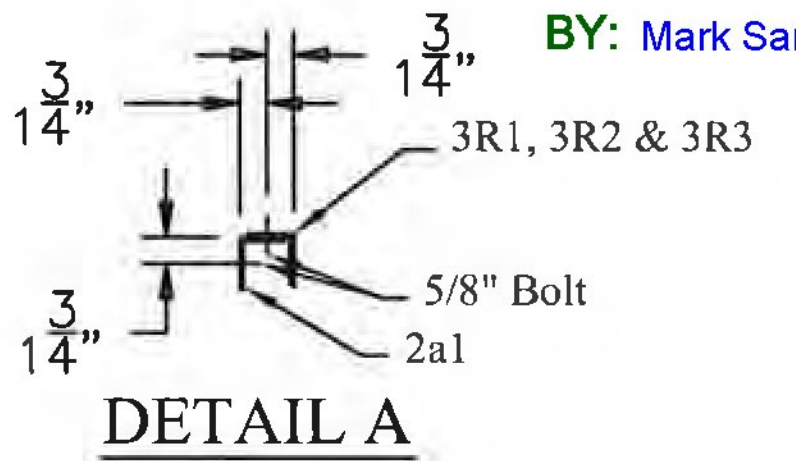

BRIDGE RAIL  
 SPLICE DETAIL

**BRIDGE RAIL NOTES**

- ALL STRUCTURAL STEEL SHALL CONFORM TO AASHTO M 270/M 270 GRADE 36, PRIMED, SHERMAN WILLIAMS - ZINC CLAD III. BLAST CLEAN PER SSPC-SP10.
- REPLACEMENT OF BRIDGE RAIL POSTS WILL BE PAID UNDER ITEM 506.60.
- ALL HIGH STRENGTH 7/8" HEX HEAD BOLTS, NUTS AND WASHERS SHALL BE IN ACCORDANCE WITH AASHTO M-164 TYPE 1 GALVANIZED


DRAWING COVERS	
PROJECT	MORRISTOWN BF 0239(3)
LOCATION	CADYS FALLS ROAD over LAMOILLE RIVER
ENGINEER	VERMONT AGENCY OF TRANSPORTATION
CUSTOMER	BLOW & COTE, INC.

**MERRIMACK SHEET METAL**


119 HALL STREET  
 CONCORD NH 03301  
 Tel. 603.224.7766  
 Fax 603.224.7925

DRAWN BY: RL  
 CHECKED BY: JD  
 JOB NO: #6669  
 DWG: F1R

REV NO.	DATE	DESCRIPTION
0	8-10-2016	SUBMITTED FOR APPROVAL
HOLES AS NOTED		
MATERIAL: AASHTO M 270 GRADE 36 PAINTED		

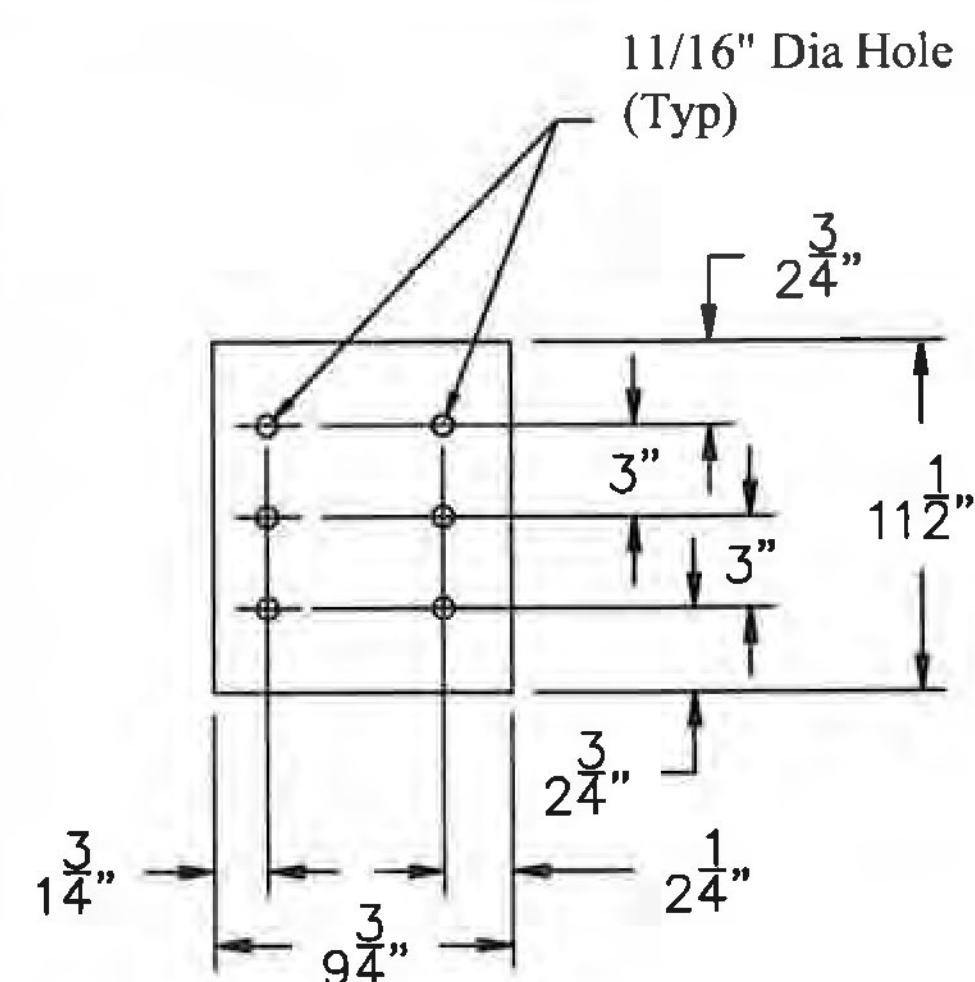

(12) - DETAIL 2p2

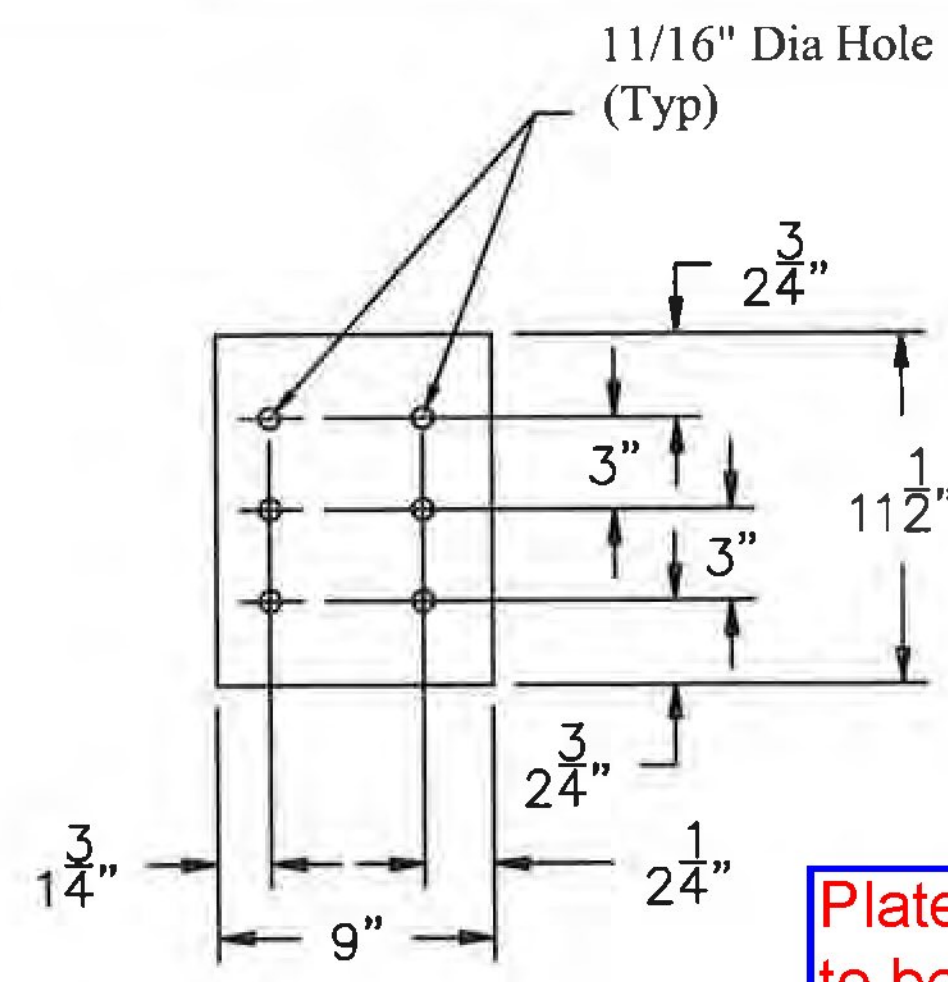

(2) - DETAIL 2p3

Plate dimensions to be verified in field by contractor


Vermont Agency of Transportation  
**RECEIVED**  
 ON: September 13, 2016  
 and Checked for  
**CONFORMANCE**  
 BY: Mark Sargent DATE: 09/13/2016

APPROVED: Approval of drawings and/or procedures indicates concurrence with the information presented and does not relieve the Contractor or Fabricator of compliance with all specifications and code requirements	
APPROVED AS NOTED	x
REVISE AND RESUBMIT	
NOT REVIEWED	
Date: 8/23/16	
By: George Bogue	
<small>This review by Stantec Consulting Services Inc. is for the sole purpose of ascertaining conformance with the general design concept. This review shall not mean that Stantec Consulting Services Inc. approves the detail design inherent in the shop drawings, responsibility for which shall remain with the Contractor. Submitting same, and such review shall not relieve the Contractor of his responsibility for errors or omissions in the shop drawing or of his responsibility for meeting all requirements of the Contract Documents. The contractor is responsible for dimensions to be confirmed and correlated at the job site, for information that pertains solely to the fabrication processes or to techniques of construction and installation and for coordination of the work of all subtrades.</small>	




BILL OF MATERIALS				
QTY	MARK	SHAPE	LENGTH	REMARKS
12	2A1	ANCHOR ASSEMBLY		
12	2p1	Plate 7/8 x 6	1'-4"	
24		7/8" Threaded Anchor Rod x 12" Lg		with Nut and Washer
24		7/8" Threaded Rod x 8" Lg		with 3 Nuts and 2 Washers
14	2B1	BASE ASSEMBLY		
28	2a2	L 4 x 3 x 1/4	0'-11 1/2"	
14	2p2	Plate 1/4 x 9 3/4	0'-11 1/2"	
140		5/8" Bolt x 2" Lg with Washer & Nut		
2	2B2	BASE ASSEMBLY		
4	2a2	L 4 x 3 x 1/4	0'-11 1/2"	
2	2p3	Plate 1/4 x 9	0'-11 1/2"	
20		5/8" Bolt x 2" Lg with Washer & Nut		


Contractor to supply threaded rod anchor details with embedment length and ultimate bond strength

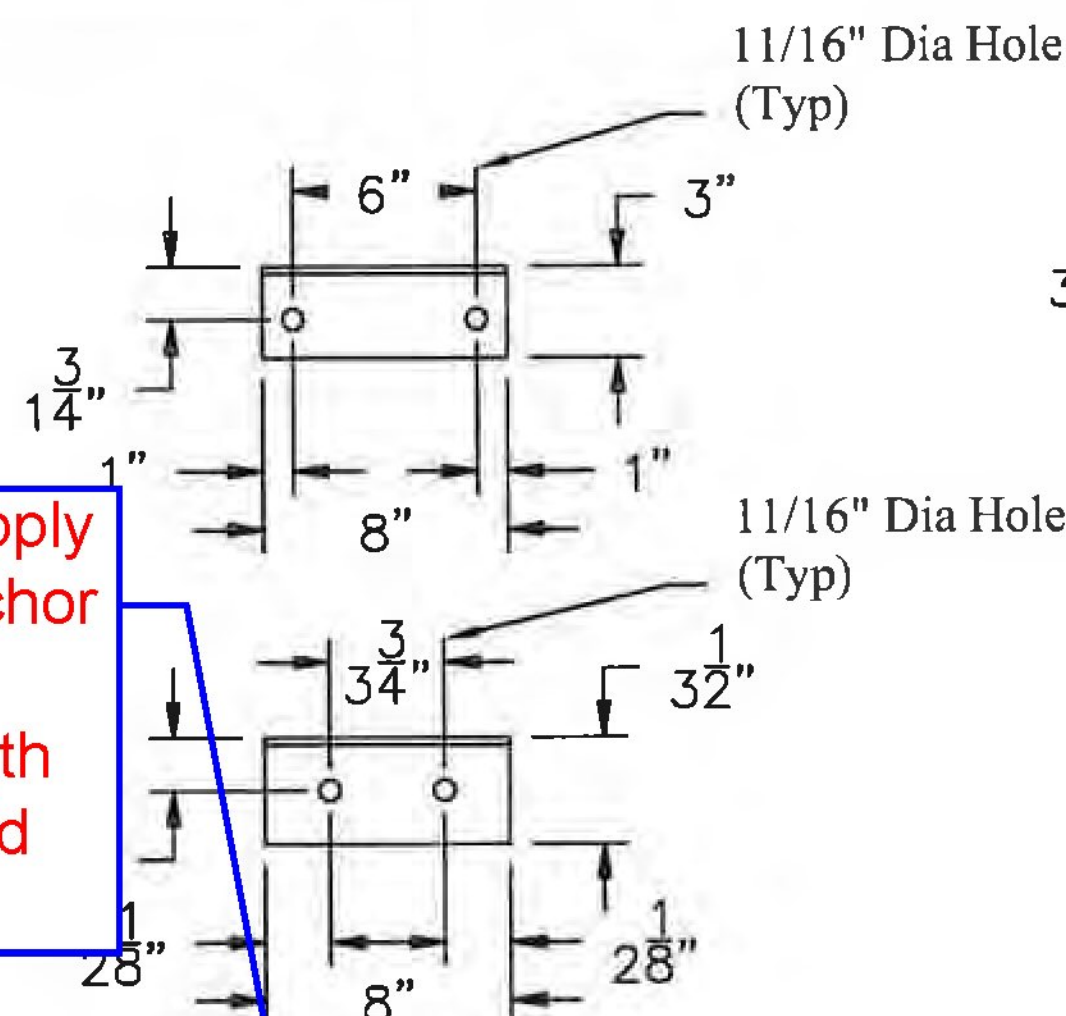


(16) - DETAIL 2a4

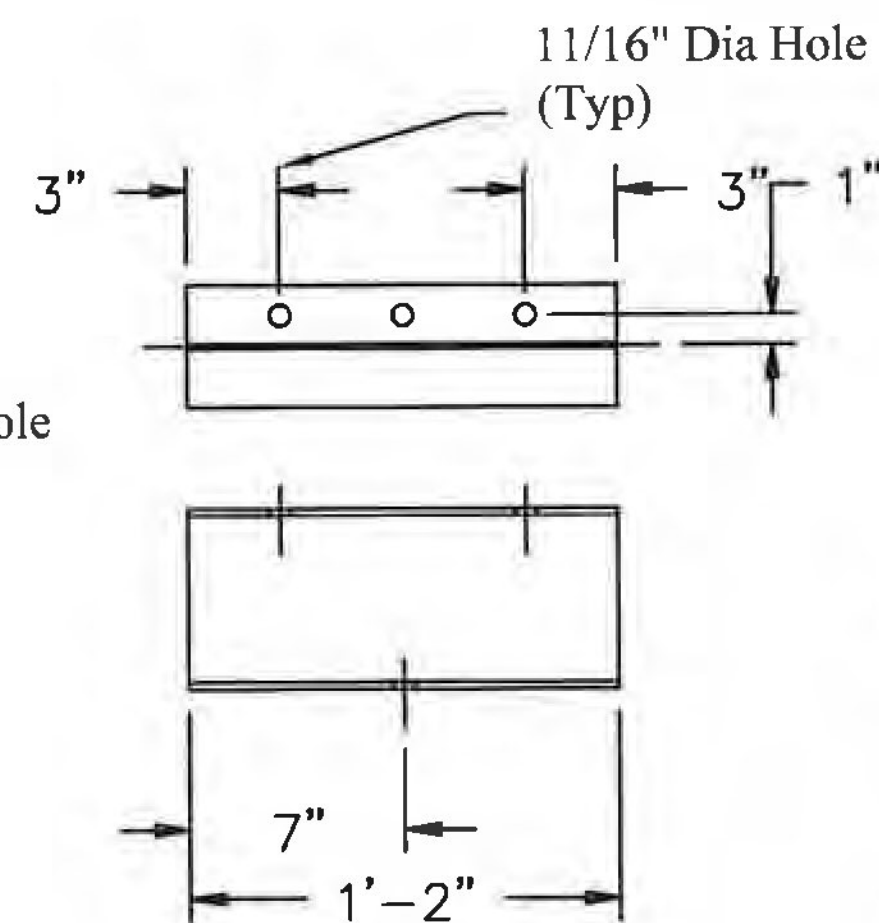


(16) - DETAIL 2w1

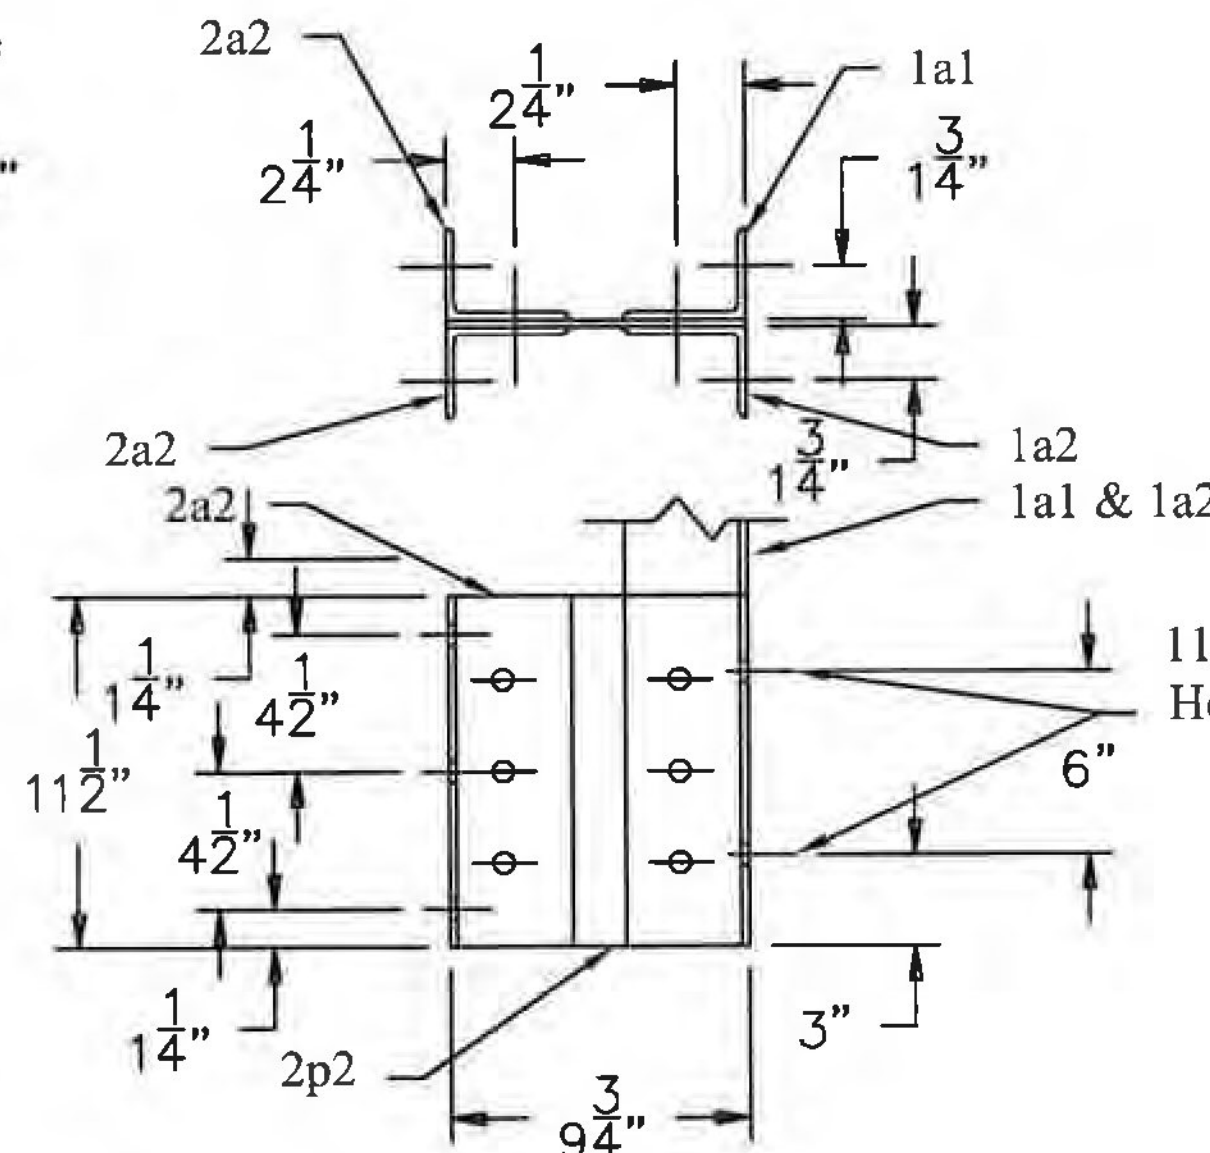


(14) - BASE ASSEMBLY 2B1

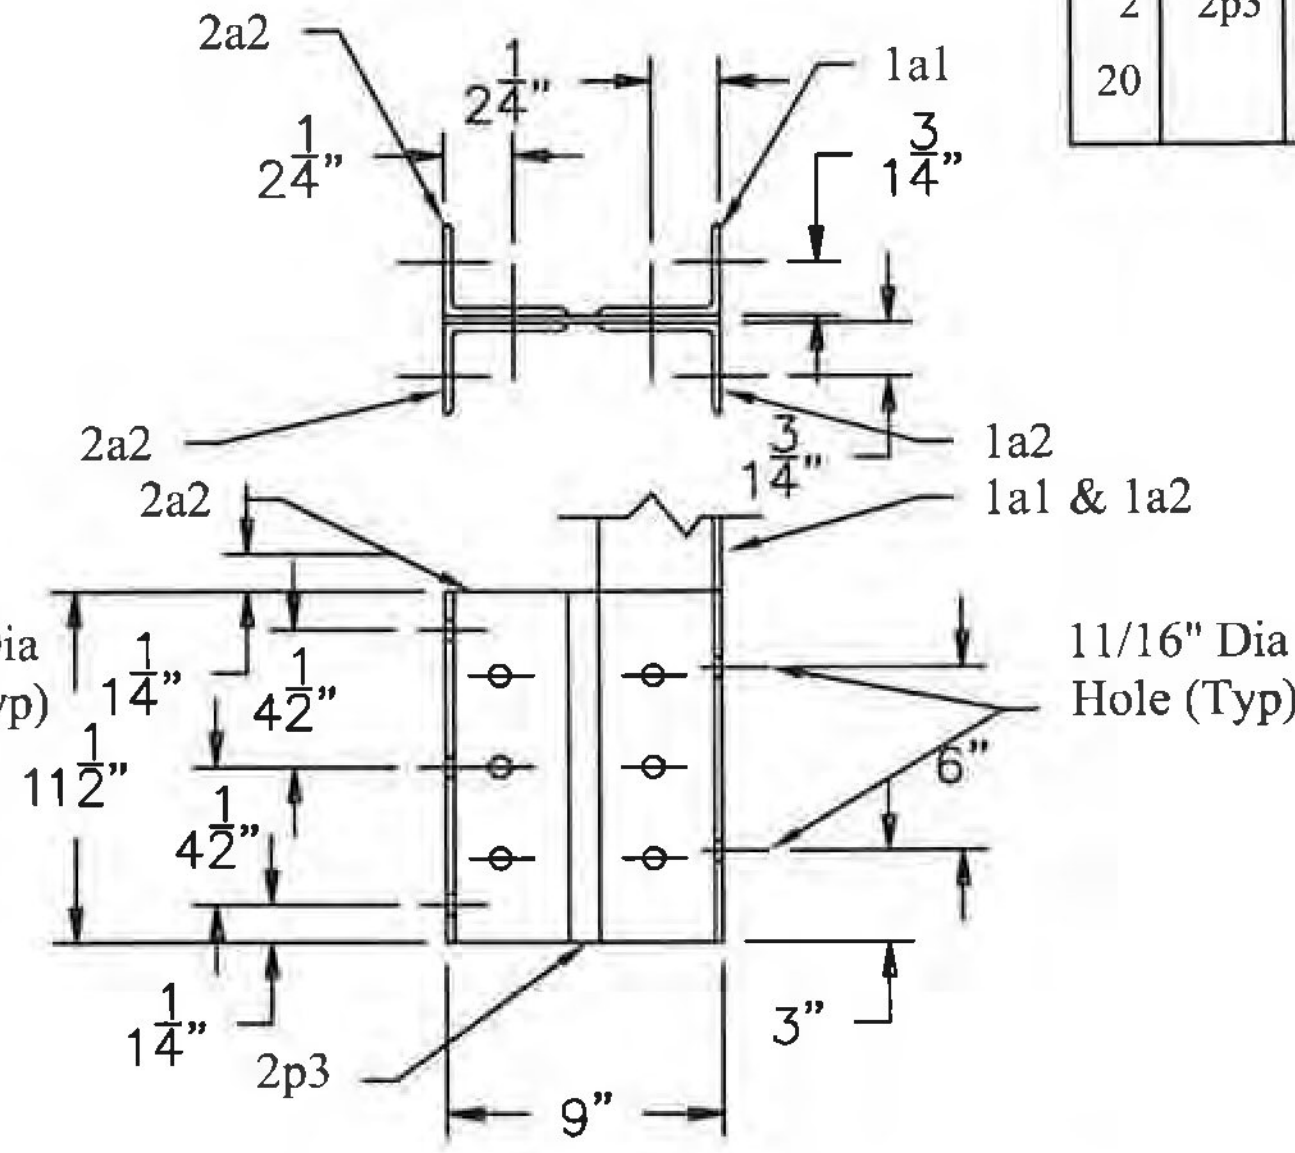


(2) - BASE ASSEMBLY 2B2

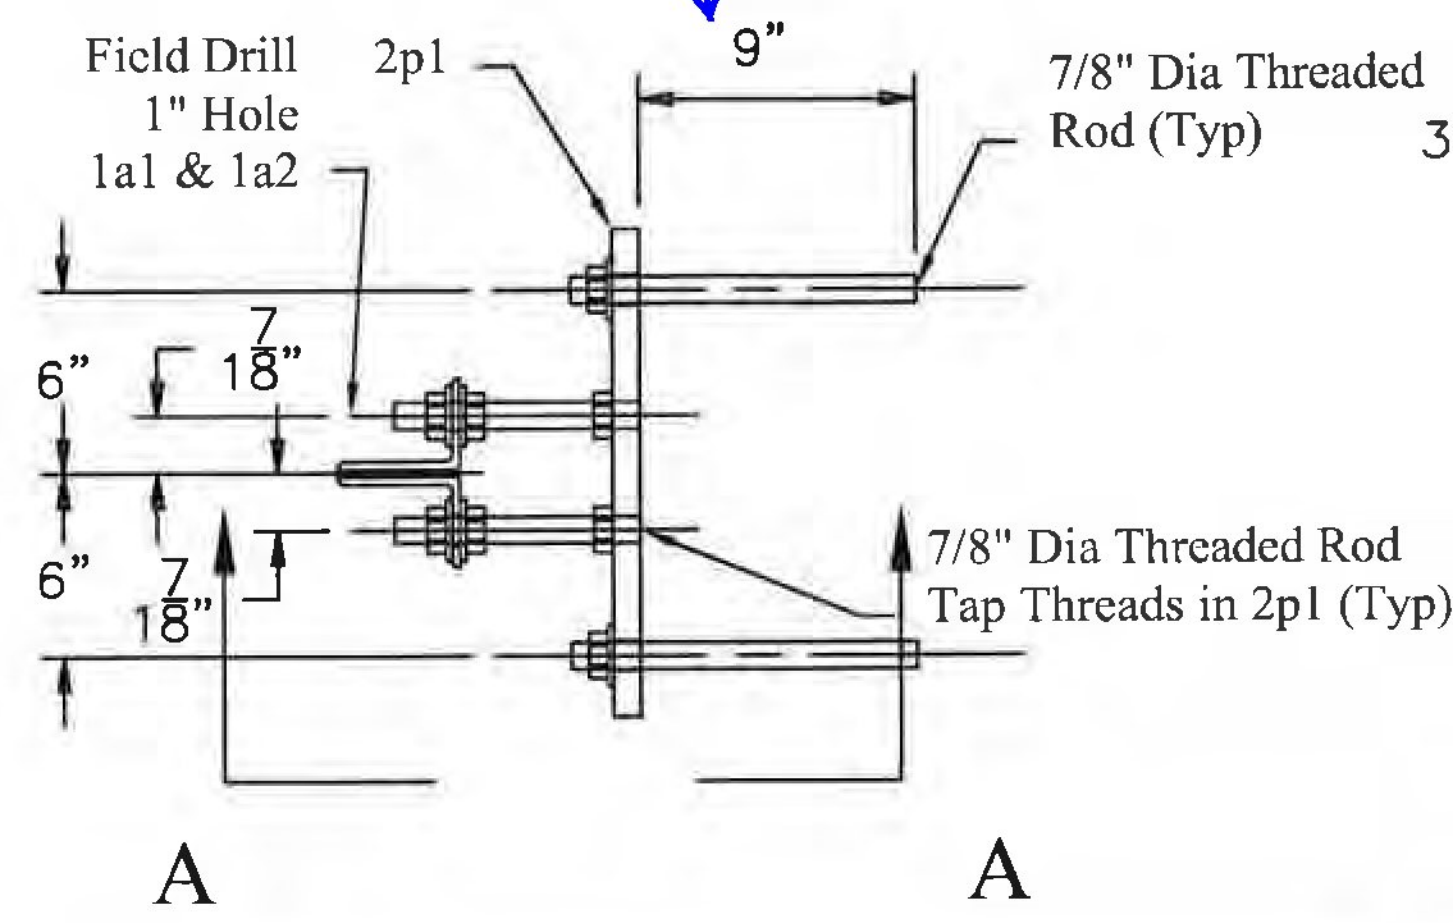

(12) - 2A1 - BRIDGE POST ANCHOR ASSY

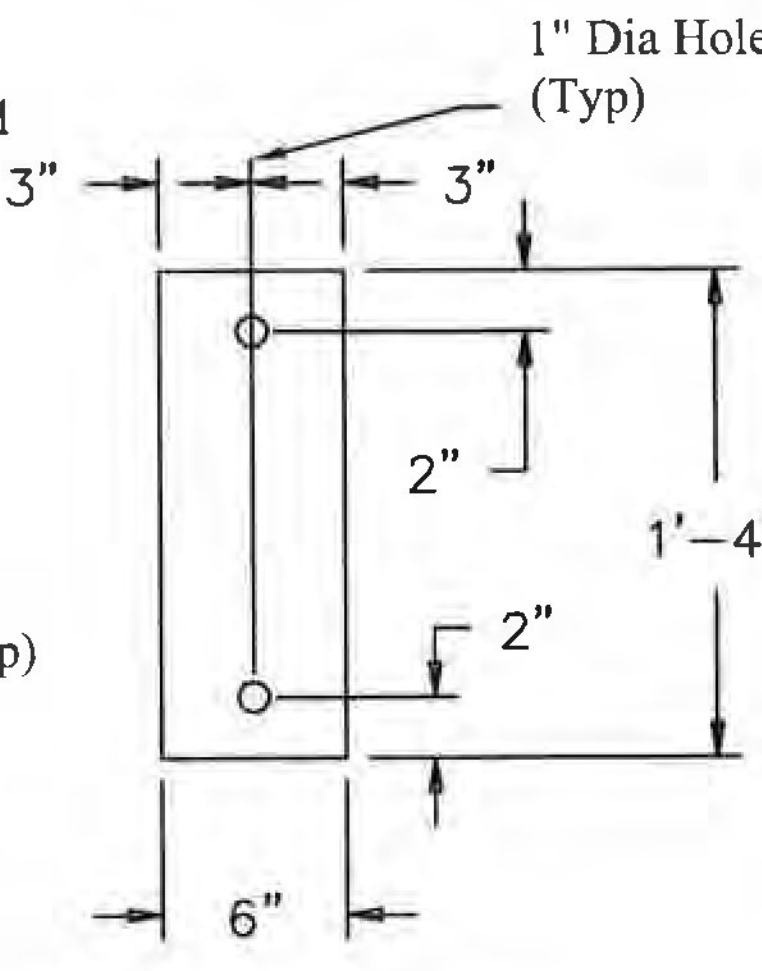

(12) - DETAIL 2p1 (Anchor Plate)

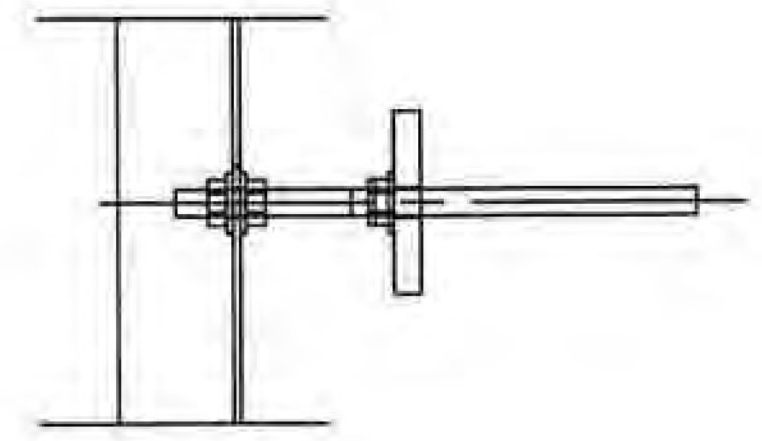

SECTION A-A

REV NO.	DATE	DESCRIPTION
0	8-10-2016	SUBMITTED FOR APPROVAL
		HOLES AS NOTED
		MATERIAL: AASHTO M 270 GRADE 36 PAINTED




DRAWING COVERS	
BRIDGE RAIL ASSEMBLY	
PROJECT	MORRISTOWN BF 0239(3)
LOCATION	CADYS FALLS ROAD over LAMOILLE RIVER
ENGINEER	VERMONT AGENCY OF TRANSPORTATION
CUSTOMER	BLOW & COTE, INC.

**MERRIMACK SHEET METAL**

119 HALL STREET  
 CONCORD NH 03301

Tel. 603.224.7766  
 Fax 603.224.7925

DRAWN BY: RL  
 CHECKED BY: JD  
 JOB NO: #6669  
 DWG: F2R

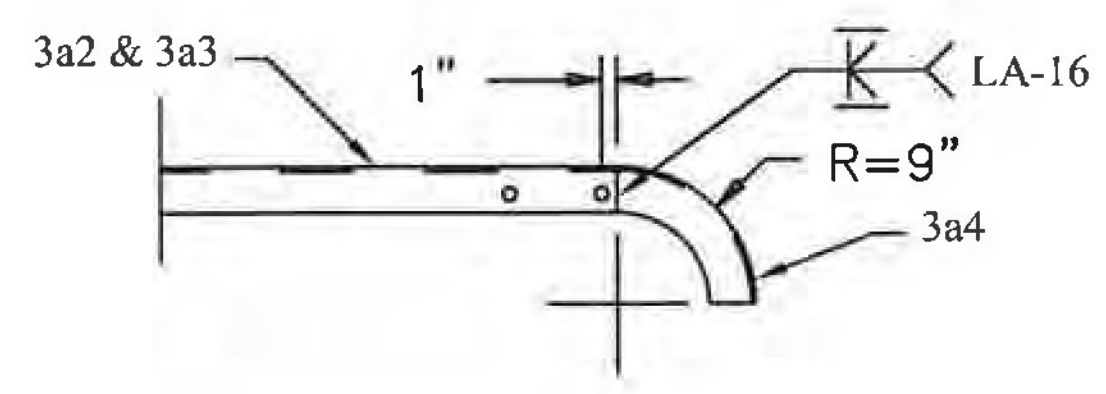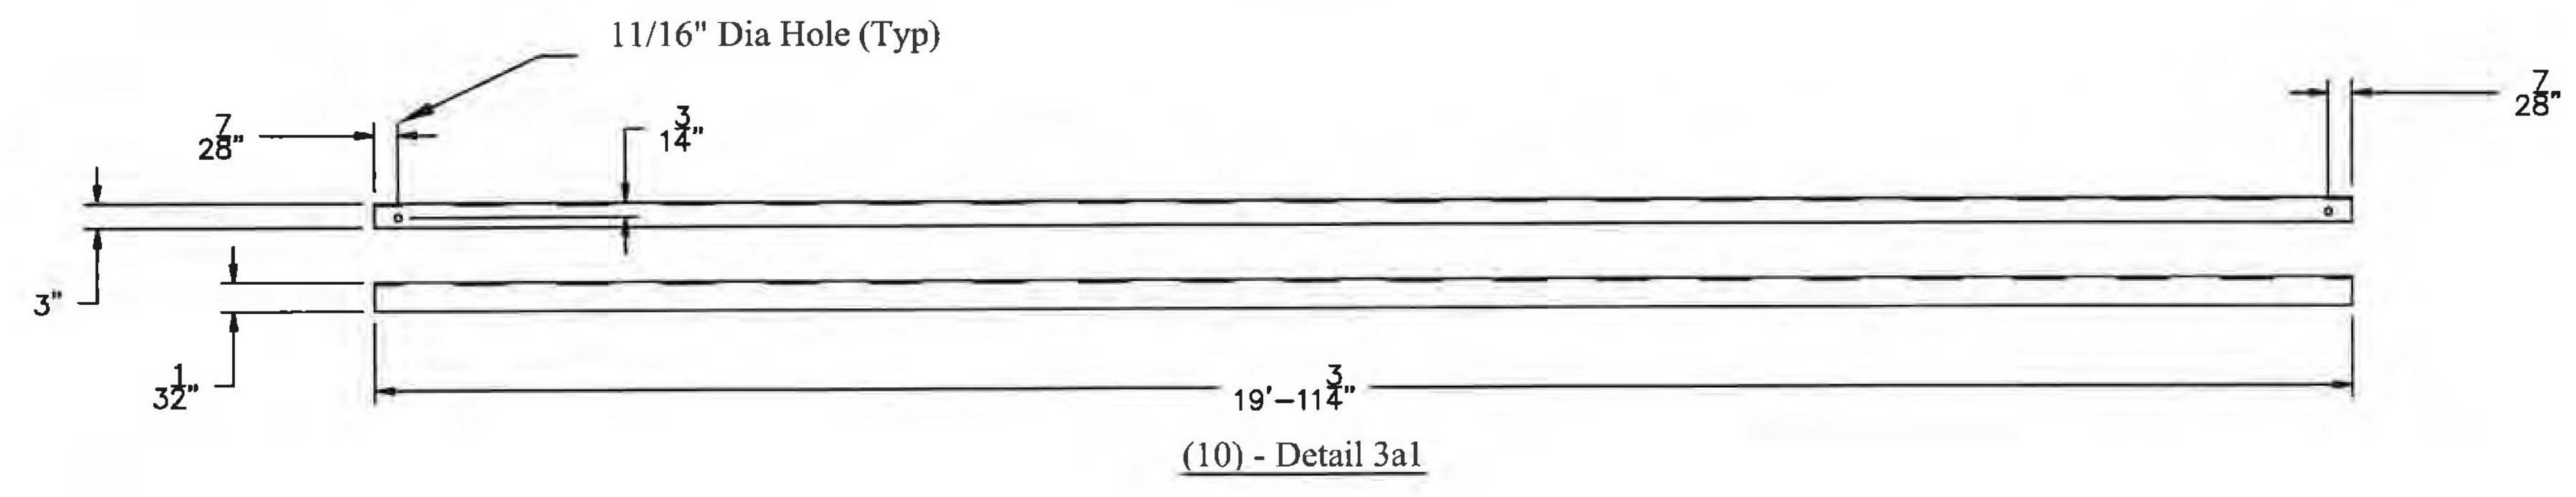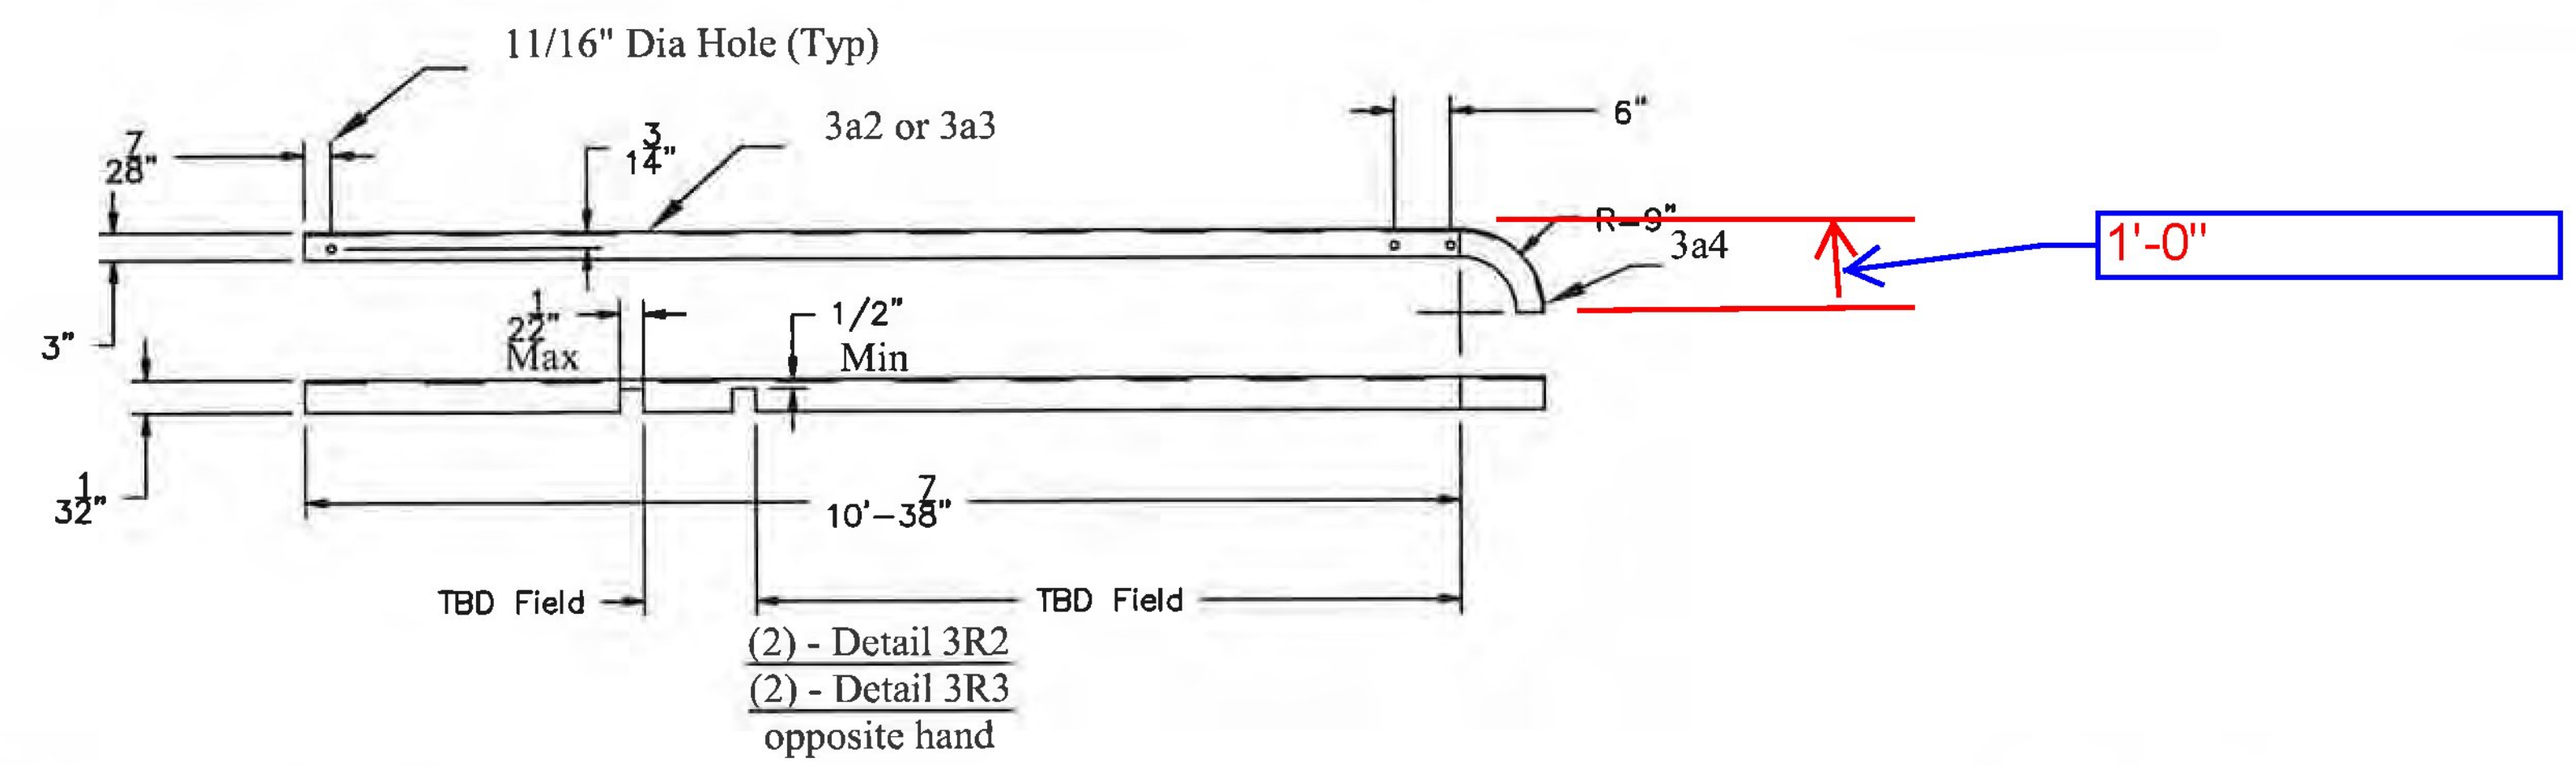

SPlice DETAIL

REV NO.	DATE	DESCRIPTION
0	8-10-2016	SUBMITTED FOR APPROVAL
HOLES AS NOTED		
MATERIAL: AASHTO M 270 GRADE 36 PAINTED		

BILL OF MATERIALS				
QTY	MARK	SHAPE	LENGTH	REMARKS
10	3R1	BRIDGE RAIL		
10	3a1	L 3 1/2 x 3 x 1/4	19'-11 3/4"	
2	3R2	BRIDGE RAIL, END		
2	3a2	L 3 1/2 x 3 x 1/4	10'-3 7/8"	
2	3a4	L 3 1/2 x 3 x 1/4	1'-2 1/4"	
2	3R3	BRIDGE RAIL, END		
2	3a3	L 3 1/2 x 3 x 1/4	10'-3 7/8"	
2	3a4	L 3 1/2 x 3 x 1/4	1'-2 1/4"	

APPROVED: Approval of drawings and/or procedures indicates concurrence with the information presented and does not relieve the Contractor or Fabricator of compliance with all specifications and code requirements		
APPROVED AS NOTED	X	
REVISE AND RESUBMIT		
NOT REVIEWED		
Date: 8/23/16		
By: George Bogue		
<small>This review by Stantec Consulting Services Inc. is for the sole purpose of ascertaining conformance with the general design concept. This review shall not mean that Stantec Consulting Services Inc approves the detail design inherent in the shop drawings, responsibility for which shall remain with the Contractor. Submitting same, and such review shall not relieve the Contractor of his responsibility for errors or omissions in the shop drawing or of his responsibility for meeting all requirements of the Contract Documents. The contractor is responsible for dimensions to be confirmed and correlated at the job site, for information that pertains solely to the fabrication processes or to techniques of construction and installation and for coordination of the work of all subtrades.</small>		

Vermont Agency of Transportation  
**RECEIVED**  
 ON: **September 13, 2016**  
 and Checked for  
**CONFORMANCE**  
 BY: **Mark Sargent** DATE: **09/13/2016**

DRAWING COVERS	
PROJECT	MORRISTOWN BF 0239(3)
LOCATION	CADYS FALLS ROAD over LAMOILLE RIVER
ENGINEER	VERMONT AGENCY OF TRANSPORTATION
CUSTOMER	BLOW & COTE, INC.

**MERRIMACK SHEET METAL**  
 119 HALL STREET  
 CONCORD NH 03301  
 Tel. 603.224.7766  
 Fax 603.224.7925

DRAWN BY:	RL
CHECKED BY:	JD
JOB NO:	#6669
DWG:	F3R

APPROVED: Approval of drawings and/or procedures indicates concurrence with the information presented and does not relieve the Contractor or Fabricator of compliance with all specifications and code requirements	
APPROVED AS NOTED	X
REVISE AND RESUBMIT	
NOT REVIEWED	
Date: 8/23/16	
By: George Rogue	
This review by Stantec Consulting Services Inc. is for the sole purpose of ascertaining conformance with the general design concept. This review shall not mean that Stantec Consulting Services Inc. approves the detail design inherent in the shop drawings, responsibility for which shall remain with the Contractor. Submitting same, and such review shall not relieve the Contractor of his responsibility for errors or omissions in the shop drawing or of his responsibility for meeting all requirements of the Contract Documents. The contractor is responsible for dimensions to be confirmed and correlated at the job site, for information that pertains solely to the fabrication processes or to techniques of construction and installation and for coordination of the work of all subtrades.	



Vermont Agency of Transportation

**RECEIVED**

ON: September 13, 2016

and Checked for

**CONFORMANCE**

BY: Mark Sargent DATE: 09/13/2016

**BILL OF MATERIALS**

QTY	MARK	SHAPE	LENGTH	REMARKS
3	1A1	REPAIR A ASSEMBLY		
3	1p6	Plate 5/16 x 16	2'-11"	
40	1p1	Plate 5/16 x 9	1'-4"	
6	1p2	Plate 5/16 x 15	1'-4"	
10	1p3	Plate 3/8 x 3	0'-9"	
7/8" Hex Head Bolt x 2" lg with Nut and Washer				
2	1C1	REPAIR C ASSEMBLY		
2	1p4	Plate 5/8 x 3 1/4	2'-10"	Charpy
16		7/8" Hex Head Bolt x 2" lg		with Nut and Washer
6	1D1	SCUPPER EXTENSION		
12	1a4	L 3 x 3 x 1/4	0'-10"	
6	1t1	Tube 12 x 12 x 3/8	2'-0"	
12		1/4" Black EPDM		
24		7/8" Rod x 8" lg, 4 Nuts and 2 Washers		
9	1E1	REPAIR E ASSEMBLY		
9	1p5	Plate 1/2 x 3	1'-3 1/4"	Charpy
36		7/8" Hex Head Bolt x 2" lg		with Nut and Washer
25	1G1	LATTICE REPLACEMENT		
50	1p7	Plate 1/2 x 2 1/2	1'-10 1/4"	
125		7/8" Hex Head Bolt x 2" lg		with Nut and Washer

**REPAIR NOTES**

1. ALL STRUCTURAL STEEL SHALL CONFORM TO AASHTO M 270/M 270 GRADE 36, PAINTED.
2. ALL HIGH STRENGTH 7/8" HEX HEAD BOLTS, NUTS AND WASHERS SHALL BE IN ACCORDANCE WITH AASHTO M-164 TYPE 1 GALVANIZED.

3. DTE & SUPPLIER'S W/ 1" RUSS BOLTS

**DRAWING COVERS**

**TRUSS REPAIR DETAILS**

PROJECT	MORRISTOWN BF 0239(3)
LOCATION	CADYS FALLS ROAD over LAMOILLE RIVER
ENGINEER	VERMONT AGENCY OF TRANSPORTATION
CUSTOMER	BLOW & COTE, INC.

**MERRIMACK SHEET METAL**

119 HALL STREET  
CONCORD NH 03301

Tel. 603.224.7766  
Fax 603.224.7925

DRAWN BY:  
RL









CHECKED BY:  
JD

JOB NO.:  
#6669

DWG:  
FIT

Sizes and dimensions to be verified in field by contractor

Plate size to be confirmed by others

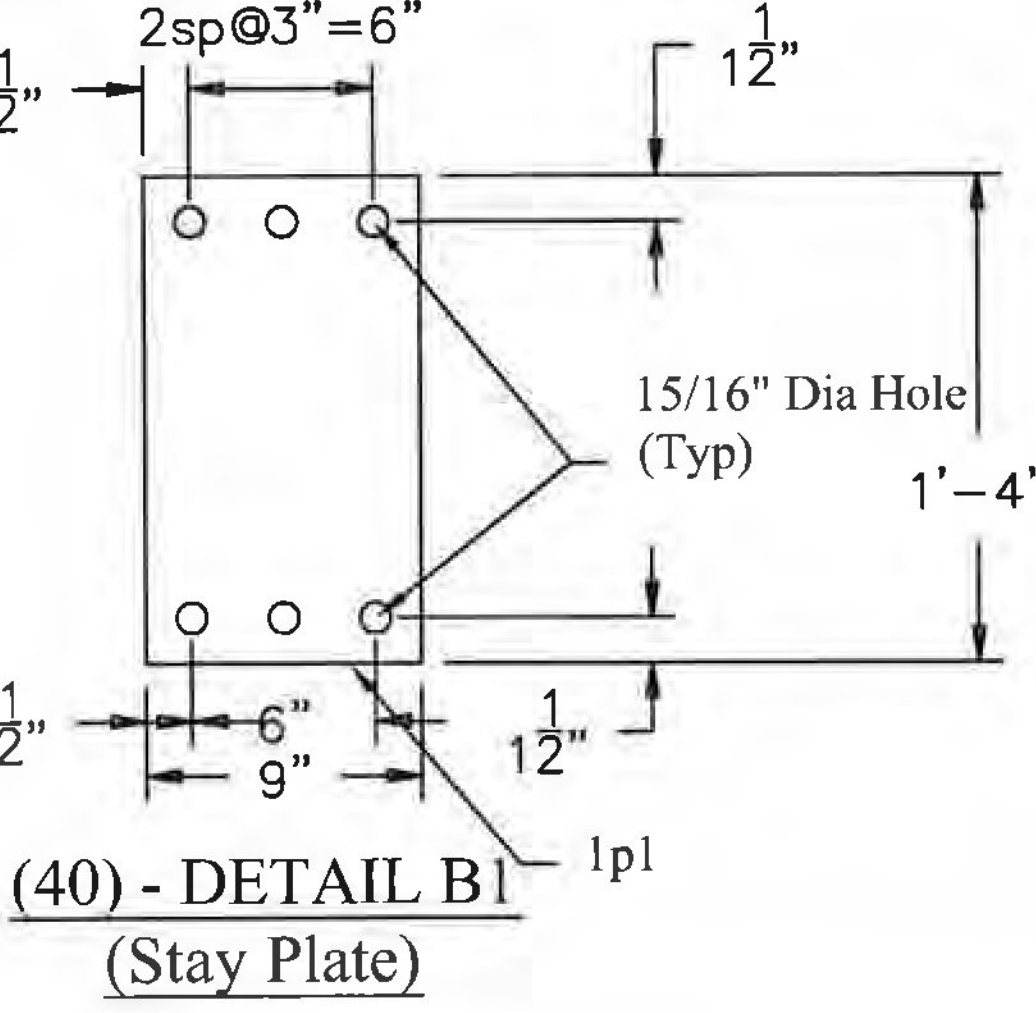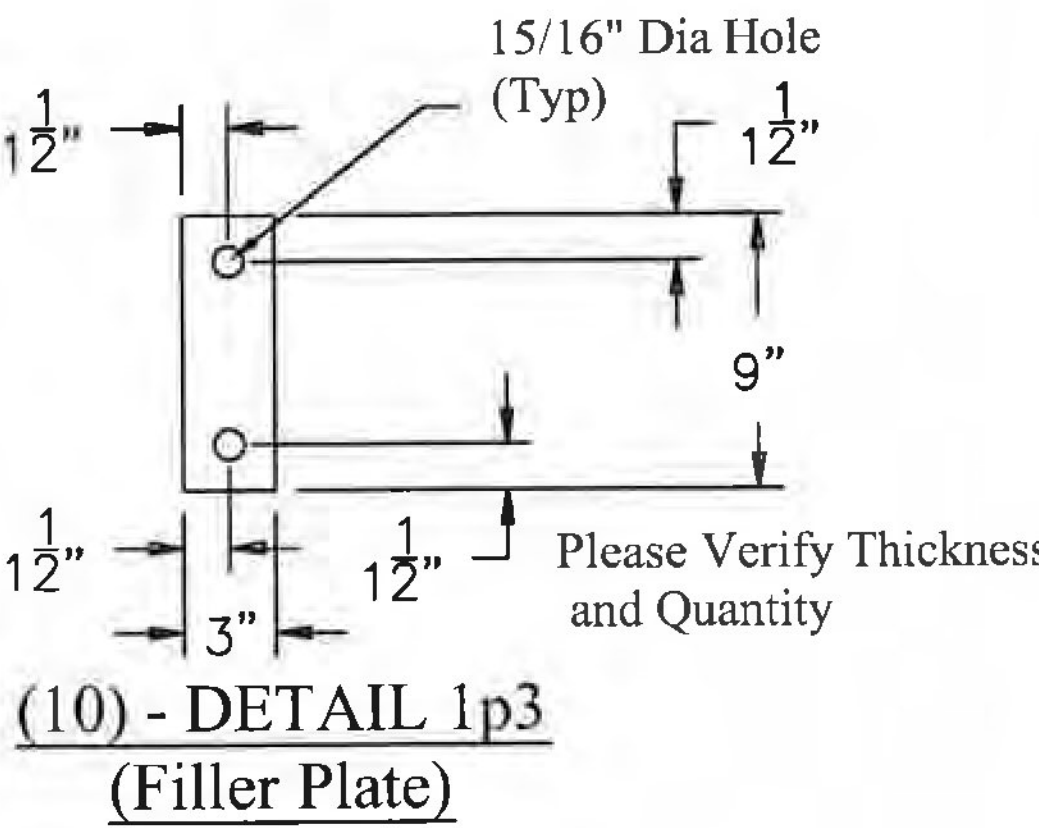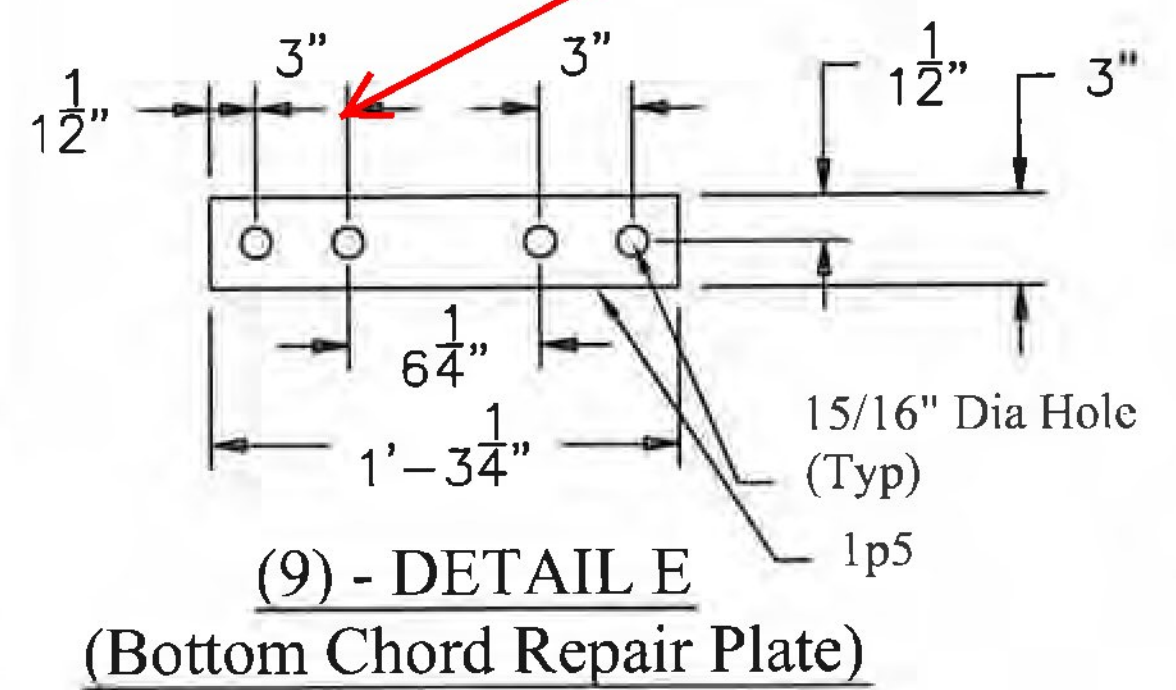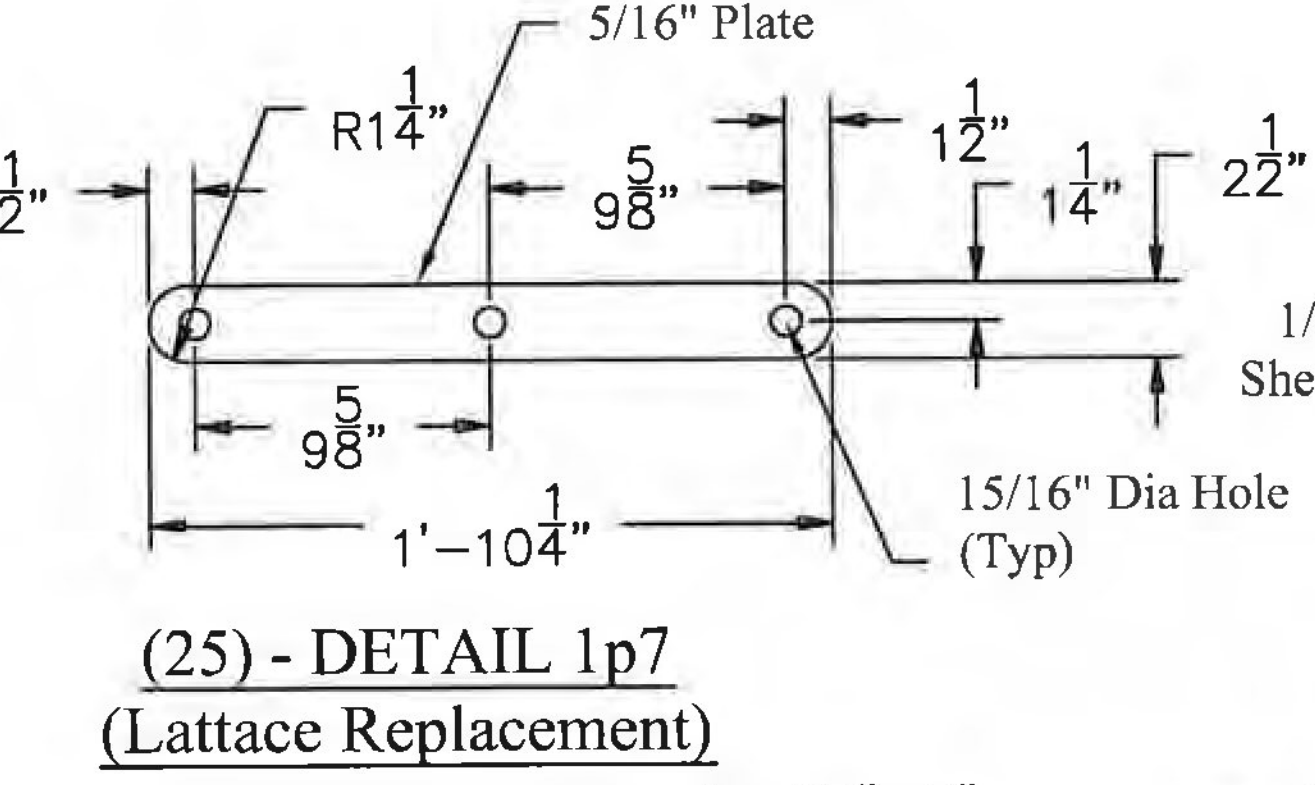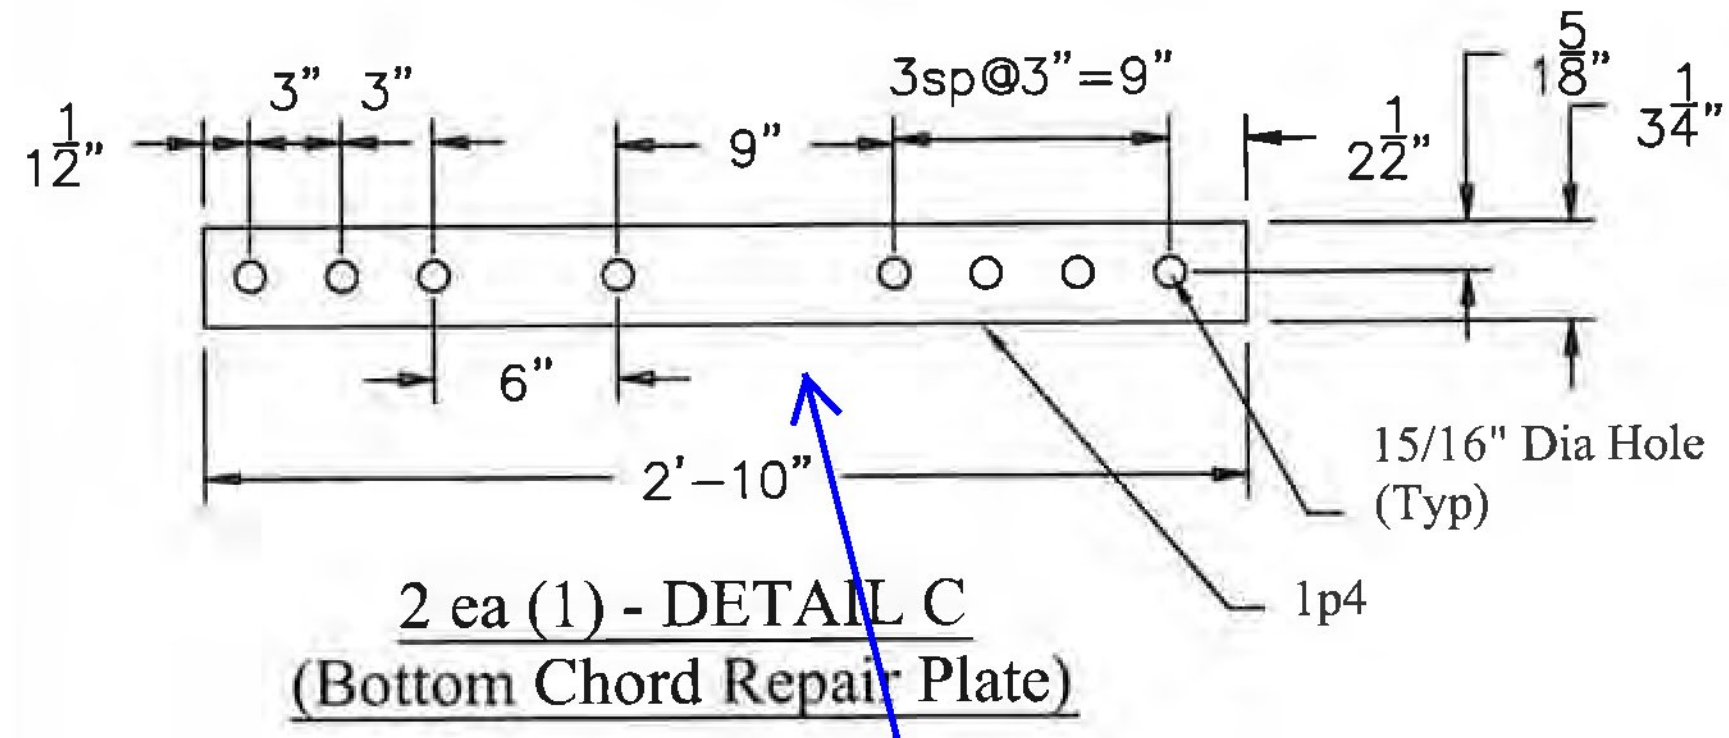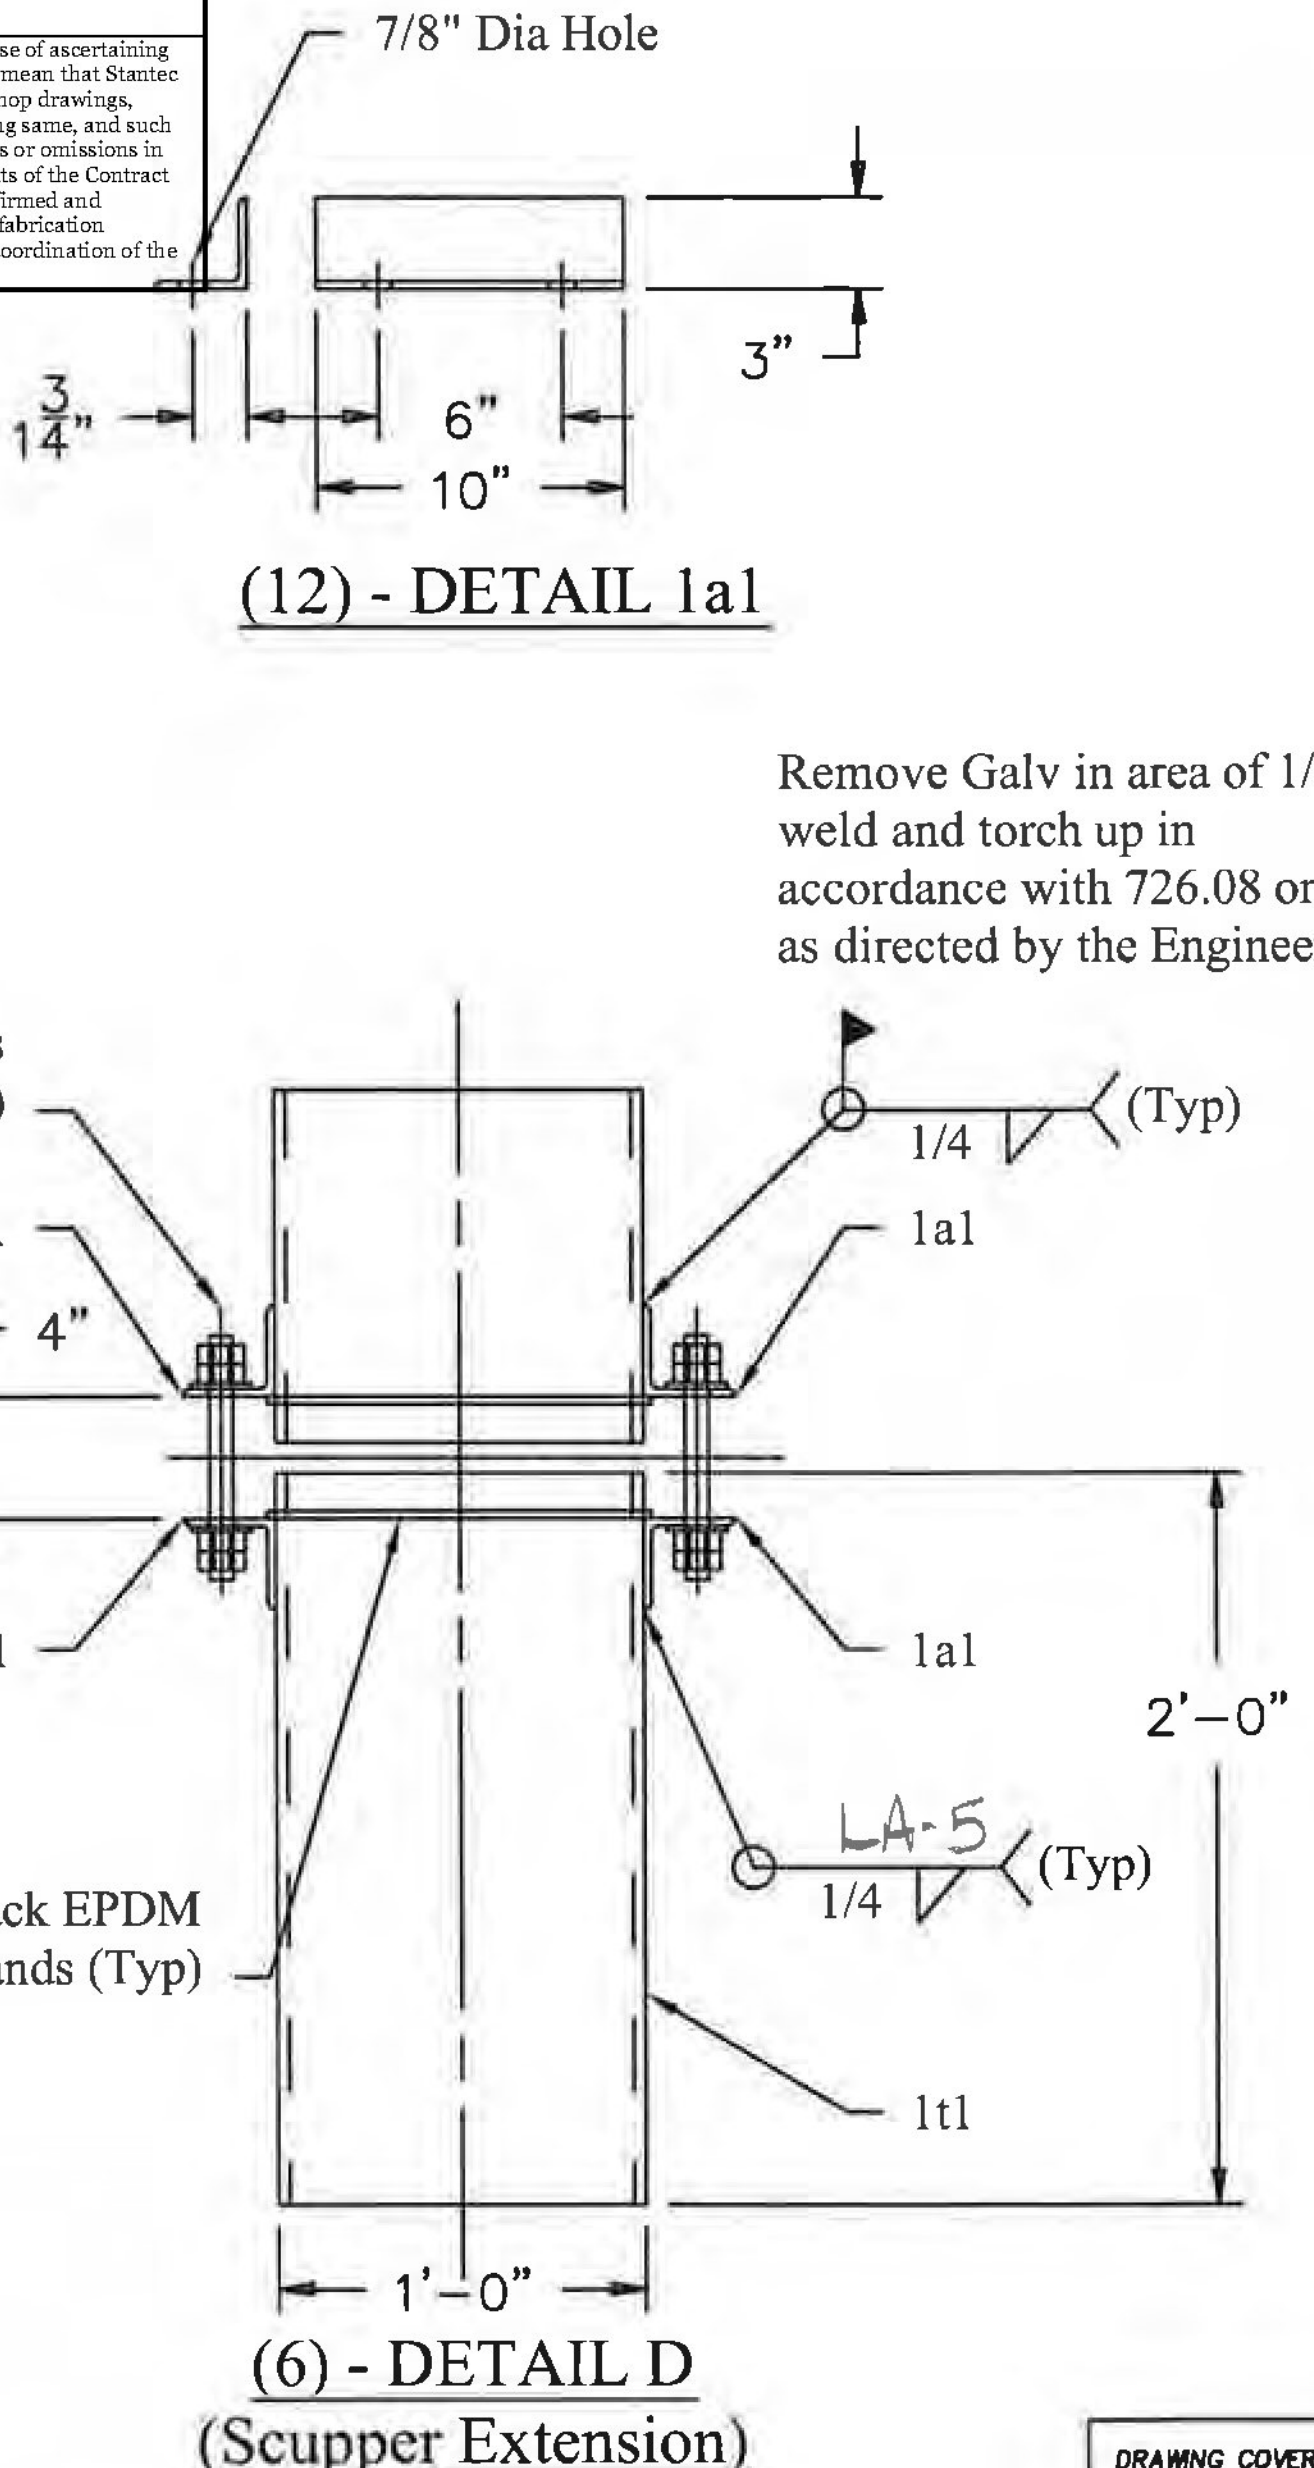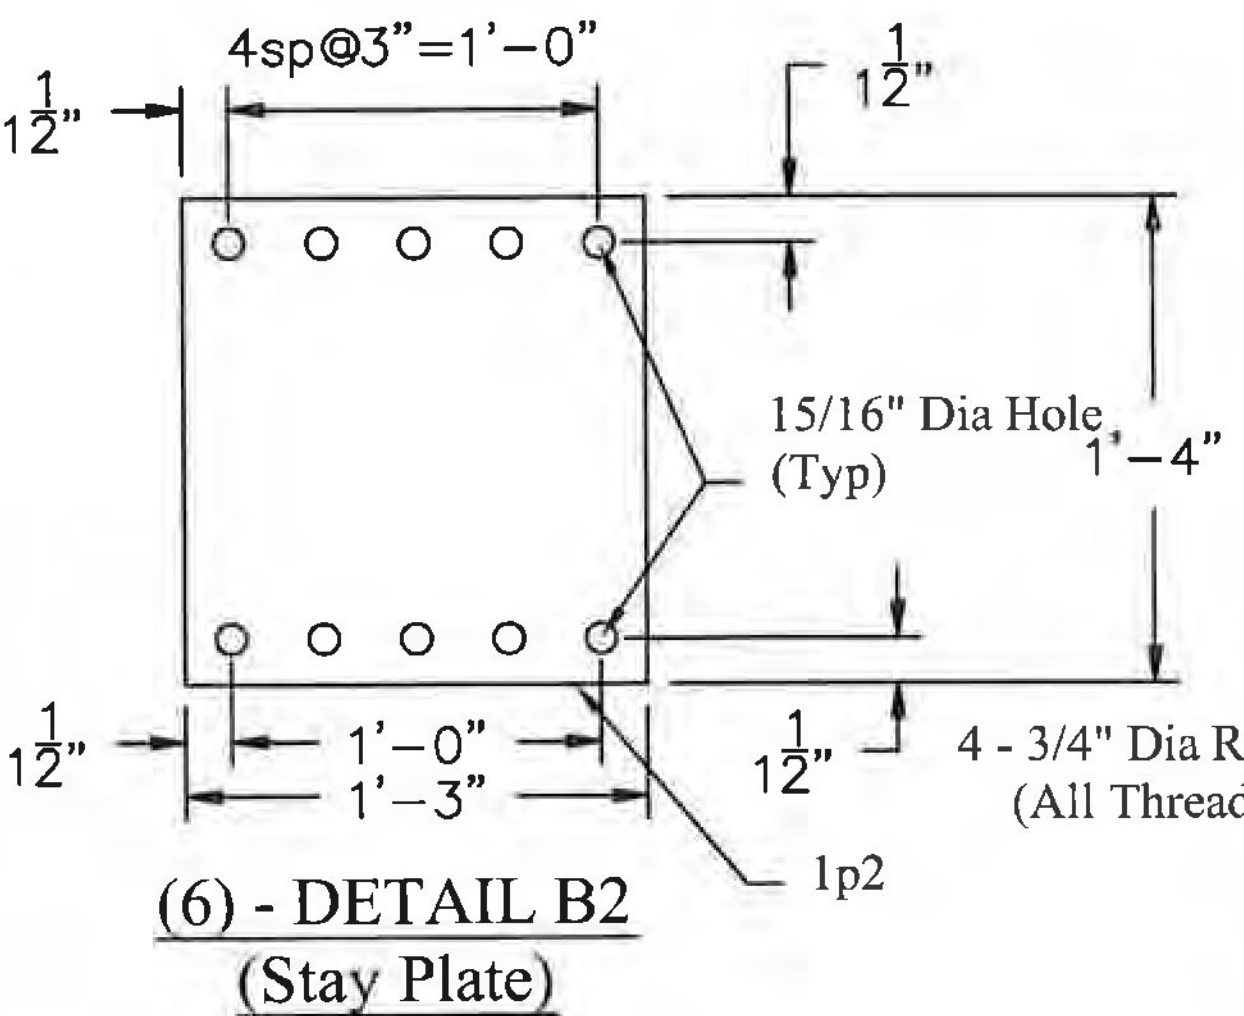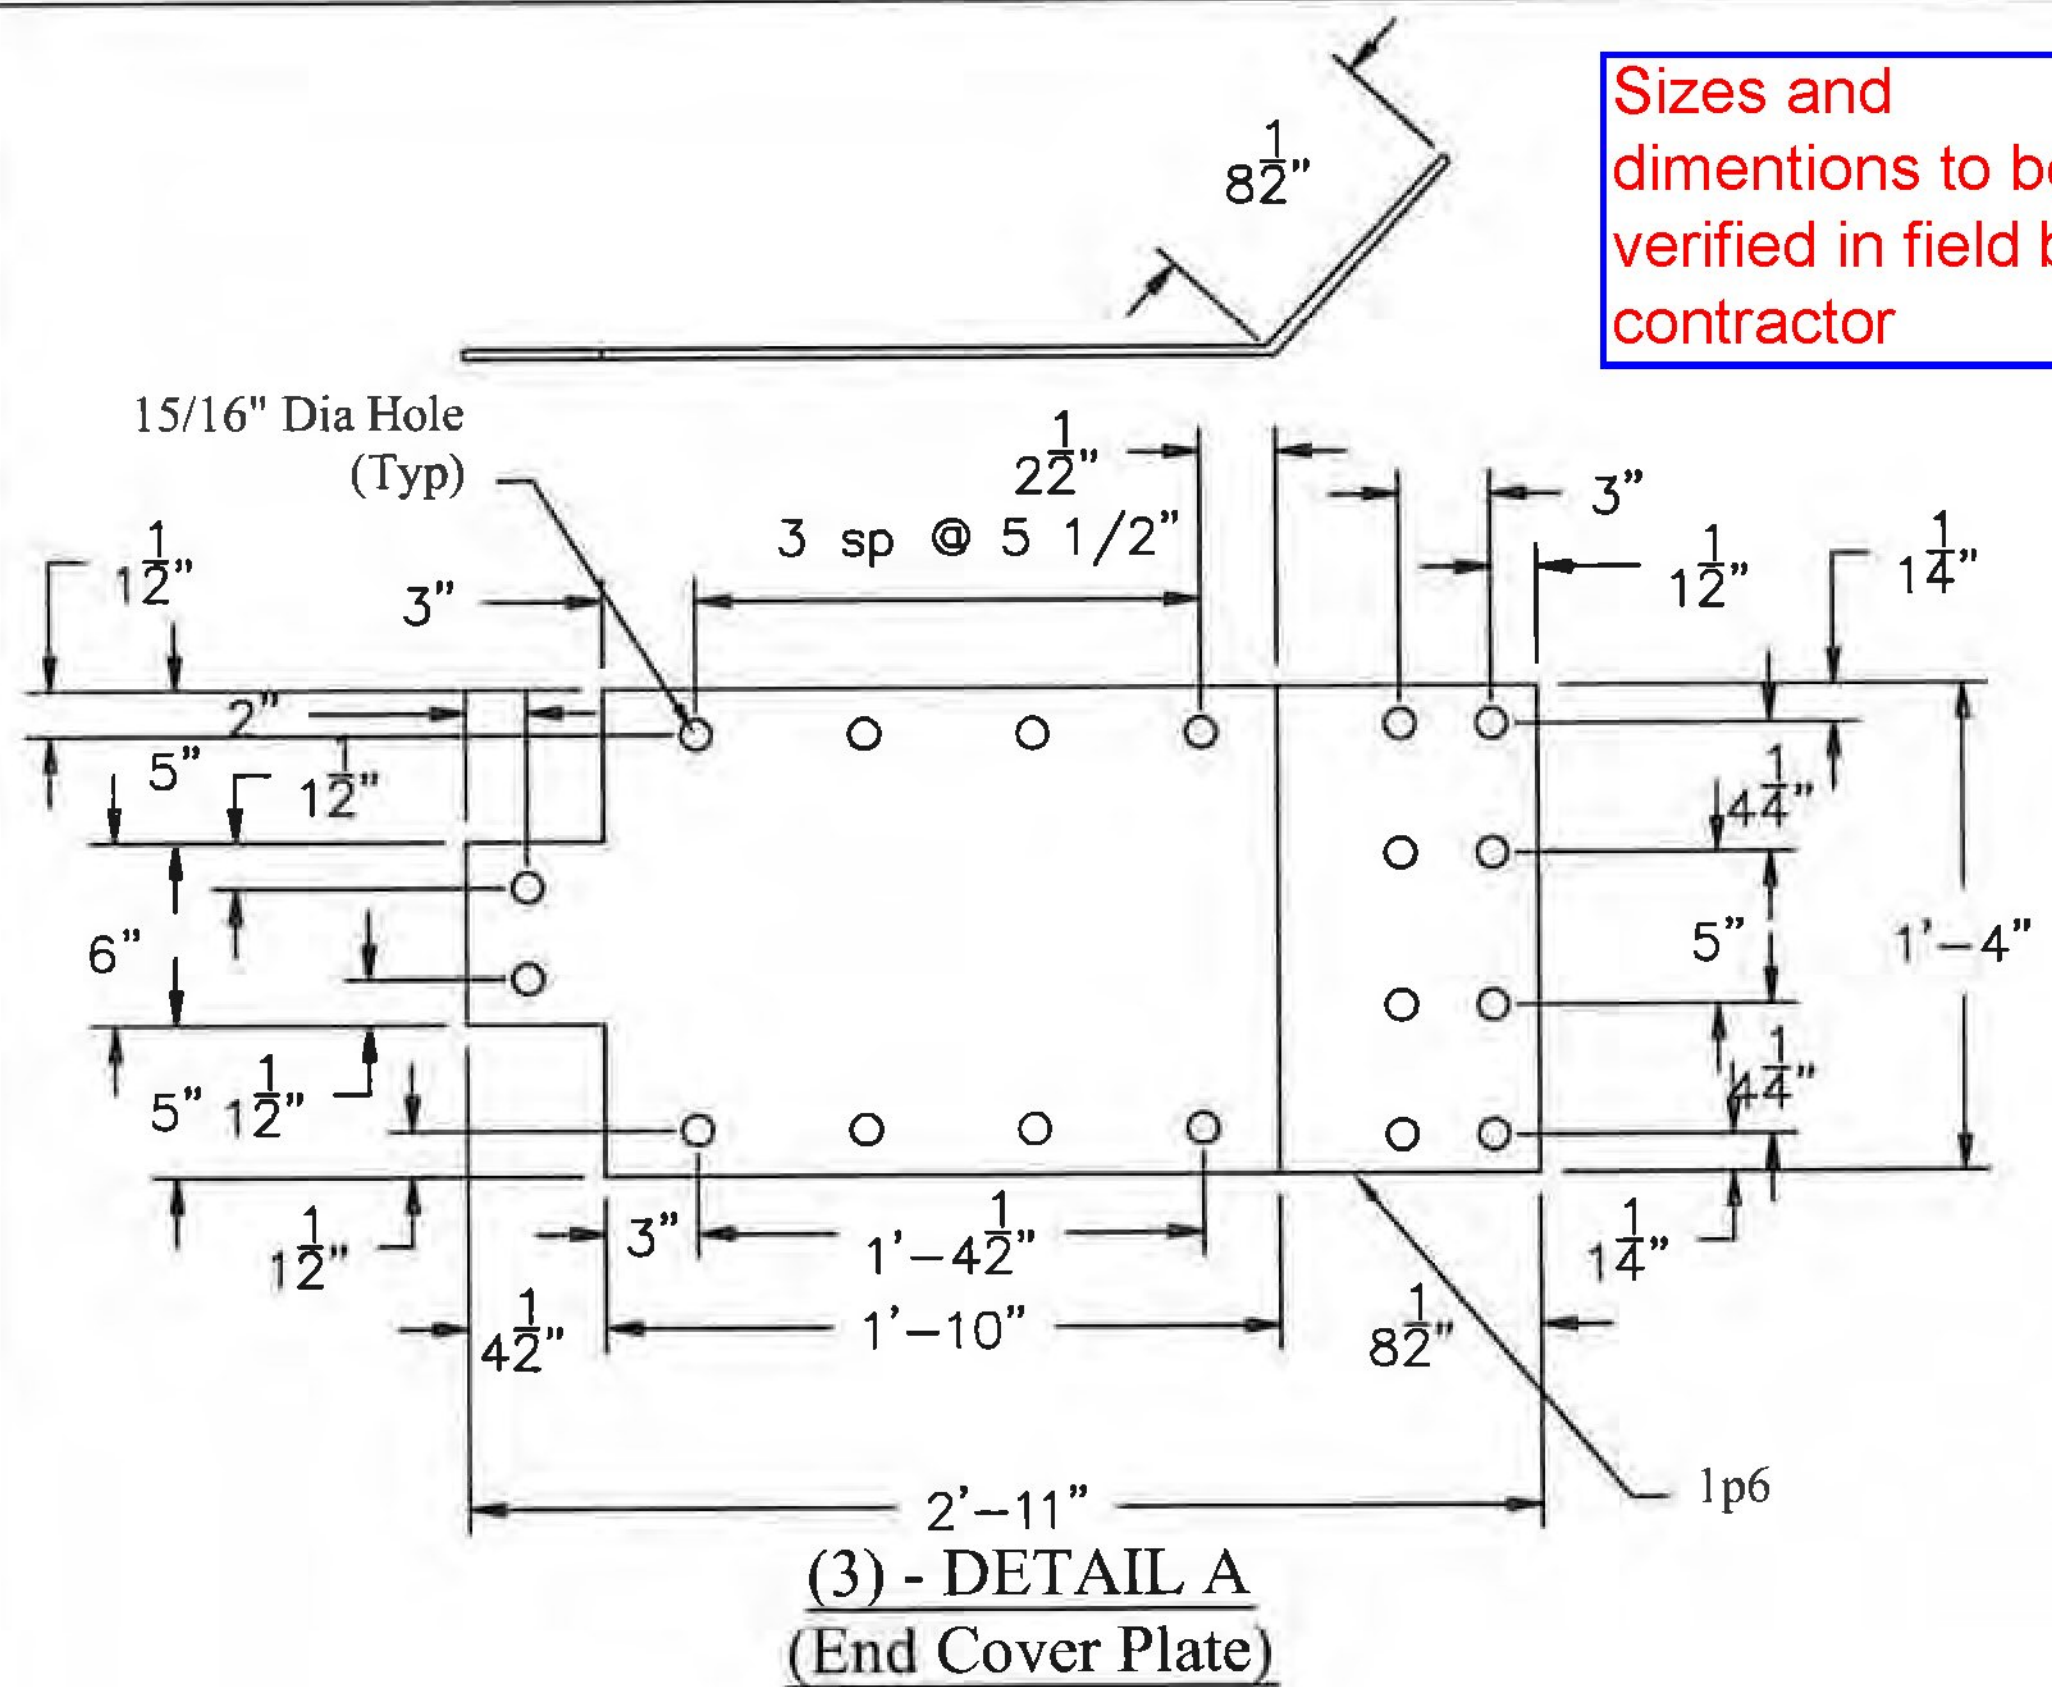

REV NO.	DATE	DESCRIPTION
1	8-3-2016	REVISED PER CONTRACTOR NOTES
0	7-22-2016	SUBMITTED FOR APPROVAL

HOLES AS NOTED  
MATERIAL: AASHTO M 270 GRADE 36 PAINTED

**WELDING PROCEDURE SPECIFICATION (WPS)**  
**PREQUALIFIED  QUALIFIED BY TESTING**   
**or PROCEDURE QUALIFICATION RECORDS (PQR) Yes**   
**AASHTO/AWS D1.5 Qualification Type 5.12.1  - 5.12.2  - 5.13**

Contractor/ Organization MERRIMACK SHEET METAL  
 Welding Process(es) GMAW  
 Type: Manual  Semiautomatic   
 Machine  Automatic   
 Tandem  Parallel

Identification LA-5  
 Revision 0 Date 6/1/2010 By KK  
 Authorized by KK Date 6/1/2010  
 Supporting PQR No.(s) PQLA1

**JOINT DESIGN USED**

Single  Double Weld   
 Backing: Yes  No  Material _____  
 Root Opening NA Root Face Dimension NA  
 Groove Angle NA Radius (J-U) _____  
 Backgouging: Yes  No  Method _____  
 Root Treatment CLEAN TO BRIGHT METAL

**POSITION**  
 Position of Groove NA Fillet 1F or 2F  
 Vertical Progression: Up  Down

**ELECTRICAL CHARACTERISTICS**

Transfer Mode (GMAW): Globular  Spray   
 Current: AC  DCEP  DCEN  Pulsed   
 Electrical Stick Out 3/4  
 Other _____

**BASE METALS**

Material Spec. A36 ; A588 ; A709 ;  
 Type or Grade G50  
 Thickness: Groove NA Fillet UNLIMITED  
 Diameter (Pipe) NA

**TECHNIQUE**

Stringer or Weave Bead BOTH  
 Multi-pass or Single Pass (per side) BOTH  
 Number of Electrodes 1  
 Electrode Spacing: Longitudinal NA  
 Lateral NA Angle NA  
 Interpass Cleaning CLEAN WITH WIRE BRUSH

**FILLER METALS**

AWS Specification A5.28  
 AWS Classification ER80S-Ni1  
 Manufacturer Trade Name LINCOLN SUPERARC LA-75

**PREHEAT**

Preheat Temp., Min. 70 F  
 Interpass Temp., Min. 70 F  
 Interpass Temp., Max. 400 F

**SHIELDING**

Flux NA Mfg. Trade Name NA  
 Electrode-Flux (Class) NA  
 Gas Composition 90% ARGON / 10% CO2  
 Flow Rate 45 CFH Gas Cup Size 3/4


**POSTWELD HEAT TREATMENT**

Temp. NA Hold Time NA  
 Heating/Cooling Rate NA

**HEAT INPUT**

Calculated Heat Input Value: kJ/in  kJ/mm   
 Max. Heat Input 42.7 Min. Heat Input 22.5

**WELDING PROCEDURE**

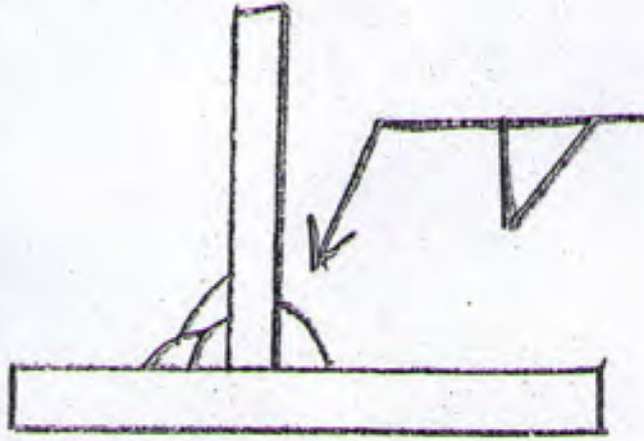Pass or Weld Layer(s)	Process	Filler Metals Diam.	Current		Volts	Travel Speed	Joint Details
			Type & Polarity	Amps or Wire Feed Speed			
ROOT 3/16	GMAW	.045	DCEP	220-260	26-29	15-18 IPM	LA-5-1F 
ROOT 1/4	GMAW	.045	DCEP	220-260	26-29	14-17 IPM	
ROOT 5/16	GMAW	.045	DCEP	220-270	26-29	13-16 IPM	
ROOT 3/8	GMAW	.045	DCEP	220-270	26-29	12-15 IPM	
2ND 3/8	GMAW	.045	DCEP	220-270	26-29	11-14 IPM	
3RD 3/8	GMAW	.045	DCEP	220-270	26-29	11-14 IPM	
ROOT 7/16	GMAW	.045	DCEP	220-270	26-29	12-15 IPM	
2ND 7/16	GMAW	.045	DCEP	220-270	26-29	12-14 IPM	
3RD 7/16	GMAW	.045	DCEP	220-270	26-29	12-15 IPM	

Form L-2

**Form L-2—Sample Welding Procedure Specification**

**WELDING PROCEDURE SPECIFICATION (WPS)**  
**PREQUALIFIED  QUALIFIED BY TESTING**   
**or PROCEDURE QUALIFICATION RECORDS (PQR) Yes**   
**AASHTO/AWS D1.5 Qualification Type 5.12.1  - 5.12.2  - 5.13**

Contractor/  
 Organization MERRIMACK SHEET METAL  
 Welding Process(es) GMAW  
 Type: Manual  Semiautomatic   
 Machine  Automatic   
 Tandem  Parallel

Identification LA-16  
 Revision 0 Date 6/1/2010 By KK  
 Authorized by KK Date 6/1/2010  
 Supporting PQR No.(s) PQLA1

**JOINT DESIGN USED**  
 Single  Double Weld   
 Backing: Yes  No  Material _____  
 Root Opening 0-1/8 Root Face Dimension 1/8 MIN  
 Groove Angle 45 DEGREE Radius (J-U) _____  
 Backgouging: Yes  No  Method _____  
 Root Treatment CLEAN TO BRIGHT METAL

**POSITION**  
 Position of Groove 1G Fillet 1F  
 Vertical Progression: Up  Down

**ELECTRICAL CHARACTERISTICS**  
 Transfer Mode (GMAW): Globular  Spray   
 Current: AC  DCEP  DCEN  Pulsed   
 Electrical Stick Out 3/4  
 Other _____

**BASE METALS**  
 Material Spec. A36 ; A588 ; A709 ;  
 Type or Grade G50  
 Thickness: Groove 1/4 TO UNLIMITED Fillet _____  
 Diameter (Pipe) NA

**TECHNIQUE**  
 Stringer or Weave Bead STRINGER  
 Multi-pass or Single Pass (per side) SINGLE  
 Number of Electrodes 1  
 Electrode Spacing: Longitudinal NA  
 Lateral NA Angle NA  
 Interpass Cleaning CLEAN WITH WIRE BRUSH

**FILLER METALS**  
 AWS Specification A5.28  
 AWS Classification ER80S-N1  
 Manufacturer Trade Name LINCOLN SUPERARC LA-75

**PREHEAT**  
 Preheat Temp., Min. 70 F  
 Interpass Temp., Min. 70 F  
 Interpass Temp., Max. 400 F

**SHIELDING**  
 Flux NA Mfg. Trade Name NA  
 Electrode-Flux (Class) NA  
 Gas Composition 90% ARGON / 10% CO2  
 Flow Rate 45 CFH Gas Cup Size 3/4

**POSTWELD HEAT TREATMENT**  
 Temp. NA Hold Time NA  
 Heating/Cooling Rate NA

**HEAT INPUT**  
 Calculated Heat Input Value: kJ/in  kJ/mm   
 Max. Heat Input 35.0 Min. Heat Input 20.2

**WELDING PROCEDURE**

Pass or Weld Layer(s)	Process	Filler Metals	Current		Volts	Travel Speed	Joint Details
		Diam.	Type & Polarity	Amps or Wire Feed Speed			
3/16	GMAW	.045	DCEP	220-250	26-28	15-17 IPM	
1/4	GMAW	.045	DCEP	220-250	26-28	14-16 IPM	
5/16	GMAW	.045	DCEP	220-250	26-28	12-14 IPM	

Form L-2

**Form L-2—Sample Welding Procedure Specification**

**RECEIVED**

ON: September 13, 2016

and Checked for

**CONFORMANCE**

BY: Mark Sargent DATE: 09/13/2016

**WELDING PROCEDURE SPECIFICATION ( WPS )**  
**PREQUALIFIED** _____ **QUALIFIED BY TEST** _____ **YES** _____

Company Name Merrimack Sheet Metal Identification # LA-5  
 Welding Process(es) GMAW Revision NA Date N/A By N/A  
 Supporting PQR # (s) LA-1/2016 Authorized Michael J. Smith Date 5/10/2016

Type- Manual  Semi-Auto   
 Machine  Automatic

**JOINT DESIGN USED**  
 Single  Double Weld   
 Backing Yes / No    
 Backing Material NO  
 Root Opening and Face Dimension N/A  
 Groove Angle, U or J N/A  
 Back Gouge Y/N/Type NO

**POSITION**  
 Position of Groove N/A Fillet Flat & Horizontal  
 Vertical Progression, up N/A Down _____

**BASE METALS**  
 Base Metal A36:A588:A709  
 Type or Grade B  
 Thickness: Groove N/A  
 Fillet Unlimited  
 Pipe Diameter N/A

**ELECTRICAL CHARACTERISTICS**  
 Transfer Mode ( GMAW ):  
 Short-Circuiting / Globular / Spray SPRAY  
 Current AC, DCEP, DCEN, Pulsed DCEP  
 Other none  
 Tungsten Electrode ( GTAW ):  
 Size N/A  
 Type N/A

**FILLER METALS**  
 A.W.S. Specification A5.28  
 A.W.S. Classification ER80S-NI1  
 Trade Name Lincoln Superarc LA-75

**TECHNIQUE**  
 Stringer or Weave Bead Stringer  
 Multi or Single Pass ( per side ) Multi Pass  
 Number of Electrodes ONE  
 Electrode Spacing: Longitudinal N/A  
 Lateral N/A  
 Angle 15 degree push angle  
 Contact Tube to Work Distance 1/2" TO 3/4" ESO  
 Peening none  
 Interpass Cleaning none

**SHIELDING**  
 Flux N/A Gas Ar/Co2  
 Electrode-flux Class Composition 90AR 10Co2  
 NA Flow Rate 35-40 CFH  
 Gas Cup Size 1/2 inch

**PREHEAT**  
 Preheat Temp., Min. 70 deg. F  
 Interpass Temp. Min. 100 deg. F  
 Interpass Temp. Max. 350 deg. F

**POSTWELD HEAT TREATMENT**  
 Temp. none  
 Time N/A  
 Heat Input Max KJ/in 37.8 Heat Input Min KJ/in 24.3

26 Min.



15 Max

**WELDING PROCEDURE**

Pass or Weld Layer Layer(s)	Process	FILLER METALS		CURRENT			Travel Speed	JOINT DETAIL
		Class	Diam.	Type & Polarity	Amps or WFS	Volts		
ALL	GMAW	ER80S-NI1	.045 dia	DCEP	250-270	27-28	13-16 IPM	SINGLE SIDED FILLET

**RECEIVED**

ON: September 13, 2016

and Checked for

**CONFORMANCE**

BY: Mark Sargent DATE: 09/13/2016

**WELDING PROCEDURE SPECIFICATION ( WPS )**  
**PREQUALIFIED** _____ **QUALIFIED BY TEST** _____

**YES**

Company Name Merrimack Sheet Metal Identification # LA-16  
 Welding Process(es) GMAW Revision NA Date N/A By N/A  
 Supporting PQR # (s) LA-1/2016 Authorized Michael J. Smith Date 5/10/2016

Type- Manual  Semi-Auto   
 Machine  Automatic

**JOINT DESIGN USED**  
 Single  Double Weld   
 Backing Yes / No    
 Backing Material NO  
 Root Opening and Face Dimension R=0 F=1/8 min  
 Groove Angle, U or J 45 Degree  
 Back Gouge Y/N/Type NO

**POSITION**  
 Position of Groove FLAT 1G Fillet NA  
 Vertical Progression, up N/A Down _____

**BASE METALS**  
 Base Metal A36:A588:A709  
 Type or Grade B  
 Thickness: Groove 1/4" min. Unlimited  
 Fillet N/A  
 Pipe Diameter N/A

**ELECTRICAL CHARACTERISTICS**  
 Transfer Mode ( GMAW ):  
 Short-Circuiting / Globular / Spray SPRAY  
 Current AC, DCEP, DCEN, Pulsed DCEP  
 Other none  
 Tungsten Electrode ( GTAW ):  
 Size N/A  
 Type N/A

**FILLER METALS**  
 A.W.S. Specification A5.28  
 A.W.S. Classification ER80S-N11  
 Trade Name Lincoln Superarc LA-75

**TECHNIQUE**  
 Stringer or Weave Bead Stringer  
 Multi or Single Pass ( per side ) Multi Pass  
 Number of Electrodes ONE  
 Electrode Spacing: Longitudinal N/A  
 Lateral N/A  
 Angle 15 degree push angle  
 Contact Tube to Work Distance 1/2" TO 3/4" ESO  
 Peening none  
 Interpass Cleaning none

**SHIELDING**  
 Flux N/A Gas Ar/Co2  
 Electrode-flux Class Composition 90AR 10Co2  
NA Flow Rate 35-40 CFH  
 Gas Cup Size 1/2 inch

**PREHEAT**  
 Preheat Temp., Min. 70 deg. F  
 Interpass Temp. Min. 100 deg. F  
 Interpass Temp. Max. 350 deg. F

**POSTWELD HEAT TREATMENT**  
 Temp. none  
 Time N/A  
 Heat Input Max KJ/in 37.8 Heat Input Min KJ/in 24.3

**26 Min.** 


**WELDING PROCEDURE**

Pass or Weld Layer(s)	Process	FILLER METALS		CURRENT			Travel Speed	JOINT DETAIL
		Class	Diam.	Type & Polarity	Amps or WFS	Volts		
ALL	GMAW	ER80S-N11	.045 dia	DCEP	250-270	27-28	13-18 IPM	TC-P4-GF
							<b>15 Max</b>	

Vermont Agency of Transportation  
**RECEIVED**

CK'D BY MS OK'D BY MS  
October 18, 2016

RESUBMIT No Approved  
BY Mark Sargent DATE 10/18/2016

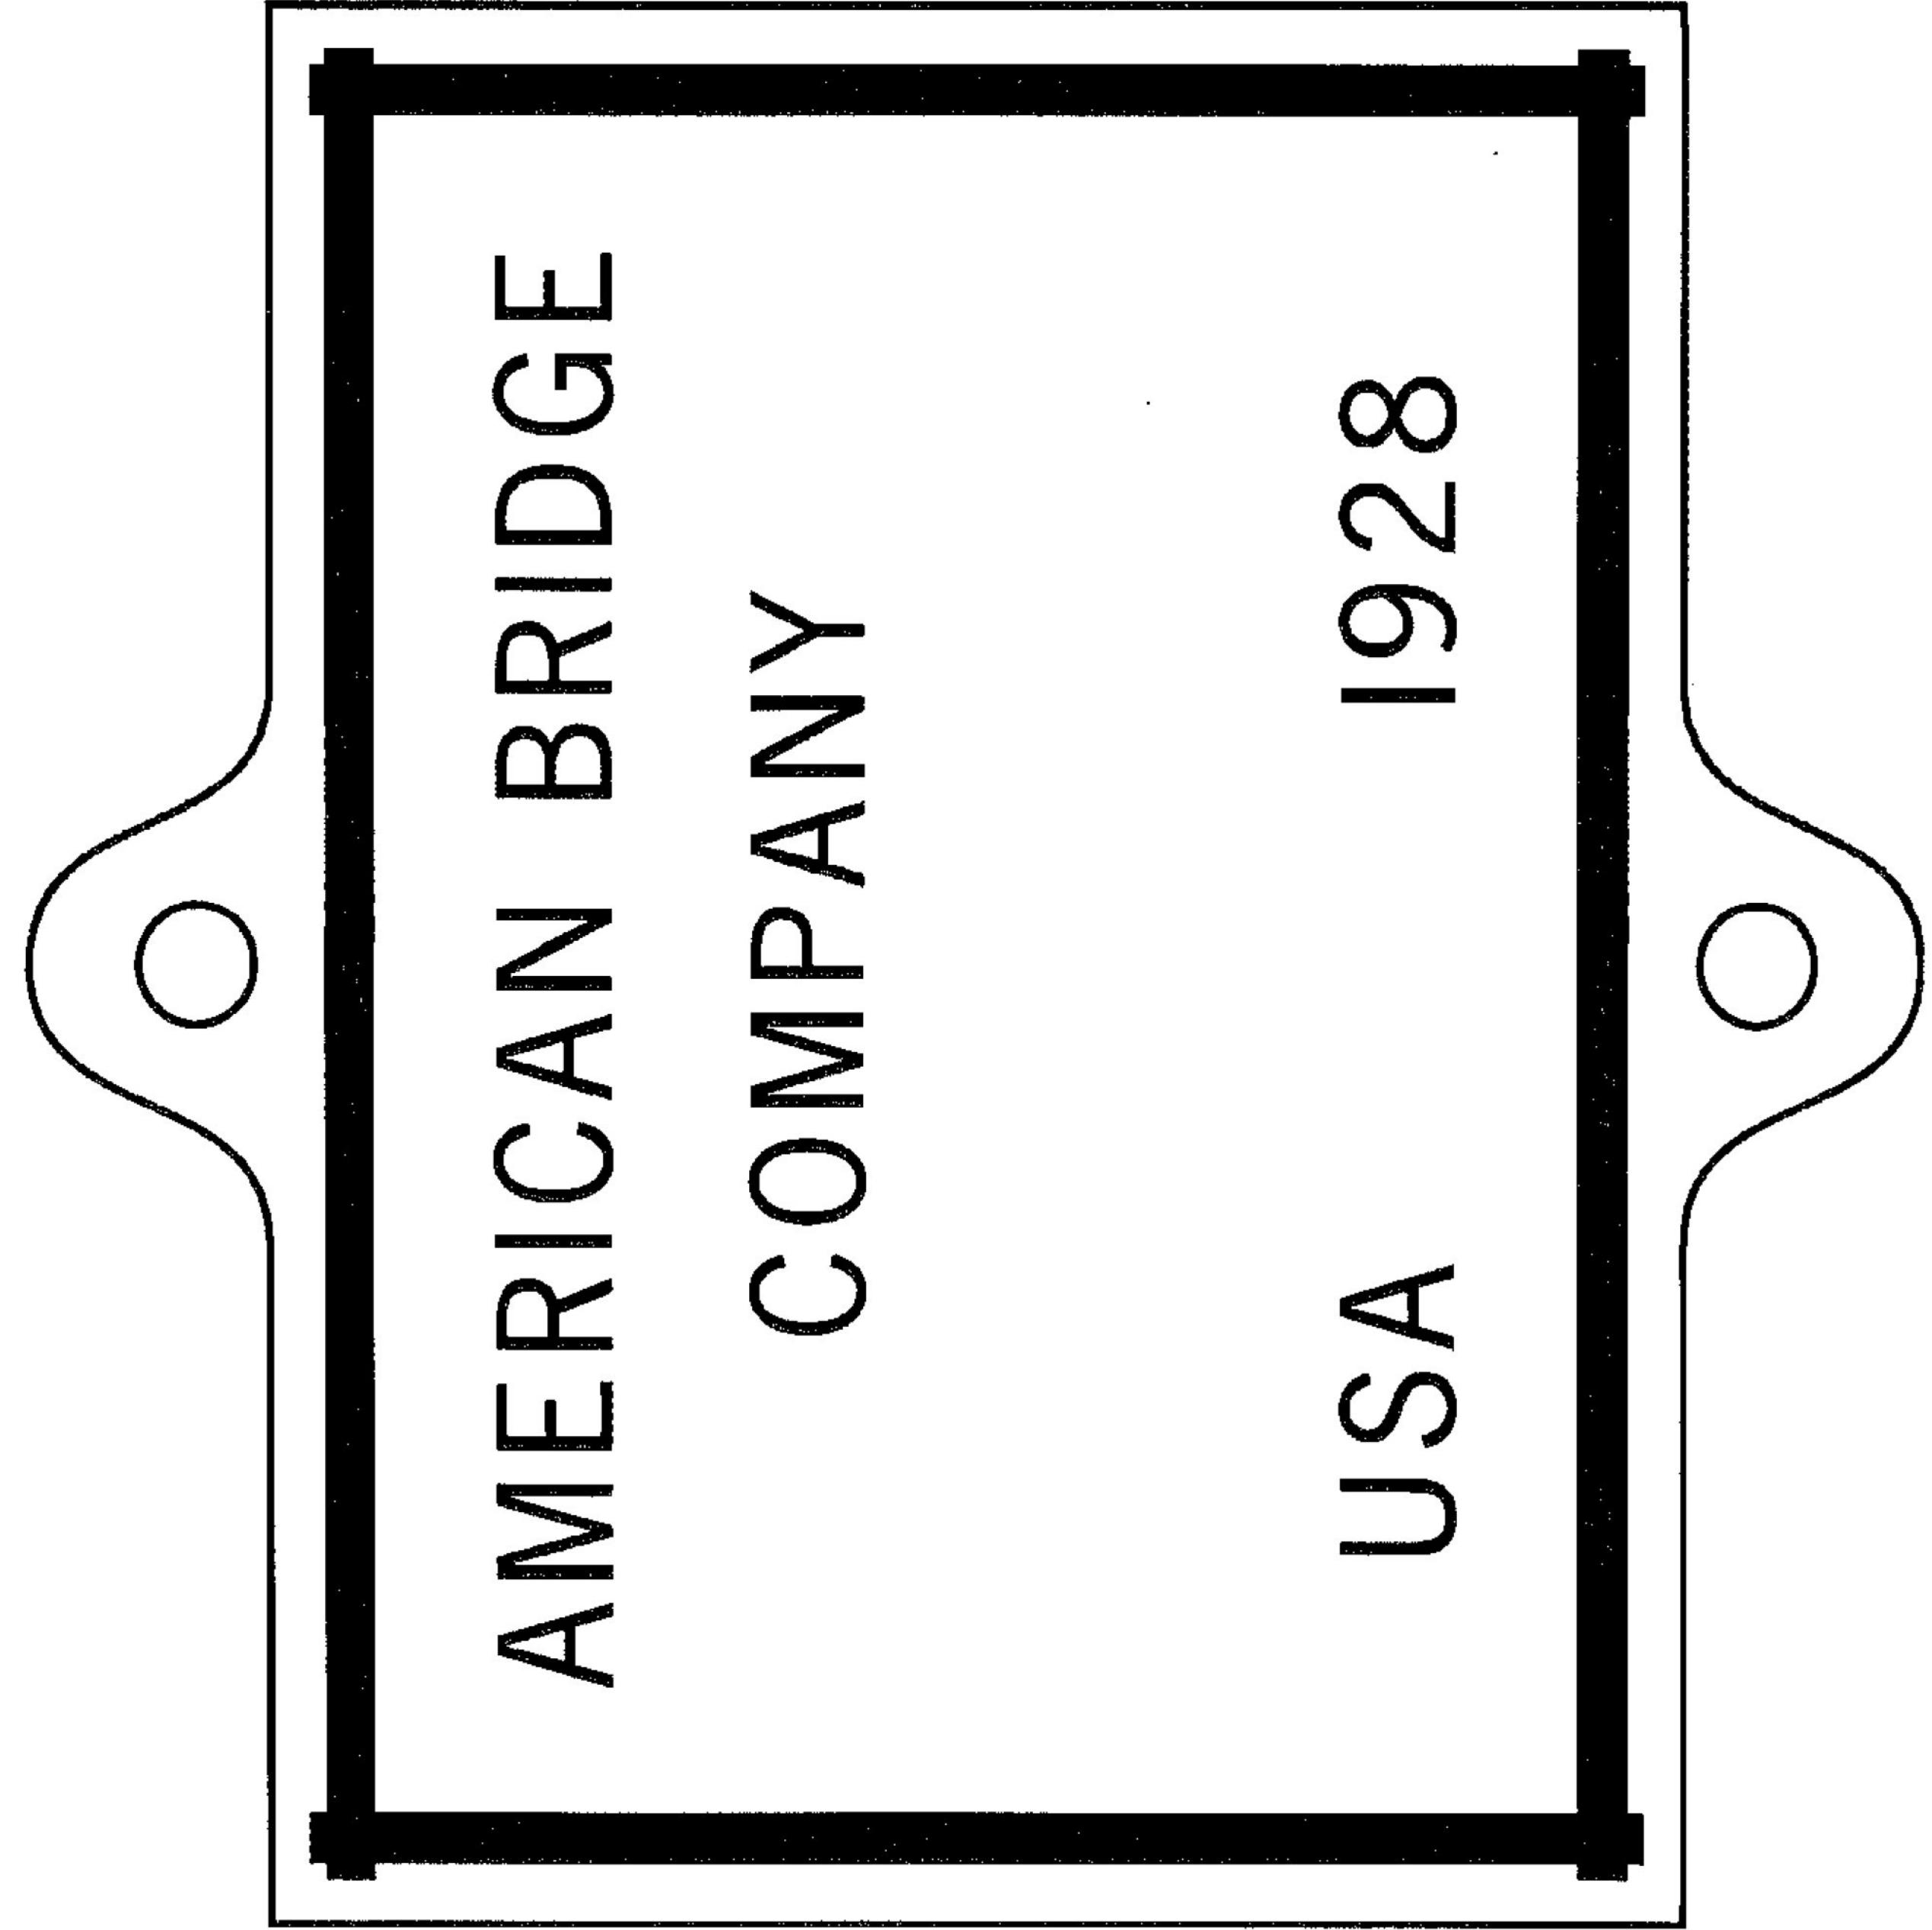


200% 4617844 lb 10/14/16 14x14.375 SE



ARCHITECTURAL SALES  
1315 West Liberty Ave.  
Pittsburgh, PA 15226  
USA

Phone: 1-800-950-1317  
Fax: 1-866-814-4028  
Internet: www.matthewsbronze.net

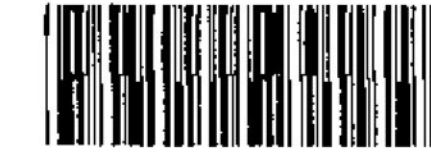

4617844

BRONZE

## Drawing Approval

Sold-To-Party
BRONZE CRAFT CORP. PO Box 788 NASHUA NH 03061-0788

Ship-To-Party
BRONZE CRAFT CORP. 37 WILL ST NASHUA NH 03060-3083

Information
Sales Order No. 4617844
Document Date 10/12/2016
Customer No. 10013486
Currency USD
CSR Eddie McAndrews
Phone Number 800-950-1317
E-mail emcandrews@matthewsintl.com
Shipping Type ZBRZ
Order Type TBD
Est Ship Date 4000
Office

Vermont Agency of Transportation  
**RECEIVED**  
CK'D BY MS OK'D BY MS  
October 18, 2016  
RESUBMIT No Approved  
BY Mark Sargent DATE 10/18/2016

Header Information	
Purchase Order No: AMERICAN BRIDGE	Purchase Order Date:
Estimated Ship Date: TBD	Reference:
Terms of payment: Net 30 days	
Terms of Delivery: FEG FEDEX GROUND	

**INSTRUCTIONS**  
PLAQUE-201" - 288"-CAST-BRONZE-CUSTOM

Item	Material	Quantity	Price	Price Unit	Amount
<b>ITEMIZED ENTRIES</b>					
10	71030369 PLQ,14X14.375,CAST,BRZ,CUSTOM Surname: AMERICAN BRIDGE COMPANY Old Part#: B201A288 Production Order#: 32318690	1.00 EA		1 EA Plant: 4000	
<b>INSCRIPTION</b>					
AMERICAN BRIDGE COMPANY USA 1928					
<b>SETUP</b>					
30	119074 DWG-SUBMIT DRAWINGS FOR APPROVAL Old Part#: 8581	1.00 EA		Plant: 4000	
40	121045	1.00 EA			



ARCHITECTURAL SALES  
 1315 West Liberty Ave.  
 Pittsburgh, PA 15226  
 USA

Phone: 1-800-950-1317  
 Fax: 1-866-814-4028  
 Internet: www.matthewsbronze.net

BRONZE

## Drawing Approval

Sold To Party
BRONZE CRAFT CORP. PO Box 788 NASHUA NH 03001-0788

Information
Sales Order No. 4617844 Customer No. 10013486

Item	Material	Quantity	Price	Price Unit	Amount
	PAT-STRAIGHT EDGE Old Part#: 8201			Plant: 4000	
50	120860	1.00 EA			
	PAT-FLAT-BACKED PATTERN Old Part#: 8002			Plant: 4000	
60	112776	1.00 EA			
	PAT-1/4IN THICK BACKGROUND (NORANDA) Old Part#: 8360			Plant: 4000	
70	116395	1.00 EA			
	GRH-ALL CAPS Old Part#: 8400			Plant: 4000	
80	120835	1.00 EA			
	GRH-MATCH COPY/PHOTO OF EXISTING PLAQUE Old Part#: 8355			Plant: 4000	
90	123611	1.00 EA			
	GRH-CLOSE MATCH & NOTE STYLE Old Part#: 8426			Plant: 4000	
100	118218	1.00 EA			
	GRH-LEATHERETTE Old Part#: 8300			Plant: 4000	
CUSTOM INSIDE SINGLE LINE BORDER DIMENSIONS PER CUSTOMER LAYOUT					
<b>COLOR AND FINISHING</b>					
110	110610	1.00 EA			
	FIN-DARK OXIDE STAIN Old Part#: 8801			Plant: 4000	
120	116099	1.00 EA			
	PRO-USE DIAMOND SHIELD Old Part#: 8802			Plant: 4000	
130	125771	1.00 EA			
	FIN-SATIN (ON RAISED AREAS)			Plant: 4000	

Vermont Agency of Transportation  
**RECEIVED**  
 CK'D BY MS OK'D BY MS  
 October 18, 2016  
 RESUBMIT No Approved  
 BY Mark Sargent DATE 10/18/2016



**ARCHITECTURAL SALES**  
 1315 West Liberty Ave.  
 Pittsburgh, PA 15226  
 USA

Phone: 1-800-950-1317  
 Fax: 1-866-814-4028  
 Internet: www.matthewsbronze.net

BRONZE

## Drawing Approval

Sold To Party
BRONZE CRAFT CORP. PO Box 788 NASHUA NH 03061-0788

Information
Sales Order No. 4617844 Customer No. 10013486

Item	Material	Quantity	Price	Price Unit	Amount
	Old Part#: 8820				
<b>HARDWARE AND DRILLING</b>					
20	124632	1.00	EA		
	HDW-D&T/PROVIDE 1/4-20 X 3IN BRASS STUD			Plant: 4000	
	Old Part#: 8768/30351				
Final amount:					

APPROVED: Approval of drawings and/or procedures indicates concurrence with the information presented and does not relieve the Contractor or Fabricator of compliance with all specifications and code requirements	✓	
APPROVED AS NOTED		
REVISE AND RESUBMIT		
NOT REVIEWED		
Date:	<b>10/18/16</b>	
Signature:	<i>TEK</i>	
<p>This review by Stantec Consulting Services Inc. is for the sole purpose of ascertaining conformance with the general design concept. This review shall not mean that Stantec Consulting Services Inc approves the detail design inherent in the shop drawings, responsibility for which shall remain with the Contractor. Submitting same, and such review shall not relieve the Contractor of his responsibility for errors or omissions in the shop drawing or of his responsibility for meeting all requirements of the Contract Documents. The contractor is responsible for dimensions to be confirmed and correlated at the job site, for information that pertains solely to the fabrication processes or to techniques of construction and installation and for coordination of the work of all subtrades.</p>		

Vermont Agency of Transportation  
**RECEIVED**  
 CK'D BY MS OK'D BY MS  
 October 18, 2016  
 RESUBMIT No Approved  
 BY Mark Sargent DATE 10/18/2016

Approved As Is _____ DATE _____  
 Revise and Resubmit _____ DATE _____  
 Make Revisions and Proceed _____ DATE _____