

STATE OF VERMONT AGENCY OF TRANSPORTATION



PROPOSED IMPROVEMENT BRIDGE PROJECT



TOWN OF POULTNEY
COUNTY OF RUTLAND

ROUTE NO : SNR 140/TH 2 (CLASS 2) , MAJOR COLLECTOR BRIDGE NO : BR 2

PROJECT LOCATION: ON SNR 140 APPROXIMATELY 2.2 MILES EAST OF THE JUNCTION WITH VT ROUTE 30 (OVER FINEL HOLLOW BROOK).

PROJECT DESCRIPTION: REPLACEMENT OF EXISTING BRIDGE WITH A NEW PRECAST CONCRETE RIGID FRAME WITH RELATED APPROACH AND CHANNEL WORK.

LENGTH OF STRUCTURE: 37.29 FEET
LENGTH OF ROAD: 87.71 FEET
LENGTH OF PROJECT: 125.00 FEET

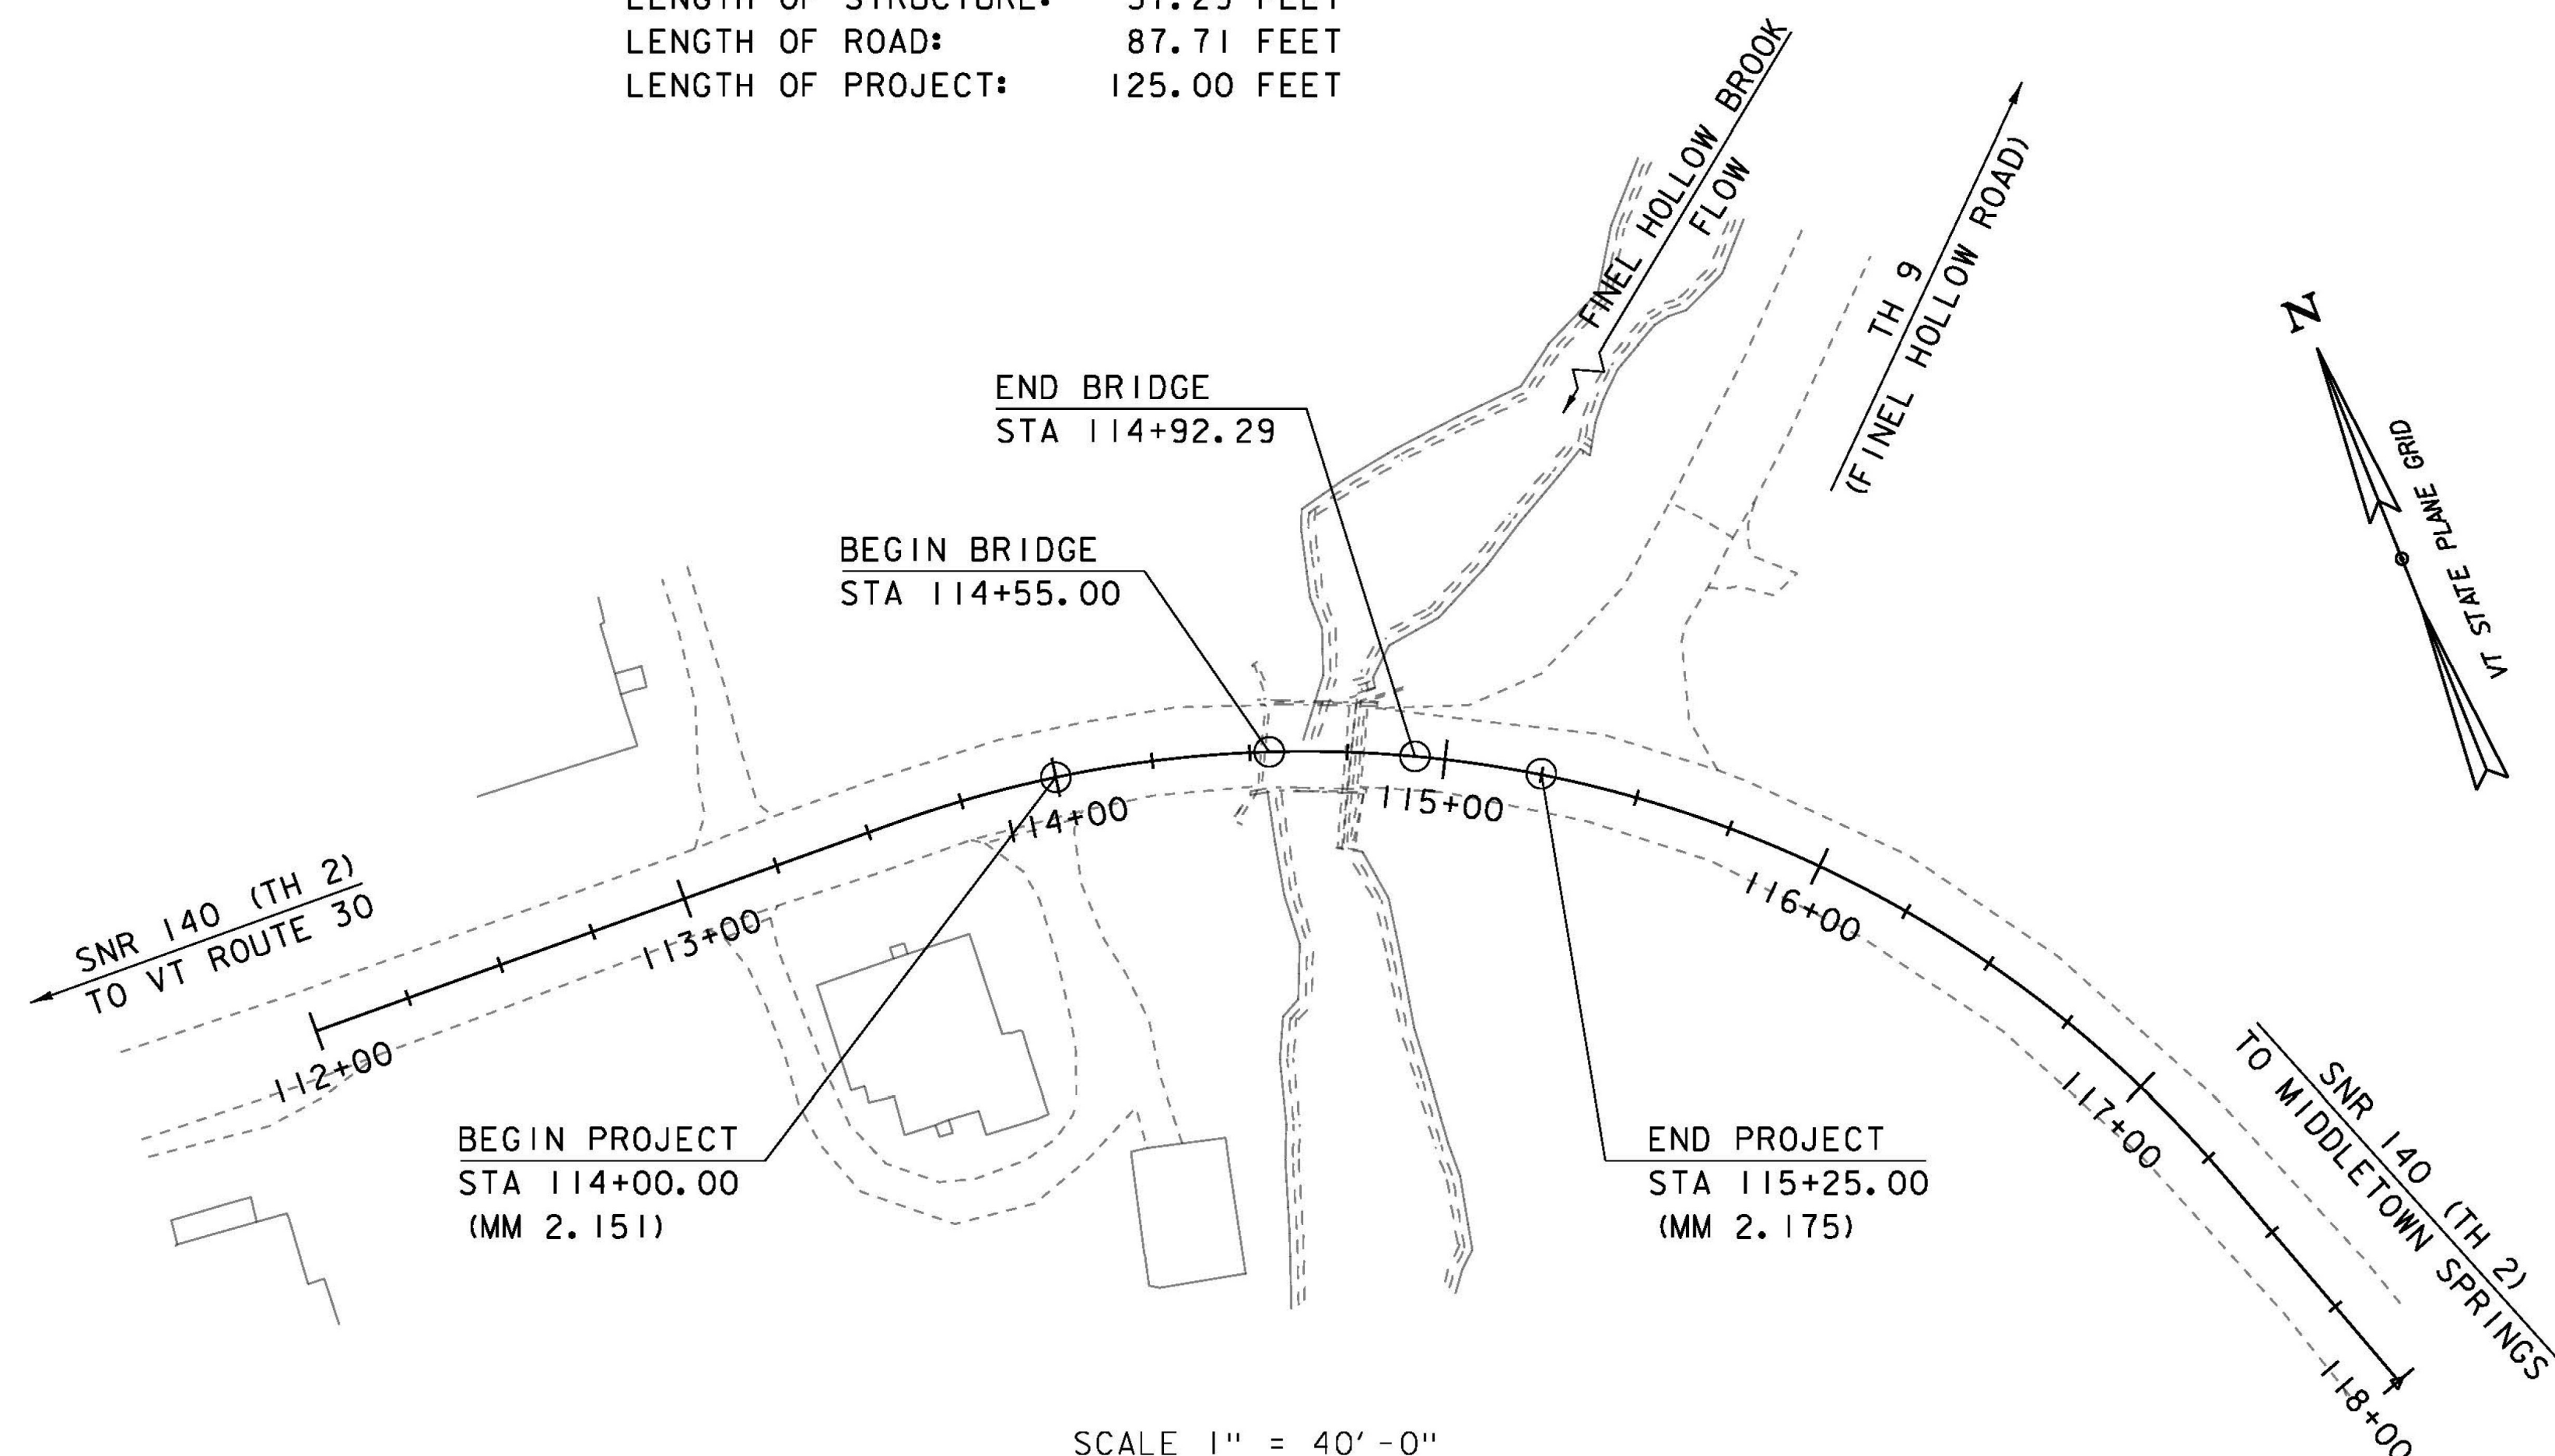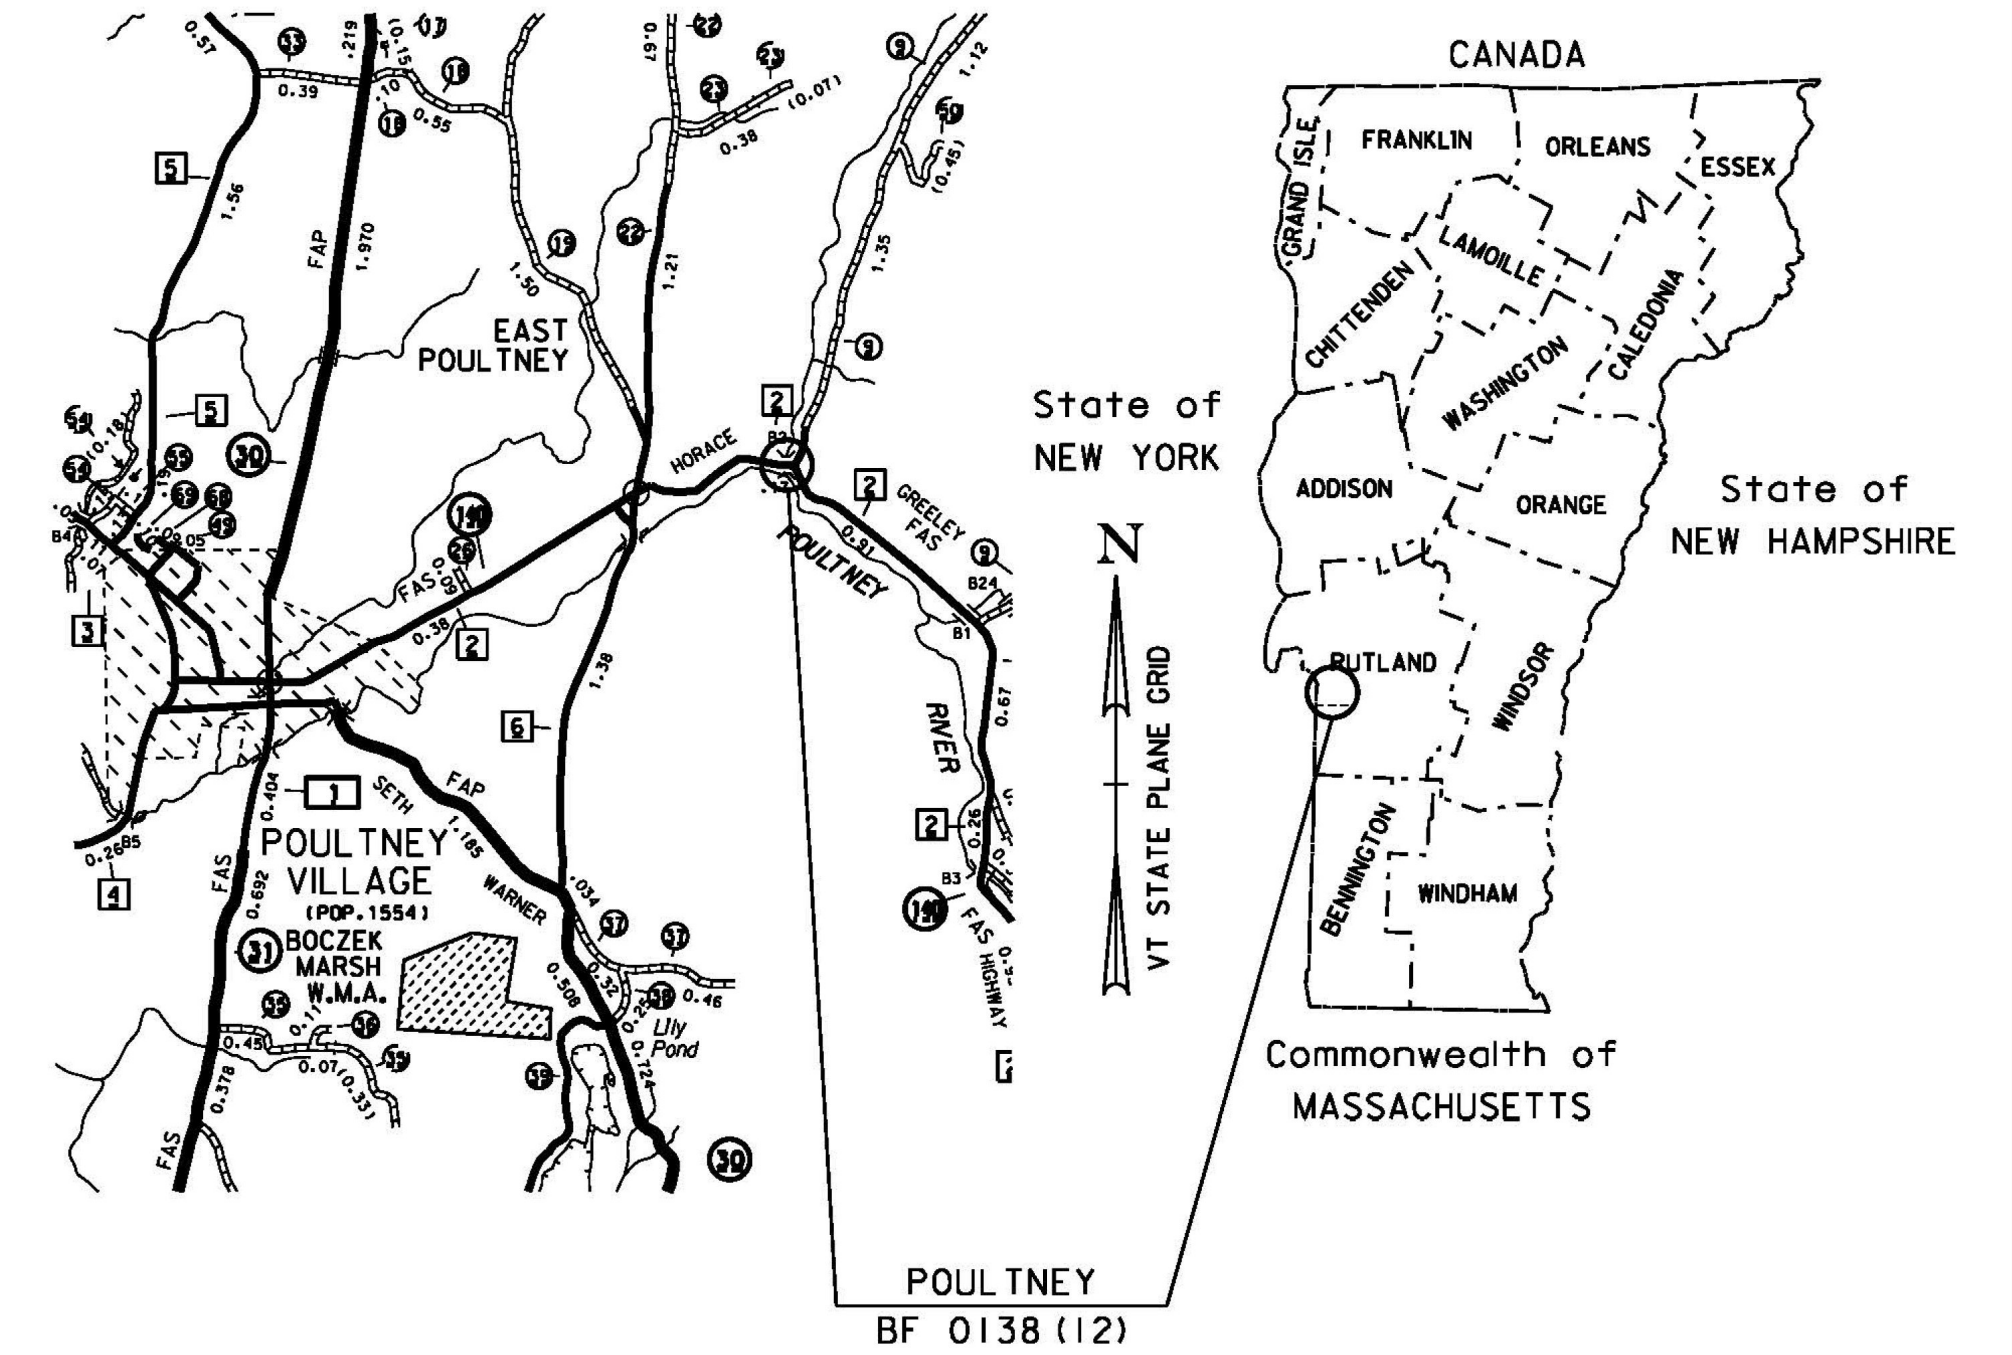

CONSTRUCTION IS TO BE CARRIED ON IN ACCORDANCE WITH THESE PLANS AND THE STANDARD SPECIFICATIONS FOR CONSTRUCTION DATED 2011, AS APPROVED BY THE FEDERAL HIGHWAY ADMINISTRATION ON JULY 20, 2011 FOR USE ON THIS PROJECT, INCLUDING ALL SUBSEQUENT REVISIONS AND SUCH REVISED SPECIFICATIONS AND SPECIAL PROVISIONS AS ARE INCORPORATED IN THESE PLANS.

QUALITY ASSURANCE PROGRAM : LEVEL 2	
SURVEYED BY :	L. ORVIS
SURVEYED DATE :	5-19-2014
DATUM	
VERTICAL	NAVD 88
HORIZONTAL	NAD 1983 (2011)

Record Plans

Contractor: B.U.R. CONSTRUCTION, LLC
Resident Engineer: JACE CURTIS
Construction Began: JUNE 13, 2019
Construction Complete: NOVEMBER 8, 2019
Record Plans By: JUDY GILMORE

I hereby certify that all construction required by this set of drawings has been accomplished as indicated herein.

E-SIGNED by Jace Curtis
on 2020-01-03 17:45:55 GMT Resident Engineer

Date: January 03, 2020

NOTE: Any further information concerning final quantities, amounts or other details relative to this project may be found at Central Files in the electronic archives.

DIRECTOR OF PROJECT DELIVERY	
APPROVED <u>Wayne Symonds</u>	DATE <u>Jul 24, 2018</u>
PROJECT MANAGER :	ROB YOUNG, P. E.
PROJECT NAME :	POULTNEY
PROJECT NUMBER :	BF 0138 (12)
SHEET 1	OF 46 SHEETS