


**MAINLINE PROFILE**

HOR. SCALE 1" = 20'-0"  
VER. SCALE 1" = 10'-0"

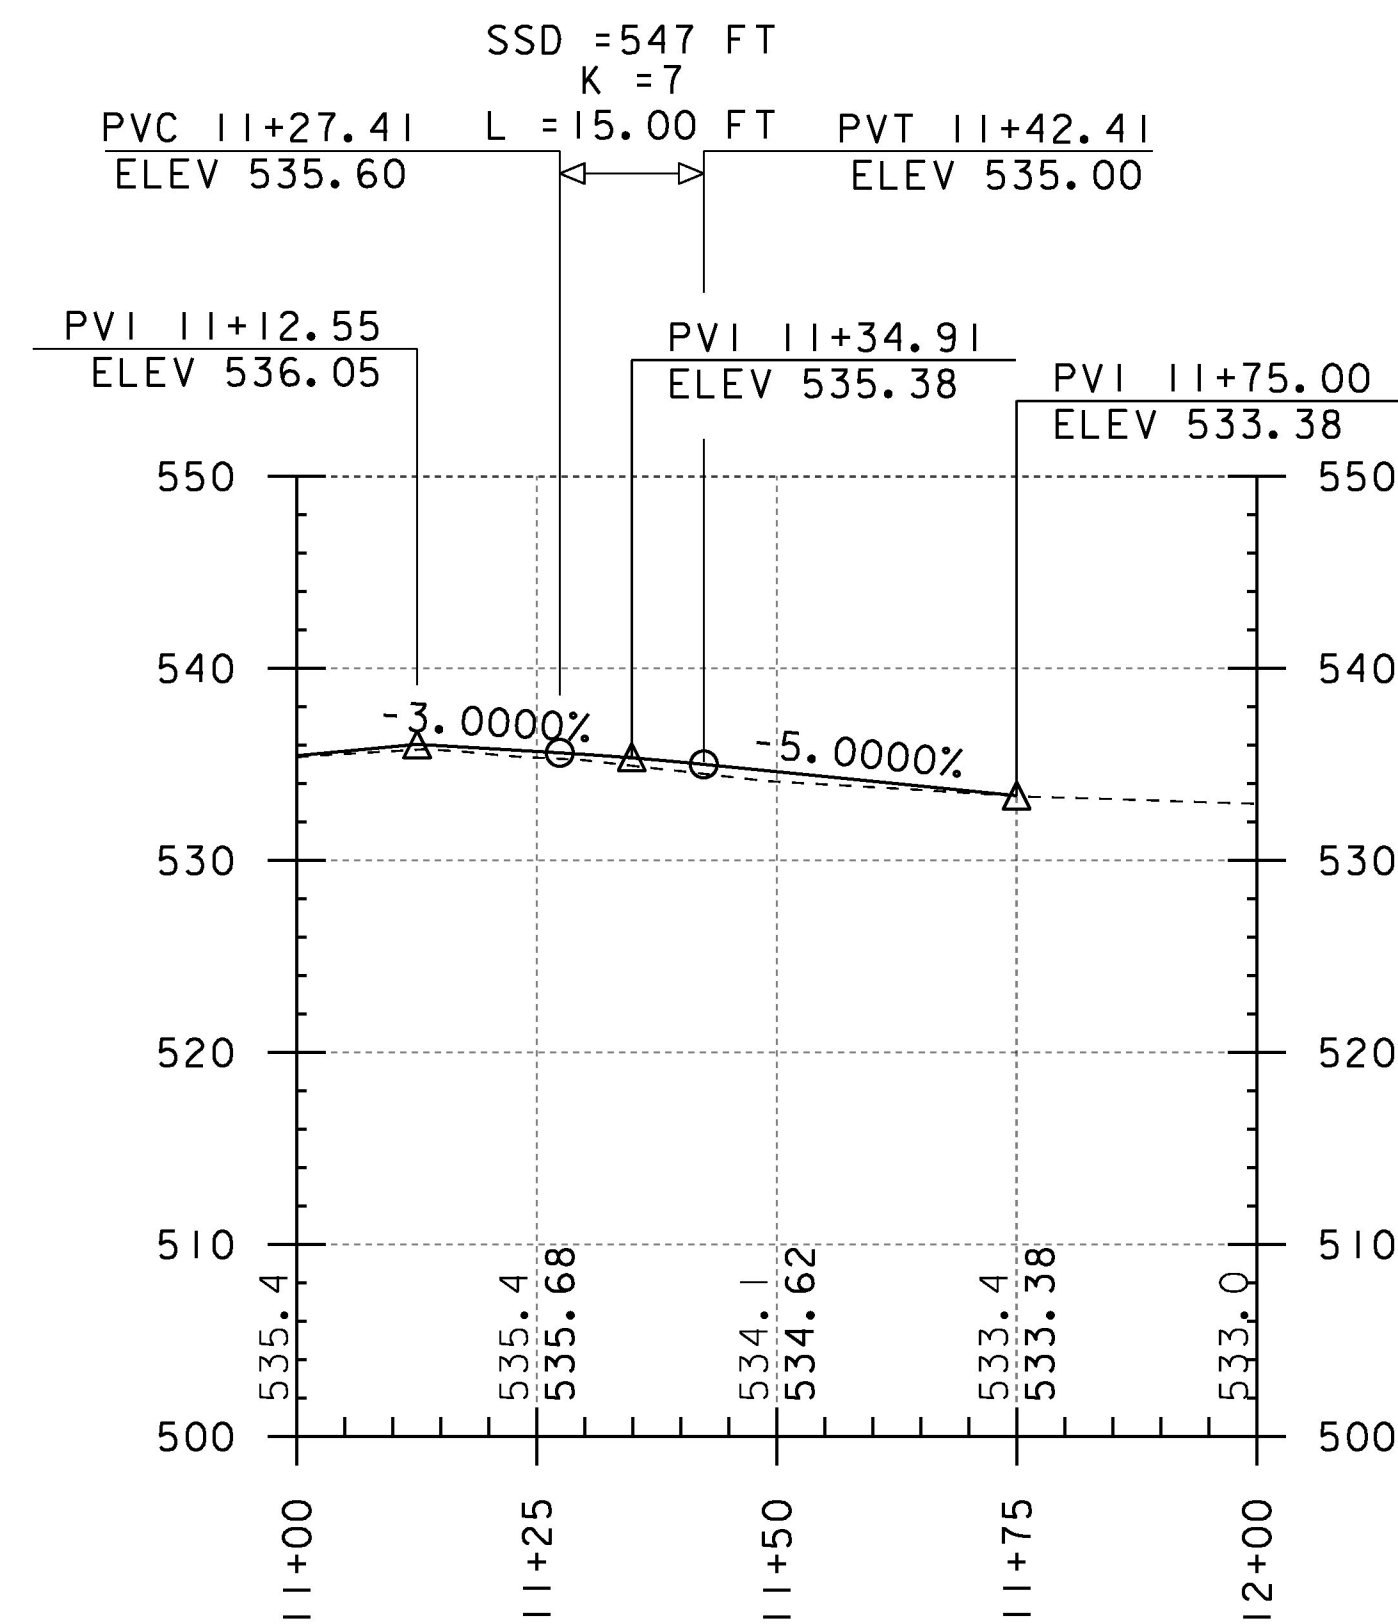

**TH9 PROFILE**

HOR. SCALE 1" = 20'-0"  
VER. SCALE 1" = 10'-0"

THE GRADES SHOWN TO THE TENTH ARE THE EXISTING GROUND ELEVATIONS ALONG THE PROPOSED ALIGNMENT.  
THE GRADES SHOWN TO THE NEAREST HUNDREDTH ARE THE FINISH GRADES ALONG THE PROPOSED ALIGNMENT.

PROJECT NAME:	POULTNEY	PLOT DATE:	15-AUG-2018
PROJECT NUMBER:	BF 0138(12)	DRAWN BY:	G. DARGAN
FILE NAME:	s13j276pro.dgn	DESIGNED BY:	G. DARGAN
PROFILE		CHECKED BY:	G. LAROCHE
		SHEET	14 OF 46