


MATERIAL TRANSITION
 HOR. SCALE 1" = 20'-0"
 VER. SCALE 1" = 2'-0"

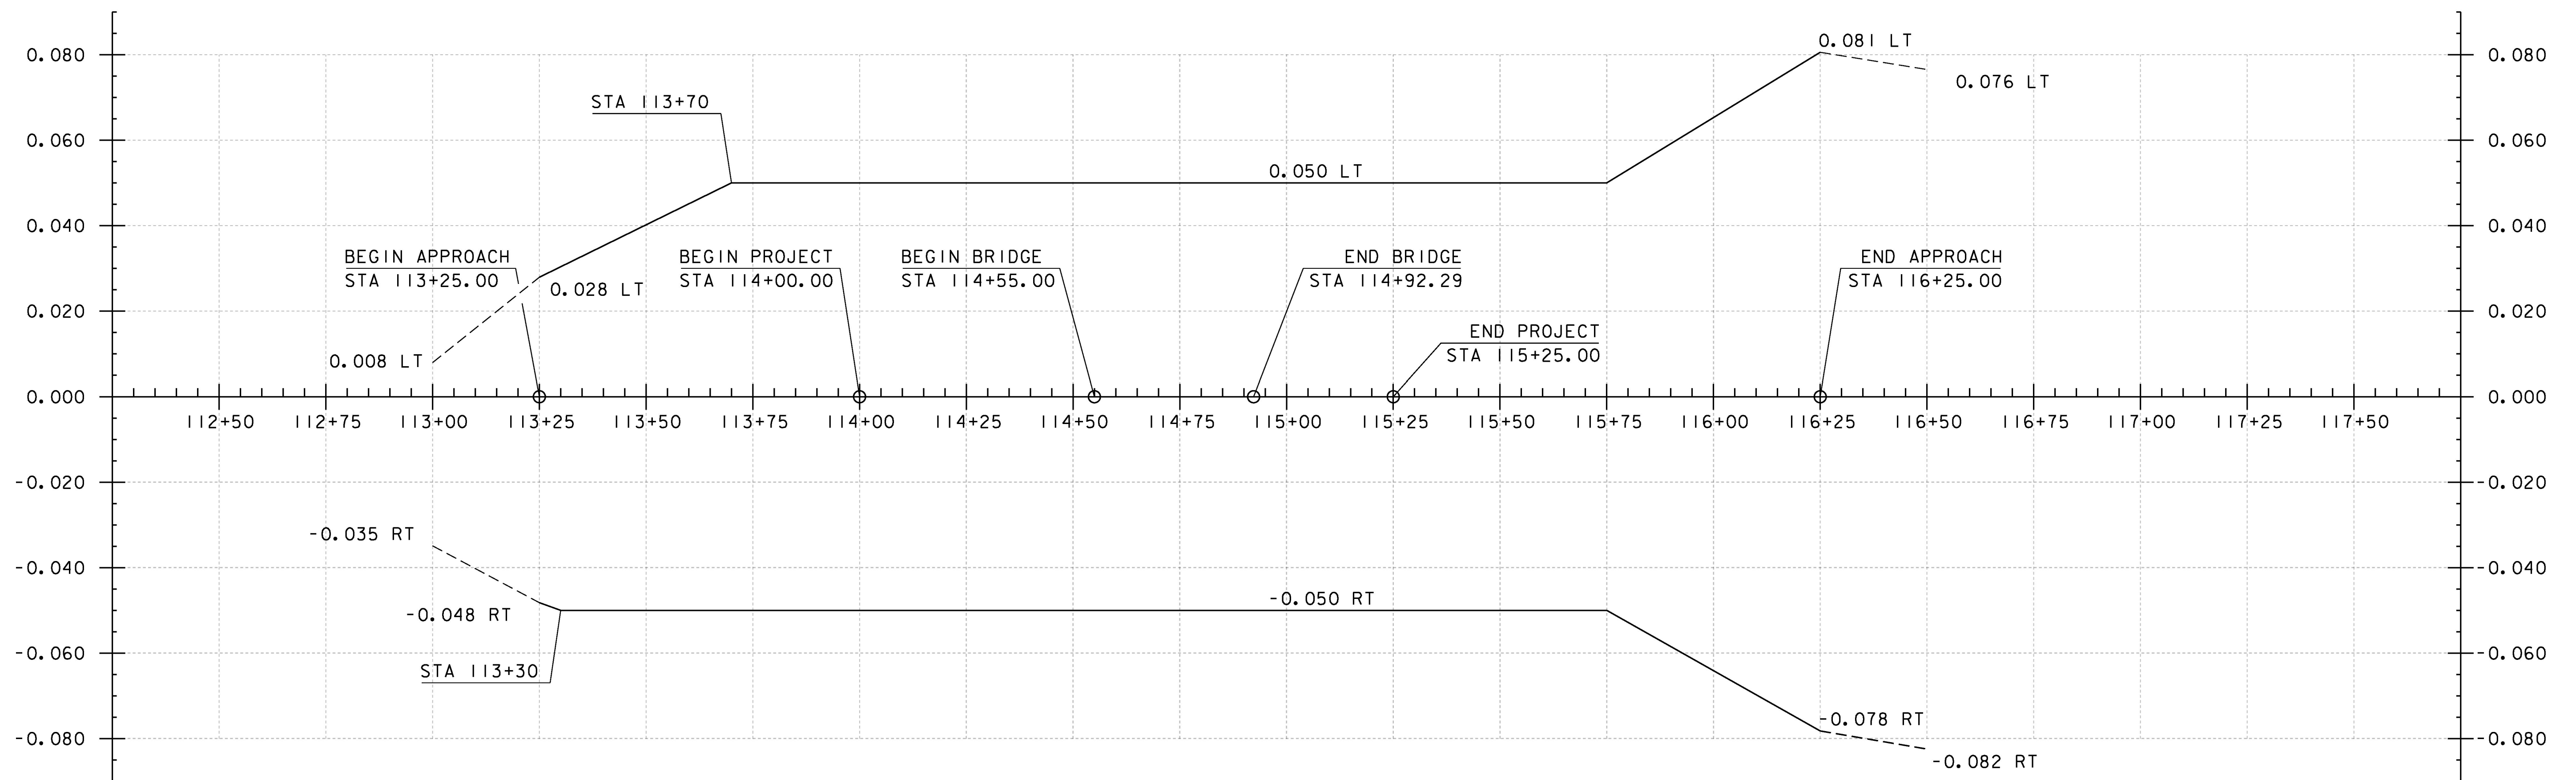

BANKING DIAGRAM
 HOR. SCALE 1" = 20'-0"
 NO VER. SCALE

PROJECT NAME: POULTNEY	PLOT DATE: 15-AUG-2018
PROJECT NUMBER: BF 0138(12)	DRAWN BY: G. DARGAN
FILE NAME: s13j276pro.dgn	CHECKED BY: G. LAROCHE
DESIGNED BY: G. DARGAN	BANKING DIAGRAM AND MATERIAL TRANSITION SHEET 15 OF 46