

HD STEEL BEAM GUARDRAIL, GALVANIZED  
 STA 11+46.4 LT - STA 11+58.9 LT  
 114+20.2 STA ~~113+95.2~~ LT - STA 115+04.5 LT  
 STA 114+10.5 RT - STA 115+40.1 RT



MANUFACTURED TERMINAL SECTION,  
 TANGENT  
 STA 11+58.9 LT - STA 11+72.9 LT

ANCHOR FOR STEEL BEAM GUARDRAIL  
 STA ~~114+03.3~~ LT 114+28.3  
 STA 114+17.8 RT

REMOVE AND RESET GUARDRAIL  
 STA 115+40.1 RT - STA ~~115+66.2~~ RT  
 116+16.2

DELINEATOR WITH STEEL POST  
 STA ~~113+73~~ LT (BLUE) 115+06  
 STA ~~113+95~~ LT (GREEN) 114+32  
 STA ~~114+10~~ RT (BLUE) 114+22

SPECIAL PROVISION (HD STEEL BEAM  
 GUARDRAIL, GALVANIZED) (35 FOOT RADIUS)  
 STA 115+04.5 LT - STA 11+46.4 LT

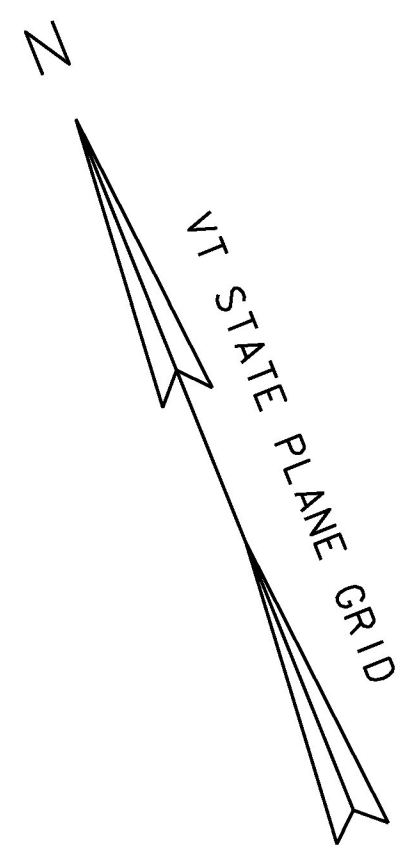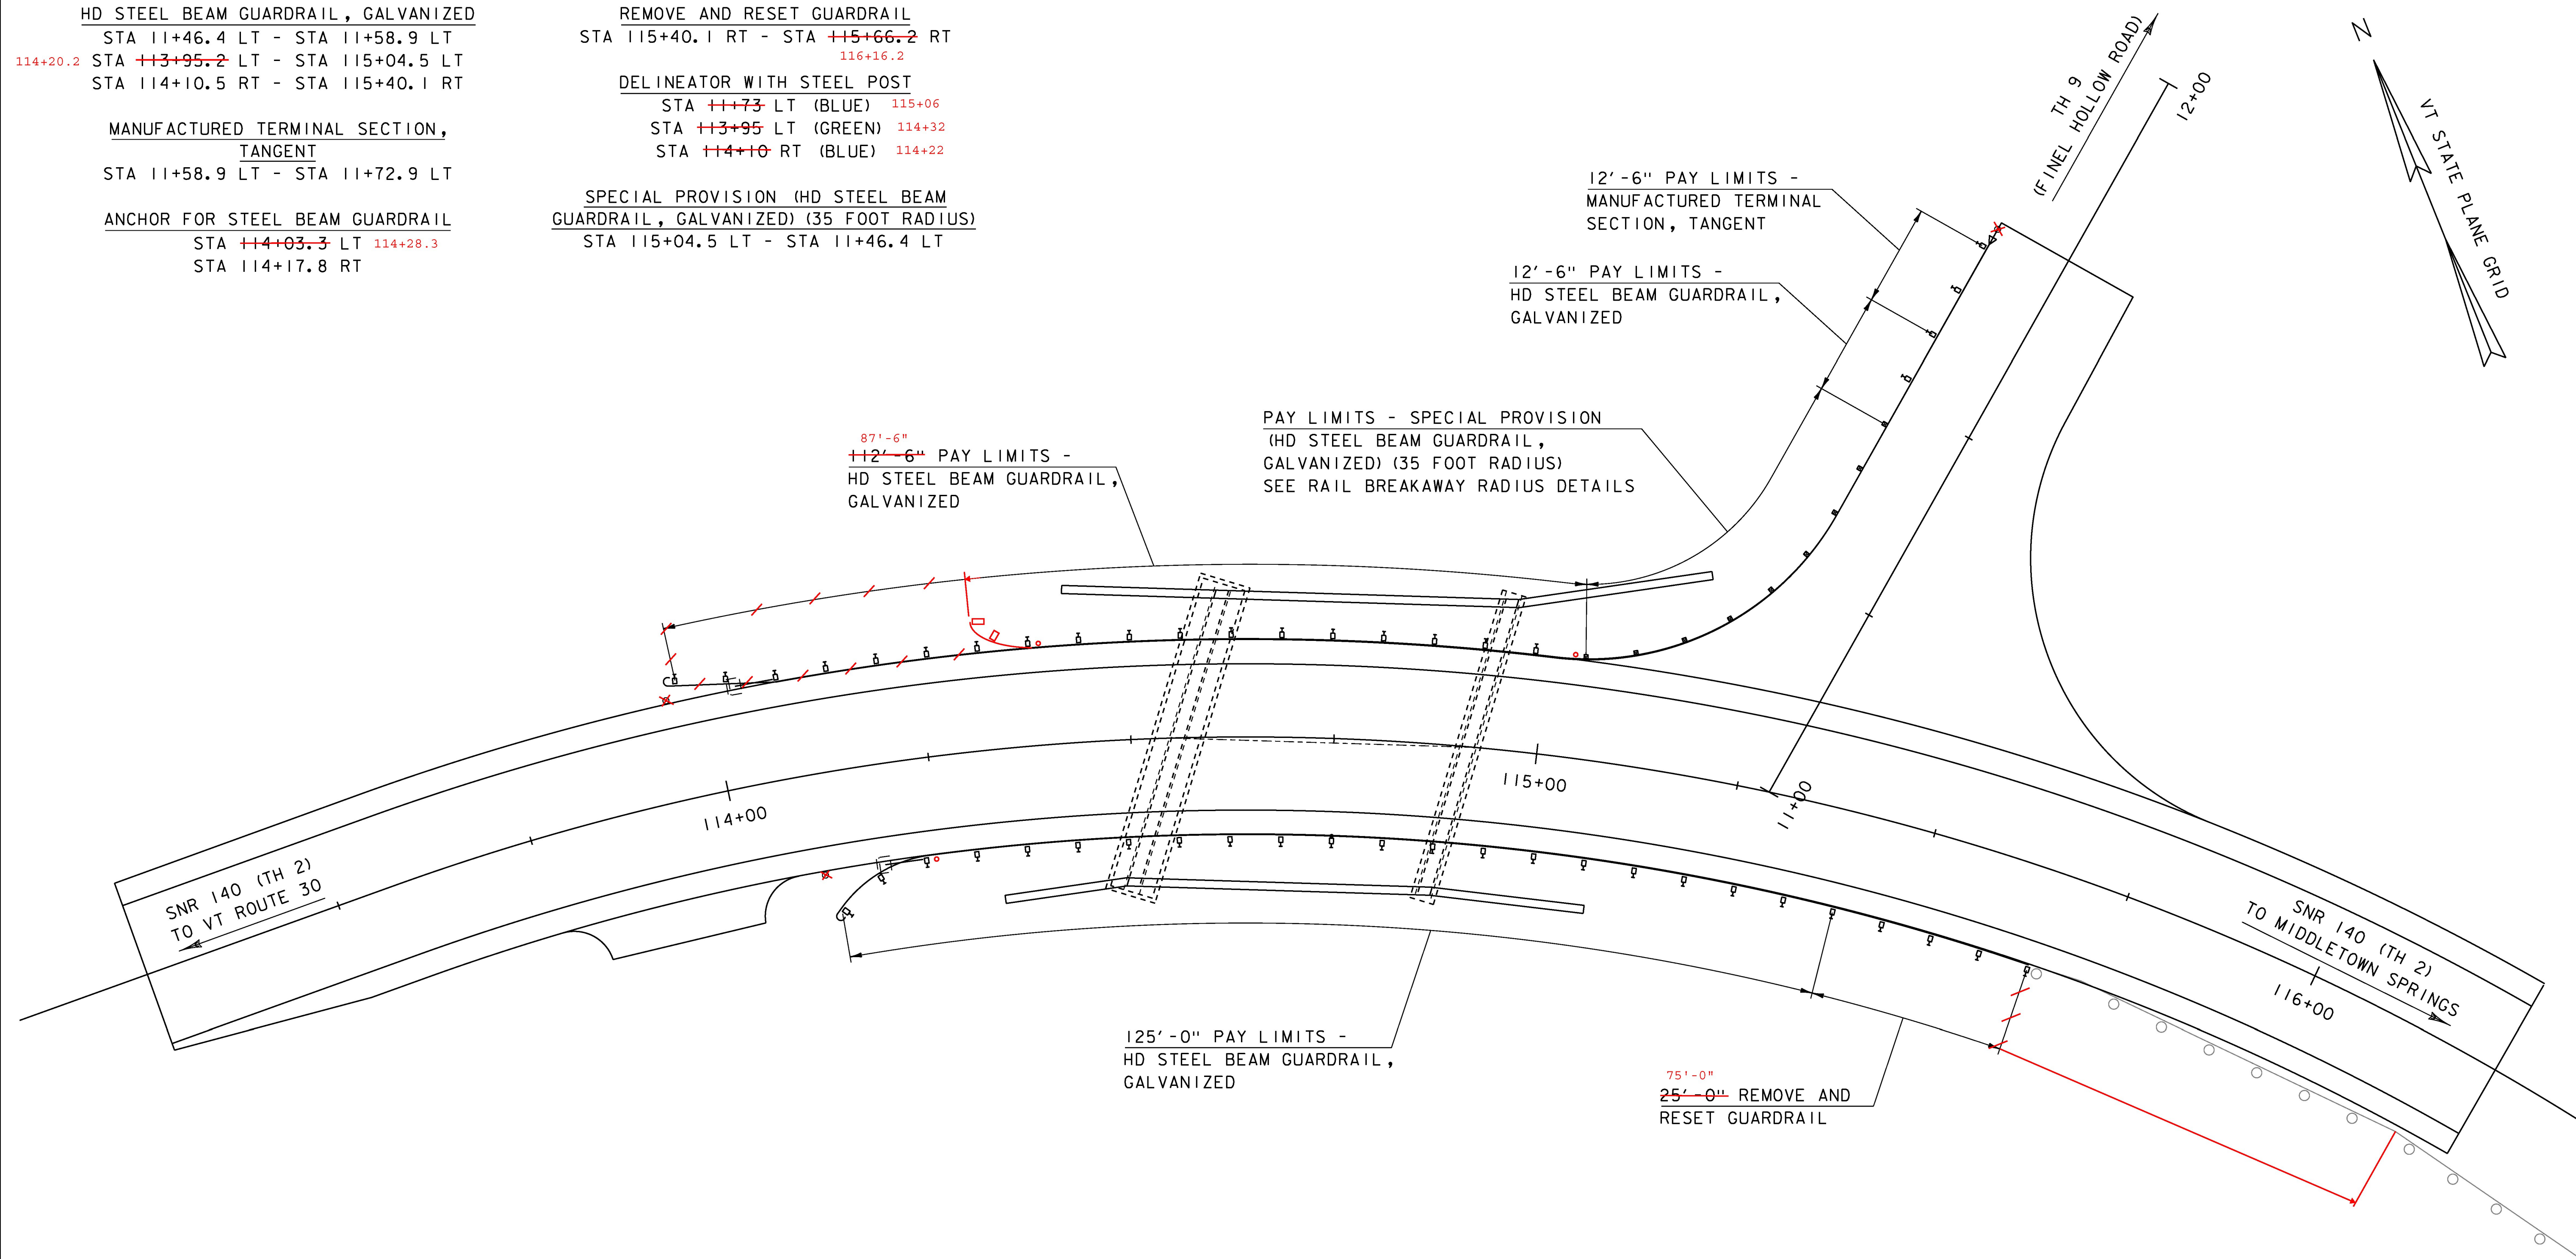

END TREATMENTS:

WW1: ~~FLARED~~ G1-D  
 WW2: G1-D  
 WW3: MANUFACTURED TERMINAL SECTION (TANGENT)  
 WW4: TIE-IN TO EXISTING RAIL

NOTES:

1. SEE STANDARDS G-1, G-1D, G-19 FOR FURTHER DETAILS.

SCALE 1" = 10'-0"  
 10 0 10

PROJECT NAME:	POULTNEY	PLOT DATE:	15-AUG-2018
PROJECT NUMBER:	BF 0138(12)	DRAWN BY:	G. DARGAN
FILE NAME:	s13j276bdr_rail.dgn	CHECKED BY:	G. LAROCHE
PROJECT LEADER:	R. YOUNG	RAIL LAYOUT	SHEET 16 OF 46
DESIGNED BY:	G. DARGAN		