



4 INCH YELLOW LINE (DOUBLE)
 STA 113+25.0 - STA 115+10.0
 STA 115+65.0 - STA 116+25.0

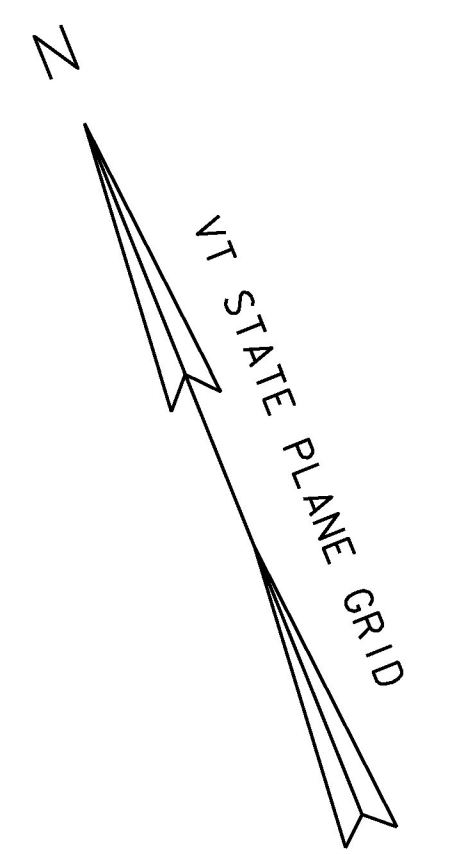

STA 114+51.5 LT
 STA 114+48.5 RT
 STA 114+83.0 LT
 STA 114+82.5 RT

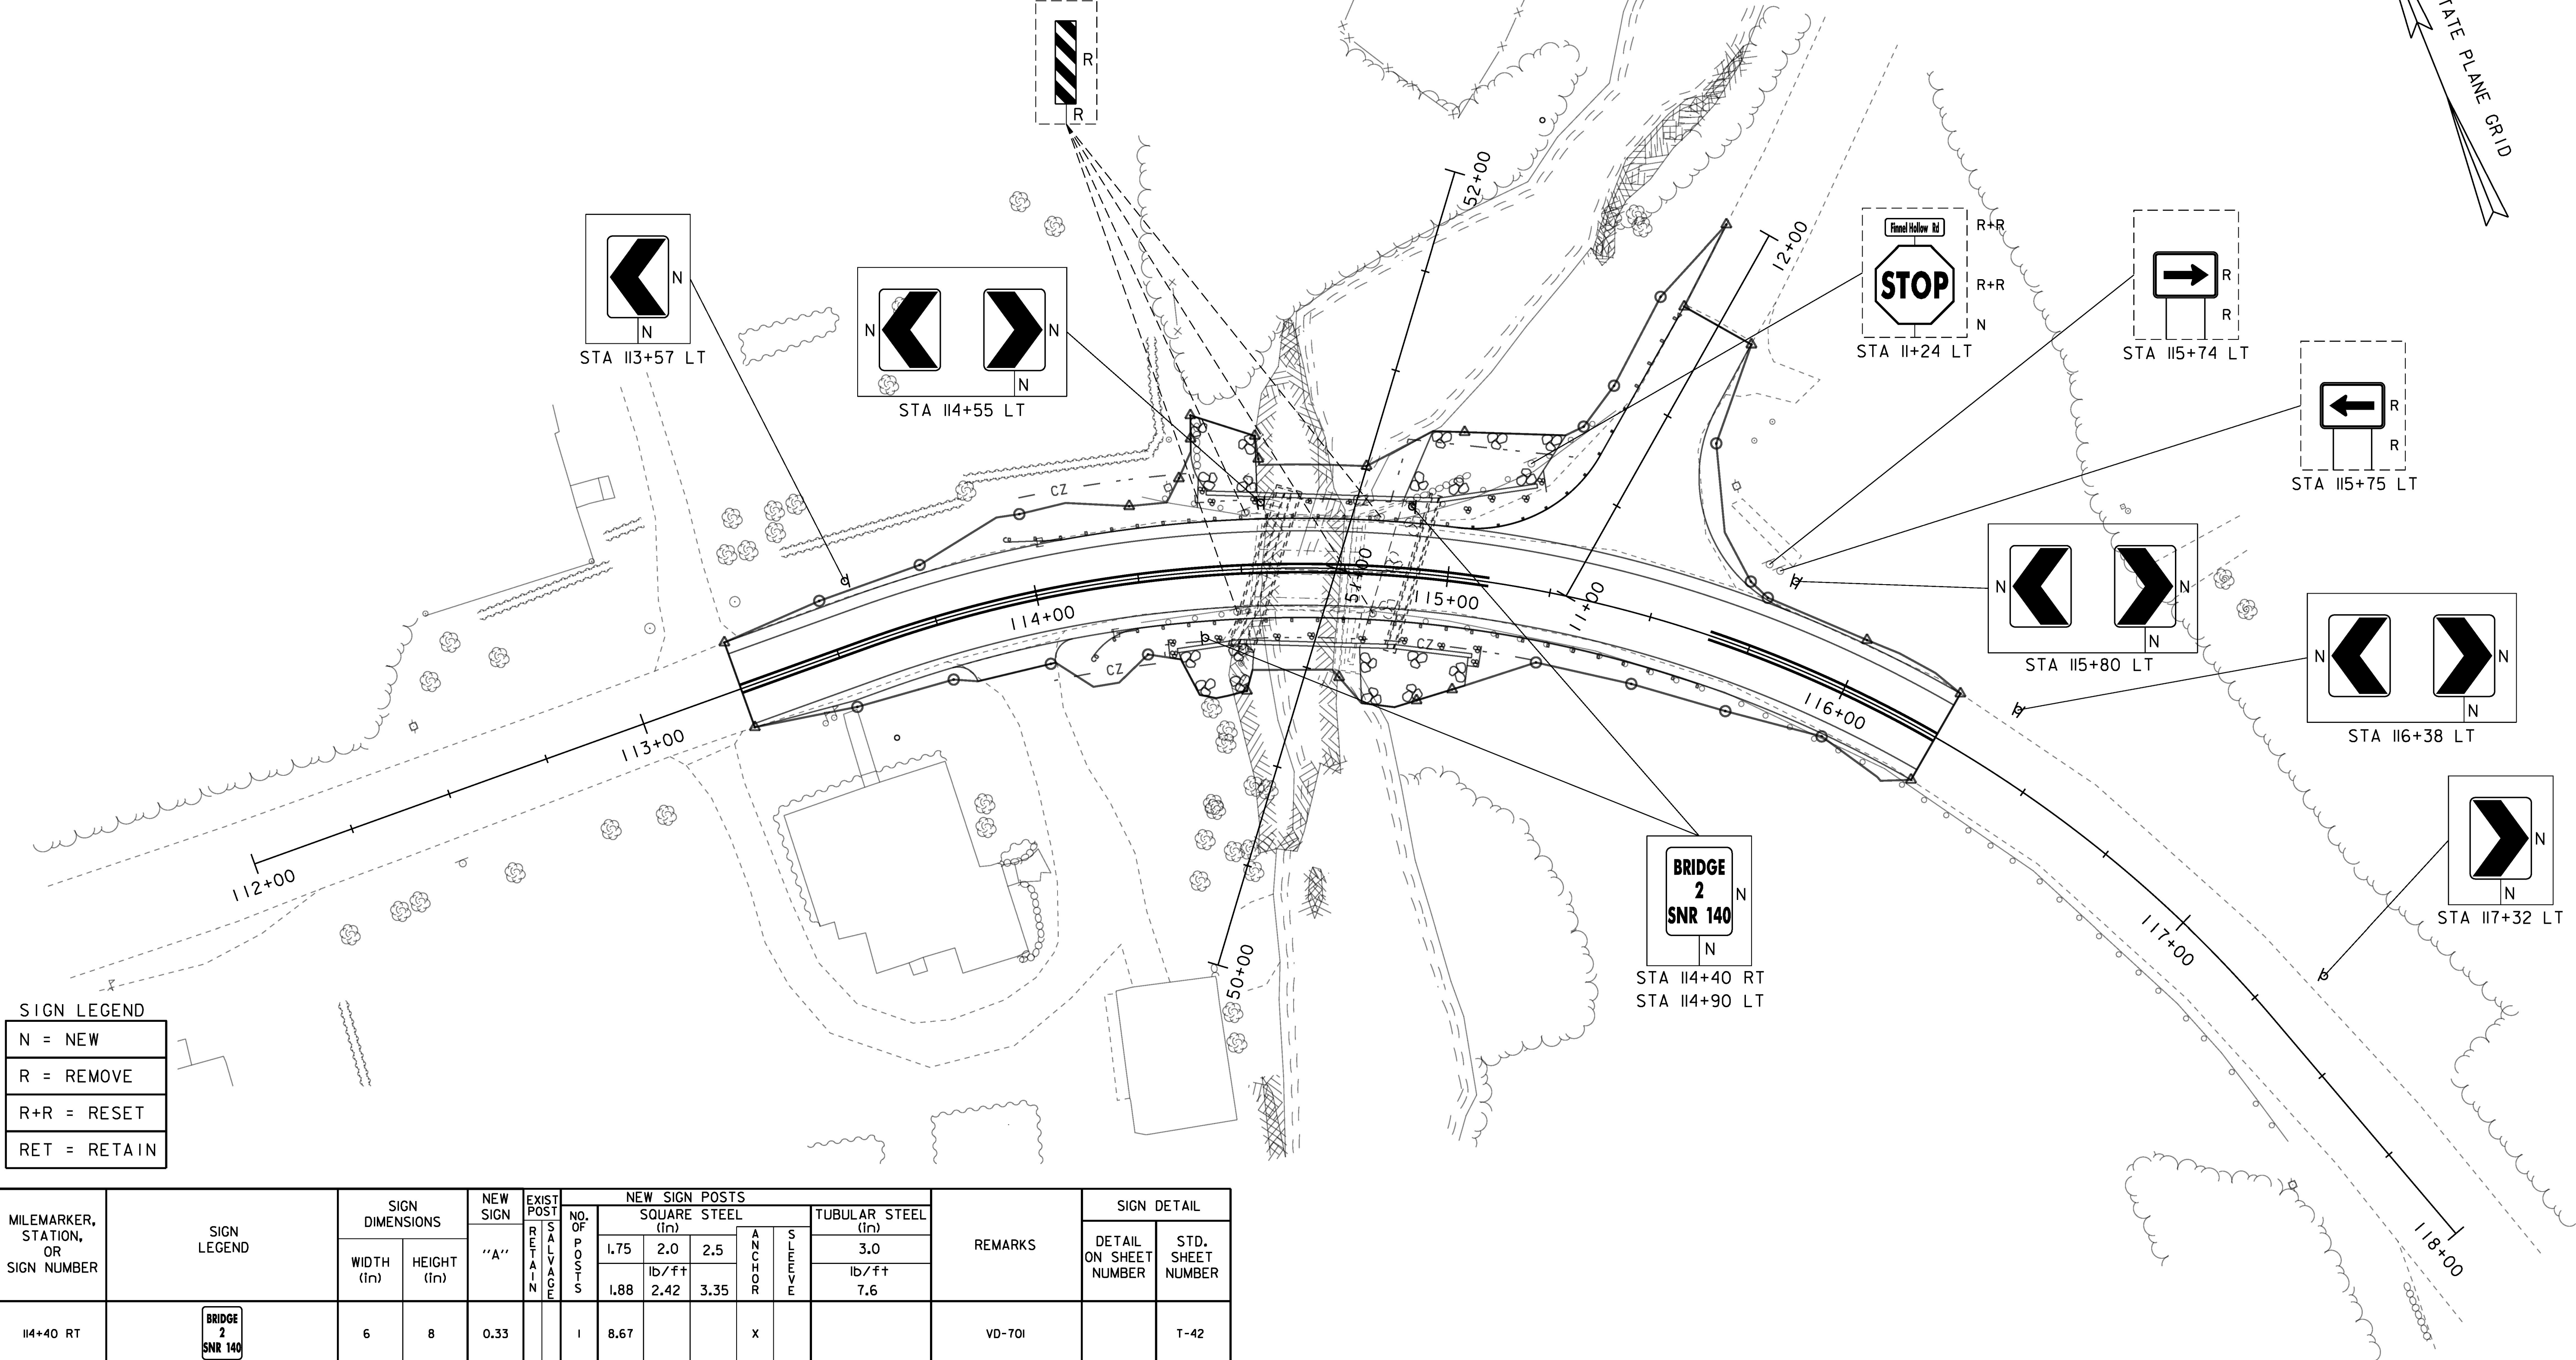

SIGN LEGEND

N = NEW
R = REMOVE
R+R = RESET
RET = RETAIN

MILEMARKER, STATION, OR SIGN NUMBER	SIGN LEGEND	SIGN DIMENSIONS		NEW SIGN "A"	EXIST POST REL. TO ALIGN	NO. OF POSTS	NEW SIGN POSTS					REMARKS	SIGN DETAIL		
		WIDTH (in)	HEIGHT (in)				SQUARE STEEL (in)			ANCHOR	SUPPORT		TUBULAR STEEL (in)	DETAIL ON SHEET NUMBER	STD. SHEET NUMBER
							1.75	2.0	2.5				3.0		
						1.88	2.42	3.35	lb/ft	lb/ft					
114+40 RT	BRIDGE 2 SNR 140	6	8	0.33		1	8.67			X		VD-701		T-42	
114+90 LT	BRIDGE 2 SNR 140	6	8	0.33		1	8.67			X		VD-701		T-42	
SEE CALLOUTS	Arrow pointing right	18	24	3.00		4		26.01		X		WI-8			
SEE CALLOUTS	Arrow pointing left	18	24	3.00		1		8.67		X		WI-8			

SCALE 1" = 20'-0"
 20 0 20

NOTE:
 ADJUST NEW CENTERLINE TO MATCH EXISTING LINES AT BEGIN/END APPROACH

PROJECT NAME: POULTNEY	PLOT DATE: 23-AUG-2018
PROJECT NUMBER: BF 0138(12)	DRAWN BY: T. MATTHEWS
FILE NAME: s13j276sign.dgn	CHECKED BY: G. LAROCHE
PROJECT LEADER: R. YOUNG	SHEET 20 OF 46
DESIGNED BY: G. DARGAN	
SIGNS AND PAVEMENT MARKINGS	