



113+25


STA 113+25.00  
BEGIN APPROACH  
MATCH EXISTING

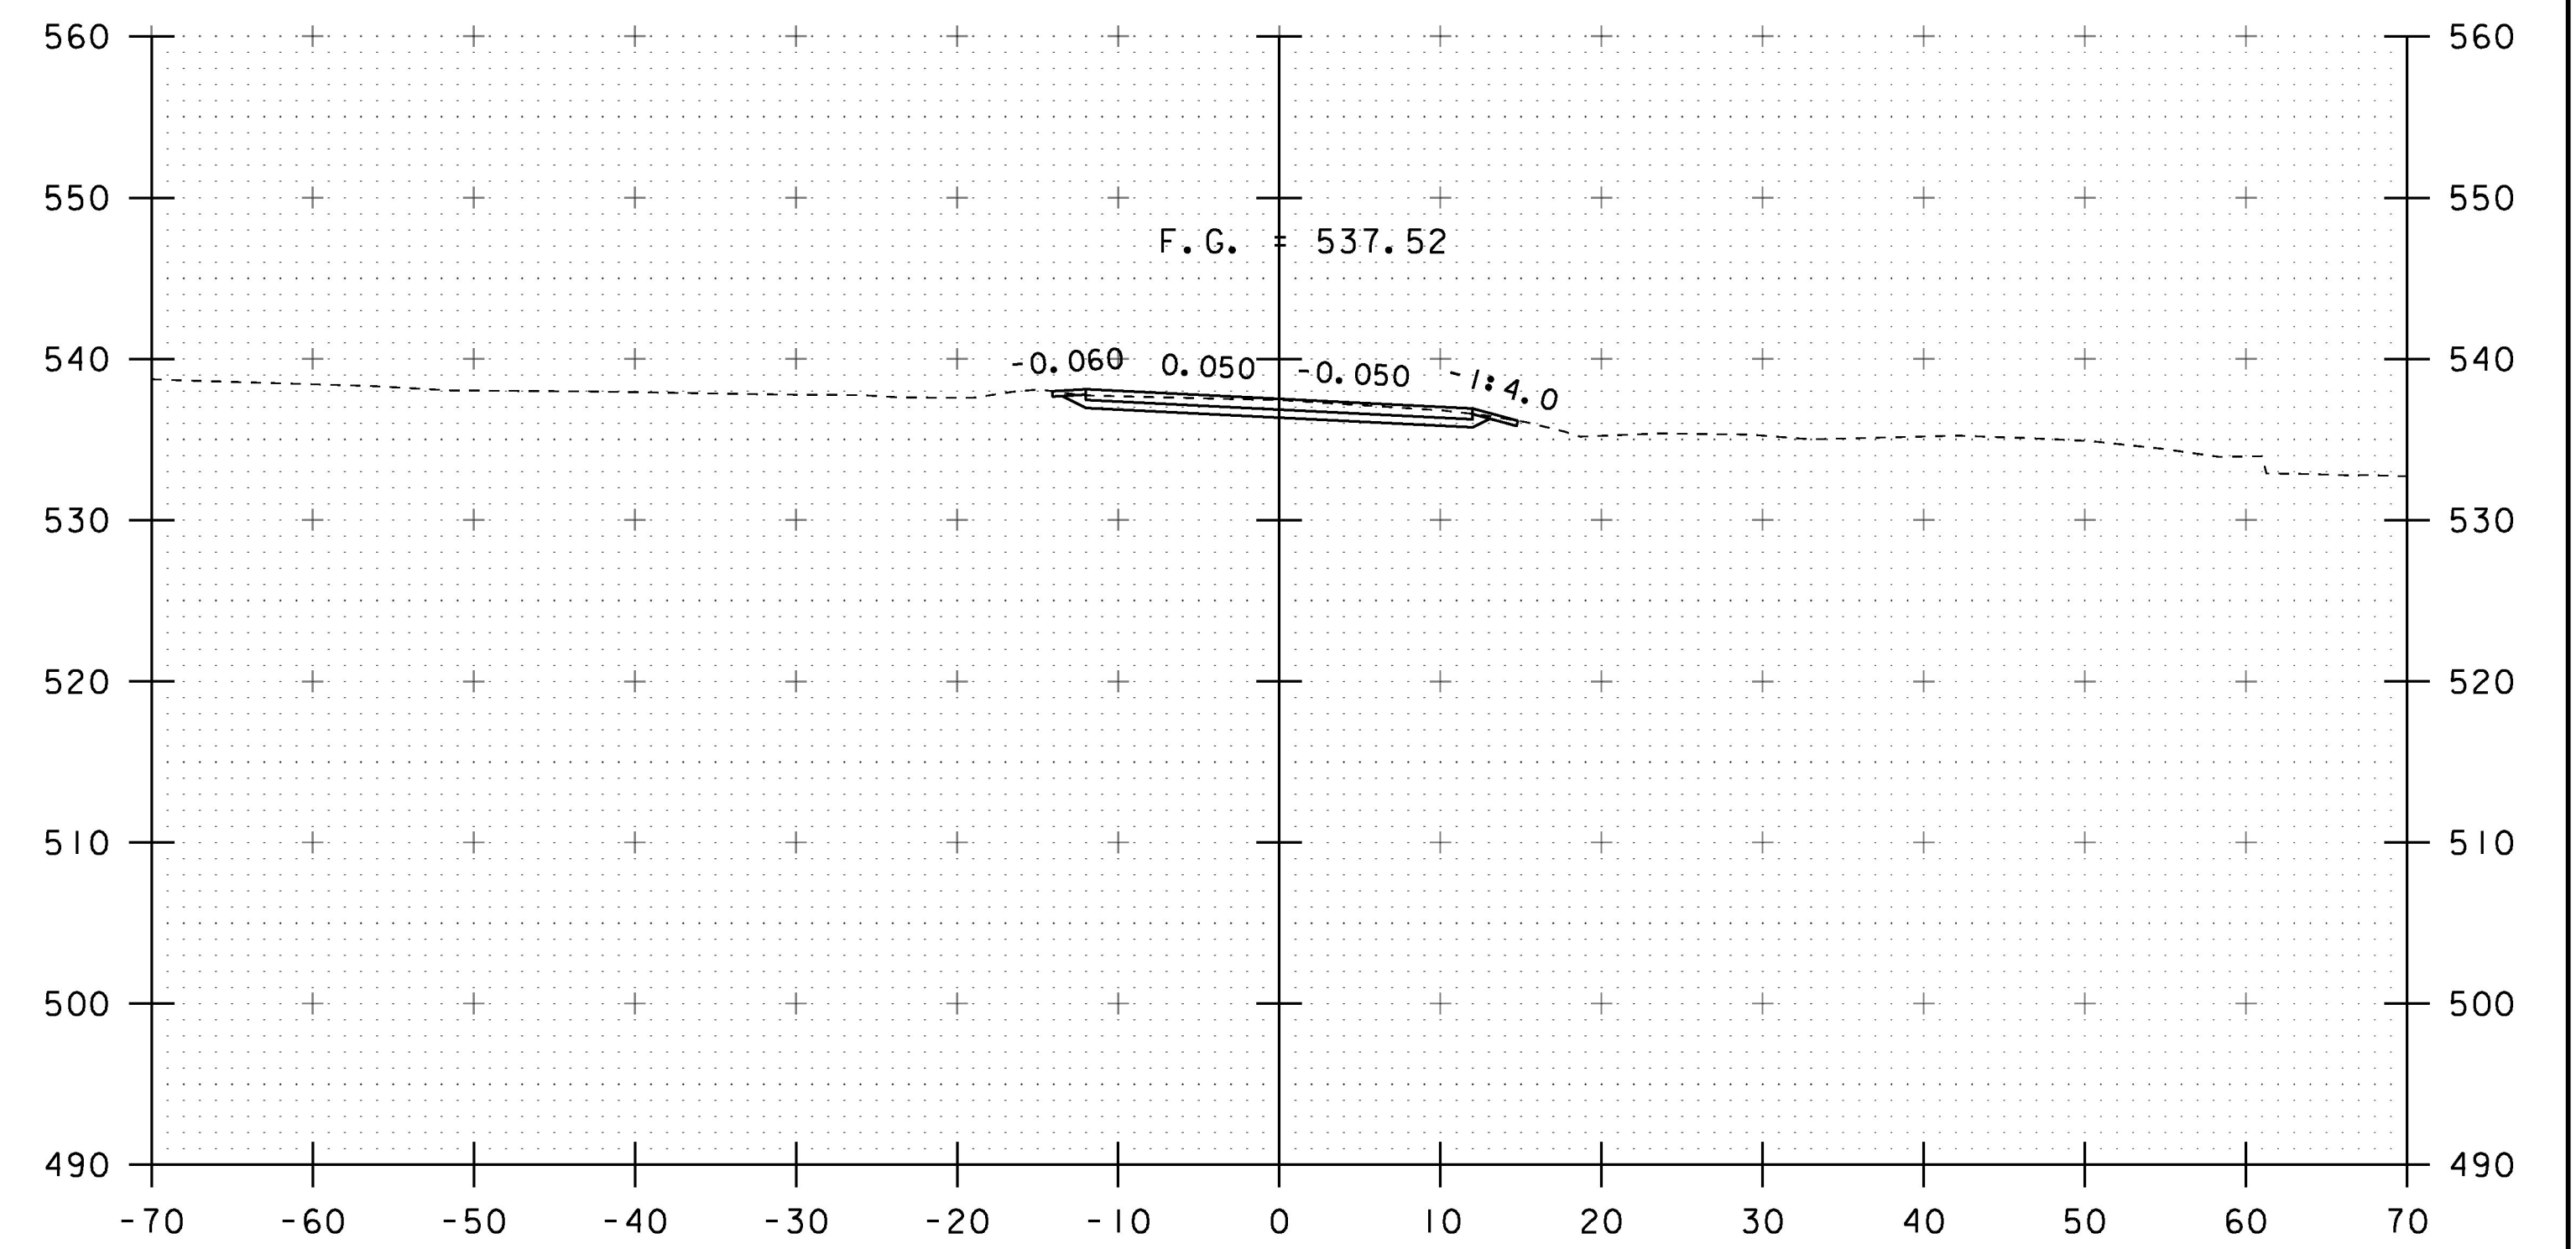


113+75

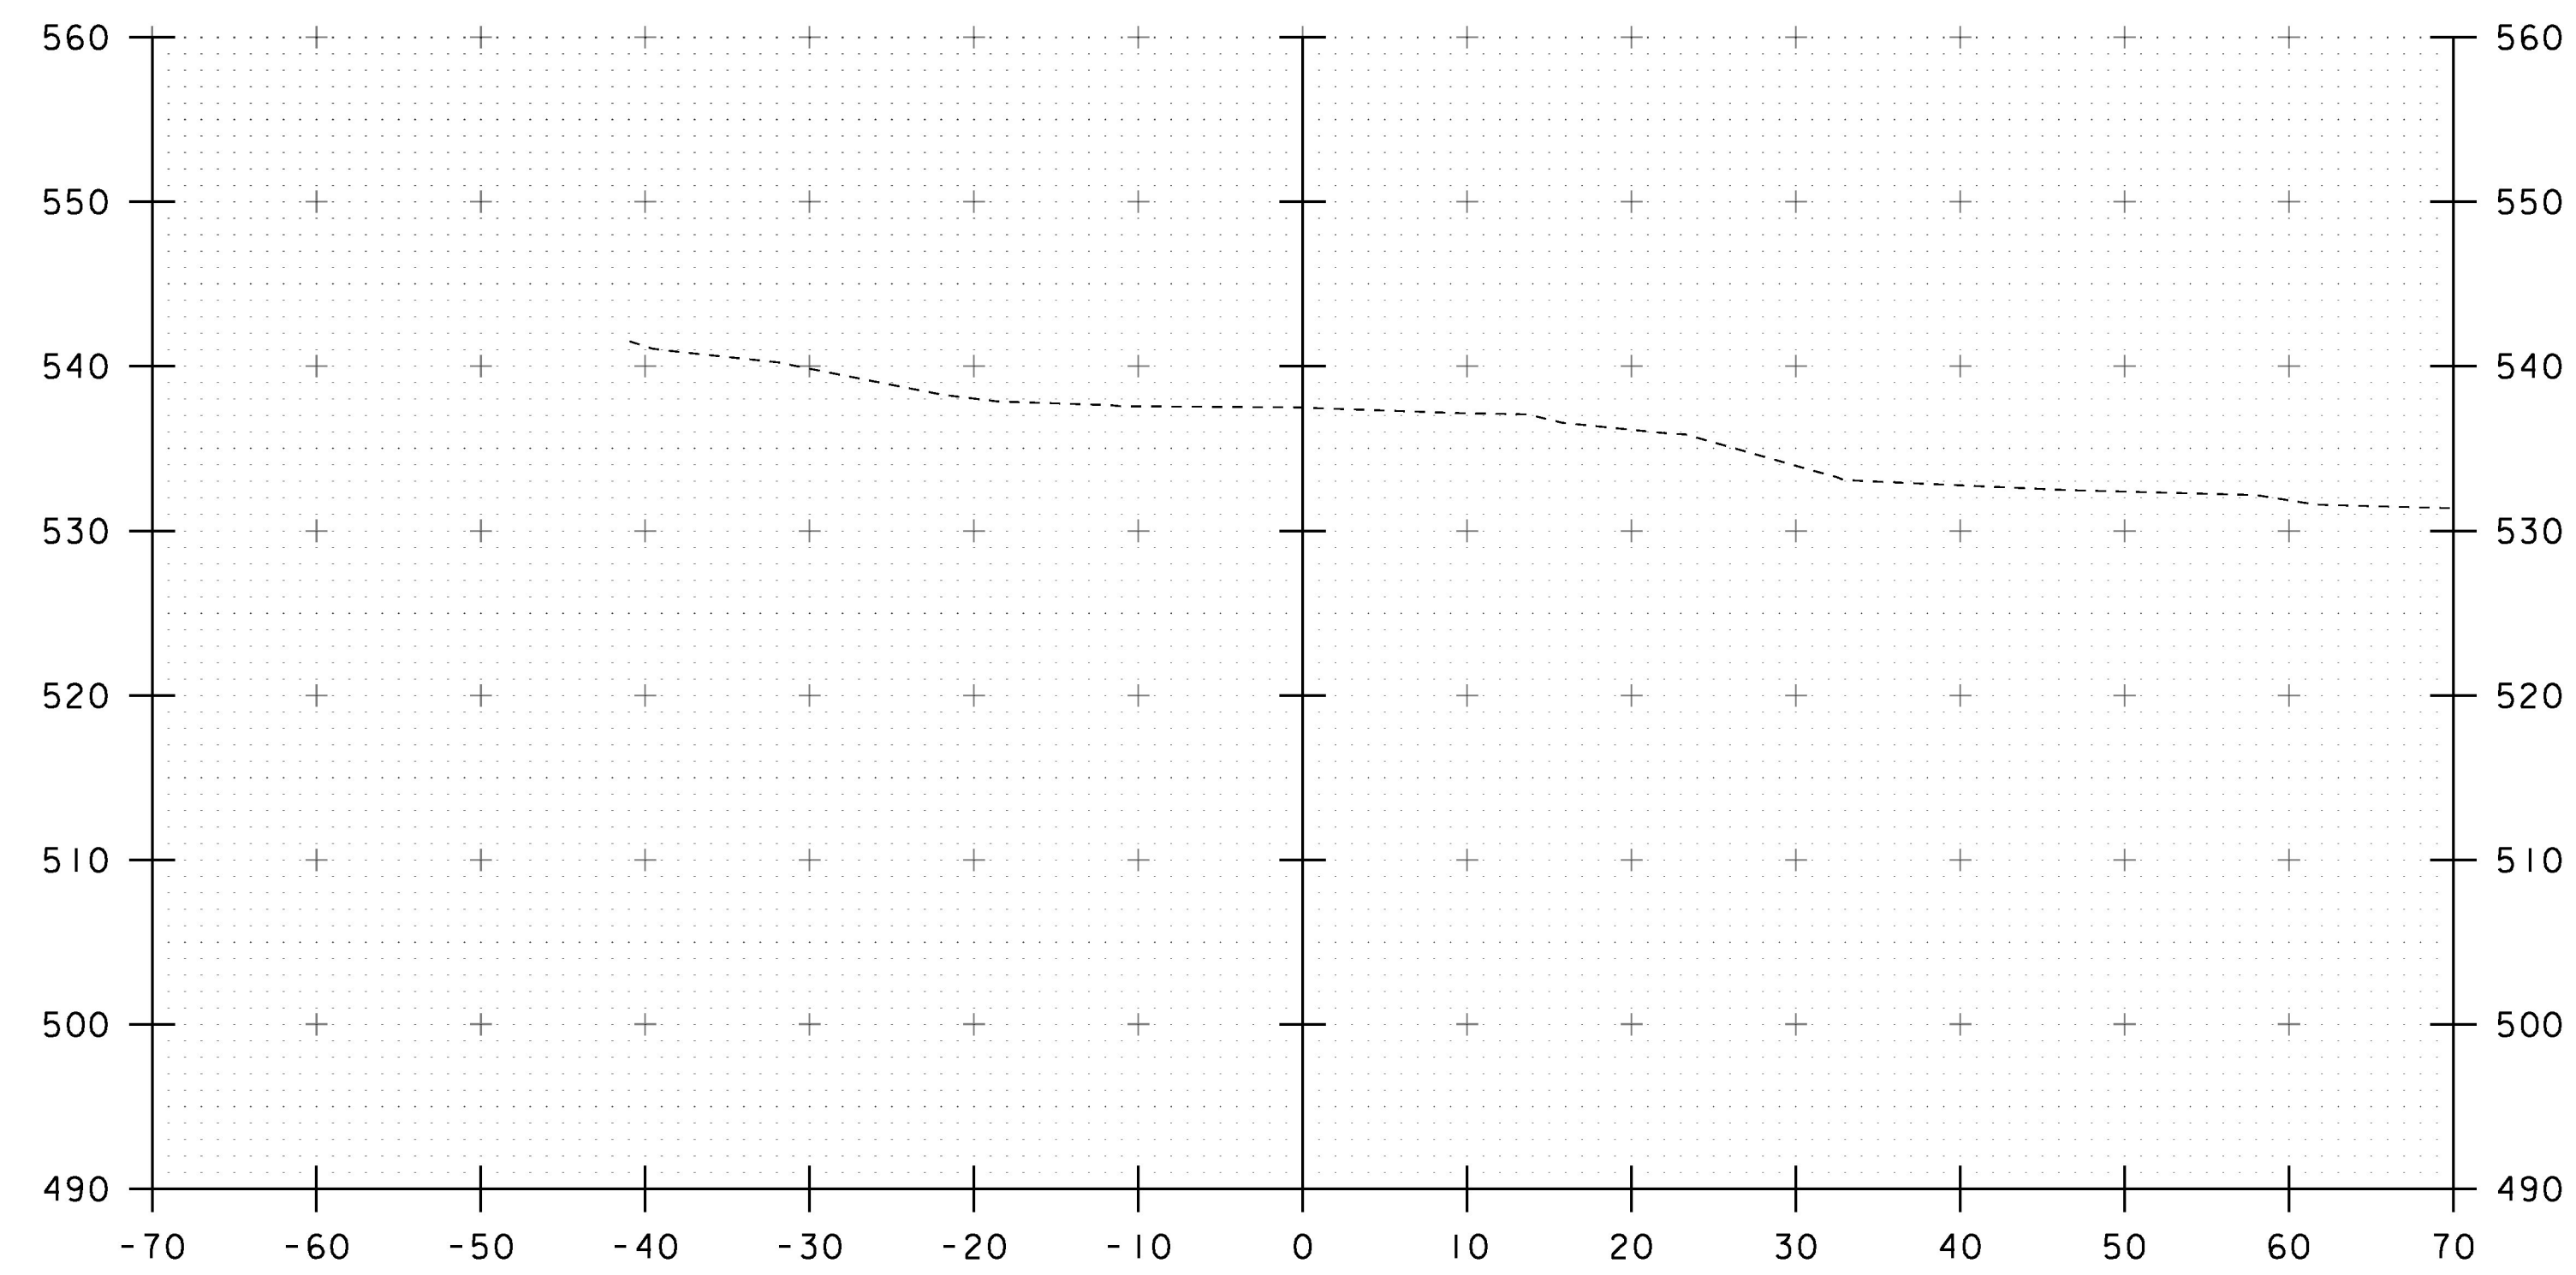

113+00

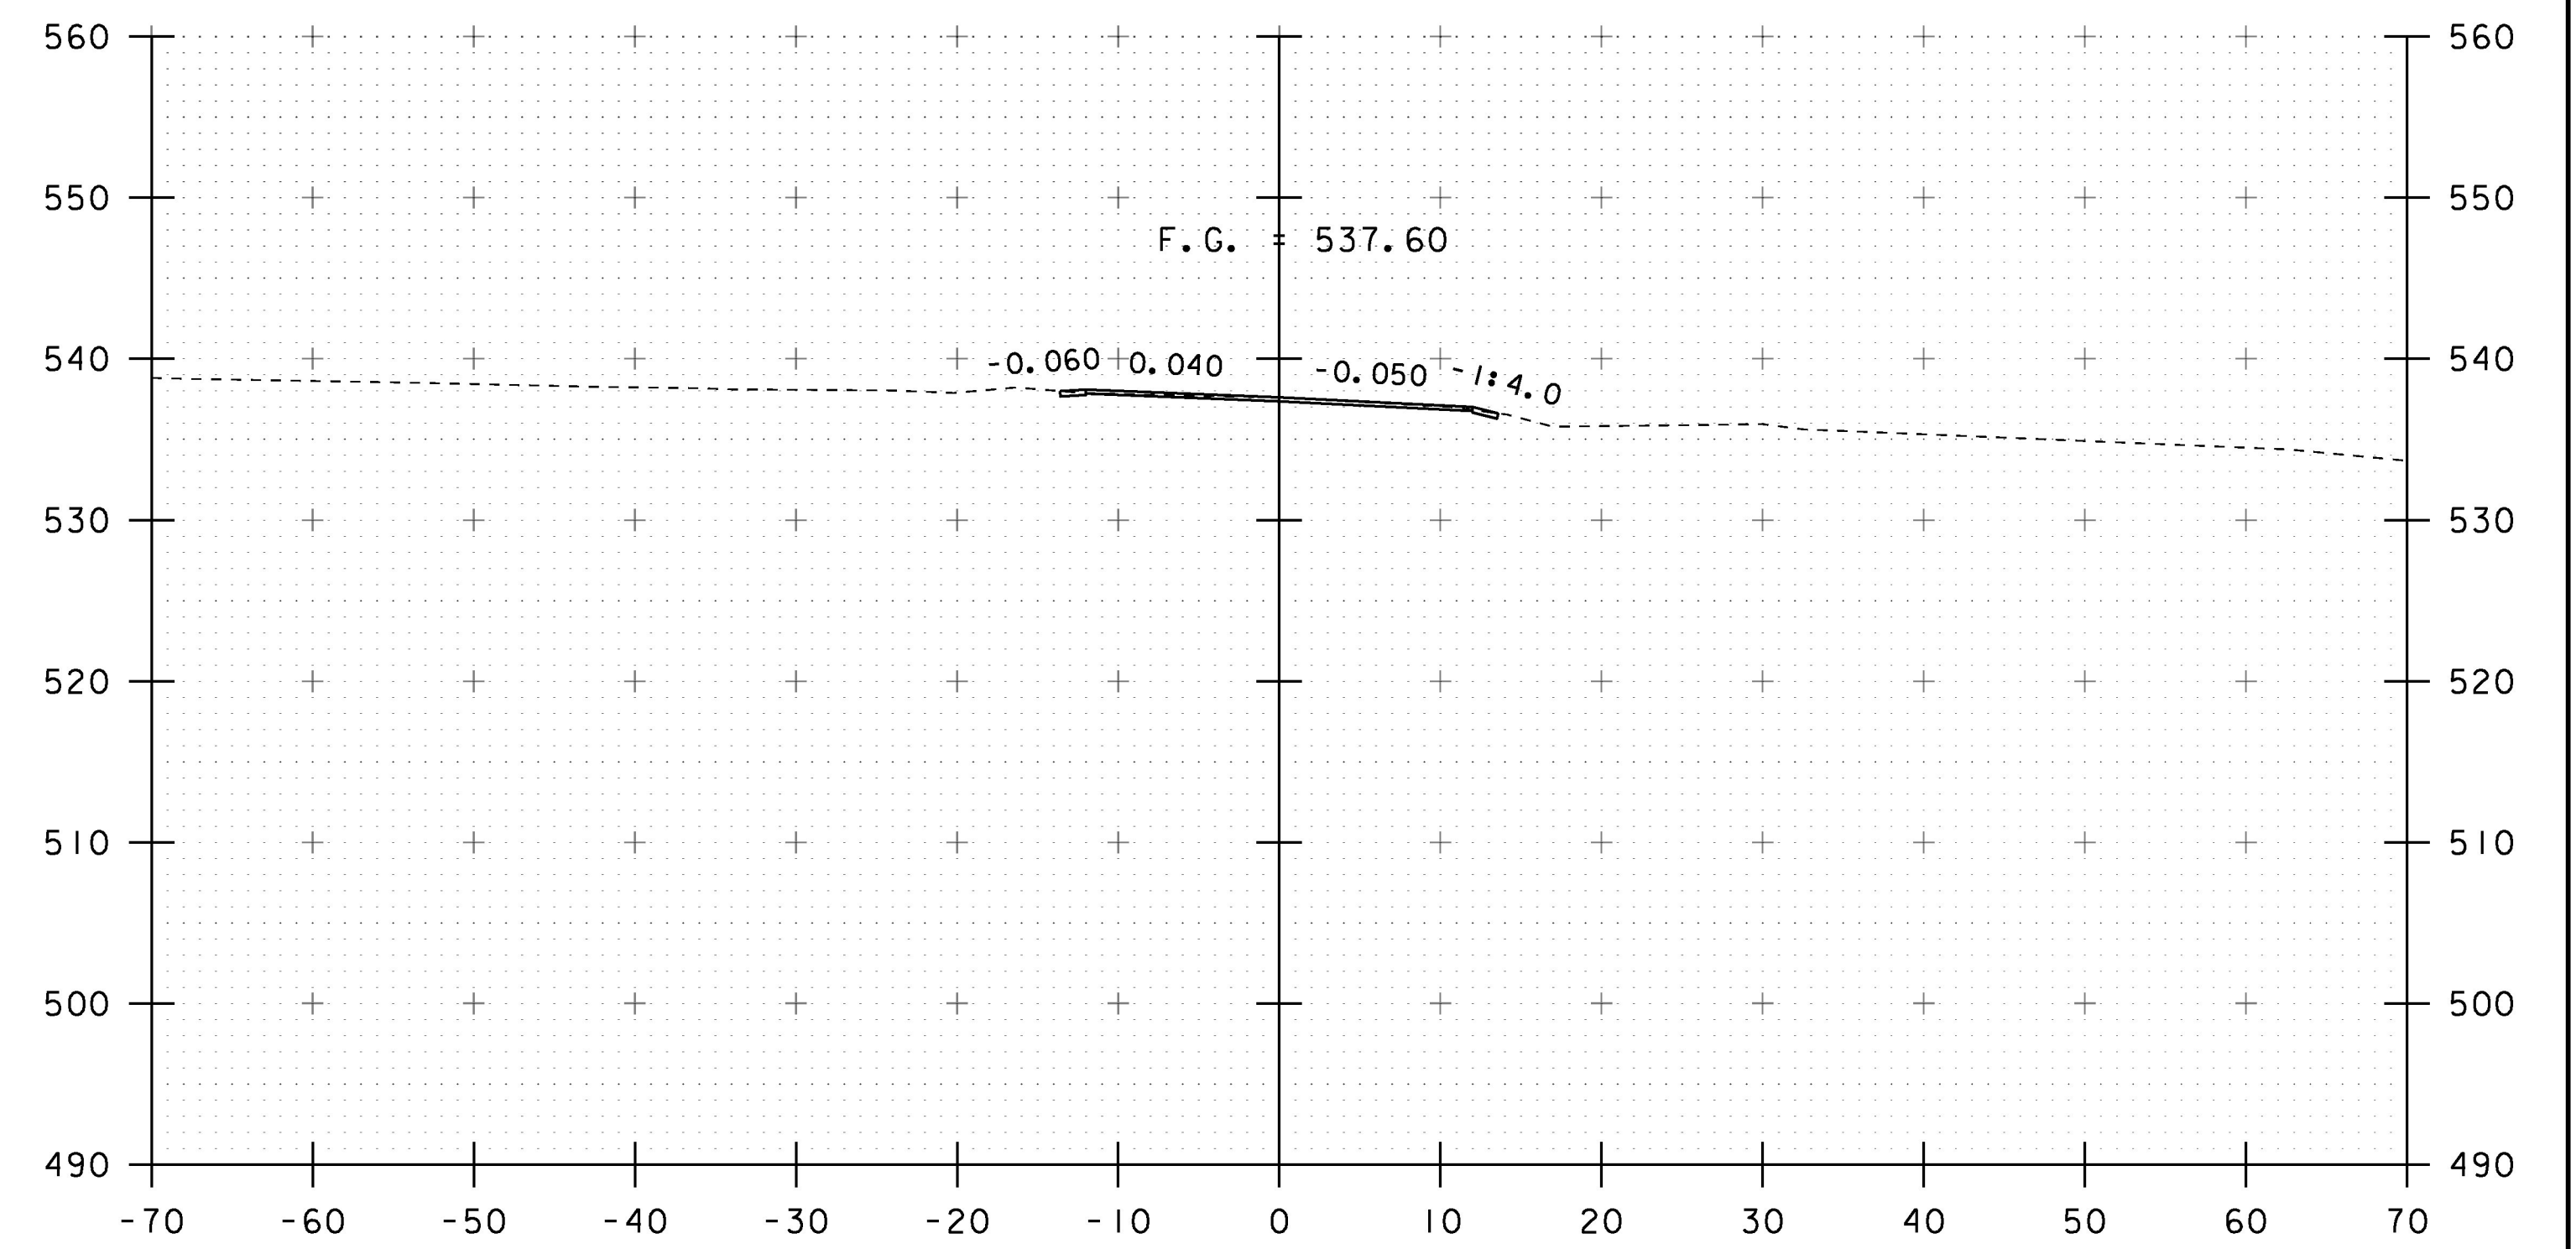

113+50

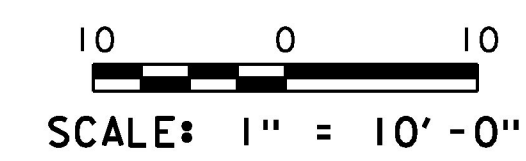

STA. 113+00 TO STA. 113+75

PROJECT NAME: POULTNEY	PLOT DATE: 15-AUG-2018
PROJECT NUMBER: BF 0138(12)	DRAWN BY: G. DARGAN
FILE NAME: s13j276xs.dgn	CHECKED BY: G. LAROCHE
PROJECT LEADER: R. YOUNG	SHEET 32 OF 46
DESIGNED BY: G. DARGAN	
MAINLINE CROSS SECTIONS (1)	