



11+50

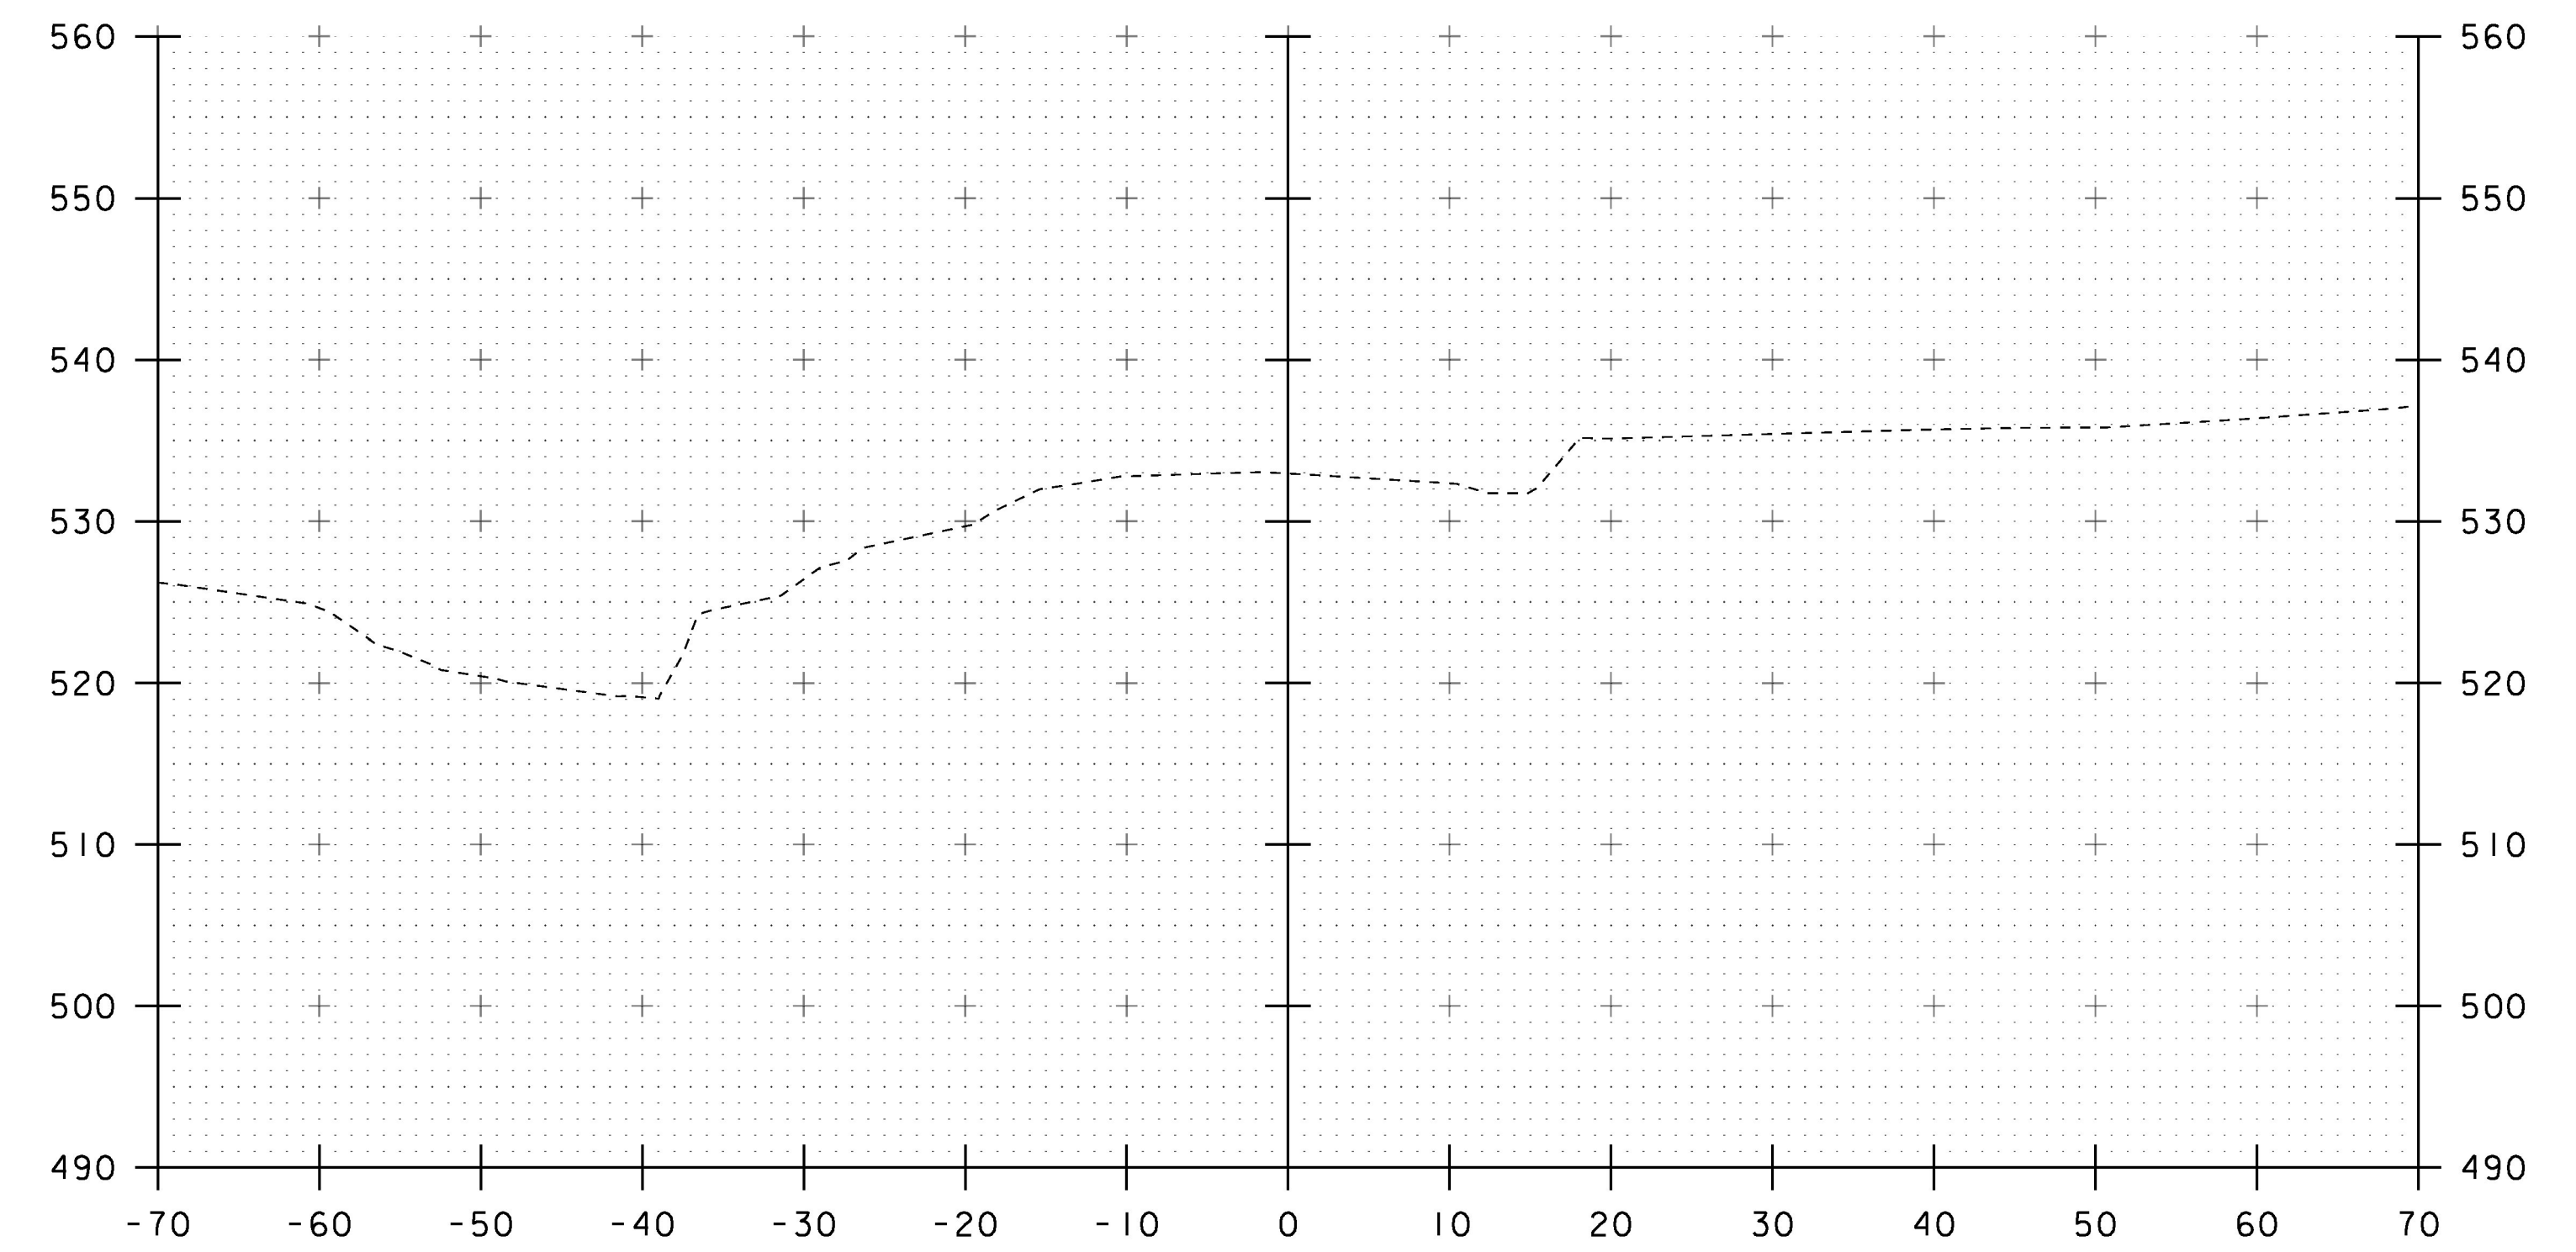


12+00

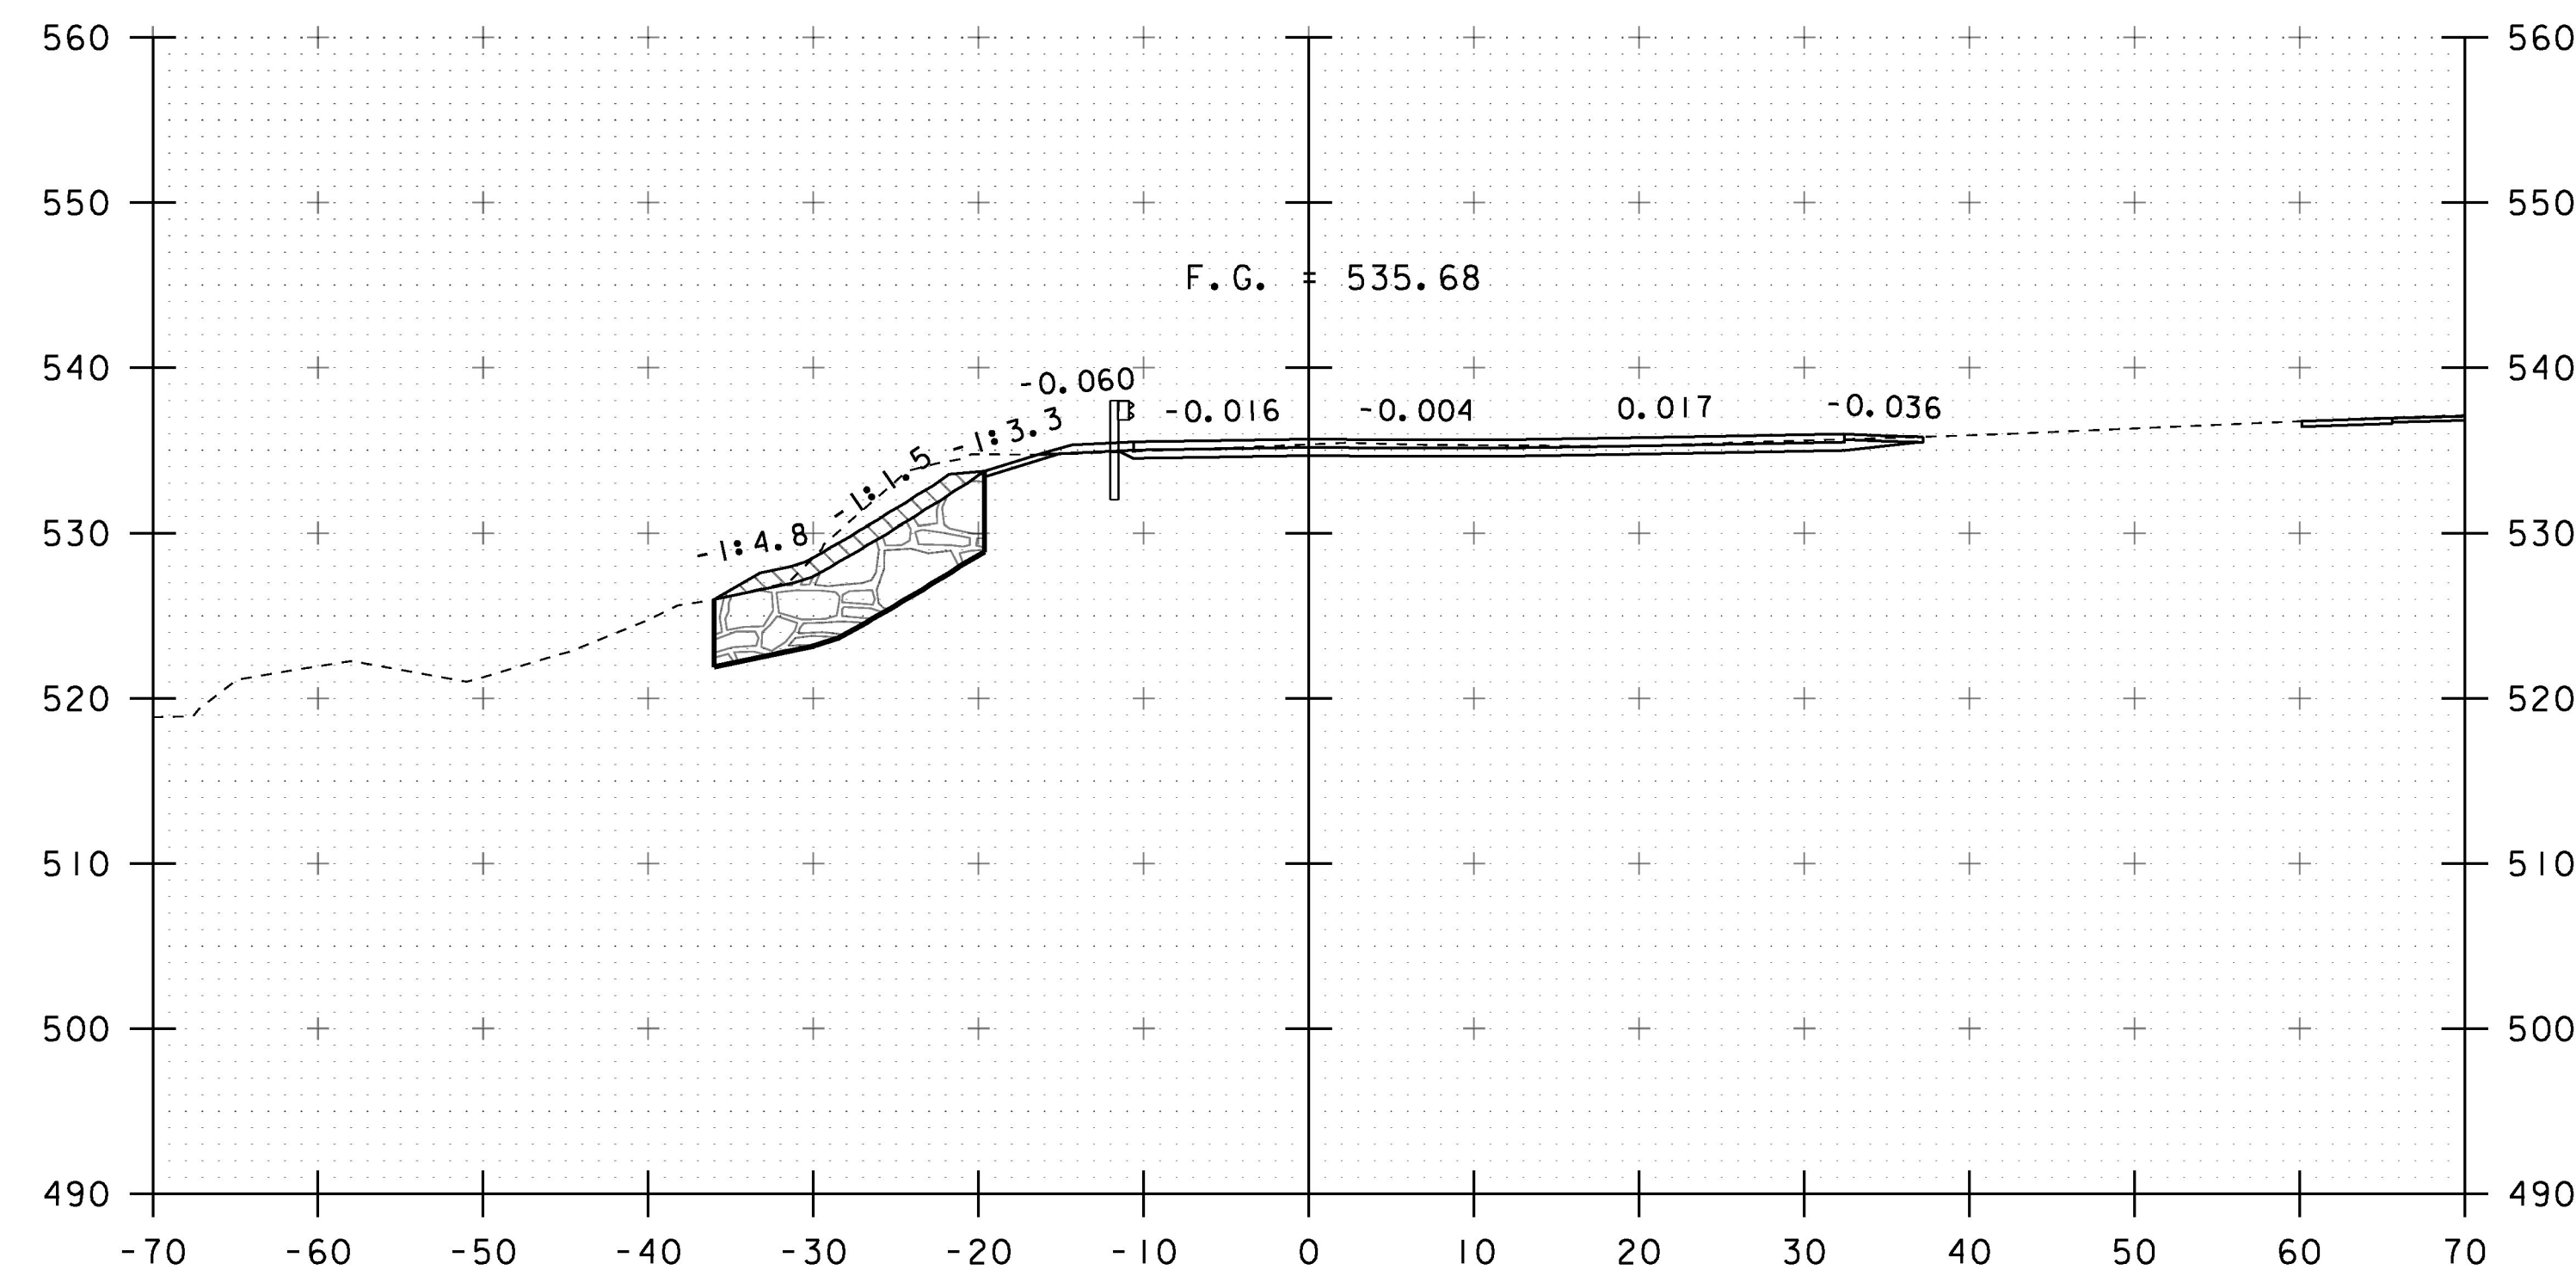


11+25

STA 11+12.55
BEGIN TH 9 APPROACH

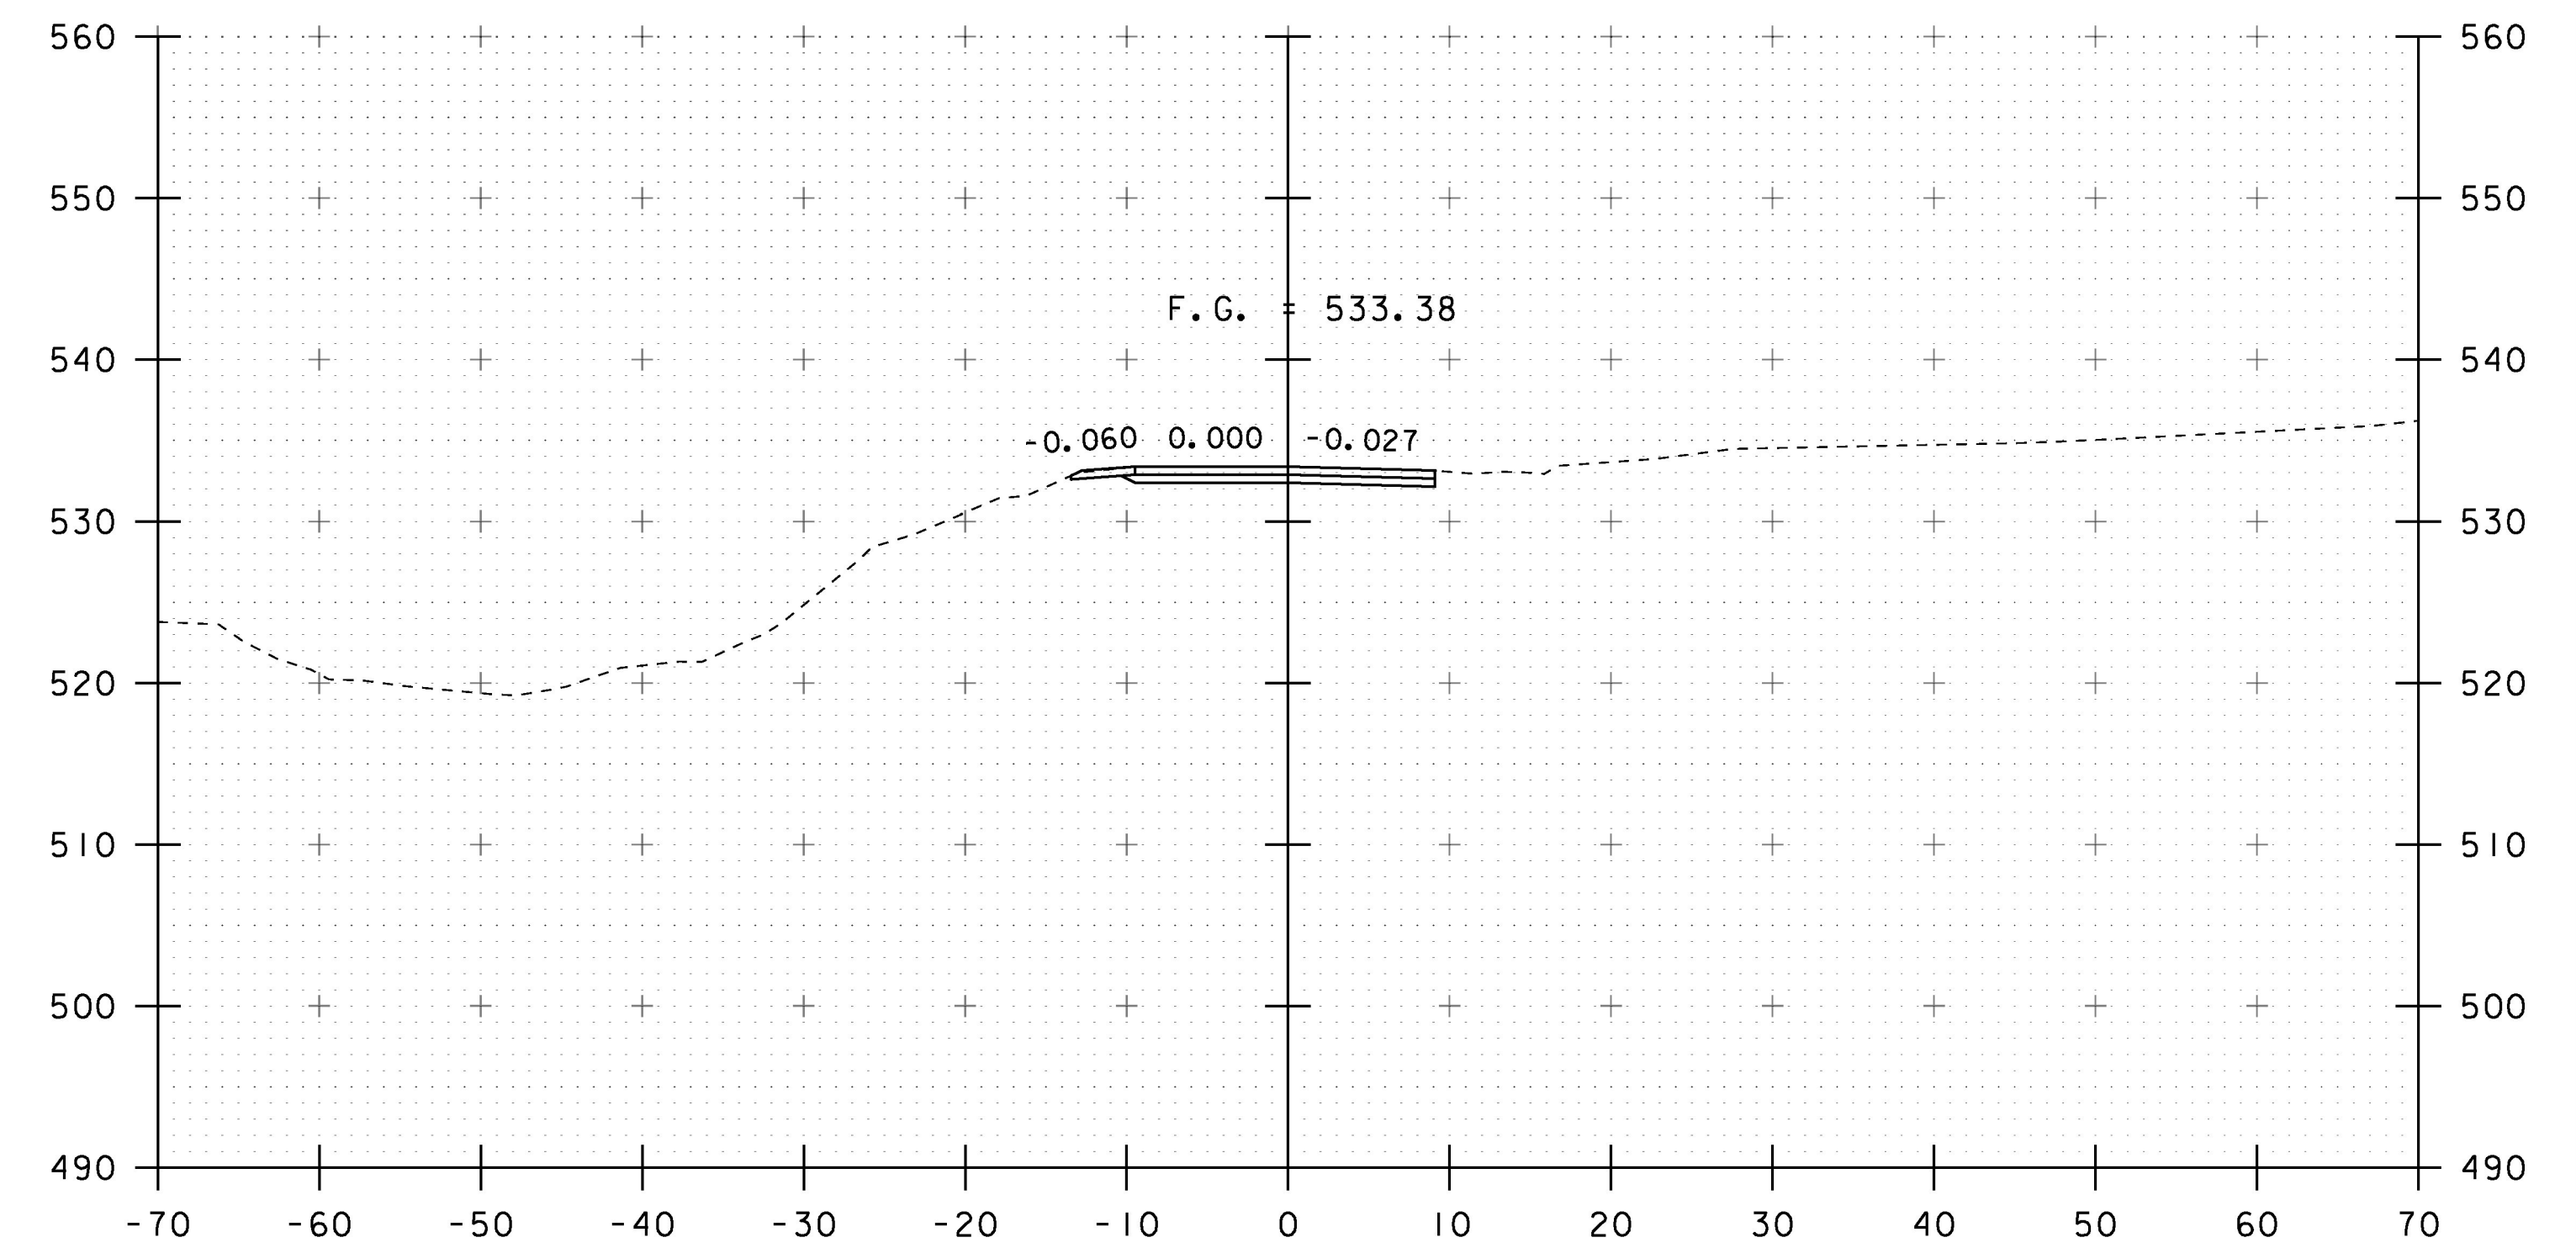

11+75

STA 11+75.00
END TH 9 APPROACH
MATCH EXISTING

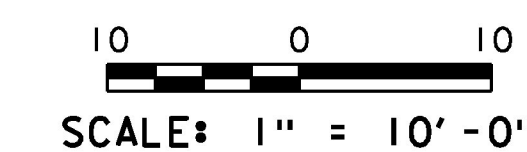

STA. 11+25 TO STA. 12+00

| | |
|-----------------------------|------------------------|
| PROJECT NAME: POULTNEY | PLOT DATE: 15-AUG-2018 |
| PROJECT NUMBER: BF 0138(12) | DRAWN BY: G. DARGAN |
| FILE NAME: s13j276xs.dgn | CHECKED BY: G. LAROCHE |
| PROJECT LEADER: R. YOUNG | TH 9 CROSS SECTIONS |
| DESIGNED BY: G. DARGAN | SHEET 36 OF 46 |