



50+25

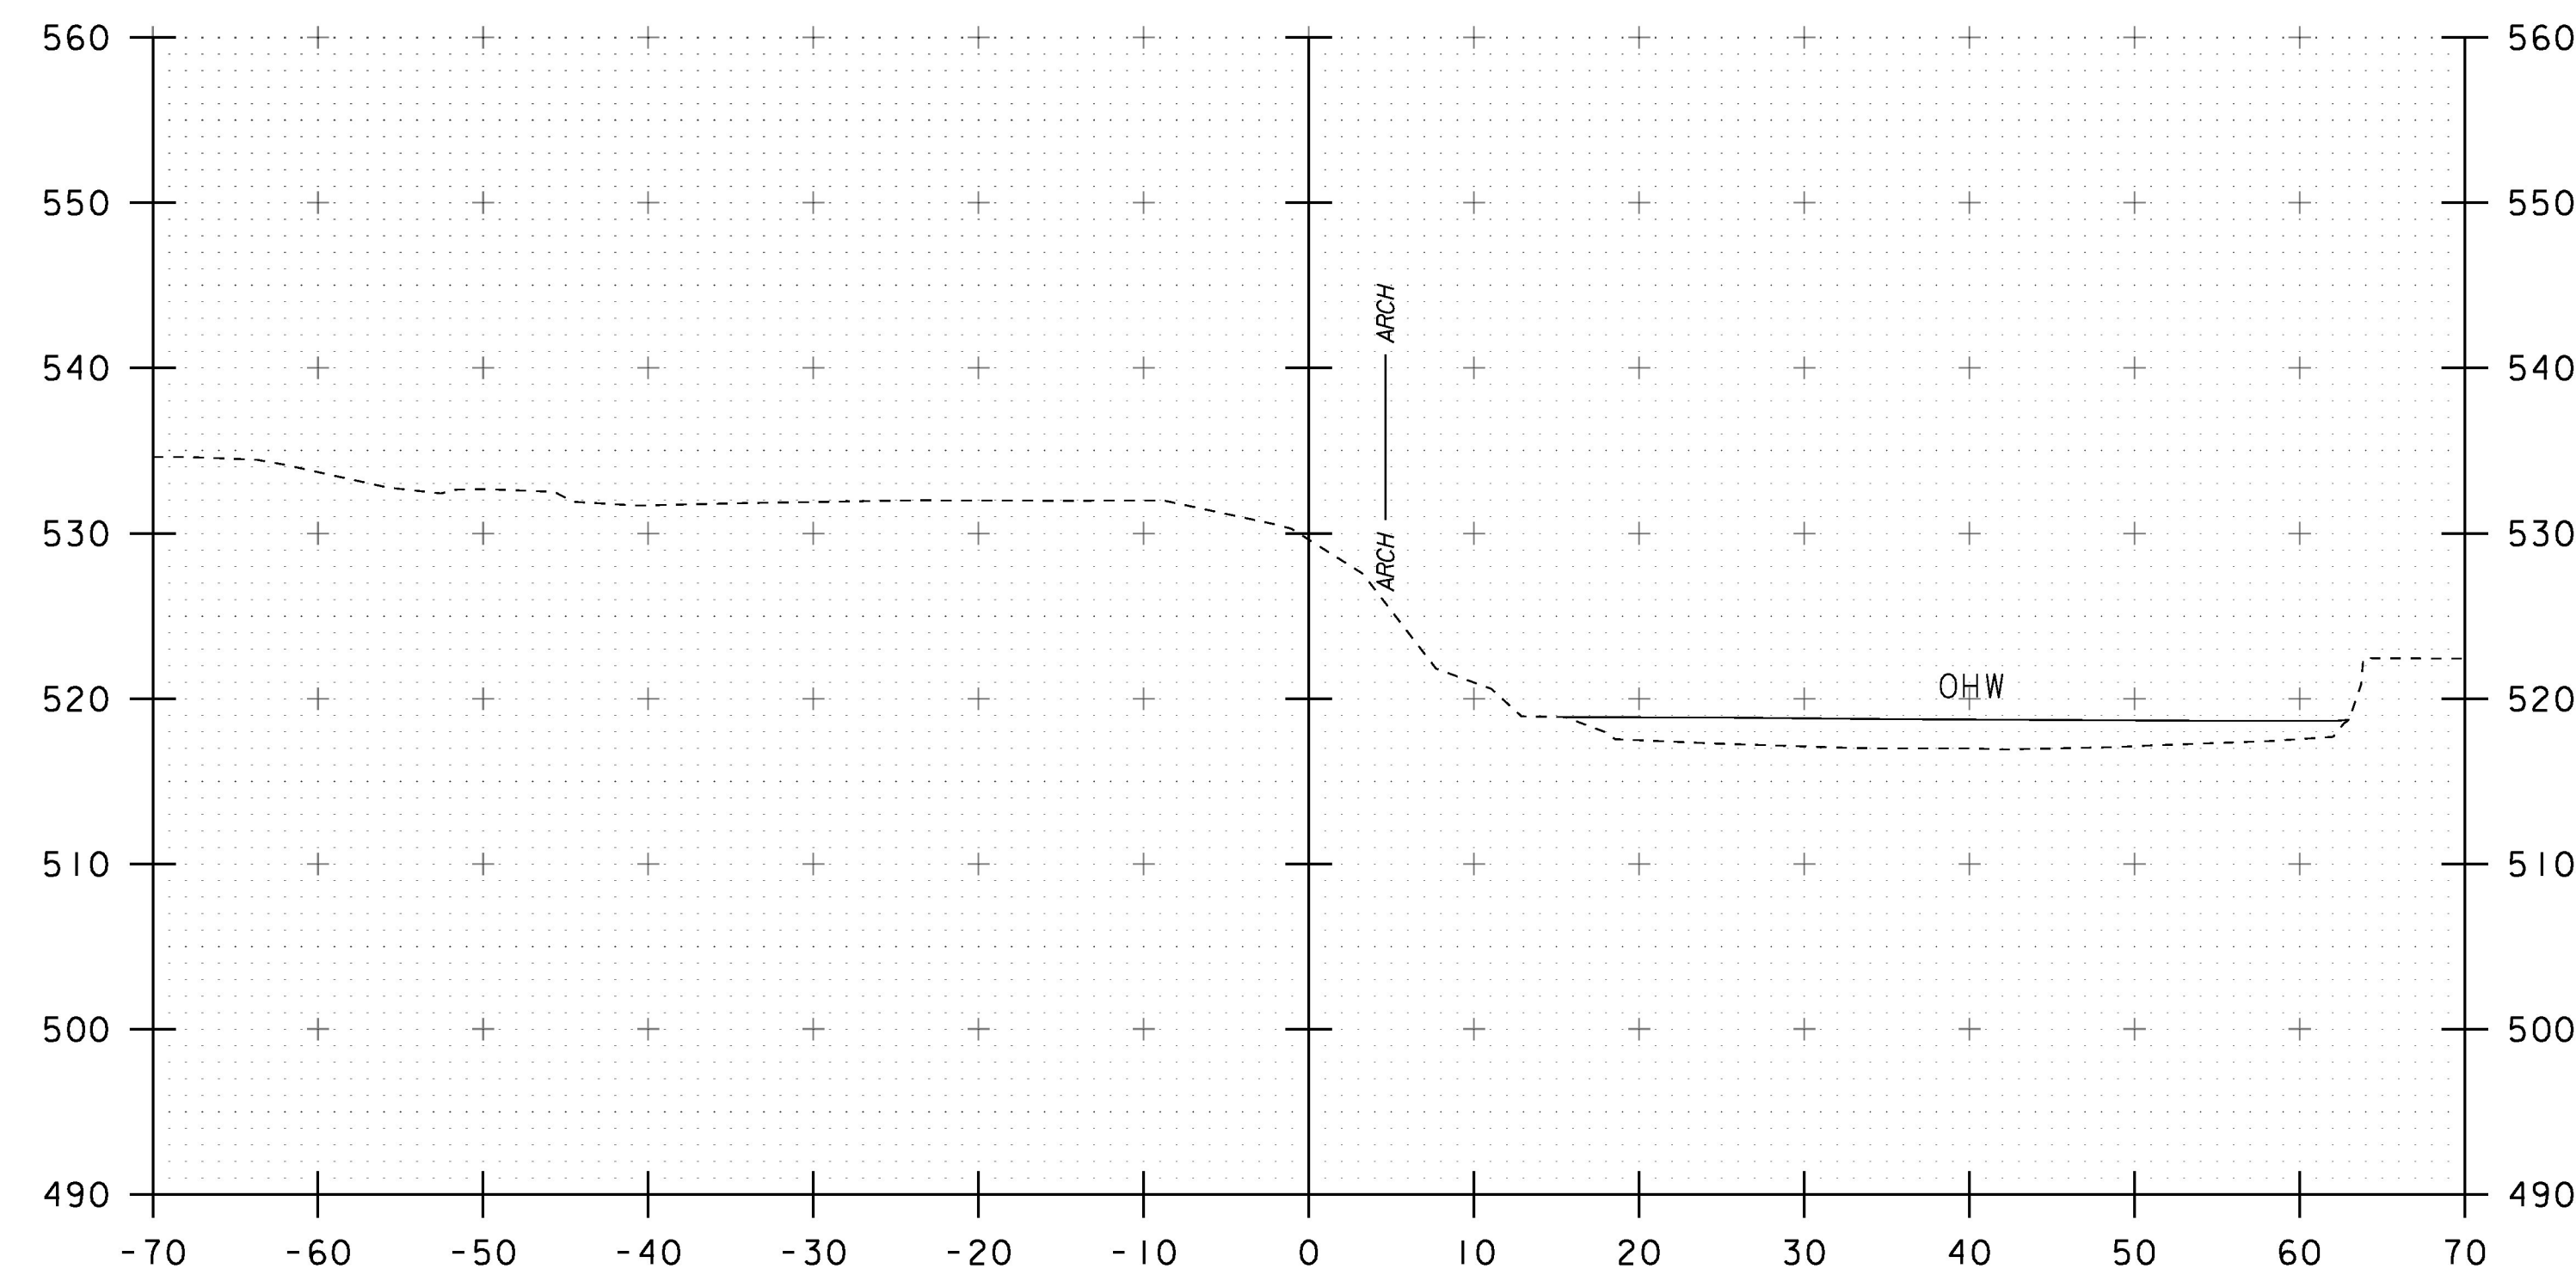

50+00

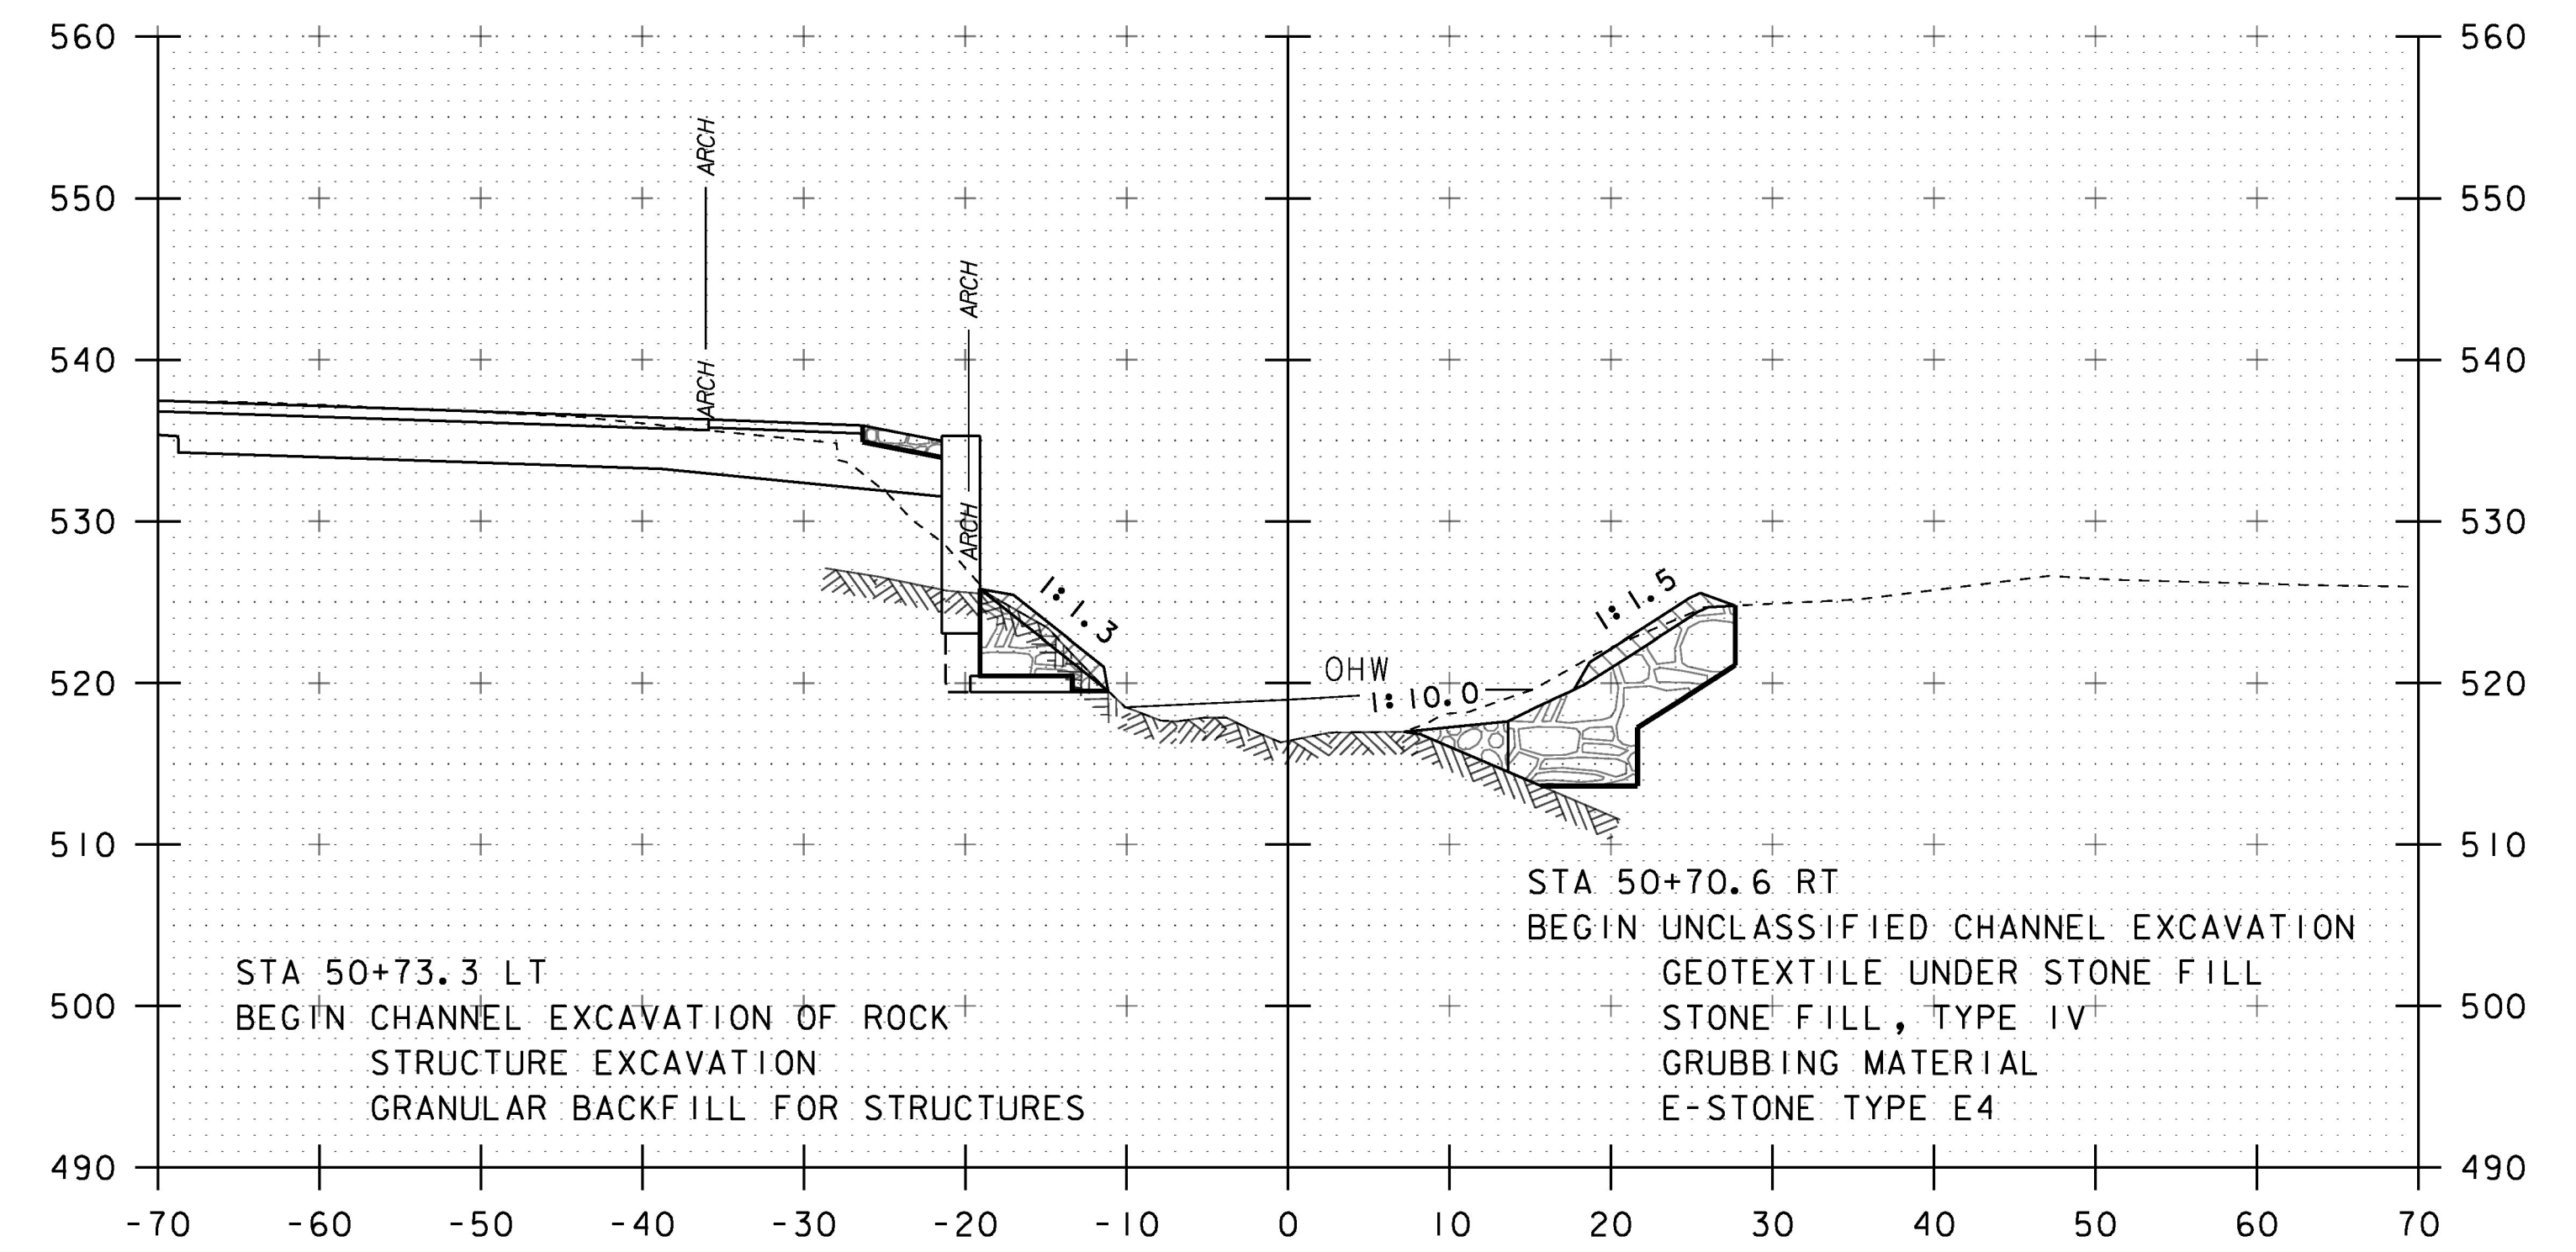


50+75


STA 50+73.3 LT  
 BEGIN CHANNEL EXCAVATION OF ROCK  
 STRUCTURE EXCAVATION  
 GRANULAR BACKFILL FOR STRUCTURES

STA 50+61.3 LT  
 BEGIN UNCLASSIFIED CHANNEL EXCAVATION  
 GEOTEXTILE UNDER STONE FILL  
 STONE FILL, TYPE IV  
 GRUBBING MATERIAL

STA 50+70.6 RT  
 BEGIN UNCLASSIFIED CHANNEL EXCAVATION  
 GEOTEXTILE UNDER STONE FILL  
 STONE FILL, TYPE IV  
 GRUBBING MATERIAL  
 E-STONE TYPE E4

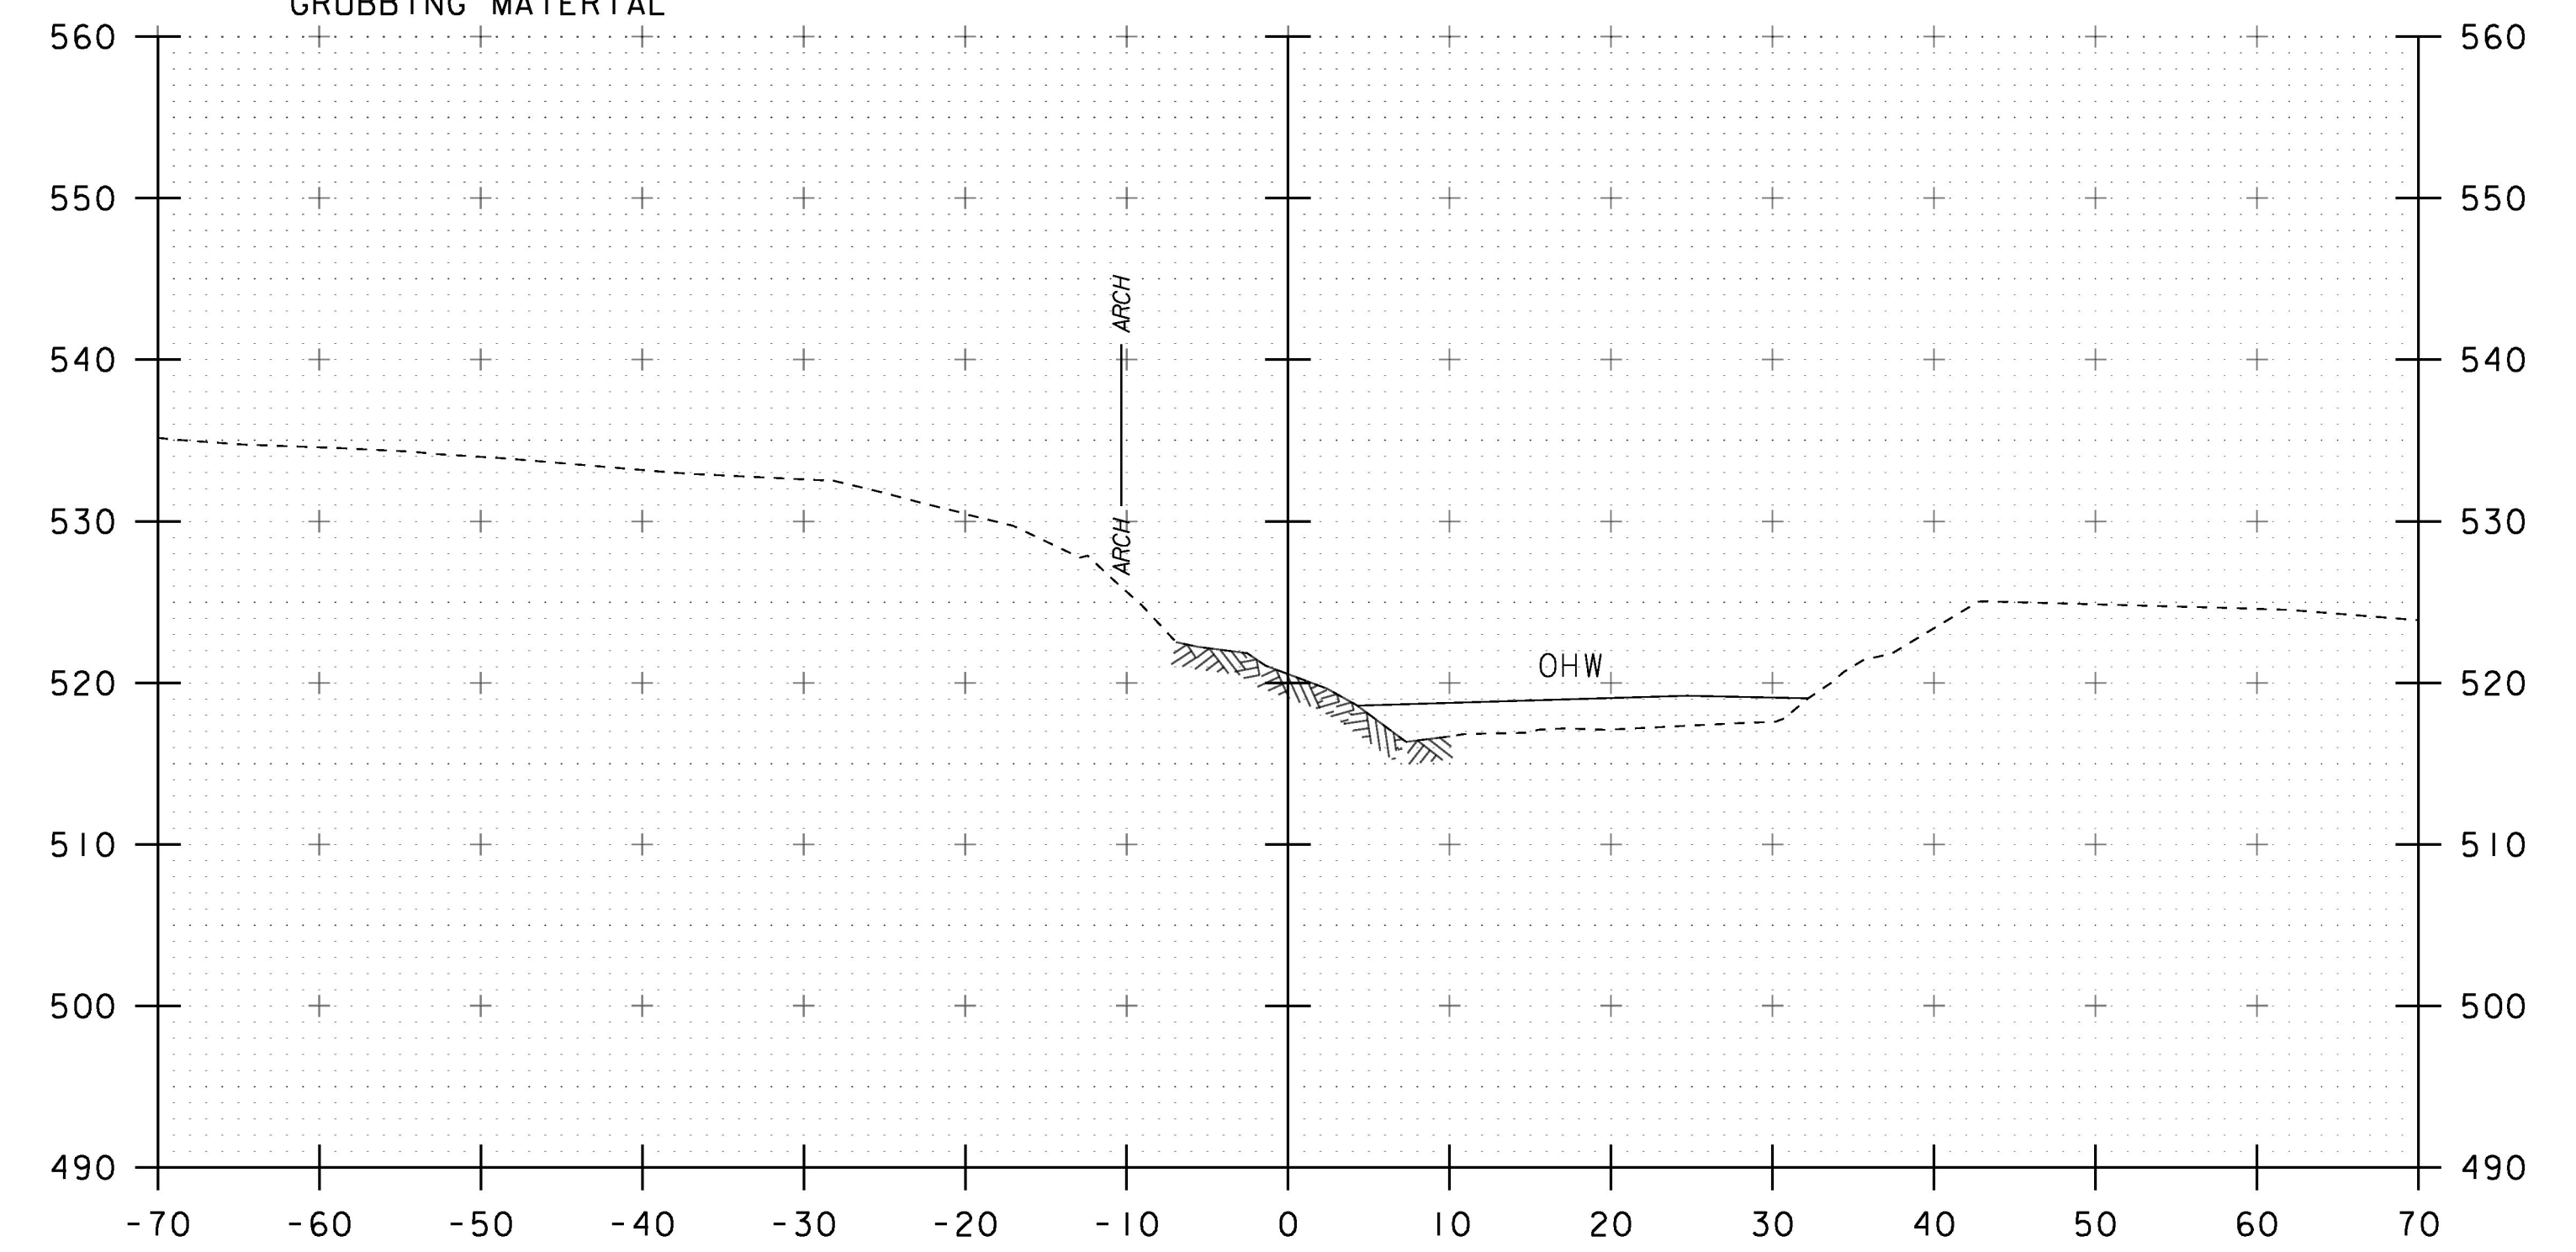

50+50

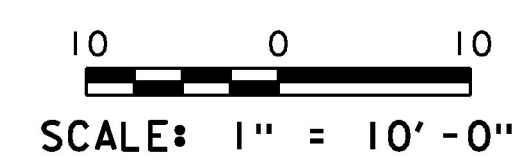

STA. 50+00 TO STA. 50+75

PROJECT NAME:	POULTNEY	PLOT DATE:	15-AUG-2018
PROJECT NUMBER:	BF 0138(12)	DRAWN BY:	G. DARGAN
FILE NAME:	sl3j276xs.dgn	CHECKED BY:	G. LAROCHE
PROJECT LEADER:	R. YOUNG	SHEET	37 OF 46
DESIGNED BY:	G. DARGAN		
CHANNEL CROSS SECTIONS (1)			