



50+90


STA 50+83.0 RT
 BEGIN STRUCTURE EXCAVATION
 SPECIAL PROVISION (LIGHTWEIGHT BACKFILL)

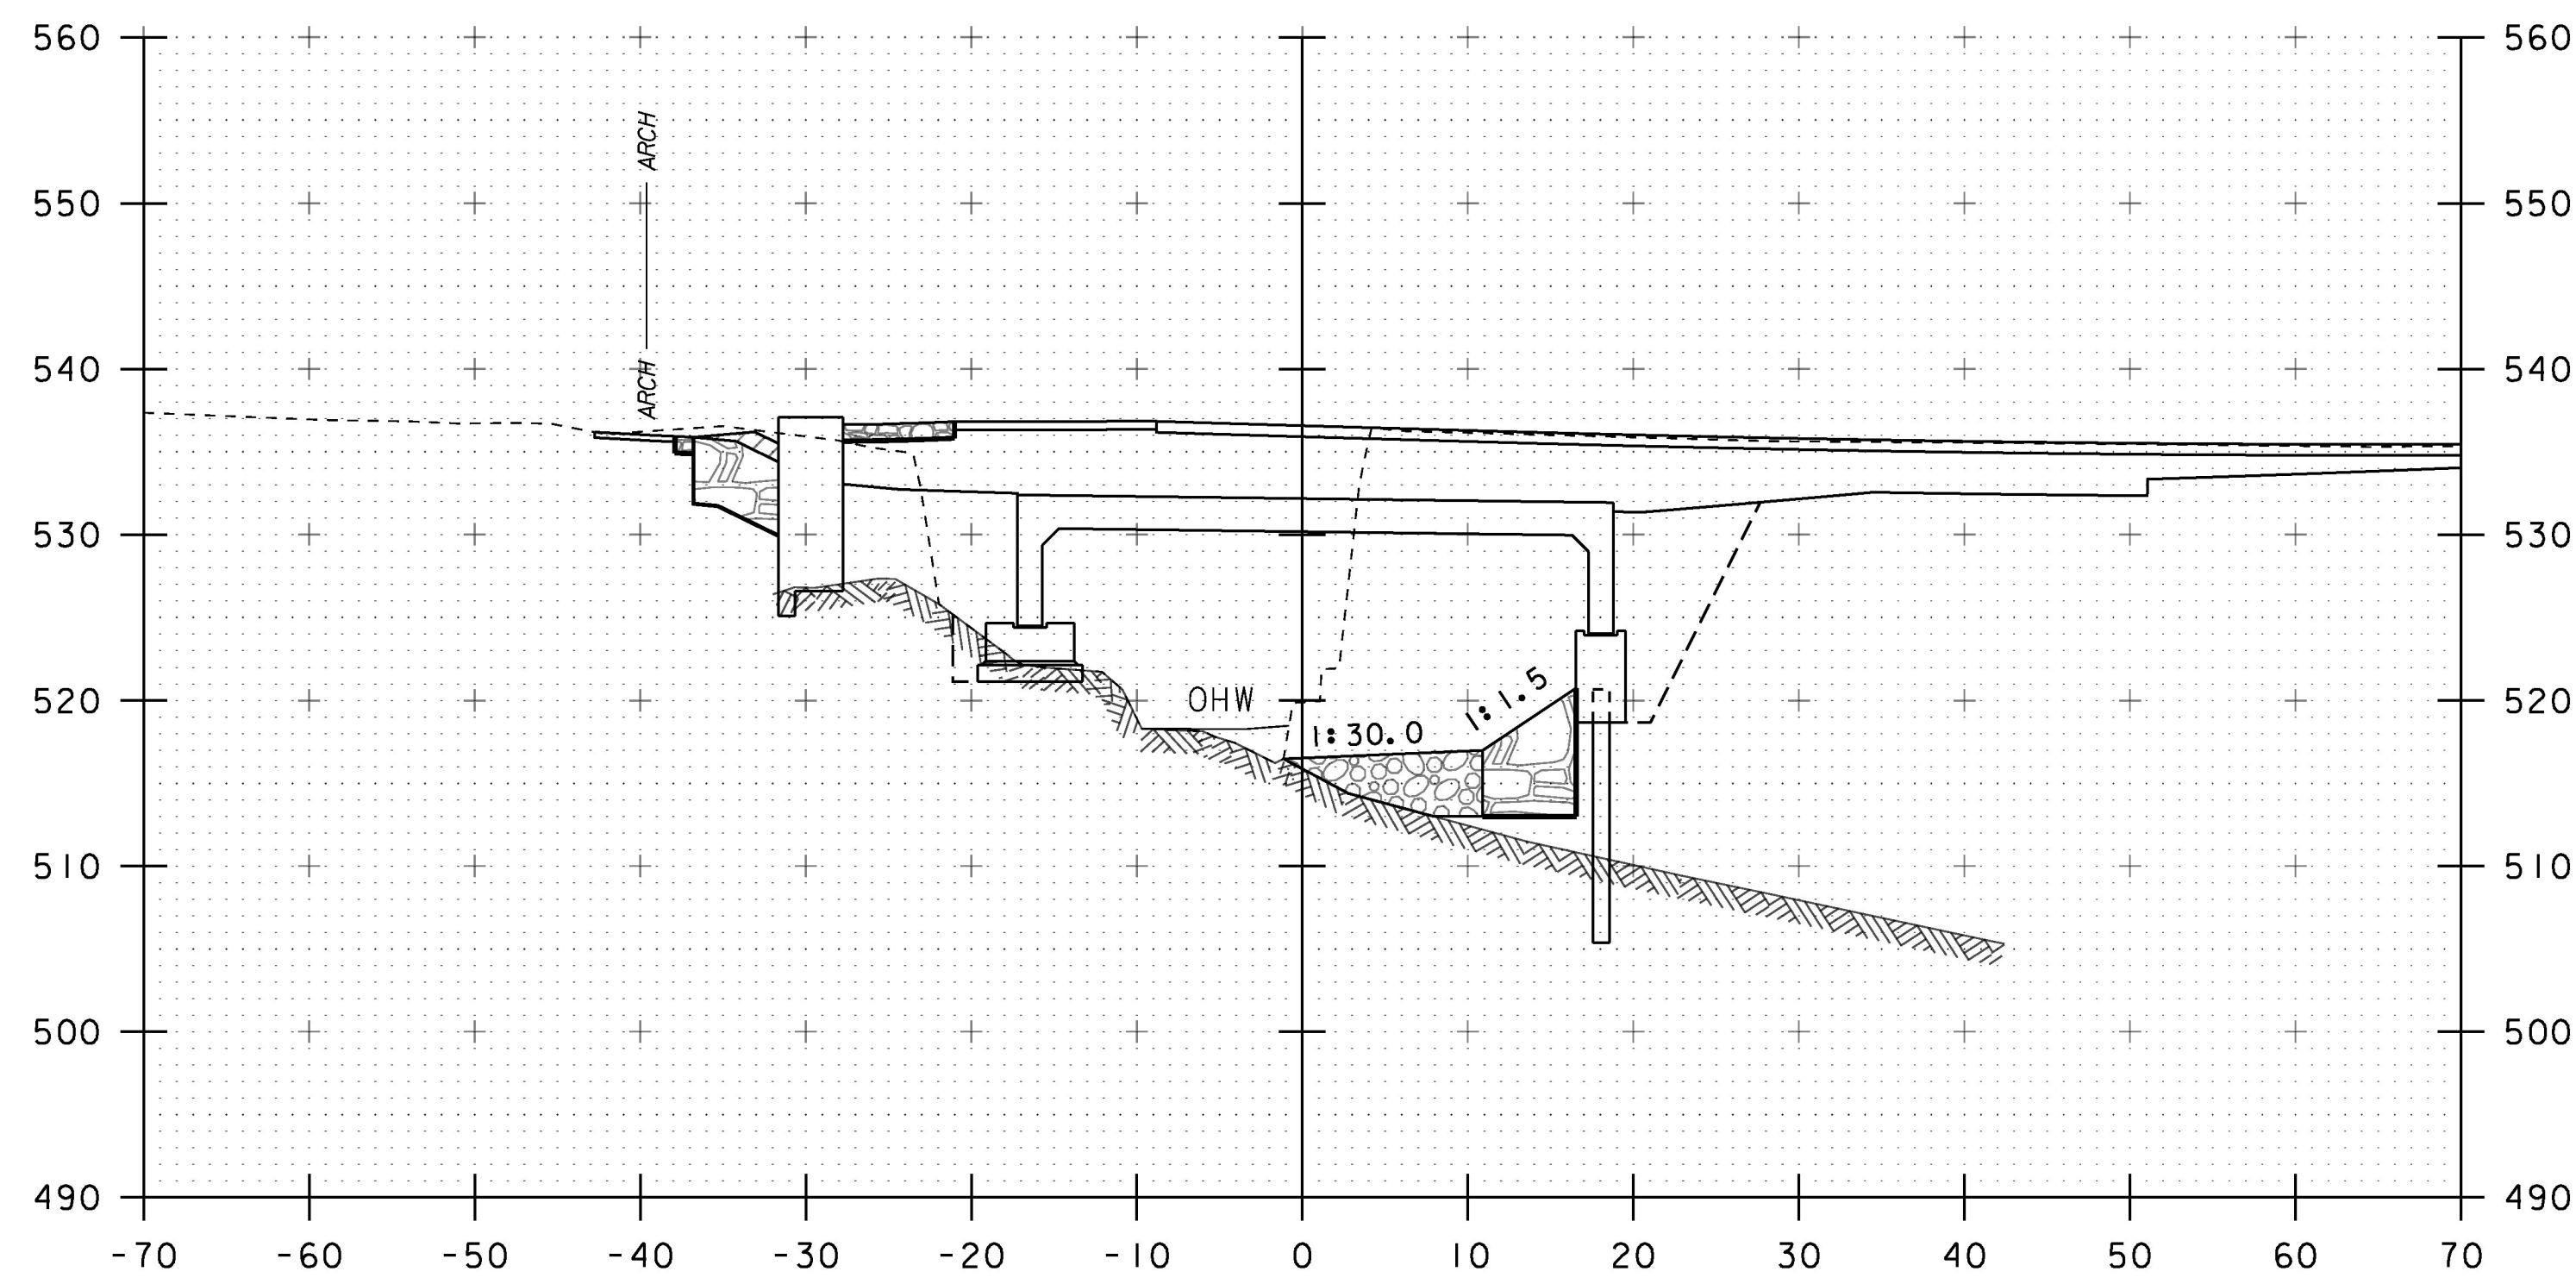


51+10

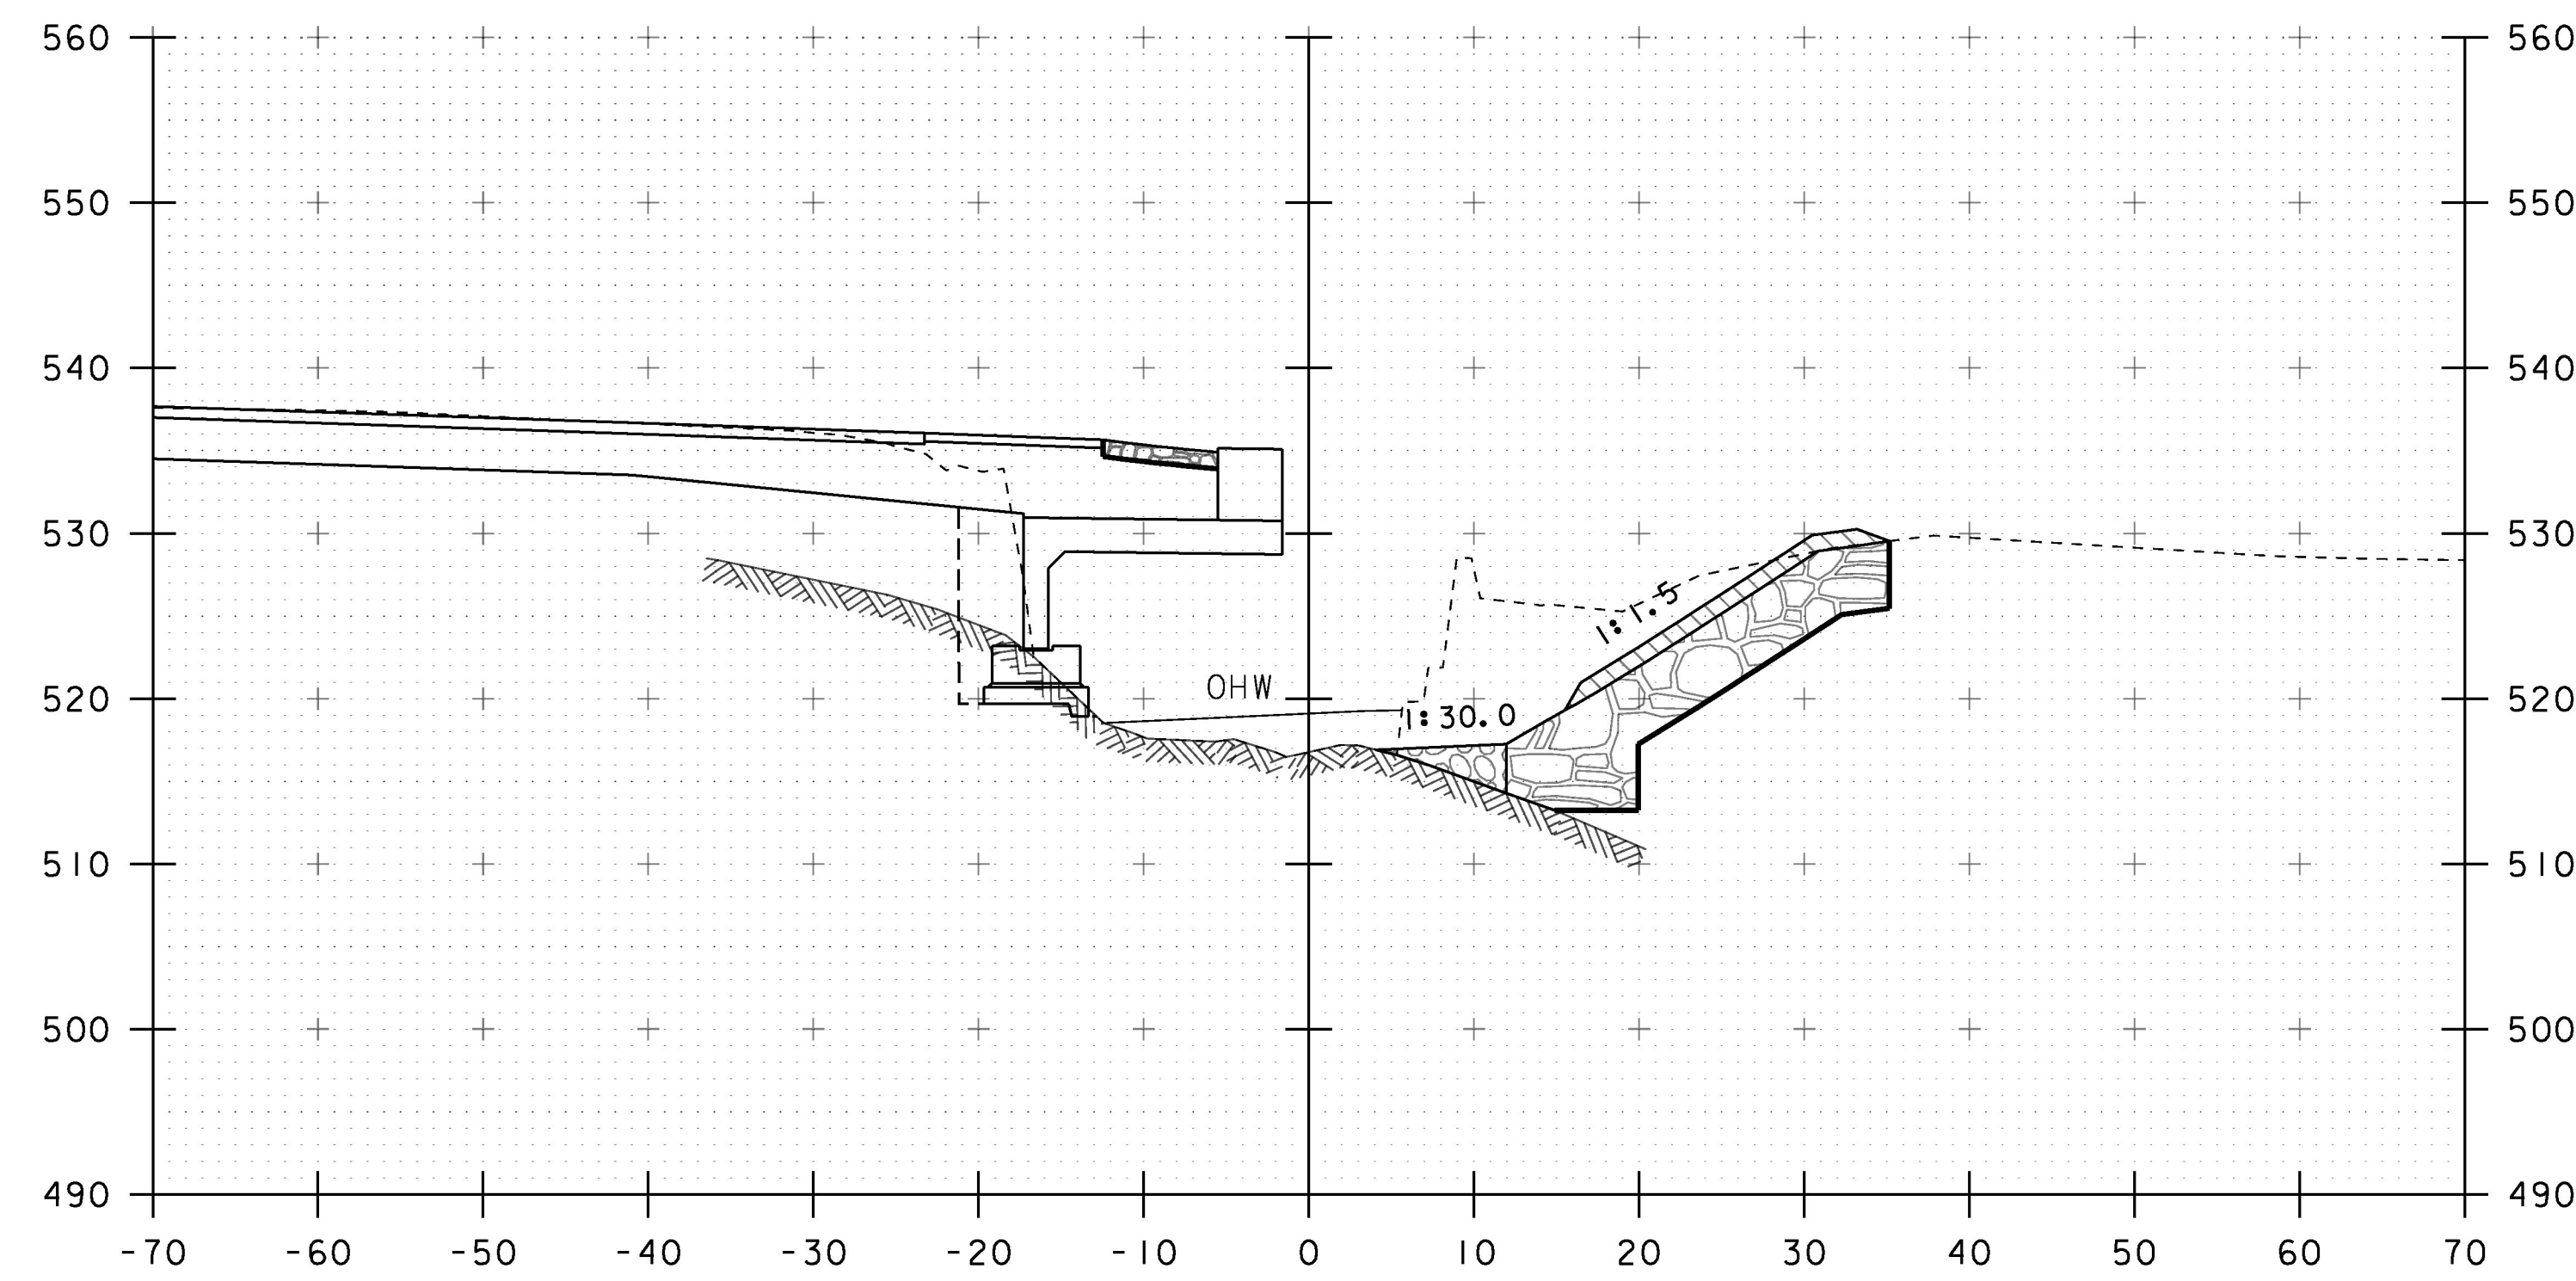

50+80

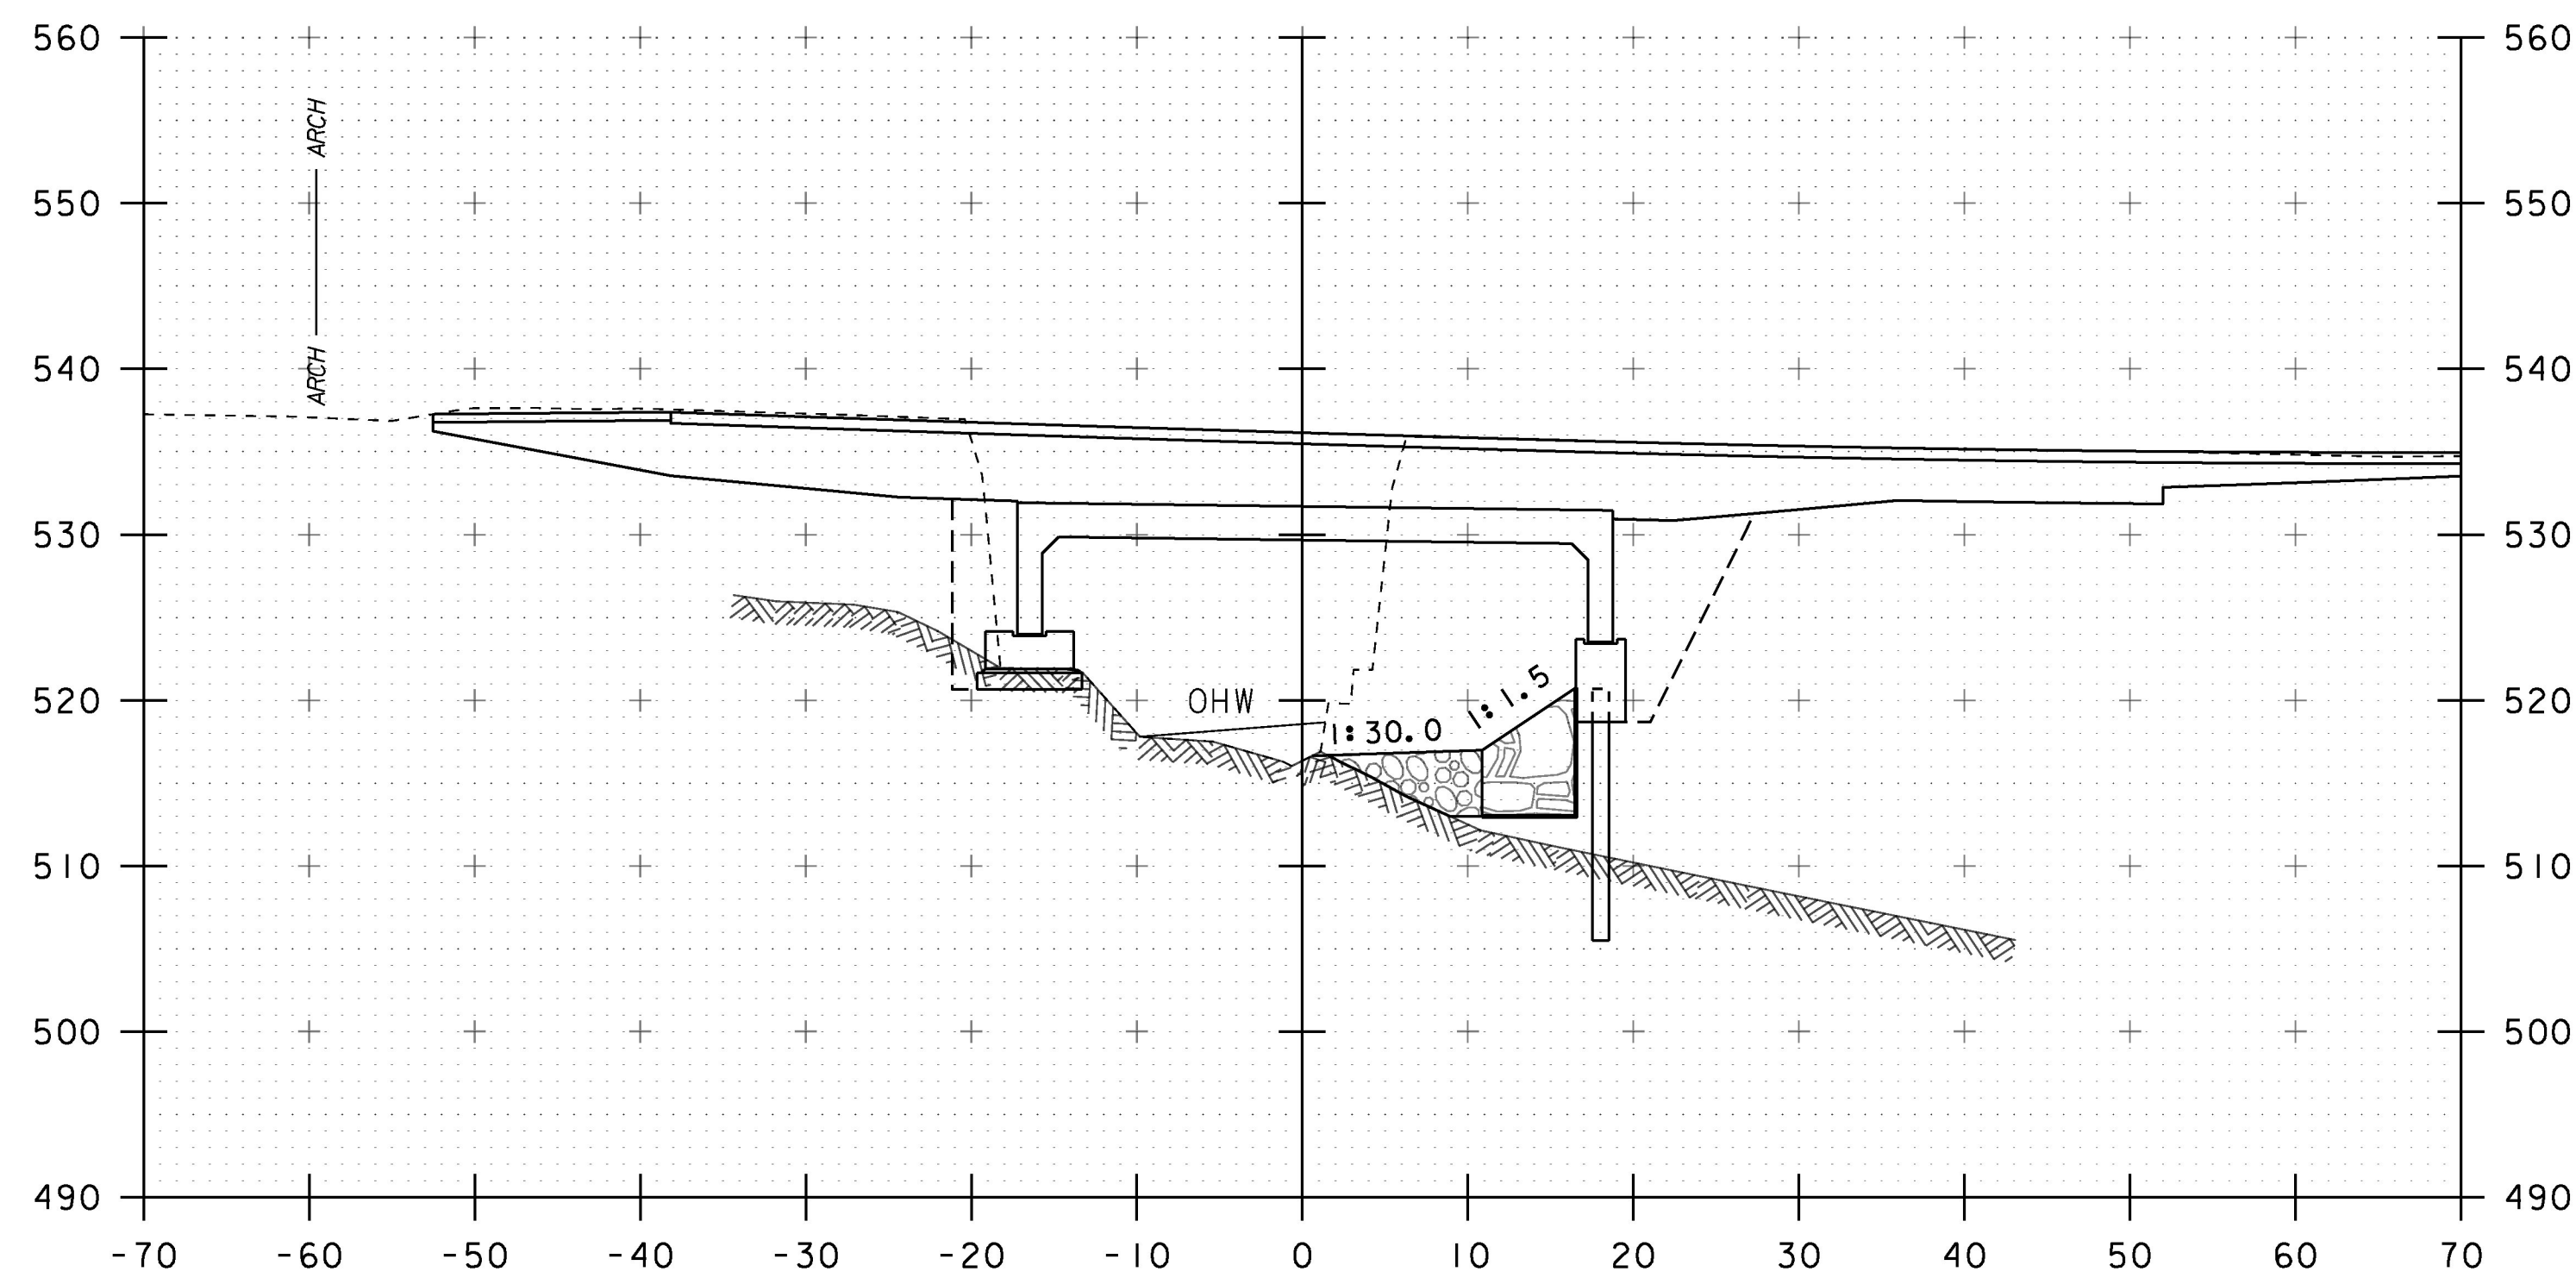

51+00

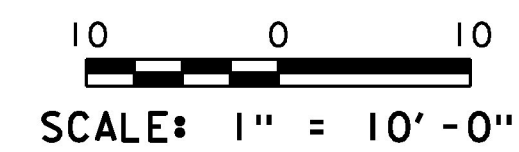

STA. 50+80 TO STA. 51+10

PROJECT NAME:	POULTNEY	PLOT DATE:	15-AUG-2018
PROJECT NUMBER:	BF 0138(12)	DRAWN BY:	G. DARGAN
FILE NAME:	sl3j276xs.dgn	DESIGNED BY:	G. DARGAN
PROJECT LEADER:	R. YOUNG	CHECKED BY:	G. LAROCHE
CHANNEL CROSS SECTIONS (2)		SHEET 38 OF 46	