

STATE OF VERMONT AGENCY OF TRANSPORTATION



PROPOSED IMPROVEMENT


STATEWIDE NORTHEAST REGION STP HRRR(16)
TOWNS OF BERLIN, LUNENBURG, NEWARK, NEWBURY AND WOLCOTT
COUNTIES OF WASHINGTON, ESSEX, CALEDONIA, ORANGE AND LAMOILLE COUNTIES

PROJECT DESCRIPTION: WORK TO BE PERFORMED UNDER THIS PROJECT INCLUDES THE REMOVAL OF EXISTING SIGNS, SIGN POSTS, AND GUARDRAIL; THE INSTALLATION OF NEW SIGNS, SIGN POSTS, AND GUARDRAIL; PAVEMENT MARKINGS (CENTERLINE, EDGELINE, SYMBOLS AND LETTERS); AND OTHER HIGHWAY RELATED ITEMS FOR THE DESCRIBED WORK.

| | | | | |
|--------------------|--------|----|---------------|---------------------------------|
| PROJECT LOCATIONS: | TH-8, | MM | 0.000 - 0.680 | BERLIN (DOG RIVER ROAD) |
| | TH-1, | MM | 0.000 - 7.100 | LUNENBURG (RIVER ROAD) |
| | TH-4, | MM | 0.000 - 0.026 | LUNENBURG (MT ORNE BRIDGE ROAD) |
| | TH-1, | MM | 1.260 - 1.834 | NEWARK (NEWARK STREET) |
| | TH-25, | MM | 0.000 - 0.024 | NEWARK (HOLLOW ROAD) |
| | TH-7, | MM | 0.000 - 4.626 | NEWBURY (LEIGHTON HILL ROAD) |
| | TH-4, | MM | 0.000 - 3.402 | WOLCOTT (ELMORE POND ROAD) |
| | TH-15, | MM | 3.410 - 4.891 | WOLCOTT (GULF ROAD) |

PROJECT LOCATIONS

SEE SHEETS 8-10 FOR SITE MAPS

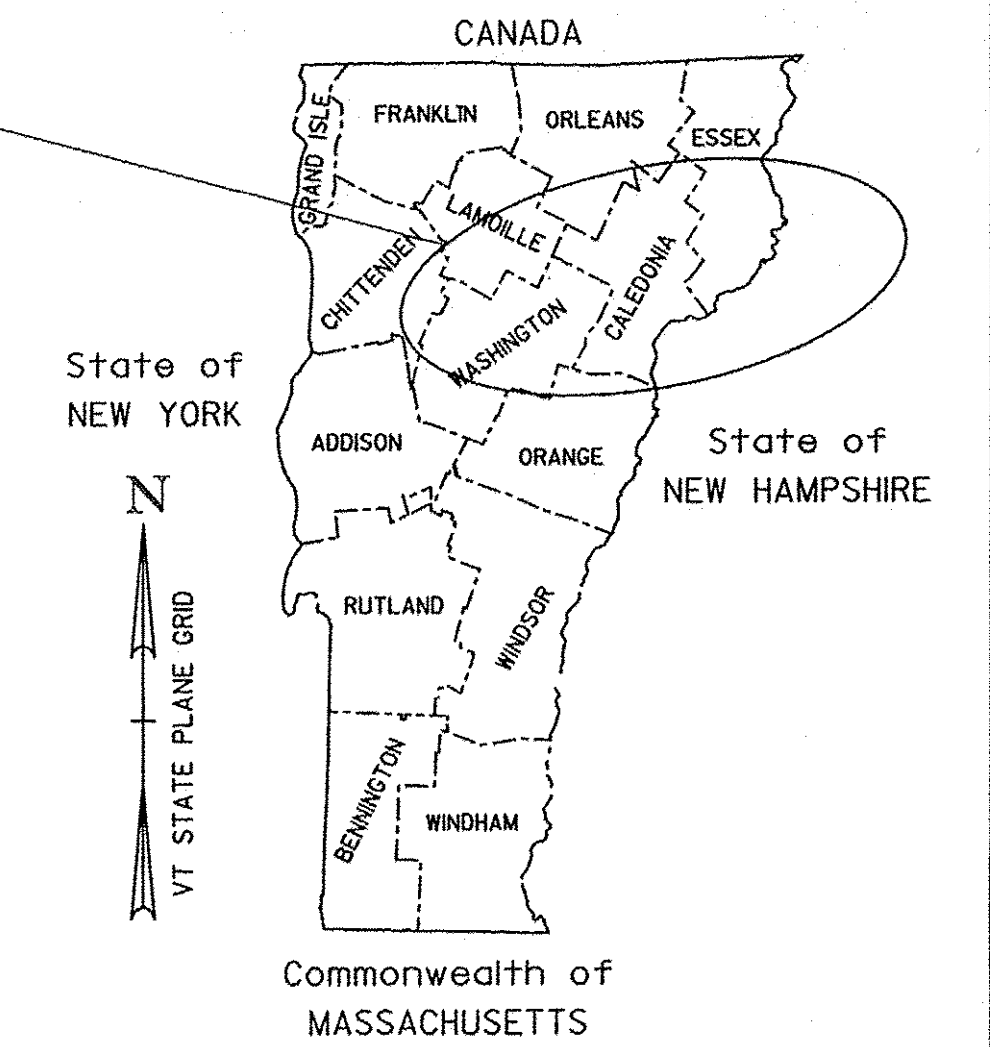

| | | |
|------------------|-------------|---------------|
| PROJECT LENGTHS: | 0.680 MILES | (3590.40 FT) |
| | 7.100 MILES | (37488.00 FT) |
| | 0.026 MILES | (137.28 FT) |
| | 0.574 MILES | (3030.72 FT) |
| | 0.024 MILES | (126.72 FT) |
| | 4.626 MILES | (24425.28 FT) |
| | 3.402 MILES | (17962.56 FT) |
| | 1.481 MILES | (7819.68 FT) |

TOTAL LENGTH: 17.913 MILES (94580.64 FT)

QUALITY ASSURANCE PROGRAM: LEVEL 3

| CONVENTIONAL SYMBOLS | |
|----------------------|--|
| COUNTY LINE | |
| TOWN LINE | |
| LIMITS OF ACCESS | |
| POINT OF ACCESS | |
| FENCE LINE | |
| STONE WALL | |
| TRAVELED WAY | |
| GUARD RAIL | |
| RAILROAD | |
| SURVEY LINE | |
| CULVERT | |
| POWER POLE | |
| TELEPHONE POLE | |
| TREES | |
| CONTROL OF ACCESS | |
| PROPERTY LINE | |
| R.O.W. TAKING LINE | |
| SLOPE RIGHTS | |
| TOP OF CUT | |
| TOE OF SLOPE | |

| | |
|-----------------|-----|
| SURVEYED BY : | N/A |
| SURVEYED DATE : | N/A |
| DATUM | |
| VERTICAL | N/A |
| HORIZONTAL | N/A |

RECORD PLANS

CONTRACTOR: F. R. LAFAYETTE, INC. - ESSEX JUNCTION, VT
 RESIDENT ENGINEER: BRIGITTE CODLING
 CONSTRUCTION BEGAN: MAY 6, 2014
 CONSTRUCTION COMPLETE: DECEMBER 15, 2014
 RECORD PLANS BY: BRIGITTE CODLING & CRAIG PIERCE

I HEREBY CERTIFY THAT ALL THE CONSTRUCTION REQUIRED BY THIS SET OF DRAWINGS HAS BEEN ACCOMPLISHED AS INDICATED HEREIN.

BY *Brigitte Codling* RESIDENT ENGINEER
 DATE *July 13, 2015*

NOTE: Any further information concerning final quantities, amounts or other details relative to this project may be found by contacting Vtrans Records Management.

THESE PLANS ARE SUBJECT TO SUCH ENGINEERING CHANGES AS MAY BE REQUIRED BY THE FEDERAL HIGHWAY ADMINISTRATION OR THE DIRECTOR OF PROGRAM DEVELOPMENT.
 CONSTRUCTION IS TO BE CARRIED ON IN ACCORDANCE WITH THESE PLANS AND THE STANDARD SPECIFICATIONS FOR CONSTRUCTION DATED 2011, AS APPROVED BY THE FEDERAL HIGHWAY ADMINISTRATION ON JULY 20, 2011 FOR USE ON THIS PROJECT, INCLUDING ALL SUBSEQUENT REVISIONS AND SUCH REVISED SPECIFICATIONS AND SPECIAL PROVISIONS AS ARE INCORPORATED IN THESE PLANS.

| | |
|---|--|
| DIRECTOR OF PROGRAM DEVELOPMENT | APPROVED <i>Richard Johnson</i> DATE <i>1-8-14</i> |
| PROJECT MANAGER : JESSE DEVLIN, P.E. | |
| PROJECT NAME : STATEWIDE - NORTHEAST REGION | |
| PROJECT NUMBER : STP HRRR(16) | |
| SHEET 1 OF 50 SHEETS | |