


BERLIN

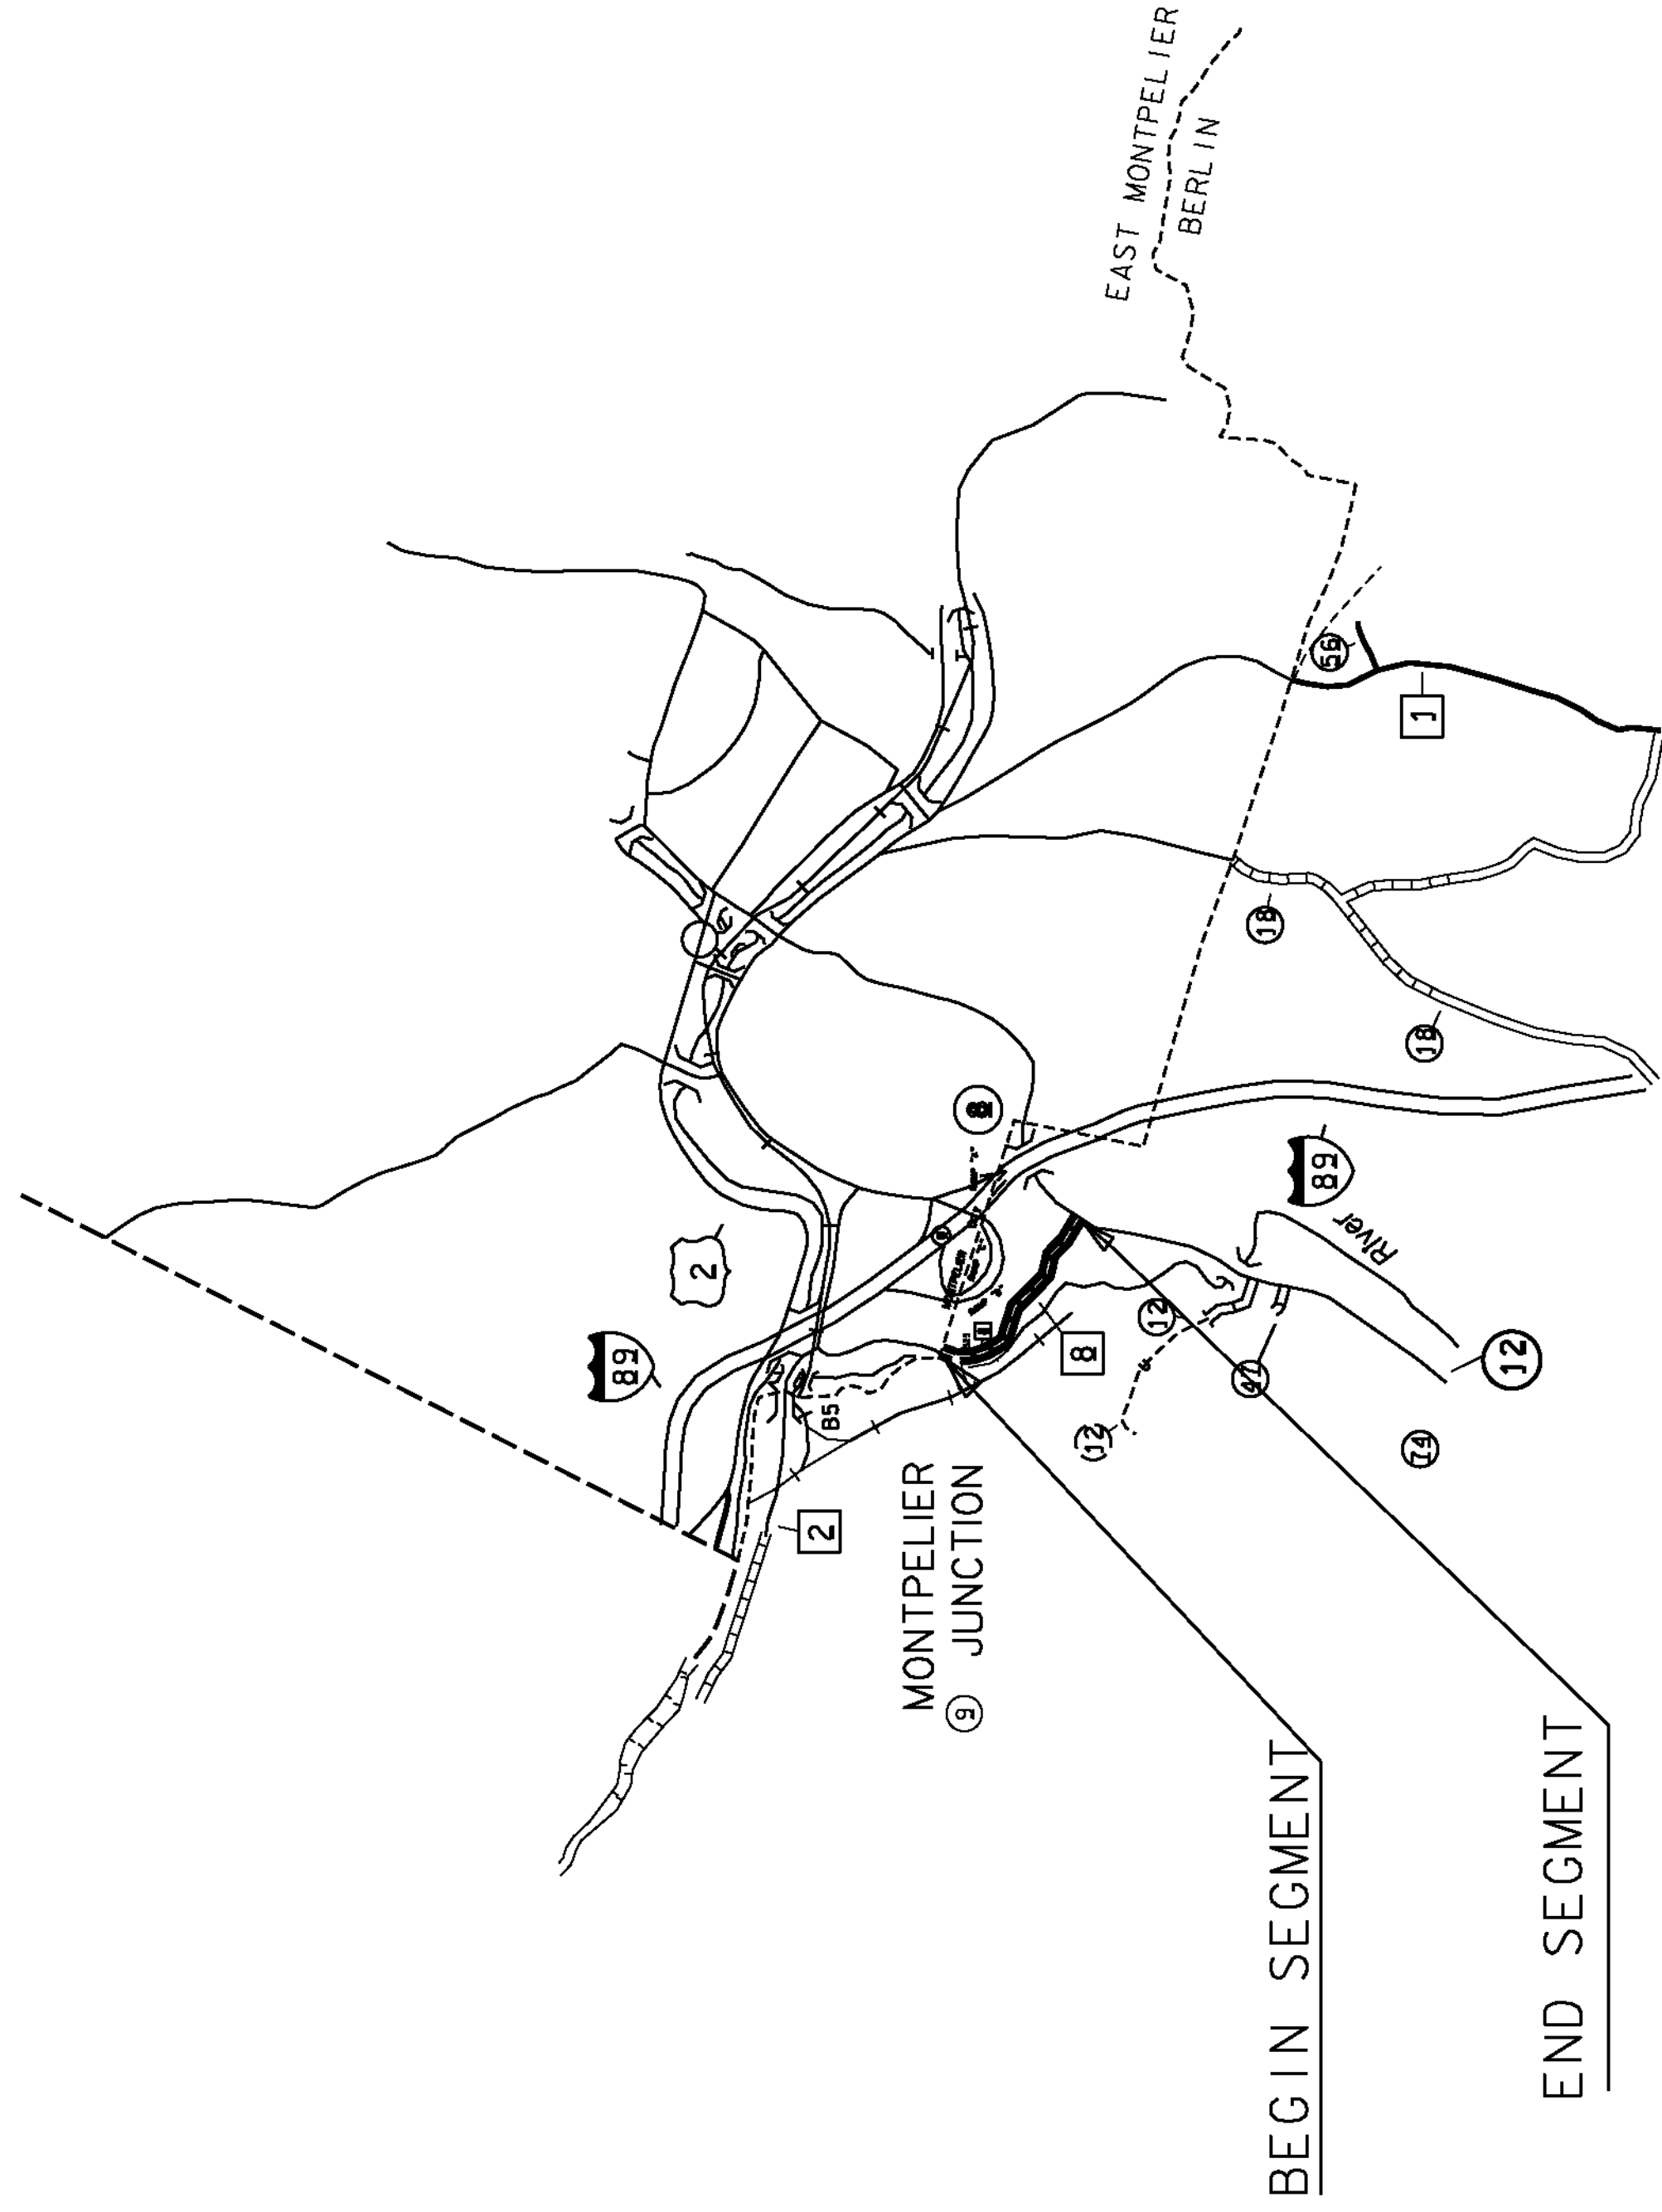


WORK TO BEGIN AT THE TOWN LINE OF MONTEPELLIER AND BERLIN ON DOG RIVER ROAD (TH-8) IN THE TOWN OF BERLIN, DESIGNATING THIS AS MILE MARKER 0.000 AND EXTENDING EASTERLY ALONG DOG RIVER ROAD (TH-8) FOR A DISTANCE OF 0.680 MILES TO A POINT 0.089 MILES EAST OF POLE 2/GMP/27501 (MM 0.591) TO END THIS SEGMENT OF THE PROJECT.

BEGIN SEGMENT

END SEGMENT

L

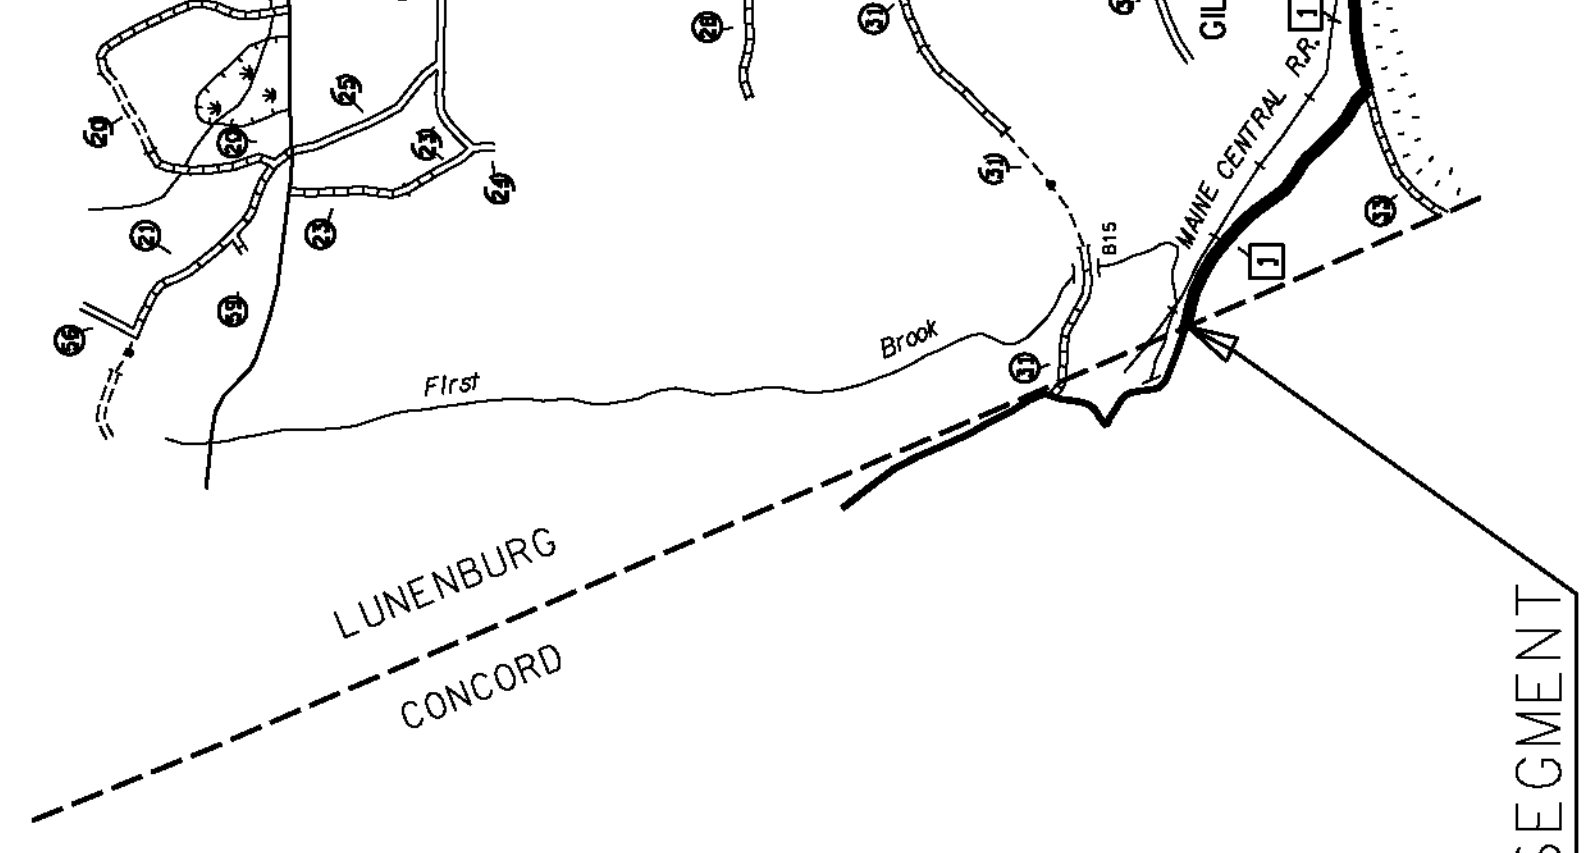

BEGIN SEGMENT

END SEGMENT

WORK TO BEGIN AT THE
ON SOUTH RIVER ROAD (TH-1)
THIS POINT AS MILE MARKER
A DISTANCE OF 7.100 MILES
POLE # 37-7/NET/895 (MM

ALSO WORK TO BEGIN AT T
AND MT. ORNE BRIDGE ROAD
ROADS INTERSECTS AS MILE
ORNE BRIDGE ROAD
TO END THIS