


WOLCOTT

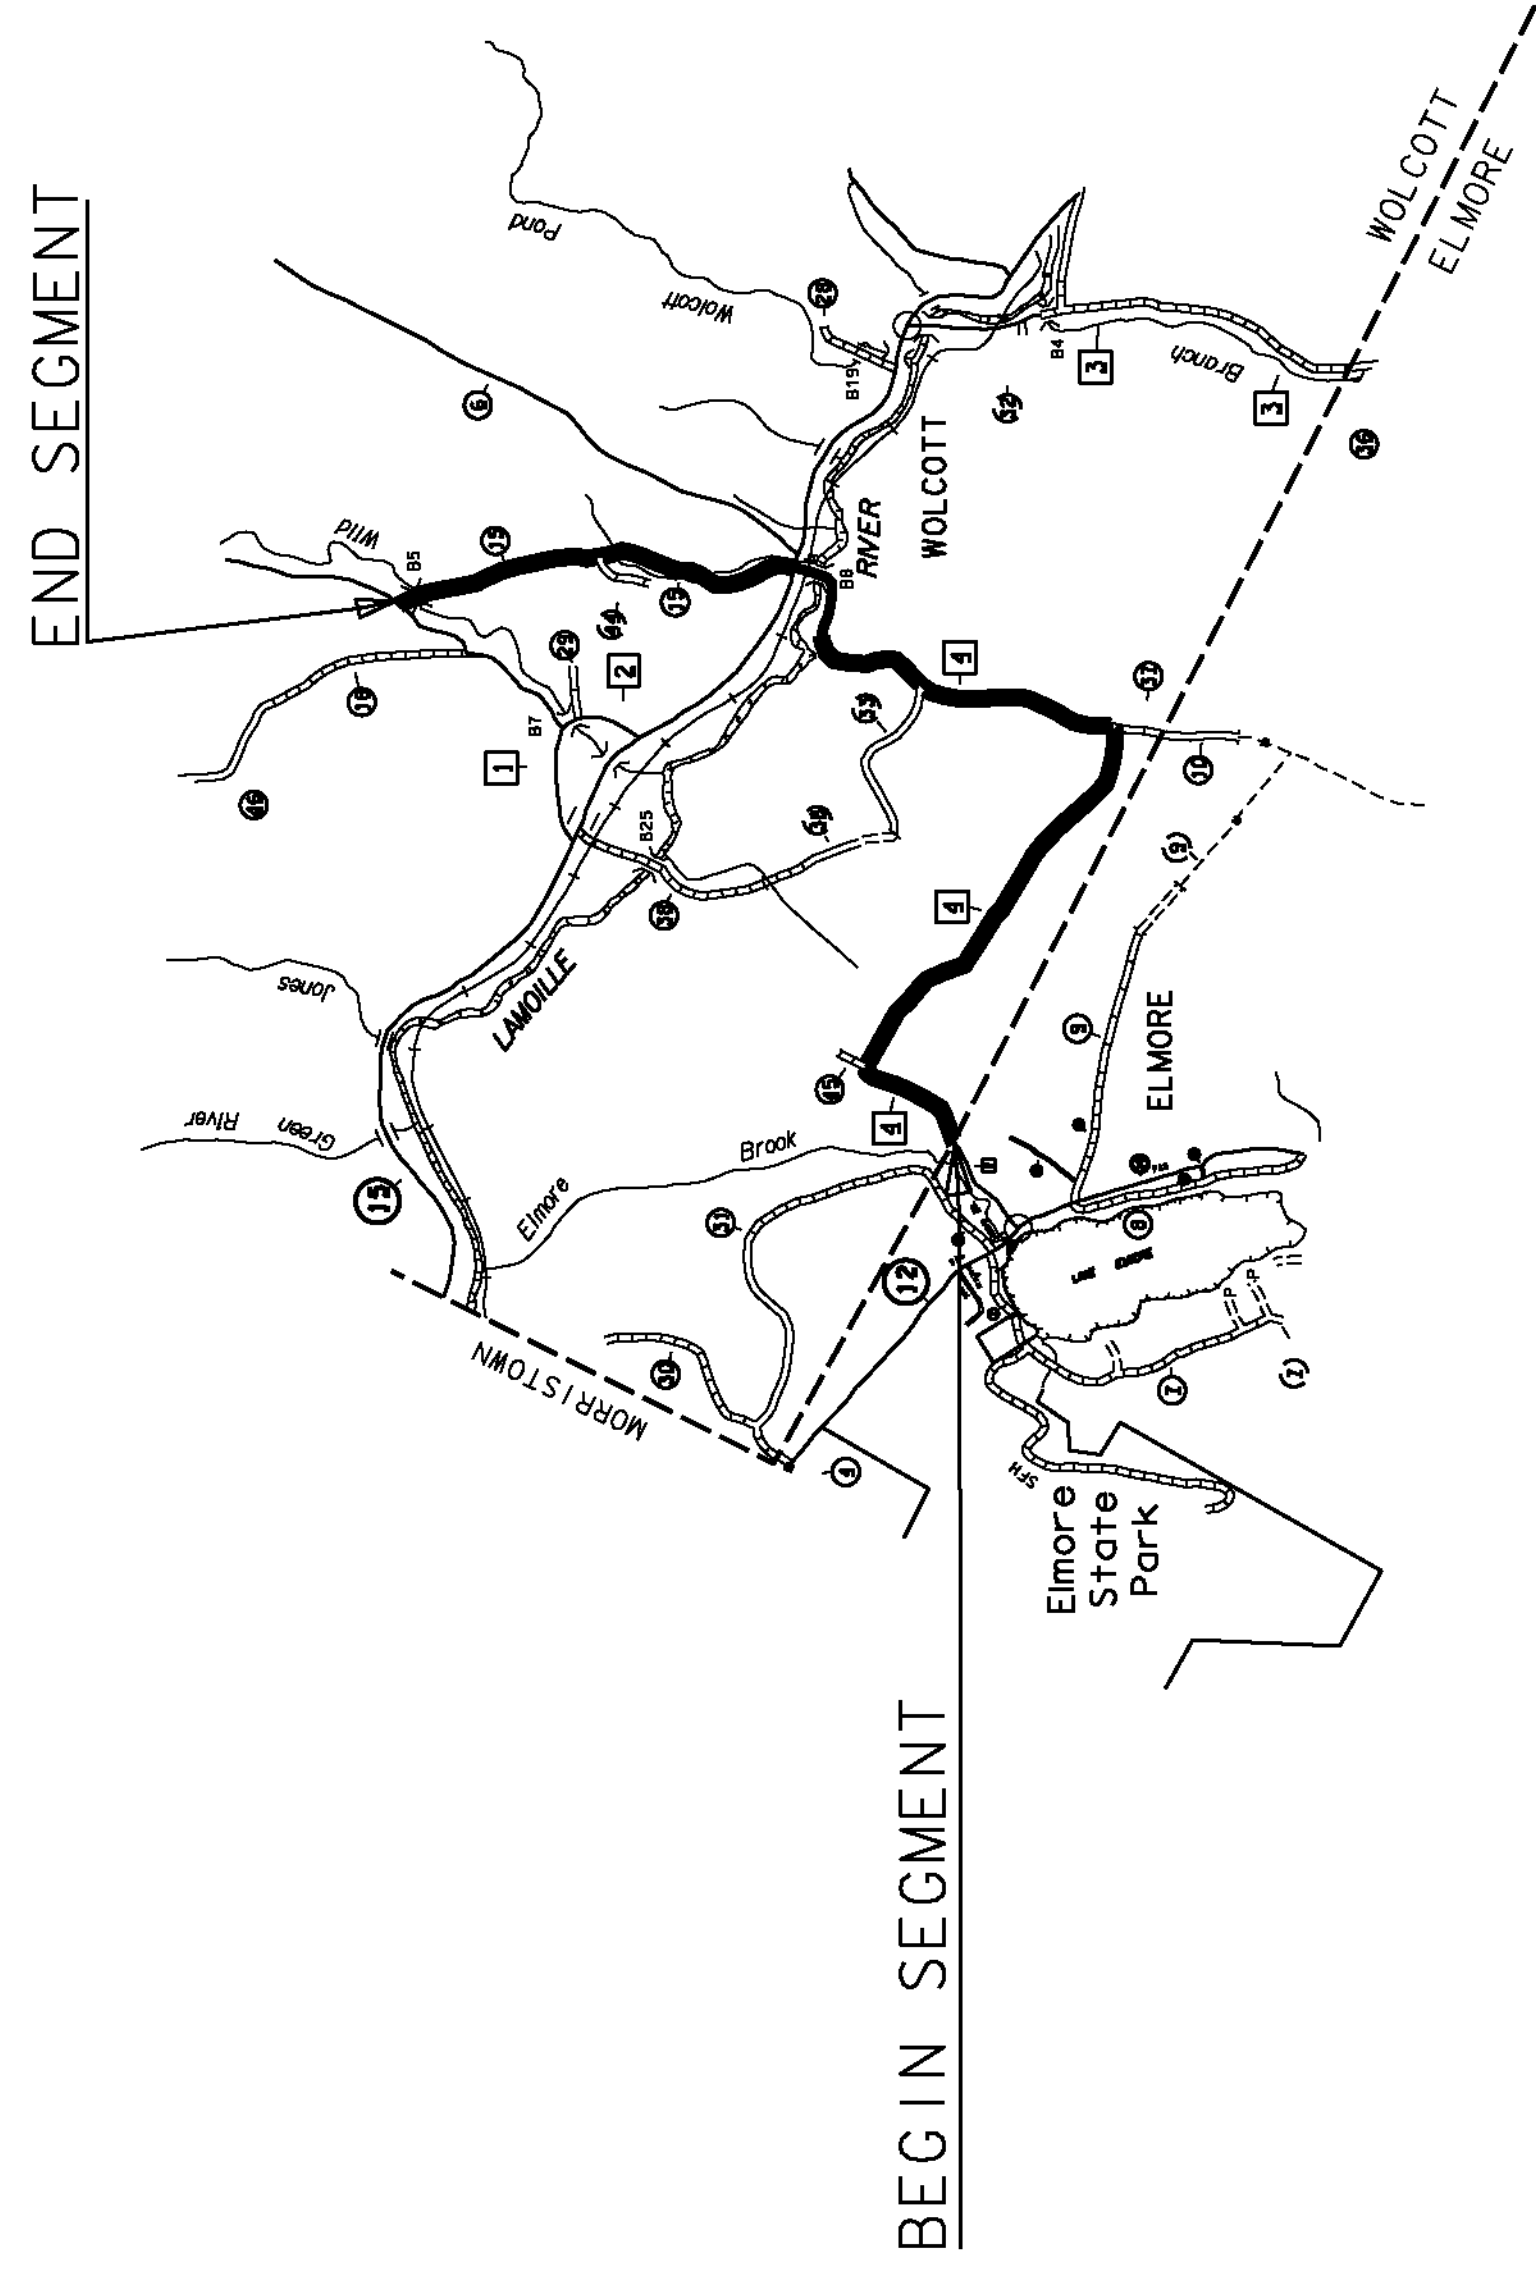

WORK TO BEGIN AT THE TOWN LINE OF WOLCOTT AND ELMORE IN THE TOWN OF WOLCOTT, DESIGNATING THIS POINT AS MILE MARKER 0.000 AND EXTENDING NORTHERLY ALONG ELMORE POND ROAD (TH-4) FOR A DISTANCE OF 3.402 MILES TO THE INTERSECTION OF ELMORE POND ROAD AND RTE 15 TO END THIS SEGMENT OF THE PROJECT.

ALSO WORK TO BEGIN AT MILE MARKER 3.410 EXTENDING NORTHERLY ALONG GULF ROAD (TH-15) AND TRAVELING FOR A DISTANCE OF 1.481 MILES TO A POINT 32' NORTH OF POLE # 38-3/ 1 (MM 4.891) TO END THIS SEGMENT OF THE PROJECT.