

STATE OF VERMONT AGENCY OF TRANSPORTATION



PROPOSED IMPROVEMENT


STATEWIDE NORTHWEST REGION STP HRRR(17)

TOWNS OF BRISTOL, GEORGIA, MILTON, MORETOWN,
RICHMOND, ST ALBANS, STOWE, SWANTON, AND WESTFORD
COUNTIES OF ADDISON, FRANKLIN, CHITTENDEN, AND LAMOILLE

PROJECT DESCRIPTION: WORK TO BE PERFORMED UNDER THIS PROJECT INCLUDES THE REMOVAL OF EXISTING SIGNS, SIGN POSTS, AND GUARDRAIL; THE INSTALLATION OF NEW SIGNS, SIGN POSTS, SIGNAL EQUIPMENT AND GUARDRAIL; PAVEMENT MARKINGS (CENTERLINE, EDGELINE, SYMBOLS AND LETTERS); AND OTHER HIGHWAY RELATED ITEMS FOR THE DESCRIBED WORK.

PROJECT LOCATIONS:	TH -	MM	0.000 -	BRISTOL (BURPEE ROAD)
	TH - 6,	MM	0.000 - 1.887	BRISTOL (MONKTON ROAD)
	TH - 4,	MM	0.000 - 0.482	BRISTOL (RIVER ROAD)
	TH - 7,	MM	0.000 - 0.413	GEORGIA (BALLARD ROAD)
	TH - 6,	MM	0.000 - 2.874	MILTON (ROLLIN IRISH ROAD)
	TH - 52,	MM	0.000 - 1.298	MILTON (DUFFY ROAD)
	TH - 52,	MM	0.000 - 0.058	MORETOWN (MORETOWN MOUNTAIN ROAD)
	TH - 1,	MM	0.000 - 6.260	RICHMOND (WES WHITE HILL ROAD)
	TH - 30,	MM	0.000 - 3.100	ST. ALBANS (US ROUTE 7)
	TH - 1,	MM	1.480 - 1.559	STOWE (WEEKS HILL ROAD)
	TH - 23,	MM	0.000 - 4.142	SWANTON (COUNTY ROAD)
	TH - 7,	MM	0.000 - 0.273	SWANTON (BEEBE ROAD)
	TH - 2,	MM	0.000 - 0.185	WESTFORD (ROLLIN IRISH ROAD)
	TH - 31,	MM	0.000 - 1.690	

PROJECT LOCATIONS
SEE SHEETS 8-12
FOR SITE MAPS

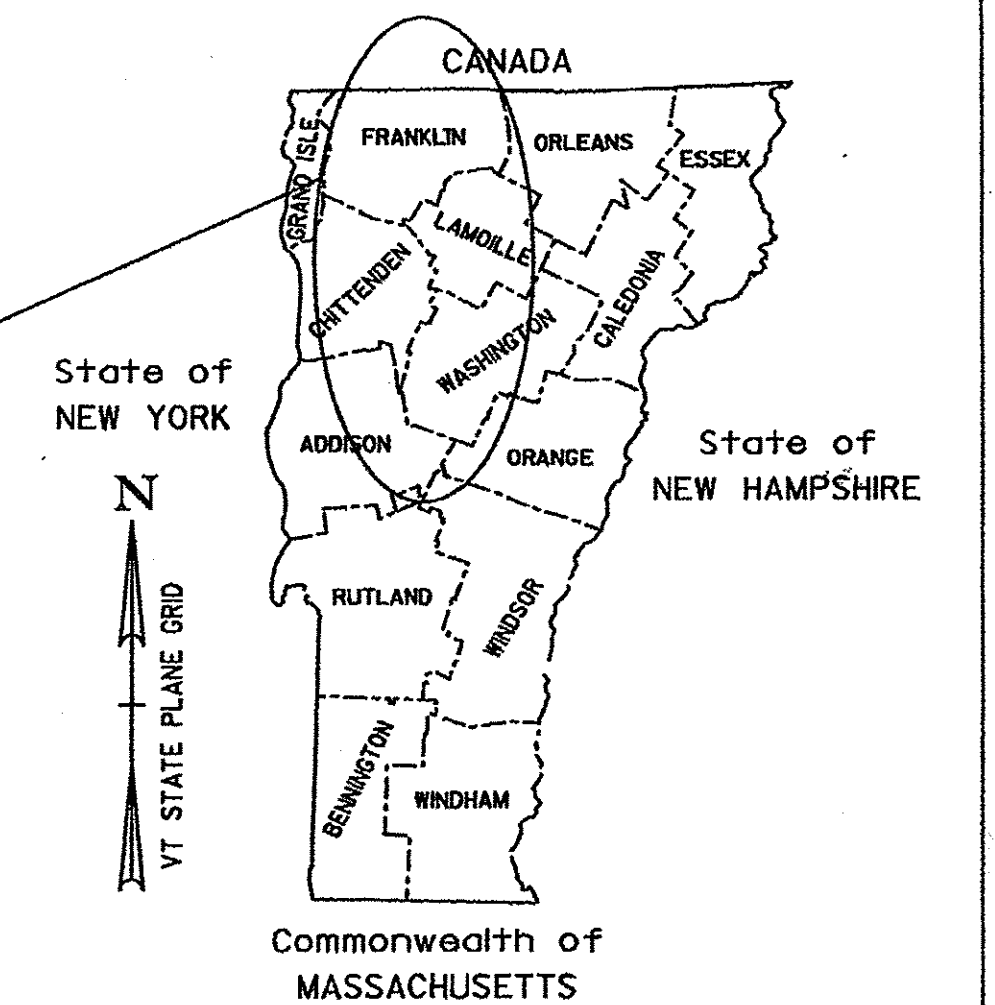

RECORD PLANS	
CONTRACTOR:	F. R. LAFAYETTE, INC. - ESSEX JUNCTION, VT
RESIDENT ENGINEER:	DAVID HOSKING
CONSTRUCTION BEGAN:	MAY 12, 2014
CONSTRUCTION COMPLETE:	OCTOBER 17, 2014
RECORD PLANS BY:	DAVID HOSKING & JENNA HYDE
I HEREBY CERTIFY THAT ALL THE CONSTRUCTION REQUIRED BY THIS SET OF DRAWINGS HAS BEEN ACCOMPLISHED AS INDICATED HEREIN.	
BY <u>David Hosking</u>	RESIDENT ENGINEER
DATE <u>12/21/15</u>	
NOTE: Any further information concerning final quantities, amounts or other details relative to this project may be found by contacting Vtrans Records Management.	

PROJECT LENGTHS:	1.887 MILES	(9963.36 FT)
	0.482 MILES	(2544.96 FT)
	0.413 MILES	(2180.64 FT)
	2.874 MILES	(15174.72 FT)
	1.298 MILES	(6858.44 FT)
	0.058 MILES	(306.24 FT)
	6.260 MILES	(33052.80 FT)
	3.100 MILES	(16368.00 FT)
	0.079 MILES	(417.12 FT)
	4.142 MILES	(21869.76 FT)
	0.273 MILES	(1441.44 FT)
	0.185 MILES	(976.80 FT)
	1.690 MILES	(8923.20 FT)
TOTAL LENGTH:	22.741 MILES	(120072.50 FT)

QUALITY ASSURANCE PROGRAM: LEVEL 3

CONVENTIONAL SYMBOLS

COUNTY LINE	
TOWN LINE	
LIMITS OF ACCESS	
POINT OF ACCESS	
FENCE LINE	
STONE WALL	
TRAVELED WAY	
GUARD RAIL	
RAILROAD	
SURVEY LINE	
CULVERT	
POWER POLE	
TELEPHONE POLE	
TREES	
CONTROL OF ACCESS	
PROPERTY LINE	
R.O.W. TAKING LINE	
SLOPE RIGHTS	
TOP OF CUT	
TOE OF SLOPE	

SURVEYED BY :	N/A
SURVEYED DATE :	N/A
DATUM	
VERTICAL	N/A
HORIZONTAL	N/A

THESE PLANS ARE SUBJECT TO SUCH ENGINEERING CHANGES AS MAY BE REQUIRED BY THE FEDERAL HIGHWAY ADMINISTRATION OR THE DIRECTOR OF PROGRAM DEVELOPMENT.
CONSTRUCTION IS TO BE CARRIED ON IN ACCORDANCE WITH THESE PLANS AND THE STANDARD SPECIFICATIONS FOR CONSTRUCTION DATED 2011, AS APPROVED BY THE FEDERAL HIGHWAY ADMINISTRATION ON JULY 20, 2011 FOR USE ON THIS PROJECT, INCLUDING ALL SUBSEQUENT REVISIONS AND SUCH REVISED SPECIFICATIONS AND SPECIAL PROVISIONS AS ARE INCORPORATED IN THESE PLANS.

DIRECTOR OF PROGRAM DEVELOPMENT	
APPROVED <u>Richard J. Johnson</u>	DATE <u>1/22/14</u>
PROJECT MANAGER : PATRICIA COBURN, P.E.	
PROJECT NAME : STATEWIDE - NORTHWEST REGION	
PROJECT NUMBER : STP HRRR(17)	
SHEET 1 OF 73 SHEETS	