


STATE OF VERMONT AGENCY OF TRANSPORTATION

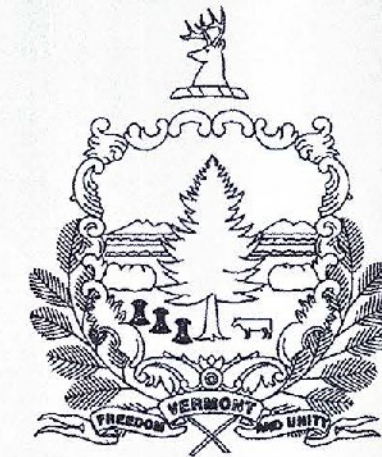


PROPOSED IMPROVEMENT

**STATEWIDE SOUTHEAST REGION STP HRRR(18)
TOWNS OF DOVER, ROYALTON AND WILMINGTON
COUNTIES OF WINDHAM AND WINDSOR**

PROJECT DESCRIPTION: WORK TO BE PERFORMED UNDER THIS PROJECT INCLUDES THE REMOVAL OF EXISTING SIGNS, SIGN POSTS, AND GUARDRAIL; THE INSTALLATION OF NEW SIGNS, SIGN POSTS, AND GUARDRAIL; PAVEMENT MARKINGS (CENTERLINE, EDGELINE, SYMBOLS AND LETTERS); AND OTHER HIGHWAY RELATED ITEMS FOR THE DESCRIBED WORK.

PROJECT LOCATIONS:	TH-2,	MM	0.000 - 2.717	DOVER (HANDLE ROAD)
	TH-3,	MM	0.000 - 0.093	DOVER (SOUTH ACCESS ROAD)
	TH-6,	MM	0.000 - 3.010	ROYALTON (ROYALTON HILL ROAD)
	TH-36,	MM	0.000 - 0.097	ROYALTON (BACK RIVER ROAD)
	TH-22,	MM	0.000 - 0.737, 1.739 - 2.730	WILMINGTON (COLDBROOK ROAD)
	TH-21,	MM	0.000 - 1.923	WILMINGTON (HIGLEY HILL ROAD)

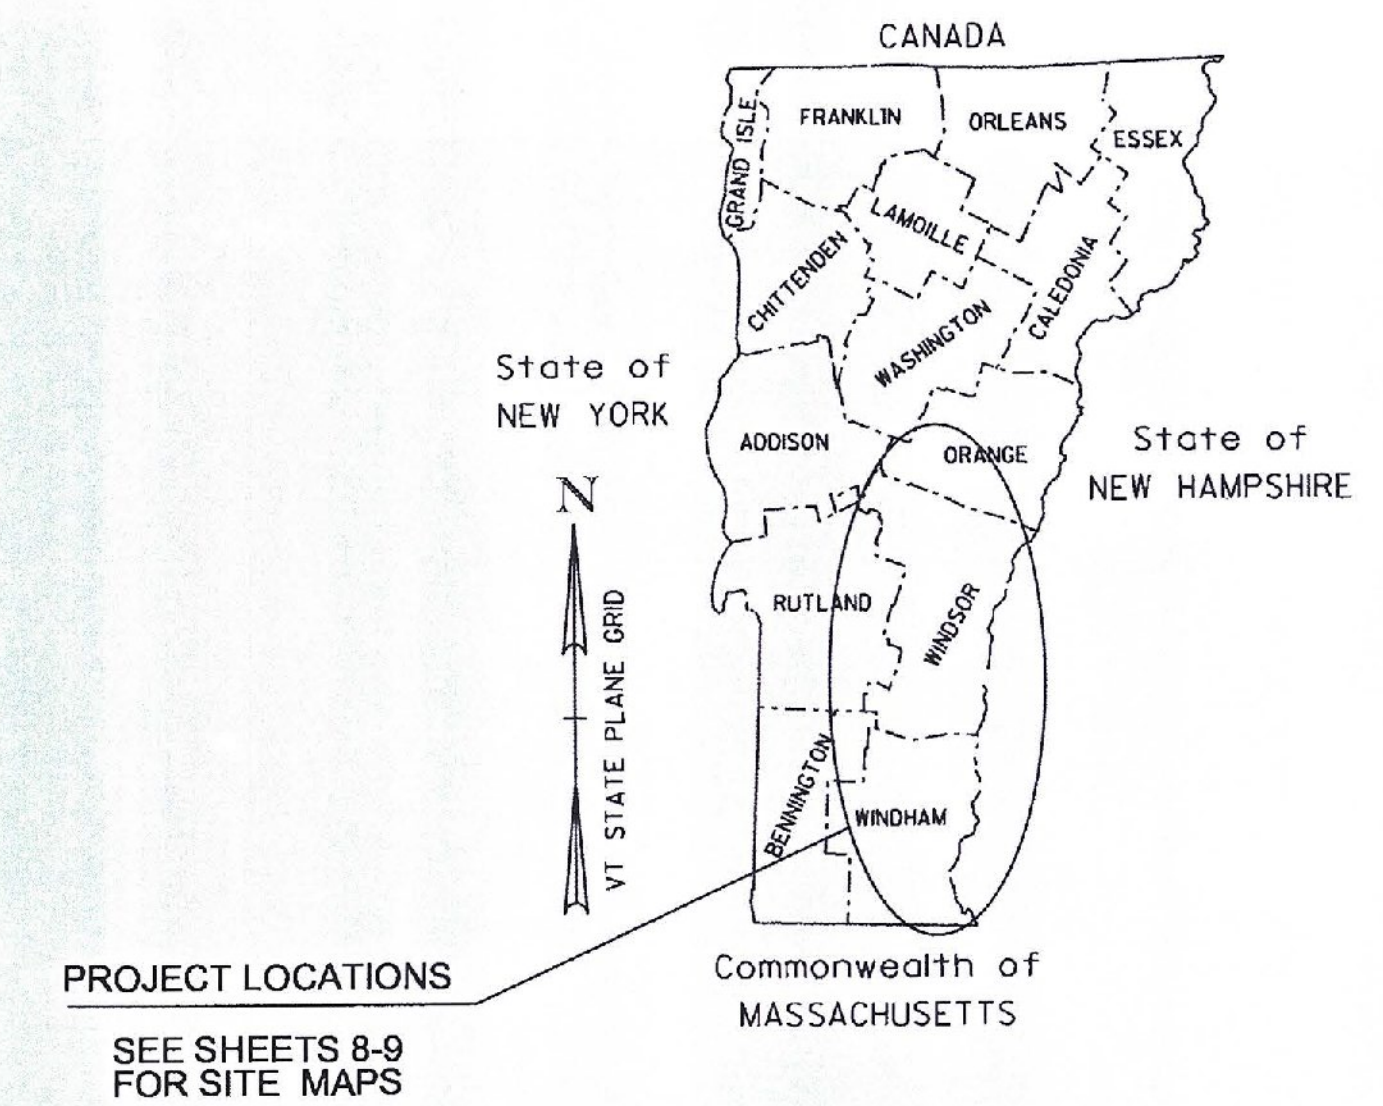

RECORD PLANS	
CONTRACTOR:	F. R. LAFAYETTE, INC.- ESSEX JUNCTION, VT
RESIDENT ENGINEER:	CHRIS BARKER
CONSTRUCTION BEGAN:	APRIL 21, 2014
CONSTRUCTION COMPLETE:	JULY 1, 2014
RECORD PLANS BY:	CHRIS BARKER & CRAIG PIERCE
I HEREBY CERTIFY THAT ALL THE CONSTRUCTION REQUIRED BY THIS SET OF DRAWINGS HAS BEEN ACCOMPLISHED AS INDICATED HEREIN.	
BY:	RESIDENT ENGINEER
DATE:	11/02/15
NOTE: Any further information concerning final quantities, amounts or other details relative to this project may be found at Central Files in the electronic archives.	

PROJECT LENGTHS:	2.717 MILES	(14346.00 FT)
	0.093 MILES	(491.00 FT)
	3.010 MILES	(15893.00 FT)
	0.097 MILES	(512.00 FT)
	1.728 MILES	(9124.00 FT)
	1.923 MILES	(10153.00 FT)
TOTAL LENGTH:	9.568 MILES	(50519.00 FT)

QUALITY ASSURANCE PROGRAM: LEVEL 3

CONVENTIONAL SYMBOLS	
COUNTY LINE	
TOWN LINE	
LIMITS OF ACCESS	
POINT OF ACCESS	
FENCE LINE	
STONE WALL	
TRAVELED WAY	
GUARD RAIL	
RAILROAD	
SURVEY LINE	
CULVERT	
POWER POLE	
TELEPHONE POLE	
TREES	
CONTROL OF ACCESS	
PROPERTY LINE	
R.O.W. TAKING LINE	
SLOPE RIGHTS	
TOP OF CUT	
TOE OF SLOPE	

SURVEYED BY :	N/A
SURVEYED DATE :	N/A
DATUM	
VERTICAL	N/A
HORIZONTAL	N/A

THESE PLANS ARE SUBJECT TO SUCH ENGINEERING CHANGES AS MAY BE REQUIRED BY THE FEDERAL HIGHWAY ADMINISTRATION OR THE DIRECTOR OF PROGRAM DEVELOPMENT.

CONSTRUCTION IS TO BE CARRIED ON IN ACCORDANCE WITH THESE PLANS AND THE STANDARD SPECIFICATIONS FOR CONSTRUCTION DATED 2011, AS APPROVED BY THE FEDERAL HIGHWAY ADMINISTRATION ON JULY 20, 2011 FOR USE ON THIS PROJECT, INCLUDING ALL SUBSEQUENT REVISIONS AND SUCH REVISED SPECIFICATIONS AND SPECIAL PROVISIONS AS ARE INCORPORATED IN THESE PLANS.

DIRECTOR OF PROGRAM DEVELOPMENT	
APPROVED	DATE 12-17-12
PROJECT MANAGER : PATRICIA COBURN, P.E.	
PROJECT NAME : STATEWIDE - SOUTHEAST REGION	
PROJECT NUMBER : STP HRRR(18)	
SHEET 1 OF 34 SHEETS	