


# STATE OF VERMONT AGENCY OF TRANSPORTATION

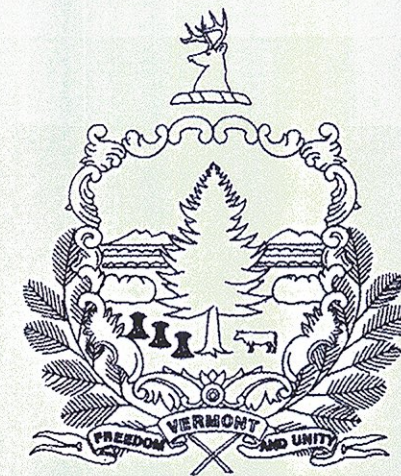

## PROPOSED IMPROVEMENT

STATEWIDE SOUTHWEST REGION STP HRRR(19)

TOWNS OF BENNINGTON, DORSET, LEICESTER, NORTH BENNINGTON, PITTSFORD, TINMOUTH,  
WALLINGFORD AND WHITING  
COUNTIES OF BENNINGTON, RUTLAND AND ADDISON

PROJECT DESCRIPTION: WORK TO BE PERFORMED UNDER THIS PROJECT INCLUDES THE REMOVAL OF EXISTING SIGNS, SIGN POSTS, AND GUARDRAIL; THE INSTALLATION OF NEW SIGNS, SIGN POSTS, AND GUARDRAIL; PAVEMENT MARKINGS (CENTERLINE, EDGELINE, SYMBOLS AND LETTERS); AND OTHER HIGHWAY RELATED ITEMS FOR THE DESCRIBED WORK.

PROJECT LOCATIONS:	TH	MM	0.000 - 0.740	BENNINGTON (OVERLEA ROAD)
	TH - 5,	MM	0.000 - 4.337	DORSET (MAD TOM ROAD)
	TH - 1,	MM	0.000 - 3.182	LEICESTER (LEICESTER-WHITING ROAD)
	TH - 3,	MM	0.000 - 0.109	LEICESTER (SWININGTON HILL ROAD)
	TH - 10,	MM	0.000 - 0.261	NORTH BENNINGTON (OVERLEA ROAD)
	TH - 7,	MM	0.000 - 0.189	PITTSFORD (MEADOWLAKE DRIVE)
	TH - 4,	MM	0.000 - 0.612	PITTSFORD (EAST PITTSFORD ROAD)
	TH - 1,	MM	0.000 - 5.925	TINMOUTH (STATE NUMBERED TOWN HIGHWAY 140)
	TH - 2,	MM	0.000 - 0.282	TINMOUTH (MOUNTAIN VIEW ROAD)
	TH - 1,	MM	0.000 - 2.398	WALLINGFORD (STATE NUMBERED TOWN HIGHWAY 140)
	TH - 1,	MM	0.000 - 2.366	WHITING (LEICESTER-WHITING ROAD)
	TH - ?,	MM	0.000 - 1.275	WHITING (SHOREHAM-WHITING ROAD)

PROJECT LENGTHS:	MILES	(FEET)
	0.740 MILES	(3907.00 FT)
	4.337 MILES	(22900.00 FT)
	3.182 MILES	(16801.00 FT)
	0.109 MILES	(576.00 FT)
	0.261 MILES	(1378.00 FT)
	0.189 MILES	(978.00 FT)
	0.612 MILES	(3231.00 FT)
	5.925 MILES	(31284.00 FT)
	0.282 MILES	(1489.00 FT)
	2.398 MILES	(12688.00 FT)
	2.366 MILES	(12492.00 FT)
	1.275 MILES	(6732.00 FT)
<b>TOTAL LENGTH:</b>	<b>20.828 MILES</b>	<b>(109972.00 FT)</b>

**RECORD PLANS**

CONTRACTOR: F. R. LAFAYETTE, INC. - ESSEX JUNCTION, VT

RESIDENT ENGINEER: JUDY GILMORE

CONSTRUCTION BEGAN: APRIL 21, 2014

CONSTRUCTION COMPLETE: OCTOBER 7, 2014


RECORD PLANS BY: JUDY GILMORE & AARON JAMES

I HEREBY CERTIFY THAT ALL THE CONSTRUCTION REQUIRED BY THIS SET OF DRAWINGS HAS BEEN ACCOMPLISHED AS INDICATED HEREIN.

BY Judy Gilmore RESIDENT ENGINEER

DATE 20 June 2014

NOTE: Any further information concerning final quantities, amounts or other details relative to this project may be found by contacting Vtrans Records Management.

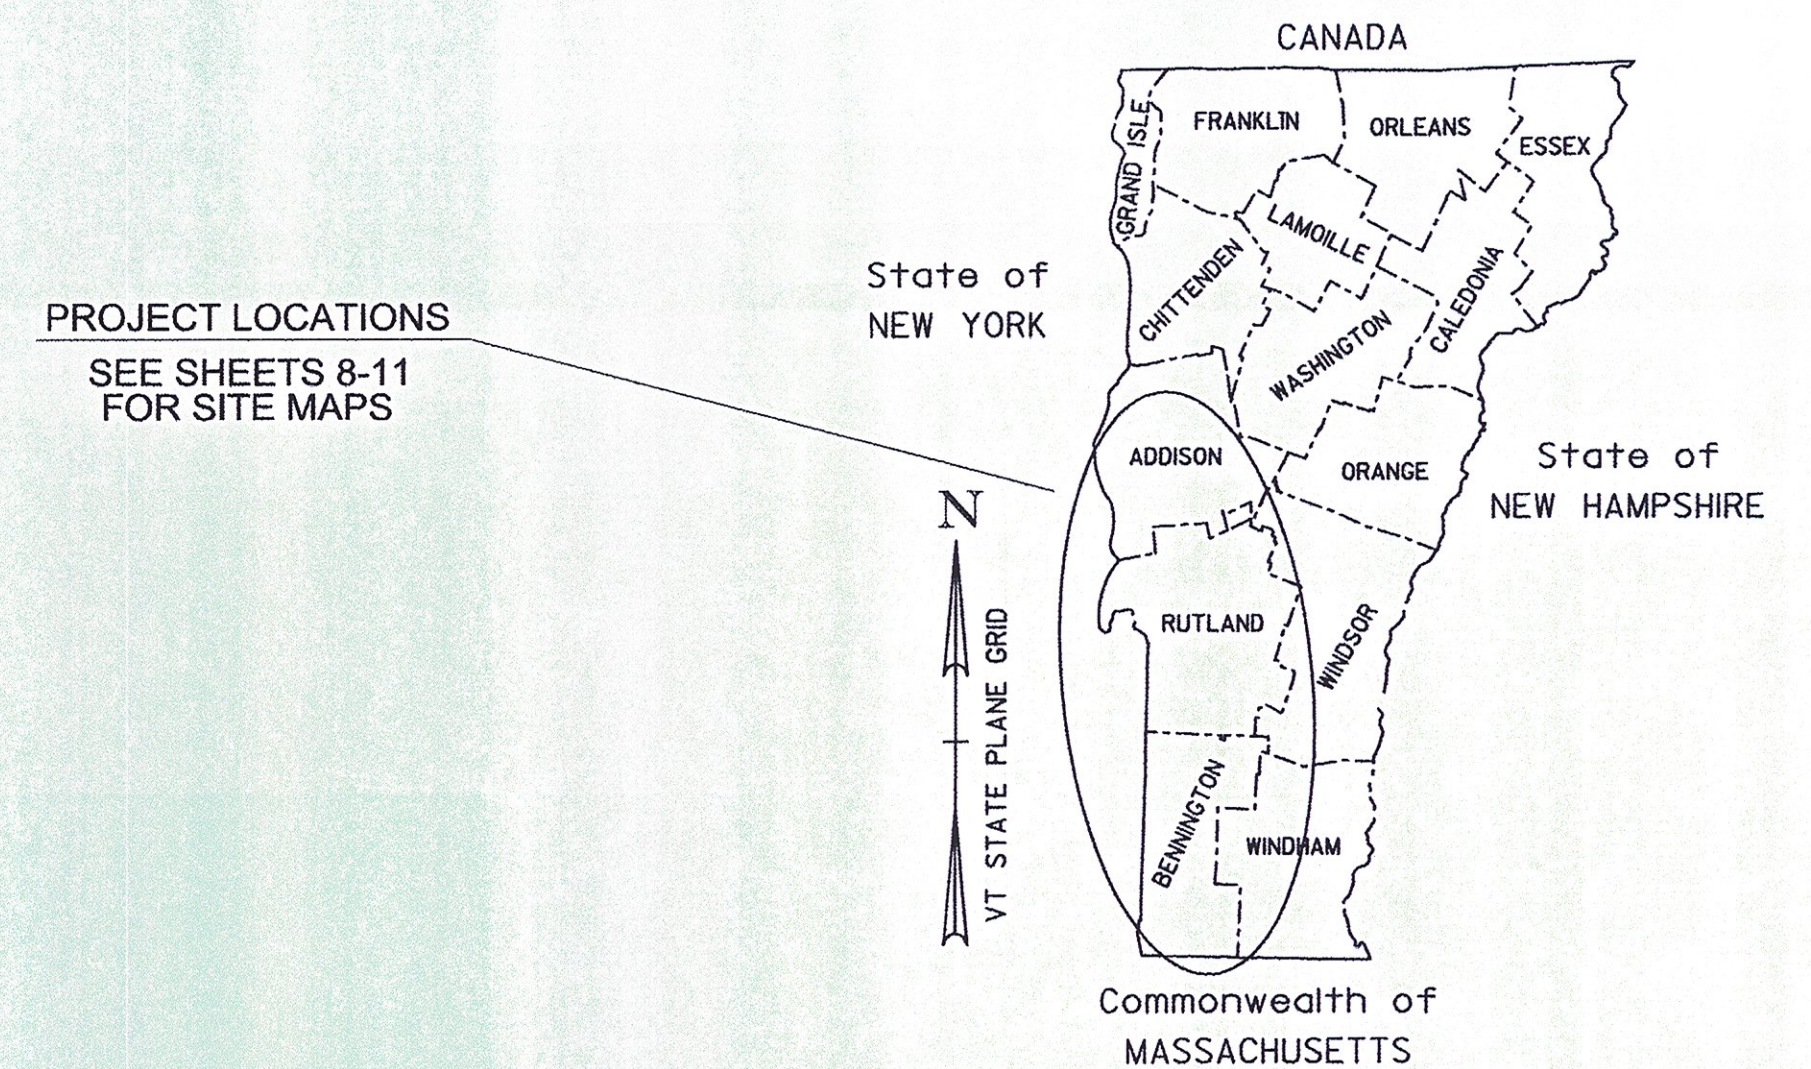

QUALITY ASSURANCE PROGRAM: LEVEL 3

CONVENTIONAL SYMBOLS	
COUNTY LINE	
TOWN LINE	
LIMITS OF ACCESS	
POINT OF ACCESS	
FENCE LINE	
STONE WALL	
TRAVELED WAY	
GUARD RAIL	
RAILROAD	
SURVEY LINE	
CULVERT	
POWER POLE	
TELEPHONE POLE	
TREES	
CONTROL OF ACCESS	
PROPERTY LINE	
R.O.W. TAKING LINE	
SLOPE RIGHTS	
TOP OF CUT	
TOE OF SLOPE	

SURVEYED BY :	N/A
SURVEYED DATE :	N/A
DATUM	
VERTICAL	N/A
HORIZONTAL	N/A

THESE PLANS ARE SUBJECT TO SUCH ENGINEERING CHANGES AS MAY BE REQUIRED BY THE FEDERAL HIGHWAY ADMINISTRATION OR THE DIRECTOR OF PROGRAM DEVELOPMENT.

CONSTRUCTION IS TO BE CARRIED ON IN ACCORDANCE WITH THESE PLANS AND THE STANDARD SPECIFICATIONS FOR CONSTRUCTION DATED 2011, AS APPROVED BY THE FEDERAL HIGHWAY ADMINISTRATION ON JULY 20, 2011 FOR USE ON THIS PROJECT, INCLUDING ALL SUBSEQUENT REVISIONS AND SUCH REVISED SPECIFICATIONS AND SPECIAL PROVISIONS AS ARE INCORPORATED IN THESE PLANS.

DIRECTOR OF PROGRAM DEVELOPMENT
APPROVED <u>Richard J. Howard</u> DATE <u>12-17-13</u>
PROJECT MANAGER : PATRICIA COBURN, P.E.
PROJECT NAME : STATEWIDE - SOUTHWEST REGION
PROJECT NUMBER : STP HRRR(19)
SHEET 1 OF 87 SHEETS