

Record Plans


Robert Suckert

Prime Contractor: Blow and Cote Inc.

Construction Began Date: 7/18/16

Substantial Completion Date: 12/9/16

STATE OF VERMONT AGENCY OF TRANSPORTATION

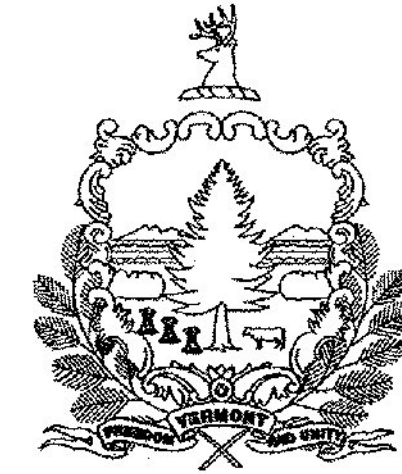


PROPOSED IMPROVEMENT

BRIDGE PROJECT

TOWN OF CHARLOTTE

COUNTY OF CHITTENDEN

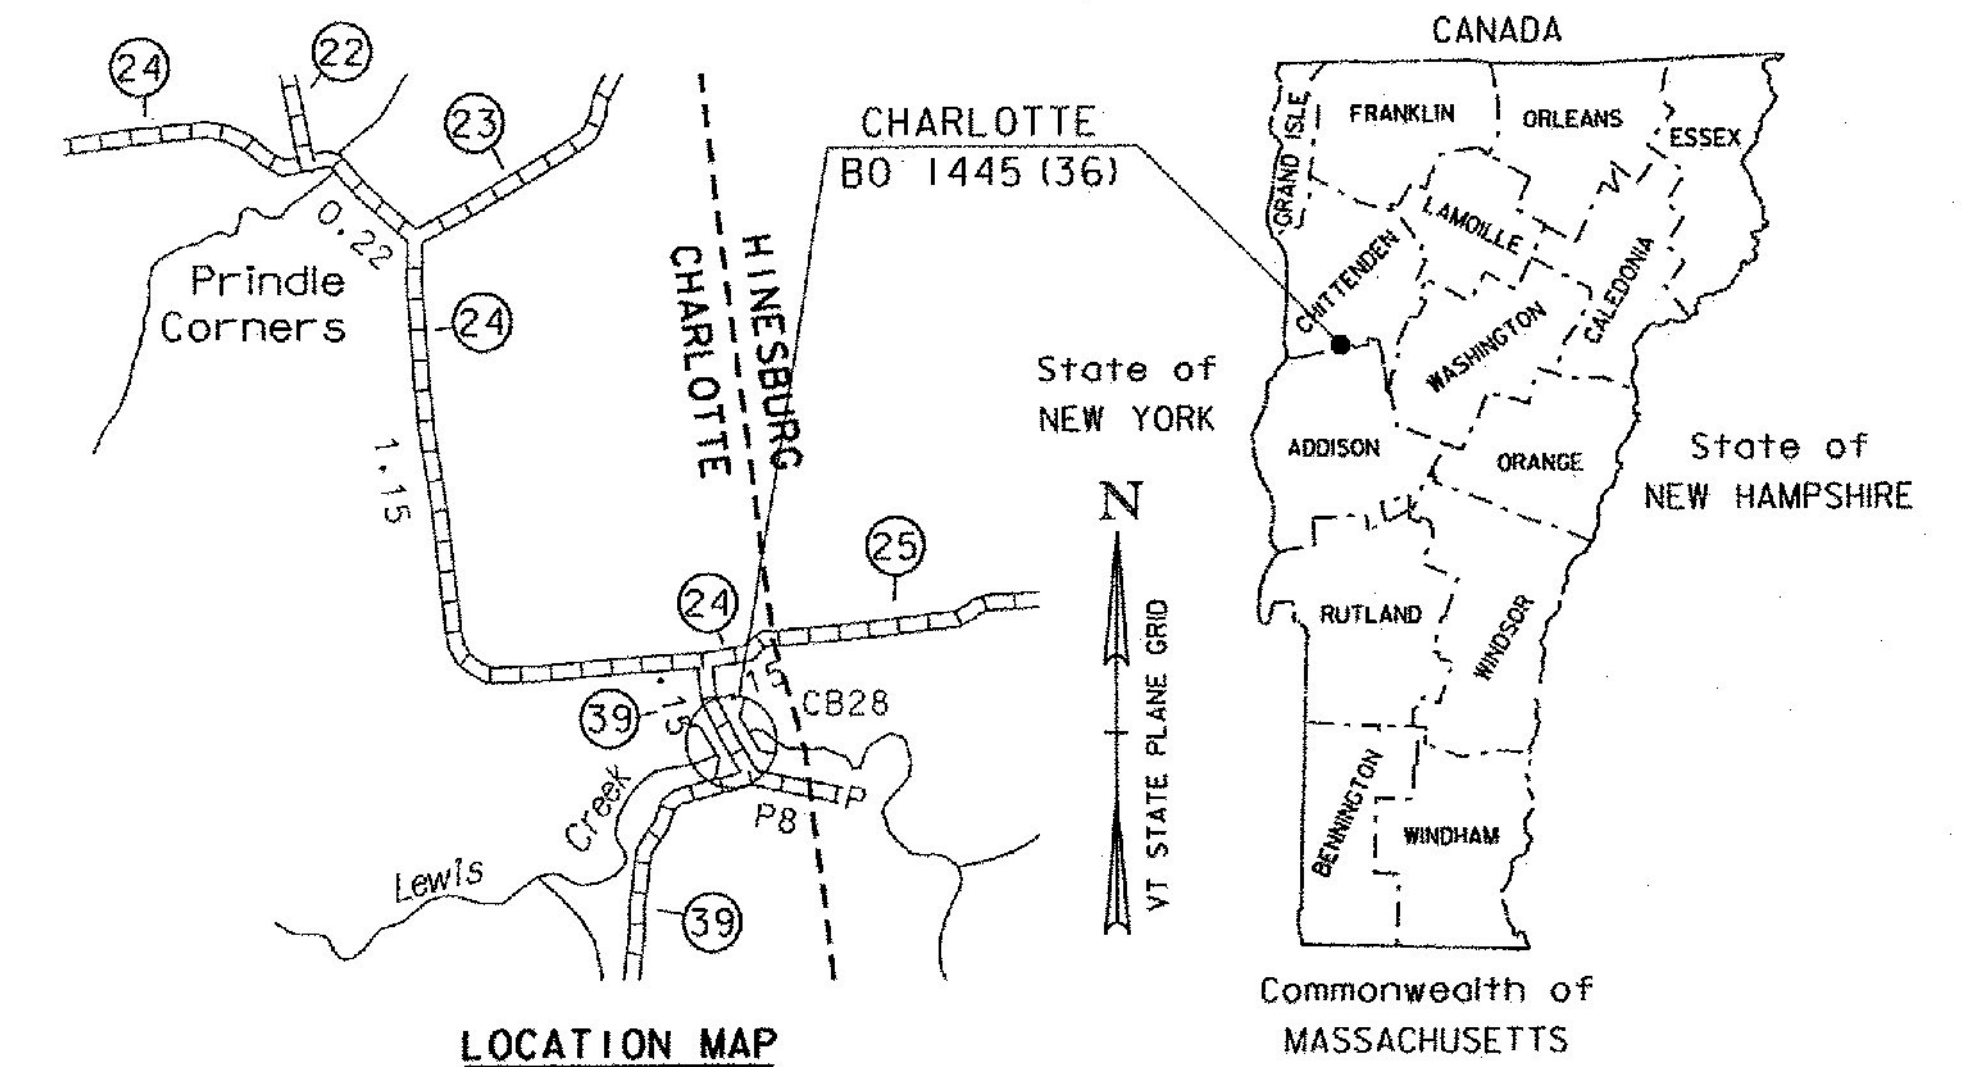


ROUTE NO : TH 39; CLASS 3 BRIDGE NO : 28

PROJECT LOCATION : ON TH 39 BEGINNING APPROXIMATELY 0.2 MILE SOUTH FROM ITS INTERSECTION WITH TH 24 AND EXTENDING SOUTHERLY APPROXIMATELY 0.01 MILE. ✓

PROJECT DESCRIPTION : REHABILITATION OF THE SEGUIN COVERED BRIDGE, INCLUDING TIMBER SUPERSTRUCTURE, BRIDGE SEATS AND MINOR APPROACH WORK. ✓

LENGTH OF STRUCTURE : 71.1 ± FEET
 LENGTH OF ROADWAY : 0.0 FEET ✓
 LENGTH OF PROJECT : 71.1 ± FEET

RECORD PLANS	
CONTRACTOR:	BLOW & COTE INC. - MORRISVILLE, VT
RESIDENT ENGINEER:	ROBERT SUCKERT
CONSTRUCTION BEGAN:	JULY 18, 2016
CONSTRUCTION COMPLETE:	DECEMBER 9, 2016
RECORD PLANS BY:	ROBERT SUCKERT & JESSE IVES
I HEREBY CERTIFY THAT ALL THE CONSTRUCTION REQUIRED BY THIS SET OF DRAWINGS HAS BEEN ACCOMPLISHED AS INDICATED HEREIN.	
BY:	<i>[Signature]</i> RESIDENT ENGINEER
DATE:	4-27-17
NOTE: Any further information concerning final quantities, amounts or other details relative to this project may be found at Central Files in the electronic archives.	

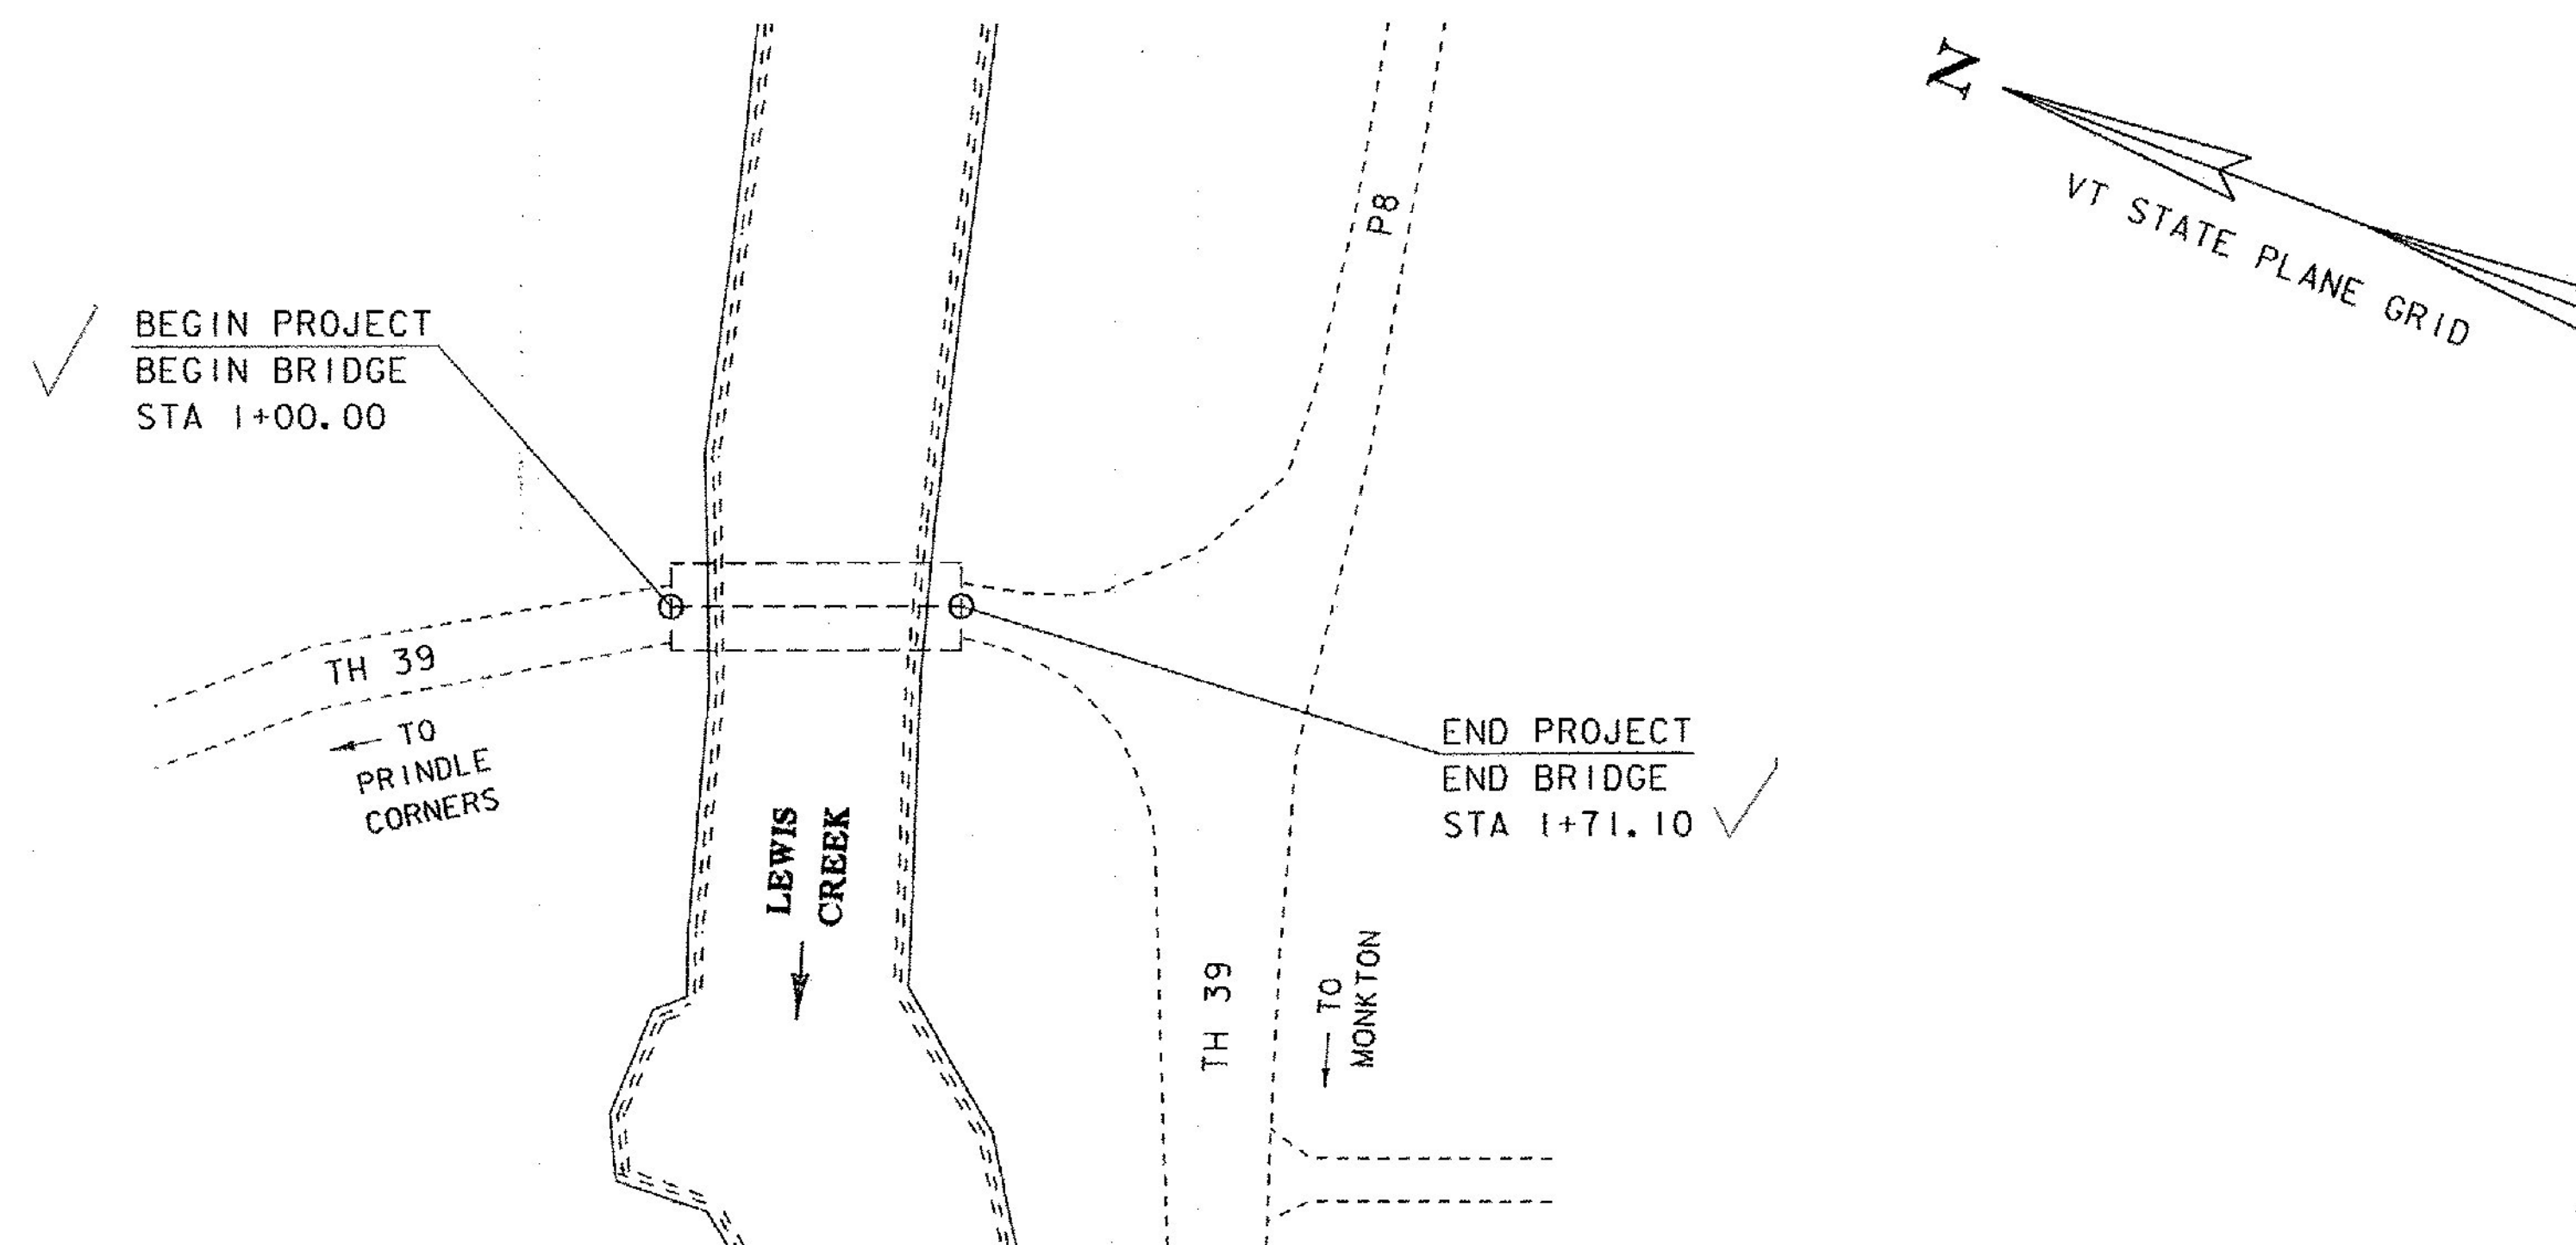

CONSTRUCTION IS TO BE CARRIED ON IN ACCORDANCE WITH THESE PLANS AND THE STANDARD SPECIFICATIONS FOR CONSTRUCTION DATED 2011, AS APPROVED BY THE FEDERAL HIGHWAY ADMINISTRATION ON JULY 20, 2011 FOR USE ON THIS PROJECT, INCLUDING ALL SUBSEQUENT REVISIONS AND SUCH REVISED SPECIFICATIONS AND SPECIAL PROVISIONS AS ARE INCORPORATED IN THESE PLANS.

QUALITY ASSURANCE PROGRAM : LEVEL 2	
SURVEYED BY :	NA
SURVEYED DATE :	NA
DATUM	
VERTICAL	NA
HORIZONTAL	NA

NOT TO SCALE

DIRECTOR OF PROJECT DELIVERY	
APPROVED <i>[Signature]</i>	DATE 2/2/2017
PROJECT MANAGER : M. SARGENT	
PROJECT NAME :	CHARLOTTE
PROJECT NUMBER :	BO 1445 (36)
SHEET 1 OF 13 SHEETS	