


INDEX OF SHEETS

- 1. TITLE SHEET
- 2. QUANTITY SHEET
- 3. MISCELLANEOUS DETAILS SHEET
- 4. TRAFFIC CONTROL SHEET
- 5-42 CLASS 2 TOWN HIGHWAY QUANTITY SHEETS 1-38
- 43-56 TOWN HIGHWAY COUNTY MAP SHEETS 1-14


STANDARDS LIST

- T-1 8-6-12
- T-24 8-6-12
- T-28 8-6-12
- T-29 8-6-12

STATE OF VERMONT AGENCY OF TRANSPORTATION

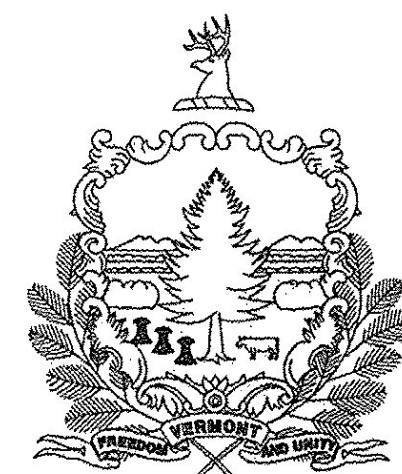



PROPOSED IMPROVEMENT STATEWIDE CLASS 2 TOWN HIGHWAY

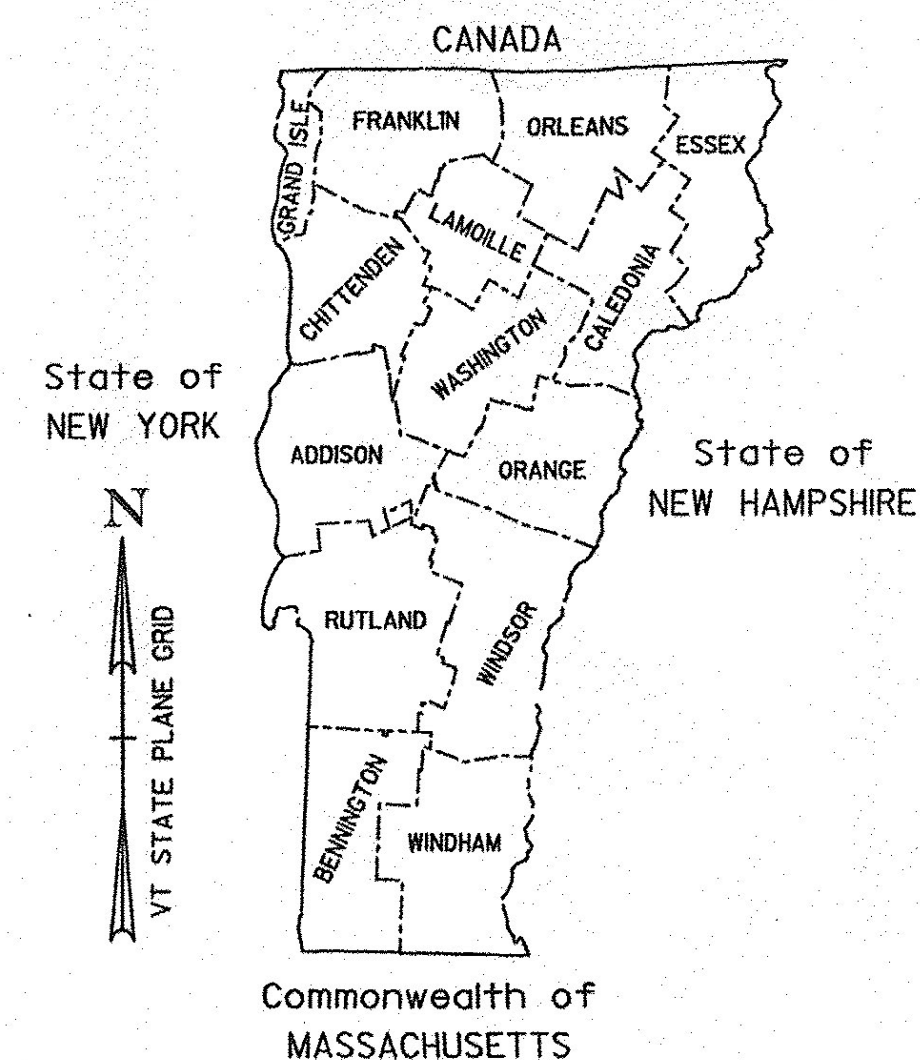

WORK TO BE PERFORMED ON THIS PROJECT CONSISTS OF PAINTING 4" DOUBLE YELLOW CENTERLINE MARKINGS ON CLASS 2 TOWN HIGHWAYS.

LENGTH OF PROJECT = 11,488,947.00 FT = 2,175.937 MILES

RECORD PLANS	
CONTRACTOR:	HI-WAY SAFETY SYSTEMS, INC. - ROCKLAND, MA
RESIDENT ENGINEER:	JOSH HULETT
CONSTRUCTION BEGAN:	JUNE 22, 2015
CONSTRUCTION COMPLETE:	OCTOBER 10, 2016
RECORD PLANS BY:	JOSH HULETT & JESSE IVES
I HEREBY CERTIFY THAT ALL THE CONSTRUCTION REQUIRED BY THIS SET OF DRAWINGS HAS BEEN ACCOMPLISHED AS INDICATED HEREIN.	
BY	RESIDENT ENGINEER
DATE	NOVEMBER 3, 2017
NOTE: Any further information concerning final quantities, amounts or other details relative to this project may be found at Central Files in the electronic archives.	

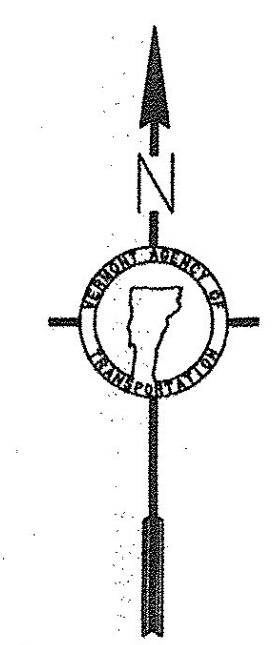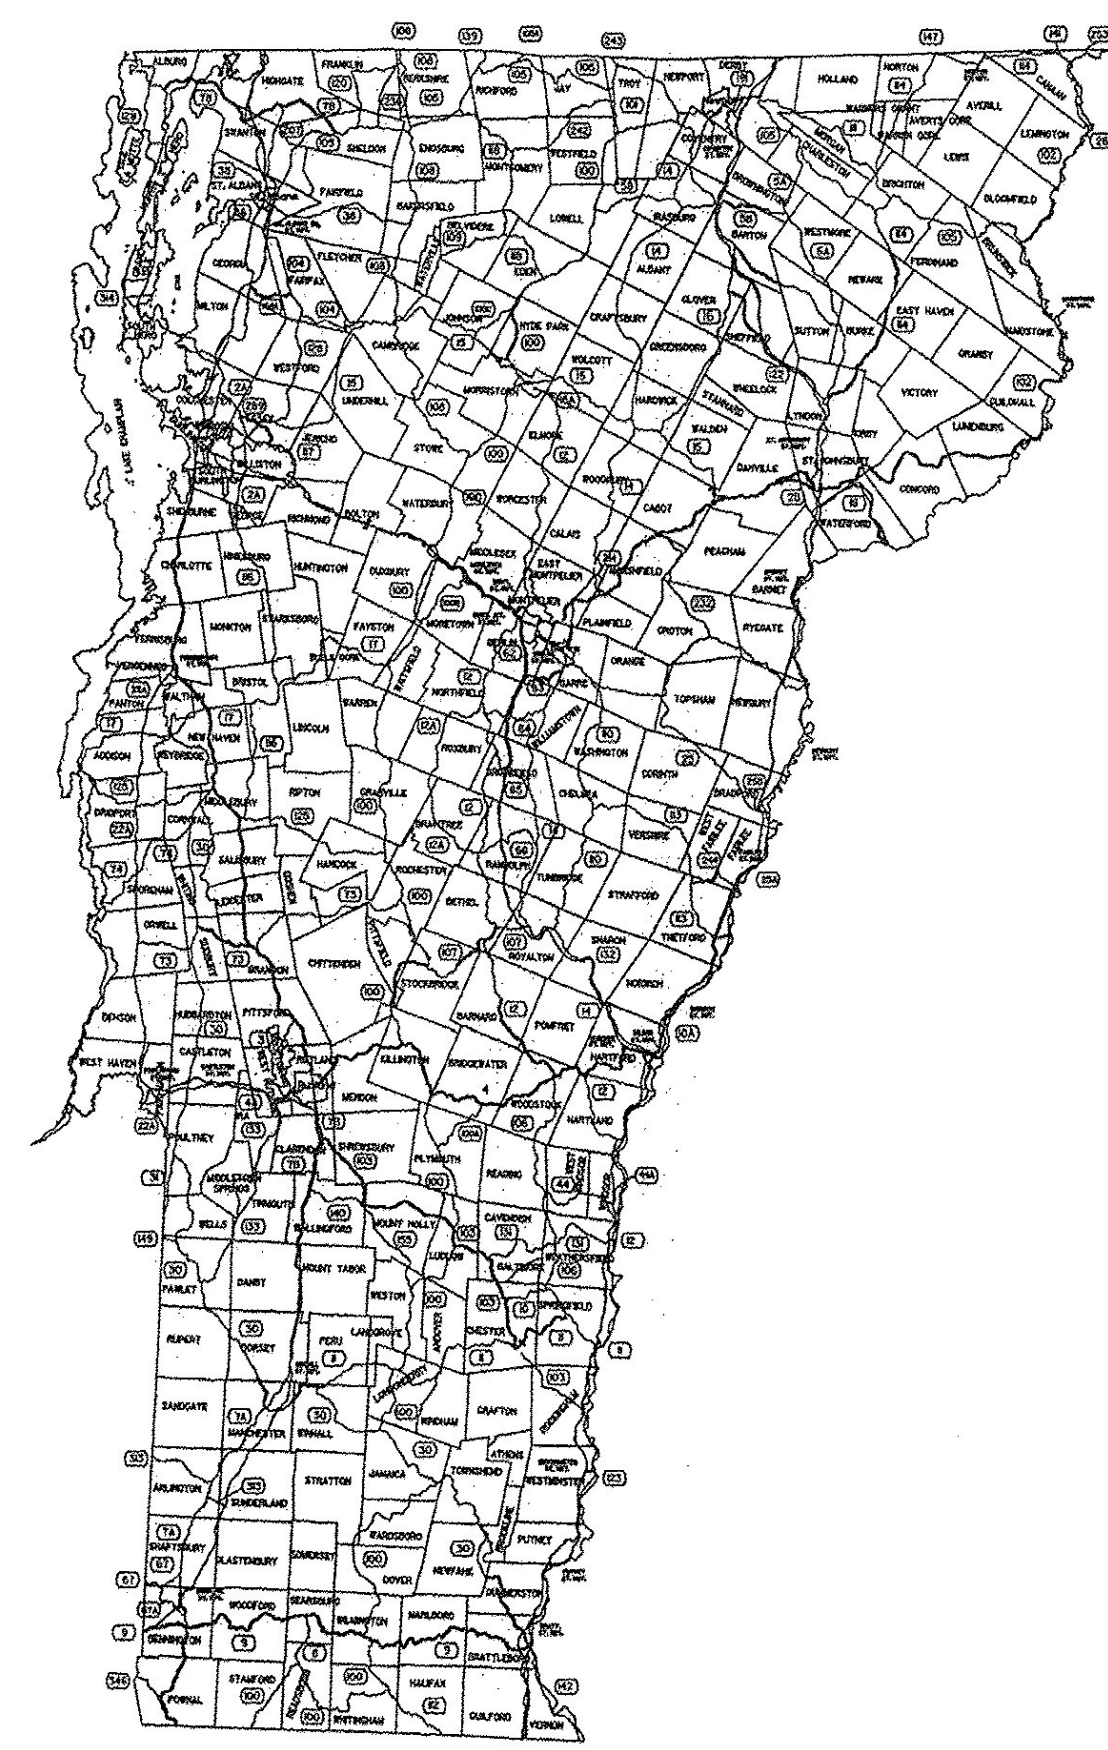

CONSTRUCTION IS TO BE CARRIED ON IN ACCORDANCE WITH THESE PLANS AND THE STANDARD SPECIFICATIONS FOR CONSTRUCTION DATED 2011, AS APPROVED BY THE FEDERAL HIGHWAY ADMINISTRATION ON JULY 20, 2011 FOR USE ON THIS PROJECT, INCLUDING ALL SUBSEQUENT REVISIONS AND SUCH REVISED SPECIFICATIONS AND SPECIAL PROVISIONS AS ARE INCORPORATED IN THESE PLANS.

QUALITY ASSURANCE PROGRAM : LEVEL 3	
SURVEYED BY :	N/A
SURVEYED DATE :	N/A
DATUM	
VERTICAL	N/A
HORIZONTAL	N/A

BUILT AS DESIGNED

DIRECTOR OF PROJECT DELIVERY	
APPROVED	DATE 1/29/2015
PROJECT MANAGER : PATRICIA COBURN, P.E.	
PROJECT NAME : STATEWIDE	
PROJECT NUMBER : HES MARK (404)	
SHEET 1 OF 56 SHEETS	