

TRAFFIC DATA	
QUARRY STREET (TH#6) TRAFFIC DATA	
ADT 2017 =	4000
ADT 2037 =	4200
DHV 2037 =	480
ZD =	65%
ADTT 2037 =	480
% T =	10%
18 KIP ESALS (2017-2037) =	1,812,000
18 KIP ESALS (2017-2057) =	4,040,000
POSTED SPEED =	25 MPH

STATE OF VERMONT
AGENCY OF TRANSPORTATION





PROPOSED IMPROVEMENT
BARRE CITY - BARRE TOWN
COUNTY OF WASHINGTON
QUARRY STREET (TH 6), (MINOR ARTERIAL)

BEGINNING AT A POINT, IN THE CITY OF BARRE, OFF VERMONT ROUTE 14 AT MM 0.29, (THE INTERSECTION OF VT ROUTE 14 AND QUARRY STREET - TH#6) APPROXIMATELY 73 FEET EASTERLY ALONG QUARRY STREET, AND EXTENDING EASTERLY FOR APPROXIMATELY 886 FEET (0.168 MILES) ALONG QUARRY STREET AND ENDING APPROXIMATELY 43 FEET EASTERLY OF HALE STREET.

WORK TO BE PERFORMED UNDER THIS PROJECT INCLUDES EXCAVATION, CLEARING AND GRUBBING ALONG THE SOUTHERLY SIDE OF QUARRY STREET, CONSTRUCTION OF PRECAST RETAINING WALL AND OTHER HIGHWAY RELATED ITEMS.

LENGTH OF PROJECT = 886.00 FT = 0.168 MILES

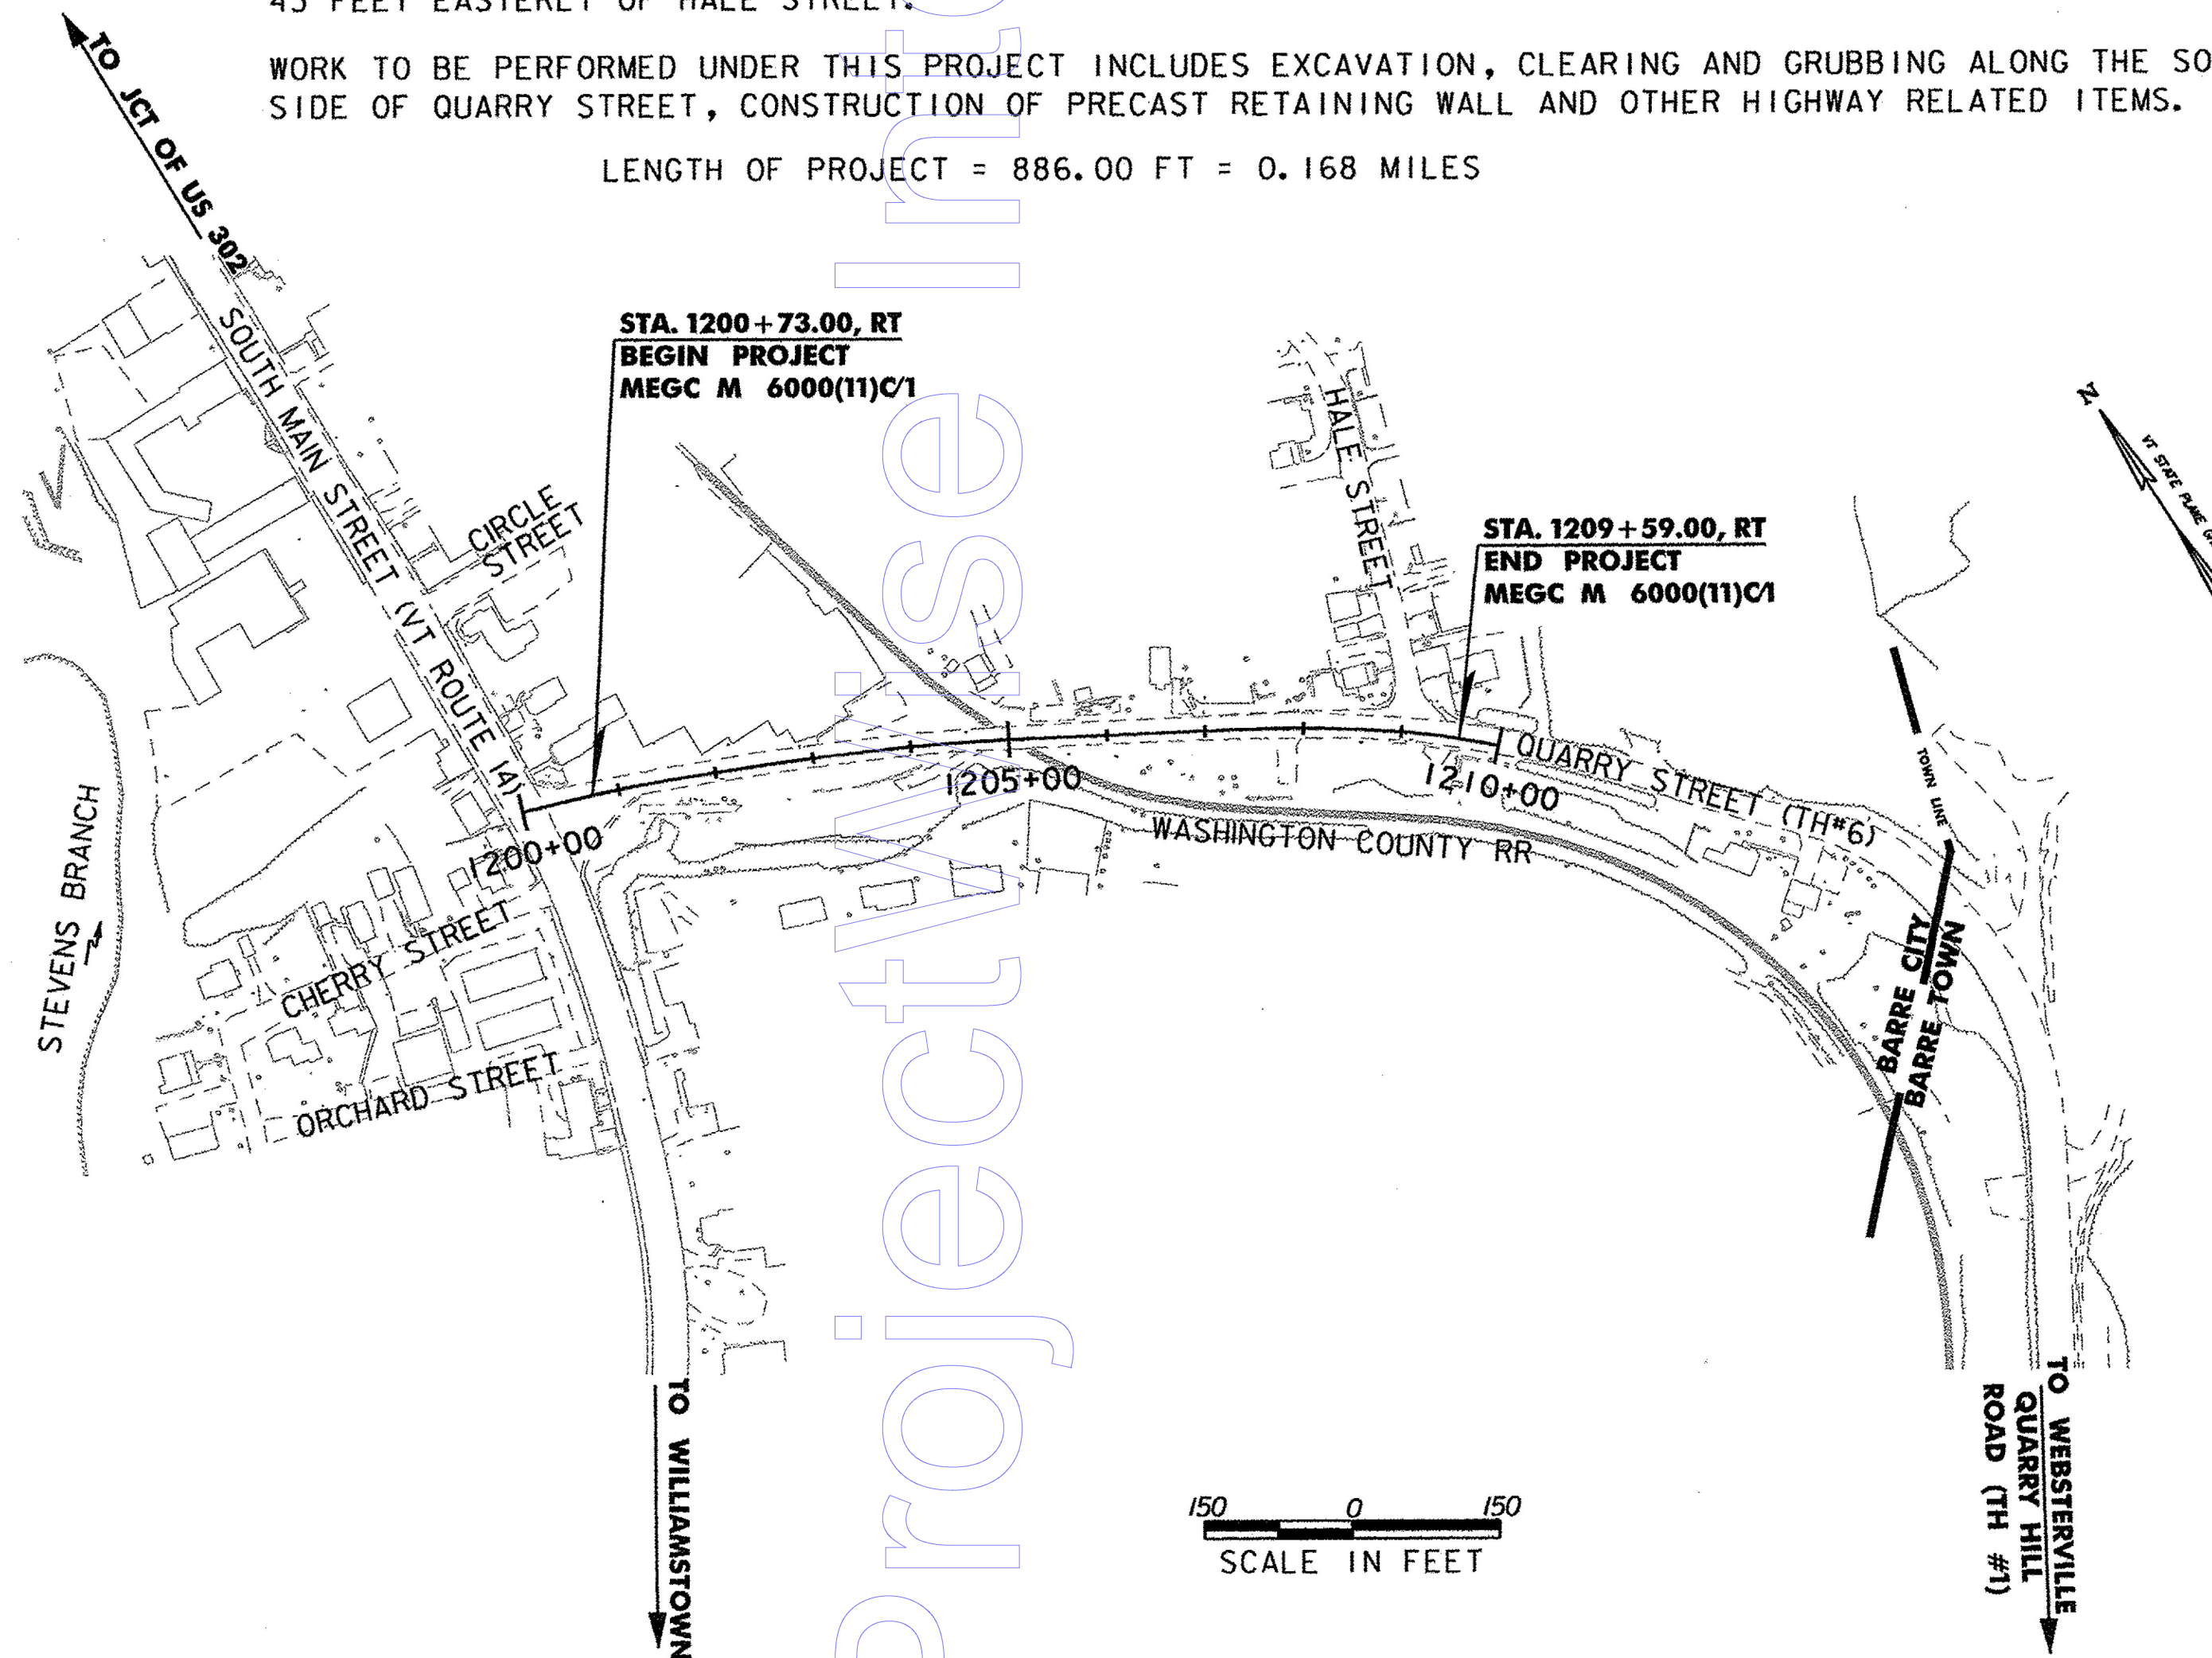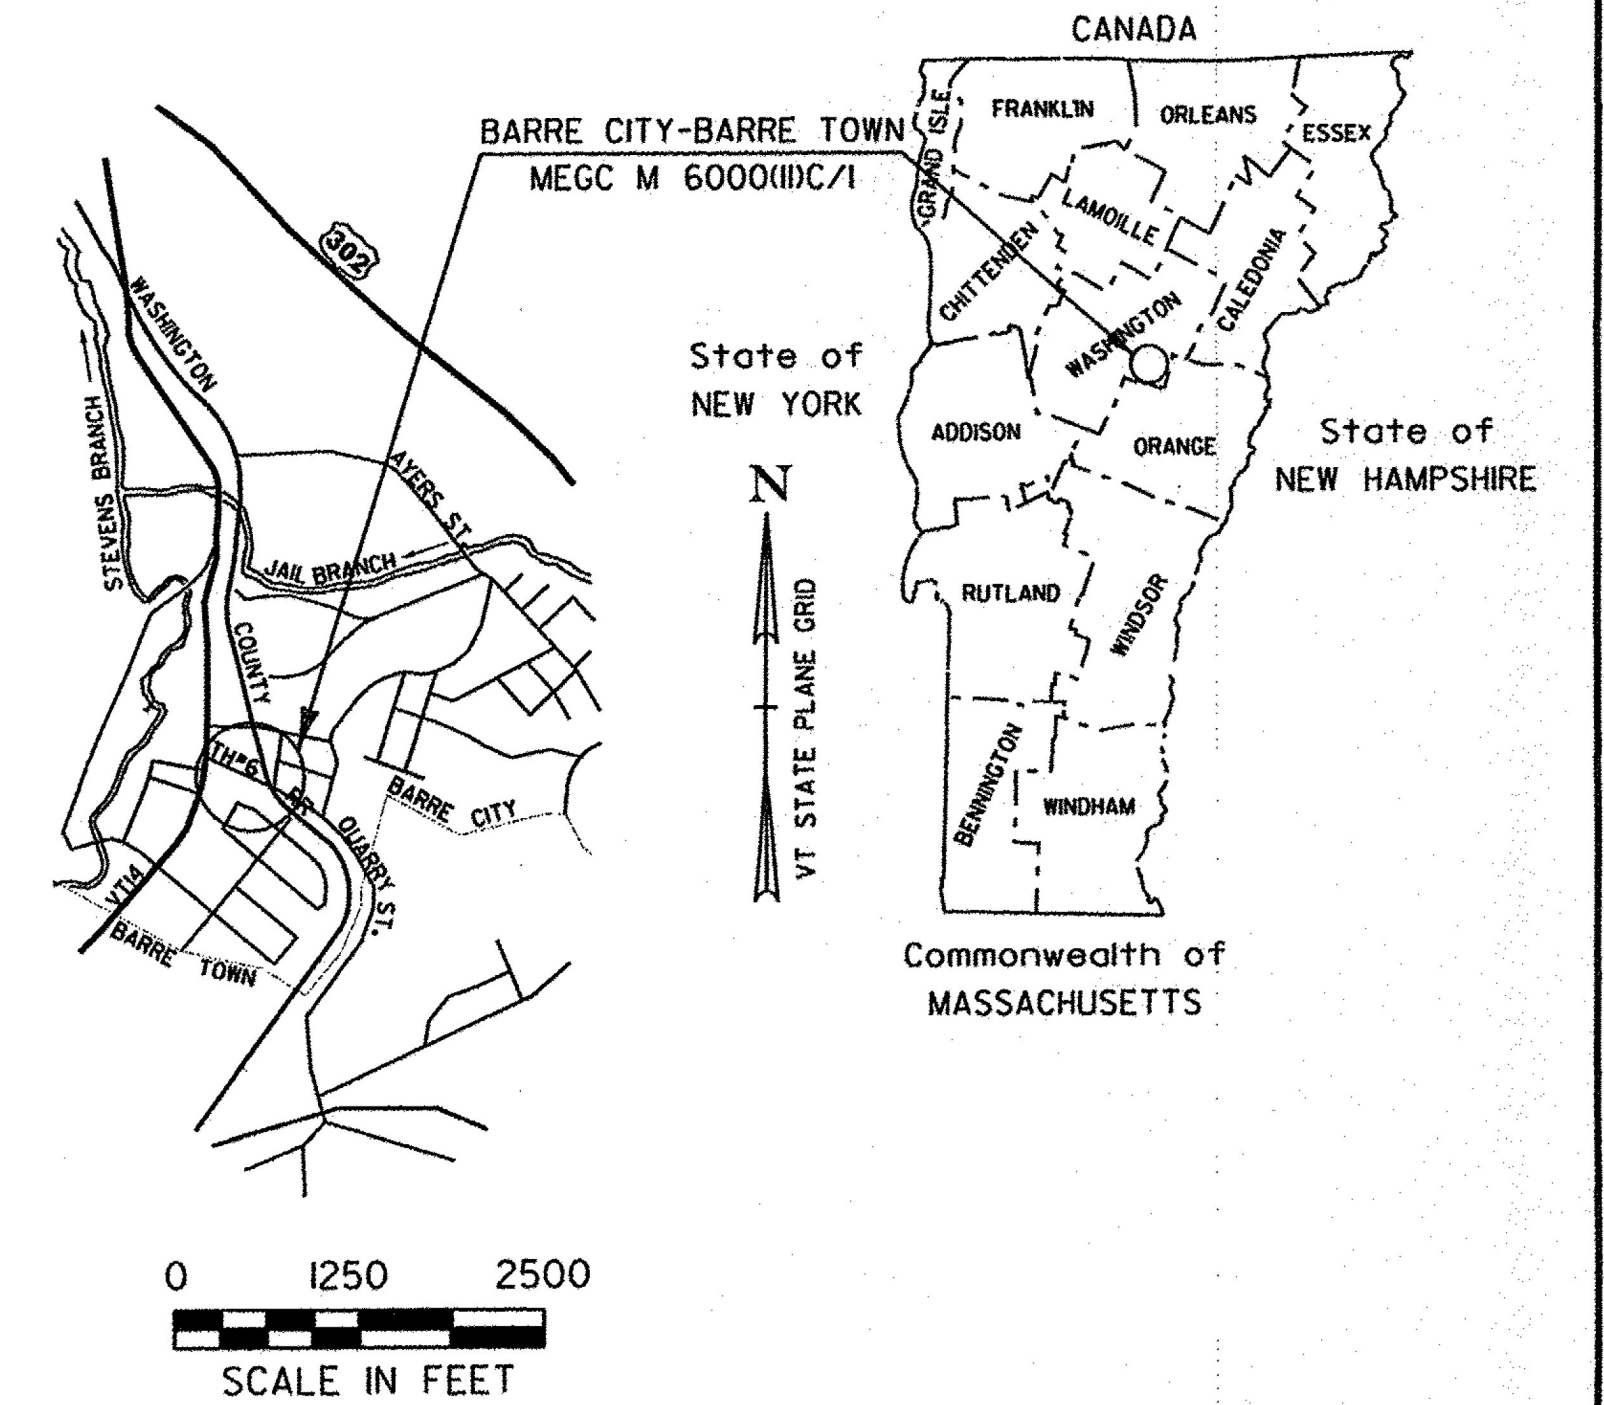

RECORD PLANS	
CONTRACTOR:	B.U.R. CONSTRUCTION, LLC, CLAREMONT, NH
RESIDENT ENGINEER:	PETE HODGSON
CONSTRUCTION BEGAN:	APRIL 18, 2017
CONSTRUCTION COMPLETE:	AUGUST 02, 2017
RECORD PLANS BY:	PETE HODGSON & JESSE IVES
I HEREBY CERTIFY THAT ALL THE CONSTRUCTION REQUIRED BY THIS SET OF DRAWINGS HAS BEEN ACCOMPLISHED AS INDICATED HEREIN.	
BY:	<i>Pete Hodgson</i> RESIDENT ENGINEER
DATE:	10/31/18
NOTE: Any further information concerning final quantities, amounts or other details relative to this project may be found at Central Files in the electronic archives.	

CONSTRUCTION IS TO BE CARRIED ON IN ACCORDANCE WITH THESE PLANS AND THE STANDARD SPECIFICATIONS FOR CONSTRUCTION DATED 2011, AS APPROVED BY THE FEDERAL HIGHWAY ADMINISTRATION ON JULY 20, 2011 FOR USE ON THIS PROJECT, INCLUDING ALL SUBSEQUENT REVISIONS AND SUCH REVISED SPECIFICATIONS AND SPECIAL PROVISIONS AS ARE INCORPORATED IN THESE PLANS.

QUALITY ASSURANCE PROGRAM : LEVEL 2
SURVEYED BY : VTrans
SURVEYED DATE : 12/2013
DATUM
VERTICAL: NAVD 1929
HORIZONTAL: NAD 1983

DIRECTOR OF PROJECT DELIVERY
APPROVED <i>[Signature]</i> DATE 11/8/2016
PROJECT MANAGER : ERIN LEWIS, PE
PROJECT NAME : BARRE CITY - BARRE TOWN
PROJECT NUMBER : MEGC M 6000(11)C/1
SHEET 1 OF 40 SHEETS



The following product(s) are not activated:

Projectwise Inc. Server