

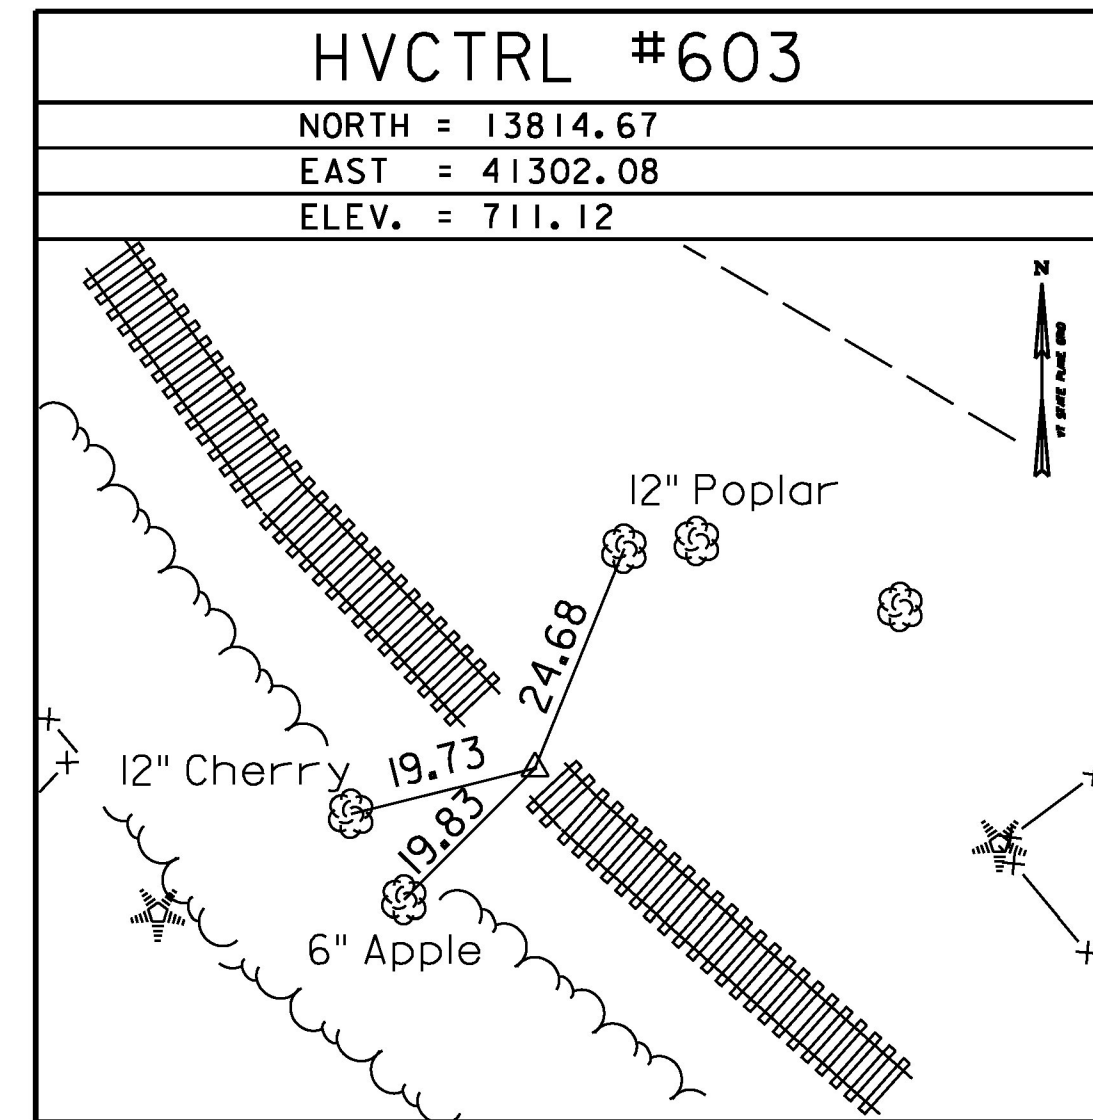
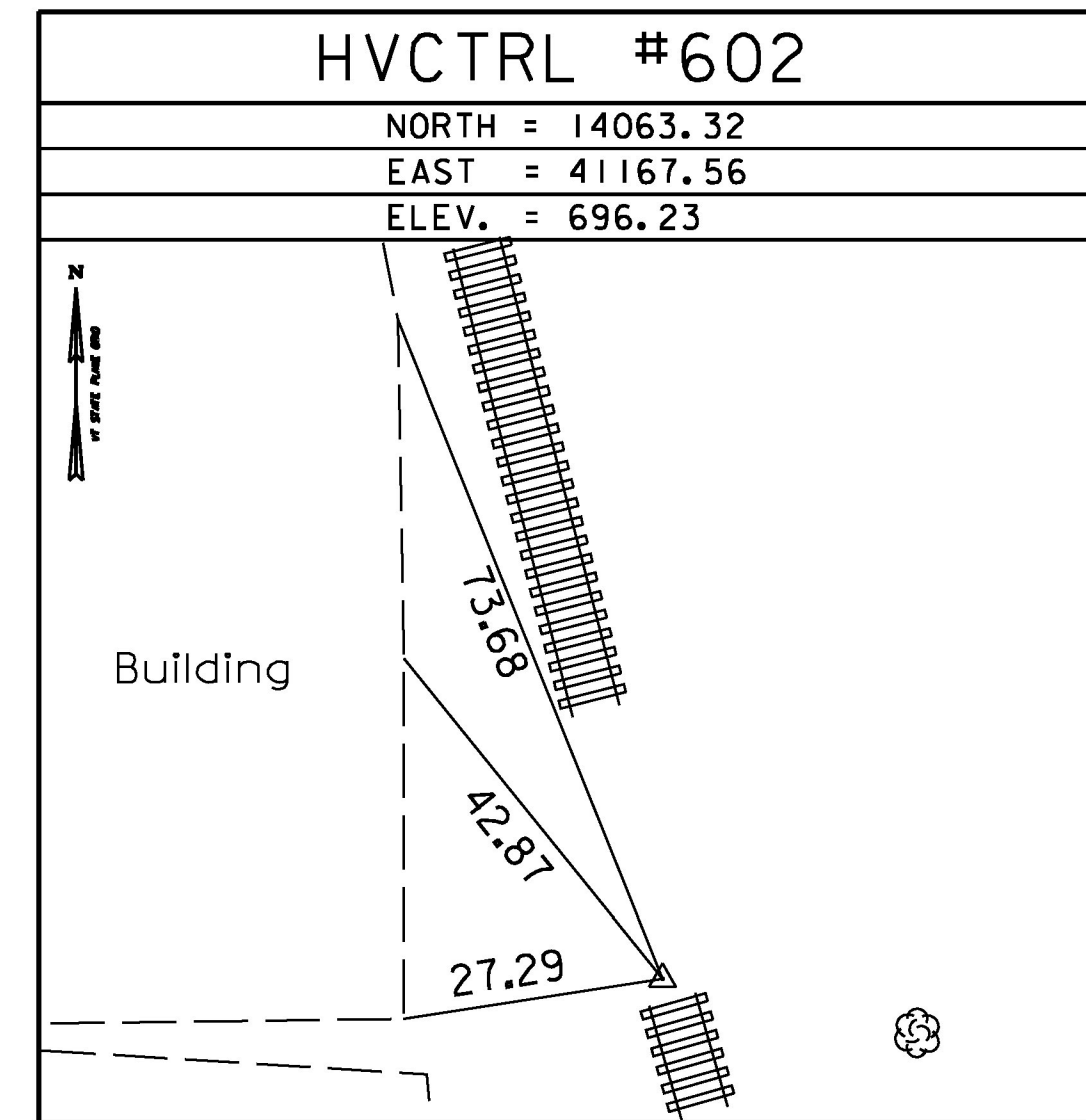
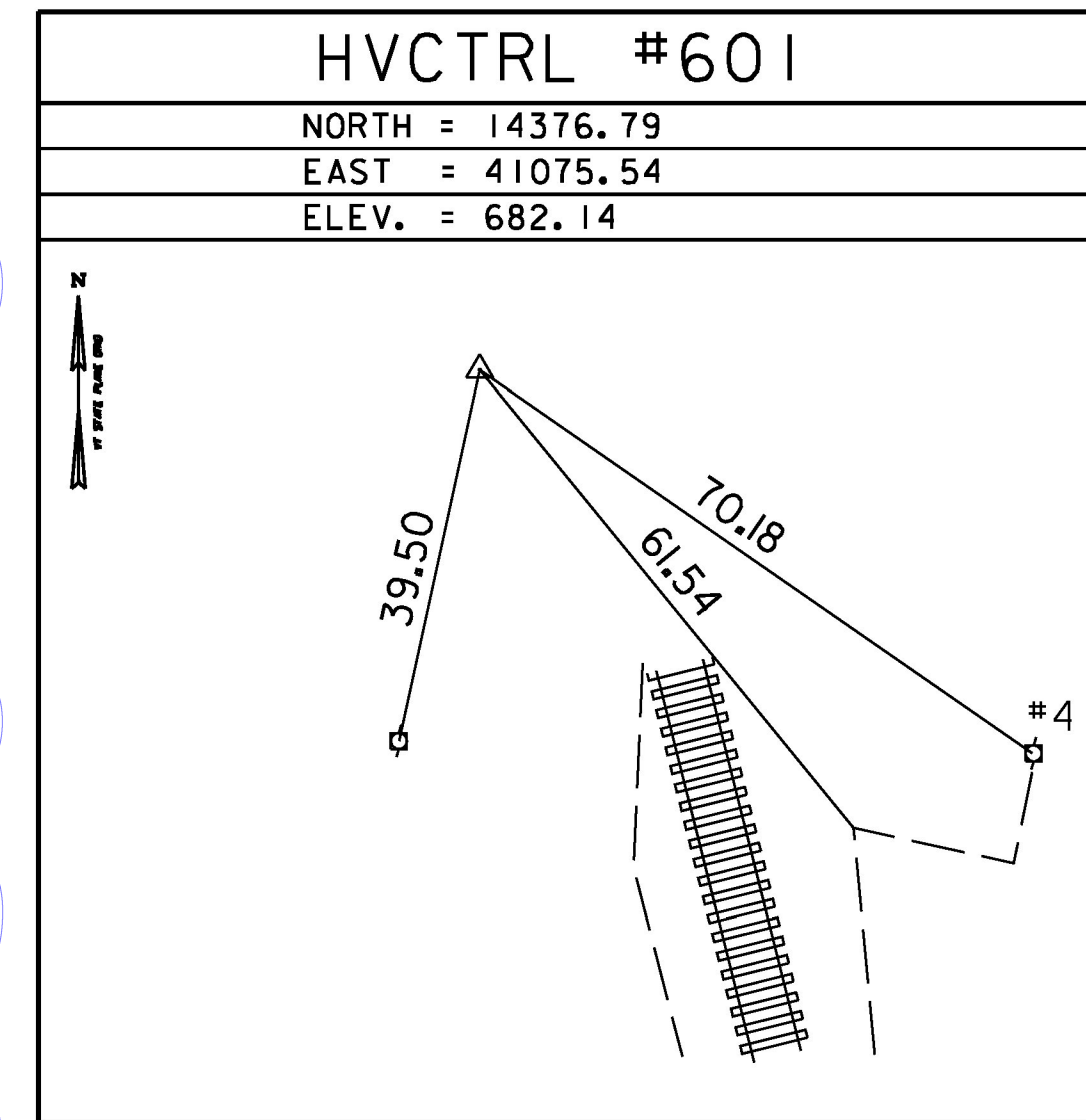
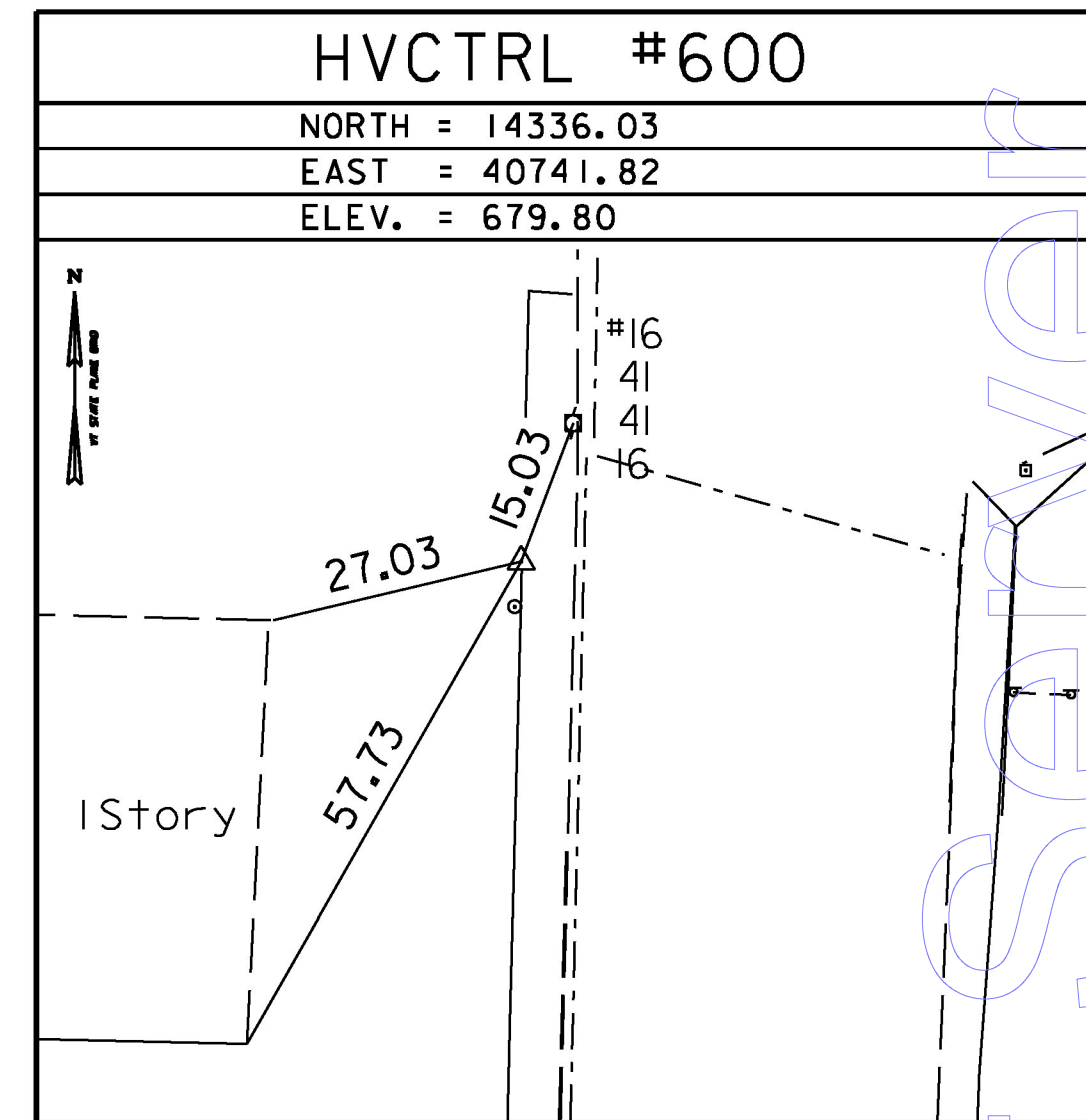
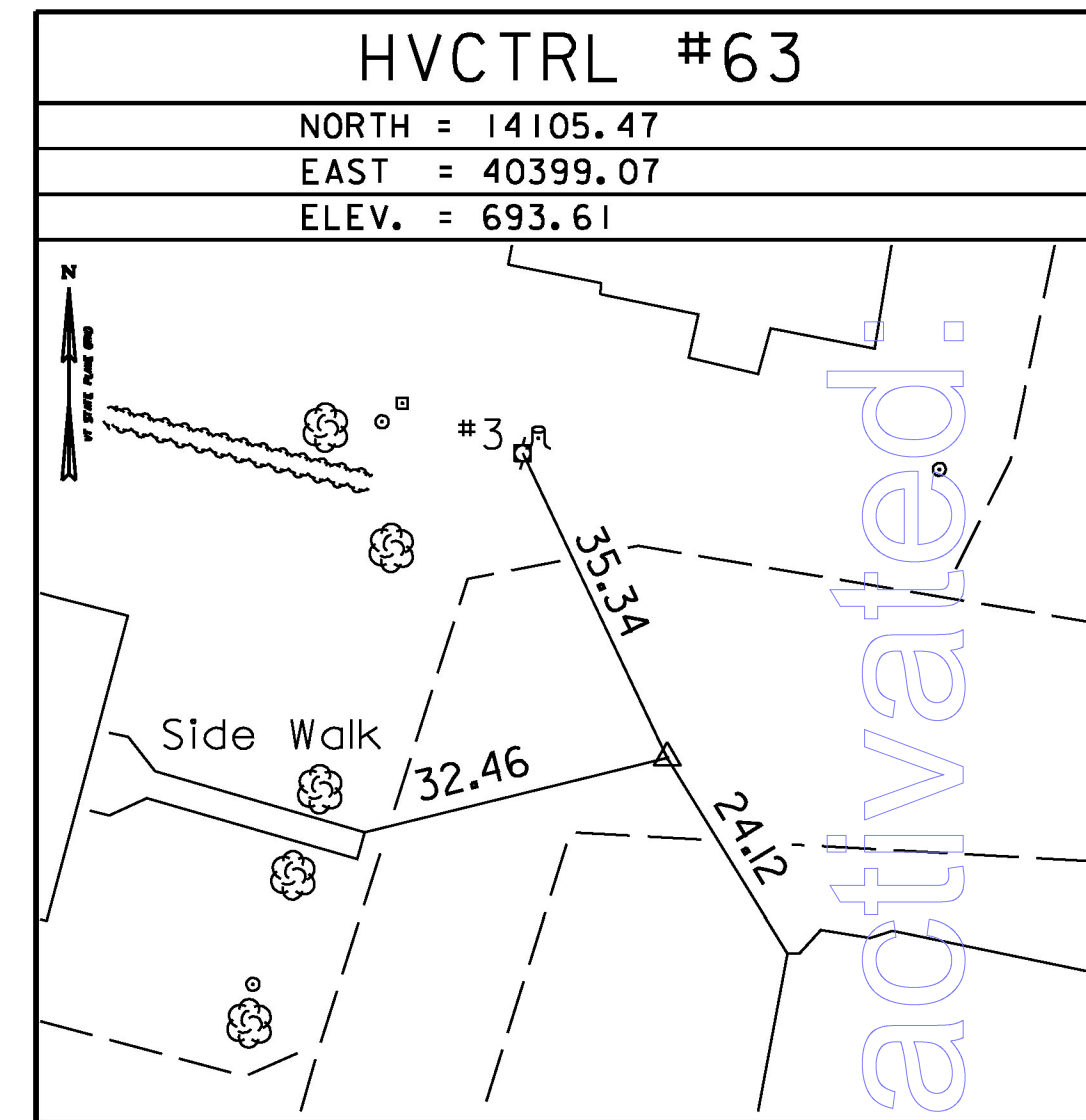
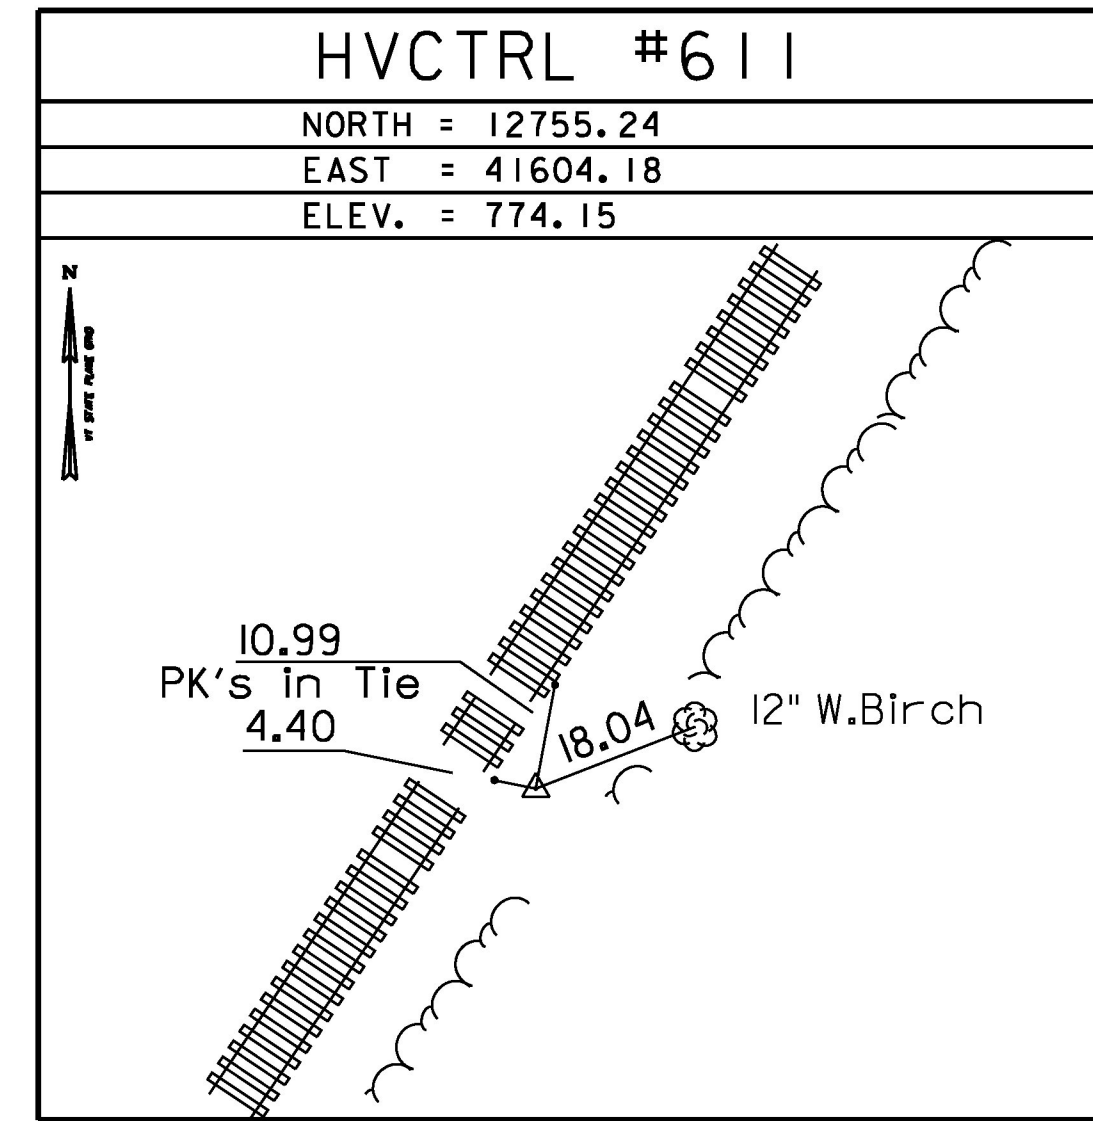
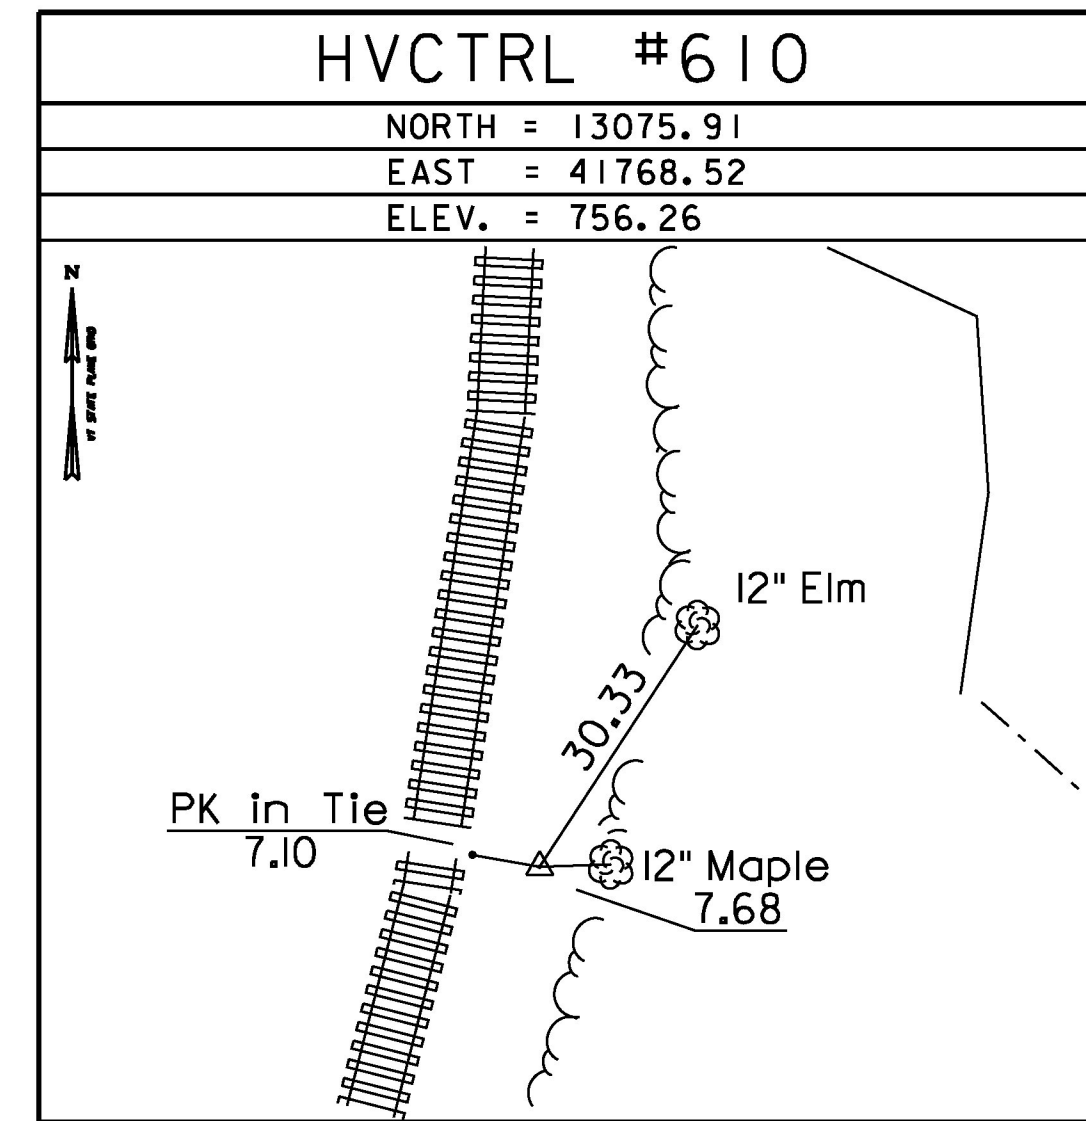
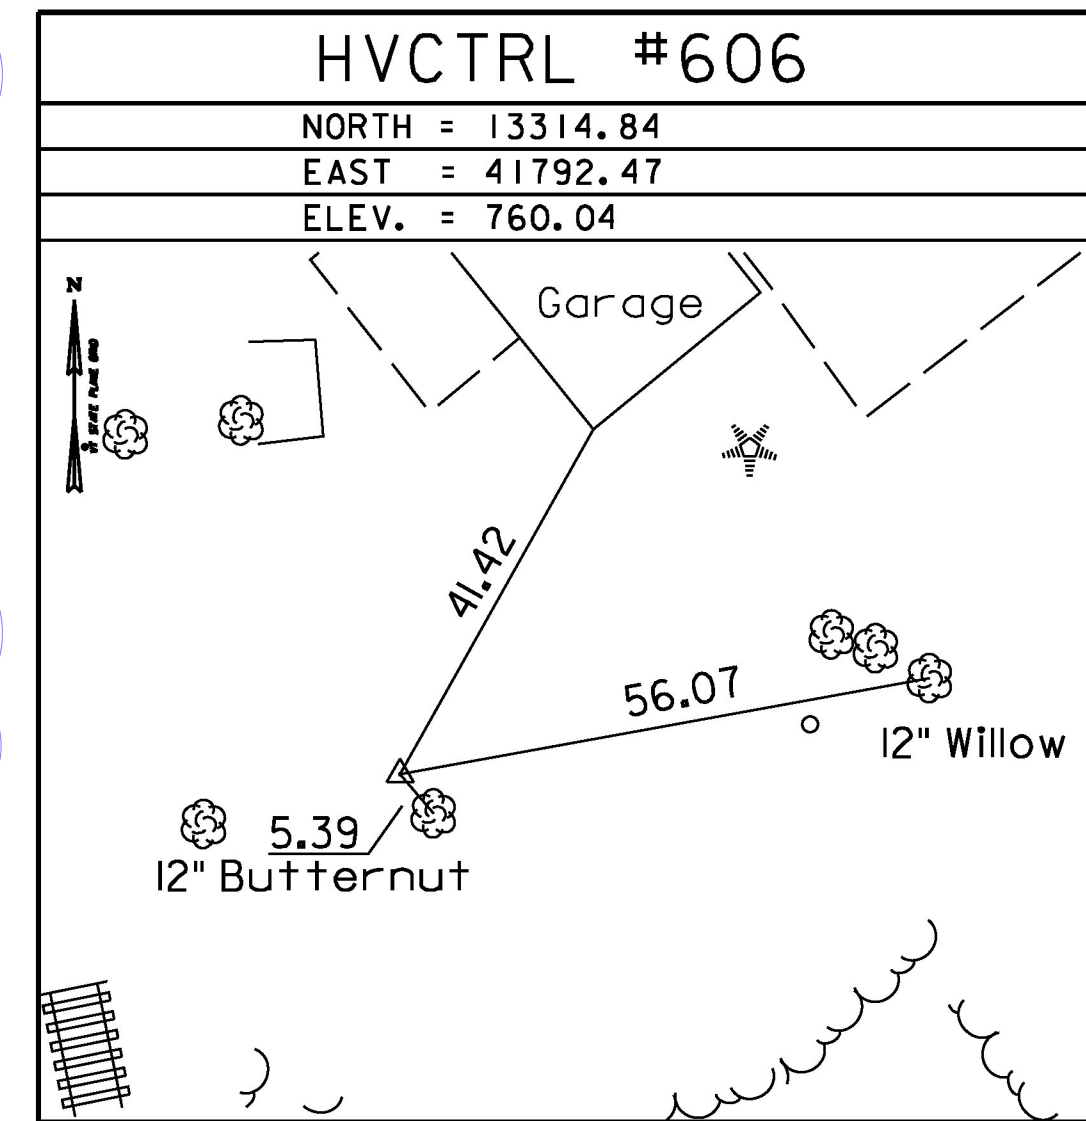







TRAVERSE TIES

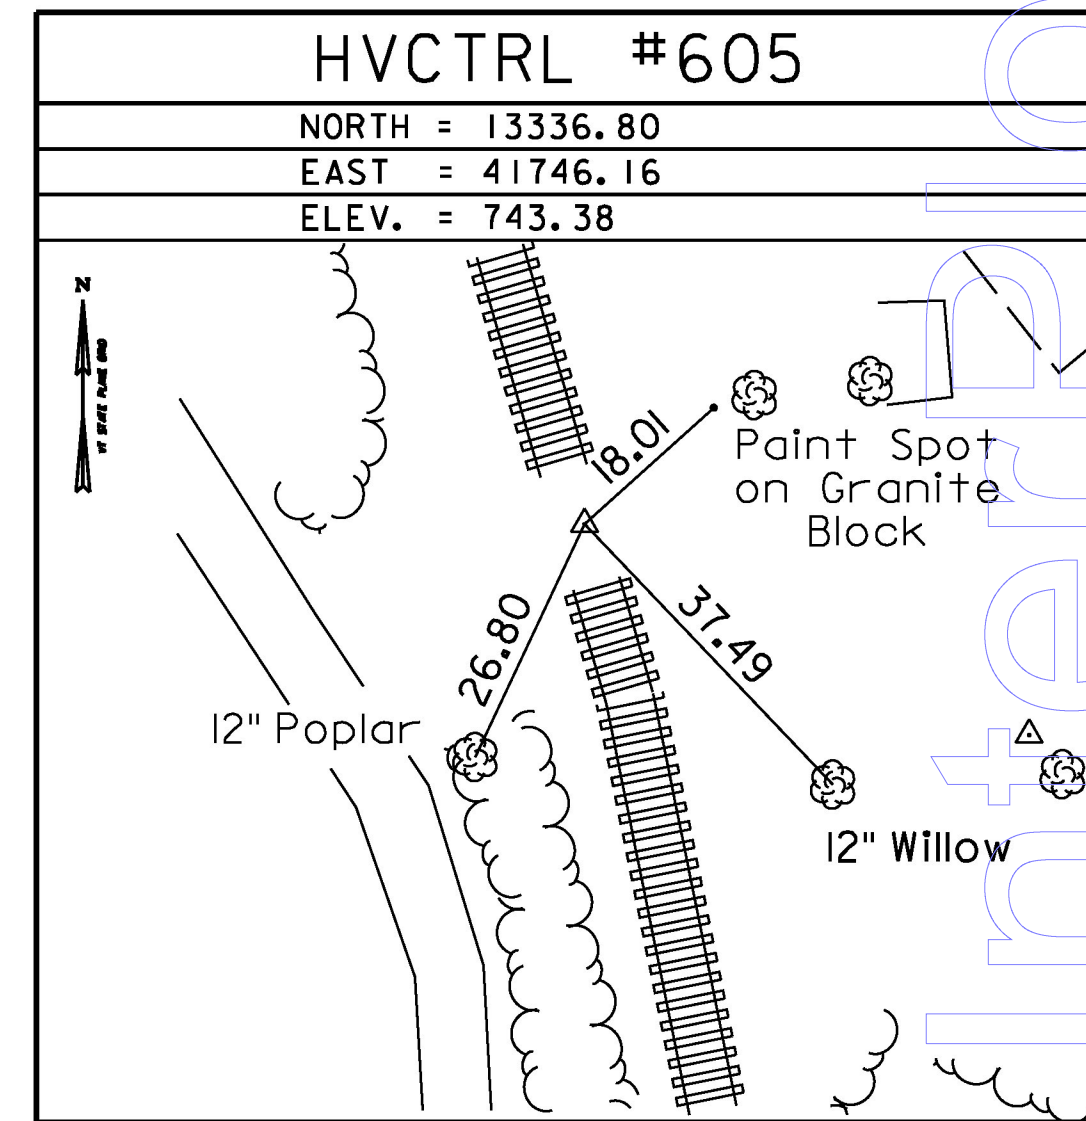

TRAVERSE TIES

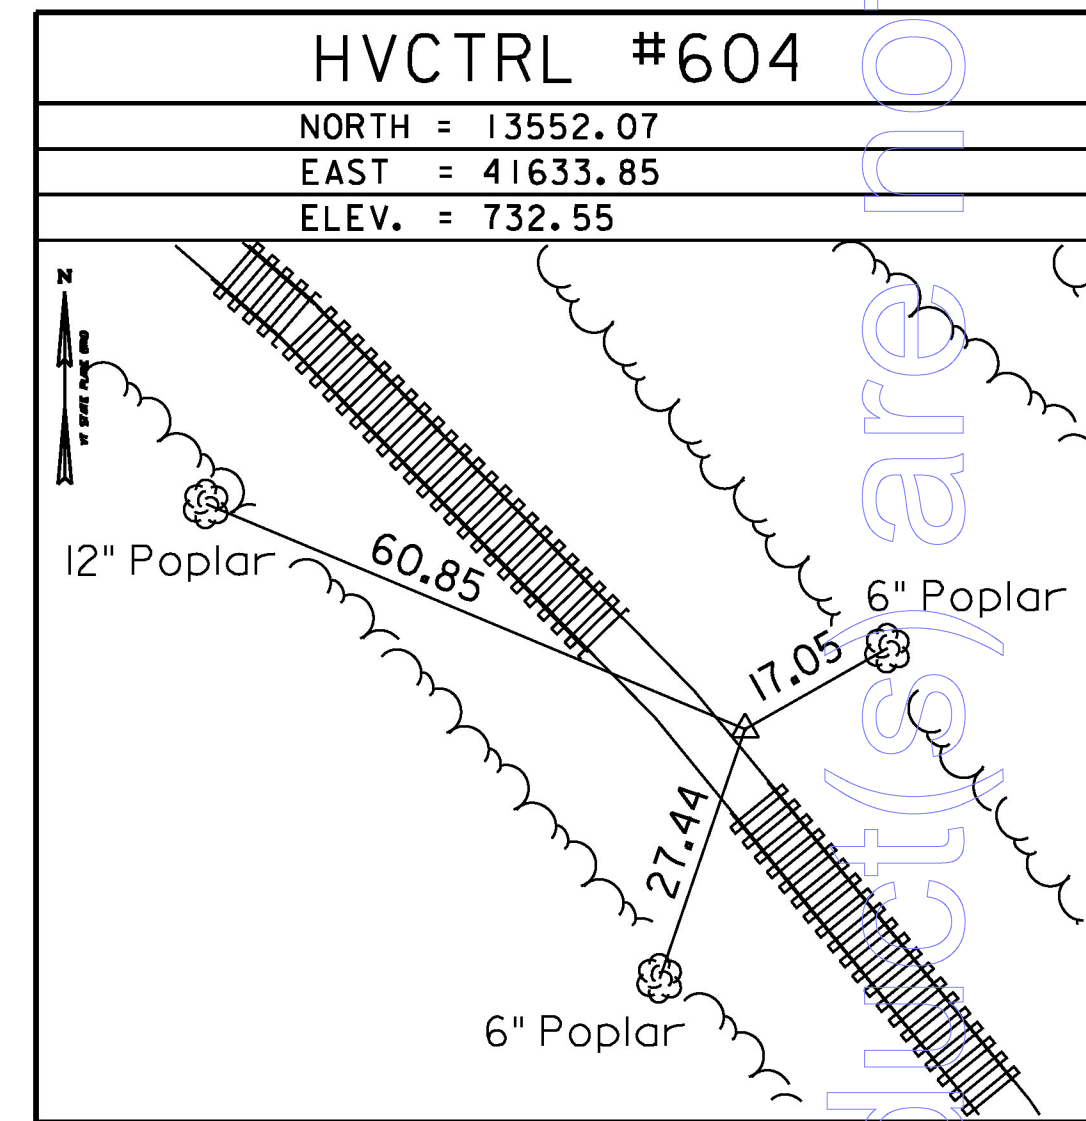

TRAVERSE TIES

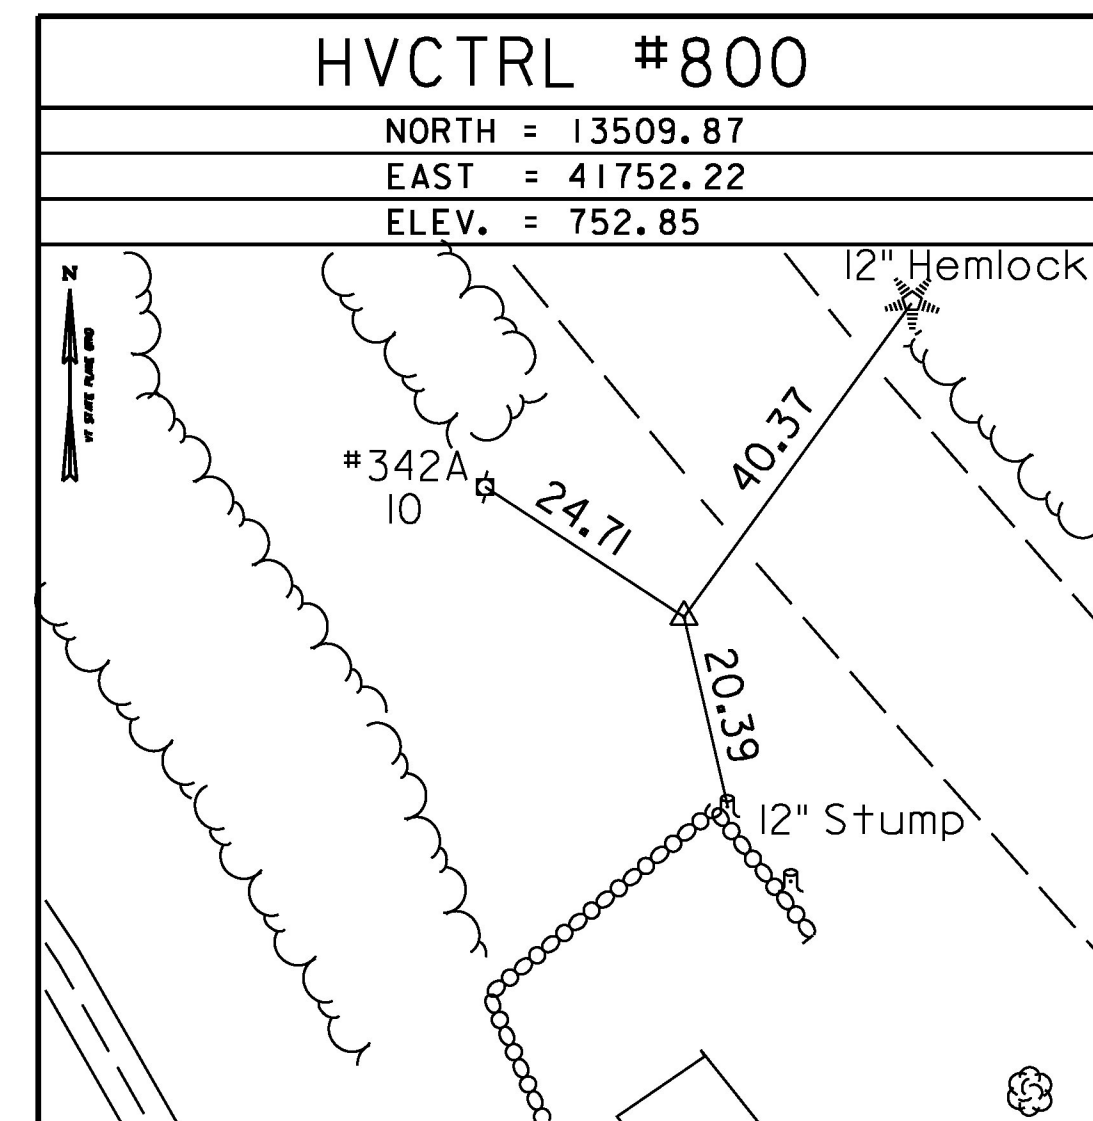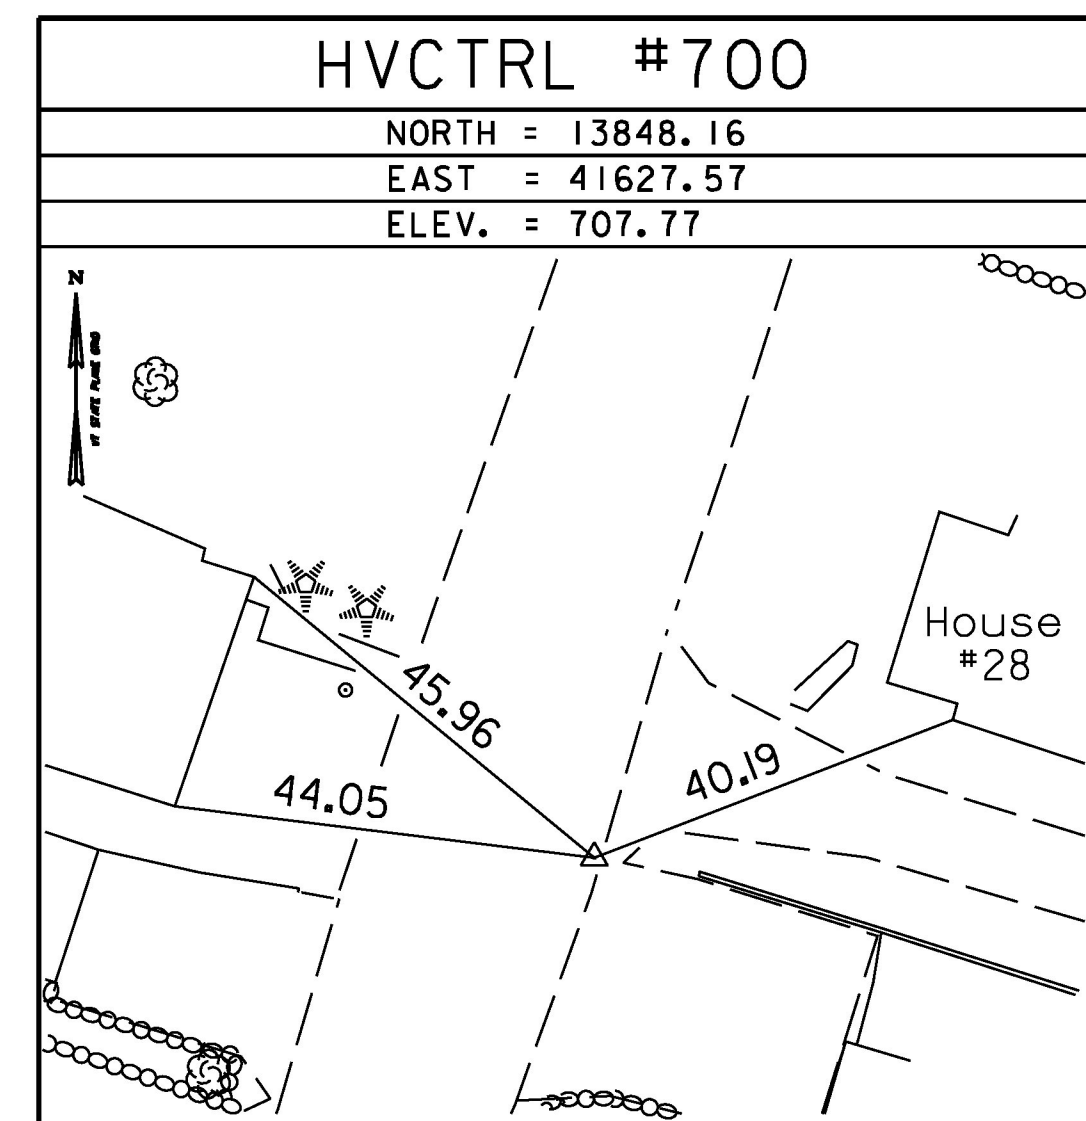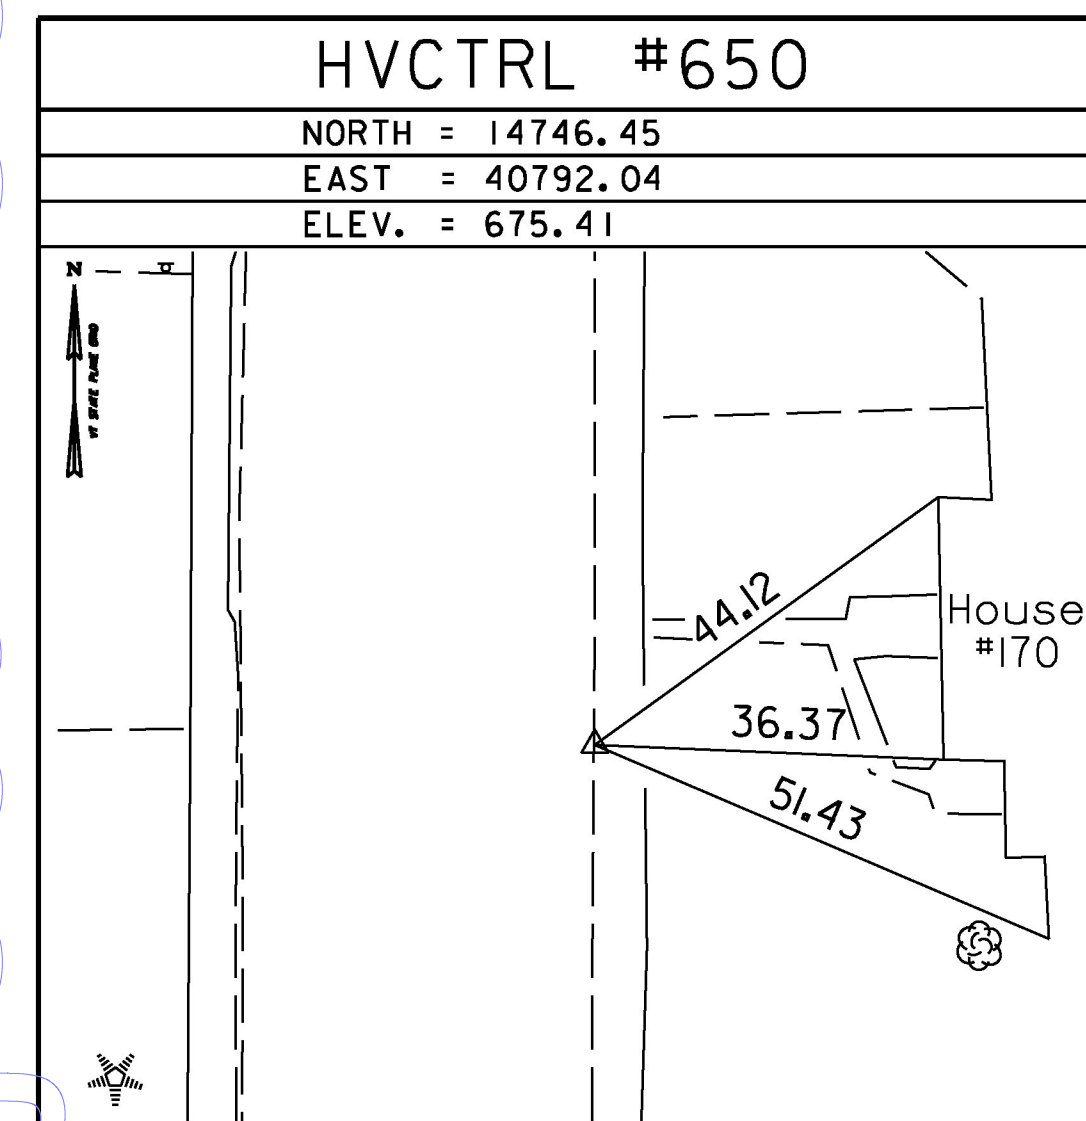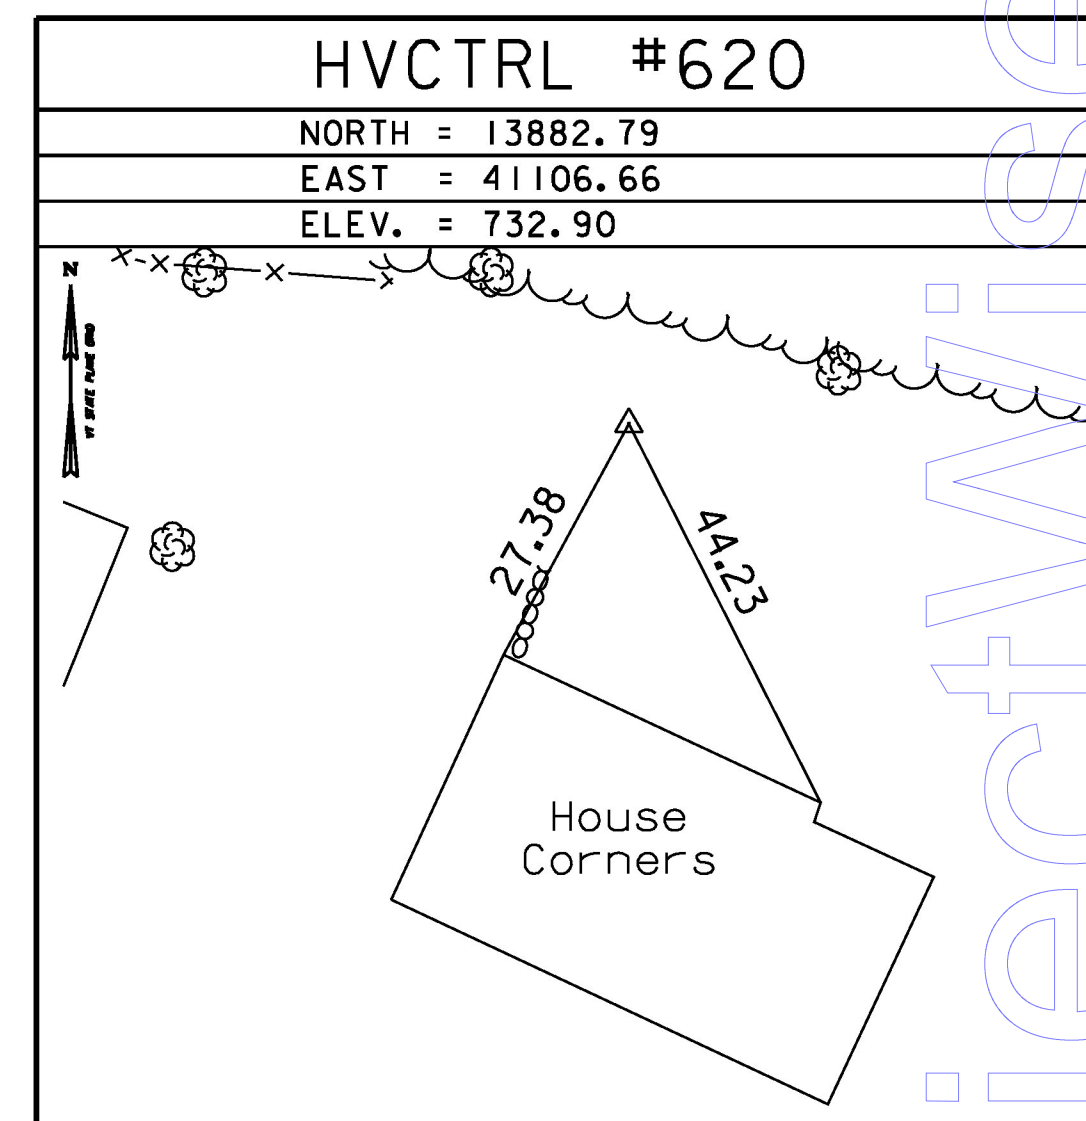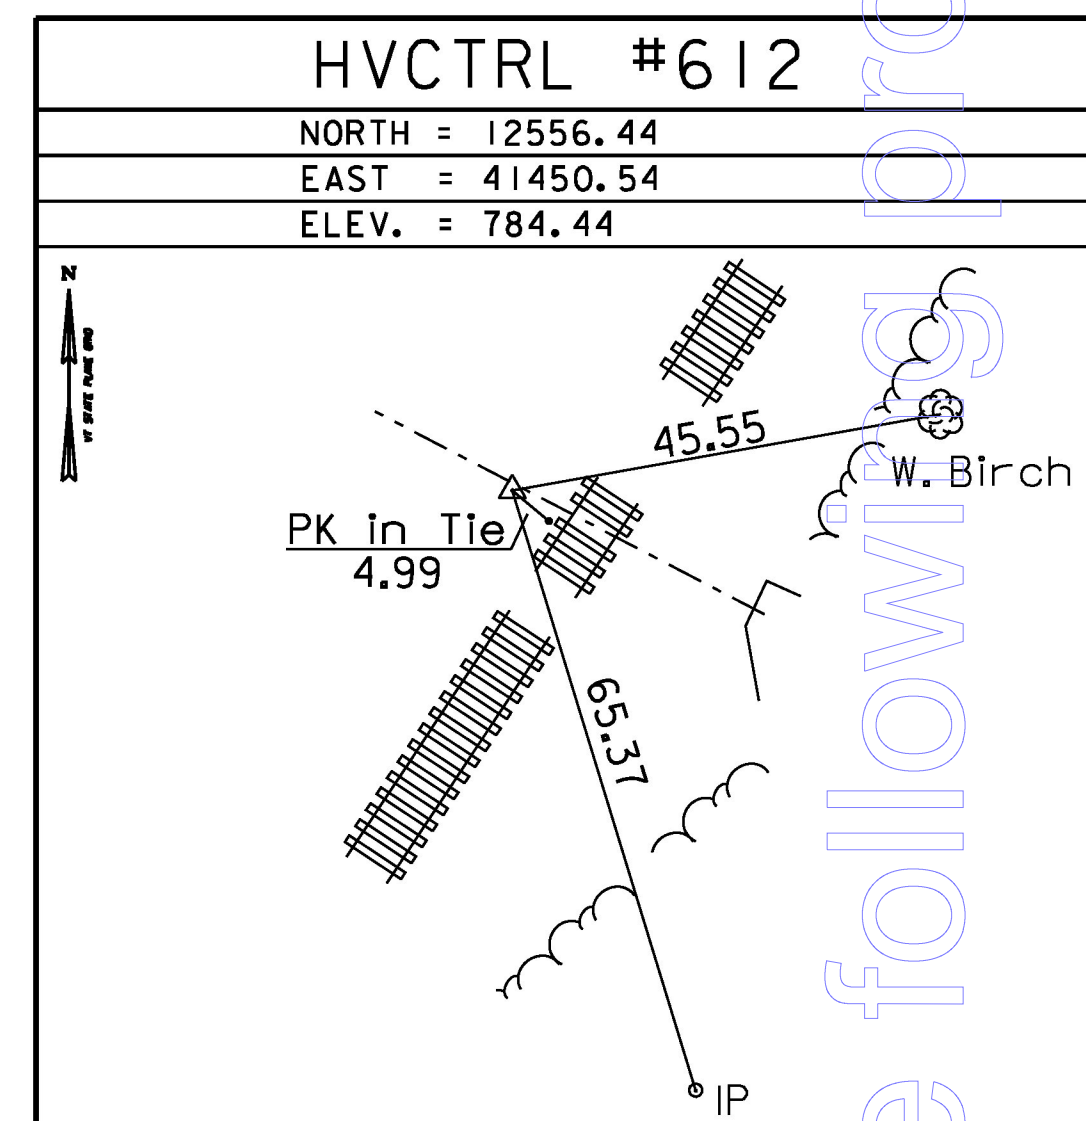

DATUM

VERTICAL	NAVD 1929
HORIZONTAL	NAD 1983
ADJUSTMENT	Compass



PROJECT NAME: BARRE CITY - BARRE TOWN
 PROJECT NUMBER: MEGC M 6000(II)C/1
 FILE NAME: z15d040.tie.dgn
 PROJECT LEADER: A.P. GUYETTE
 DESIGNED BY: D.M. PECK
 TIE SHEET (2 of 2)

PLOT DATE: 12/2/2016
 DRAWN BY: P.A. MILLER
 CHECKED BY: D.M. PECK
 SHEET 7 OF 39