



The following product(s) are not activated:


ProjectWise InterPlot Server

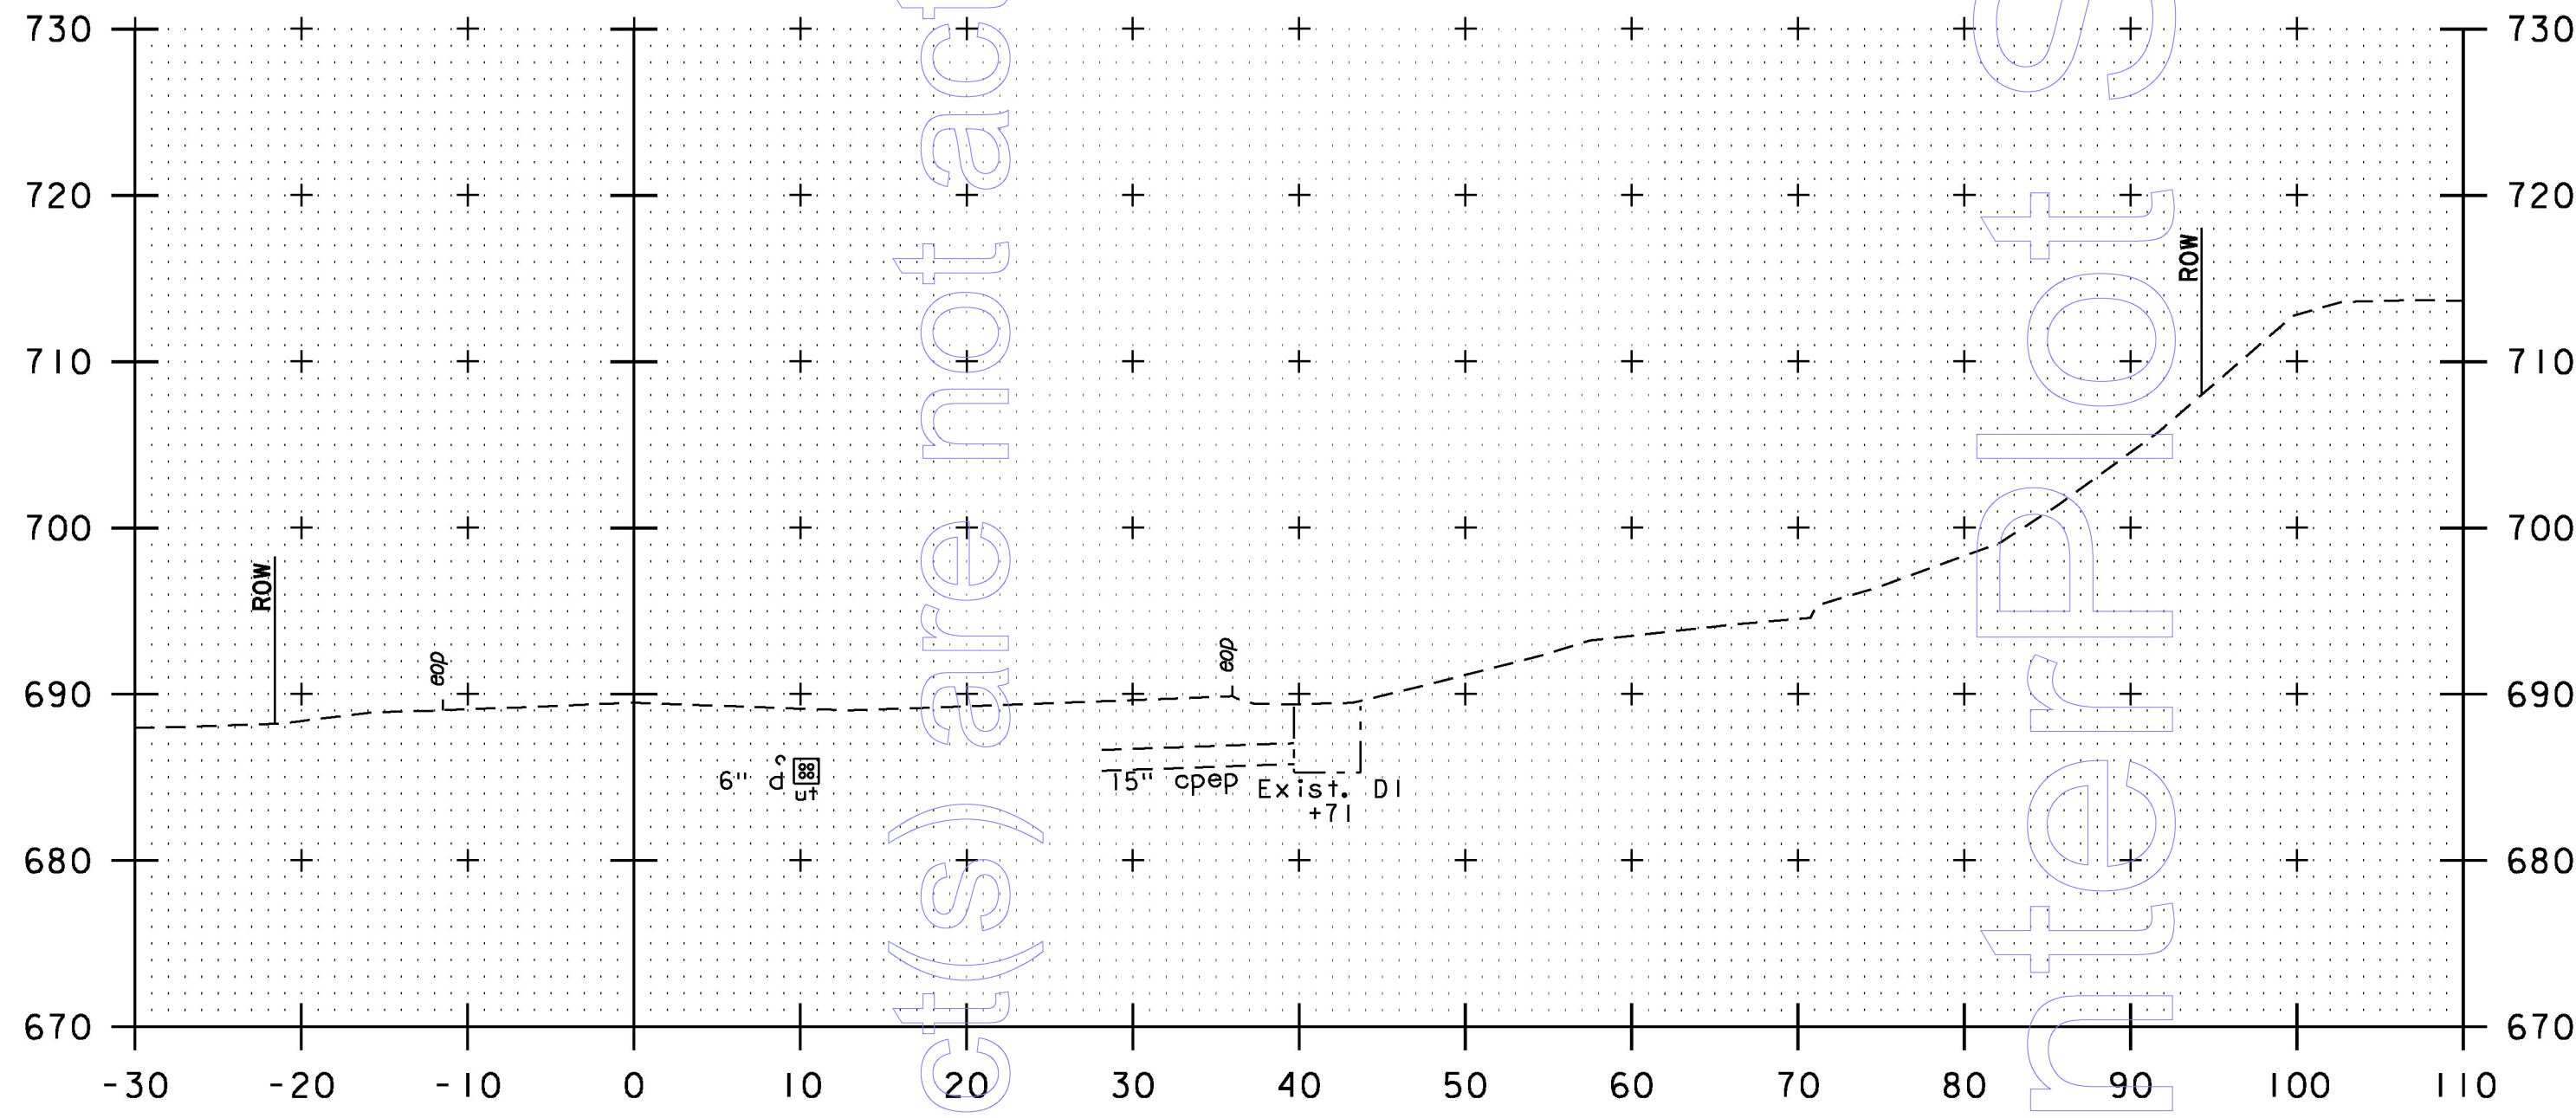


1200+75
 STA. 1200+73, RT
 BEGIN PROJECT
 MEGC M 6000 (1) C/1

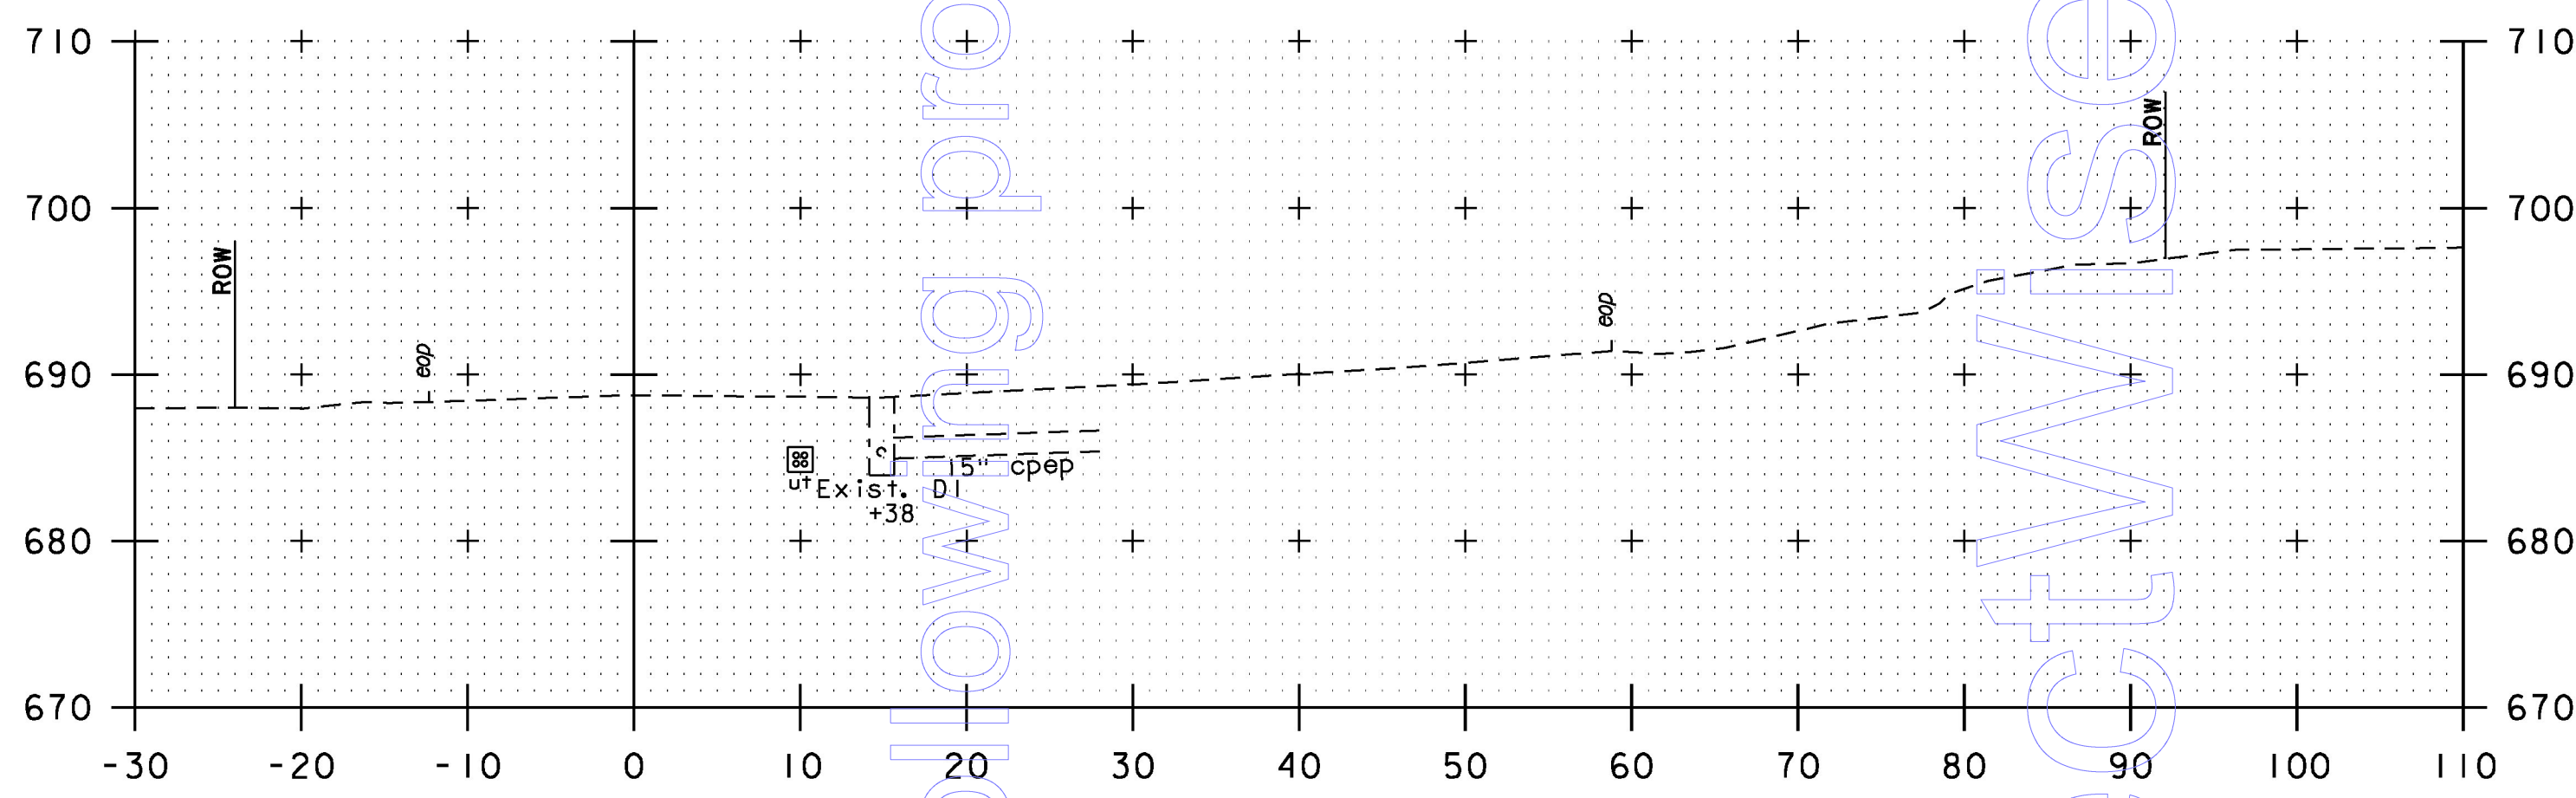

1200+50

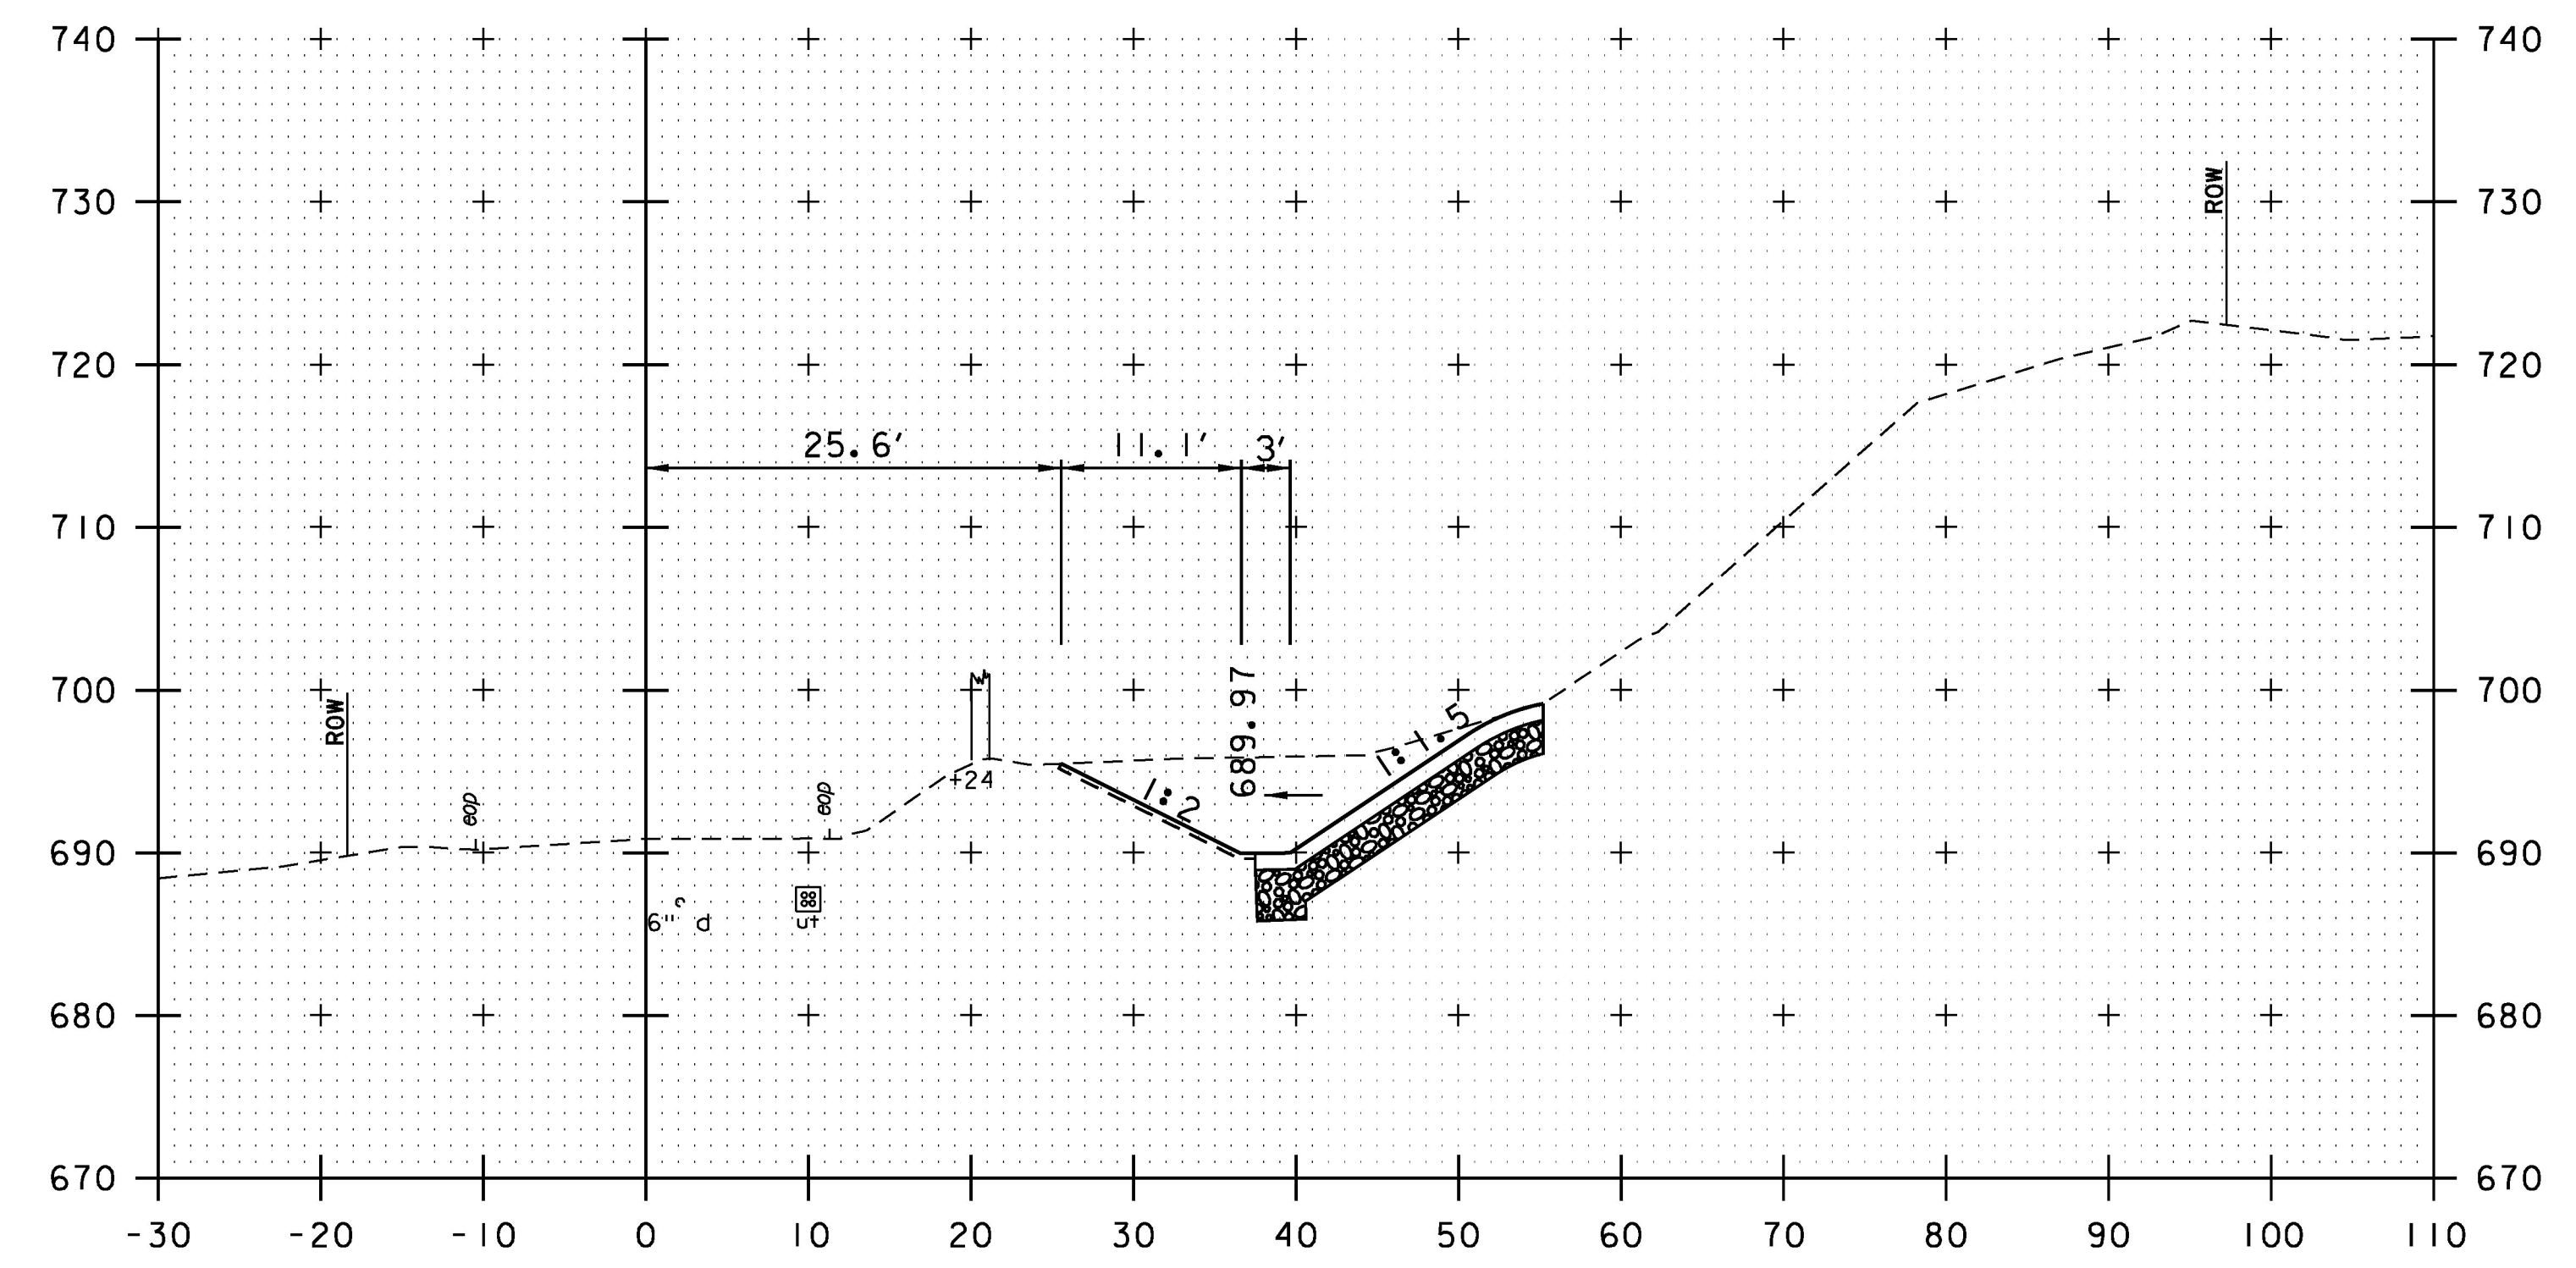

1201+25

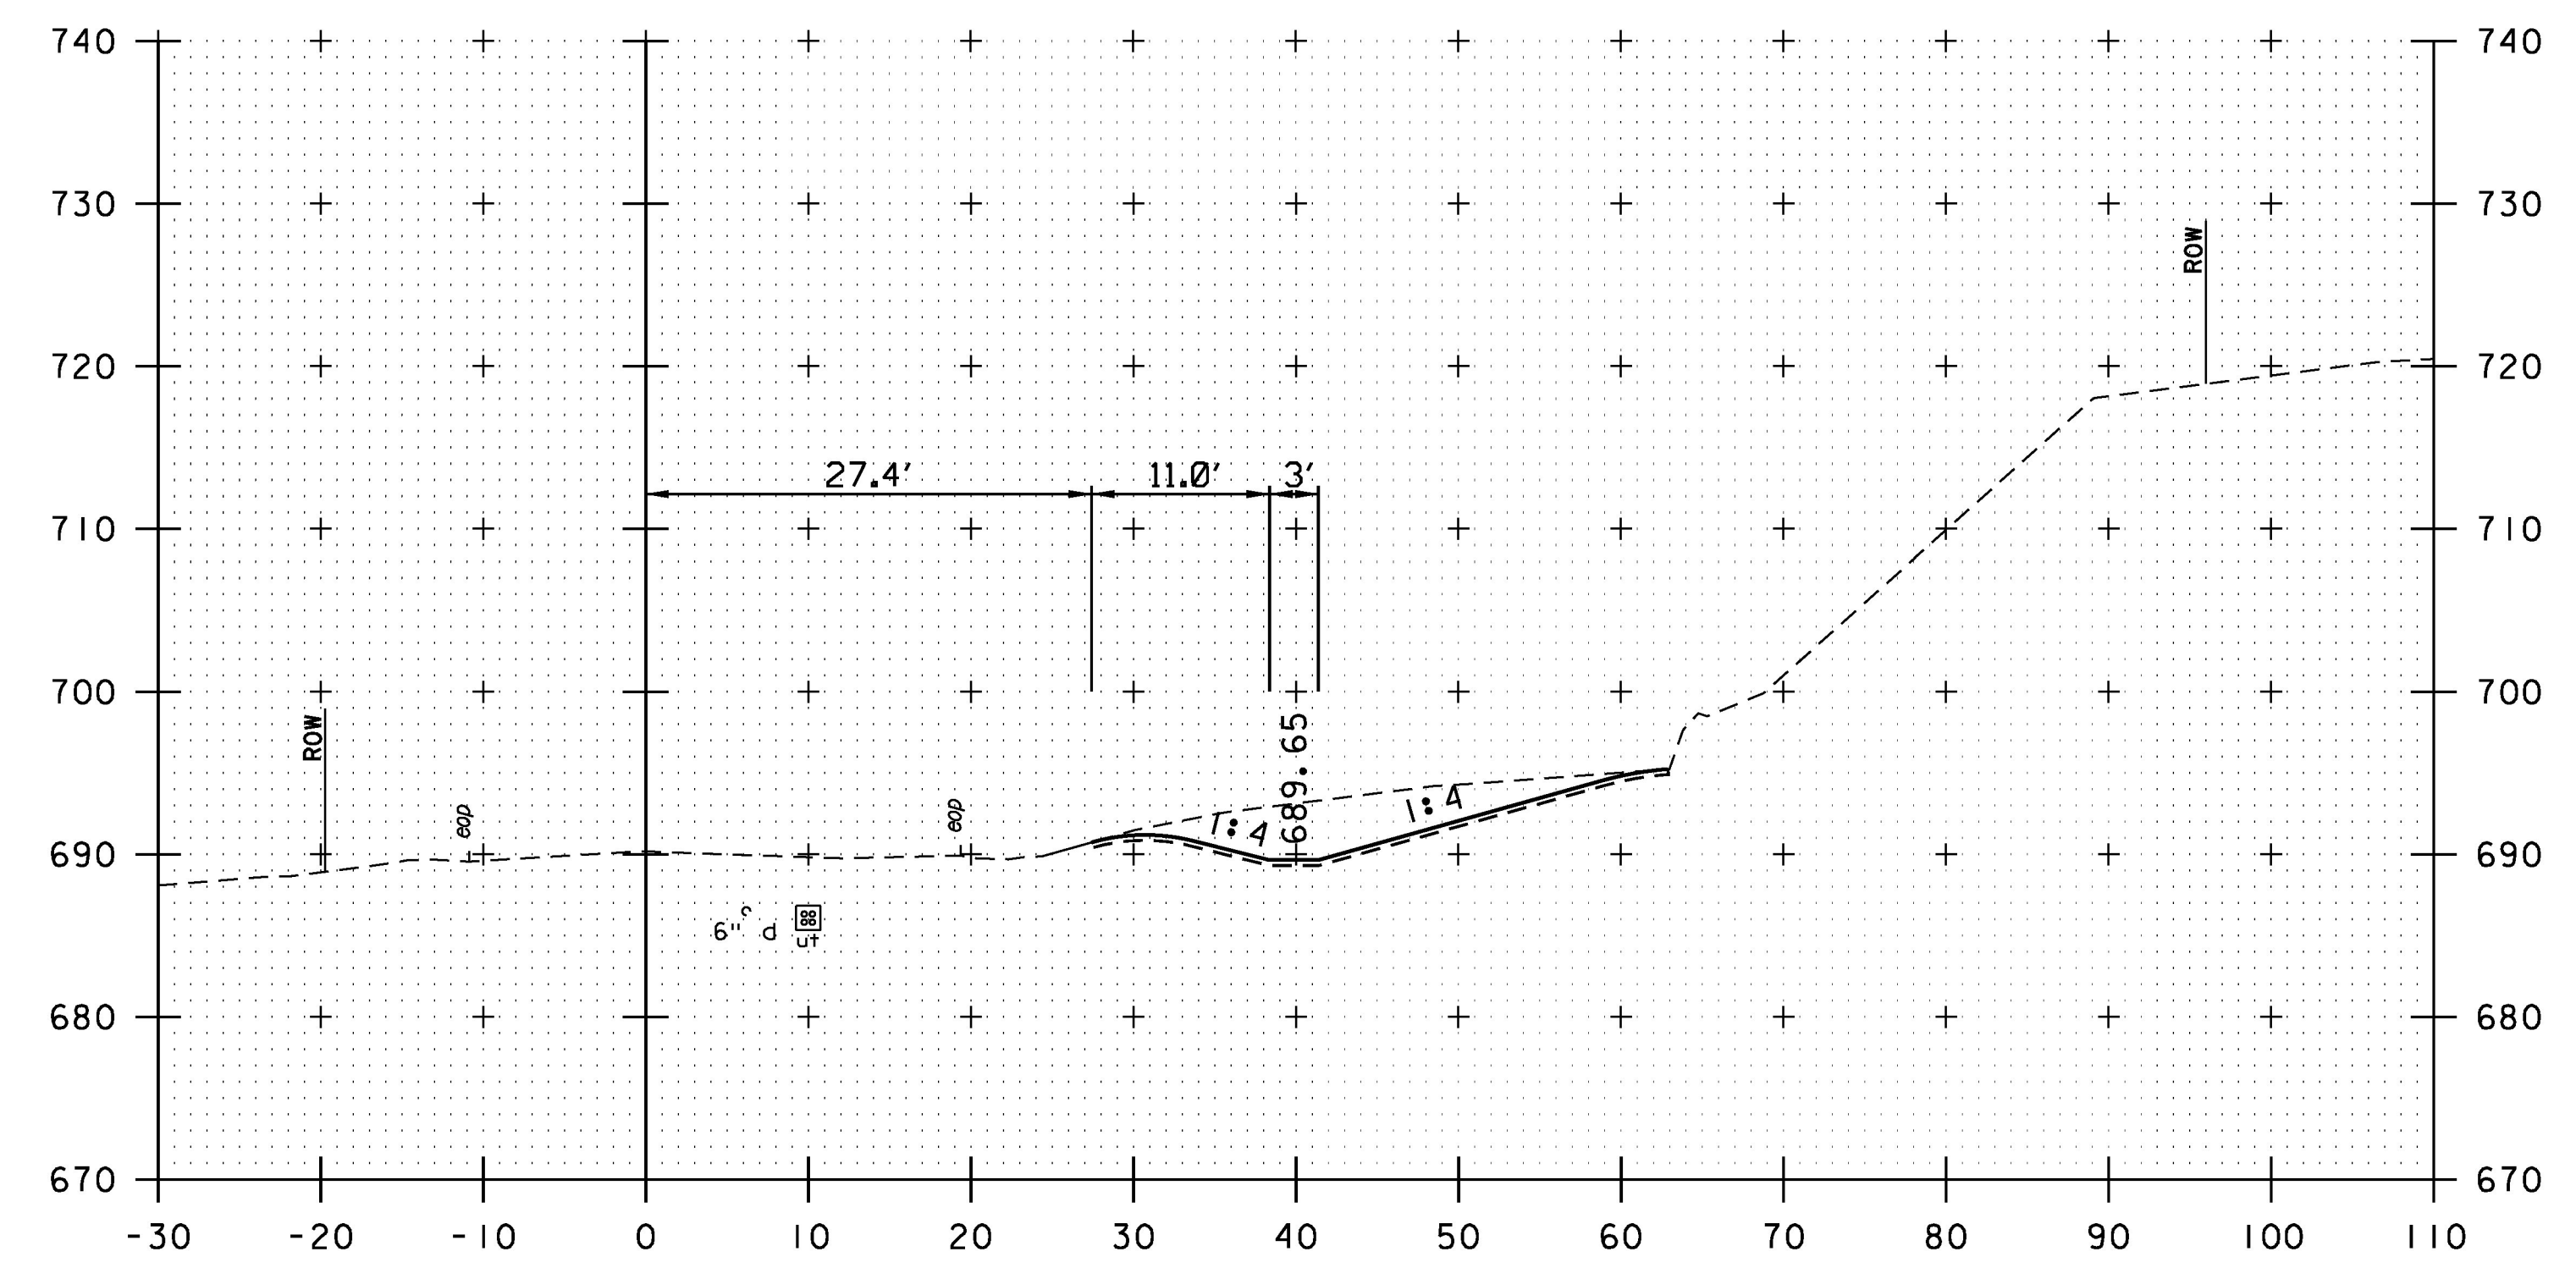

1201+00

STA. 1201+00.00, RT
 BEGIN STONE FILL, TYPE I
 BEGIN GEOTEXTILE UNDER STONE FILL
 BEGIN GRUBBING MATERIAL

PROJECT NAME:	BARRE CITY - BARRE TOWN
PROJECT NUMBER:	MEGC M 6000(12)C/1
FILE NAME:	z15d040_xs.dgn
PROJECT LEADER:	A.P. GUYETTE
DESIGNED BY:	D.M. PECK
CROSS SECTIONS (1 OF 9)	
PLOT DATE:	12/2/2016
DRAWN BY:	P.A. MILLER
CHECKED BY:	D.M. PECK
SHEET	31 OF 39

