




1201+75

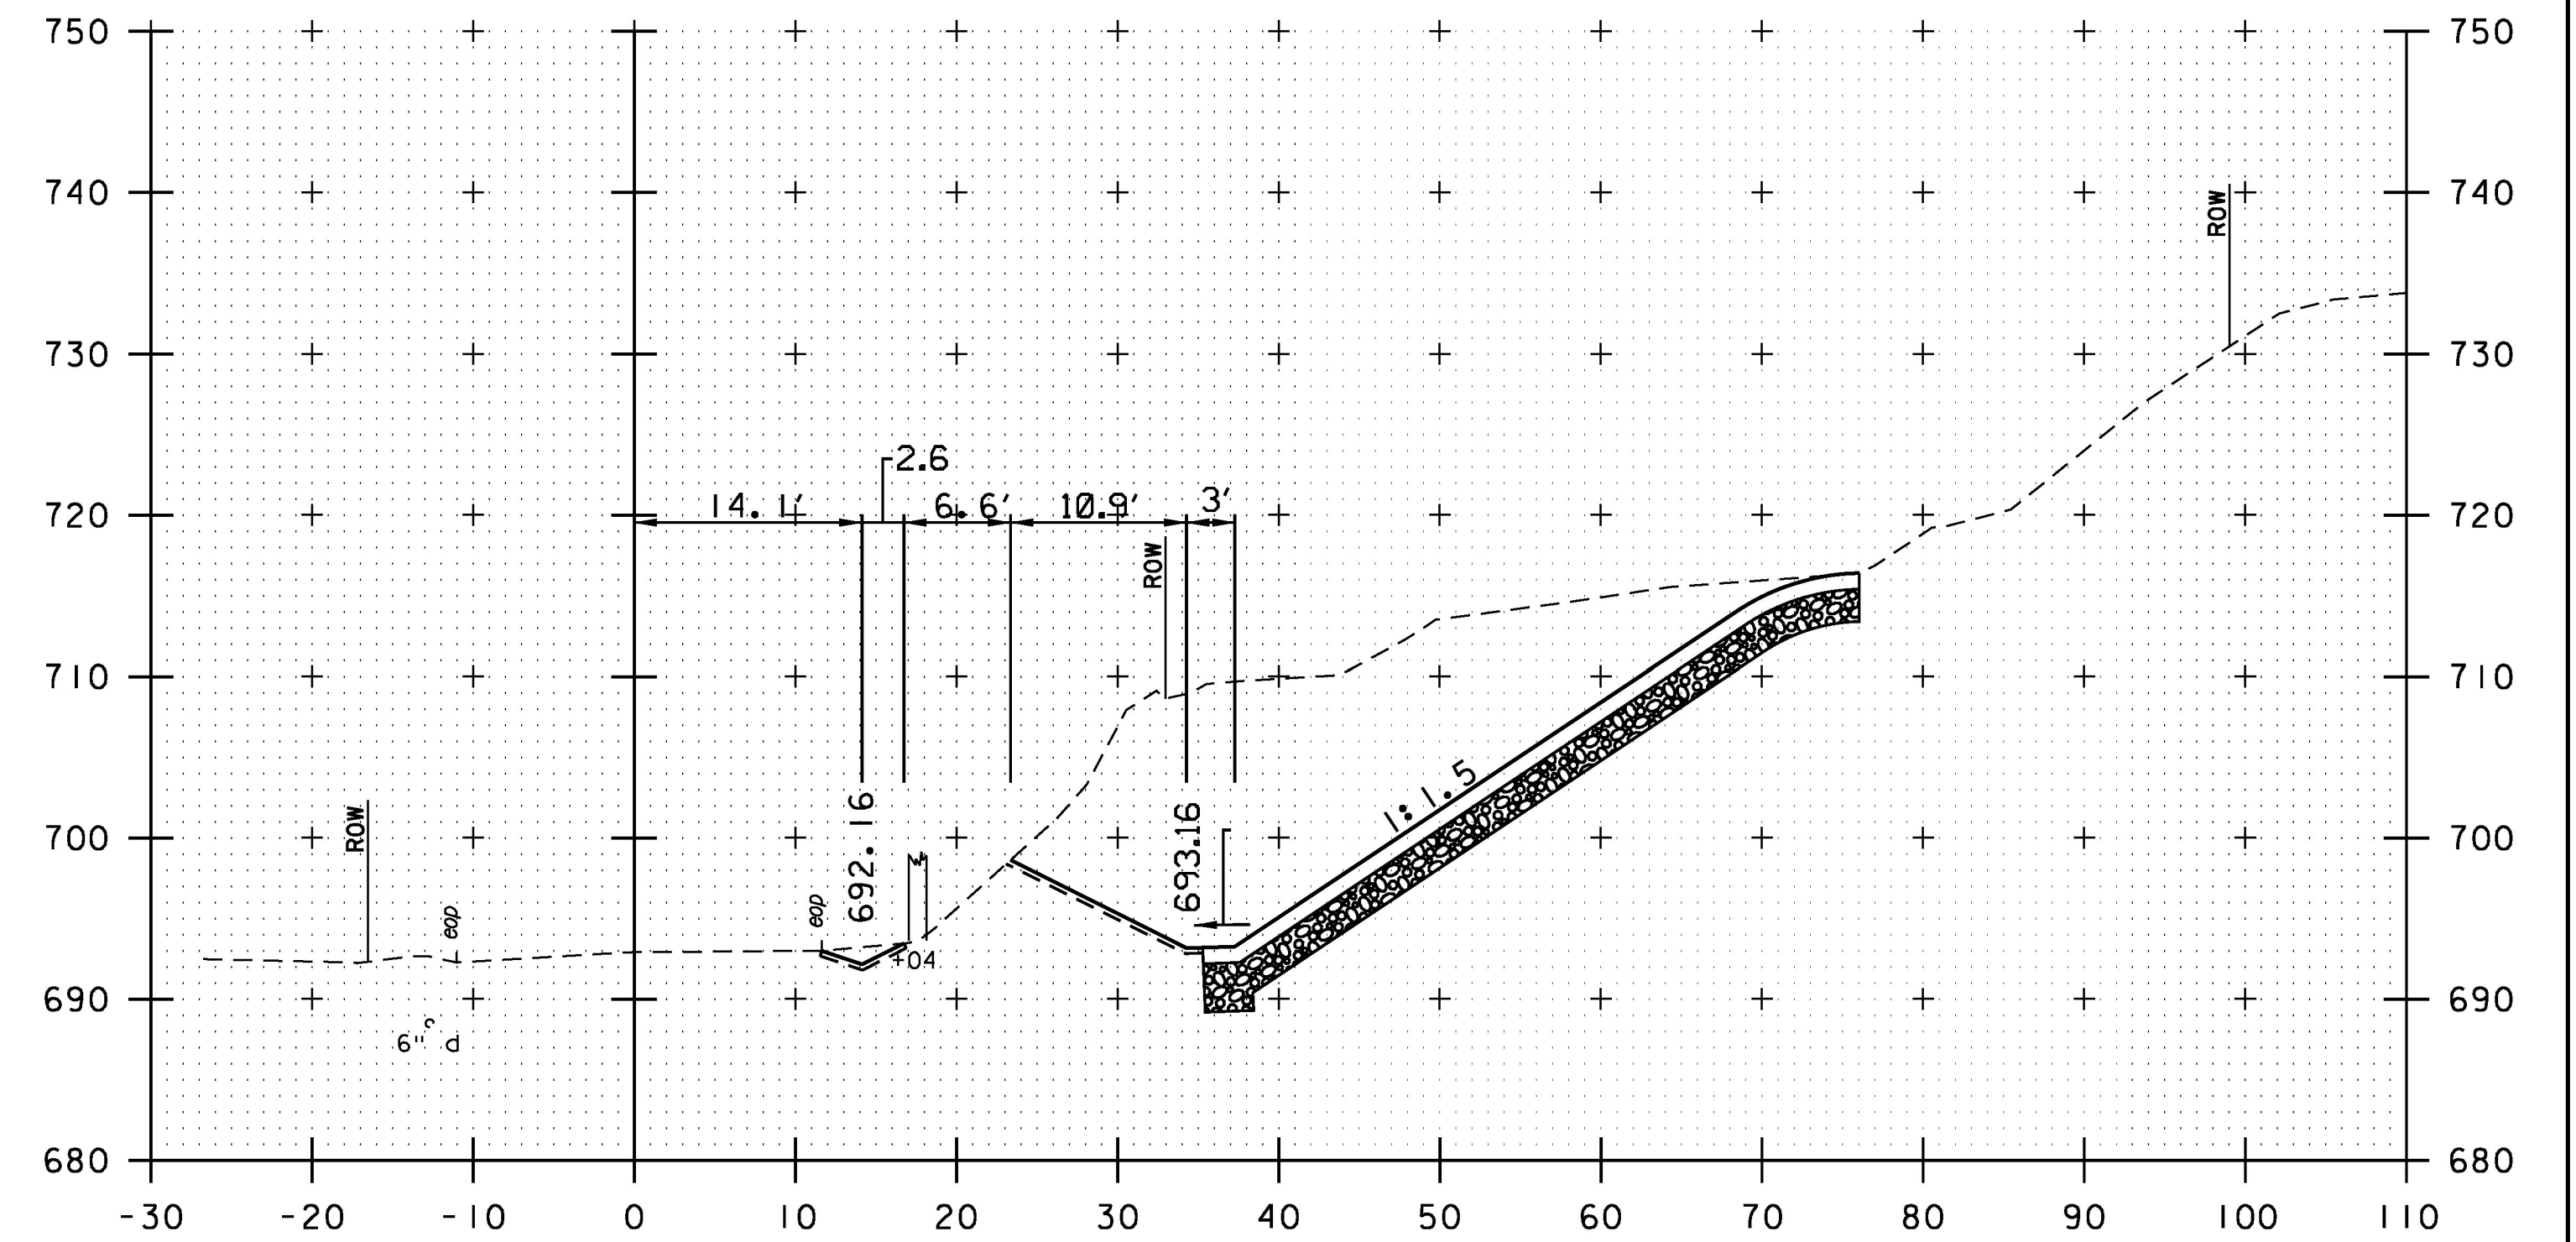

1202+04

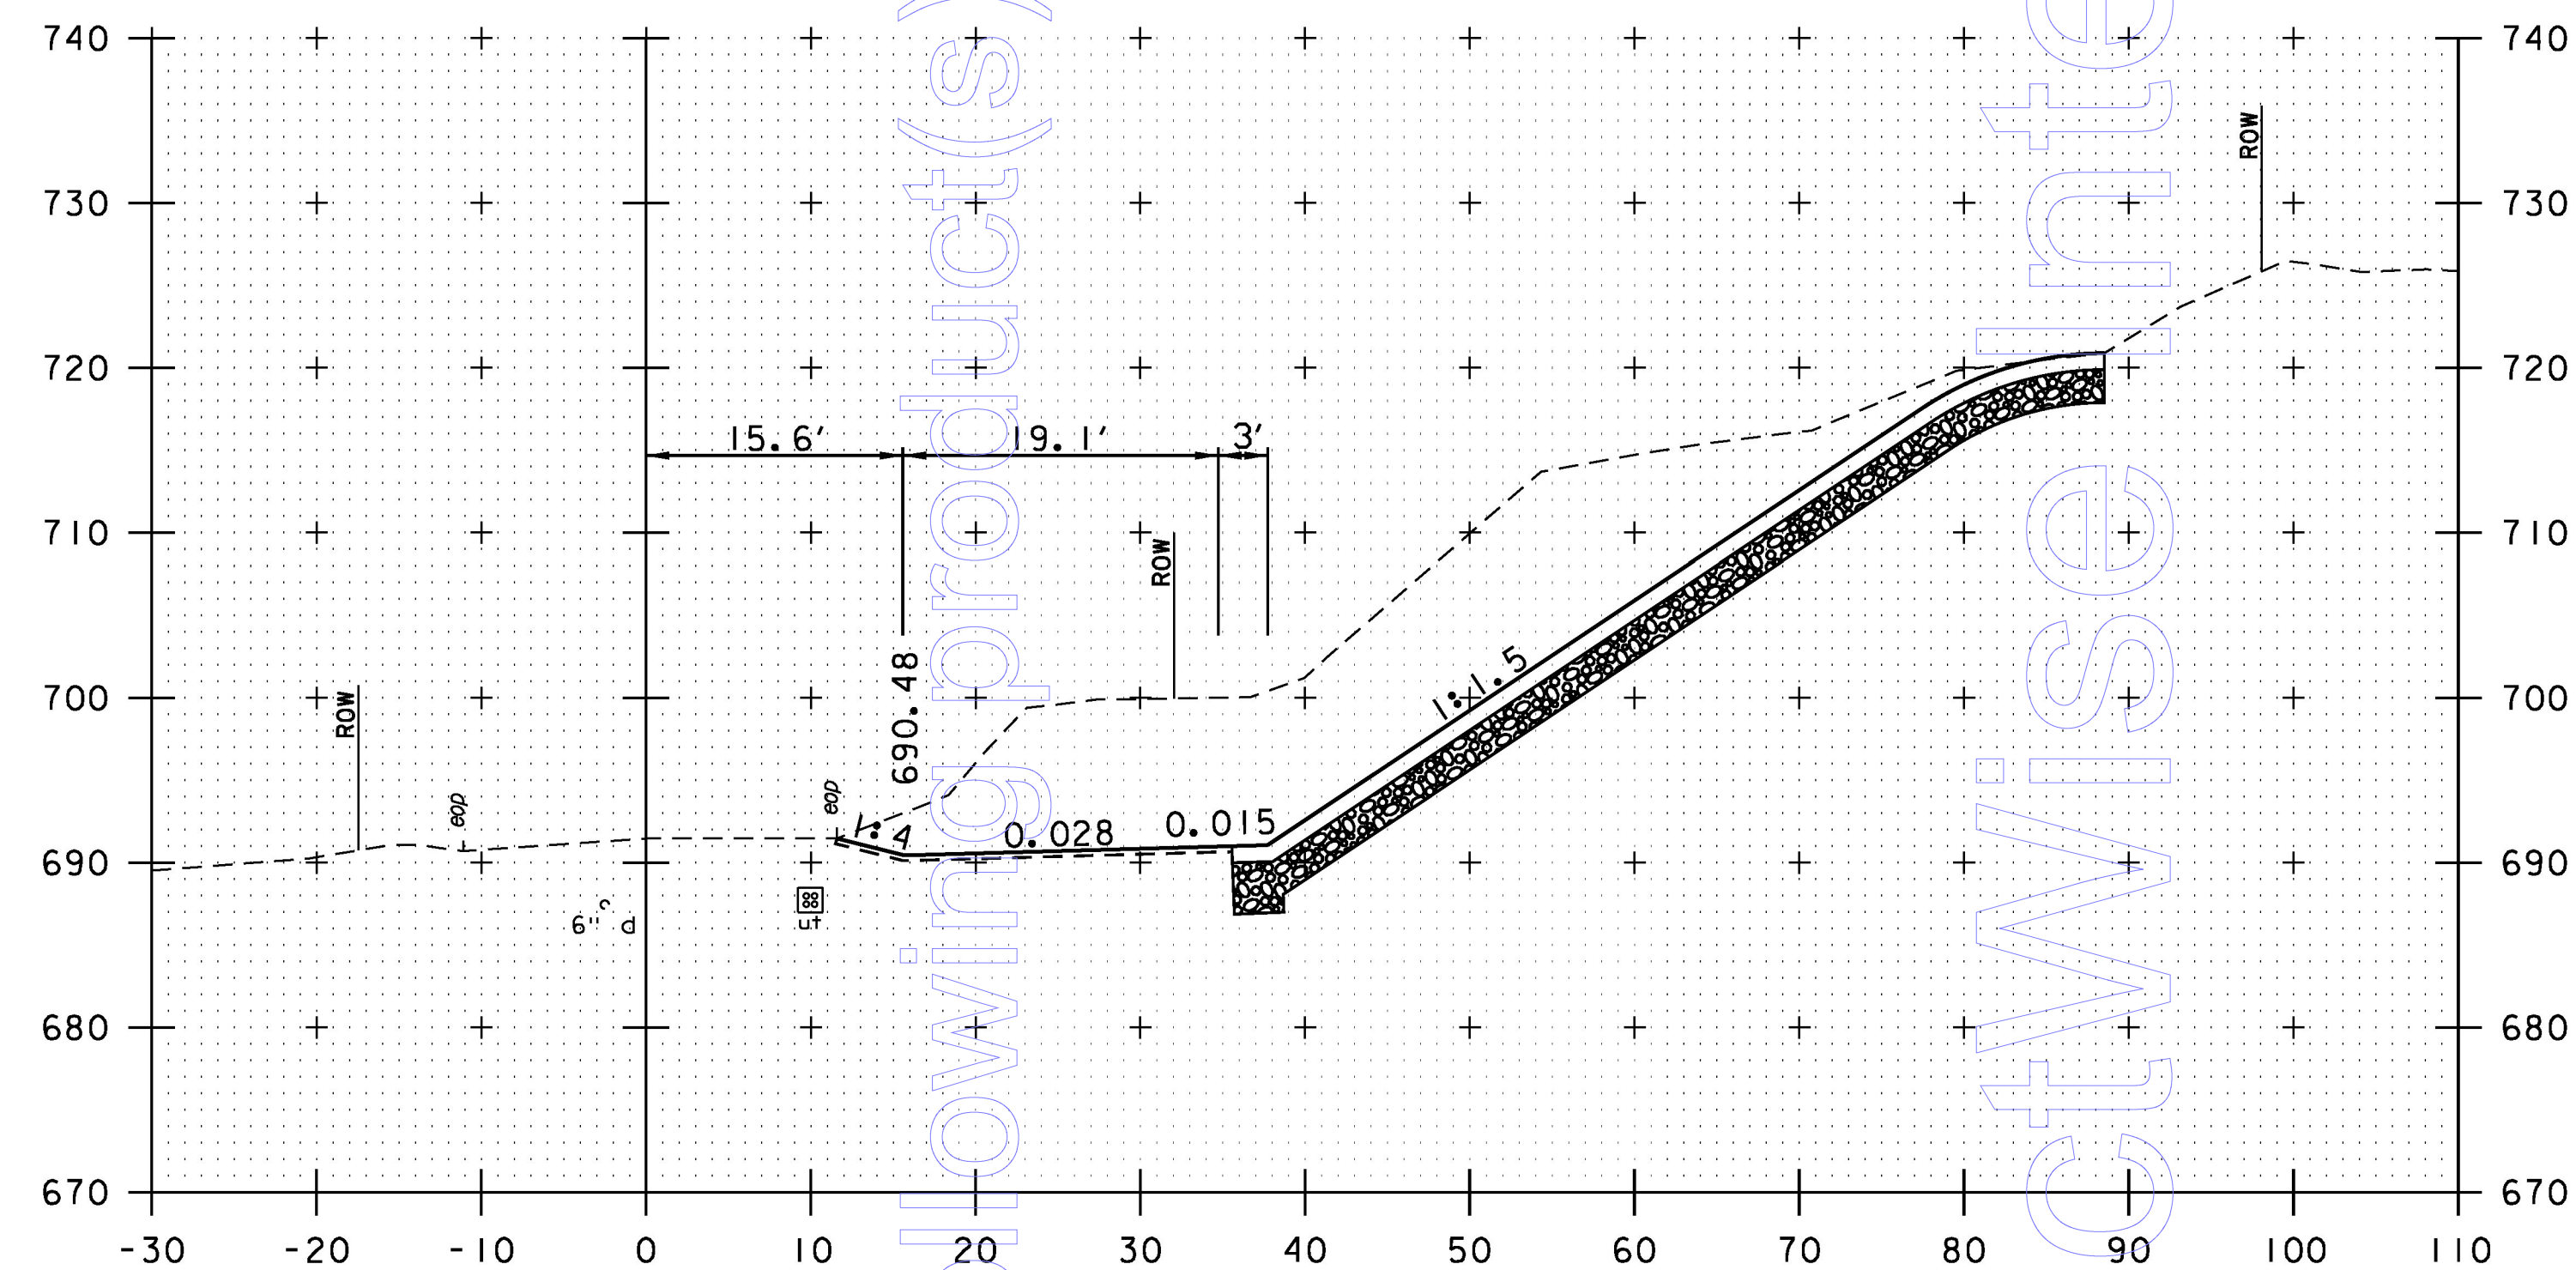

1201+50

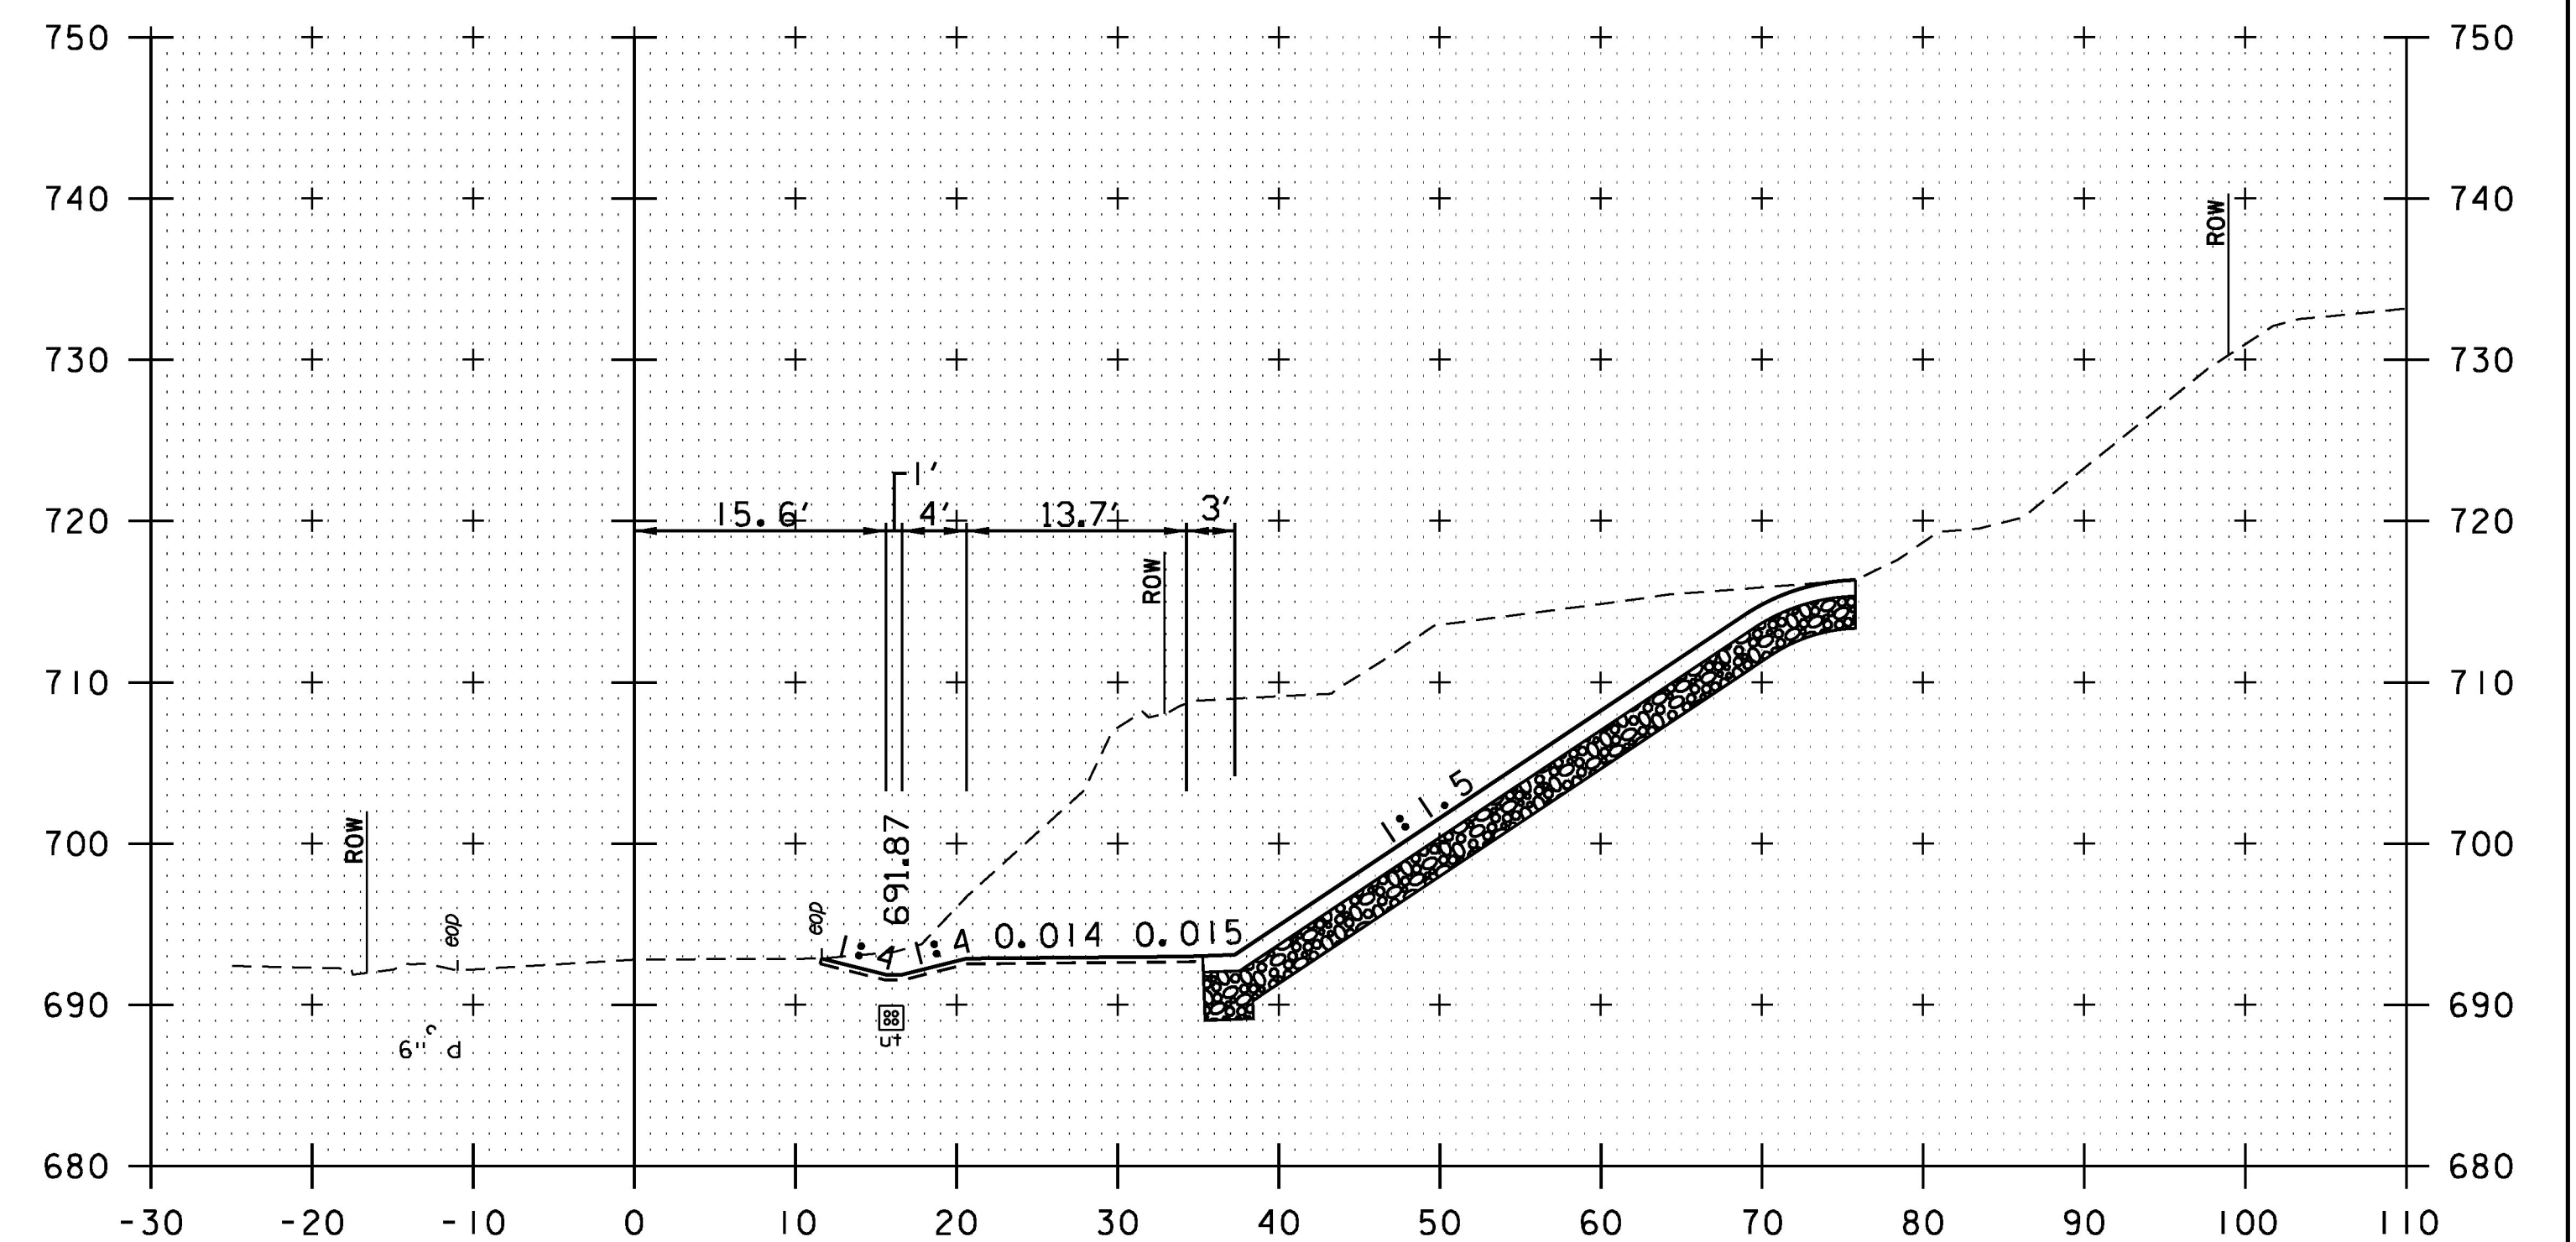

1202+00

The following product(s) are not activated:
ProjectWise InterPlot Server



PROJECT NAME:	BARRE CITY - BARRE TOWN
PROJECT NUMBER:	MEGC M 6000(12)C/1
FILE NAME:	z15d040_xs.dgn
PROJECT LEADER:	A.P. GUYETTE
DESIGNED BY:	D.M. PECK
CROSS SECTIONS (2 OF 9)	
PLOT DATE:	12/2/2016
DRAWN BY:	P.A. MILLER
CHECKED BY:	D.M. PECK
SHEET	32 OF 39