



1205+75

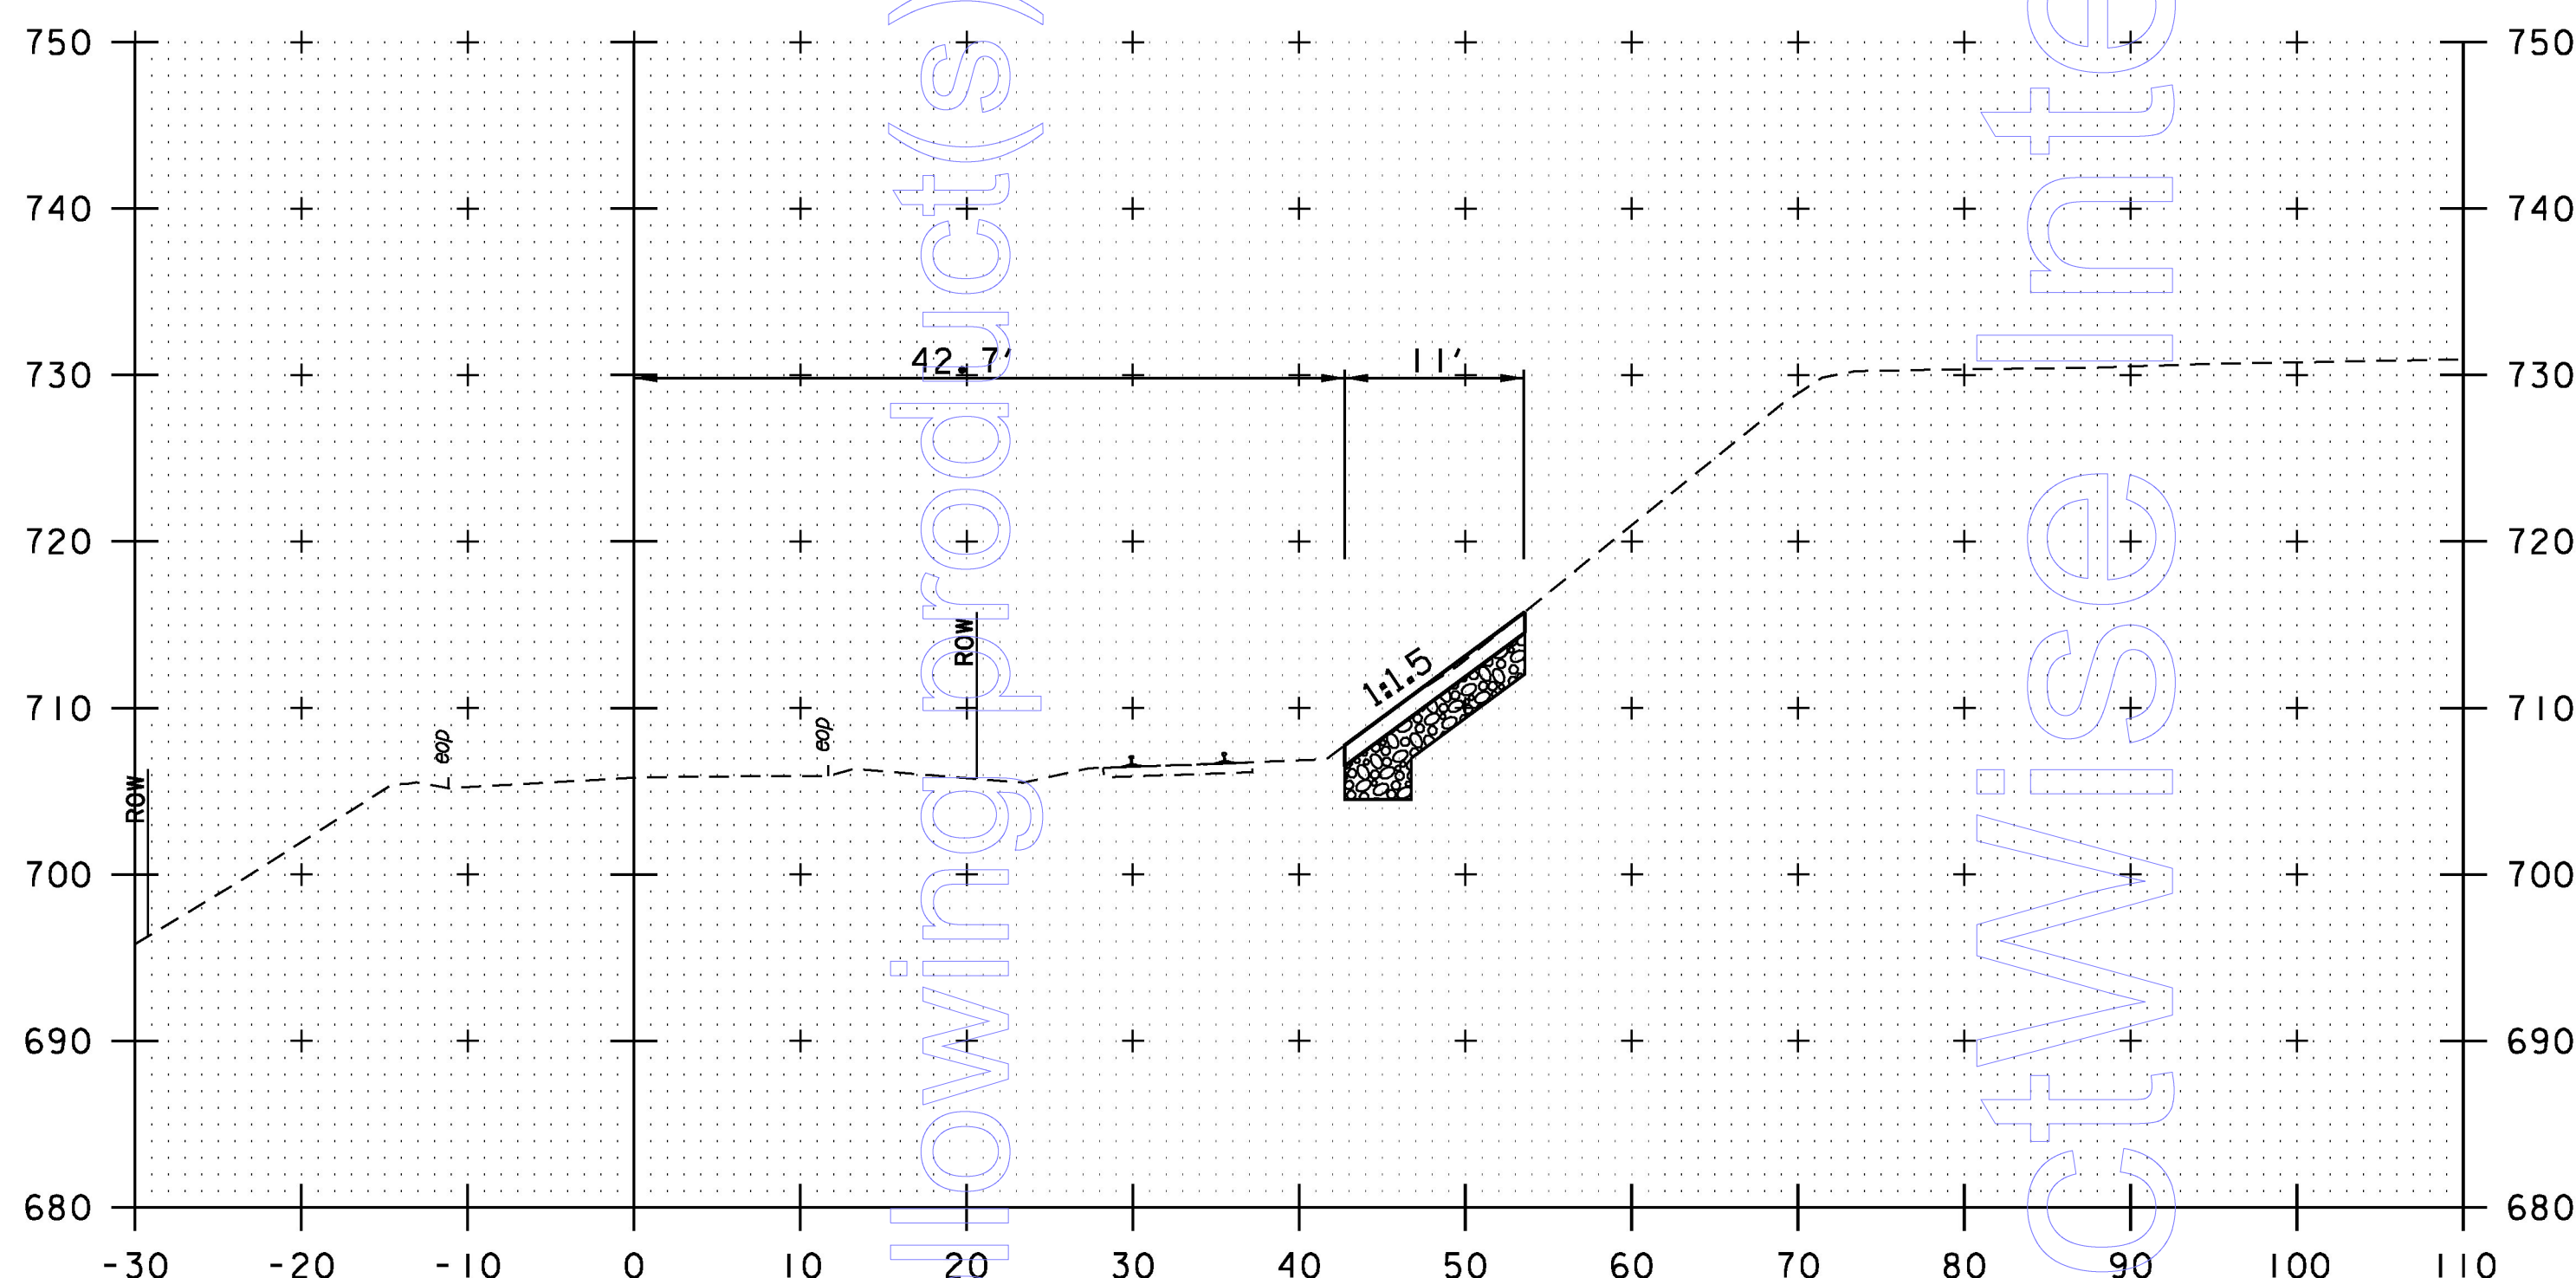


1205+50

STA. 1205+58.00, RT
 END STONE FILL, TYPE I
 END GEOTEXTILE UNDER STONE FILL
 END GRUBBING MATERIAL
 STA. 1205+36.91, RT
 END SPECIAL PROVISION (RETAINING WALL)
 STA. 1205+44, RT
 END CHAIN LINK FENCE, 6 FEET

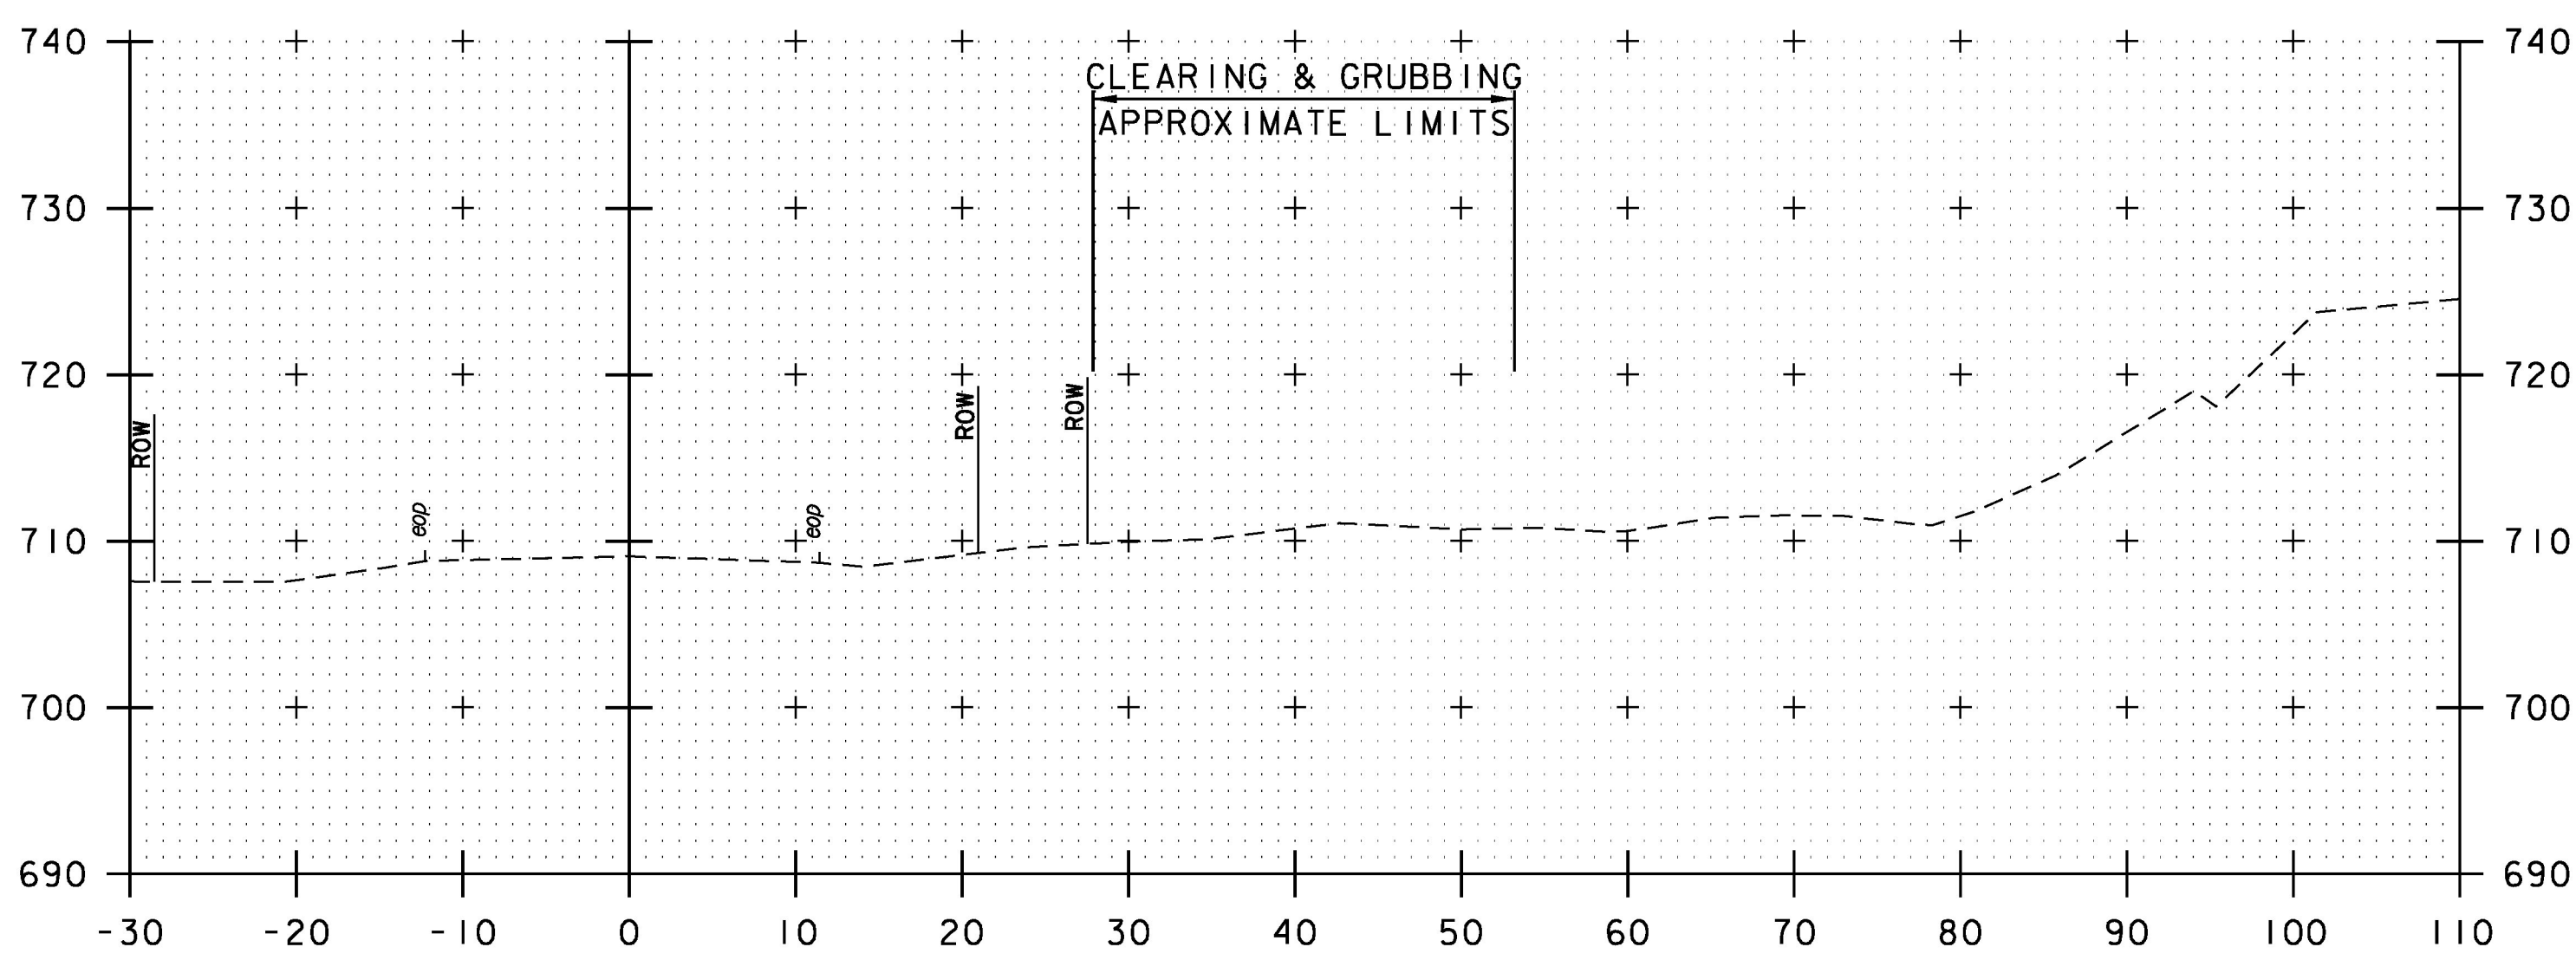

1206+50

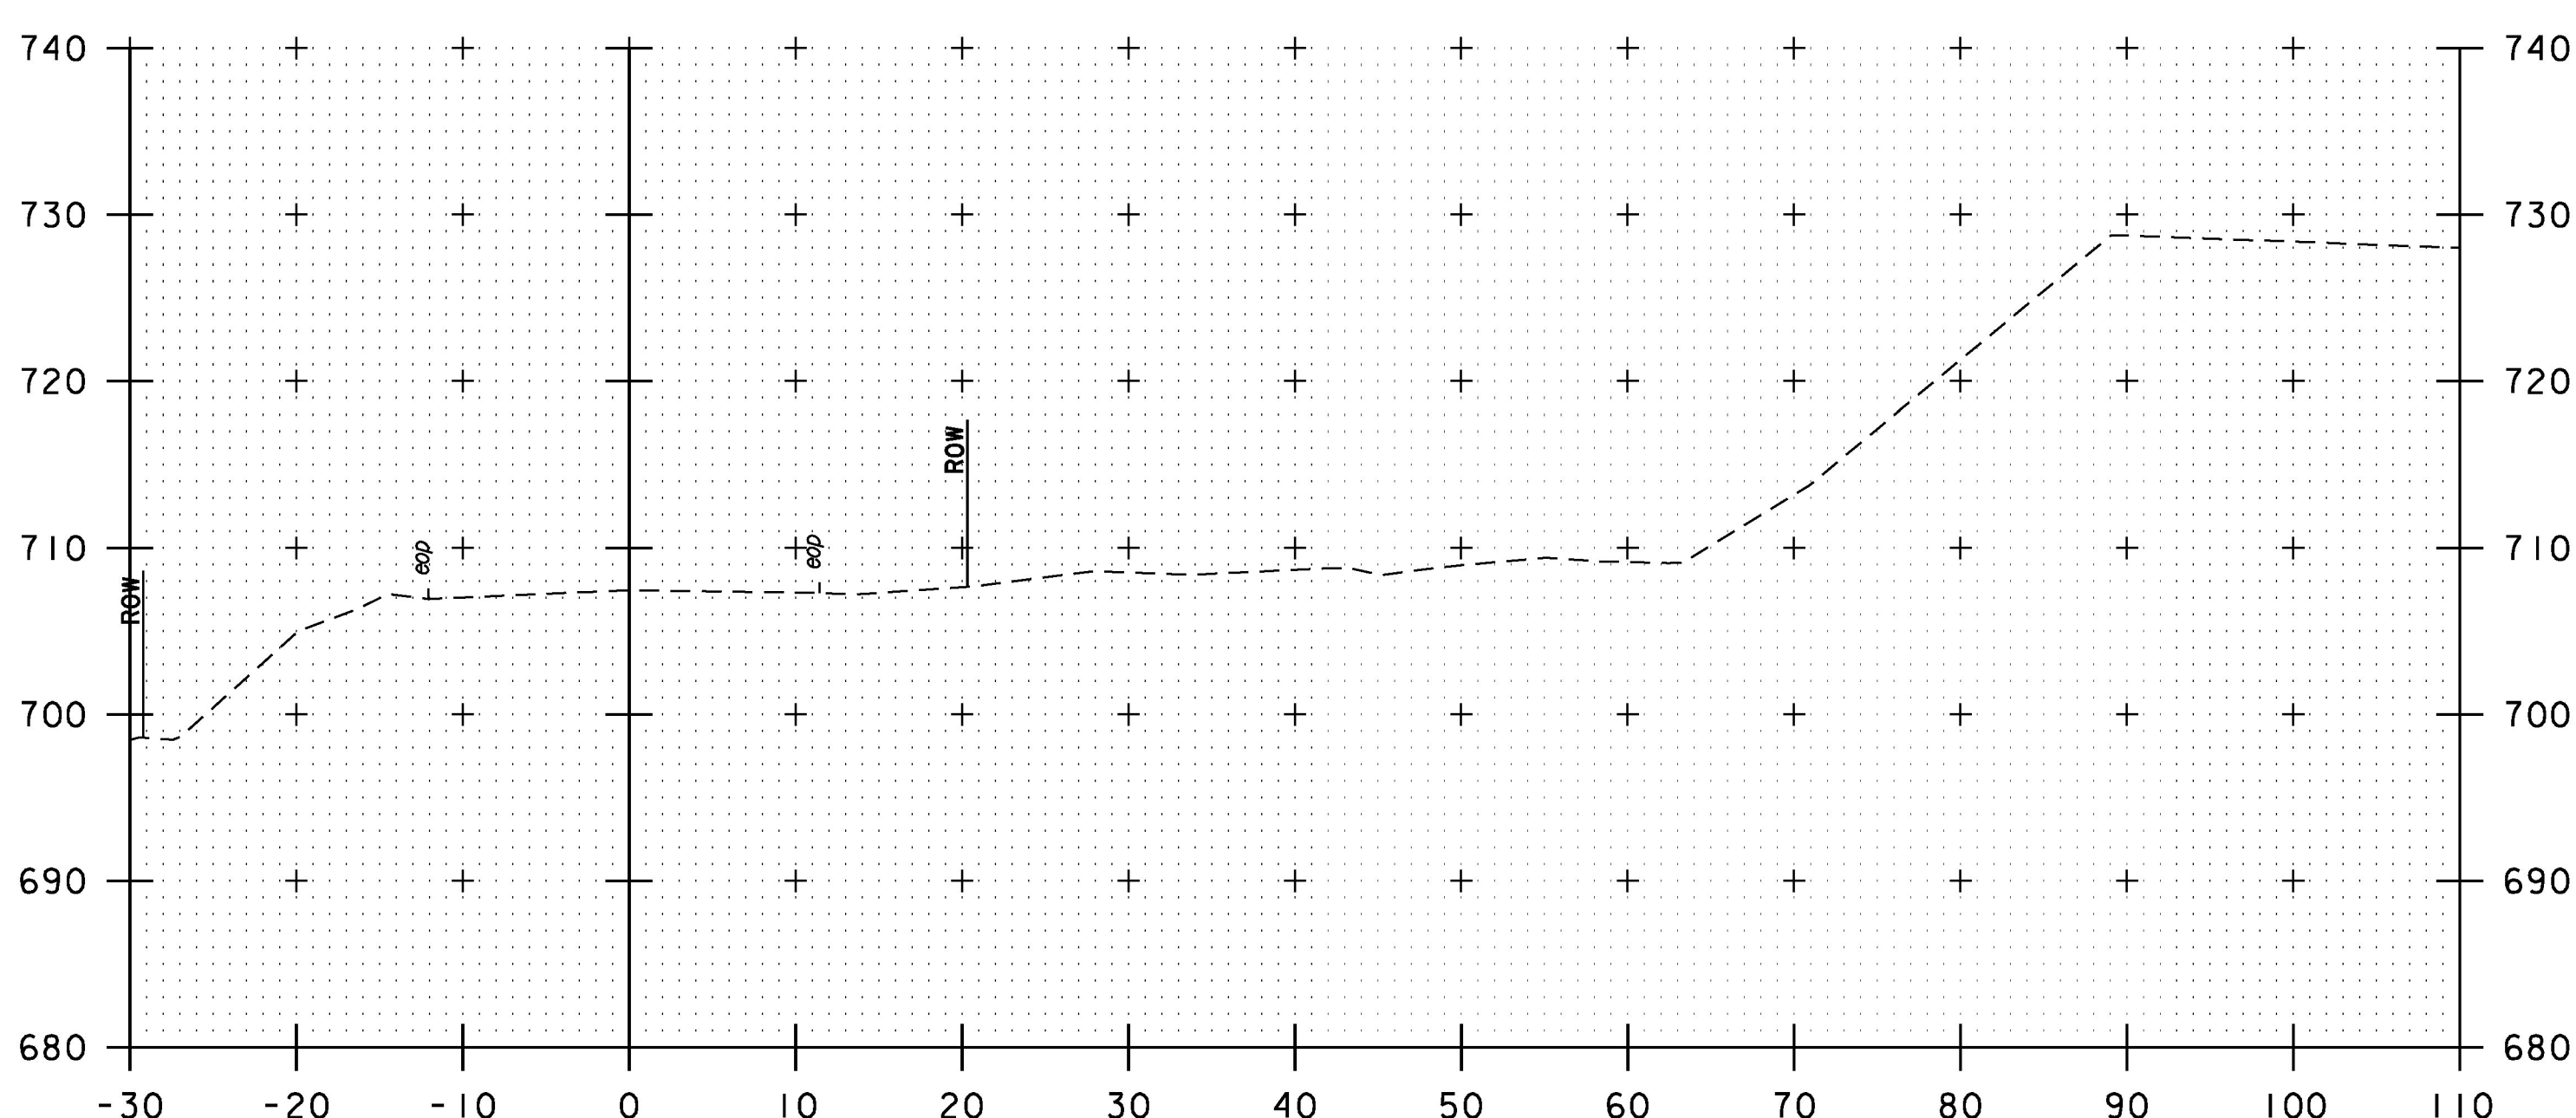

1206+00

PROJECT NAME:	BARRE CITY - BARRE TOWN
PROJECT NUMBER:	MEGC M 6000(12)C/1
FILE NAME:	z15d040_xs.dgn
PROJECT LEADER:	A.P. GUYETTE
DESIGNED BY:	D.M. PECK
CROSS SECTIONS (7 OF 9)	
PLOT DATE:	12/2/2016
DRAWN BY:	P.A. MILLER
CHECKED BY:	D.M. PECK
SHEET	37 OF 39



The following product(s) are not activated: Productwise InterPlot Server