



# STATE OF VERMONT AGENCY OF TRANSPORTATION

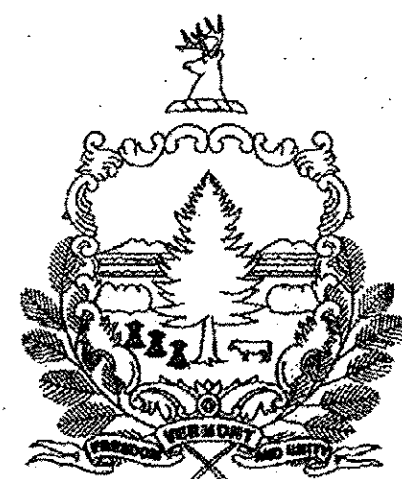

## PROPOSED IMPROVEMENT BRIDGE PROJECT TOWN OF BRATTLEBORO COUNTY OF WINDHAM

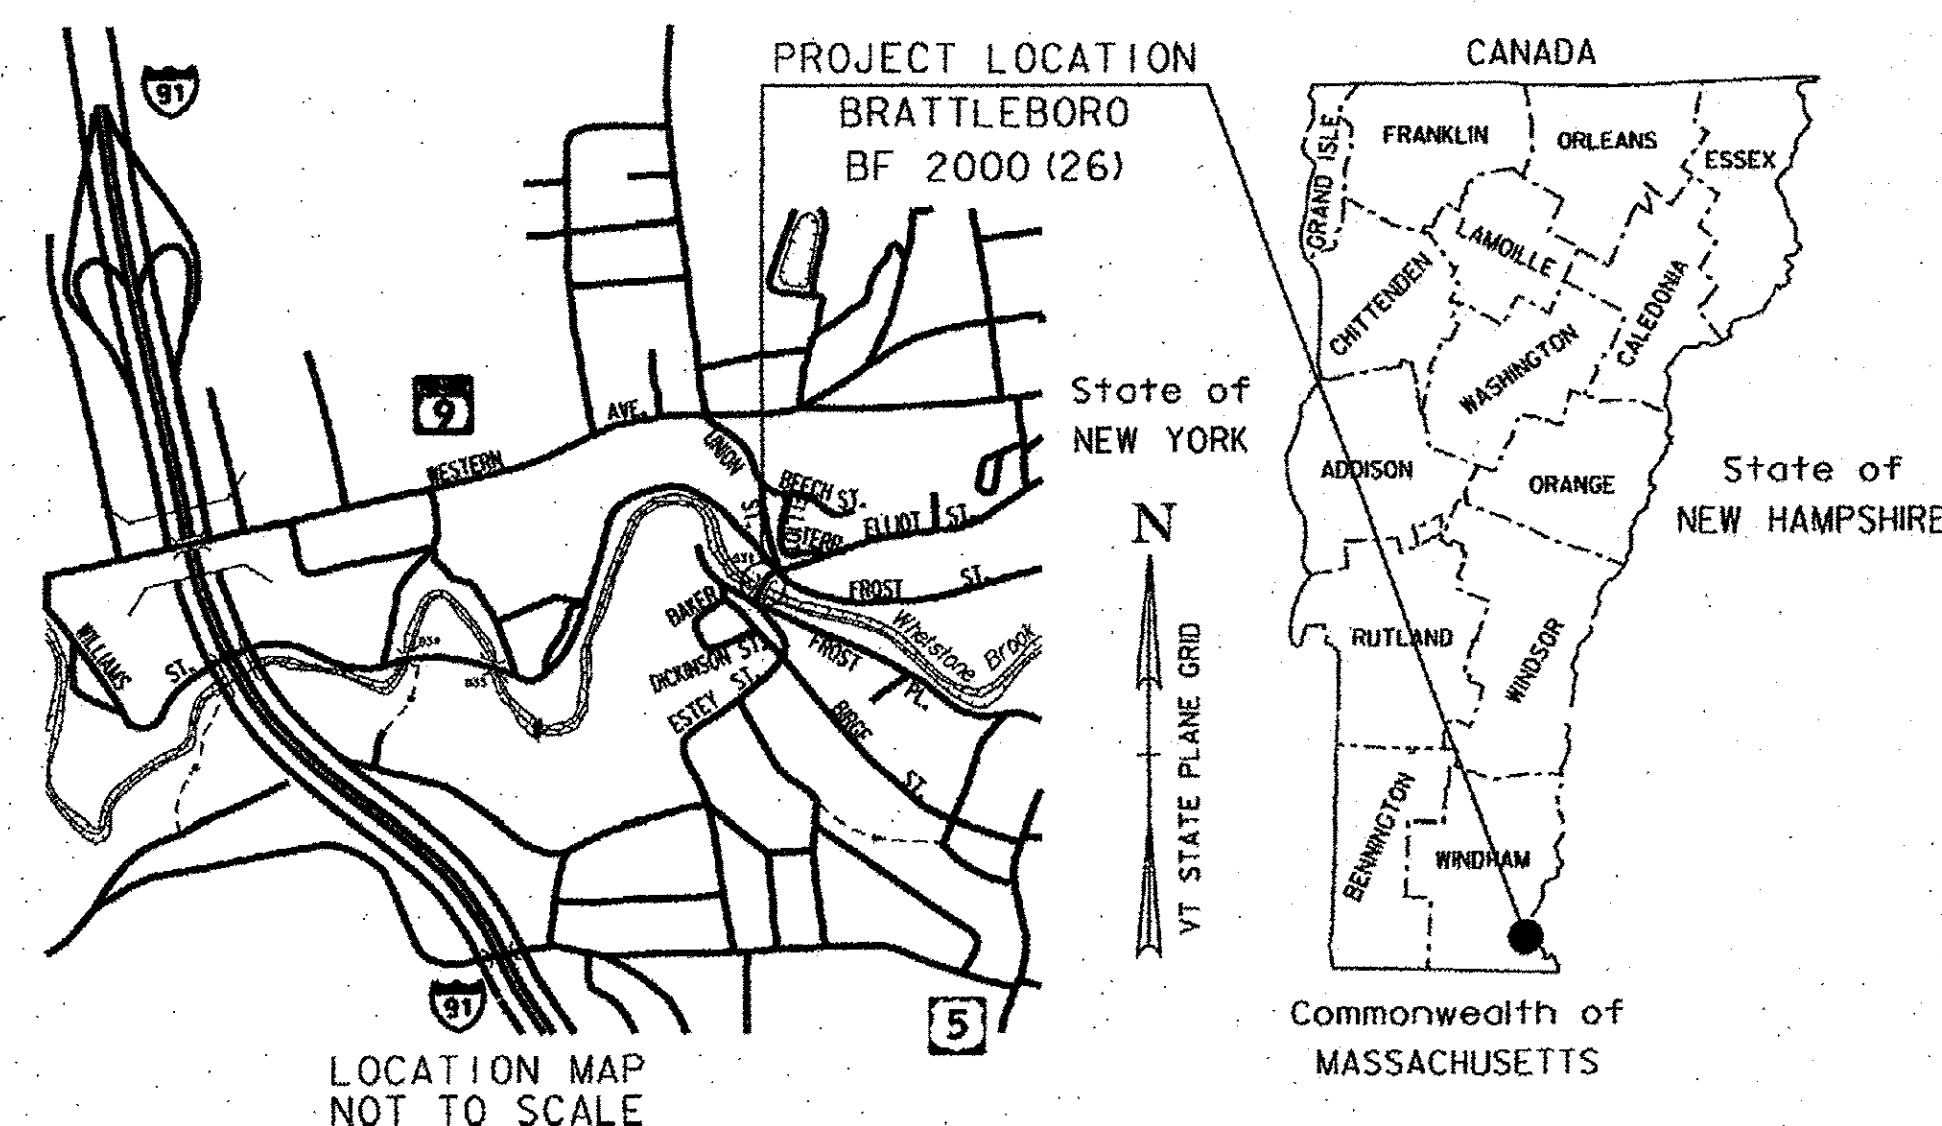


RECORD PLANS	
CONTRACTOR:	RENAUD BROTHERS, INC. - VERNON, VT
RESIDENT ENGINEER:	CHAD GREENWOOD
CONSTRUCTION BEGAN:	JUNE 21, 2016
CONSTRUCTION COMPLETE:	AUGUST 26, 2016
RECORD PLANS BY:	CHAD GREENWOOD & JESSE IVES
I HEREBY CERTIFY THAT ALL THE CONSTRUCTION REQUIRED BY THIS SET OF DRAWINGS HAS BEEN ACCOMPLISHED AS INDICATED HEREIN.	
BY	RESIDENT ENGINEER
DATE: 5/26/17	
NOTE: Any further information concerning final quantities, amounts or other details relative to this project may be found at Central Files in the electronic archives.	

### ELLIOT ST (TH #446) (URBAN COLLECTOR) BRIDGE NO. 31

**PROJECT LOCATION:** LOCATED IN THE TOWN OF BRATTLEBORO, ON ELLIOT ST (TH #446), APPROXIMATELY 0.010 MILES EASTERLY FROM THE INTERSECTION WITH FROST PL (TH #434).



**PROJECT DESCRIPTION:** WORK TO BE PERFORMED UNDER THIS PROJECT INCLUDES THE REPLACEMENT OF THE EXISTING BRIDGE DECK INCLUDING RELATED APPROACH WORK.

**LENGTH OF STRUCTURE:** 90.00 FEET  
**LENGTH OF ROADWAY:** 30.00 FEET  
**LENGTH OF PROJECT:** 120.00 FEET

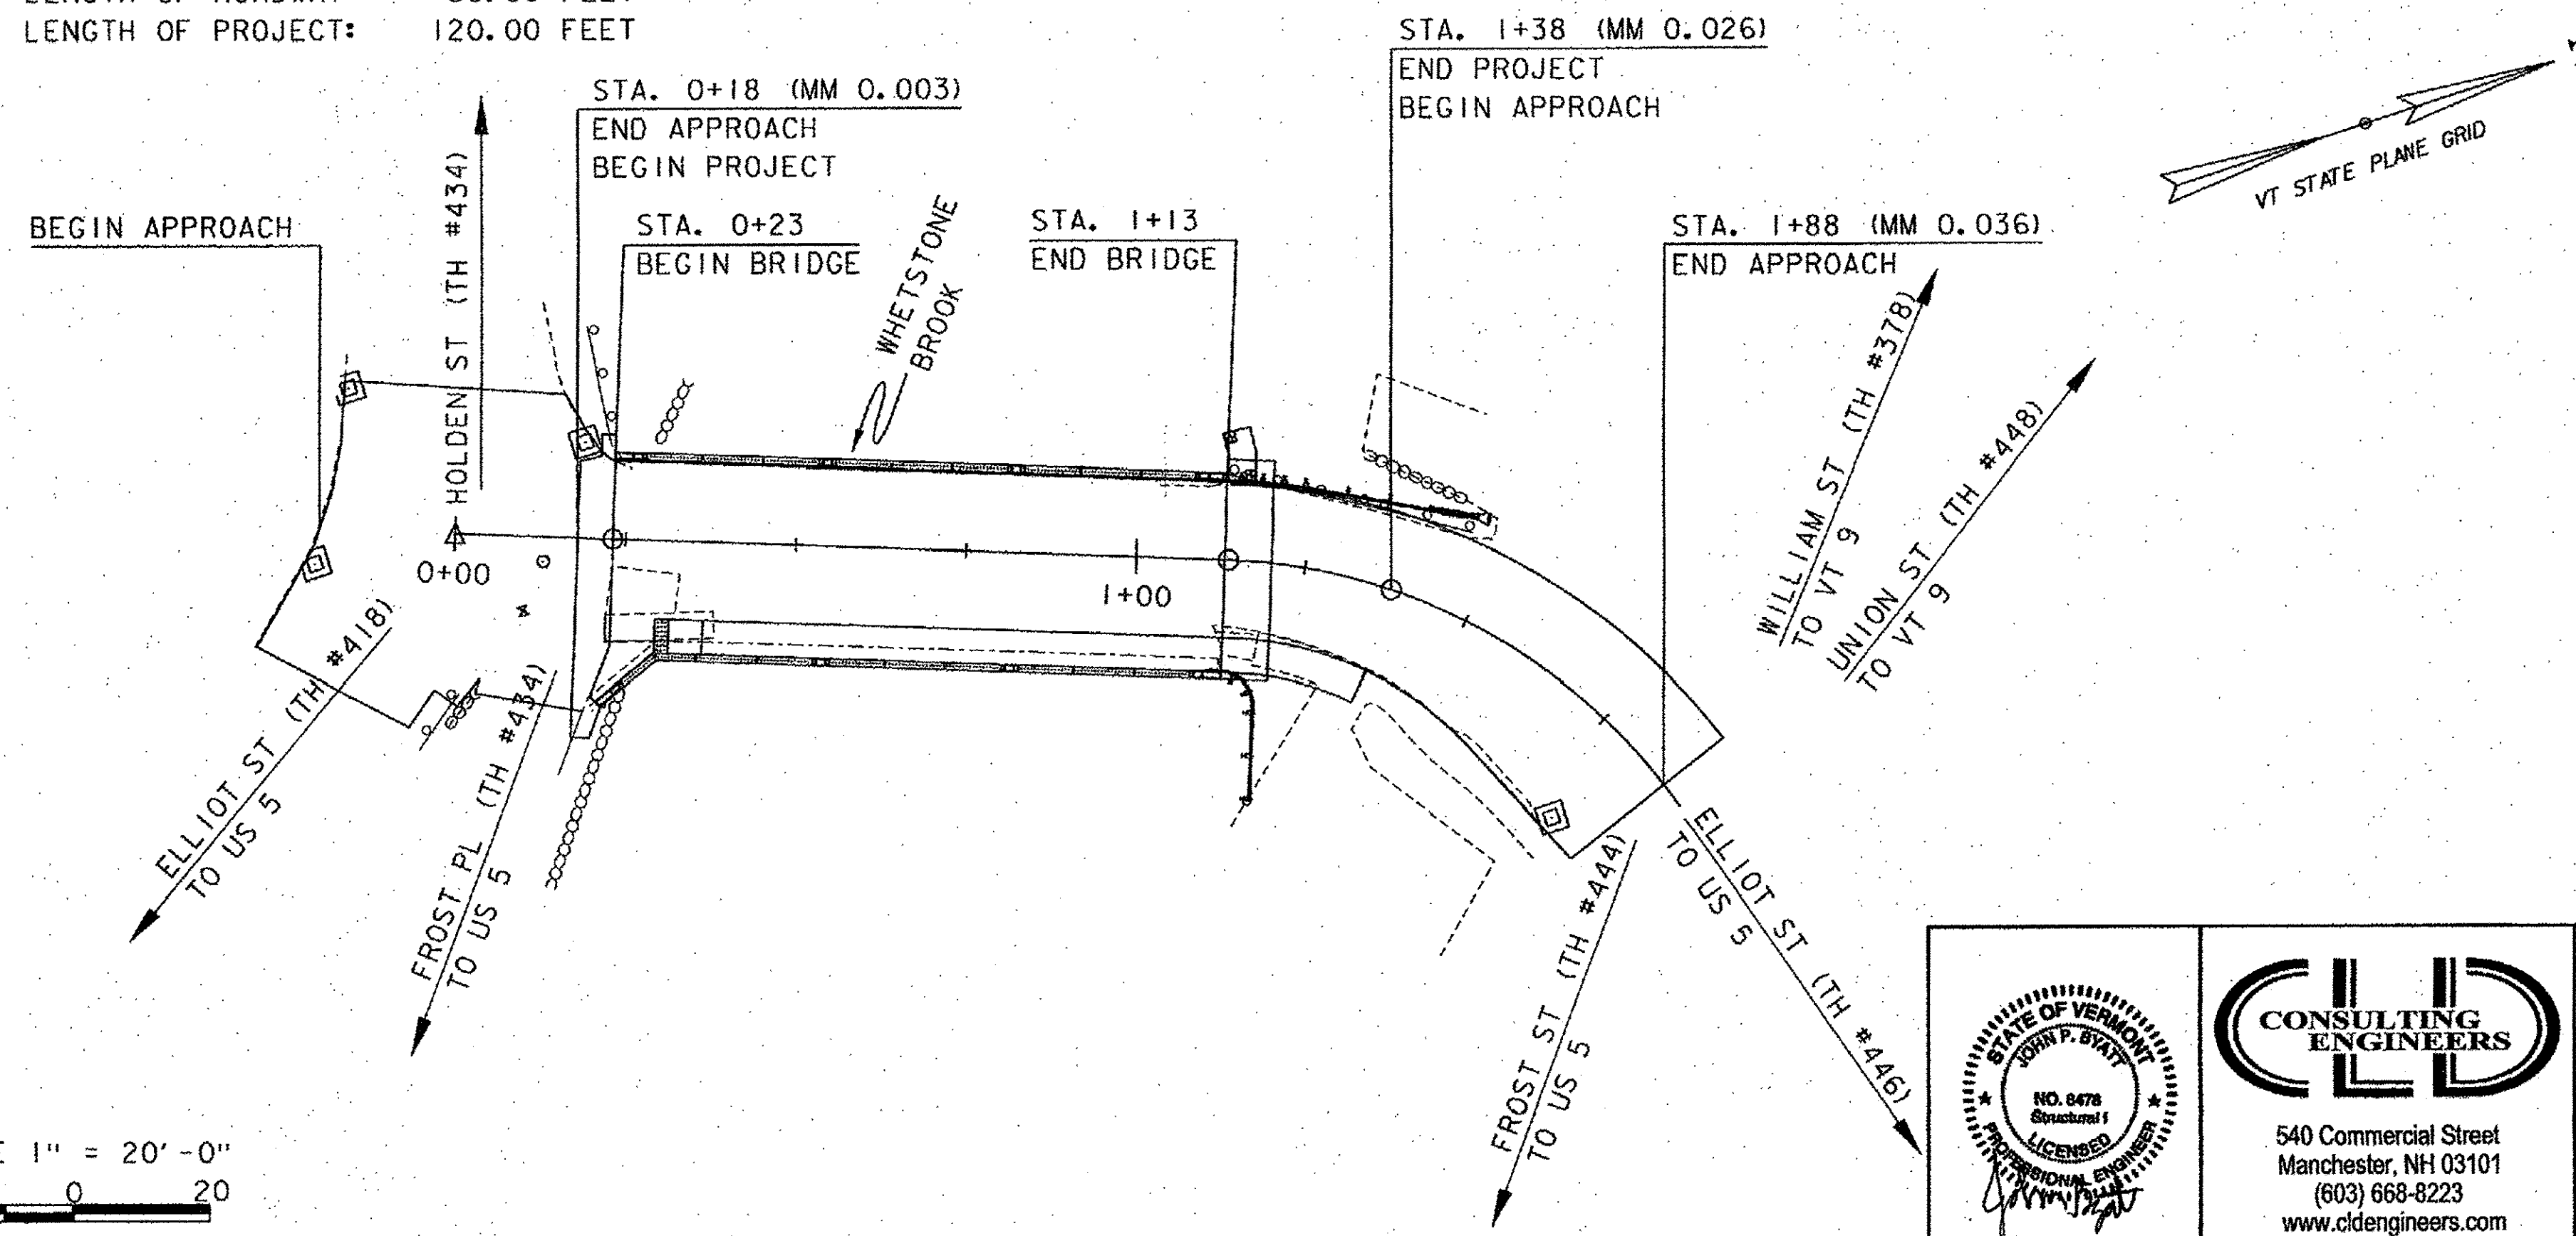

CONSTRUCTION IS TO BE CARRIED ON IN ACCORDANCE WITH THESE PLANS AND THE STANDARD SPECIFICATIONS FOR CONSTRUCTION DATED 2011, AS APPROVED BY THE FEDERAL HIGHWAY ADMINISTRATION ON JULY 20, 2011 FOR USE ON THIS PROJECT, INCLUDING ALL SUBSEQUENT REVISIONS AND SUCH REVISED SPECIFICATIONS AND SPECIAL PROVISIONS AS ARE INCORPORATED IN THESE PLANS.

QUALITY ASSURANCE PROGRAM : LEVEL 2	
SURVEYED BY :	CLD
SURVEYED DATE :	09/21/2015
DATUM	
VERTICAL	NAVD 88
HORIZONTAL	NAD 83

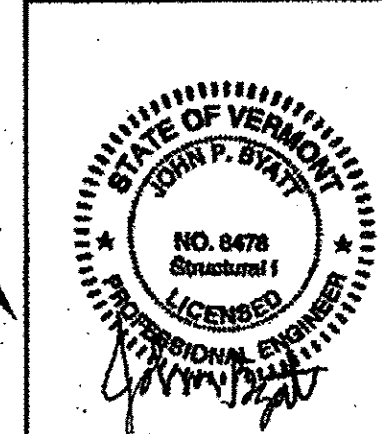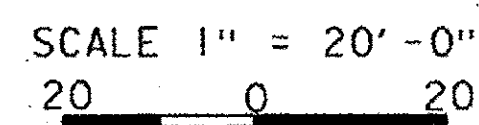

**CONSULTING ENGINEERS**

540 Commercial Street  
Manchester, NH 03101  
(603) 668-8223  
www.cldengineers.com

DIRECTOR OF PROJECT DELIVERY	
APPROVED	DATE 2/4/2016
PROJECT MANAGER : JENNIFER FITCH, P.E.	
PROJECT NAME :	BRATTLEBORO
PROJECT NUMBER :	BF 2000 (26)
SHEET 1 OF 26 SHEETS	