


EXISTING TYPICAL BRIDGE SECTION


SCALE: 1/2" = 1'-0"

PARTIAL REMOVAL OF STRUCTURE

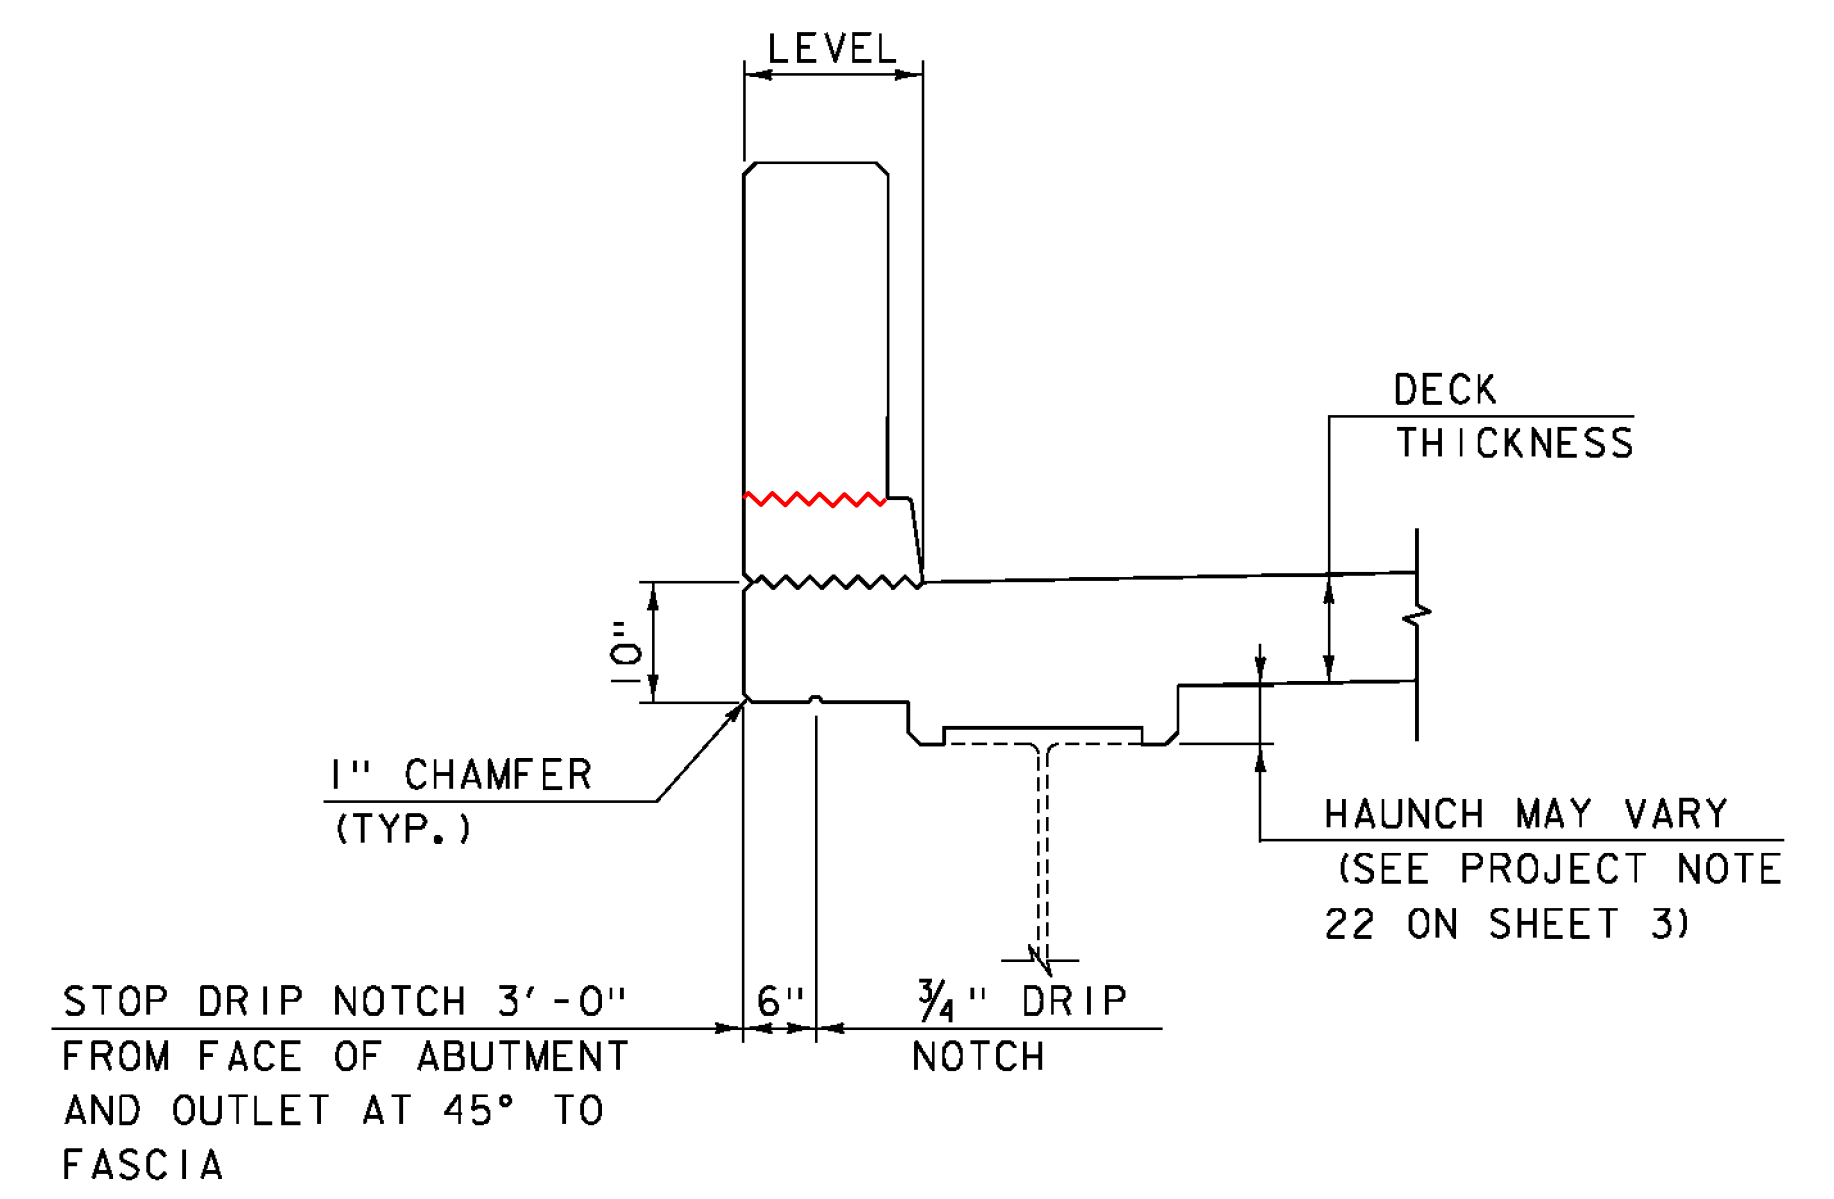


CURB FASCIA AND DRIP NOTCH DETAIL

SCALE: 3/4" = 1'-0"

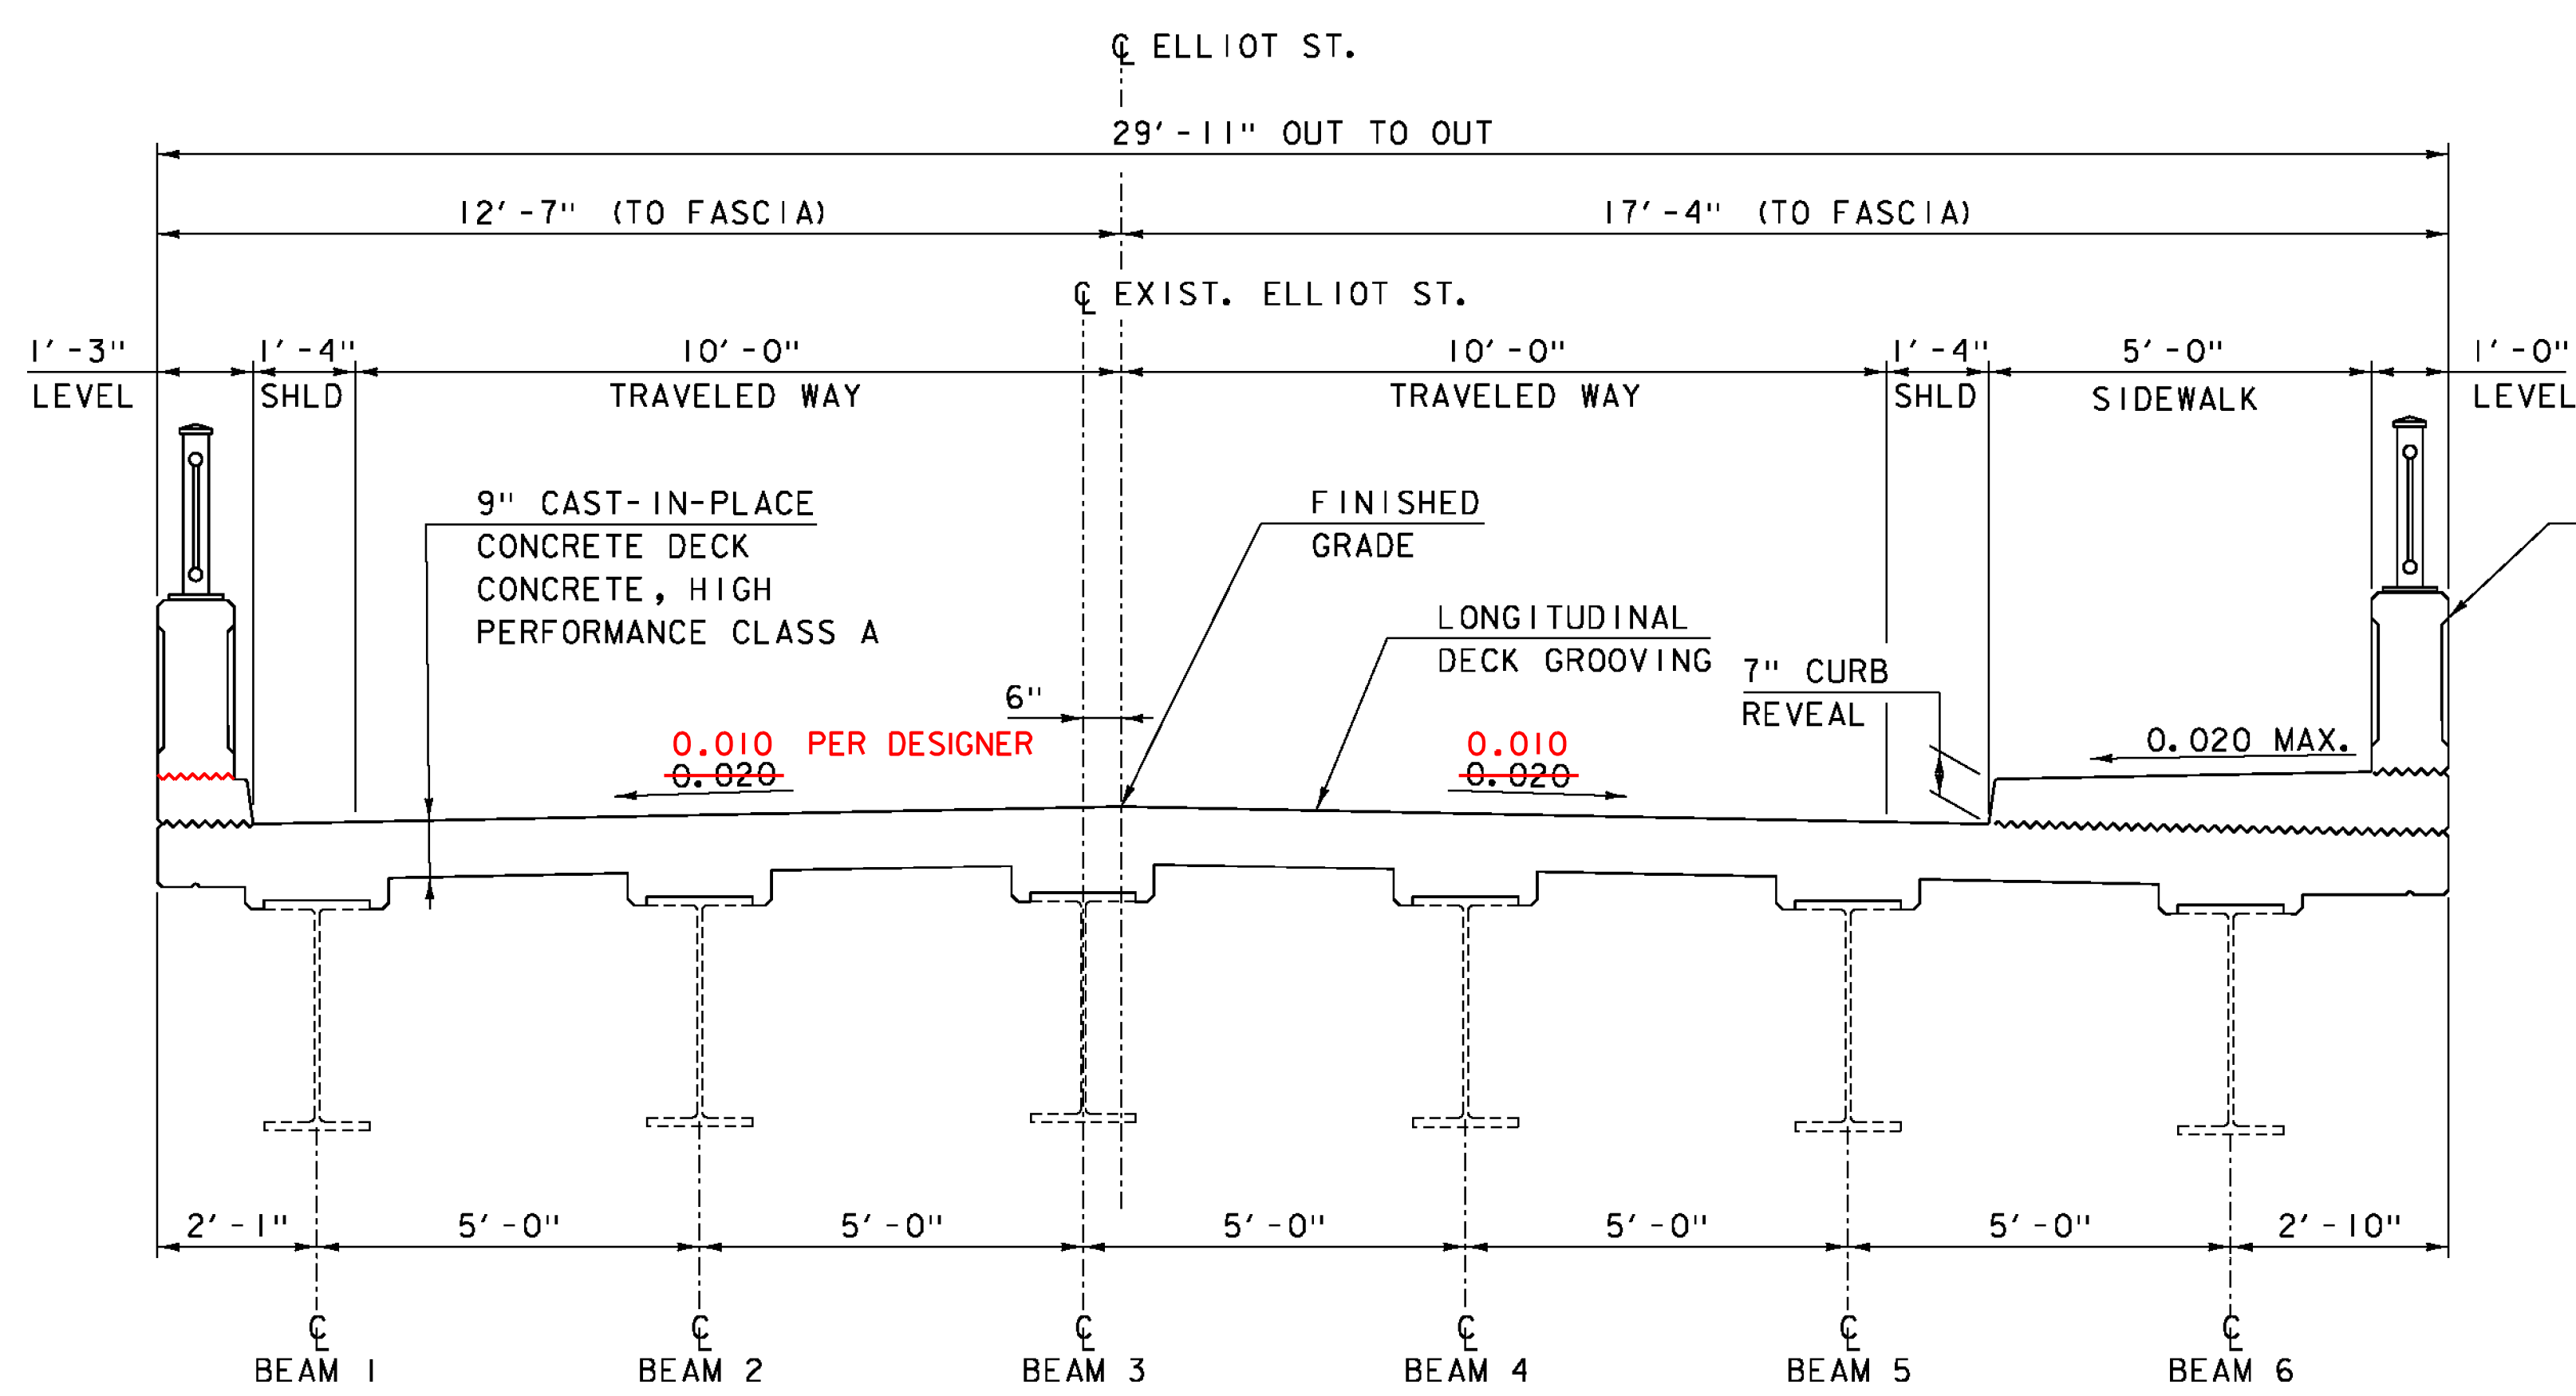

TYPICAL BRIDGE SECTION


SCALE: 1/2" = 1'-0"

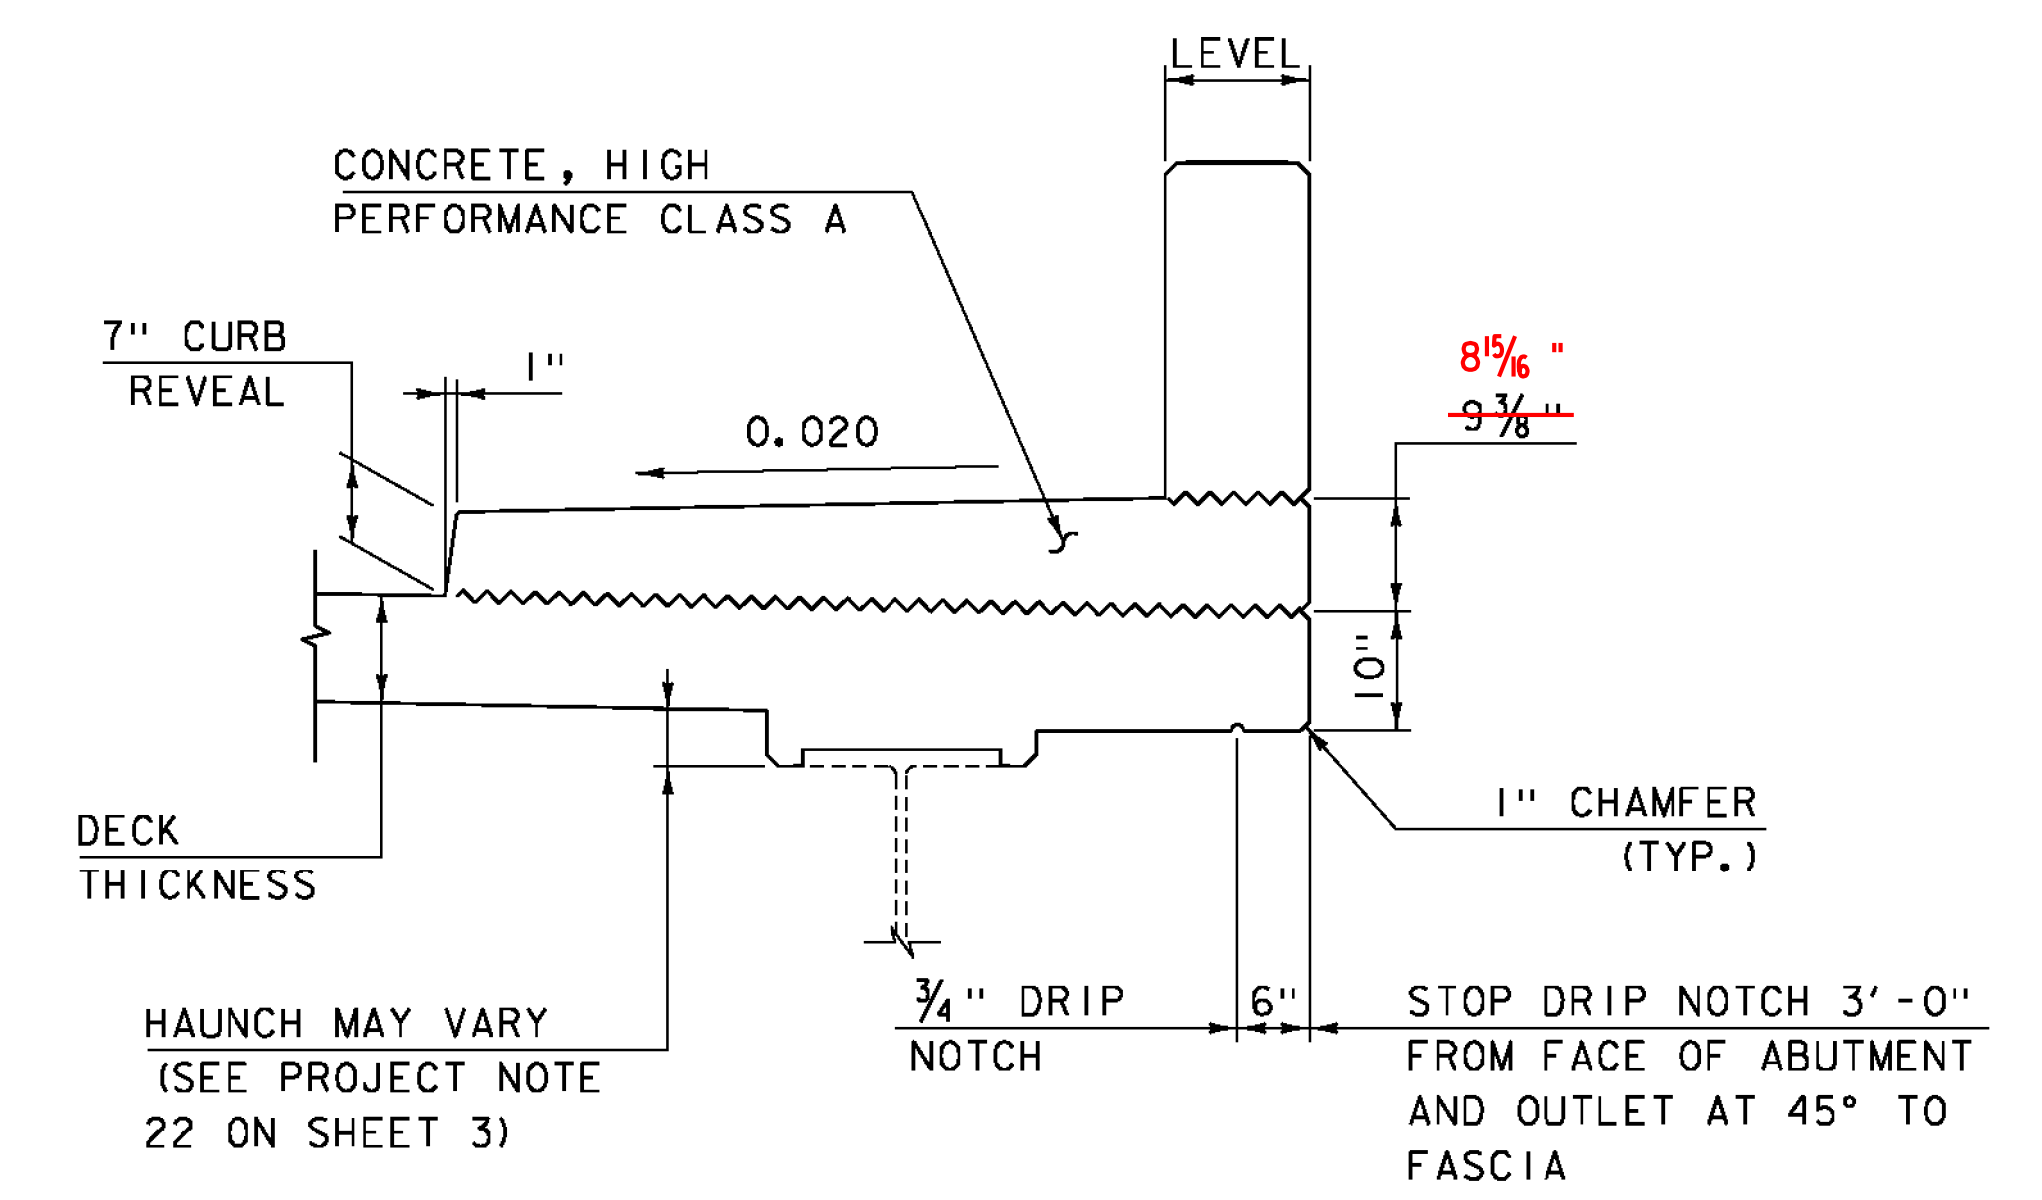

SIDEWALK FASCIA AND DRIP NOTCH DETAIL

SCALE: 3/4" = 1'-0"

CLD 15-0223 MODEL: TYPOL

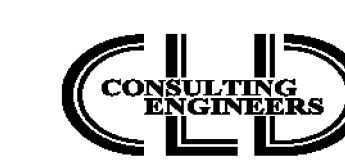

PROJECT NAME:	BRATTLEBORO	PLOT DATE:	2/5/2016
PROJECT NUMBER:	BF 2000(26)	DRAWN BY:	M. SMITH
FILE NAME:	z15j091typ-31.dgn	DESIGNED BY:	N. CARON
PROJECT LEADER:	J. BYATT	CHECKED BY:	S. BEAUMONT
TYPICALS BRIDGE SECTIONS SHEET		SHEET 4 OF 26	