


Release Number:				BAR LIST												
Bar Mark	Qty	Size	Total Length	Type	'A'	'B'	'C'	'D'	'E'	'F'	'G'	'H'	'J'	'K'	'O'	'R'
5CE01	6	#5	6'-0"	3		3'-0"	3'-0"						1'-11 1/2"		2'-3 1/2"	5'-3 1/2"
5CE02	6	#5	6'-9"			6'-9"										
5CE03	6	#5	23'-10"			23'-10"										
5CE04	40	#5	2'-0"			2'-0"										
5CE05	30	#5	24'-9"			24'-9"										
5CE06	40	#5	4'-2"			4'-2"										
5CE07	164	#5	4'-8"	17		2'-1"	0'-6"	2'-1"								
5CE08	32	#5	8'-10"	17		4'-2"	0'-6"	4'-2"								
5CE09	4	#5	5'-0"	T2	0'-6"	1'-0"	1'-0"	1'-0"	1'-0"		0'-6"					
5CE10	2	#5	5'-0"			5'-0"										

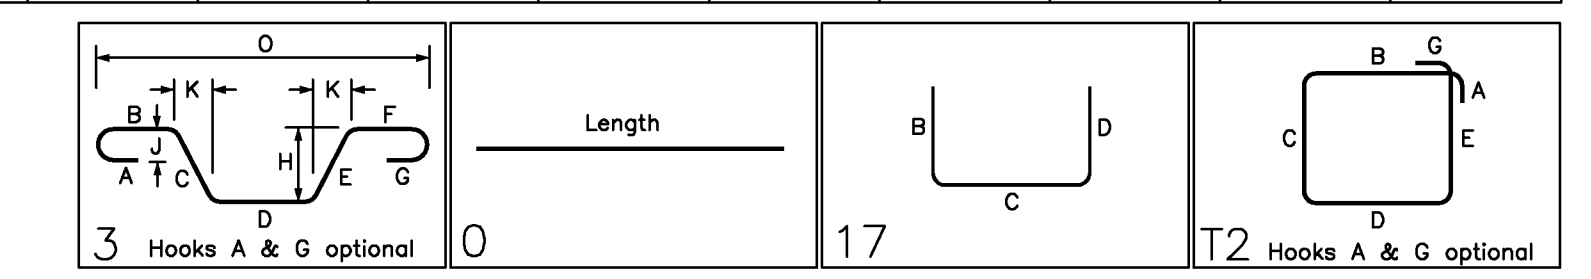

SHOP DRAWING REVIEW

REVIEWED AS REQUIRED BY THE CONSTRUCTION CONTRACT DOCUMENTS AND APPROVED, BUT ONLY FOR CONFORMANCE TO THE DESIGN CONCEPT OF THE WORK, AND SUBJECT TO FURTHER LIMITATIONS AND REQUIREMENTS CONTAINED IN THE CONSTRUCTION CONTRACT DOCUMENTS.

REJECTED REVISE AND RESUBMIT APPROVED AS NOTED

CORRECTIONS OR COMMENTS MADE ON THE SHOP DRAWINGS DURING THIS REVIEW DID NOT RELIEVE CONTRACTOR FROM COMPLIANCE WITH REQUIREMENTS OF THE DRAWINGS AND SPECIFICATIONS. THIS CHECK IS ONLY FOR REVIEW OF GENERAL CONFORMANCE WITH THE DESIGN CONCEPT OF THE PROJECT AND GENERAL COMPLIANCE WITH THE INFORMATION GIVEN IN THE CONTRACT DOCUMENTS. THE CONTRACTOR IS RESPONSIBLE FOR CONFIRMING AND CORRELATING ALL QUANTITIES AND DIMENSIONS, SELECTING FABRICATION PROCESSES AND TECHNIQUES OF CONSTRUCTION, COORDINATING THEIR WORK WITH THAT OF ALL OTHER TRADES, AND PERFORMING THEIR WORK IN A SAFE AND SATISFACTORY MANNER.

CLD Consulting Engineers
540 Commercial Street
Manchester, NH 03101
603-689-6223

Job Number: 150223
Reviewed by: SRB
Date: 06/30/2016

Vermont Agency of Transportation
RECEIVED
ON: June 29, 2016
and Checked for
CONFORMANCE
BY: Jennifer Fitch DATE: 06/29/16

ALL REINF. EPOXY

TEST BARS:
2 5CE10 #5 EPOXY COATED TEST BARS

LEGEND:
CONT.-CONTINUOUS
TRANS.-TRANSVERSE
LONG.-LONGITUDINAL
LAT.-LATITUDINAL
DWLS.-DOWELS
VERTS.-VERTICAL
HORIZ.-HORIZONTAL
T&B -TOP & BOTTOM
I.F.-INNER FACE
O.F.-OUTER FACE
E.E.-EACH END
E.F.-EACH FACE
F.F.-FRONT FACE
R.F.-REAR FACE
E.W.-EACH WAY
O.C.-ON CENTER
L.W.-LONG WAY
S.W.-SHORT WAY

FOR APPROVAL

ELEVATIONS & DIMENSIONS SHOWN ON THIS DWG. ARE FOR REINF. DETAILING PURPOSES ONLY AND ARE NOT INTENDED FOR DIMENSIONAL CONSTRUCTION.

EPOXY REINF. BARS ASTM A615 GRADE 60, MARKED (E)

VERIFICATION OF UNCLEAR INFORMATION MAY BE REQUESTED ON THIS DRAWING. SHOULD VERIFICATION BE LEFT UN-ADDRESSED IT WILL REMAIN AS SHOWN AND ASSUME TO BE CORRECT.

DATE	REV.	SENT FOR
6/27/16	1	REVISED AS NOTED/FOR APPROVAL
6/21/16	2	REVISED AS NOTED/FOR APPROVAL
6/13/16	1	FOR APPROVAL

DATE: 5/13/16 OFF # 9744

DIMENSION
DIMENSION FABRICATORS INC.
2000 7TH STREET
SCOTIA, N.Y. 12502
PH: (518) 374-1938
FAX: (518) 374-4830
www.dimensionfabricators.com

STRUCTURE: VTAOT BRATTLEBORO VF 2000(26)

LOCATION: ELLIOT ST. OVER WHETSTONE BROOK
BRATTLEBORO, VT

ARCHITECT: N/A

ENGINEER: CLD CONSULTING ENGINEERS

CUSTOMER: RENAUD BROS., INC.

DRAWING COVERS: DECK REINFORCING DETAIL
DRAWING #: C

