



STATE OF VERMONT AGENCY OF TRANSPORTATION

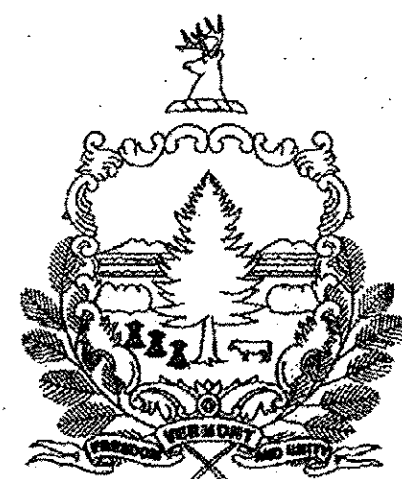

PROPOSED IMPROVEMENT BRIDGE PROJECT TOWN OF BRATTLEBORO COUNTY OF WINDHAM

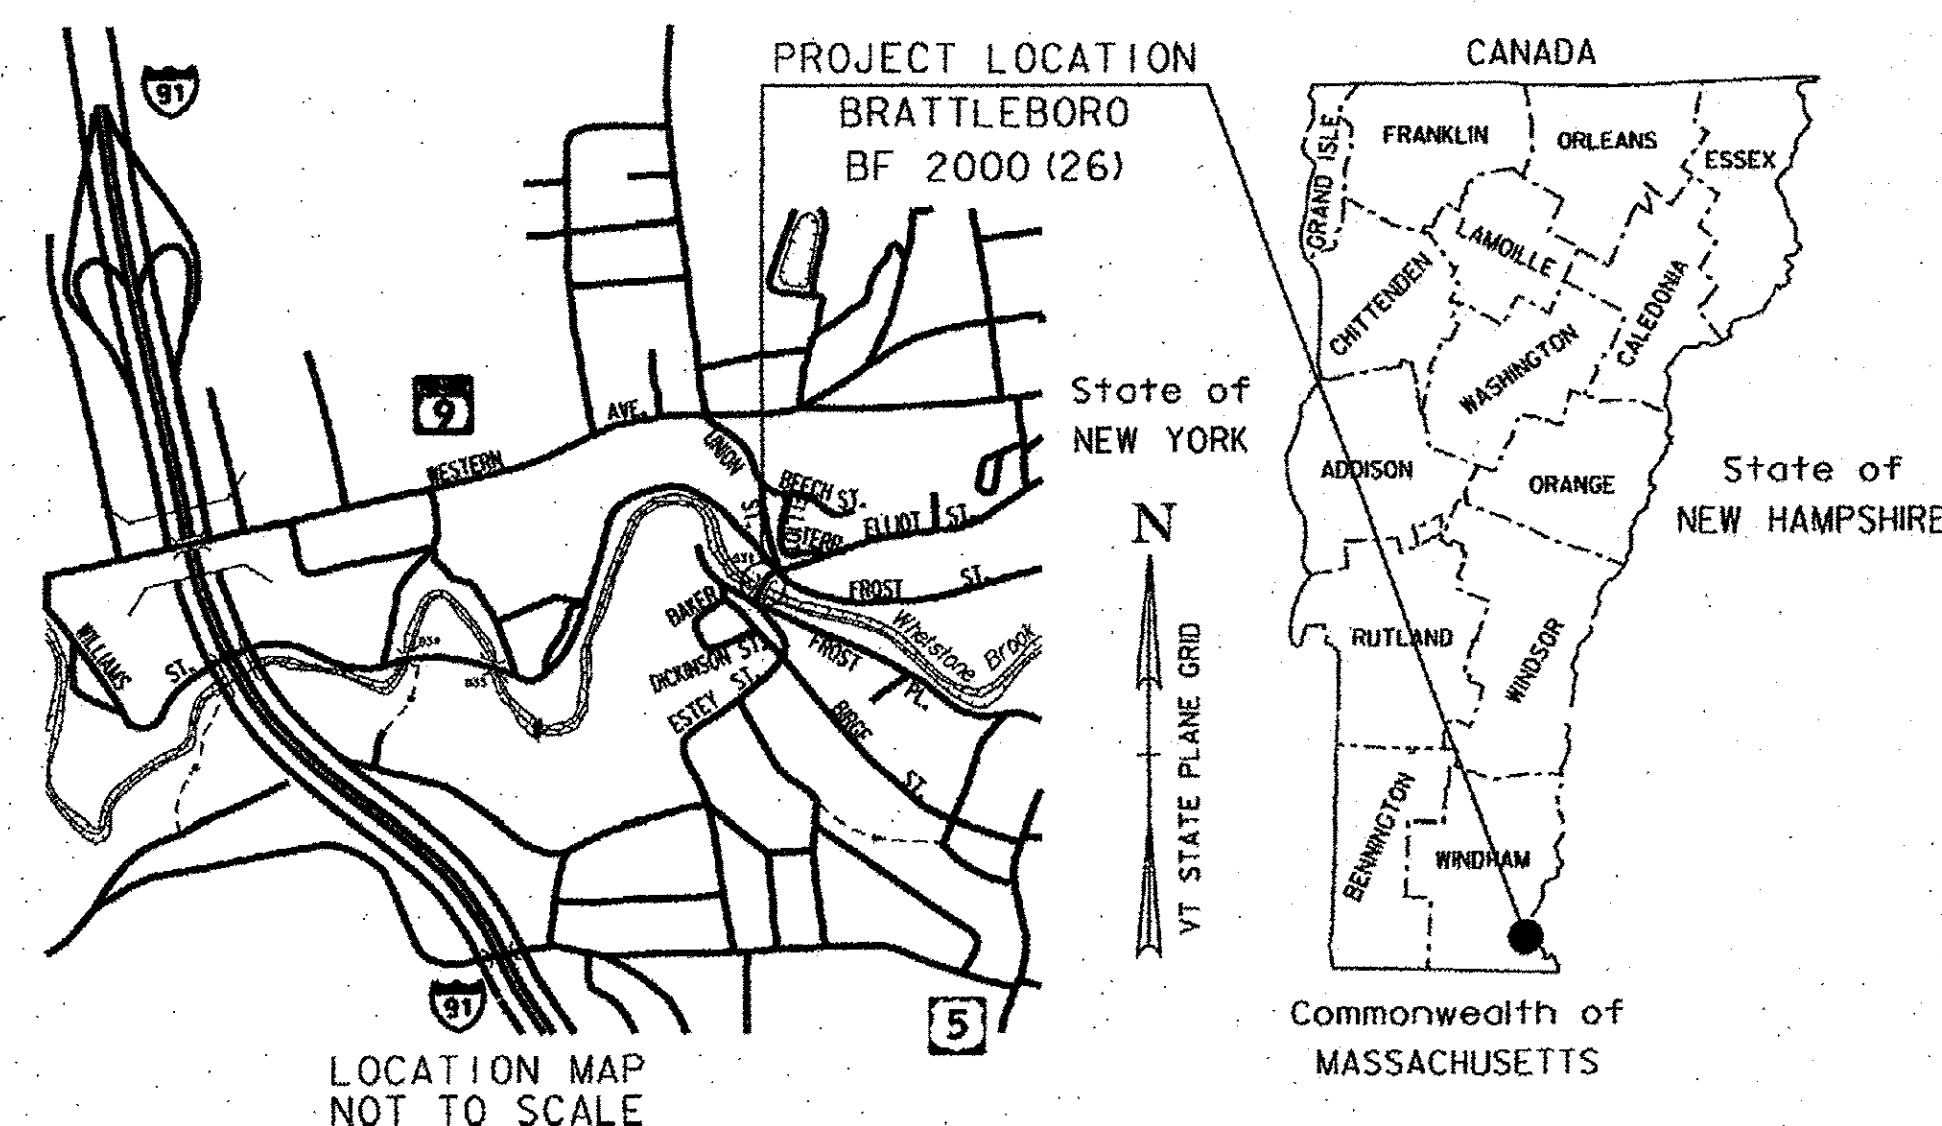


RECORD PLANS	
CONTRACTOR:	RENAUD BROTHERS, INC. - VERNON, VT
RESIDENT ENGINEER:	CHAD GREENWOOD
CONSTRUCTION BEGAN:	JUNE 21, 2016
CONSTRUCTION COMPLETE:	AUGUST 26, 2016
RECORD PLANS BY:	CHAD GREENWOOD & JESSE IVES
I HEREBY CERTIFY THAT ALL THE CONSTRUCTION REQUIRED BY THIS SET OF DRAWINGS HAS BEEN ACCOMPLISHED AS INDICATED HEREIN.	
BY	RESIDENT ENGINEER
DATE: 5/26/17	
NOTE: Any further information concerning final quantities, amounts or other details relative to this project may be found at Central Files in the electronic archives.	

ELLIOT ST (TH #446) (URBAN COLLECTOR) BRIDGE NO. 31

PROJECT LOCATION: LOCATED IN THE TOWN OF BRATTLEBORO, ON ELLIOT ST (TH #446), APPROXIMATELY 0.010 MILES EASTERLY FROM THE INTERSECTION WITH FROST PL (TH #434).

PROJECT DESCRIPTION: WORK TO BE PERFORMED UNDER THIS PROJECT INCLUDES THE REPLACEMENT OF THE EXISTING BRIDGE DECK INCLUDING RELATED APPROACH WORK.


LENGTH OF STRUCTURE: 90.00 FEET
LENGTH OF ROADWAY: 30.00 FEET
LENGTH OF PROJECT: 120.00 FEET

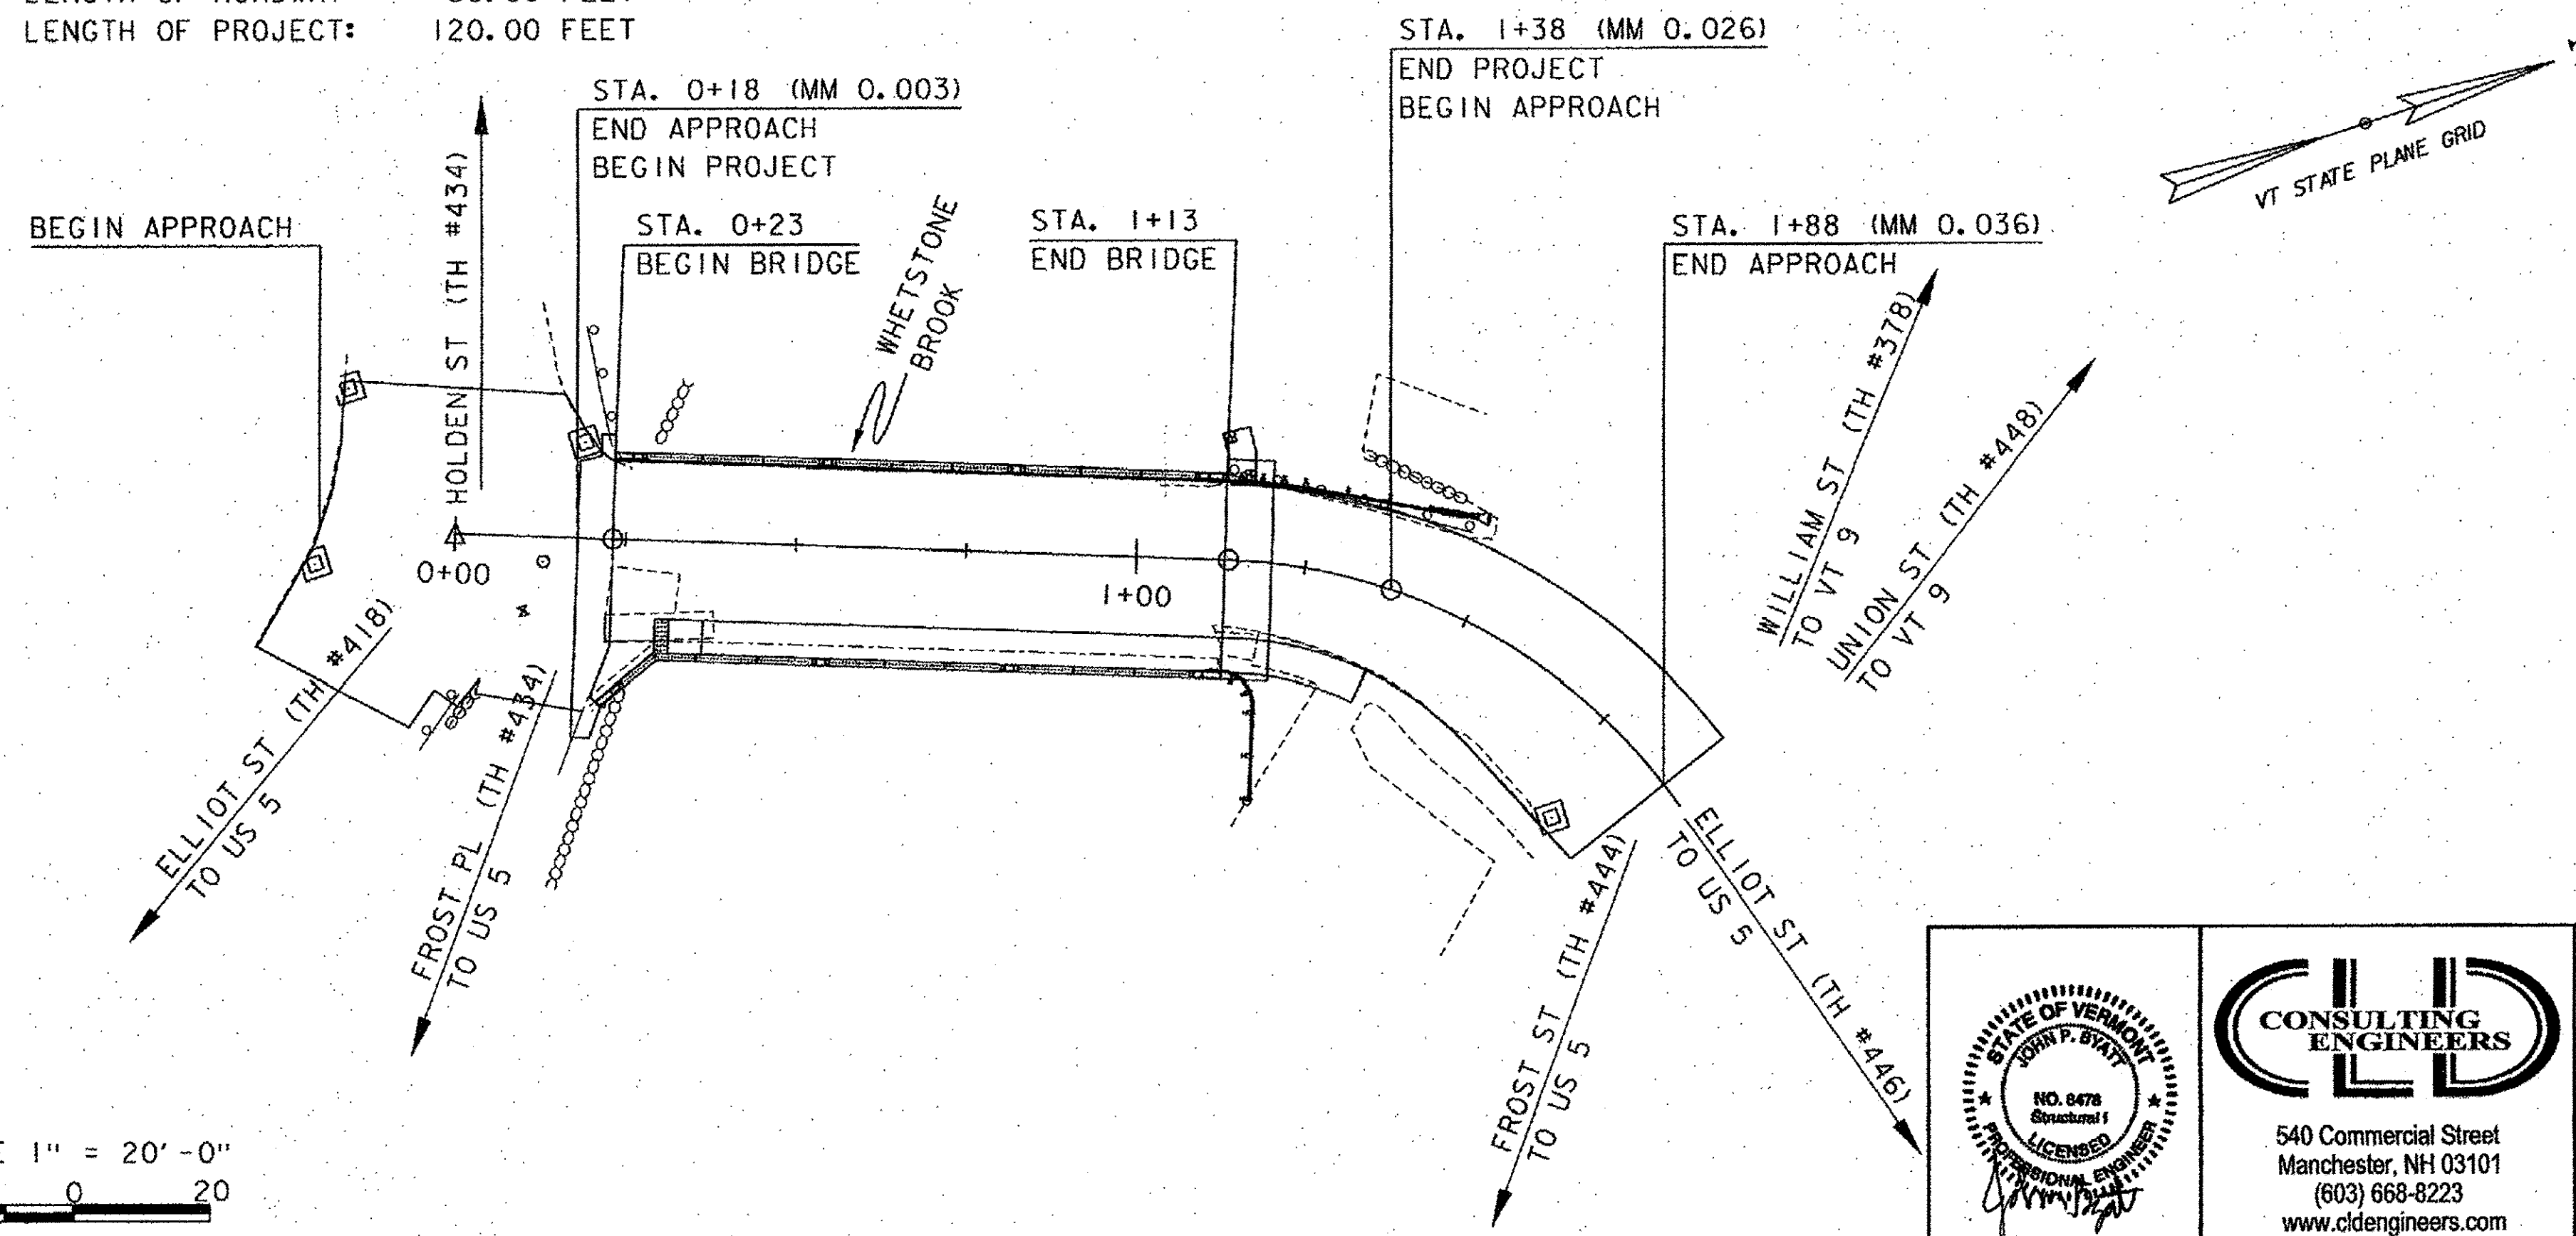

CONSTRUCTION IS TO BE CARRIED ON IN ACCORDANCE WITH THESE PLANS AND THE STANDARD SPECIFICATIONS FOR CONSTRUCTION DATED 2011, AS APPROVED BY THE FEDERAL HIGHWAY ADMINISTRATION ON JULY 20, 2011 FOR USE ON THIS PROJECT, INCLUDING ALL SUBSEQUENT REVISIONS AND SUCH REVISED SPECIFICATIONS AND SPECIAL PROVISIONS AS ARE INCORPORATED IN THESE PLANS.

QUALITY ASSURANCE PROGRAM : LEVEL 2	
SURVEYED BY :	CLD
SURVEYED DATE :	09/21/2015
DATUM	
VERTICAL	NAVD 88
HORIZONTAL	NAD 83

SCALE 1" = 20'-0"

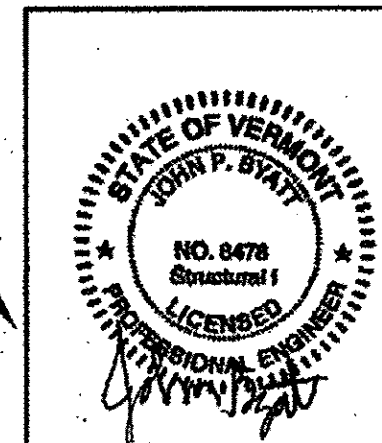

540 Commercial Street
Manchester, NH 03101
(603) 668-8223
www.cldengineers.com

DIRECTOR OF PROJECT DELIVERY	
APPROVED	DATE 2/4/2016
PROJECT MANAGER : JENNIFER FITCH, P.E.	
PROJECT NAME :	BRATTLEBORO
PROJECT NUMBER :	BF 2000 (26)
SHEET 1 OF 26 SHEETS	

INDEX OF SHEETS

- 1. TITLE SHEET
- 2.-3. INDEX OF SHEETS AND PROJECT NOTES SHEETS 1-2
- 4. TYPICALS BRIDGE SECTIONS SHEET
- 5. TYPICAL ROADWAY SECTIONS SHEET
- 6.-7. QUANTITY SHEETS 1-2
- 8. CONVENTIONAL SYMBOLOGY LEGEND SHEET
- 9. LAYOUT SHEET
- 10. PROFILE SHEET
- 11. BRIDGE CLOSURE SIGNAGE SHEET
- 12. SHEAR CONNECTOR DETAILS SHEET
- 13.-14. DECK DETAILS SHEETS 1-2
- 15.-16. REMOVAL AND CURTAIN WALL DETAILS SHEETS 1-2
- 17. JOINT DETAILS SHEET
- 18. RAIL LAYOUT SHEET
- 19.-22. BRIDGE RAIL DETAILS SHEETS 1-4
- 23. APPROACH RAIL DETAILS SHEET
- 24.-26. REFERENCE PLAN SHEETS 1-3

STRUCTURE DETAIL SHEETS

- SD-501.00 02/09/2012 CONCRETE DETAILS AND NOTES
- SD-502.00 10/10/2012 CONCRETE DETAILS AND NOTES
- SD-516.10 08/29/2011 BRIDGE JOINT ASPHALTIC PLUG
- SD-601.00 06/04/2010 STRUCTURAL STEEL DETAILS & NOTES

HIGHWAY SAFETY AND DESIGN DETAIL SHEETS

- HSD-621.06 11/03/2015 GUARDRAIL TERMINAL LABEL DETAIL

VAOT STANDARD SHEETS

- B-5 06/1/1994 EMBANKMENT ON EARTH SLOPE, EMBANKMENT ON ROCK SLOPE, MUCK EXCAVATION, TYPICAL SLOPE ROUNDING
- B-71 07/08/2005 STANDARDS FOR RESIDENTIAL AND COMMERCIAL DRIVES
- C-3A 03/10/2008 SIDEWALK RAMPS
- D-3 06/01/1994 TREATED GUTTERS
- E-193 08/18/1995 PAVEMENT MARKING DETAILS
- G-1 11/10/2015 STEEL BEAM GUARDRAIL WITH STEEL POSTS, STEEL BEAM GUARDRAIL WITH WOOD POSTS
- G-1d 02/10/2014 STEEL BEAM GUARDRAIL APPROACH END TERMINAL, STEEL BEAM GUARDRAIL TRAILING END TERMINAL
- T-1 08/06/2012 TRAFFIC CONTROL GENERAL NOTES
- T-11 08/06/2012 CONSTRUCTION APPROACH SIGNING DIVIDED HIGHWAY ONE LANE CLOSED
- T-31 08/06/2012 CONSTRUCTION SIGN DETAILS
- T-42 04/09/2014 BRIDGE NUMBER PLAQUE
- T-44 04/09/2014 MILEMARKER DETAILS STATE AND TOWN HIGHWAYS

LRFR LOAD RATING FACTORS							
LOADING LEVELS	TRUCK						
	H-20	HL-93	3S2	6 AXLE	3A. STR.	4A. STR.	5A. SEMI
TONNAGE	20	36	36	66	30	34.5	38
INVENTORY	1.60	1.01					
POSTING							
OPERATING	2.07	1.32	2.68	1.75	2.46	2.21	2.33
COMMENTS:	H-20 CONTROLLED BY DECK, HL-93 AND OTHER TRUCKS CONTROLLED BY EXTERIOR BEAMS SERVICE II						

PROJECT NOTES

GENERAL

- 1. ALL MATERIALS AND CONSTRUCTION SHALL CONFORM TO STATE OF VERMONT, AGENCY OF TRANSPORTATION, 2011 STANDARD SPECIFICATIONS FOR CONSTRUCTION, AND ITS LATEST REVISIONS, AND THE AASHTO LRFD BRIDGE DESIGN SPECIFICATIONS, DATED 2014, AND ITS LATEST REVISIONS.
- 2. THE DESIGN LIVE LOAD SHALL BE HL-93.
- 3. ALL WORK AND ANY ASSOCIATED ACTIVITY ON THIS PROJECT SHALL BE PERFORMED WITHIN THE EXISTING RIGHT-OF-WAY LIMITS.
- 4. THE CONTRACTOR IS MADE AWARE THAT EXISTING UTILITIES ARE WITHIN THE CONSTRUCTION LIMITS OF BRIDGE NO. 31. THE LOCATION OF ANY UTILITY INFORMATION ON THE PLANS IS APPROXIMATE. NO CLAIMS ARE MADE TO THE ACCURACY OR COMPLETENESS OF THE UTILITIES SHOWN. THE CONTRACTOR IS SOLELY RESPONSIBLE FOR LOCATING AND PROTECTING FROM DAMAGE ALL UTILITIES ON SITE DURING ALL STAGES OF CONSTRUCTION. ANY DAMAGE TO UTILITIES DUE DIRECTLY TO THE CONTRACTOR'S OPERATIONS SHALL BE REPAIRED AS DIRECTED BY THE ENGINEER AT NO ADDITIONAL COST TO THE STATE. SEE SPECIAL PROVISIONS FOR ADDITIONAL INFORMATION AND REQUIREMENTS.
- 5. FOLLOWING THE COMPLETION OF ALL OTHER CONSTRUCTION ACTIVITIES, ALL BEAM SEATS SHALL BE CLEANED OFF. THE COST FOR CLEANING BEAM SEATS WILL BE CONSIDERED INCIDENTAL TO ALL OTHER ITEMS IN THE CONTRACT.
- 6. ALL PG BINDER USED IN BITUMINOUS CONCRETE PAVEMENT SHALL BE IN ACCORDANCE WITH SUBSECTION 490.03B.
- 7. EMULSIFIED ASPHALT SHALL BE APPLIED ON ALL COLD PLANED SURFACES AT THE RATE OF 0.08 GAL/SY AND BETWEEN ALL COURSE OF PAVEMENT AT THE RATE OF 0.040 GAL/SY OR AS DIRECTED BY THE ENGINEER. PAYMENT WILL BE CONSIDERED INCIDENTAL TO ITEM 900.680, "SPECIAL PROVISION (BITUMINOUS CONCRETE PAVEMENT, SMALL QUANTITY)".
- 8. ANY REQUIRED SAWCUT OF EXISTING PAVEMENT WILL BE CONSIDERED INCIDENTAL TO ITEM 900.680, "SPECIAL PROVISION (BITUMINOUS CONCRETE PAVEMENT, SMALL QUANTITY)".
- 9. ANY DAMAGE TO PRIVATE OR PUBLIC PROPERTY DUE DIRECTLY TO THE CONTRACTOR'S OPERATIONS SHALL BE REPAIRED AS DIRECTED BY THE ENGINEER AT NO ADDITIONAL COST TO THE STATE.
- 10. LIMITS OF GROUND SURVEY ARE BETWEEN STA 0+00 AND STA 1+84. OUTSIDE THESE LIMITS ARE APPROXIMATE LOCATION TAKEN FROM AERIAL MAPPING.

ENVIRONMENTAL

- 11. THE CONTRACTOR SHALL REVIEW AND UNDERSTAND ALL APPLICABLE ENVIRONMENTAL PERMITS AND ENSURE THAT ALL CONSTRUCTION CONDITIONS ARE MET.
- 12. EROSION CONTROL MEASURES SHALL BE UTILIZED AS REQUIRED AND SHALL CONFORM TO SECTION 105 OF THE STANDARD SPECIFICATIONS AND THE LOW RISK SITE HANDBOOK FOR EROSION PREVENTION AND SEDIMENT CONTROL FROM THE AGENCY OF NATURAL RESOURCES. PAYMENT FOR EROSION CONTROL MEASURES, IF APPLICABLE, WILL BE PAID FOR UNDER EXTRA WORK IN ACCORDANCE WITH 104.03.
- 13. THE CONTRACTOR SHALL PREVENT ANY MATERIAL FROM ENTERING THE WATERWAY DURING EXCAVATION, PARTIAL REMOVAL OF STRUCTURE, OR CONSTRUCTING THE NEW DECK.
- 14. THE DESIGN INTENT IS TO ALLOW THE CONTRACTOR TO STAGE IN THE TRAVELED ROADWAY OF THE APPROACHES TO THE BRIDGE DURING THE CLOSURE PERIOD. ANY STAGING AREAS OUTSIDE OF THIS SHALL BE CLEARED FOR RESOURCES THROUGH THE VTRANS ENVIRONMENTAL UNIT.

TRAFFIC CONTROL

- 15. AS PART OF ITEM 900.645, "SPECIAL PROVISION (TRAFFIC CONTROL, ALL INCLUSIVE)", THE CONTRACTOR SHALL SUBMIT A SITE SPECIFIC TRAFFIC CONTROL PLAN TO THE PROJECT MANAGER FOR APPROVAL IN ACCORDANCE WITH SUBSECTION 105.03 AND SHALL BE STAMPED BY A PROFESSIONAL ENGINEER LICENSED IN AN APPROPRIATE DISCIPLINE IN THE STATE OF VERMONT. THE PLAN SHALL INCLUDE A LAYOUT SHOWING ALL ON- AND OFF-PROJECT SIGNS AND BARRICADES AND ANY OTHER DETAILS ASSOCIATED WITH THE TRAFFIC CONTROL.
- 16. ALL ITEMS REQUIRED TO PREPARE, SUBMIT, AND IMPLEMENT THE CONTRACTOR'S PLAN, INCLUDING ANY NECESSARY REVISIONS TO THE PLAN, WILL BE INCLUDED IN THE UNIT BID PRICE FOR ITEM 900.645, "SPECIAL PROVISION (TRAFFIC CONTROL, ALL-INCLUSIVE)". THE PAY ITEM INCLUDES, BUT IS NOT LIMITED TO, THE FOLLOWING:

TRAFFIC CONTROL PLAN
 TEMPORARY TRAFFIC BARRIERS
 BARRICADES
 DRUMS/CONES
 ON PROJECT CONSTRUCTION SIGNING
 TEMPORARY PAVEMENT MARKINGS (IF REQUIRED)
 REMOVE AND RESET TRAFFIC BARRIER

TRAFFIC CONTROL ITEMS NOT PAID FOR IN THE UNIT PRICE BID FOR ITEM 900.645, "SPECIAL PROVISION (TRAFFIC CONTROL, ALL-INCLUSIVE)", AND PAID FOR SEPARATELY INCLUDE THE FOLLOWING:

ITEM 630.10, "UNIFORMED TRAFFIC OFFICERS"
 ITEM 630.15, "FLAGGERS"
 ITEM 641.15, "PORTABLE CHANGEABLE MESSAGE SIGN"

THE CONTRACTOR SHALL ALLOW TWO WEEKS FOR APPROVAL OF THE TRAFFIC CONTROL PLAN. NO WORK SHALL COMMENCE UNTIL THE CONTRACTOR HAS AN APPROVED TRAFFIC CONTROL PLAN.

THE EXISTING CONCRETE TRAFFIC BARRIER ADJACENT TO THE BRIDGE IS TOWN OWNED AND SHALL BE REMOVED TO ACCOMMODATE BRIDGE WORK AND RESET ONCE THE BRIDGE WORK IS COMPLETED. SEE LAYOUT PLAN ON SHEET 9. THE CONTRACTOR SHALL CONTACT PUBLIC WORKS DIRECTOR STEVE BARRETT AT 1-802-254-4255 WITH ANY QUESTIONS. THIS WORK WILL BE INCLUDED IN THE UNIT BID PRICE FOR ITEM 900.645, "SPECIAL PROVISION (TRAFFIC CONTROL, ALL-INCLUSIVE)" AS NOTED ABOVE. ANY DAMAGE TO THE TRAFFIC BARRIER DUE DIRECTLY TO THE CONTRACTOR'S OPERATIONS SHALL BE REPAIRED OR REPLACED AS DIRECTED BY THE ENGINEER AT NO ADDITIONAL COST TO THE STATE OR OWNER.

- 17. DURING CLOSURE PERIOD, TRAFFIC SHALL BE MAINTAINED BY AN OFF-SITE DETOUR TO BE SIGNED BY THE TOWN OF BRATTLEBORO. THE CONTRACTOR SHALL BE RESPONSIBLE FOR PROVIDING CLOSURE SIGNAGE AS SHOWN ON SHEET 11 IN ACCORDANCE WITH THE LATEST EDITION OF THE MUTCD AND VTRANS STANDARDS. PAYMENT FOR BRIDGE CLOSURE SIGNAGE WILL BE MADE UNDER ITEM 900.645, "SPECIAL PROVISION (TRAFFIC CONTROL, ALL-INCLUSIVE)". ANY COORDINATION REQUIRED BETWEEN THE CONTRACTOR AND THE TOWN OF BRATTLEBORO WILL BE AT NO ADDITIONAL COST TO THE STATE. SEE THE SPECIAL PROVISIONS FOR ADDITIONAL INFORMATION AND REQUIREMENTS REGARDING THE CLOSURE PERIOD.

PROJECT NAME: BRATTLEBORO
 PROJECT NUMBER: BF 2000(26)

FILE NAME: z15J09Inotes-31.dgn PLOT DATE: 3/8/2016
 PROJECT LEADER: J. BYATT DRAWN BY: M. SMITH
 DESIGNED BY: S. BEAUMONT CHECKED BY: J. FRENCH
 INDEX OF SHEETS & PROJECT NOTES SHEET 1 SHEET 2 OF 26



DECK REMOVAL AND RELATED ITEMS

18. PAVEMENT REMOVAL SHOULD BE LIMITED AS SHOWN ON THE PLANS. THIS WORK SHALL BE IN ACCORDANCE WITH SECTION 529 OF THE STANDARD SPECIFICATIONS.
19. ITEM 529.20, "PARTIAL REMOVAL OF STRUCTURE" WILL INCLUDE REMOVAL OF ANY PORTIONS OF THE EXISTING STRUCTURE AS SHOWN ON THE PLANS, INCLUDING THE EXISTING BRIDGE DECK, CURTAIN WALLS, WINGWALLS, AND BRIDGE RAILING. THE EXISTING CONCRETE CURTAIN WALLS AND WINGWALLS SHALL BE REMOVED BY MECHANICAL MEANS AND THE REMAINING CONCRETE SHALL HAVE NEAT LINES AND BE SMOOTH. PROTECT ALL ELEMENTS INTENDED TO REMAIN.
20. DURING EXCAVATION OF BRIDGE CURTAIN WALL, ALL DRAINAGE STRUCTURES AND PIPES SHALL BE SUPPORTED AND SHALL REMAIN IN-PLACE. PAYMENT FOR SUPPORTING DRAINAGE STRUCTURES WILL BE CONSIDERED INCIDENTAL TO 203.15, "COMMON EXCAVATION".
21. AFTER REMOVAL OF THE EXISTING BRIDGE DECK AND CURTAIN WALL, ANY AREAS ON THE CONCRETE BEAM SEAT THAT ARE FOUND TO BE UNSOUND SHALL BE BROUGHT TO THE ATTENTION OF THE ENGINEER. THE METHOD FOR DETERMINING AREAS OF UNSOUND CONCRETE SHALL BE APPROVED BY THE ENGINEER. THE ENGINEER SHALL MAKE A DETERMINATION AS TO HOW TO REPAIR THE DETERIORATED PORTION OF THE CONCRETE BEAM SEAT AND THE LIMITS OF THE REPAIR. THE REPAIRS WILL BE PAID FOR UNDER ITEM 580.13, "REPAIR OF CONCRETE SUBSTRUCTURE SURFACE, CLASS I" OR ITEM 580.14, "REPAIR OF CONCRETE SUBSTRUCTURE SURFACE, CLASS II, AS APPLICABLE. QUANTITIES FOR ITEMS 580.13 AND 580.14 AS SHOWN ON THE QUANTITY SUMMARY SHEETS ARE ESTIMATED.

STEEL

22. AFTER ALL PAVEMENT AND MEMBRANE ARE REMOVED BUT PRIOR TO THE REMOVAL OF THE EXISTING CONCRETE DECK, THE CONTRACTOR SHALL TAKE TOP OF DECK ELEVATIONS ALONG THE CENTERLINE OF EACH BEAM AT TENTH POINTS FROM CENTERLINE TO CENTERLINE OF BEARING. AFTER THE EXISTING CONCRETE DECK HAS BEEN REMOVED, THE CONTRACTOR SHALL TAKE ELEVATIONS ALONG THE TOP OF EACH BEAM AT TENTH POINTS FROM CENTERLINE TO CENTERLINE OF BEARING. THE TOP OF DECK AND TOP OF BEAM ELEVATIONS SHALL THEN BE SENT TO THE ENGINEER FOR USE IN DETERMINING THE FINAL PROFILE AND HAUNCH DEPTHS. THE CONTRACTOR SHALL EXPECT 3 WORKING DAYS FOR VTRANS TO PREPARE THE REVISED PROFILE AND HAUNCH DEPTH CALCULATIONS.
23. THE EXISTING STRUCTURAL STEEL IS PAINTED WITH A MATERIAL THAT MAY CONTAIN LEAD. THE CONTRACTOR SHALL FOLLOW ALL APPLICABLE REGULATIONS WHEN HANDLING AND WORKING WITH THIS STEEL. ANY REMOVED STRUCTURAL STEEL, IF APPLICABLE, IS THE PROPERTY OF THE CONTRACTOR. THE CONTRACTOR SHALL INDEMNIFY AND HOLD THE STATE AND ITS OFFICERS AND EMPLOYEES HARMLESS CONCERNING THE CONTRACTOR'S USE OR DISPOSITION OF THE REMOVED EXISTING STRUCTURAL STEEL.
24. UPON REMOVING THE DECK, THE TOPS OF THE BEAMS IN THE AREA OF THE SHEAR STUDS SHALL BE CLEANED IN ACCORDANCE WITH SSPC-SPII REQUIREMENTS AND ALL APPLICABLE PROVISIONS PRIOR TO THE WELDING OF THE SHEAR STUDS. THE CONTRACTOR IS NOT REQUIRED TO APPLY NEW PAINT. THIS WORK WILL BE CONSIDERED INCIDENTAL TO ITEM 529.20, "PARTIAL REMOVAL OF STRUCTURE", EXCEPT AS NOTED IN PROJECT NOTE 25.
25. THE CONTRACTOR SHALL TEST ALL AREAS WHERE EXISTING PAINT IS TO BE REMOVED FOR LEAD. PAYMENT FOR LEAD PAINT TESTING WILL BE CONSIDERED INCIDENTAL TO ITEM 529.20, "PARTIAL REMOVAL OF STRUCTURE". IF LEAD PAINT REMOVAL IS REQUIRED, PAINT REMOVAL, SURFACE PREPARATION, CONTAINMENT, AND DISPOSAL WILL BE PAID FOR AS EXTRA WORK IN ACCORDANCE WITH 104.03. THE CONTRACTOR SHALL OBTAIN AND COMPLY WITH ALL NECESSARY LEAD ABATEMENT PERMITS.
26. THE SHEAR CONNECTORS SHALL BE SPACED AS SHOWN ON THE PLANS AND WILL BE PAID FOR UNDER ITEM 508.15, "SHEAR CONNECTORS (1266 - 8" X 7/8)".

REINFORCED CONCRETE


27. ALL CONCRETE SHALL CONFORM TO THE SPECIFICATIONS FOR CONCRETE, HIGH PERFORMANCE CLASS A. THE CONTRACTOR SHALL PROVIDE TESTING EQUIPMENT FOR CONCRETE IN ACCORDANCE WITH SUBSECTION 631.05.
28. A REINFORCING STEEL SCHEDULE AND SHOP DRAWINGS MEETING THE REQUIREMENTS OF SUBSECTION 105.03 SHALL BE SUBMITTED. PAYMENT FOR THIS WORK WILL BE CONSIDERED INCIDENTAL TO ITEM 507.11, "REINFORCING STEEL, LEVEL I" OR TO ITEM 900.640 "SPECIAL PROVISION (BRIDGE RAILING, GALVANIZED METAL HAND RAILING/CONCRETE PARAPET COMBINATION)", AS APPLICABLE. ALL REINFORCING STEEL SHALL BE LEVEL I - EPOXY COATED AND MEET THE REQUIREMENTS OF SECTION 507.
29. TEST BARS SHALL BE PROVIDED IN ACCORDANCE WITH THE "VERMONT AGENCY OF TRANSPORTATION MATERIAL SAMPLING MANUAL" AVAILABLE ON THE AGENCY WEBSITE. A MINIMUM OF TWO TEST SECTIONS ARE REQUIRED FOR EACH SIZE, BRAND, AND GRADE OR TYPE OF REINFORCING. SEE THE MANUAL FOR ACCEPTABLE DIMENSIONS OF TEST SECTIONS. EXTRA BARS FOR TESTING PURPOSES SHALL BE SPECIFIED IN THE WORKING DRAWING SUBMITTAL.
30. ALL BEAM SEATS SHALL BE CLEANED OFF AND WATER REPELLENT, SILANE SHALL BE APPLIED TO ALL EXPOSED CONCRETE SURFACES EXCEPT THE UNDERSIDE OF THE DECK BETWEEN THE DRIP NOTCHES. THIS WORK, INCLUDING CLEANING OF BEAM SEATS, WILL BE PAID FOR UNDER ITEM 514.10, "WATER REPELLENT, SILANE".
31. THE CORK JOINT BETWEEN THE EXISTING CHEEKWALLS AND CAST-IN-PLACE CONCRETE CURTAIN WALL WILL BE CONSIDERED INCIDENTAL TO ITEM 501.33, "CONCRETE, HIGH PERFORMANCE CLASS A".
32. THE PREFORMED JOINT SEALER, CLOSED CELL FOAM BETWEEN THE CAST-IN-PLACE CONCRETE CURTAIN WALL AND THE EXISTING BRIDGE SEAT SHALL MEET THE REQUIREMENTS OF SUBSECTION 707.09 AND WILL BE CONSIDERED INCIDENTAL TO ITEM 501.33, "CONCRETE, HIGH PERFORMANCE CLASS A".
33. ALL REINFORCING STEEL SHALL BE DETAILED AND FABRICATED USING PROCEDURES AND TOLERANCES IN ACCORDANCE WITH APPLICABLE PUBLICATIONS OF THE "CONCRETE REINFORCING INSTITUTE".
34. MINIMUM CLEAR COVER FOR REINFORCING STEEL SHALL BE AS FOLLOWS:

ALONG BACK FACES OF WALL AGAINST EARTH:	2.0 INCH
ALONG TOP SURFACE OF DECK SLAB:	3.0 INCH
ALONG BOTTOM SURFACE OF DECK SLAB:	1.5 INCH
ELSEWHERE UNLESS OTHERWISE INDICATED:	3.0 INCH



PROJECT NAME: BRATTLEBORO
PROJECT NUMBER: BF 2000(26)


FILE NAME: z15J09Inotes-31.dgn PLOT DATE: 3/8/2016
PROJECT LEADER: J. BYATT DRAWN BY: M. SMITH
DESIGNED BY: S. BEAUMONT CHECKED BY: J. FRENCH
INDEX OF SHEETS & PROJECT NOTES SHEET 2 SHEET 3 OF 26

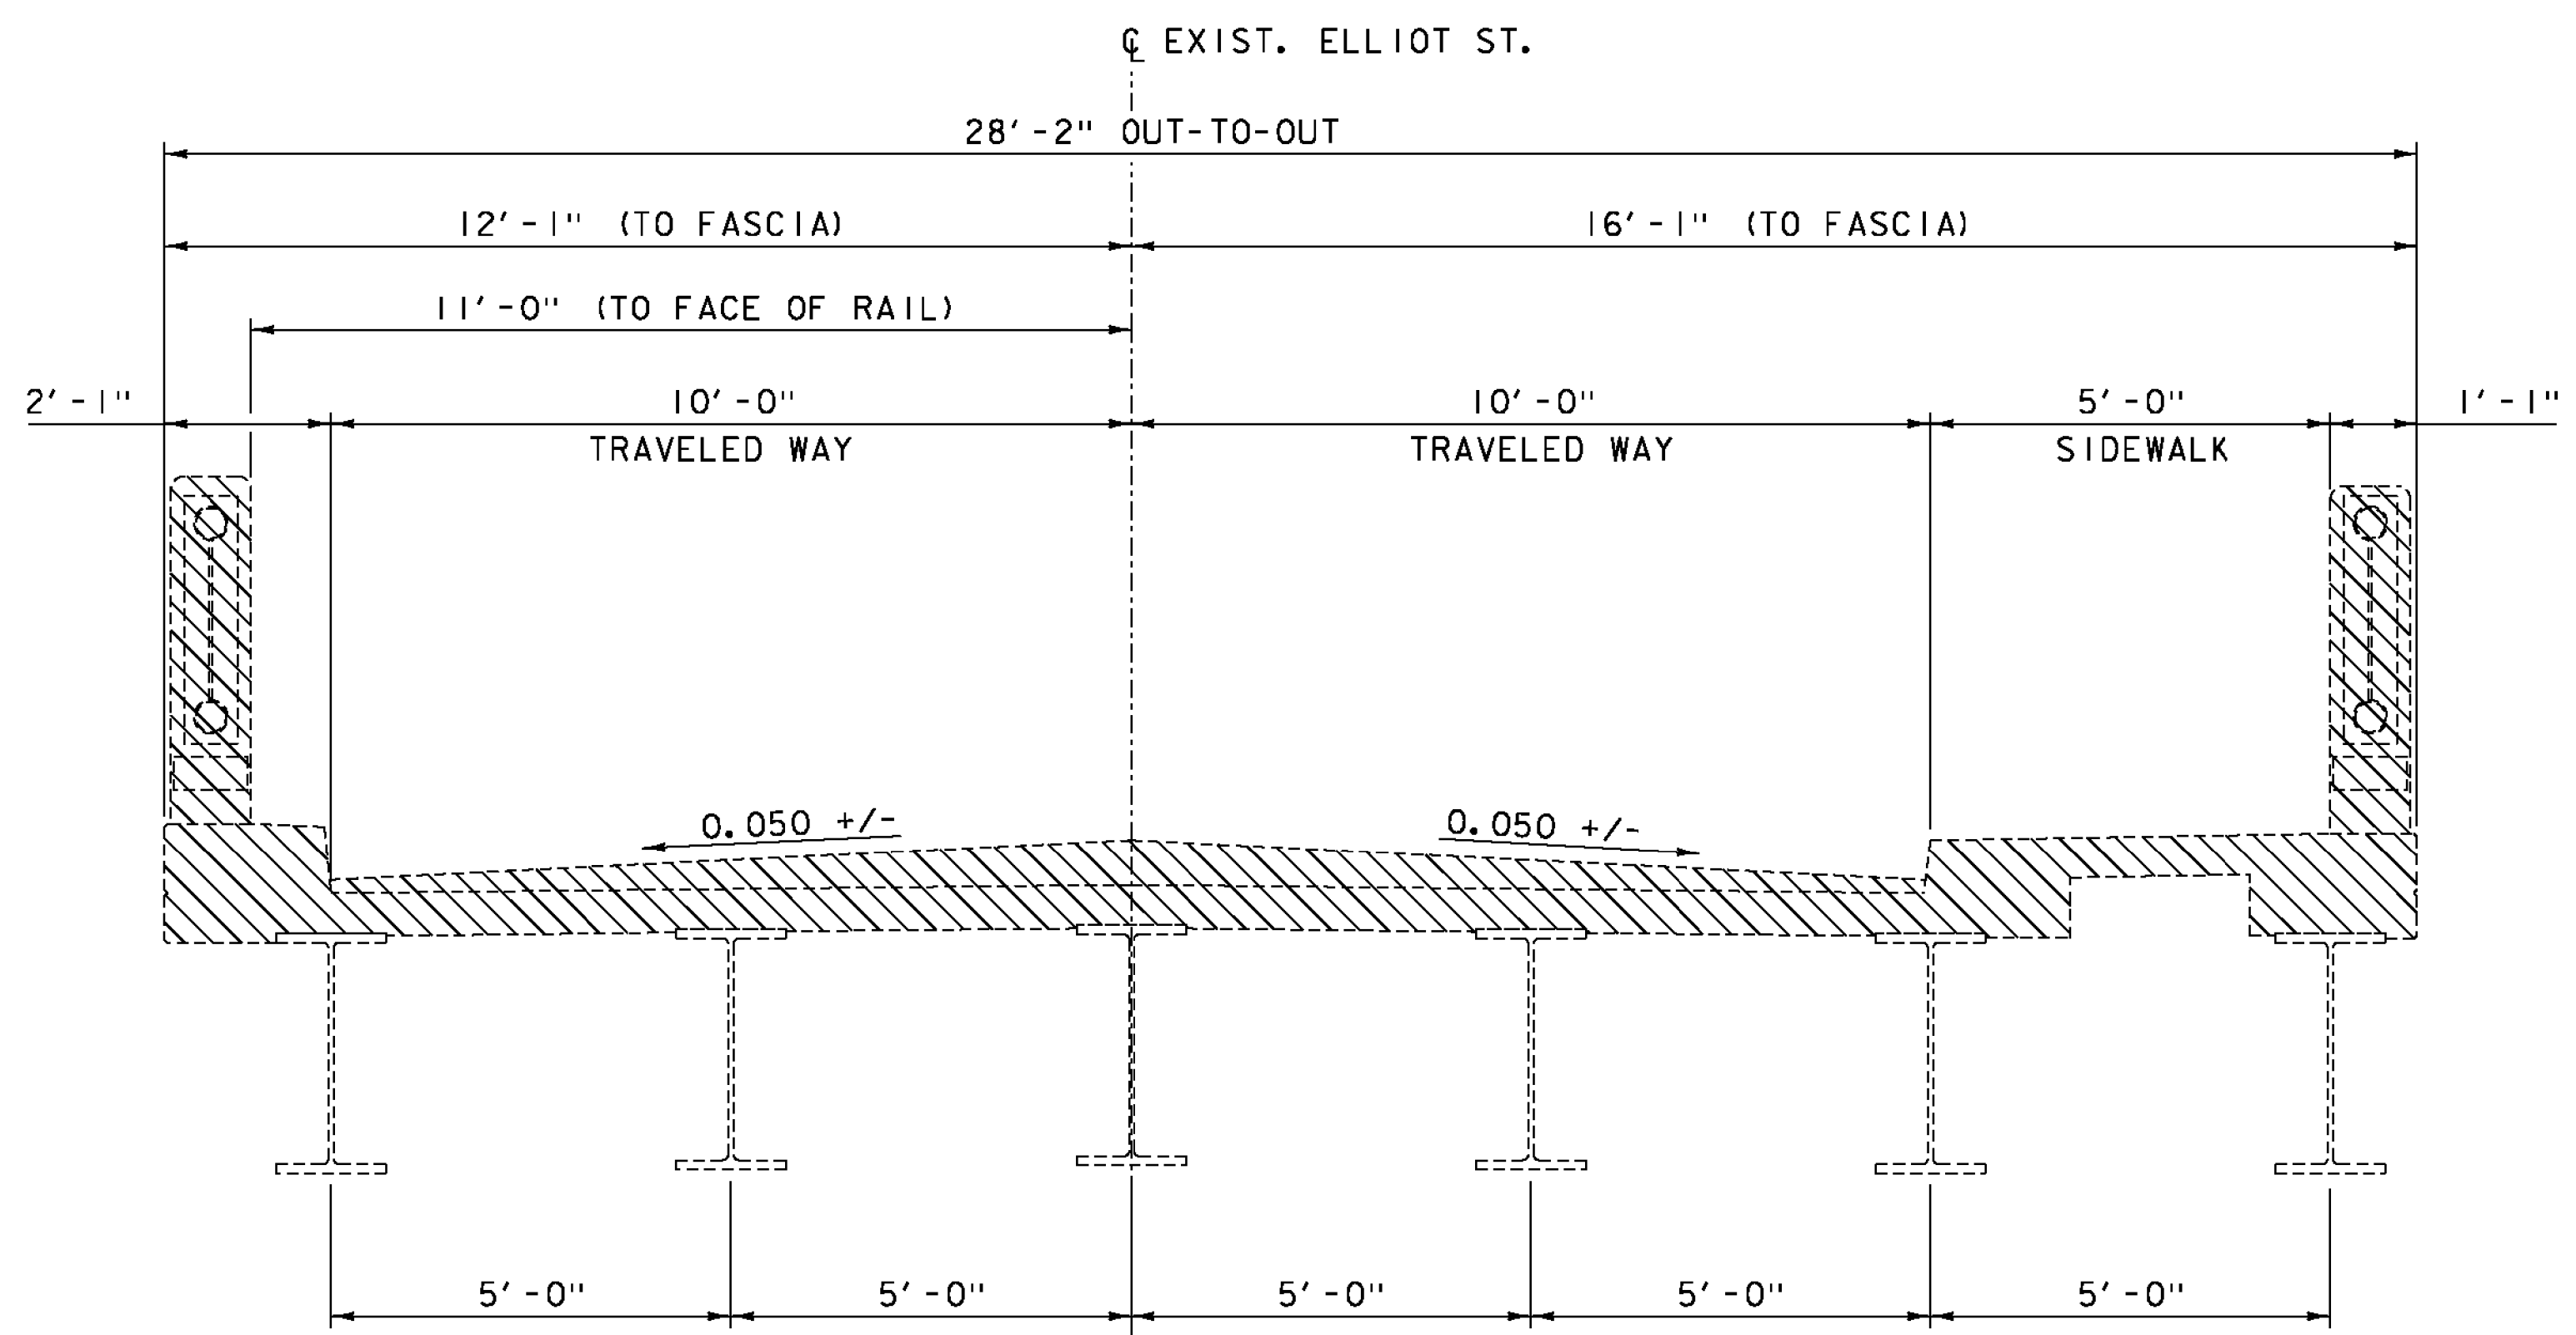

EXISTING TYPICAL BRIDGE SECTION


SCALE: 1/2" = 1'-0"

PARTIAL REMOVAL OF STRUCTURE

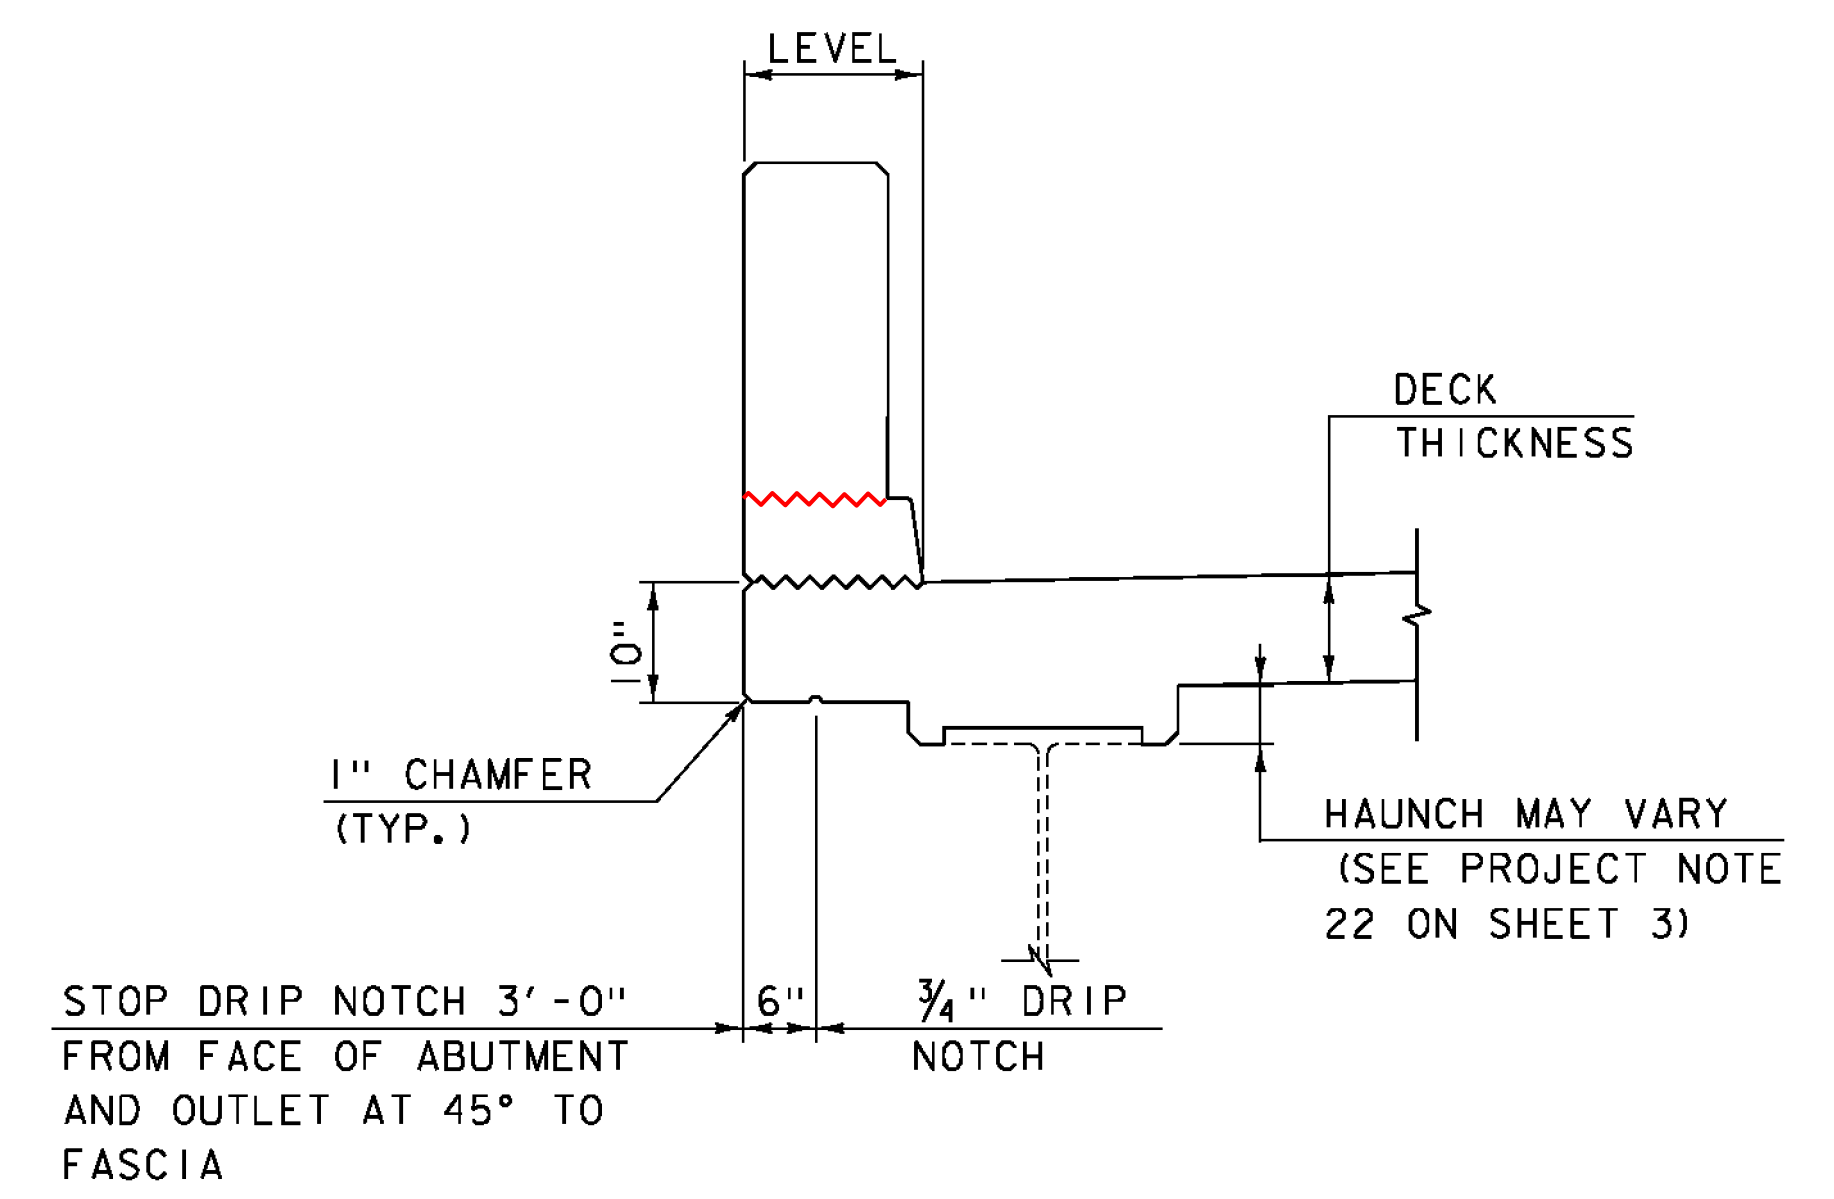


CURB FASCIA AND DRIP NOTCH DETAIL

SCALE: 3/4" = 1'-0"

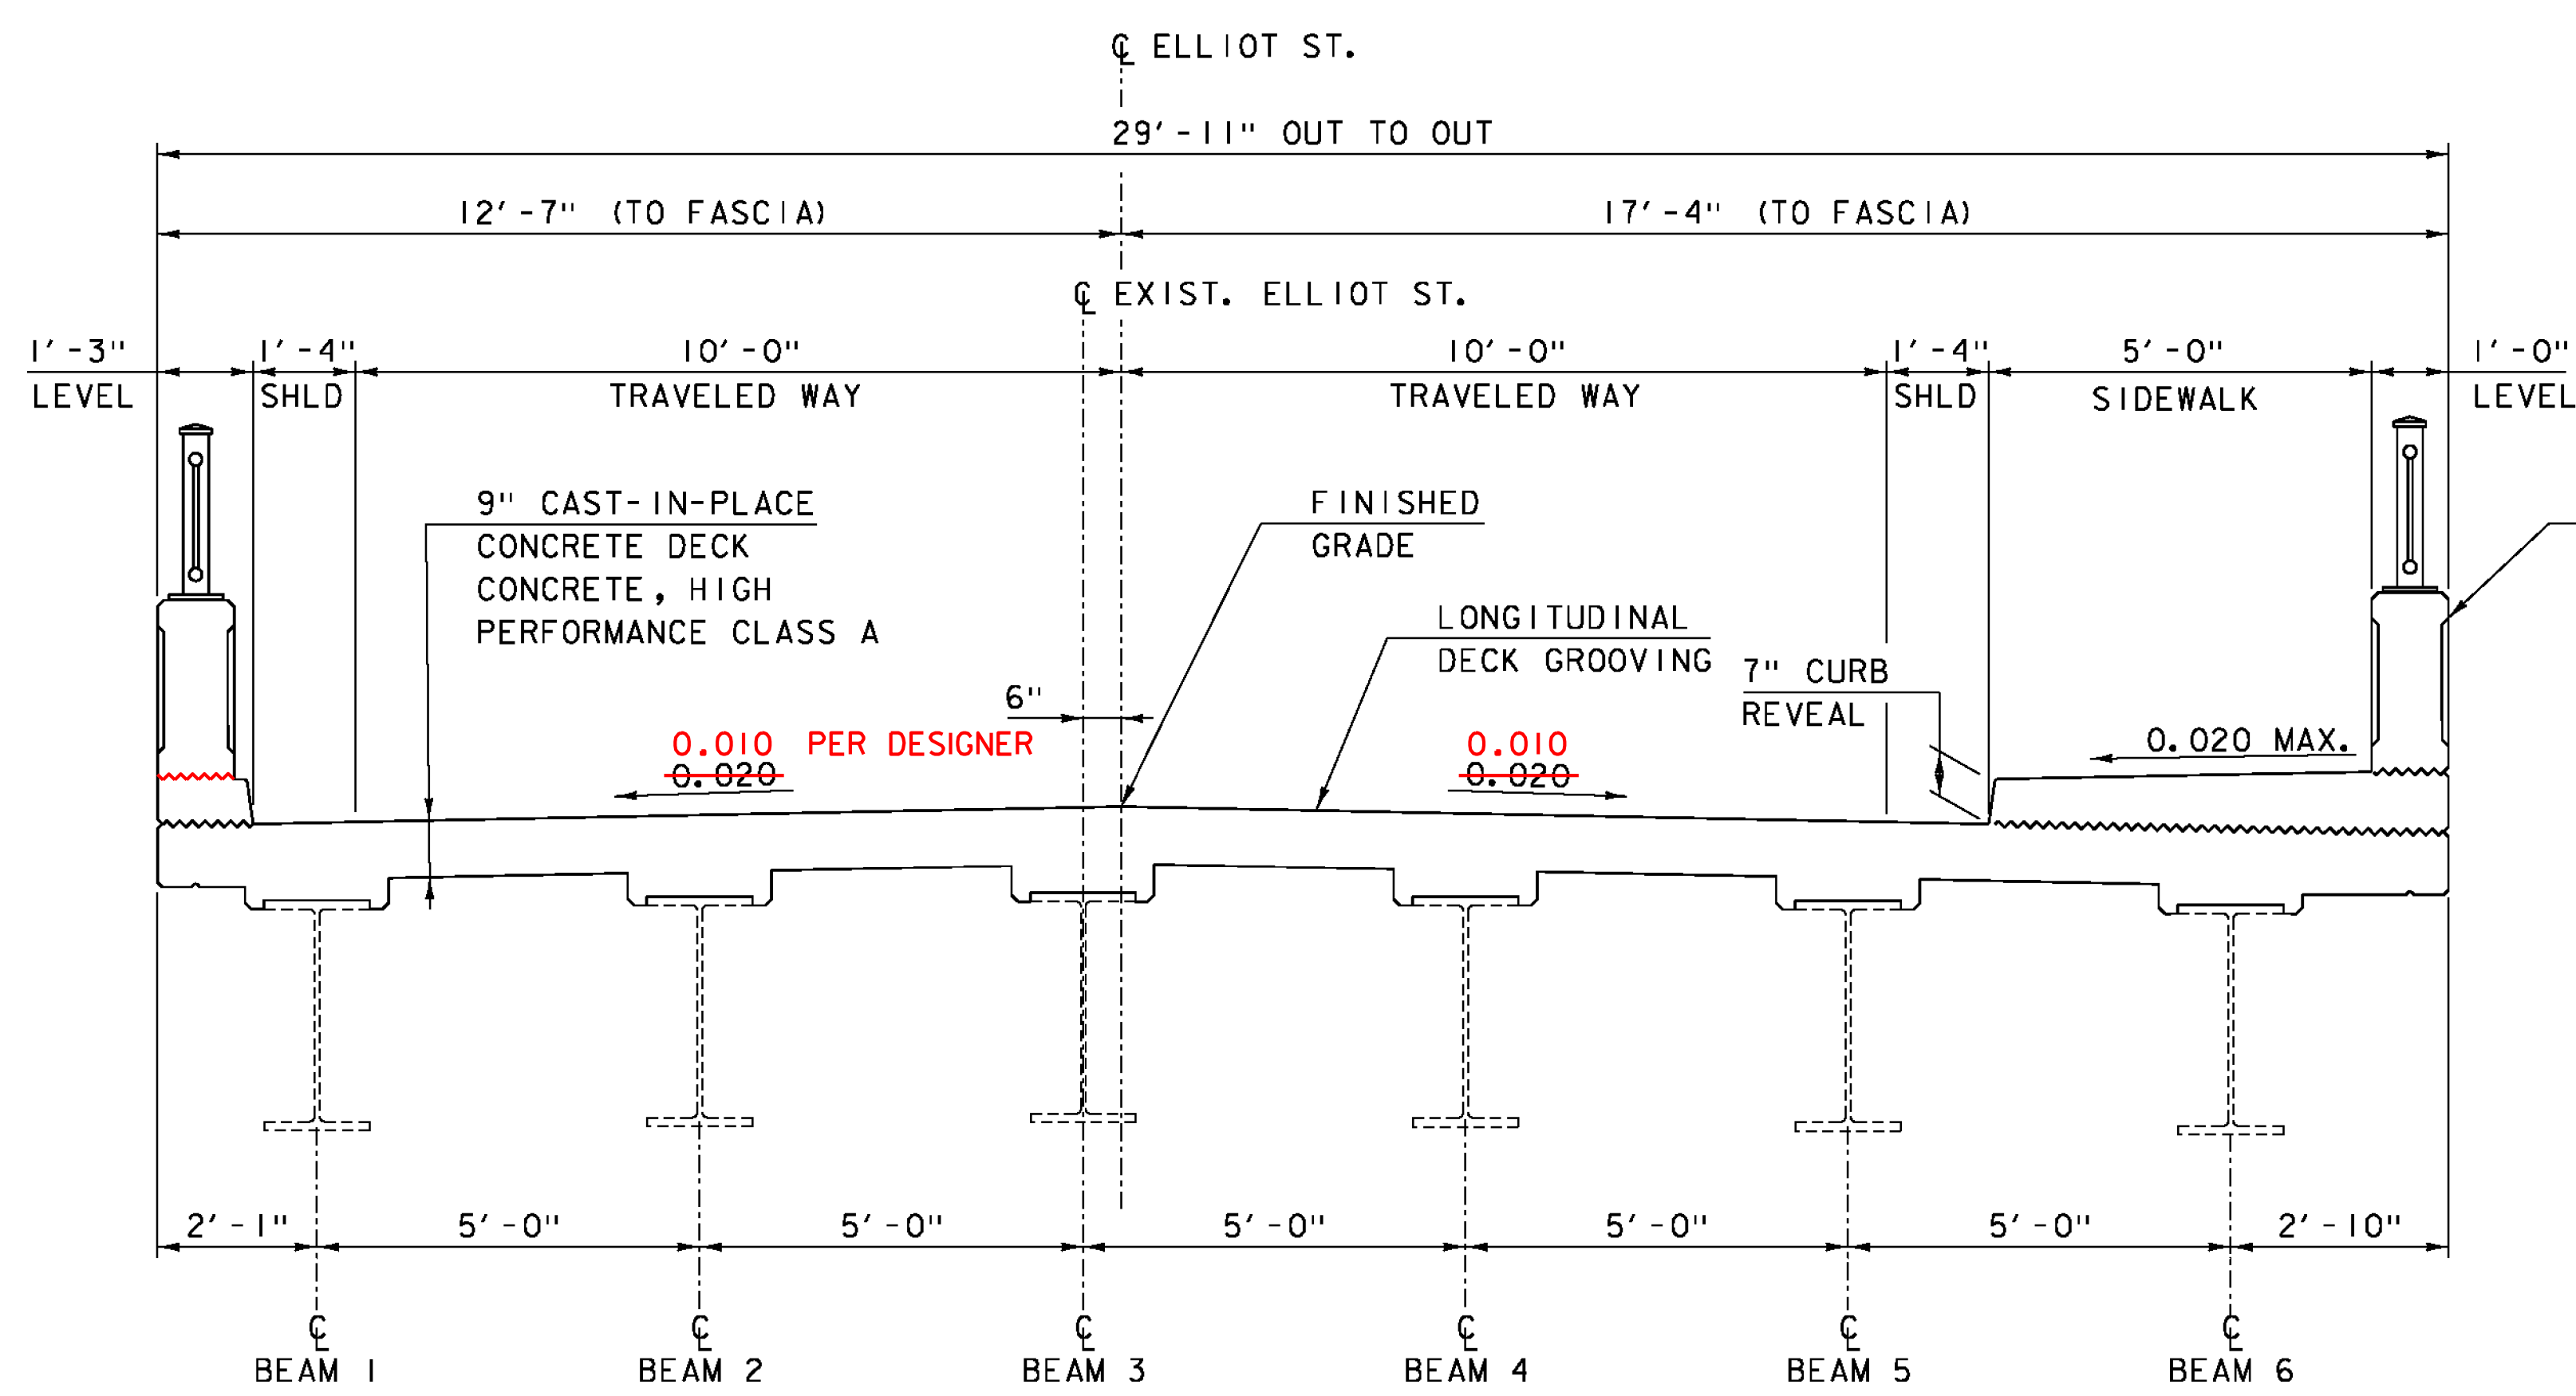

TYPICAL BRIDGE SECTION


SCALE: 1/2" = 1'-0"

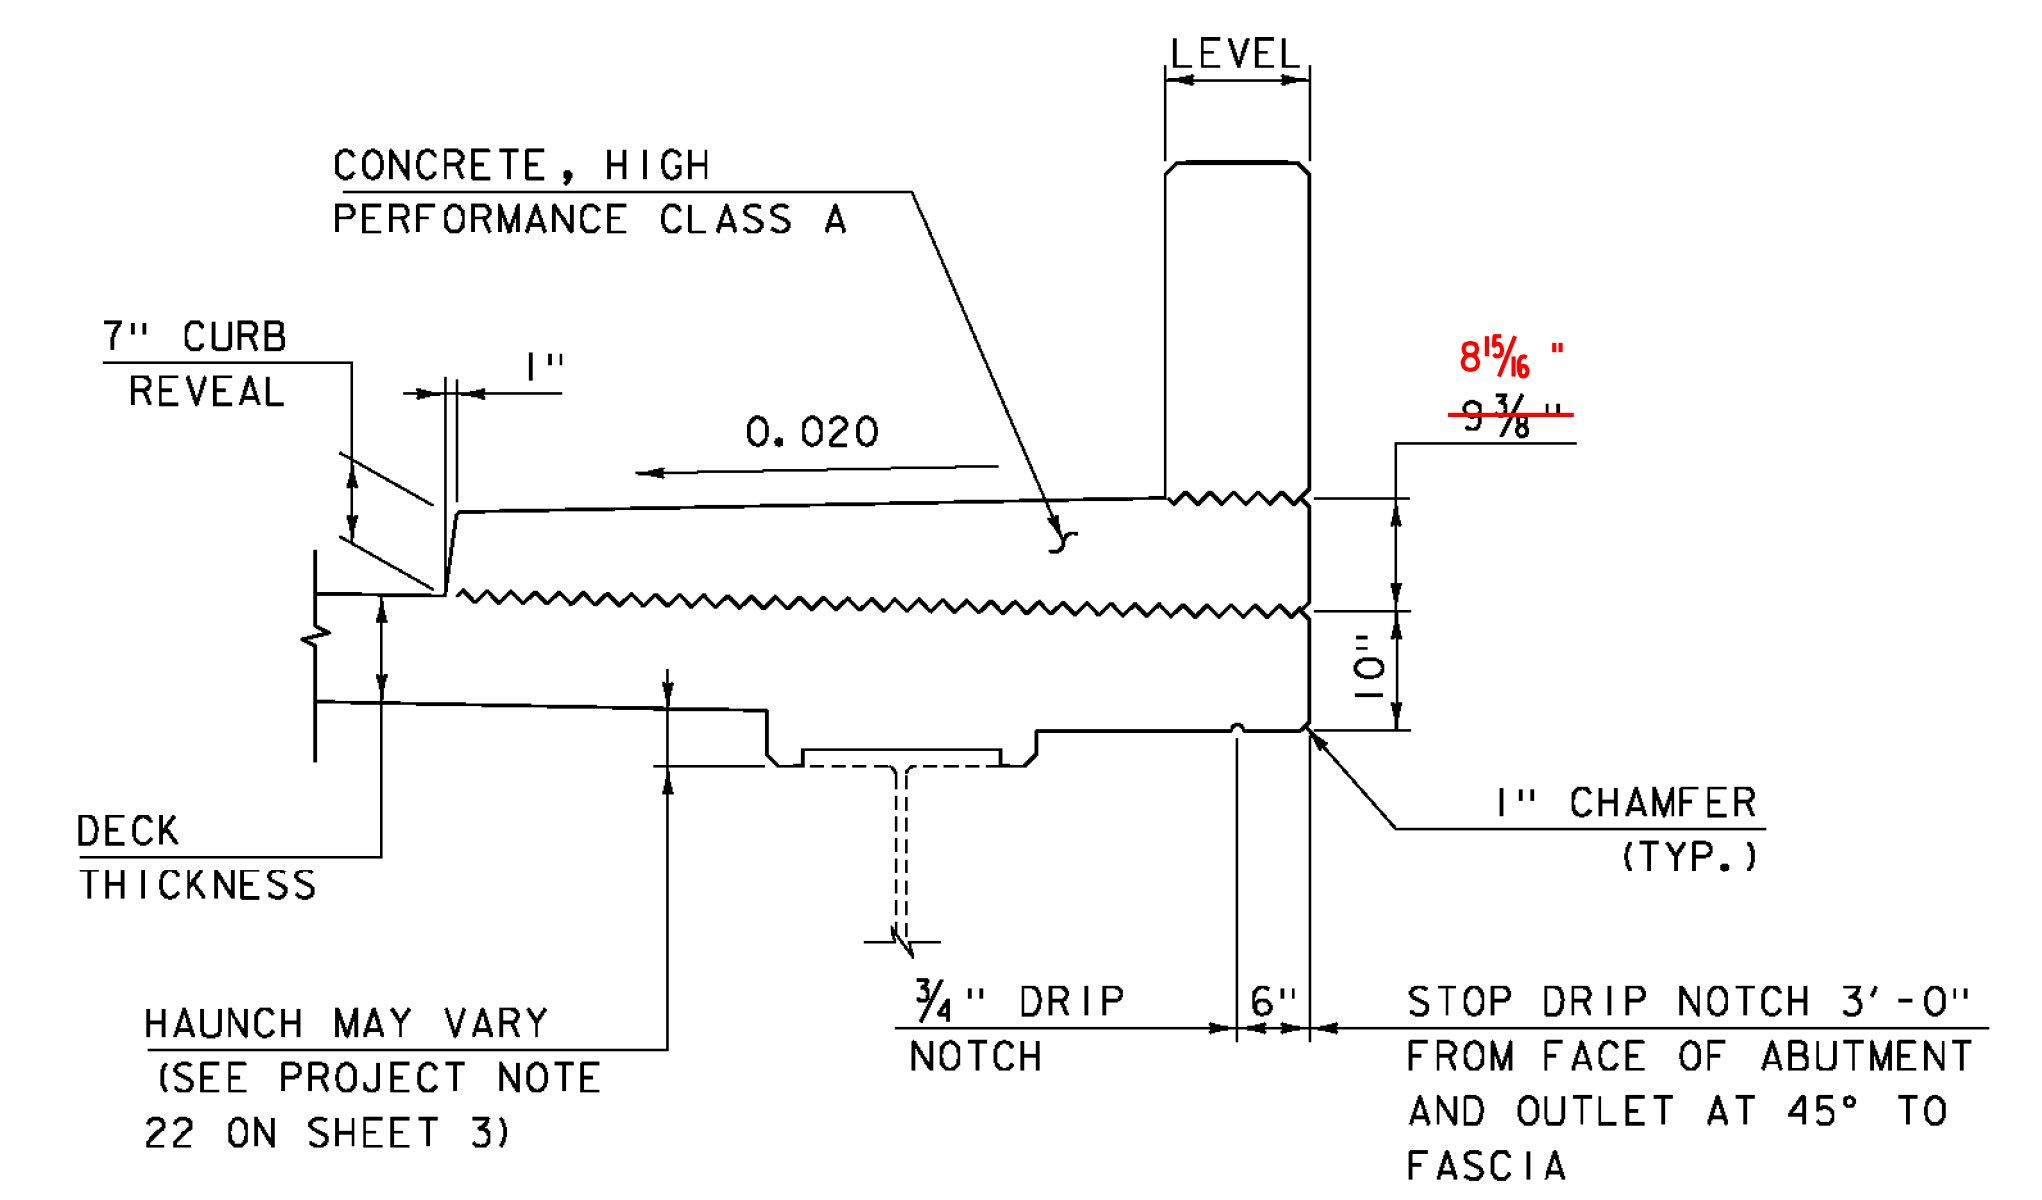


SIDEWALK FASCIA AND DRIP NOTCH DETAIL

SCALE: 3/4" = 1'-0"

CLD 15-0223 MODEL: TYP01

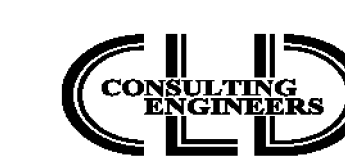

PROJECT NAME:	BRATTLEBORO	PLOT DATE:	2/5/2016
PROJECT NUMBER:	BF 2000(26)	DRAWN BY:	M. SMITH
FILE NAME:	z15j091typ-31.dgn	DESIGNED BY:	N. CARON
PROJECT LEADER:	J. BYATT	CHECKED BY:	S. BEAUMONT
TYPICALS BRIDGE SECTIONS SHEET		SHEET 4 OF 26	

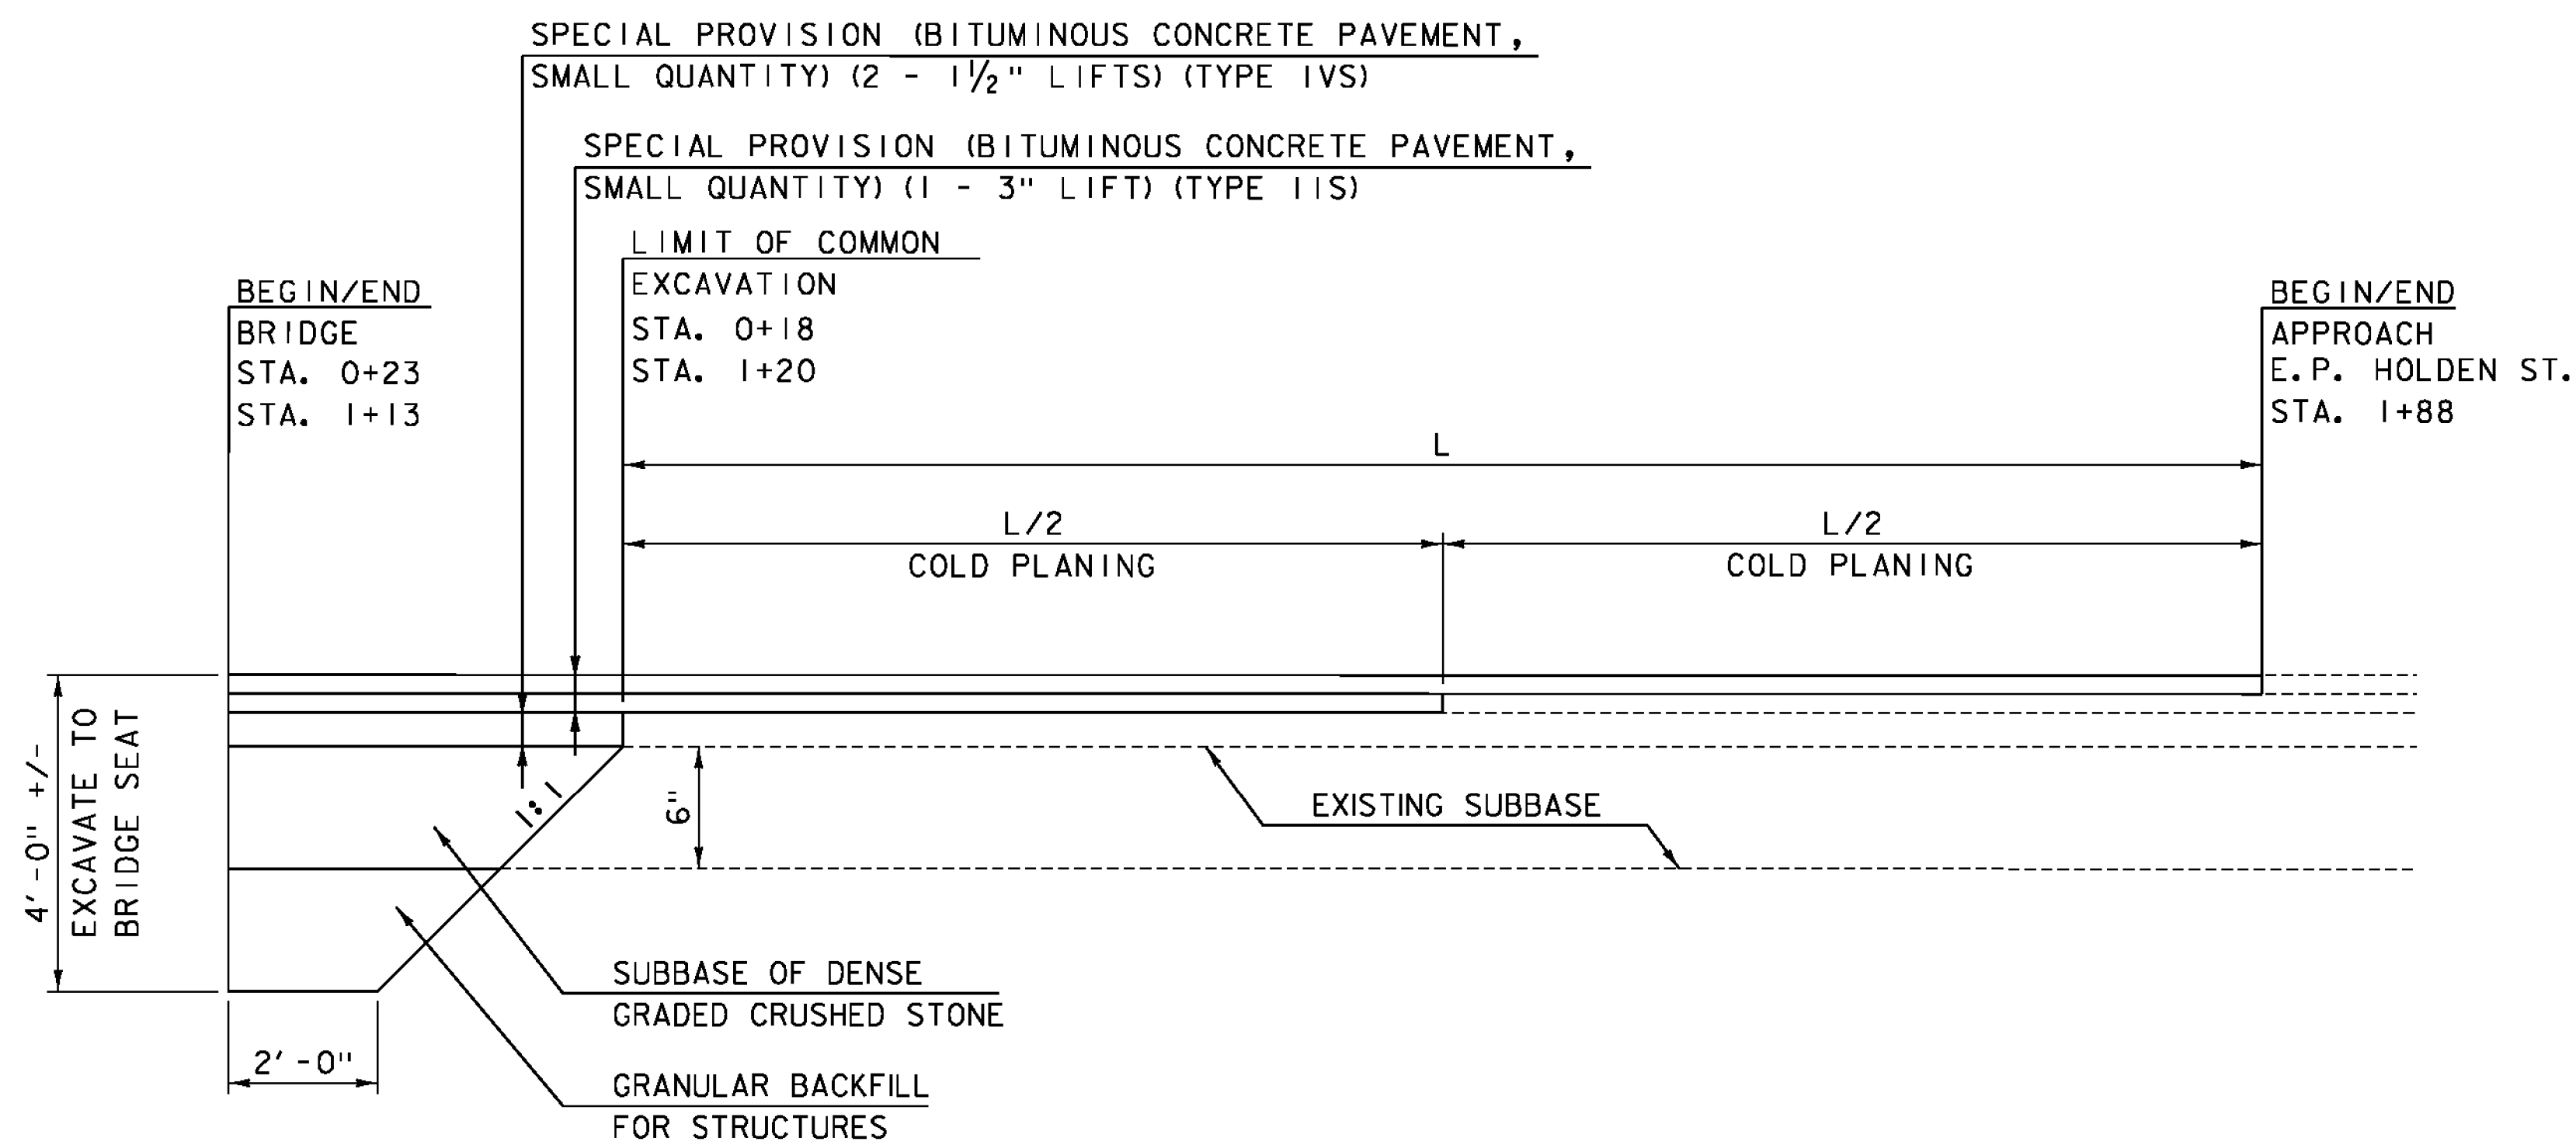


MATERIAL TRANSITION DIAGRAM

NOT TO SCALE


MATERIAL TOLERANCES	
SURFACE	
- PAVEMENT (TOTAL THICKNESS)	+/- 1/4"
- AGGREGATE SURFACE COURSE	+/- 1/2"
SUBBASE	
	+/- 1"

3" SPECIAL PROVISION (BITUMINOUS CONCRETE PAVEMENT, SMALL QUANTITY) (2 - 1 1/2" LIFTS) (TYPE IVS)
 3" SPECIAL PROVISION (BITUMINOUS CONCRETE PAVEMENT, SMALL QUANTITY) (1 - 3" LIFT) (TYPE IIS)

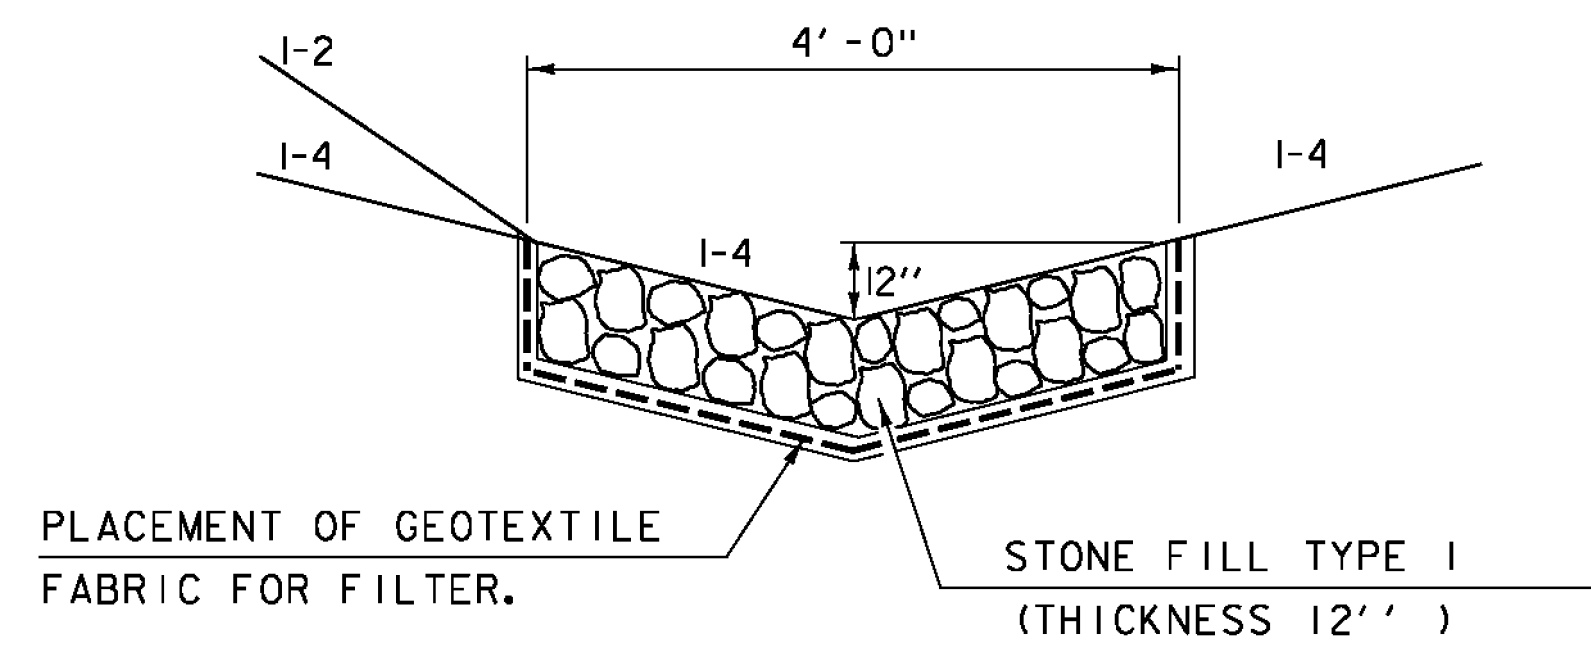

TYPICAL STONE FILL DITCH

NOT TO SCALE

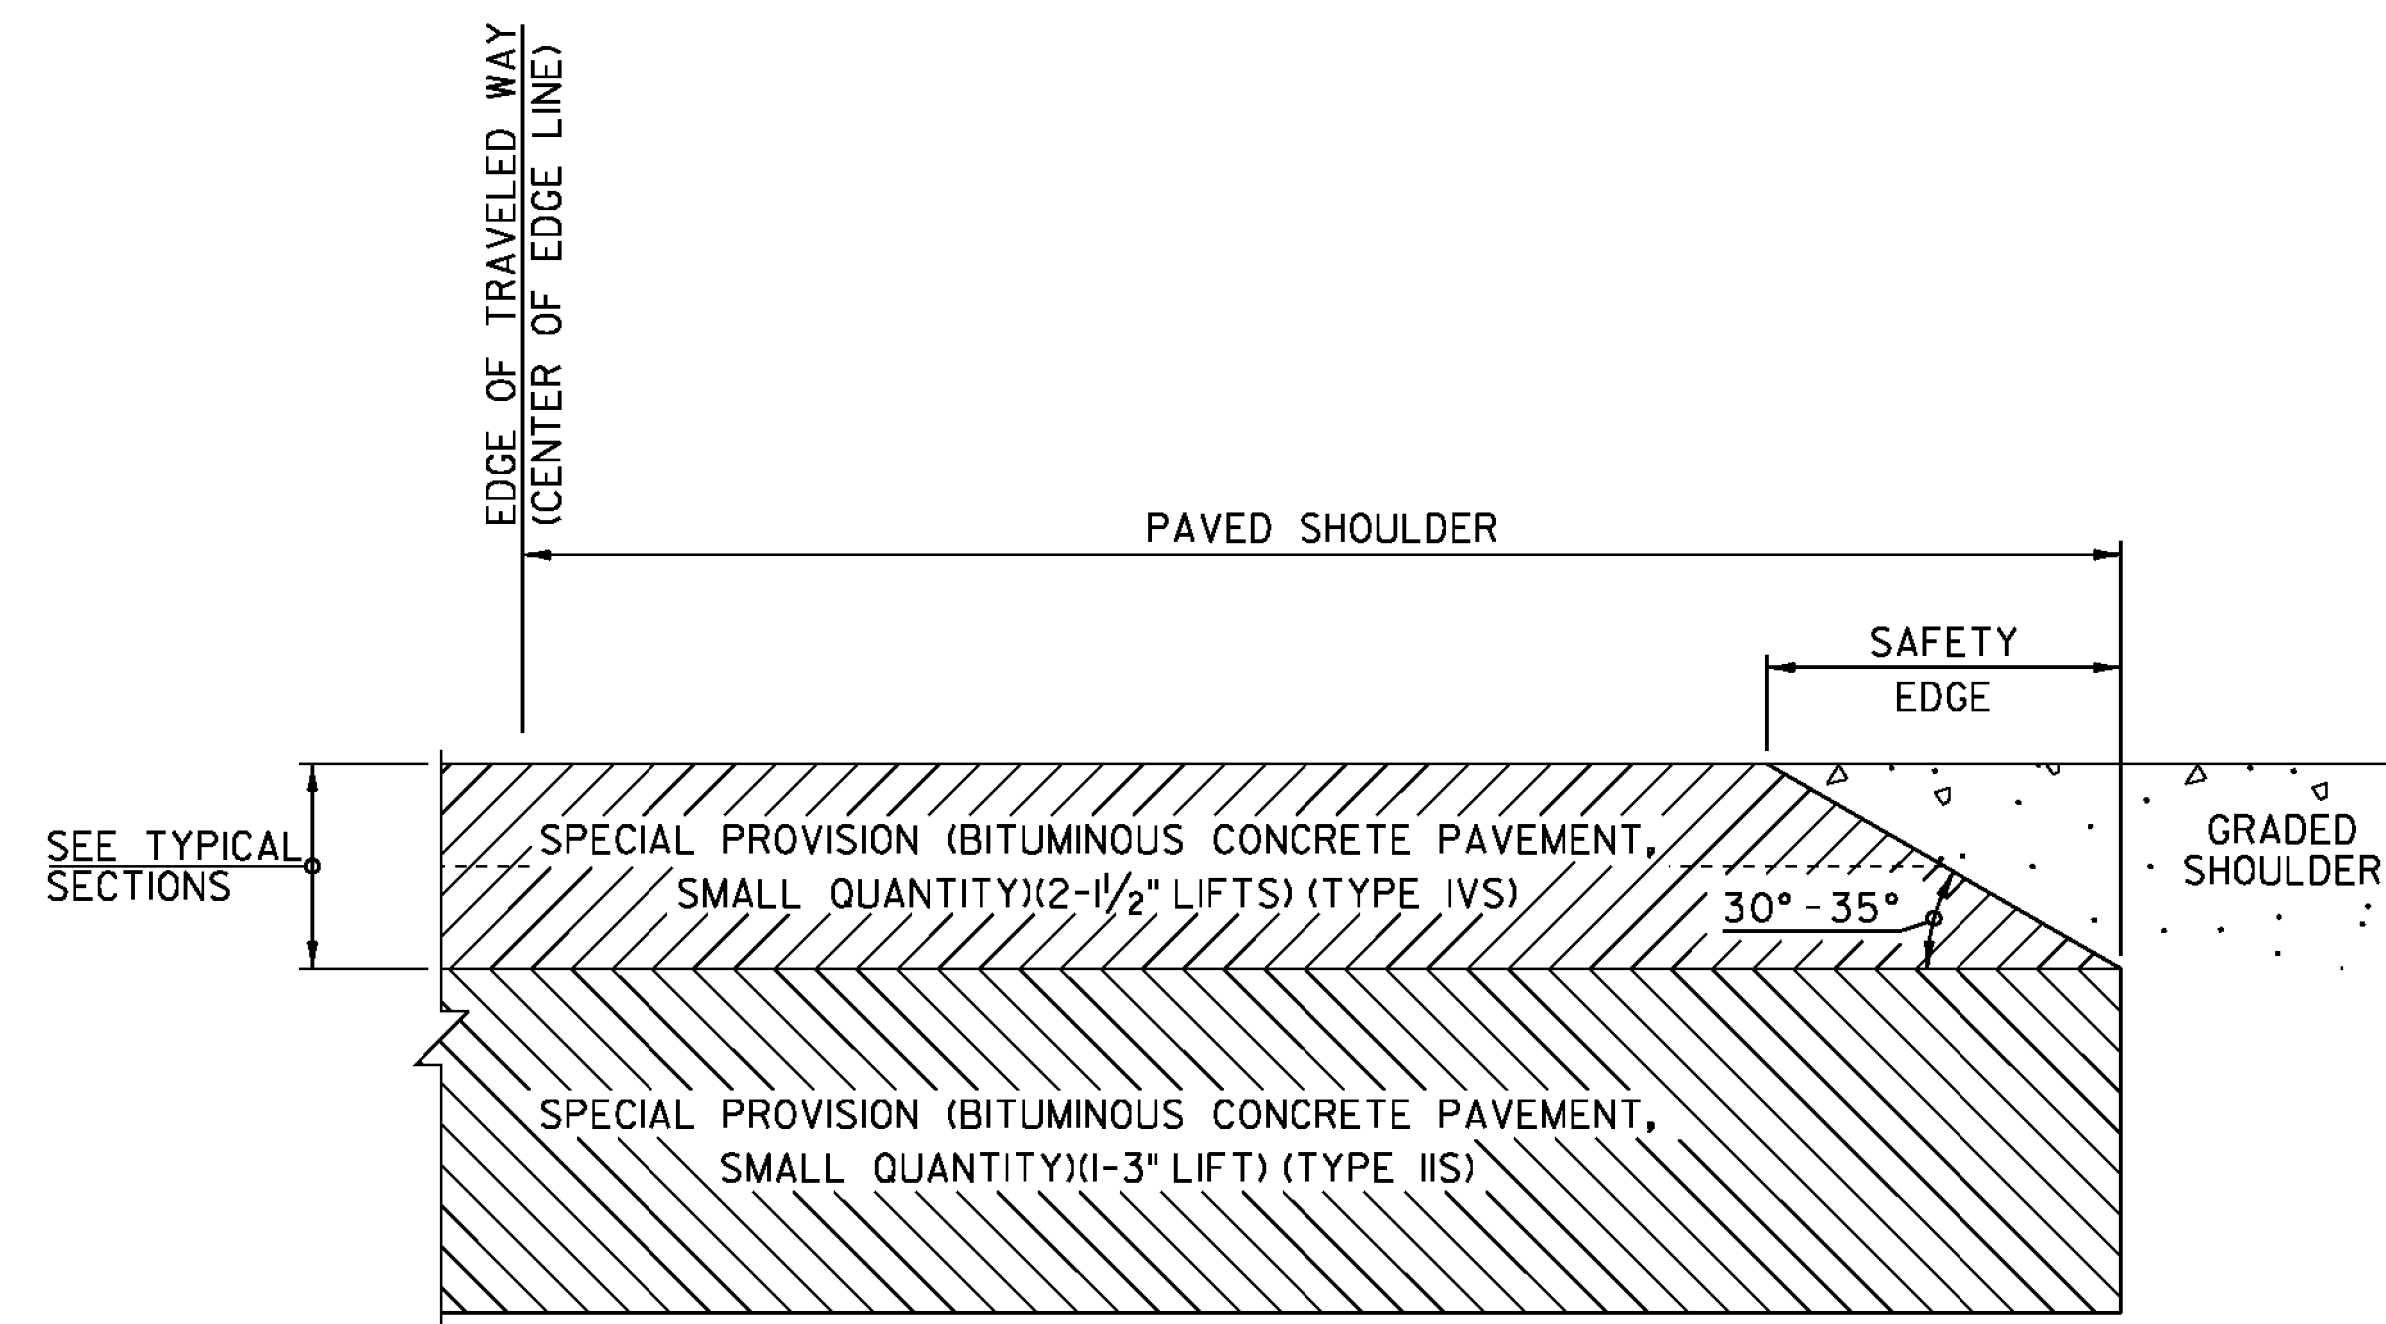


SAFETY EDGE DETAIL

NOT TO SCALE

SAFETY EDGE NOTES

1. THE EDGE OF PAVEMENT SHALL BE FORMED IN SUCH A WAY THAT THE BITUMINOUS CONCRETE PAVEMENT IS EXTRUDED OR COMPRESSED TO FORM THE 30 TO 35 DEGREE ANGLE. DEVICES THAT SIMPLY STRIKE-OFF THE MIX WITHOUT PROVIDING ANY COMPACTIVE EFFORT WILL NOT BE ALLOWED.
2. TO PAVED SHOULDER EXTENDS FROM THE EDGE OF TRAVELED WAY TO THE EDGE OF THE WEARING COURSE, INCLUDED THE "SAFETY EDGE".

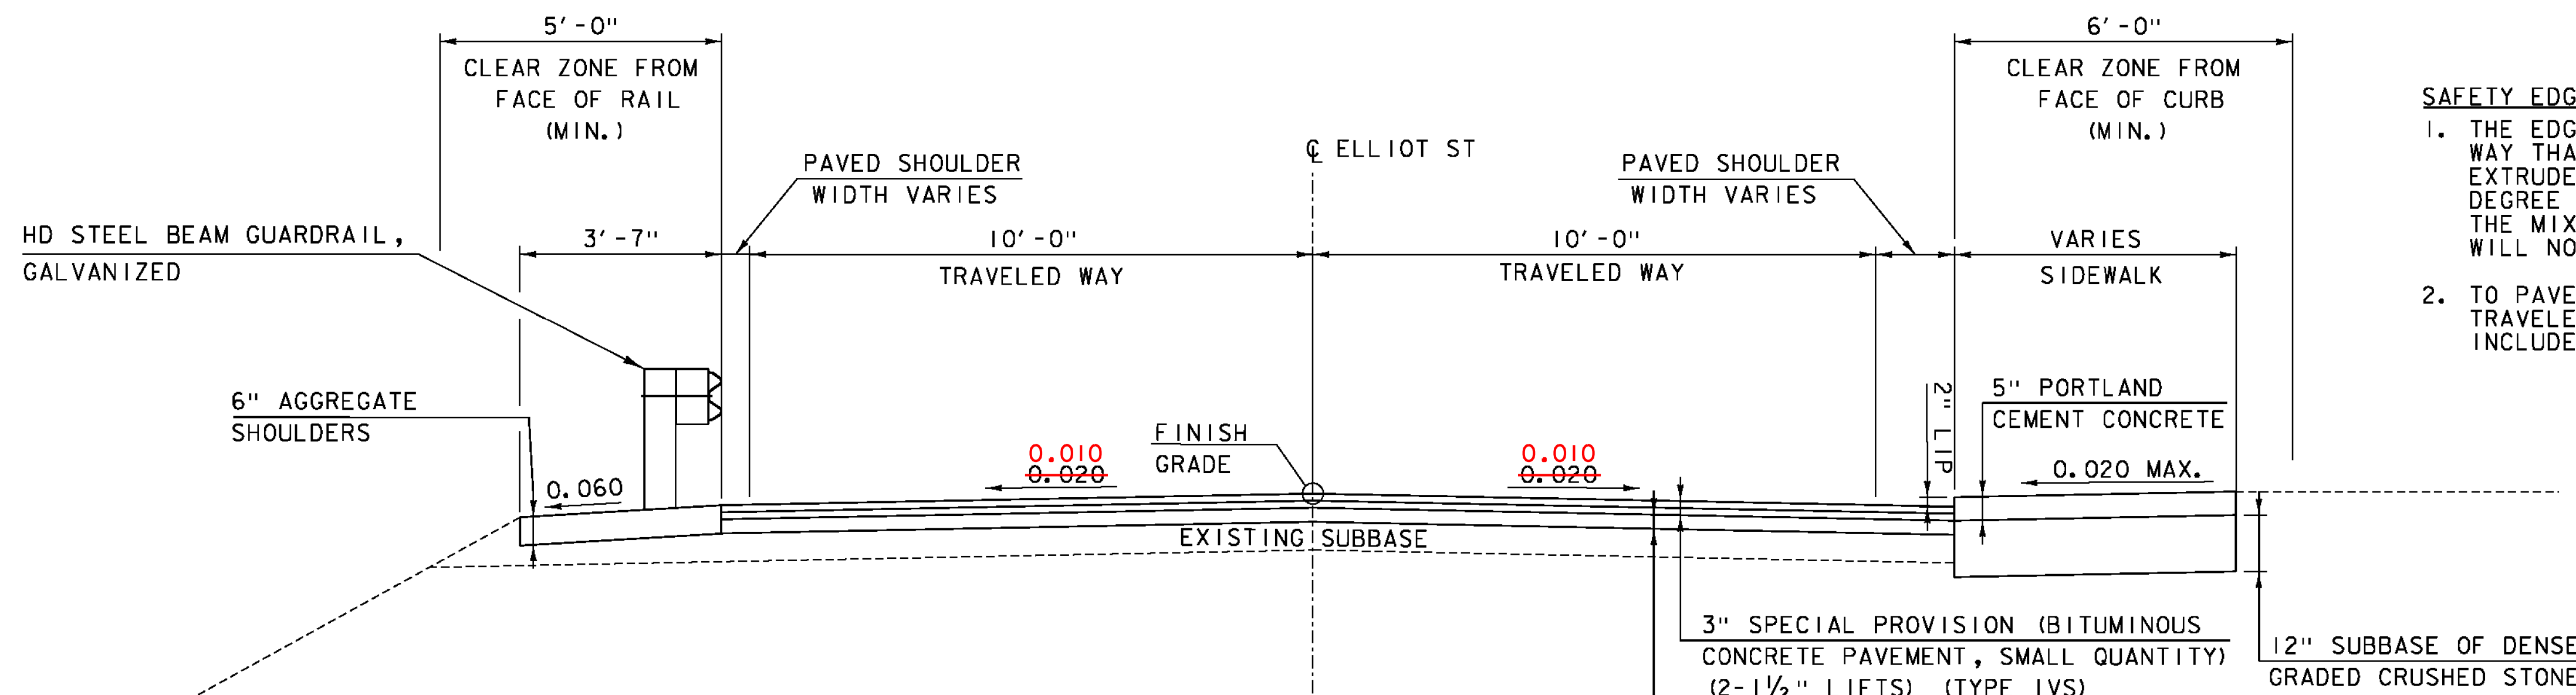

**ELLIOT ST (TH #446)
TYPICAL SECTION**

SCALE: 1/2" = 1'-0"

3" SPECIAL PROVISION (BITUMINOUS CONCRETE PAVEMENT, SMALL QUANTITY) (2-1 1/2" LIFTS) (TYPE IVS)
 3" SPECIAL PROVISION (BITUMINOUS CONCRETE PAVEMENT, SMALL QUANTITY) (1-3" LIFT) (TYPE IIS)
 12" SUBBASE OF DENSE GRADED CRUSHED STONE

PROJECT NAME: BRATTLEBORO	PLOT DATE: 2/5/2016
PROJECT NUMBER: BF 2000(26)	DRAWN BY: P. McKECHNIE
FILE NAME: z15j091typ-3l.dgn	CHECKED BY: S. FORTIER
PROJECT LEADER: J. BYATT	SHEET 5 OF 26
DESIGNED BY: L. GREER	



MODEL: TYP02
CLD 15-0223

QUANTITY SHEET 1

SUMMARY OF ESTIMATED QUANTITIES										TOTALS		DESCRIPTIONS				DETAILED SUMMARY OF QUANTITIES			
							ROADWAY	EROSION CONTROL	BRIDGE NO. 31	FULL C.E. ITEMS	GRAND TOTAL	FINAL	UNIT	ITEMS	ITEM NUMBER	ROUND	QUANTITIES	UNIT	ITEMS
							1				1		LS	CLEARING AND GRUBBING, INCLUDING INDIVIDUAL TREES AND STUMPS	201.10	-			
							50				50		CY	COMMON EXCAVATION	203.15	3			
							1				1		CY	TRENCH EXCAVATION OF EARTH, EXPLORATORY (N.A.B.I.)	204.22	-			
							35				35		CY	GRANULAR BACKFILL FOR STRUCTURES	204.30	5			
							425				425		SY	COLD PLANING, BITUMINOUS PAVEMENT	210.10	8			
							15				15		CY	SUBBASE OF DENSE GRADED CRUSHED STONE	301.35	1.9			
							10				10		TON	AGGREGATE SHOULDERS	402.12	1			
							1				1		LU	PRICE ADJUSTMENT, ASPHALT CEMENT (N.A.B.I.)	406.50	-			
									110		110		CY	CONCRETE, HIGH PERFORMANCE CLASS A	501.33	0.2			
									20941		20941		LB	REINFORCING STEEL, LEVEL I	507.11	0.98			
									1		1		LS	SHEAR CONNECTORS (1266 - 8" X 7/8")	508.15	-			
									234		234		SY	LONGITUDINAL DECK GROOVING	509.10	0.49			
									38		38		GAL	WATER REPELLENT, SILANE	514.10	0.25			
									37		37		LF	BRIDGE EXPANSION JOINT, ASPHALTIC PLUG	516.10	0.33			
									23		23		LF	JOINT SEALER, HOT POURED	524.11	0.33			
									1		1		EACH	PARTIAL REMOVAL OF STRUCTURE	529.20	-			
									10		10		SY	REPAIR OF CONCRETE SUBSTRUCTURE SURFACE, CLASS I	580.13	EST.			
									10		10		SY	REPAIR OF CONCRETE SUBSTRUCTURE SURFACE, CLASS II	580.14	EST.			
							4				4		EACH	REHAB. DROP INLETS, CATCH BASINS, OR MANHOLES, CLASS I	604.412	-			
							1				1		EACH	CHANGING ELEVATION OF SEWER MANHOLES	604.42	-			
							1				1		CY	STONE FILL, TYPE I	613.10	-			
							8				8		LF	CAST-IN-PLACE CONCRETE CURB, TYPE B	616.28	-			
							15				15		SY	PORTLAND CEMENT CONCRETE SIDEWALK, 5 INCH	618.10	1			
									10		10		SF	DETECTABLE WARNING SURFACE	618.30	-			
							37.5				37.5		LF	HD STEEL BEAM GUARDRAIL, GALVANIZED	621.21	-			
							3				3		EACH	STEEL BEAM GUARDRAIL OFFSET BLOCK	621.219	-			
							1				1		EACH	MANUFACTURED TERMINAL SECTION, FLARED	621.50	-			
							2				2		EACH	ANCHOR FOR STEEL BEAM RAIL	621.60	-			
							40				40		LF	REMOVAL AND DISPOSAL OF GUARDRAIL	621.80	3			
							3				3		EACH	GUIDE POSTS	621.85	-			
							1				1		EACH	ADJUST ELEVATION OF VALVE BOX	629.20	-			
							40				40		HR	UNIFORMED TRAFFIC OFFICERS	630.10	-			
							120				120		HR	FLAGGERS	630.15	-			
										1	1		LS	FIELD OFFICE, ENGINEERS	631.10	-			
										1	1		LS	TESTING EQUIPMENT, CONCRETE	631.16	-			
										1	1		LS	TESTING EQUIPMENT, BITUMINOUS	631.17	-			
										3000	3000		DL	FIELD OFFICE TELEPHONE (N.A.B.I.)	631.26	-			
							1				1		LS	MOBILIZATION/DEMOBILIZATION	635.11	-			
							2				2		EACH	PORTABLE CHANGEABLE MESSAGE SIGN	641.15	-			
							200				200		LF	DURABLE 4 INCH WHITE LINE, THERMOPLASTIC	646.402	20			

PROJECT NAME: BRATTLEBORO
PROJECT NUMBER: BF 2000(26)
FILE NAME: z15j09lqss-31.dgn
PROJECT LEADER: J. BYATT
DESIGNED BY: J. FRENCH
QUANTITY SHEET 1
PLOT DATE: 2/26/2016
DRAWN BY: M. SMITH
CHECKED BY: A. GIRALDI
SHEET 6 OF 26

QUANTITY SHEET 2

SUMMARY OF ESTIMATED QUANTITIES

TOTALS

DESCRIPTIONS

DETAILED SUMMARY OF QUANTITIES

SUMMARY OF ESTIMATED QUANTITIES					TOTALS		DESCRIPTIONS				DETAILED SUMMARY OF QUANTITIES					
				ROADWAY	EROSION CONTROL	BRIDGE NO. 31	FULL C.E. ITEMS	GRAND TOTAL	FINAL	UNIT	ITEMS	ITEM NUMBER	ROUND	QUANTITIES	UNIT	ITEMS
				350				350		LF	DURABLE 4 INCH YELLOW LINE, THERMOPLASTIC	646.412	20			SPECIAL PROVISION (BITUMINOUS CONCRETE PAVEMENT, SMALL QUANTITY)
				10				10		LF	DURABLE 24 INCH STOP BAR	646.480	-	61	TON	TYPE IVS
				5				5		SY	GEOTEXTILE UNDER STONE FILL	649.31	1	6	TON	TYPE IIS
				3				3		EACH	REMOVING SIGNS	675.50	-	67	TON	SUBTOTAL
				2				2		EACH	ERECTING SALVAGED SIGNS	675.60	-	3	TON	ROUNDING
				1				1		EACH	SETTING SALVAGED POSTS	675.61	-	70	TON	TOTAL
				2				2		EACH	DELINEATOR WITH STEEL POST	676.10	-			
				6				6		EACH	SPECIAL PROVISION (CPM SCHEDULE)	900.620	-			
						185.13		185.13		LF	SPECIAL PROVISION (BRIDGE RAILING, GALVANIZED METAL HAND RAILING/CONCRETE PARAPET COMBINATION)	900.640	-			
				1				1		LS	SPECIAL PROVISION (TRAFFIC CONTROL, ALL INCLUSIVE)	900.645	-			
				1				1		LU	SPECIAL PROVISION (MAT DENSITY PAY ADJUSTMENT, SMALL QUANTITY) (N.A.B.I.)	900.650	-			
				1				1		LU	SPECIAL PROVISION (MIXTURE PAY ADJUSTMENT) (N.A.B.I.)	900.650	-			
				15				15		SY	SPECIAL PROVISION (HAND-PLACED BITUMINOUS CONCRETE MATERIAL, DRIVES)	900.675	4			
				70				70		TON	SPECIAL PROVISION (BITUMINOUS CONCRETE PAVEMENT, SMALL QUANTITY)	900.680	3			

PROJECT NAME: BRATTLEBORO
 PROJECT NUMBER: BF 2000(26)
 FILE NAME: z15j09lqss-3l.dgn
 PROJECT LEADER: J. BYATT
 DESIGNED BY: S. BEAUMONT
 QUANTITY SHEET 2
 PLOT DATE: 2/26/2016
 DRAWN BY: M. SMITH
 CHECKED BY: A. GIRALDI
 SHEET 7 OF 26

GENERAL INFORMATION

SYMBOLY LEGEND NOTE

THE SYMBOLY ON THIS SHEET IS INTENDED TO COVER STANDARD CONVENTIONAL SYMBOLY. THE SYMBOLY IS USED FOR EXISTING & PROPOSED FEATURES WITH HEAVIER LINEWEIGHT, IN COMBINATION WITH PROJECT ANNOTATION, AS NOTED ON PROJECT PLAN SHEETS. THIS LEGEND SHEET COVERS THE BASICS. SYMBOLY ON PLANS MAY VARY, PLAN ANNOTATIONS AND NOTES SHOULD BE USED TO CLARIFY AS NEEDED.

R.O.W. ABBREVIATIONS (CODES) & SYMBOLS

POINT CODE	DESCRIPTION
CH	CHANNEL EASEMENT
CONST	CONSTRUCTION EASEMENT
CUL	CULVERT EASEMENT
D&C	DISCONNECT & CONNECT
DIT	DITCH EASEMENT
DR	DRAINAGE EASEMENT
DRIVE	DRIVEWAY EASEMENT
EC	EROSION CONTROL
HWY	HIGHWAY EASEMENT
I&M	INSTALL & MAINTAIN EASEMENT
LAND	LANDSCAPE EASEMENT
R&RES	REMOVE & RESET
R&REP	REMOVE & REPLACE
SR	SLOPE RIGHT
UE	UTILITY EASEMENT
(P)	PERMANENT EASEMENT
(T)	TEMPORARY EASEMENT
■	BNDNS BOUND SET
▣	BNDNS BOUND TO BE SET
●	IPNS IRON PIN SET
⊙	IPNS IRON PIN TO BE SET
⊠	CALC EXISTING ROW POINT
○	PROW PROPOSED ROW POINT
[LENGTH]	LENGTH CARRIED ON NEXT SHEET

COMMON TOPOGRAPHIC POINT SYMBOLS

POINT CODE	DESCRIPTION
#	APL BOUND APPARENT LOCATION
▣	BM BENCHMARK
▣	BND BOUND
▣	CB CATCH BASIN
⊕	COMB COMBINATION POLE
▣	DITHR DROP INLET THROATED DNC
⊕	EL ELECTRIC POWER POLE
⊙	FPOLE FLAGPOLE
⊙	GASFIL GAS FILLER
⊙	GP GUIDE POST
×	GSO GAS SHUT OFF
⊙	GUY GUY POLE
⊙	GUYW GUY WIRE
×	GV GATE VALUE
⊙	H TREE HARDWOOD
△	HCTRL CONTROL HORIZONTAL
△	HVCTRL CONTROL HORIZ. & VERTICAL
◇	HYD HYDRANT
⊙	IP IRON PIN
⊙	IPIPE IRON PIPE
⊕	LI LIGHT - STREET OR YARD
⊙	MB MAILBOX
⊙	MH MANHOLE (MH)
▣	MM MILE MARKER
⊙	PM PARKING METER
▣	PMK PROJECT MARKER
⊙	POST POST STONE/WOOD
⊕	RRSIG RAILROAD SIGNAL
⊕	RRSL RAILROAD SWITCH LEVER
⊕	S TREE SOFTWOOD
⊙	SAT SATELLITE DISH
⊕	SHRUB SHRUB
⊕	SIGN SIGN
⊕	STUMP STUMP
⊕	TEL TELEPHONE POLE
⊕	TIE TIE
⊕	TSIGN SIGN W/DOUBLE POST
⊕	VCTRL CONTROL VERTICAL
⊙	WELL WELL
×	WSO WATER SHUT OFF

THESE ARE COMMON VAOT SURVEY POINT SYMBOLS FOR EXISTING FEATURES, ALSO USED FOR PROPOSED FEATURES WITH HEAVIER LINEWEIGHT, IN COMBINATION WITH PROPOSED ANNOTATION.

PROPOSED GEOMETRY CODES

CODE	DESCRIPTION
PC	POINT OF CURVATURE
PI	POINT OF INTERSECTION
CC	CENTER OF CURVE
PT	POINT OF TANGENCY
PCC	POINT OF COMPOUND CURVE
PRC	POINT OF REVERSE CURVE
POB	POINT OF BEGINNING
POE	POINT OF ENDING
STA	STATION PREFIX
AH	AHEAD STATION SUFFIX
BK	BACK STATION SUFFIX
D	CURVE DEGREE OF (100FT)
R	CURVE RADIUS OF
T	CURVE TANGENT LENGTH
L	CURVE LENGTH OF
E	CURVE EXTERNAL DISTANCE

UTILITY SYMBOLY

UNDERGROUND UTILITIES	
---	UGU UTILITY (GENERIC-UNKNOWN)
---	TELEPHONE
---	ELECTRIC
---	CABLE (TV)
---	UEC ELECTRIC+CABLE
---	UET ELECTRIC+TELEPHONE
---	UCT CABLE+TELEPHONE
---	UECT ELECTRIC+CABLE+TELEP.
---	GAS LINE
---	WATER LINE
---	SANITARY SEWER (SEPTIC)
ABOVE GROUND UTILITIES (AERIAL)	
---	AGU UTILITY (GENERIC-UNKNOWN)
---	TELEPHONE
---	ELECTRIC
---	C CABLE (TV)
---	EC ELECTRIC+CABLE
---	ET ELECTRIC+TELEPHONE
---	ECT ELECTRIC+TELEPHONE
---	ECT CABLE+TELEPHONE
---	ECT ELECTRIC+CABLE+TELEP.
---	UTILITY POLE GUY WIRE

PROJECT CONSTRUCTION SYMBOLY

PROJECT DESIGN & LAYOUT SYMBOLY	
---	CZ CLEAR ZONE
---	PLAN LAYOUT MATCHLINE

PROJECT CONSTRUCTION FEATURES

---	TOP OF CUT SLOPE
---	TOE OF FILL SLOPE
---	STONE FILL
---	BOTTOM OF DITCH
---	CULVERT PROPOSED
---	STRUCTURE SUBSURFACE
---	PROJECT DEMARCATION FENCE
---	BARRIER FENCE
---	TREE PROTECTION ZONE (TPZ)
---	STRIPING LINE REMOVAL
---	SHEET PILES

CONVENTIONAL BOUNDARY SYMBOLY

BOUNDARY LINES	
---	TOWN BOUNDARY LINE
---	COUNTY BOUNDARY LINE
---	STATE BOUNDARY LINE
---	PROPOSED STATE R.O.W. (LIMITED ACCESS)
---	PROPOSED STATE R.O.W.
---	STATE ROW (LIMITED ACCESS)
---	STATE ROW
---	TOWN ROW
---	PERMANENT EASEMENT LINE (P)
---	TEMPORARY EASEMENT LINE (T)
---	SURVEY LINE
---	PROPERTY LINE (P/L)
---	SLOPE RIGHTS
---	6F PROPERTY BOUNDARY
---	4F PROPERTY BOUNDARY
---	HAZARDOUS WASTE

EPSC LAYOUT PLAN SYMBOLY

EPSC MEASURES	
---	FILTER CURTAIN
---	SILT FENCE
---	SILT FENCE WOVEN WIRE
---	CHECK DAM
---	DISTURBED AREAS REQUIRING RE-VEGETATION
---	EROSION MATTING

ENVIRONMENTAL RESOURCES

---	WETLAND BOUNDARY
---	RIPARIAN BUFFER ZONE
---	WETLAND BUFFER ZONE
---	SOIL TYPE BOUNDARY
---	T&E THREATENED & ENDANGERED SPECIES
---	HAZARDOUS WASTE AREA
---	AG AGRICULTURAL LAND
---	HABITAT FISH & WILDLIFE HABITAT
---	FLOOD PLAIN FLOOD PLAIN
---	OHW ORDINARY HIGH WATER (OHW)
---	STORM WATER
---	USDA FOREST SERVICE LANDS
---	WILDLIFE HABITAT SUIT/CONN

ARCHEOLOGICAL & HISTORIC

---	ARCH ARCHEOLOGICAL BOUNDARY
---	HISTORIC DIST HISTORIC DISTRICT BOUNDARY
---	HISTORIC HISTORIC AREA
---	(H) HISTORIC STRUCTURE

CONVENTIONAL TOPOGRAPHIC SYMBOLY

EXISTING FEATURES	
---	ROAD EDGE PAVEMENT
---	ROAD EDGE GRAVEL
---	DRIVEWAY EDGE
---	DITCH
---	FOUNDATION
---	FENCE (EXISTING)
---	FENCE WOOD POST
---	FENCE STEEL POST
---	GARDEN
---	ROAD GUARDRAIL
---	RAILROAD TRACKS
---	CULVERT (EXISTING)
---	STONE WALL
---	WALL
---	WOOD LINE
---	BRUSH LINE
---	HEDGE
---	BODY OF WATER EDGE
---	LEDGE EXPOSED

PROJECT NAME: BRATTLEBORO
PROJECT NUMBER: BF 2000(26)

FILE NAME: z15j09legend-3i.dgn PLOT DATE: 2/5/2016
PROJECT LEADER: J. BYATT DRAWN BY: P. McKECHNE
DESIGNED BY: L. GREER CHECKED BY: S. FORTIER
CONVENTIONAL SYMBOLY LEGEND SHEET SHEET 8 OF 26



TREATED TIMBER CURB
1+13 - 1+28 LT

EXISTING BRIDGE DATA:

ROLLED BEAMS, CONCRETE DECK
SPAN = 88'-0"
WIDTH = 28'-2" OUT TO OUT
BUILT IN 1947

DURABLE 4 INCH WHITE LINE, THERMOPLASTIC
0+23 TO 1+13 SOLID LT & RT
DURABLE 4 INCH YELLOW LINE, THERMOPLASTIC
0+23 TO 1+88 SOLID LT & RT
DURABLE 24 INCH STOP BAR
0+11 TO 0+20 RT
REMOVING SIGNS
0+24 LT
0+21 RT (2)
ERECTING SALVAGED SIGN
0+21 RT (2)
SETTING SALVAGED POST
0+21 RT

PORTLAND CEMENT
CONCRETE SIDEWALK, 5 INCH
1+13 TO 1+38 RT

STONE FILL, TYPE I
GEOTEXTILE UNDER STONE FILL
1+13 TO 1+17 RT

CAST-IN-PLACE CONCRETE CURB, TYPE B
(FOR SIDEWALK RAMP TIP DOWN)
1+13 TO 1+21 RT

DETECTABLE WARNING SURFACE
0+31 RT

REHAB. DROP INLETS, CATCH BASINS,
OR MANHOLES, CLASS 1
2 - AS SHOWN AT EP
0+19 LT
1+80 RT
CHANGING ELEVATION
OF SEWER MANHOLES
0+13 RT

ADJUST
ELEVATION OF VALVE BOX
0+10 RT
~~REMOVE AND RESET TEMPORARY
TRAFFIC BARRIER
0+20 TO 0+21 RT~~

REMOVAL AND DISPOSAL OF GUARDRAIL
1+13 TO 1+46 LT


HD STEEL BEAM GUARDRAIL, GALVANIZED
1+13 TO 1+23 LT
1+13 TO 1+21 RT

ANCHOR FOR STEEL BEAM RAIL
~~1+15 RT~~
1+19 RT

DELINEATOR WITH STEEL POST
1+47 LT
1+21 RT

MANUFACTURED TERMINAL SECTION, FLARED
1+23 TO 1+47 LT

CURVE (1)
DELTA = 54°05'35" RT
D = 67°24'24"
R = 85.00'
T = 43.40'
L = 80.25'
E = 10.44'

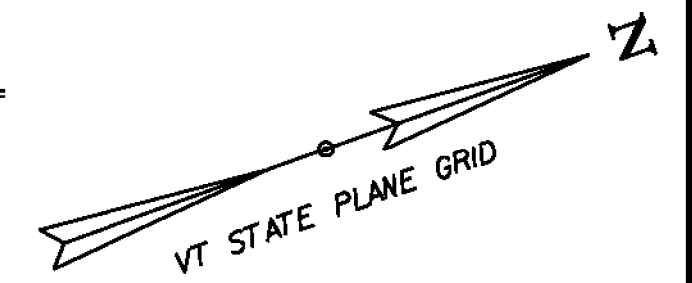

EXISTING RIGHT-OF-WAY

BEGIN APPROACH
MATCH EXISTING

END APPROACH
BEGIN PROJECT
STA 0+18




BEGIN BRIDGE
STA 0+23

END BRIDGE
STA 1+13

END PROJECT
BEGIN APPROACH
STA 1+38


END APPROACH
STA 1+88

KEY TO PAVEMENT MARKINGS
WL = SOLID WHITE LINE
YL = SOLID YELLOW LINE

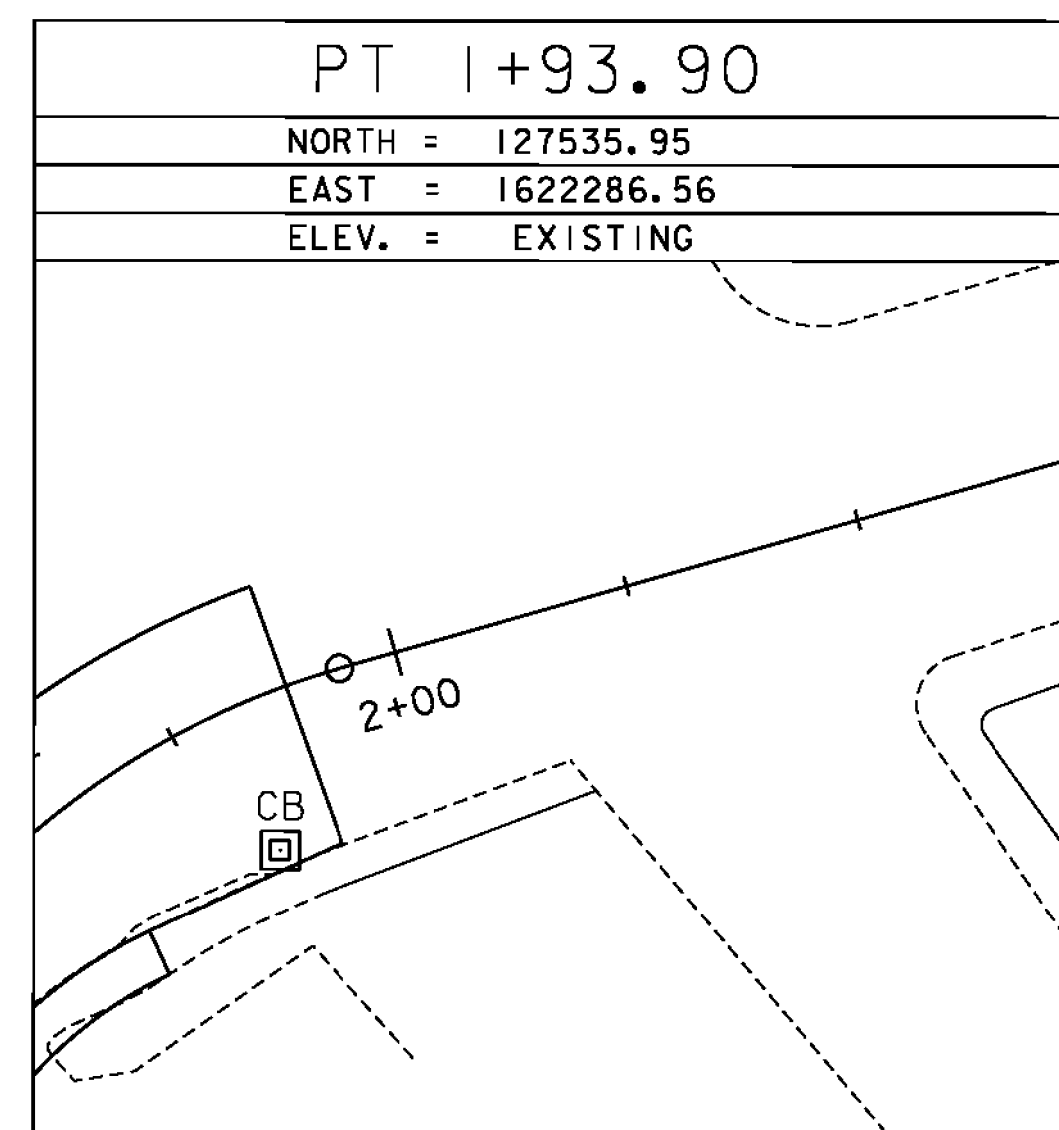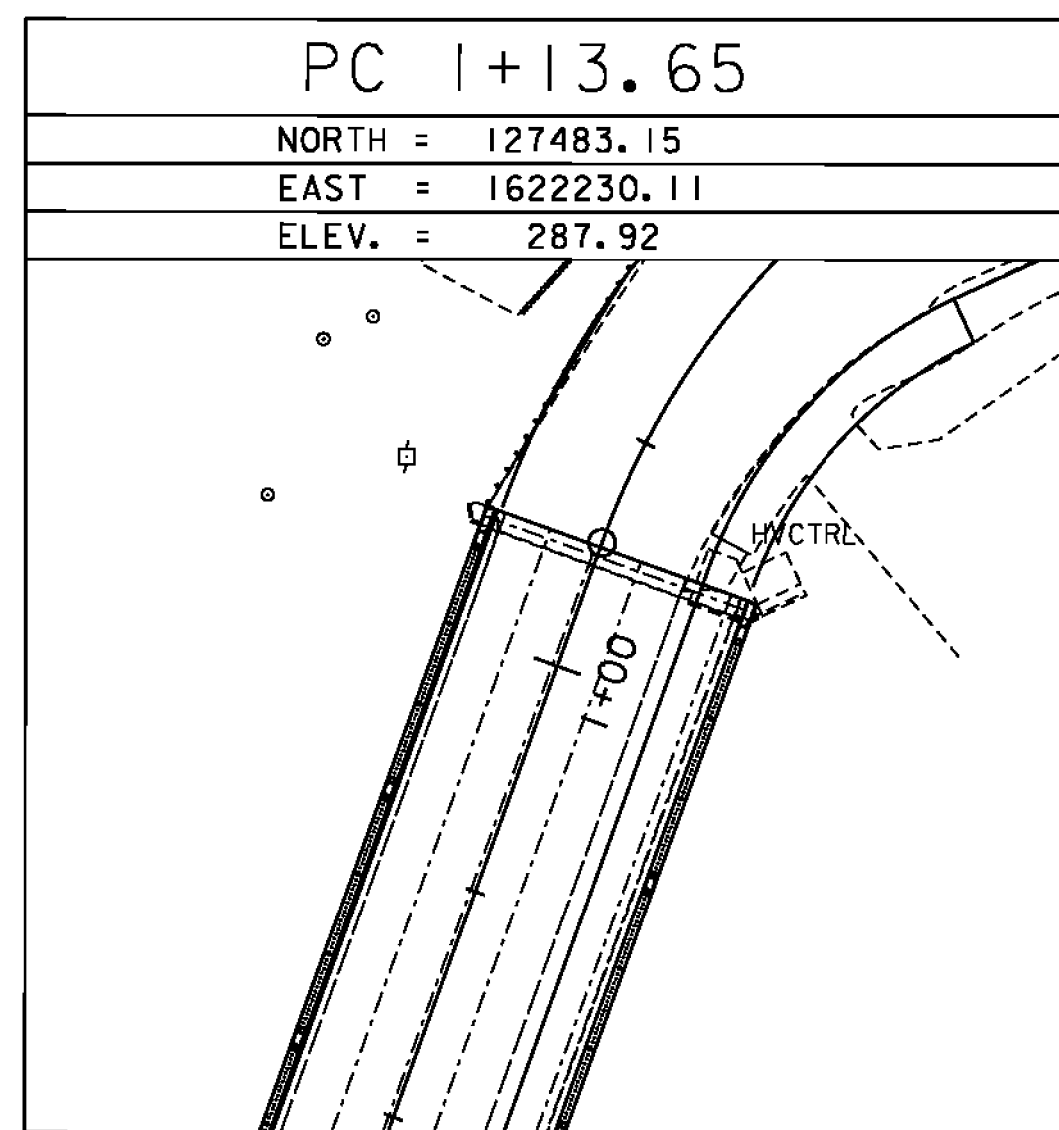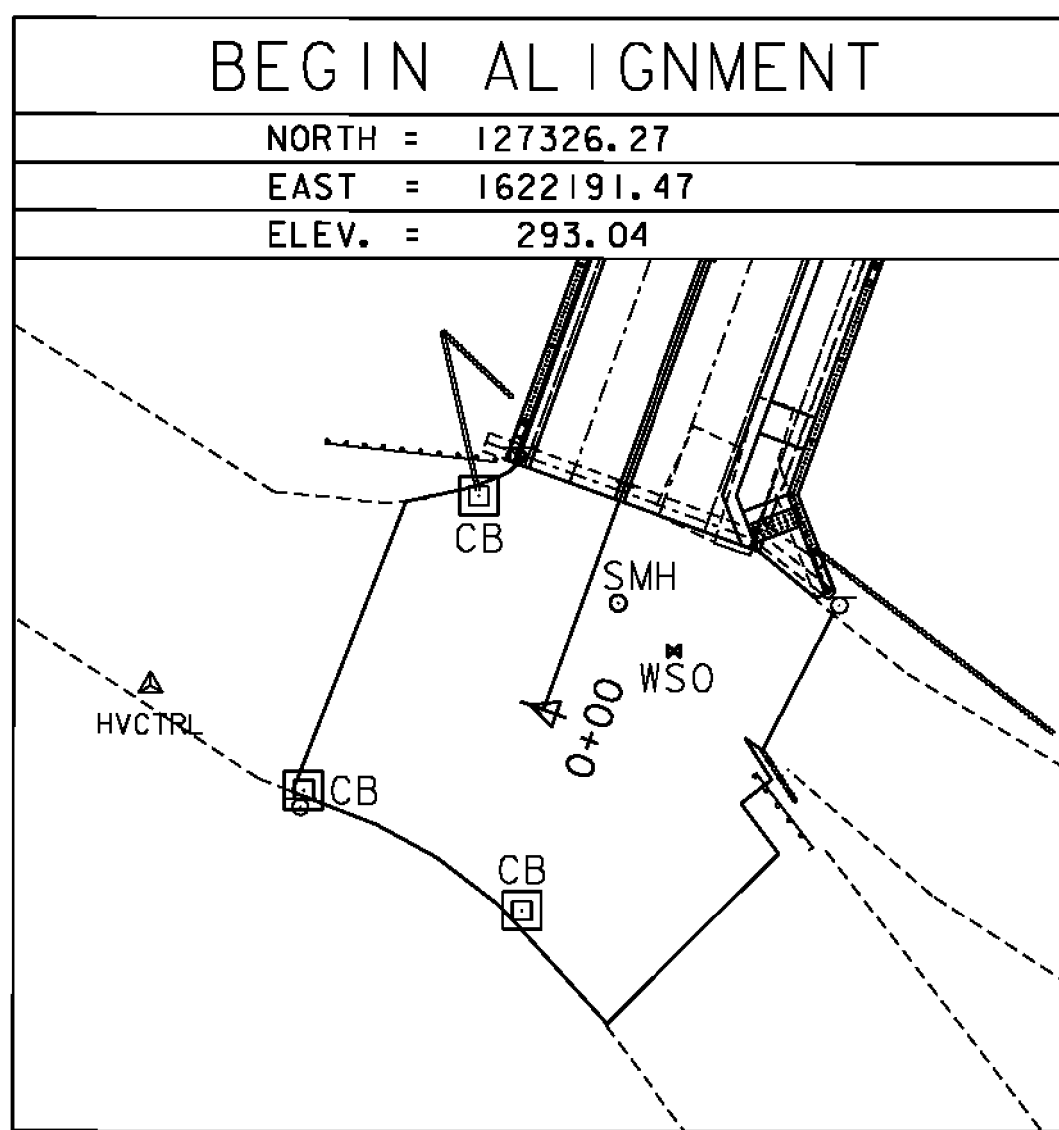


CLD 15-0223 MODEL: Layout 01

NOTE: NO TREES SHALL BE REMOVED.

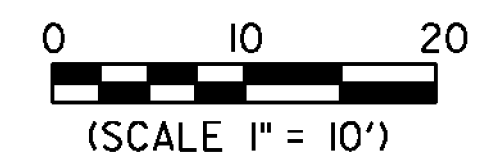

PROJECT NAME: BRATTLEBORO
PROJECT NUMBER: BF 2000(26)
FILE NAME: z15j091bdr-31.dgn
PROJECT LEADER: J. BYATT
DESIGNED BY: L. GREER
LAYOUT SHEET

PLOT DATE: 2/26/2016
DRAWN BY: P. McKECHNIE
CHECKED BY: S. FORTIER
SHEET 9 OF 26

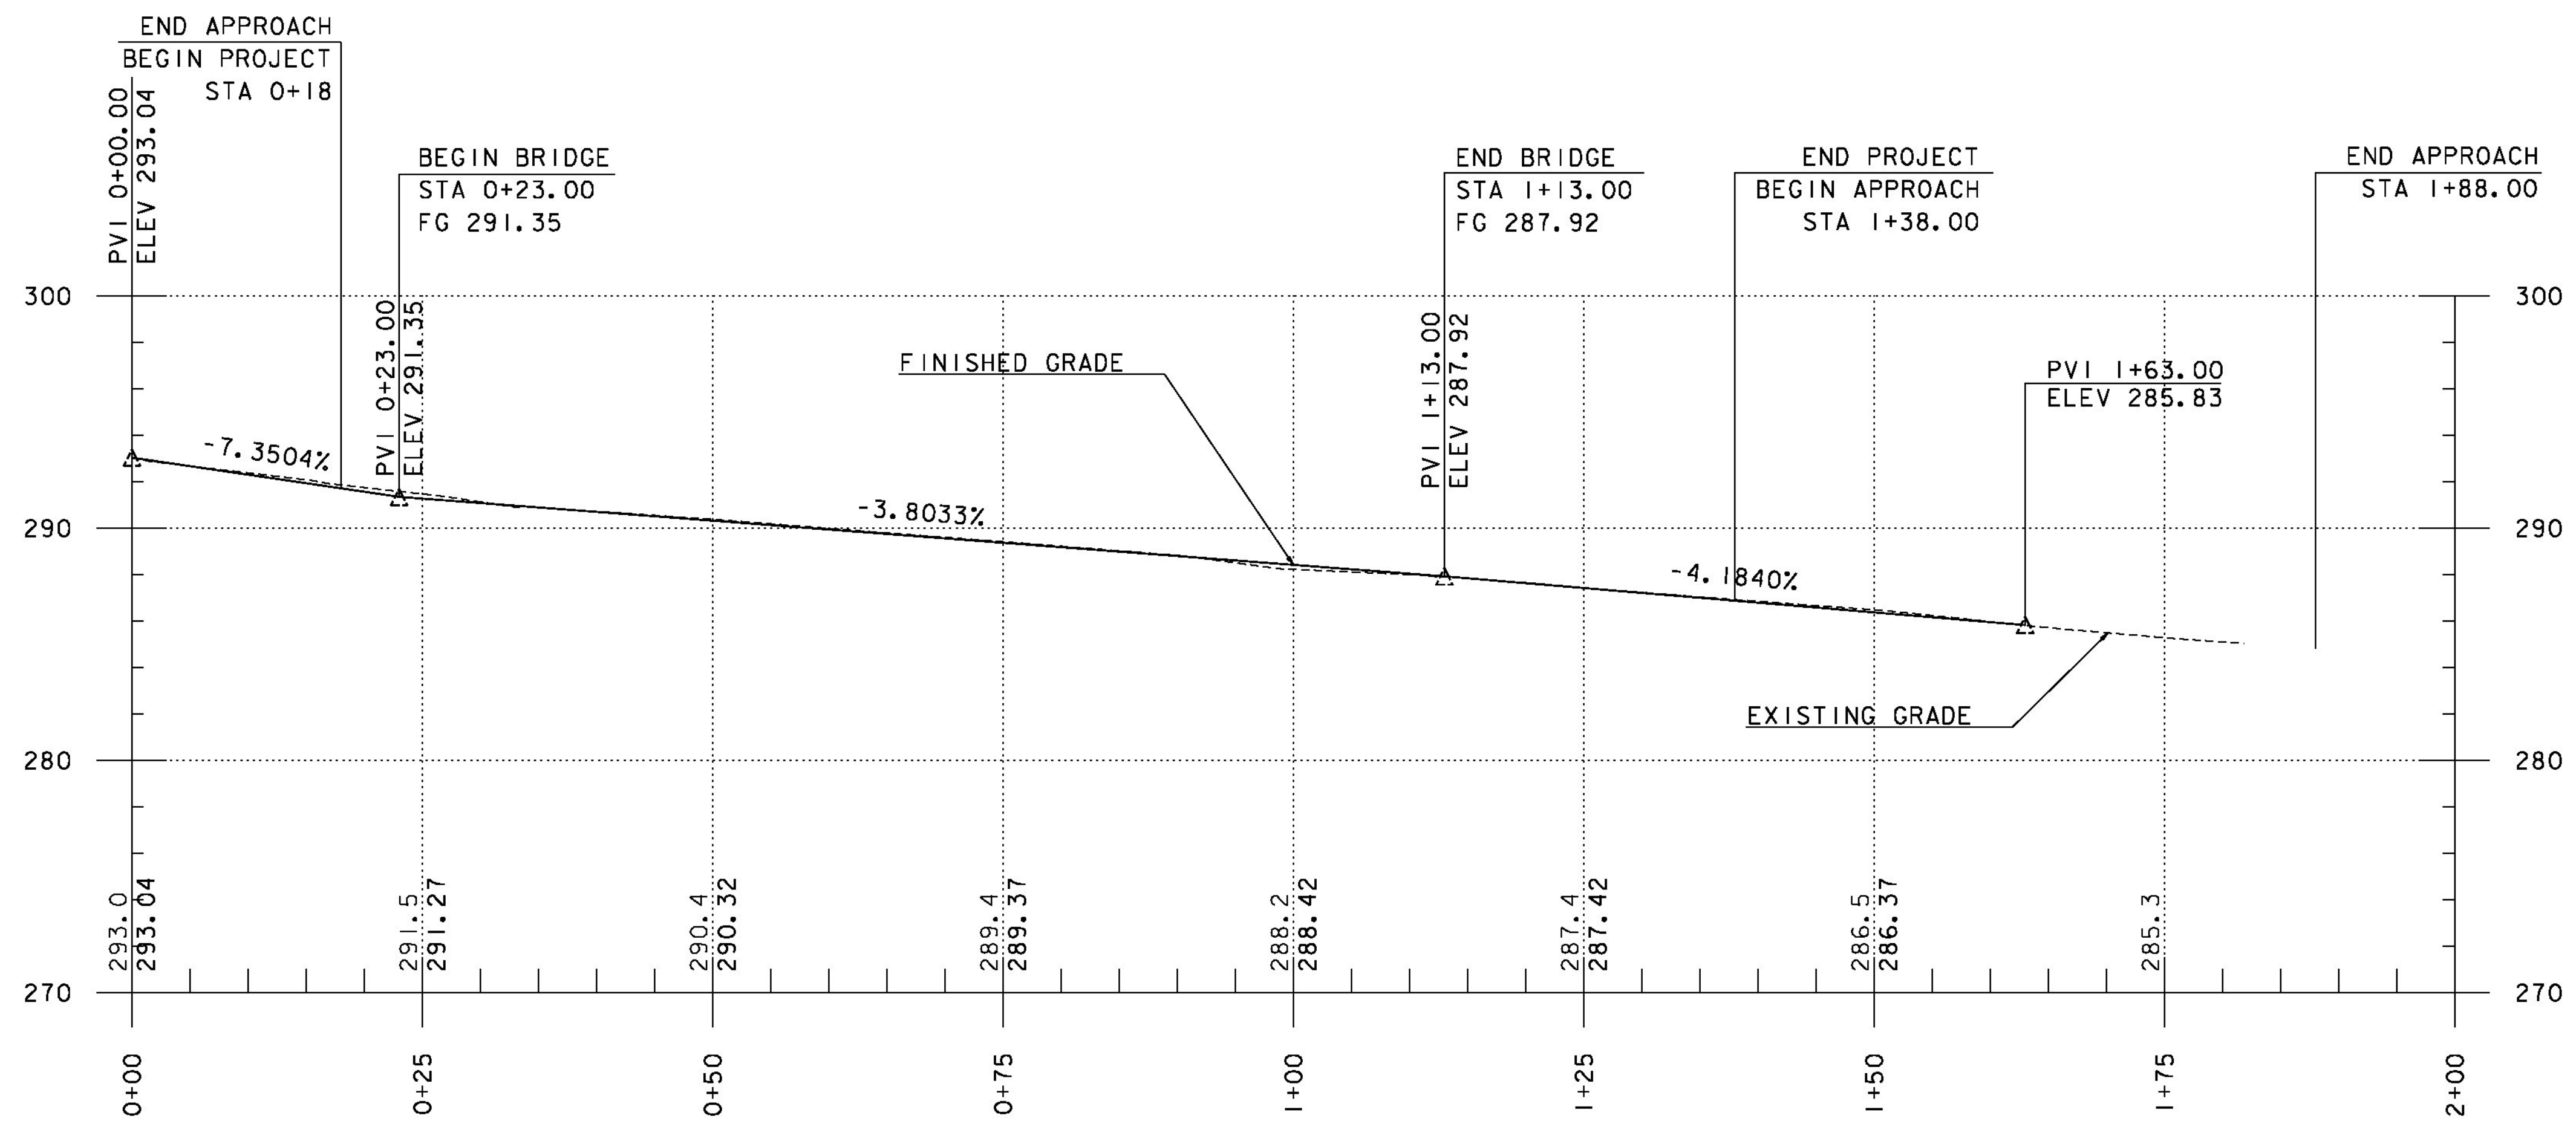

NOTES

1. STATIONS AND ELEVATIONS ARE IN FEET.
2. THE ELEVATIONS SHOWN TO THE NEAREST TENTH ARE THE EXISTING GROUND ALONG THE CENTERLINE.
3. THE ELEVATIONS SHOWN TO THE NEAREST HUNDRETH ARE THE FINISHED GRADE ALONG THE CENTERLINE.
4. PROPOSED PROFILE SHOWN IS FOR INFORMATIONAL PURPOSES ONLY. FINAL FINISHED GRADE SHALL BE DETERMINED BY THE PROJECT MANAGER AFTER EXISTING TOP OF DECK AND TOP OF BEAM ELEVATIONS ARE SURVEYED. SEE PROJECT NOTE 22 ON SHEET 3.

ELLIOT STREET PROFILE

HOR. SCALE 1" = 20'-0"
 VER. SCALE 1" = 10'-0"



GLD 15-0223 MODEL: PROFILE 01




PROJECT NAME: BRATTLEBORO
 PROJECT NUMBER: BF 2000(26)

FILE NAME: z15j09lpro-3l.dgn
 PROJECT LEADER: J. BYATT
 DESIGNED BY: L. GREER
 PROFILE SHEET

PLOT DATE: 2/5/2016
 DRAWN BY: J. FOWLER
 CHECKED BY: S. FORTIER
 SHEET 10 OF 26

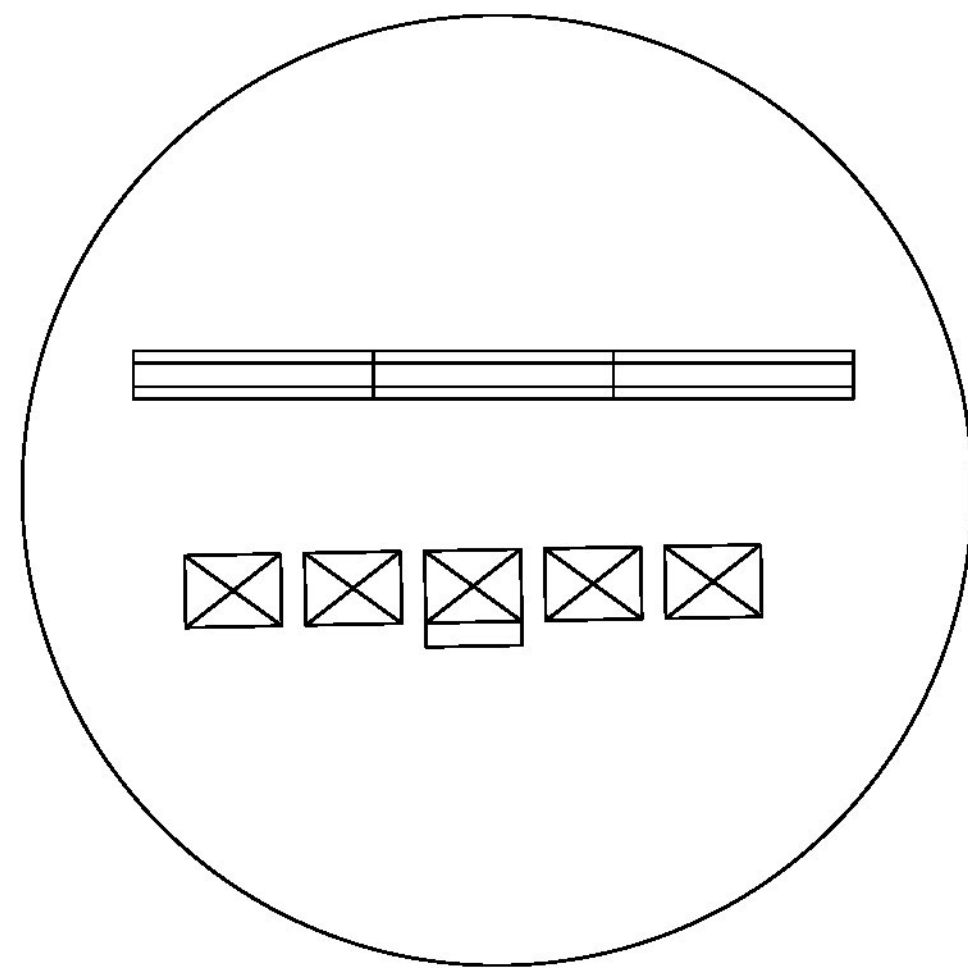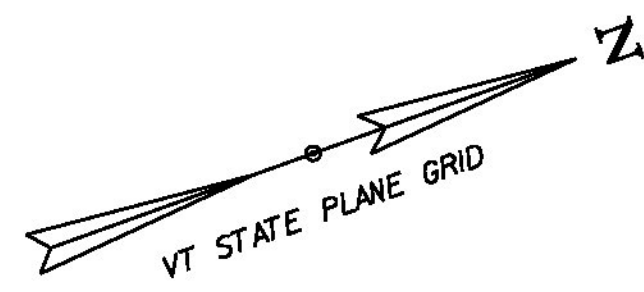


LEGEND
 N/C NEW SIGN/CONSTRUCTION ONLY
 B/O BLACK/ORANGE
 B/W BLACK/WHITE
 ☒ TYPE III BARRICADE
 ☒ TYPE III BARRICADE (MOD.)
 — TEMPORARY TRAFFIC BARRIER

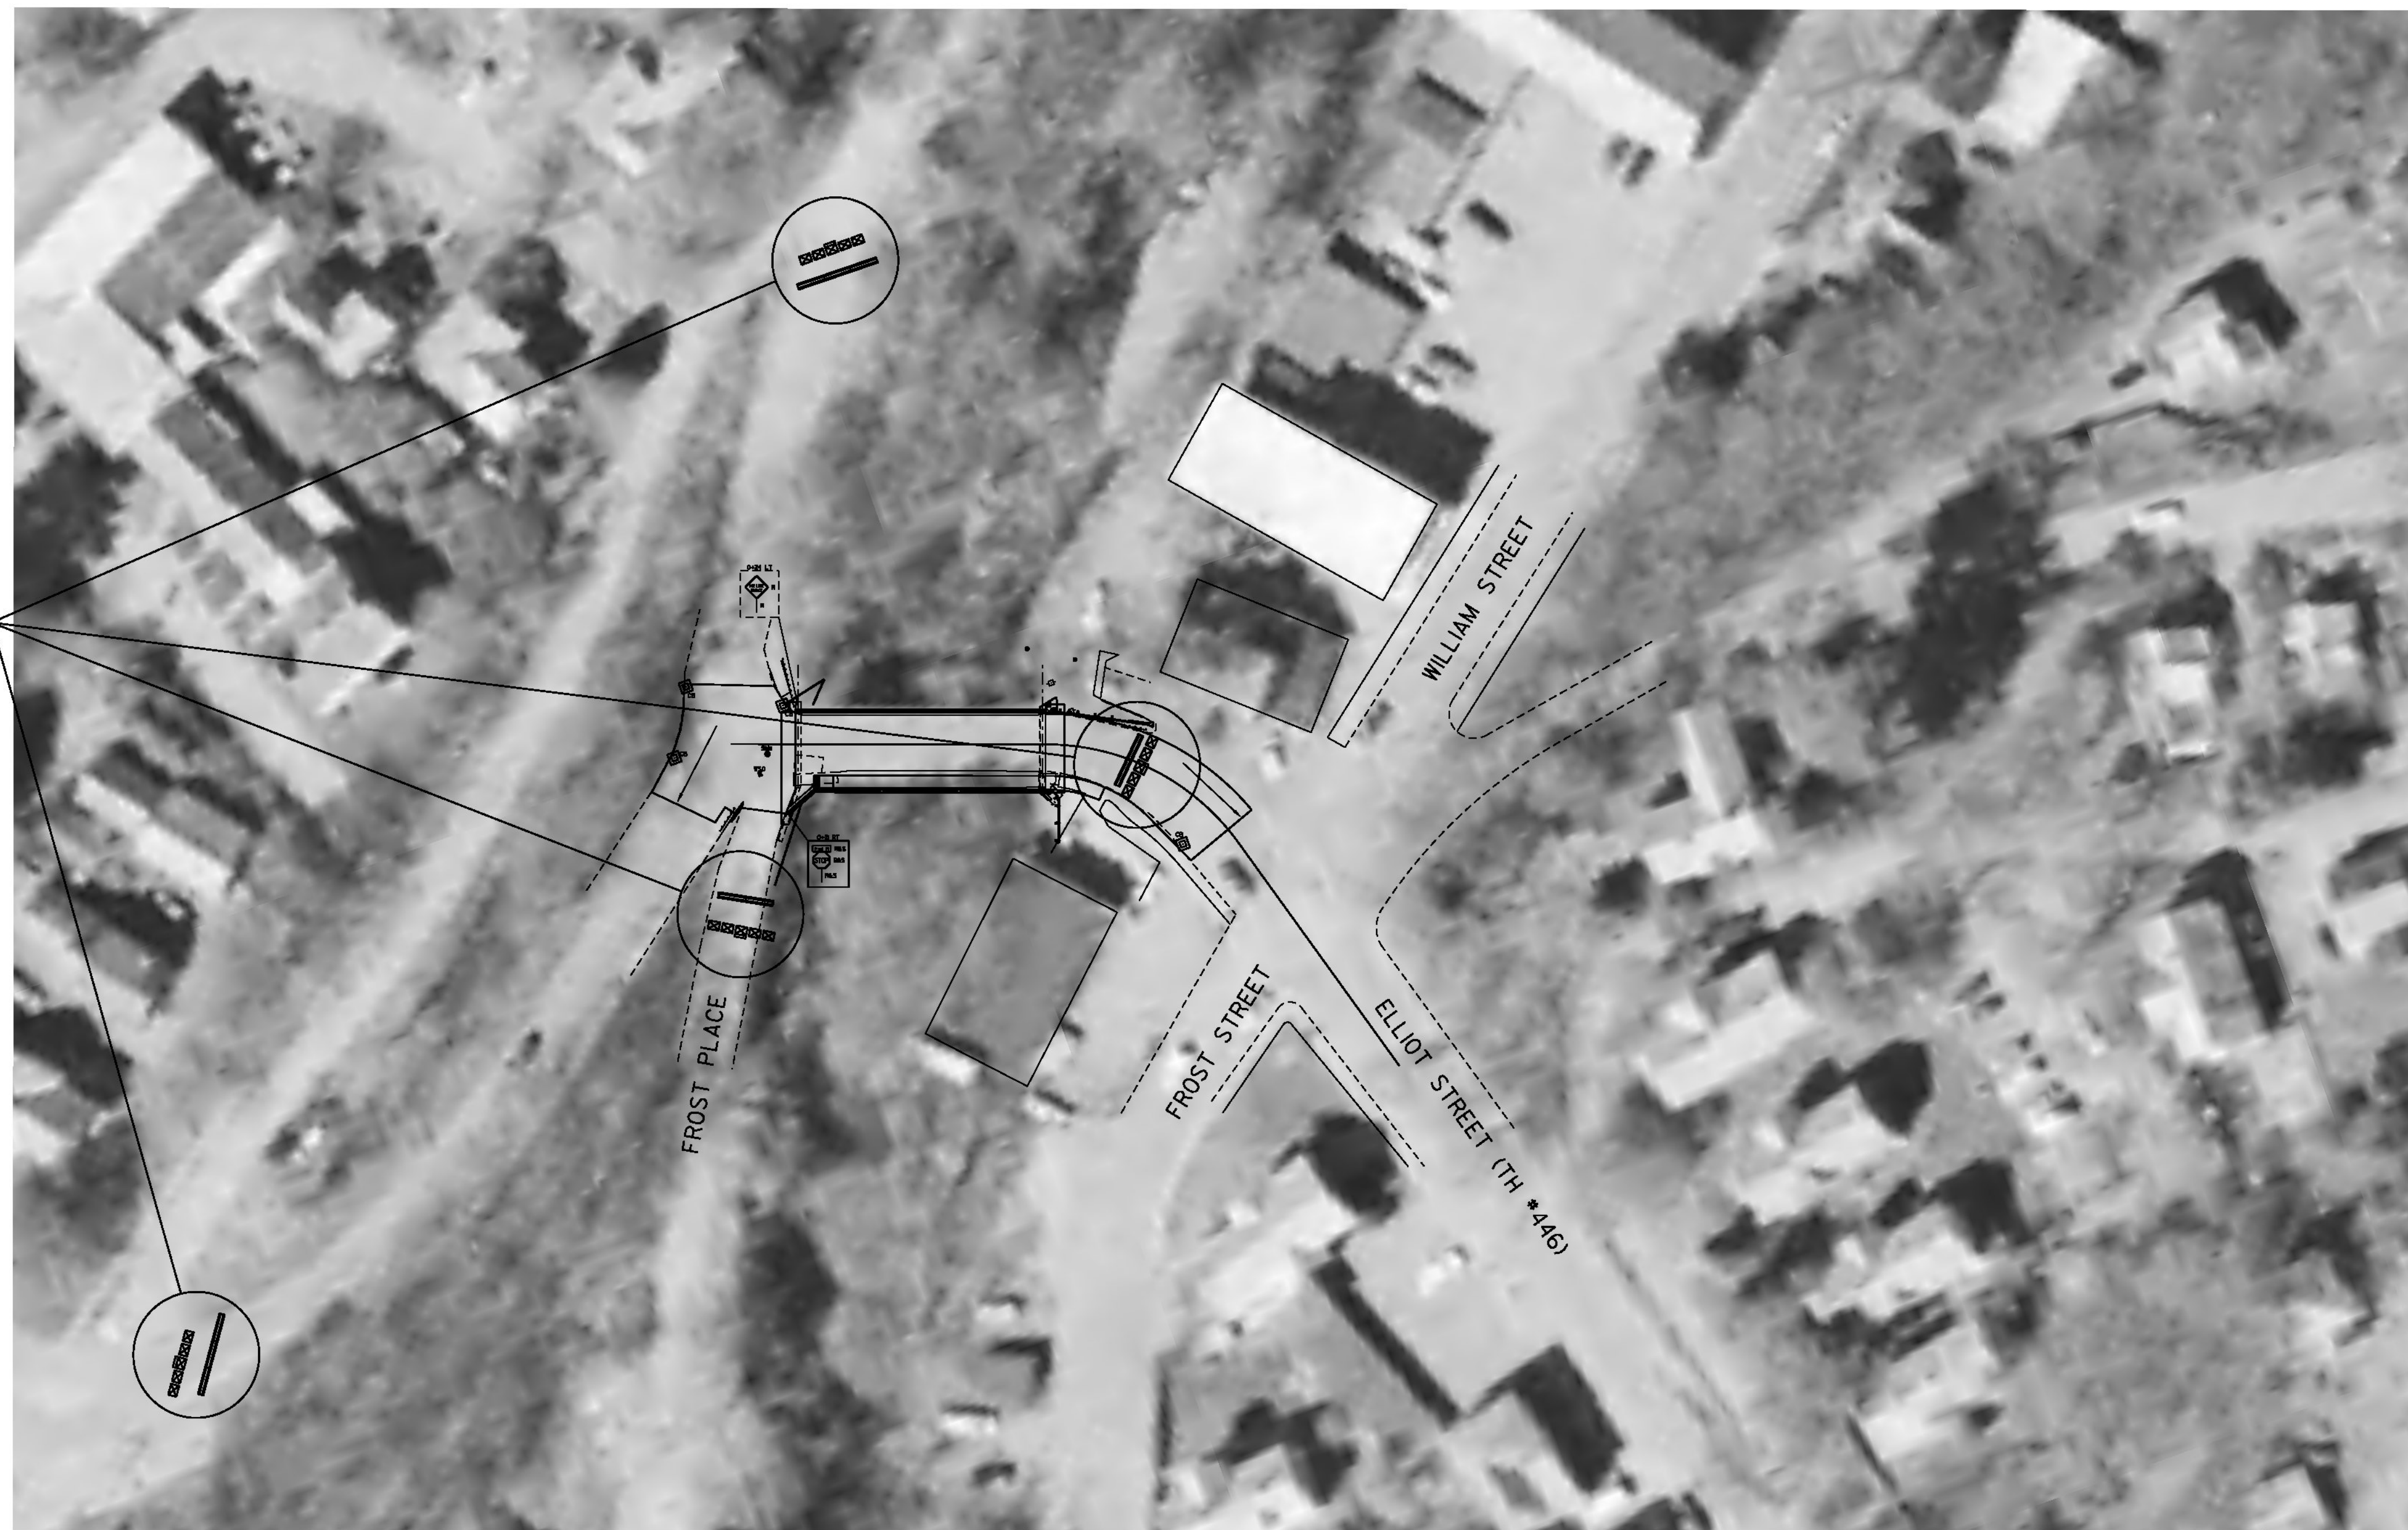

LOCATION	AADT		DHV		%T		%D		ADTT	
	2015	2035	2015	2035	2015	2035	2015	2035	2015	2035
ELLIOT STREET	4800	4900	640	650	1.4	2.1	54	54	60	90

NOTES

1. THE CONTRACTOR SHALL BE RESPONSIBLE FOR ALL SIGNS AND BARRICADES SHOWN ON THIS SHEET. THEY WILL BE PAID FOR UNDER ITEM 900.645, "SPECIAL PROVISION (TRAFFIC CONTROL, ALL-INCLUSIVE)".
2. ANY TEMPORARY TRAFFIC BARRIER REQUIRED WILL BE CONSIDERED INCIDENTAL TO PAY ITEM 900.645, "SPECIAL PROVISION (TRAFFIC CONTROL, ALL-INCLUSIVE)" AND FURNISHED IN ACCORDANCE WITH SECTION 621.
3. THE CONTRACTOR WILL PLACE ONE PORTABLE CHANGABLE MESSAGE SIGN ON EACH END OF PROJECT A MINIMUM OF TWO WEEKS PRIOR TO THE CLOSURE OF ELLIOT STREET (TH #446). THE MESSAGE SIGNS SHALL INDICATE THE ANTICIPATED BRIDGE CLOSURE PERIOD AND WILL BE PAID FOR UNDER ITEM 641.15, "PORTABLE CHANGABLE MESSAGE SIGN".

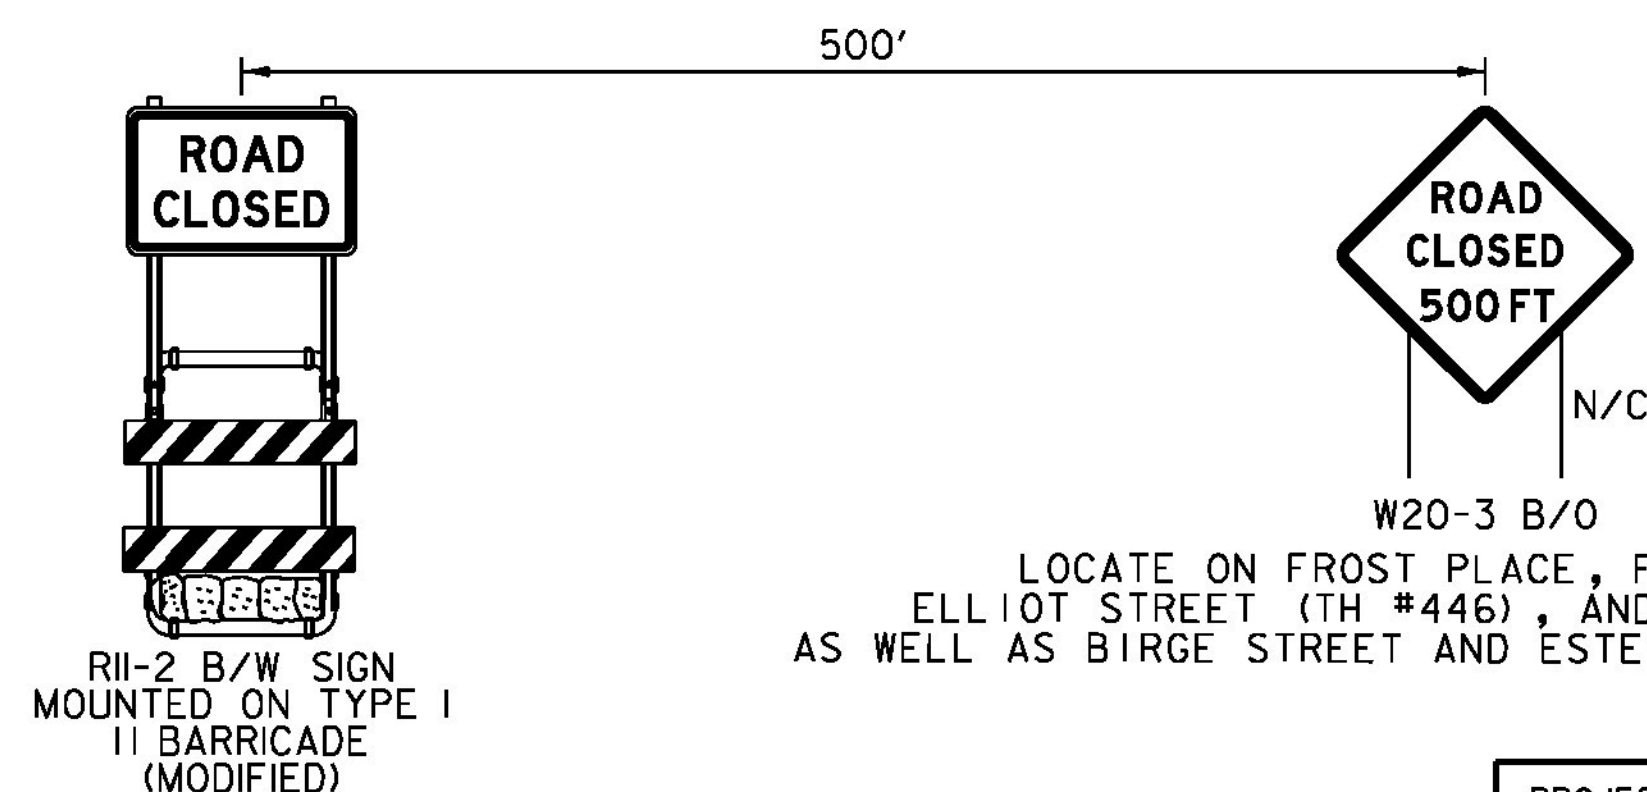


SCALE 1" = 40'-0"
 40 0 40

LOCATE ON FROST PLACE, FROST STREET, ELLIOT STREET (TH #446), AND WILLIAM STREET AS WELL AS BIRGE STREET AND ESTEY STREET TO THE WEST

PROJECT NAME: BRATTLEBORO
 PROJECT NUMBER: BF 2000(26)


FILE NAME: z15j091bdr+top-31.dgn
 PROJECT LEADER: J. BYATT
 DESIGNED BY: L. GREER
 BRIDGE CLOSURE SIGNAGE SHEET

PLOT DATE: 2/5/2016
 DRAWN BY: J. FOWLER
 CHECKED BY: S. FORTIER
 SHEET II OF 26

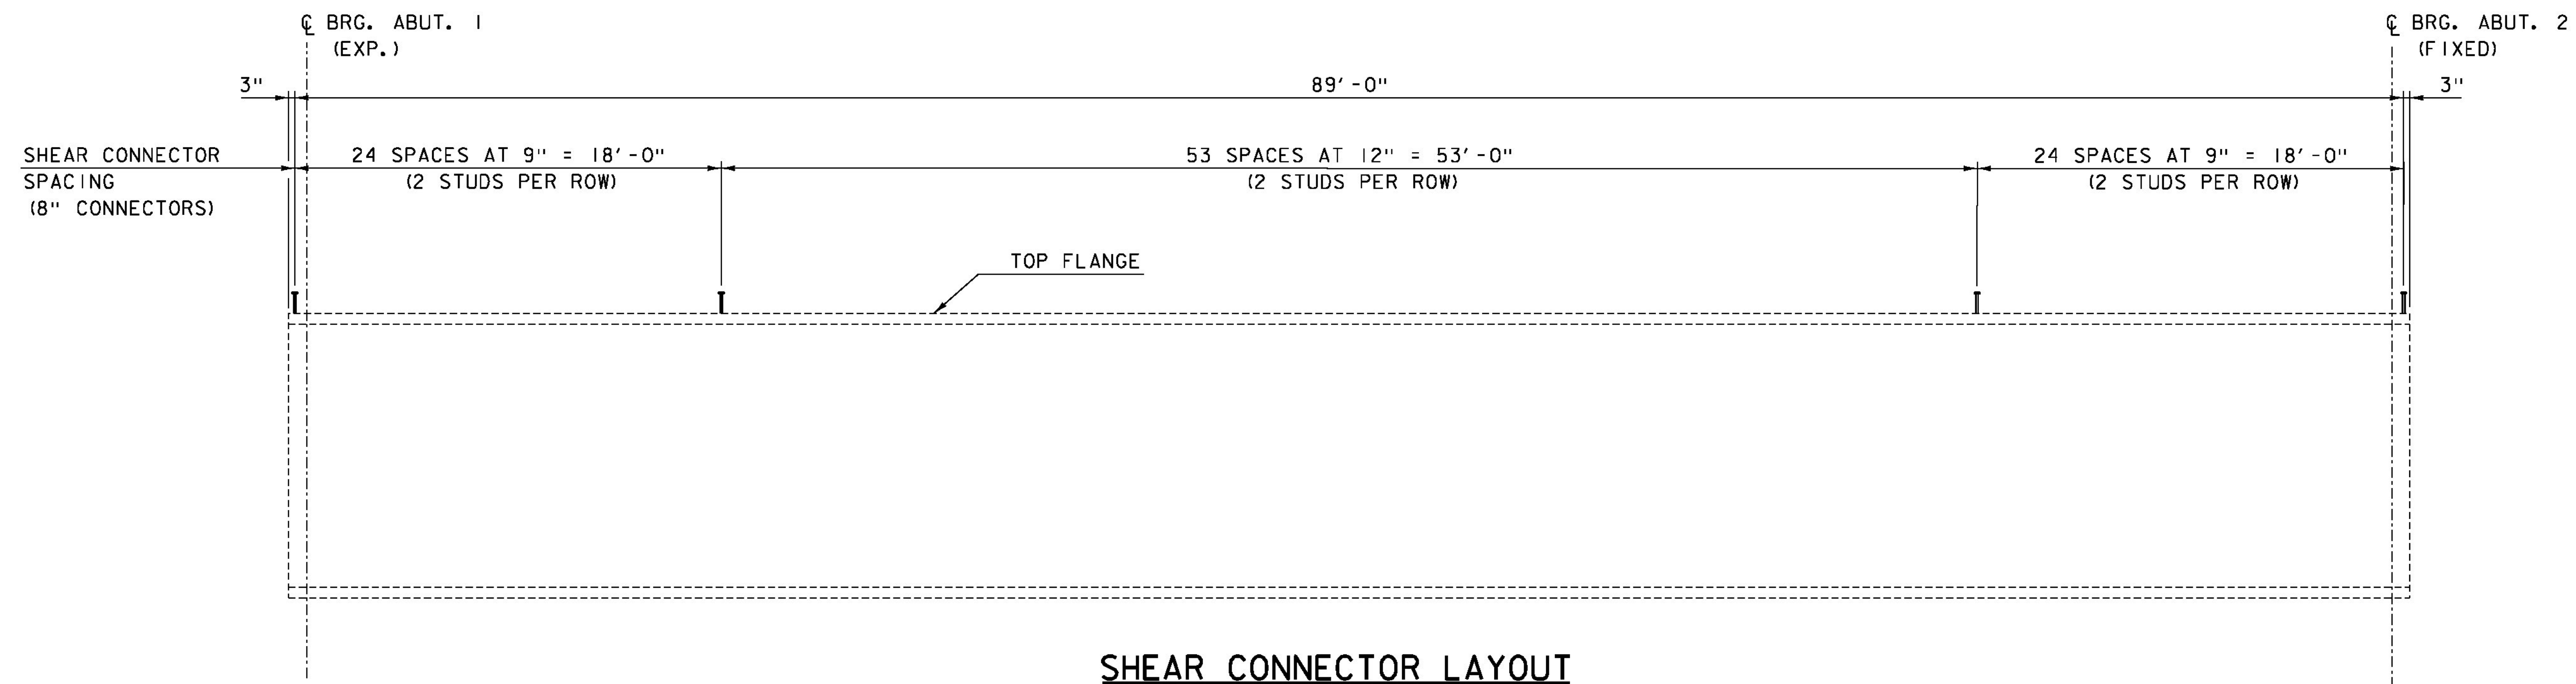


SHEAR CONNECTOR LAYOUT

HORIZONTAL SCALE: 1" = 1'-0"
 VERTICAL SCALE: 1/4" = 1'-0"

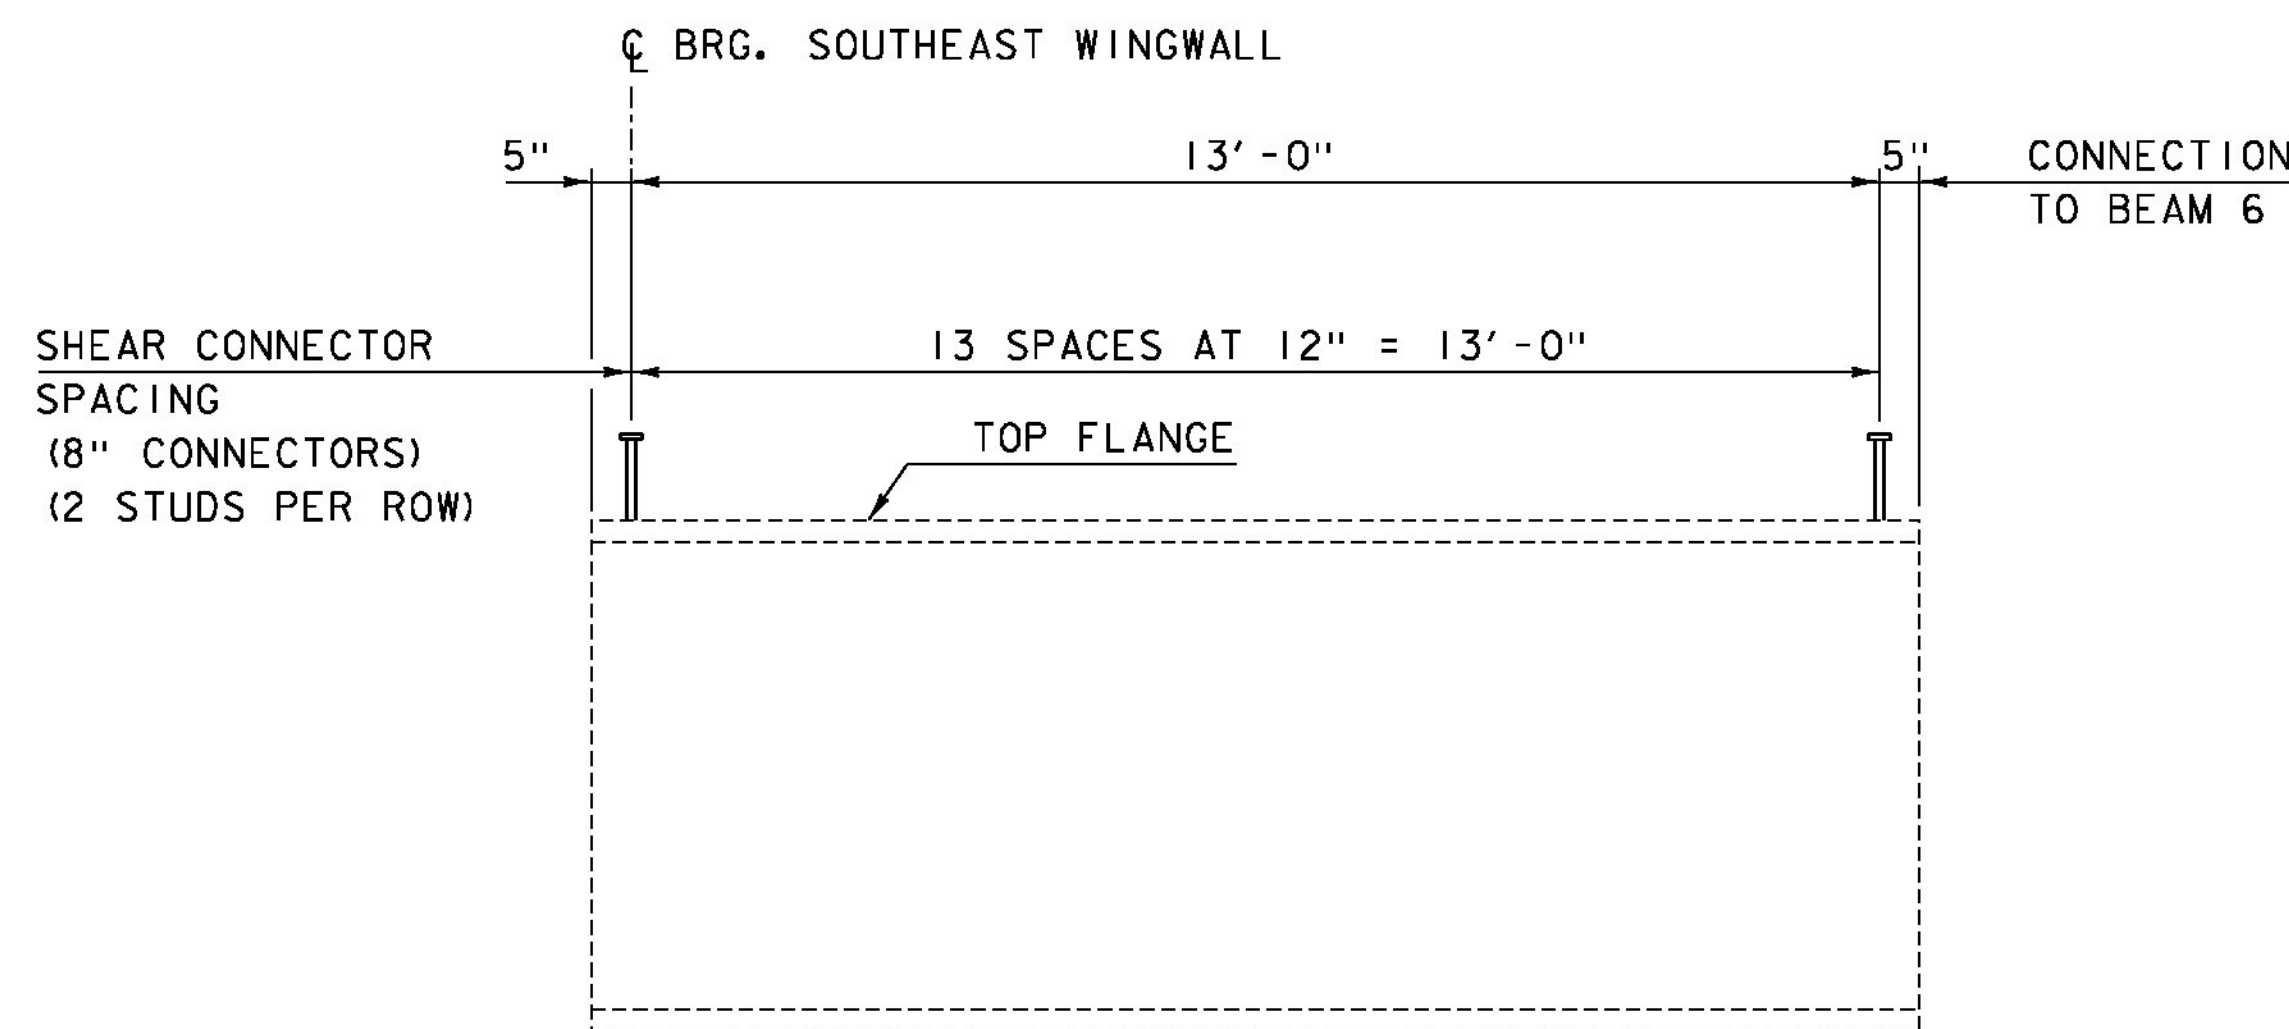


SHEAR CONNECTOR LAYOUT FOR SIDEWALK RAMP FASCIA BEAM

HORIZONTAL SCALE: 1/2" = 1'-0"
 VERTICAL SCALE: 1/8" = 1'-0"

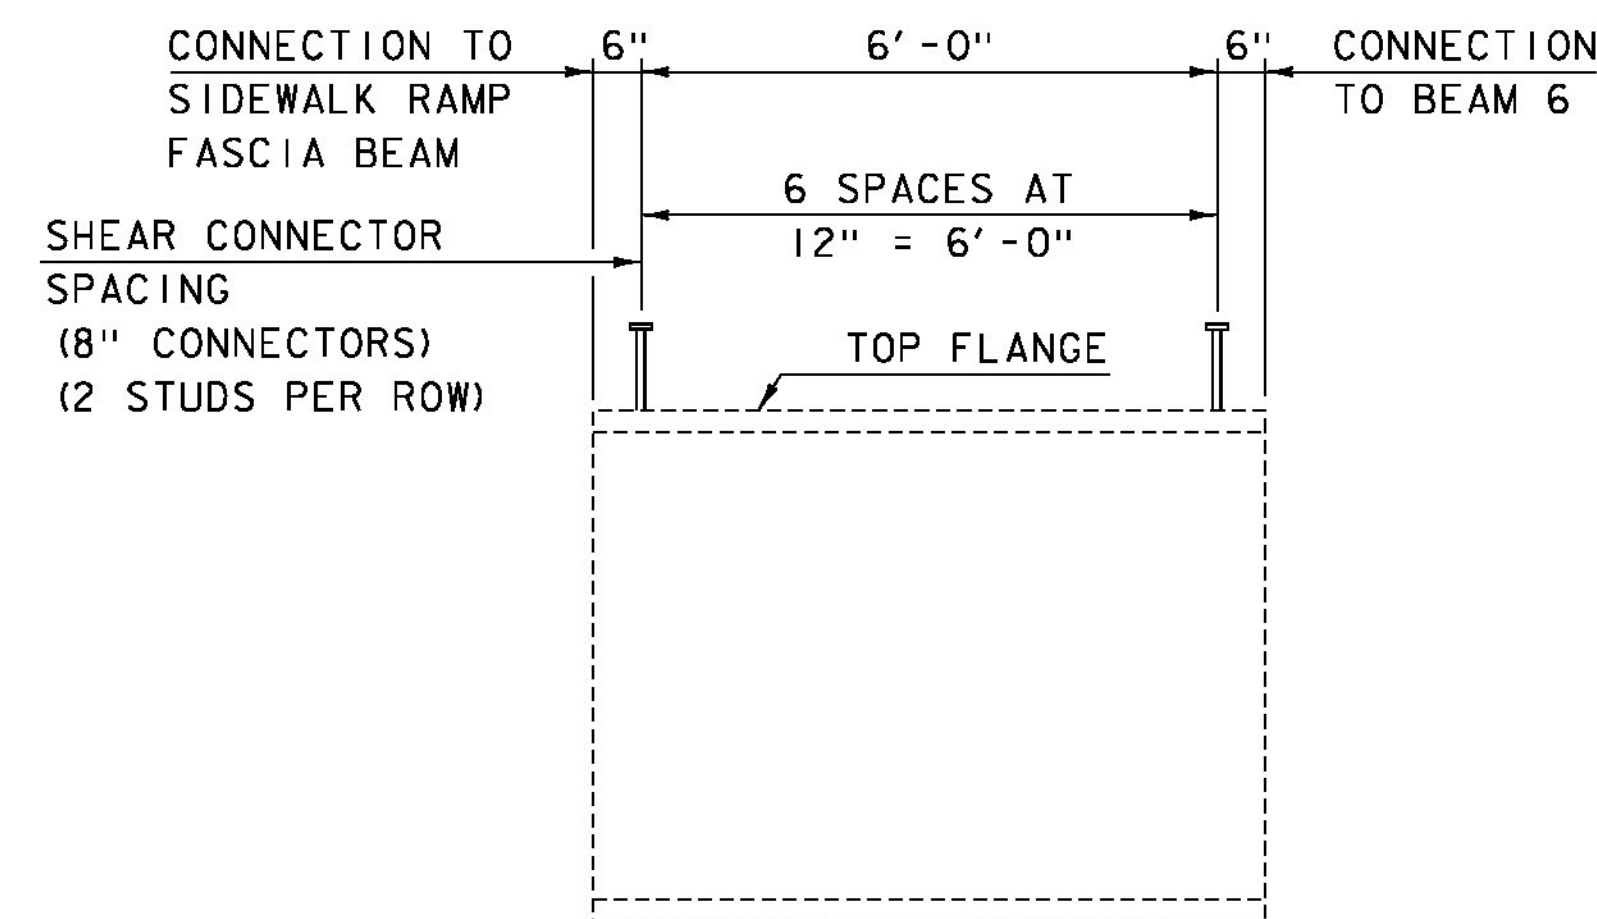

SHEAR CONNECTOR LAYOUT FOR SIDEWALK RAMP INTERIOR BEAM

HORIZONTAL SCALE: 1/2" = 1'-0"
 VERTICAL SCALE: 1/8" = 1'-0"

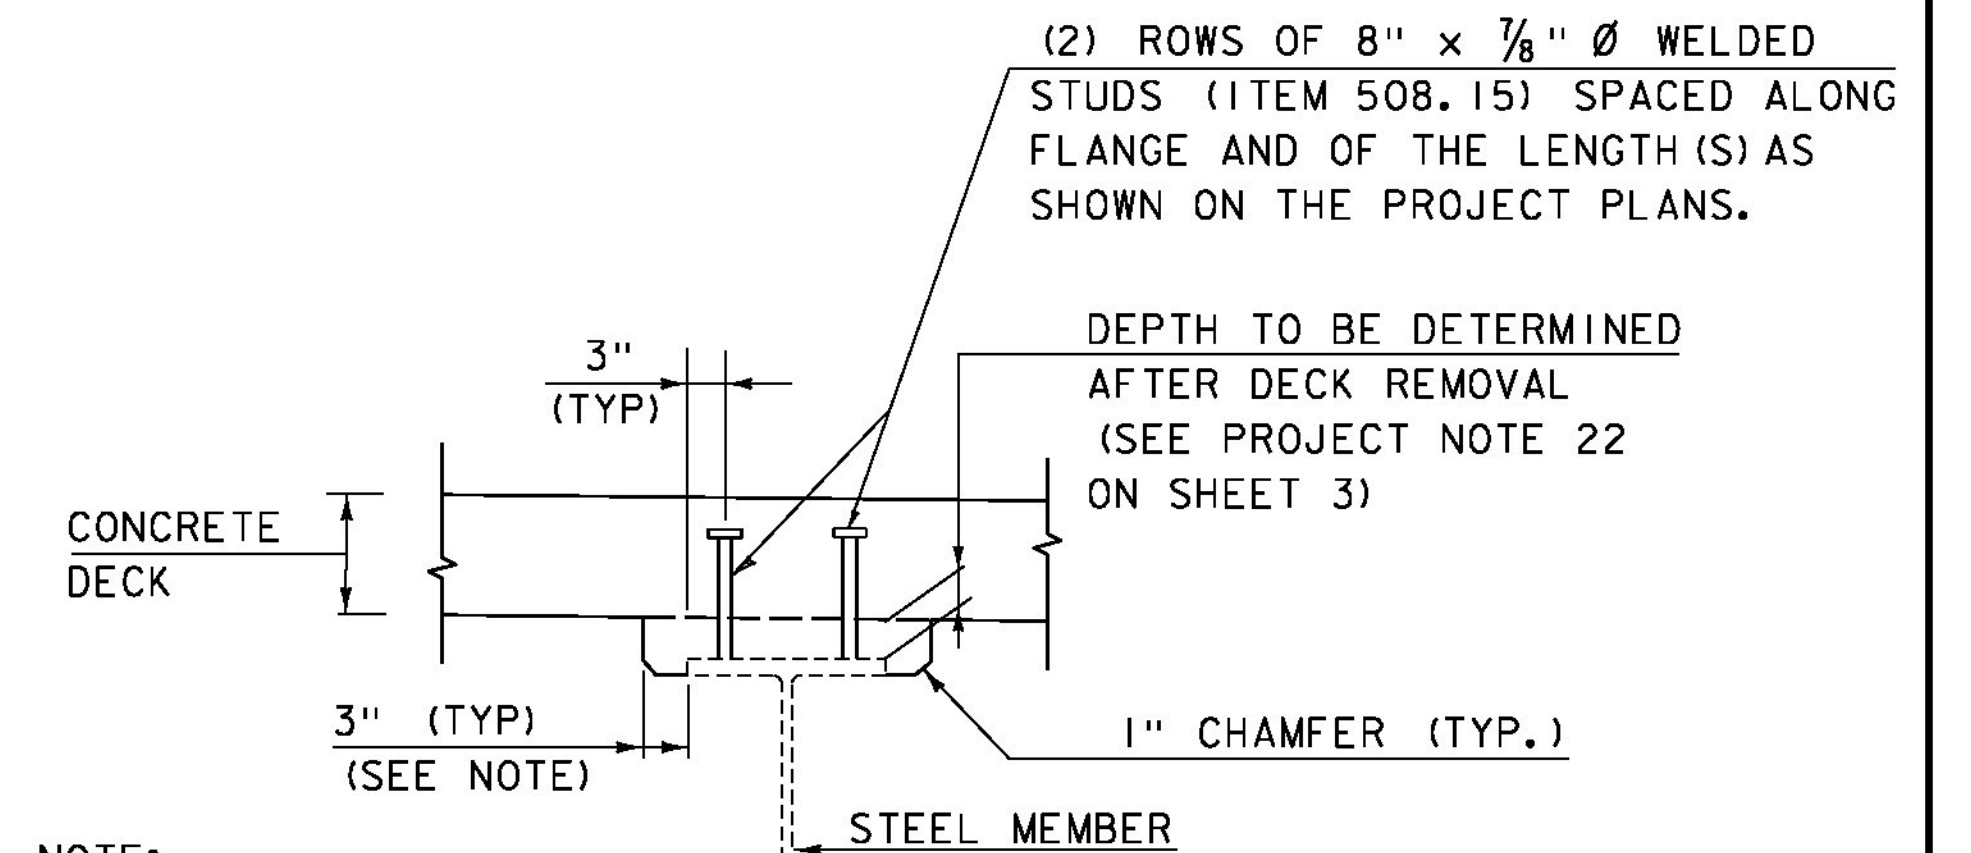

NOTE:

THE 3" HORIZONTAL SECTION MAY BE ELIMINATED FOR FORMING SYSTEMS DESIGNED FOR THE CONSTRUCTION OF VERTICAL HAUNCHES. ANY VOIDS RESULTING FROM FORMING SYSTEM ELEMENTS SHALL BE FILLED WITH JOINT SEALER, POLYURETHANE MEETING THE REQUIREMENTS OF SECTION 524. THE COST OF THE JOINT SEALER, POLYURETHANE WILL BE CONSIDERED INCIDENTAL TO THE ADJACENT CONCRETE ITEM.

HAUNCH AND SHEAR CONNECTOR DETAIL

SCALE: 3/4" = 1'-0"


MODEL: TYP03
 CLD 15-0223



PROJECT NAME: BRATTLEBORO
 PROJECT NUMBER: BF 2000(26)

FILE NAME: z15J091+yp-3i.dgn
 PROJECT LEADER: J. BYATT
 DESIGNED BY: N. CARON
 SHEAR CONNECTOR DETAILS SHEET


PLOT DATE: 2/5/2016
 DRAWN BY: M. SMITH
 CHECKED BY: S. BEAUMONT
 SHEET 12 OF 26

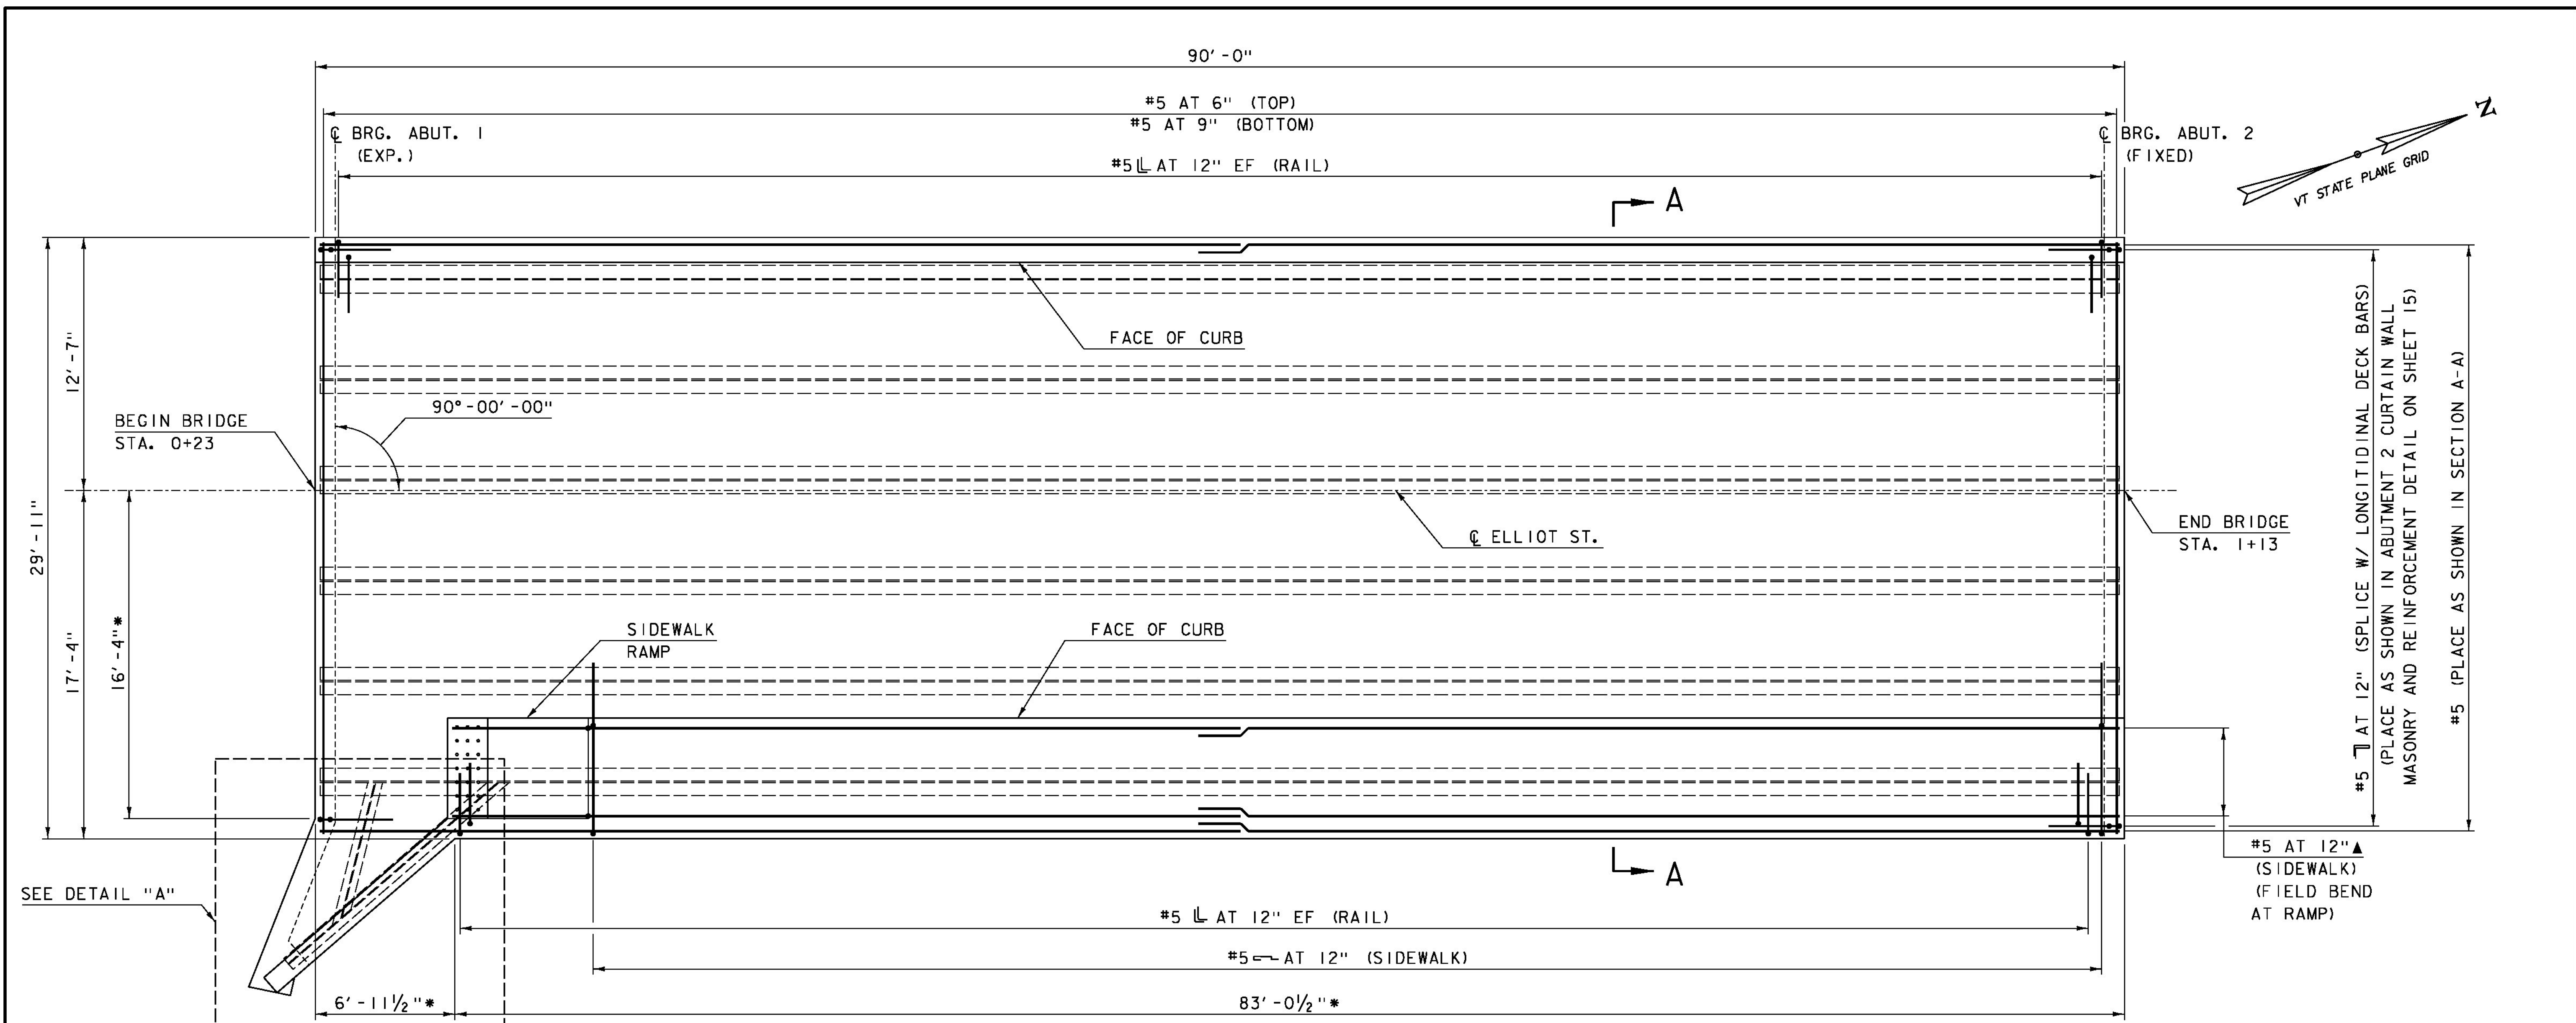

DECK REINFORCEMENT PLAN

SCALE: 1/4" = 1'-0"


* DIMENSIONS ARE BASED ON FIELD MEASUREMENTS AND ARE APPROXIMATE. THE CONTRACTOR SHALL VERIFY ALL EXISTING DIMENSIONS.

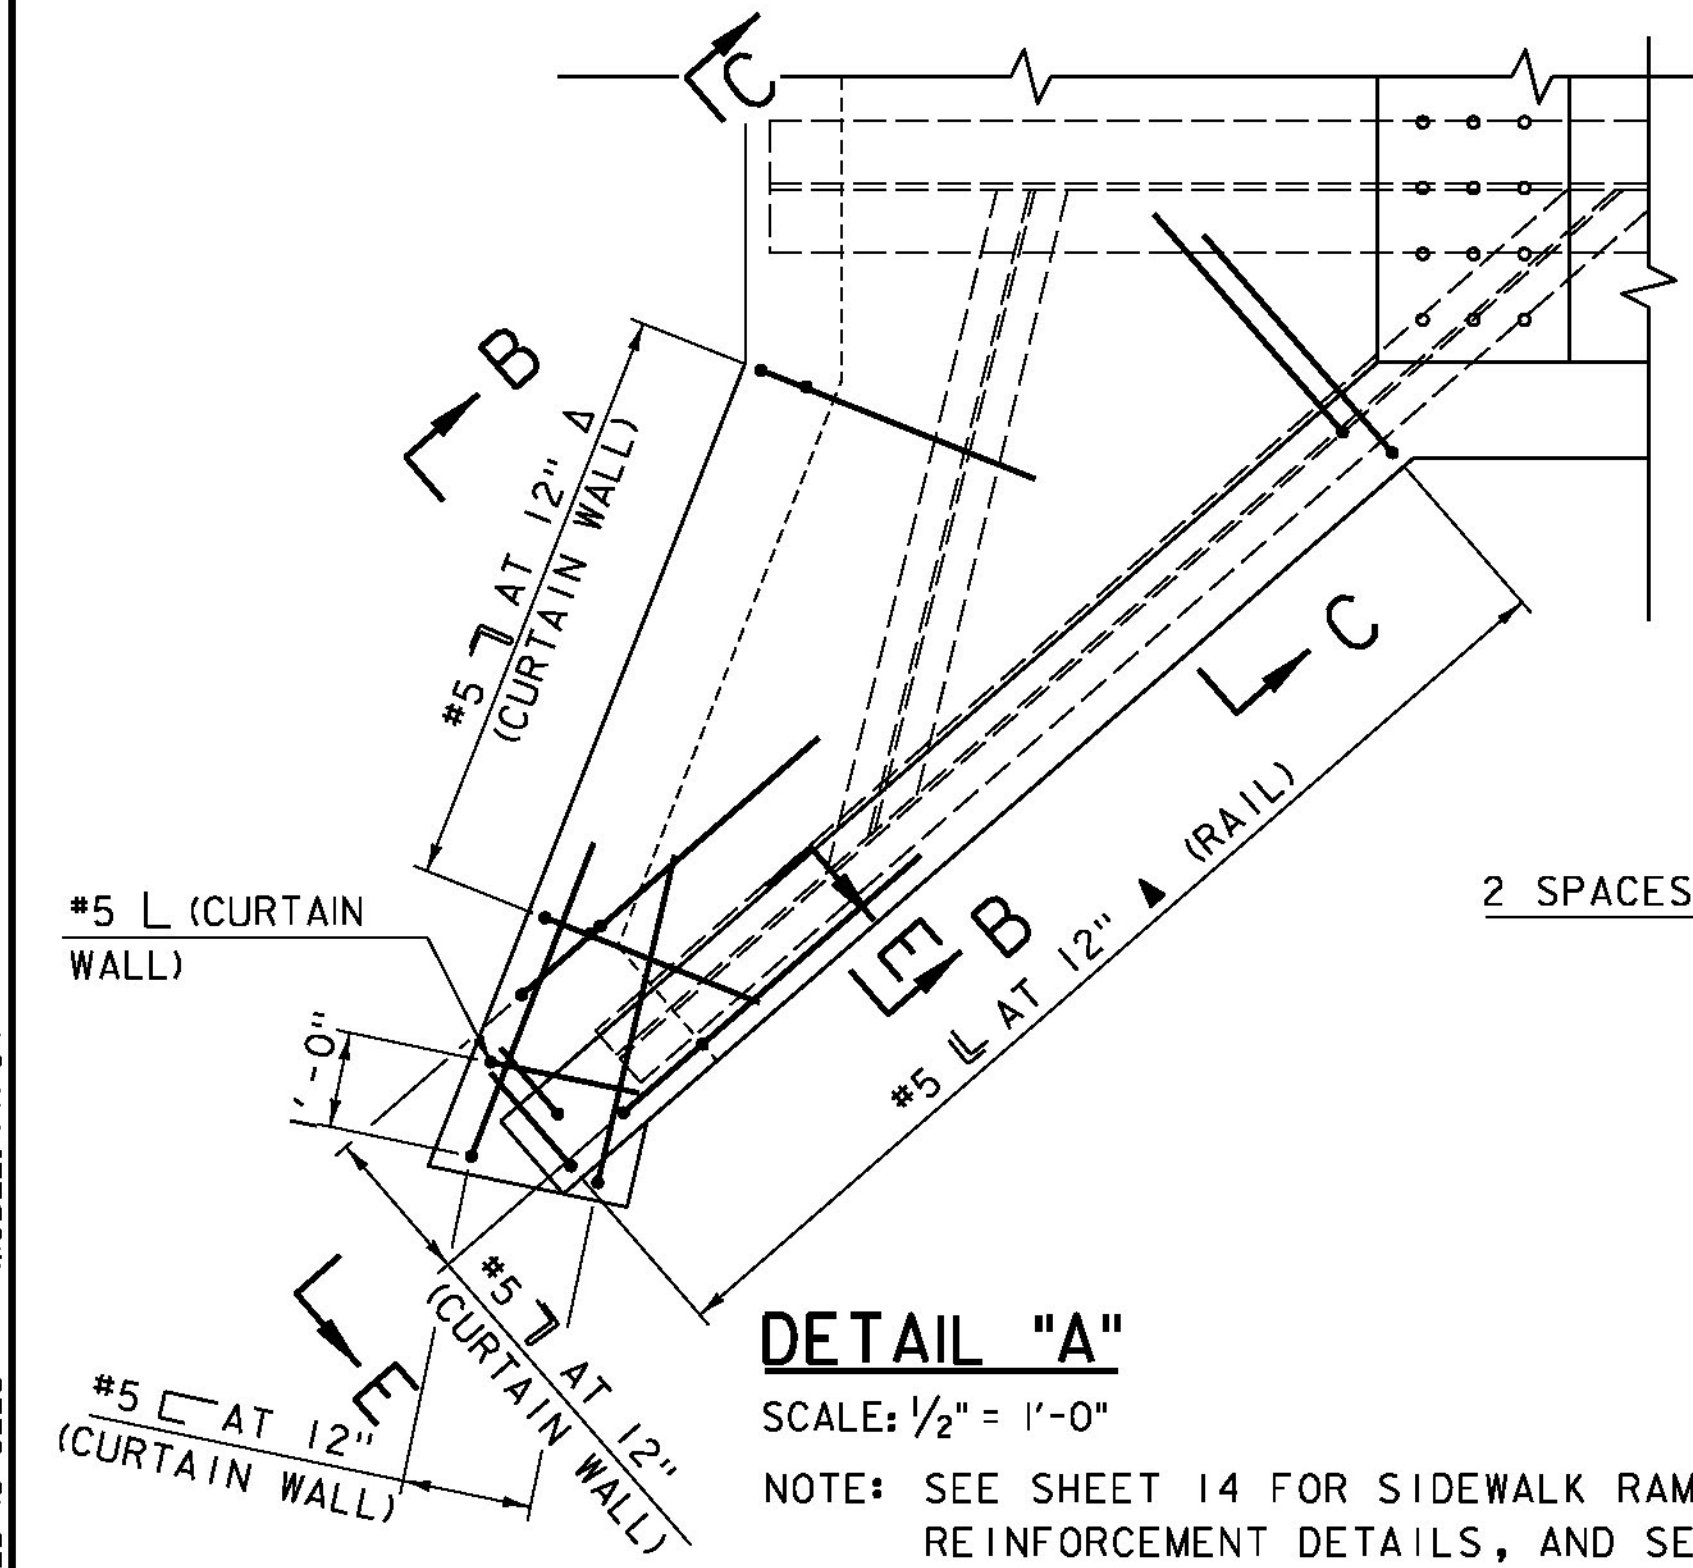

DETAIL "A"

SCALE: 1/2" = 1'-0"

NOTE: SEE SHEET 14 FOR SIDEWALK RAMP MASONRY, ADDITIONAL REINFORCEMENT DETAILS, AND SECTIONS B-B, C-C, AND E-E.

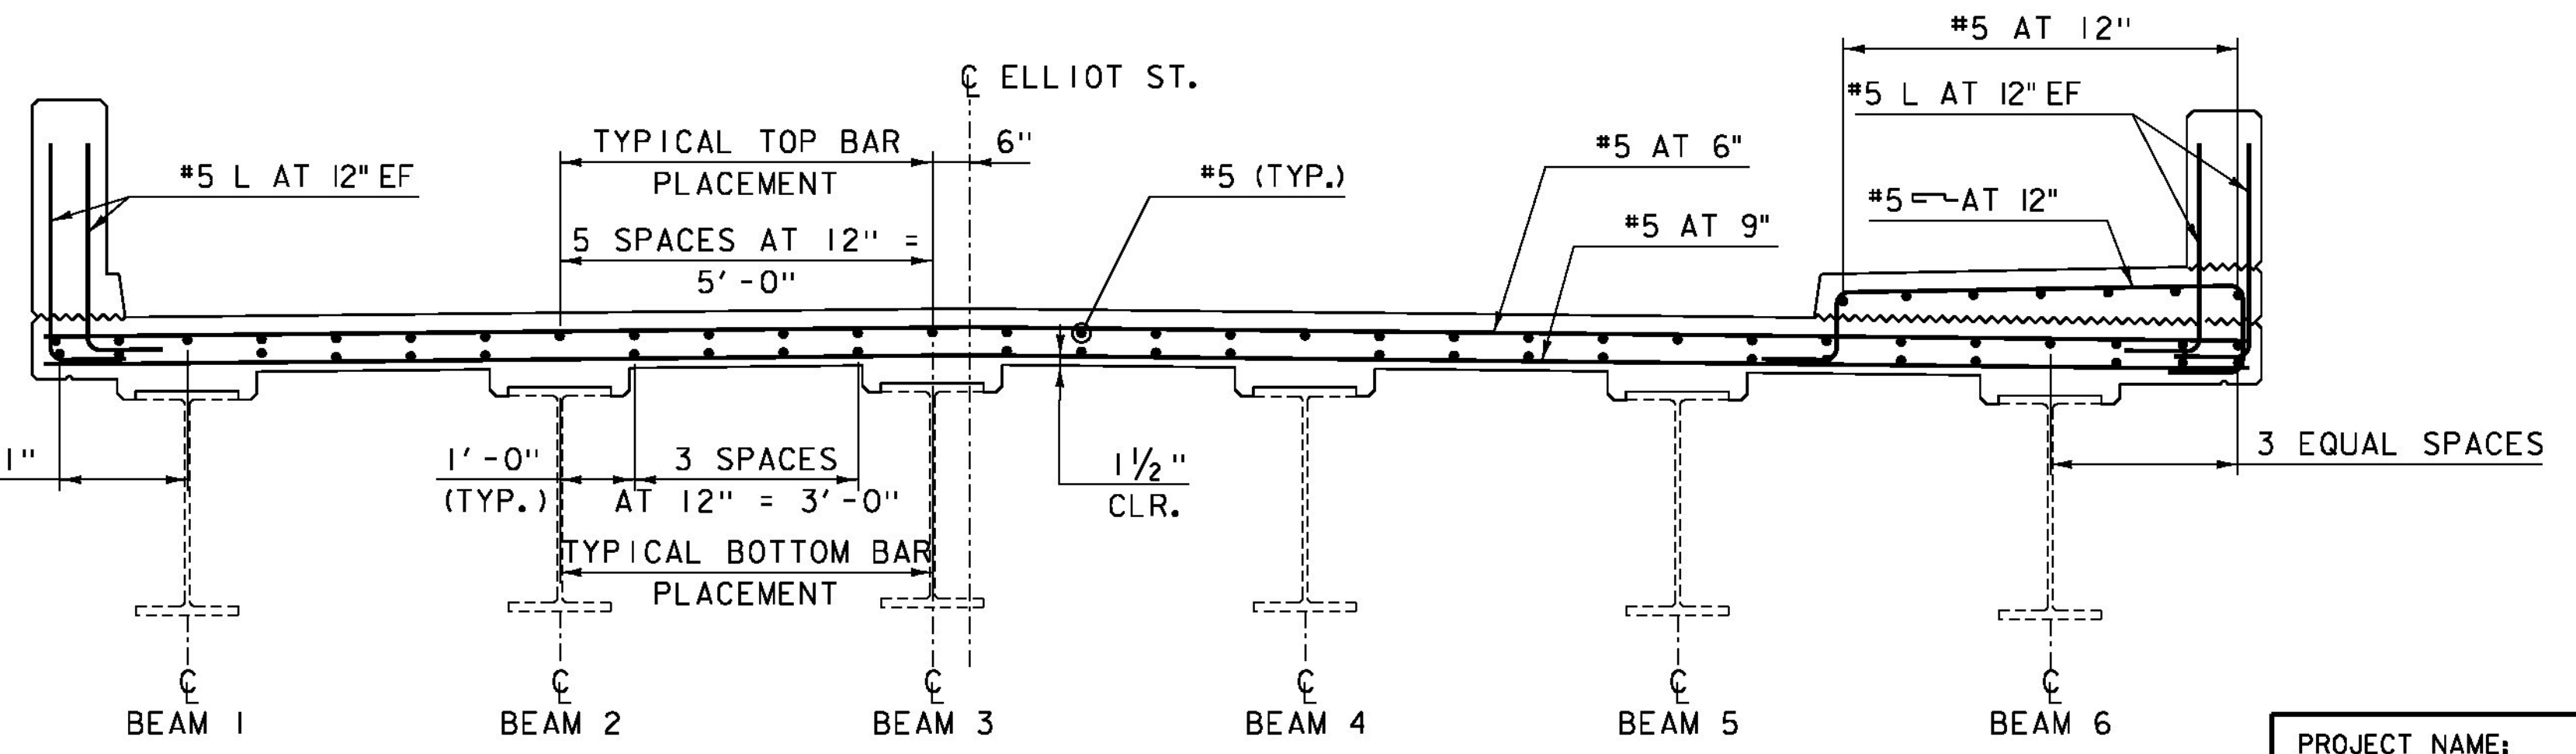

SECTION A-A

SCALE: 1/2" = 1'-0"


NOTES:

1. 3" CLEAR, UNLESS OTHERWISE SPECIFIED ON THE PLANS.
2. 3'-0" BAR LAP UNLESS OTHERWISE SPECIFIED ON THE PLANS.
3. 1'-0" HOOK UNLESS OTHERWISE SPECIFIED ON THE PLANS.
4. EF = EACH FACE
5. SEE SHEET 18 FOR RAIL LAYOUT SHEET.

PROJECT NAME:	BRATTLEBORO
PROJECT NUMBER:	BF 2000(26)
FILE NAME:	z15j091+yp-3i.dgn
PROJECT LEADER:	J. BYATT
DESIGNED BY:	S. BEAUMONT
DECK DETAILS SHEET 1	
PLOT DATE:	2/5/2016
DRAWN BY:	M. SMITH
CHECKED BY:	J. FRENCH
SHEET	13 OF 26




MODEL: TYP04
GLD 15-0223

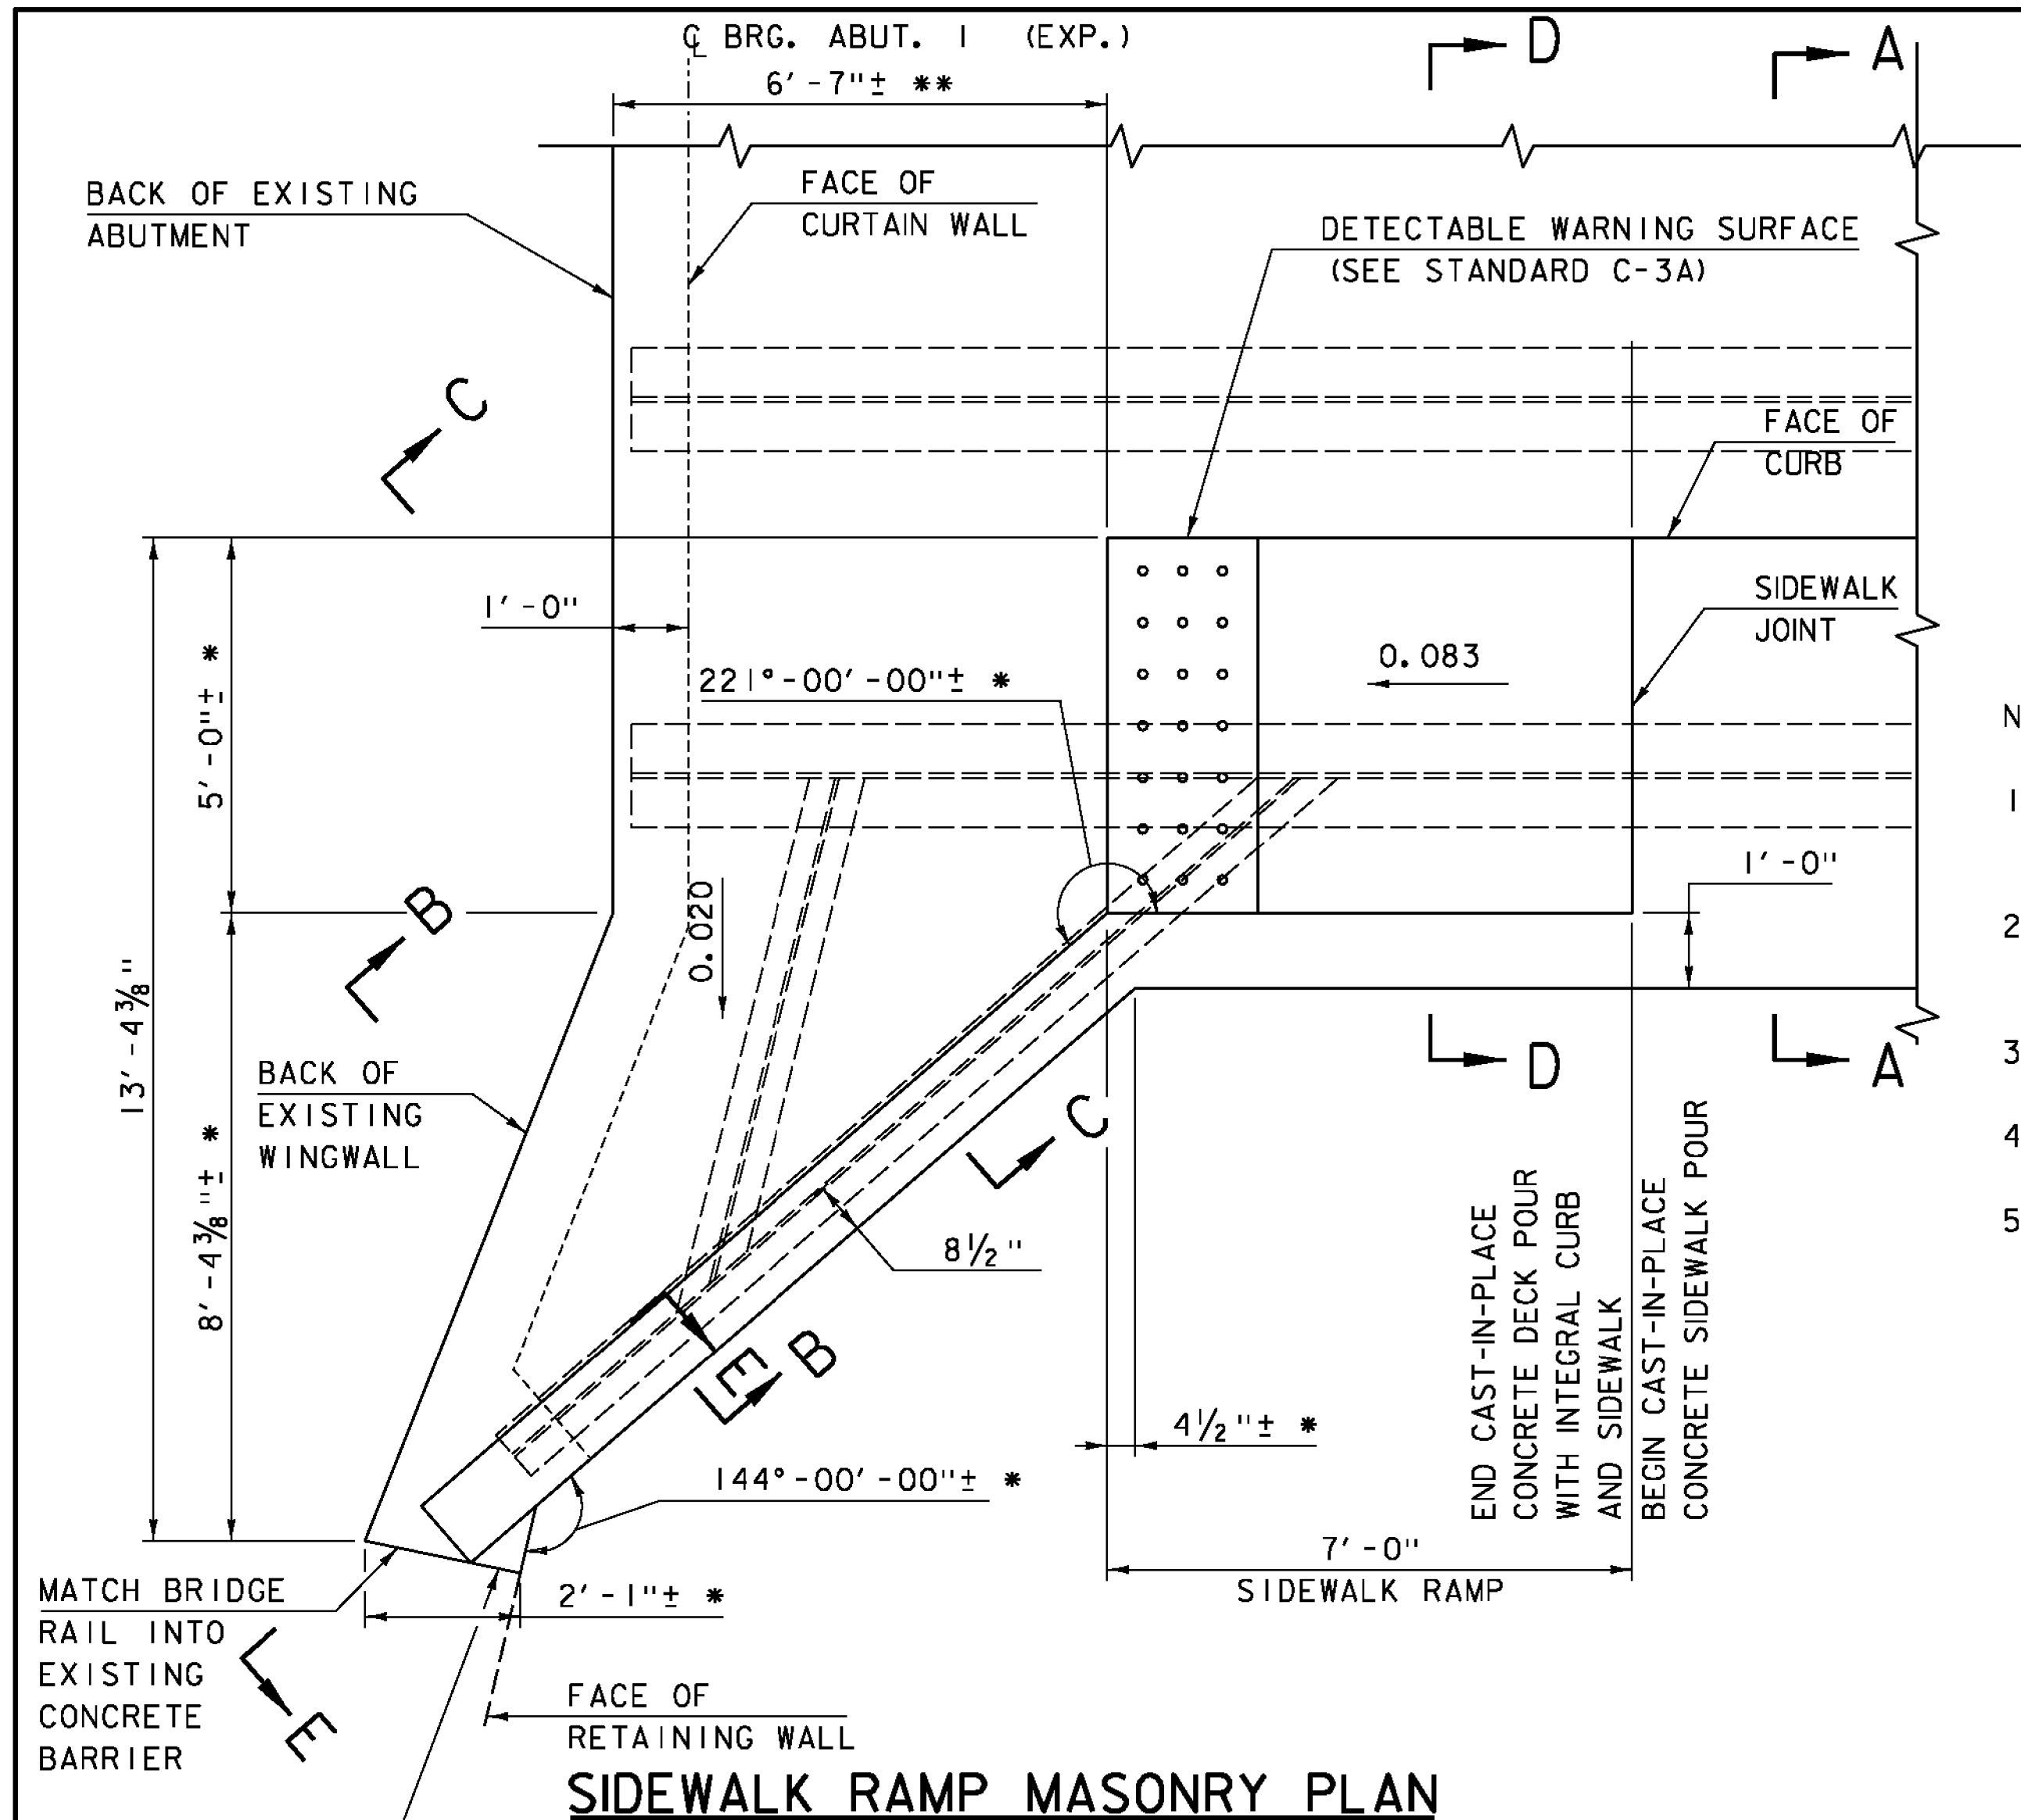


SIDEWALK RAMP MASONRY PLAN
SCALE: 1/2" = 1'-0"

- NOTES:
- 3" CLEAR, UNLESS OTHERWISE SPECIFIED ON THE PLANS.
 - 3'-0" BAR LAP UNLESS OTHERWISE SPECIFIED ON THE PLANS.
 - EF = EACH FACE
 - SEE SHEET 13 FOR SECTION A-A.
 - SEE TYPICAL CURTAIN WALL SECTION ON SHEET 15 FOR MASONRY AND REINFORCEMENT DETAILS AND SECTION E-E THIS SHEET FOR REINFORCEMENT LAYOUT IN CURTAIN WALL AT SIDEWALK RAMP.

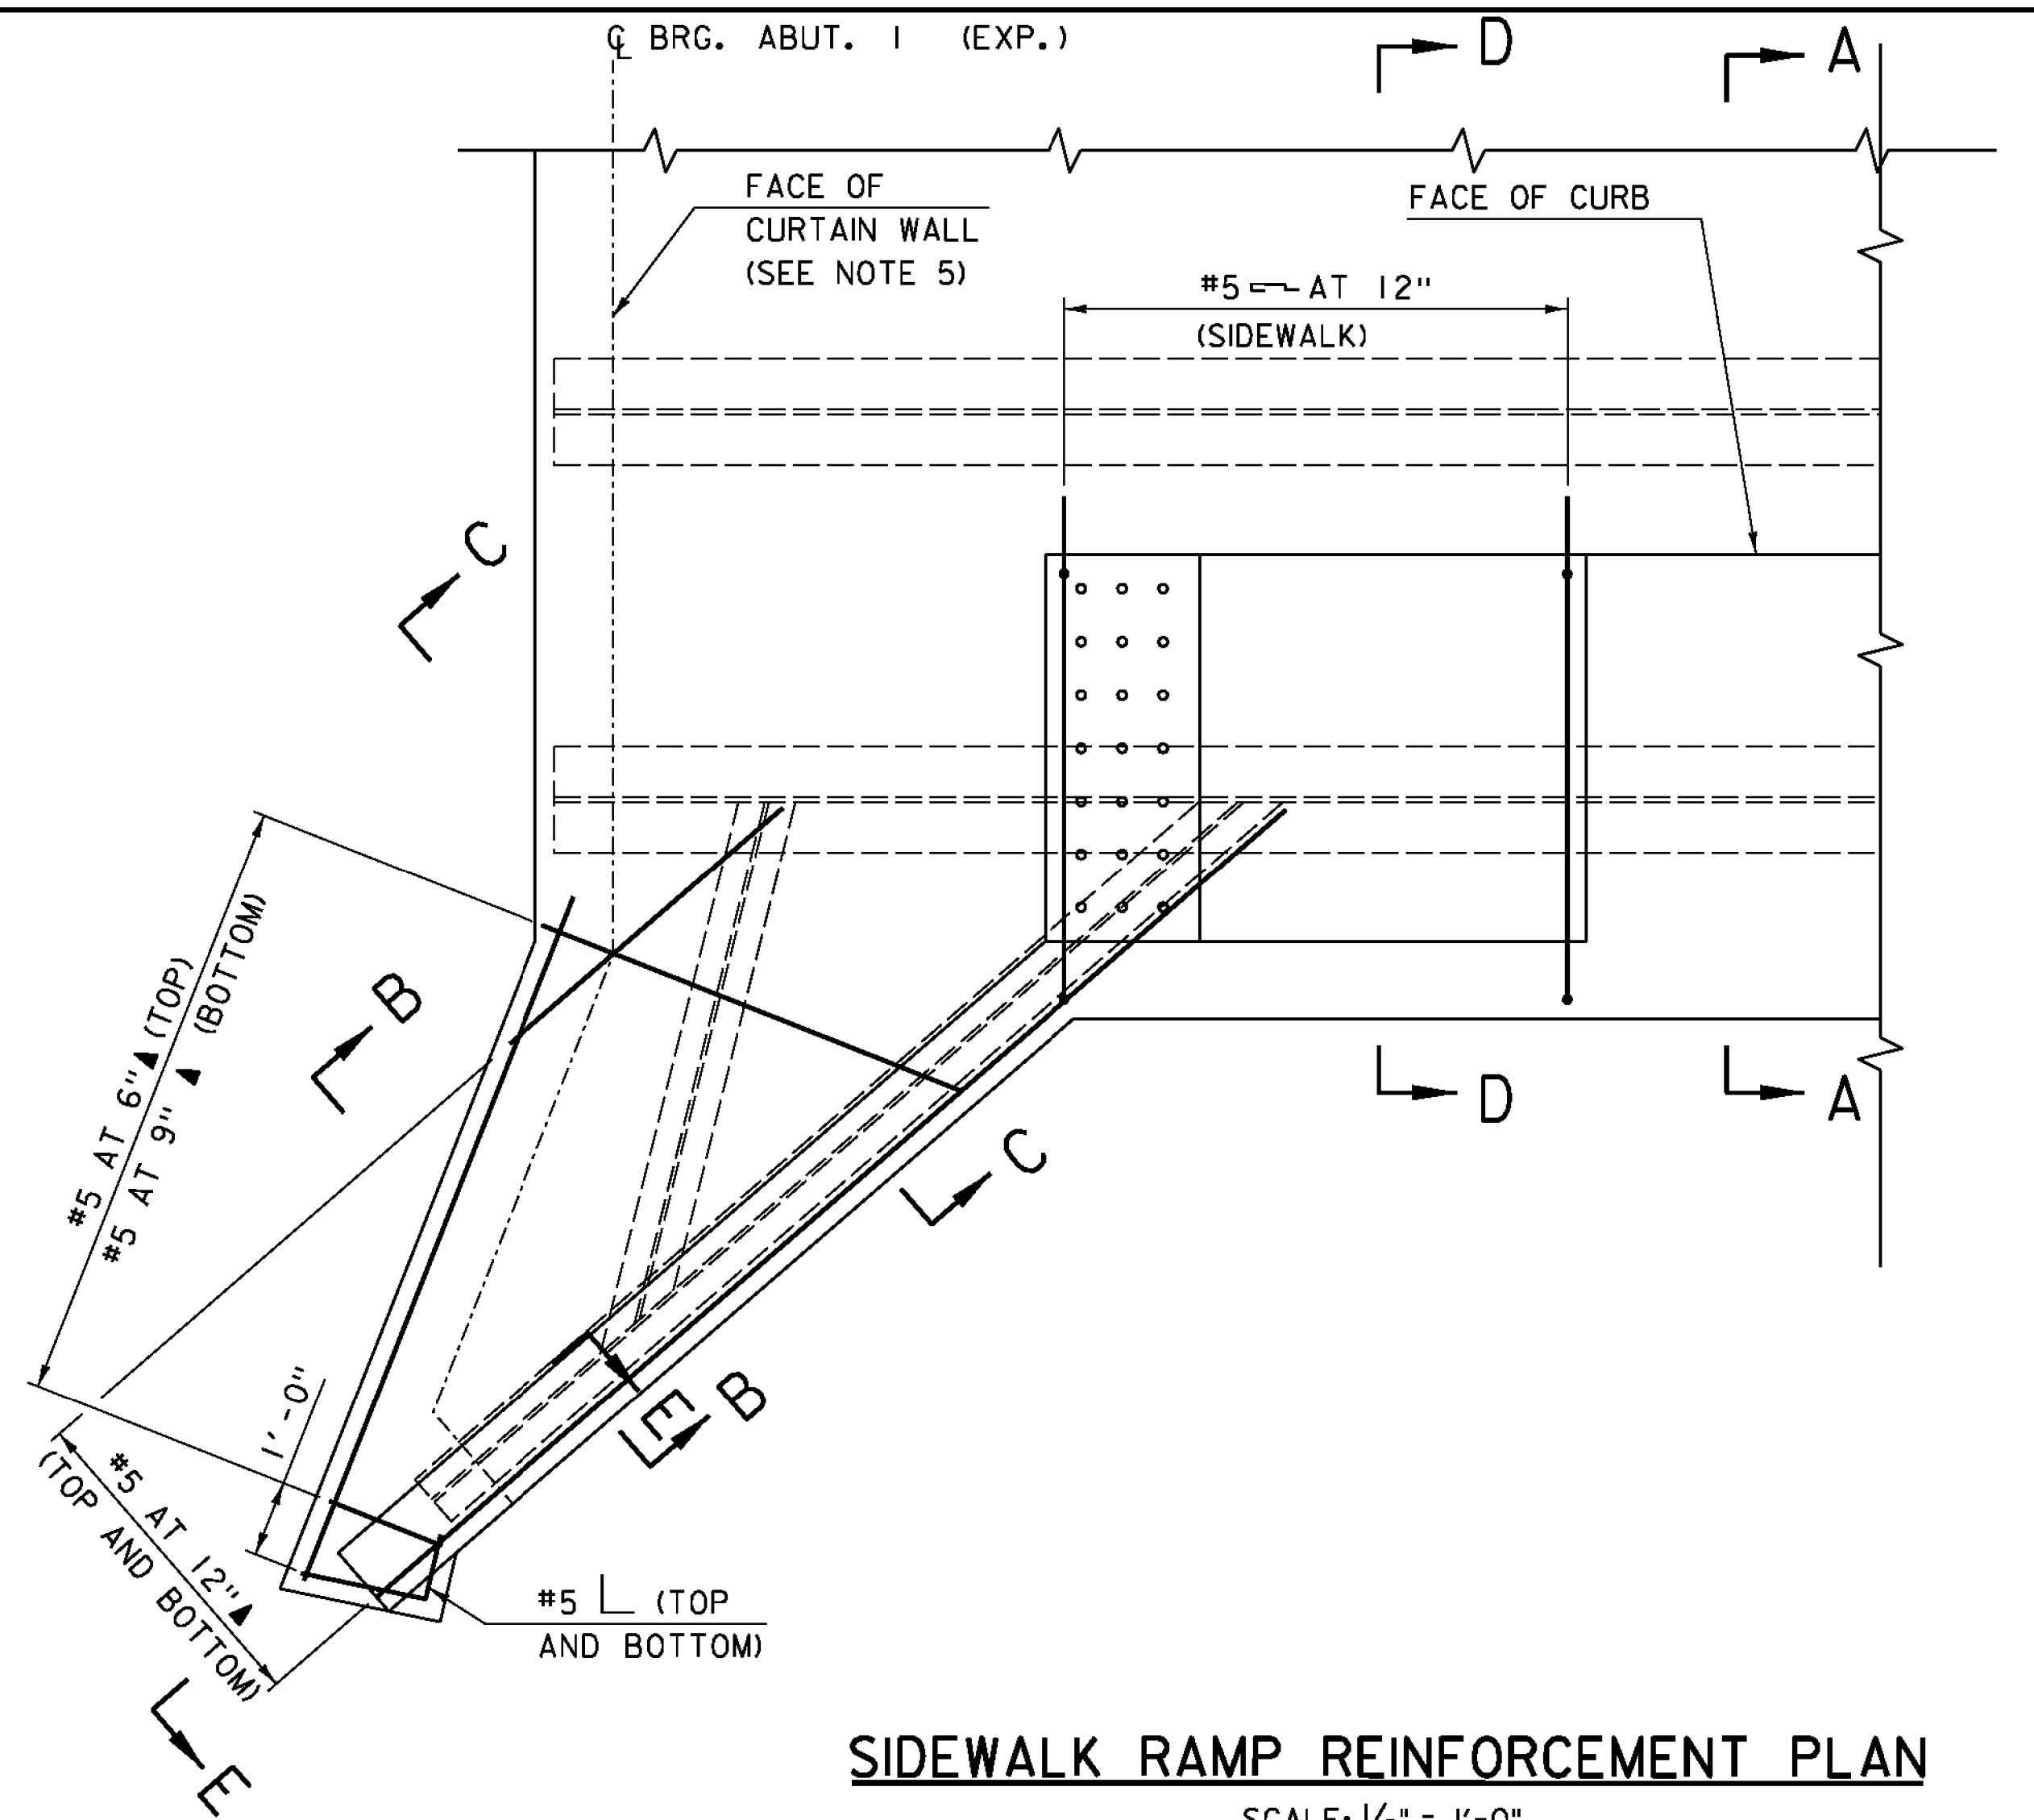


SIDEWALK RAMP REINFORCEMENT PLAN
SCALE: 1/2" = 1'-0"

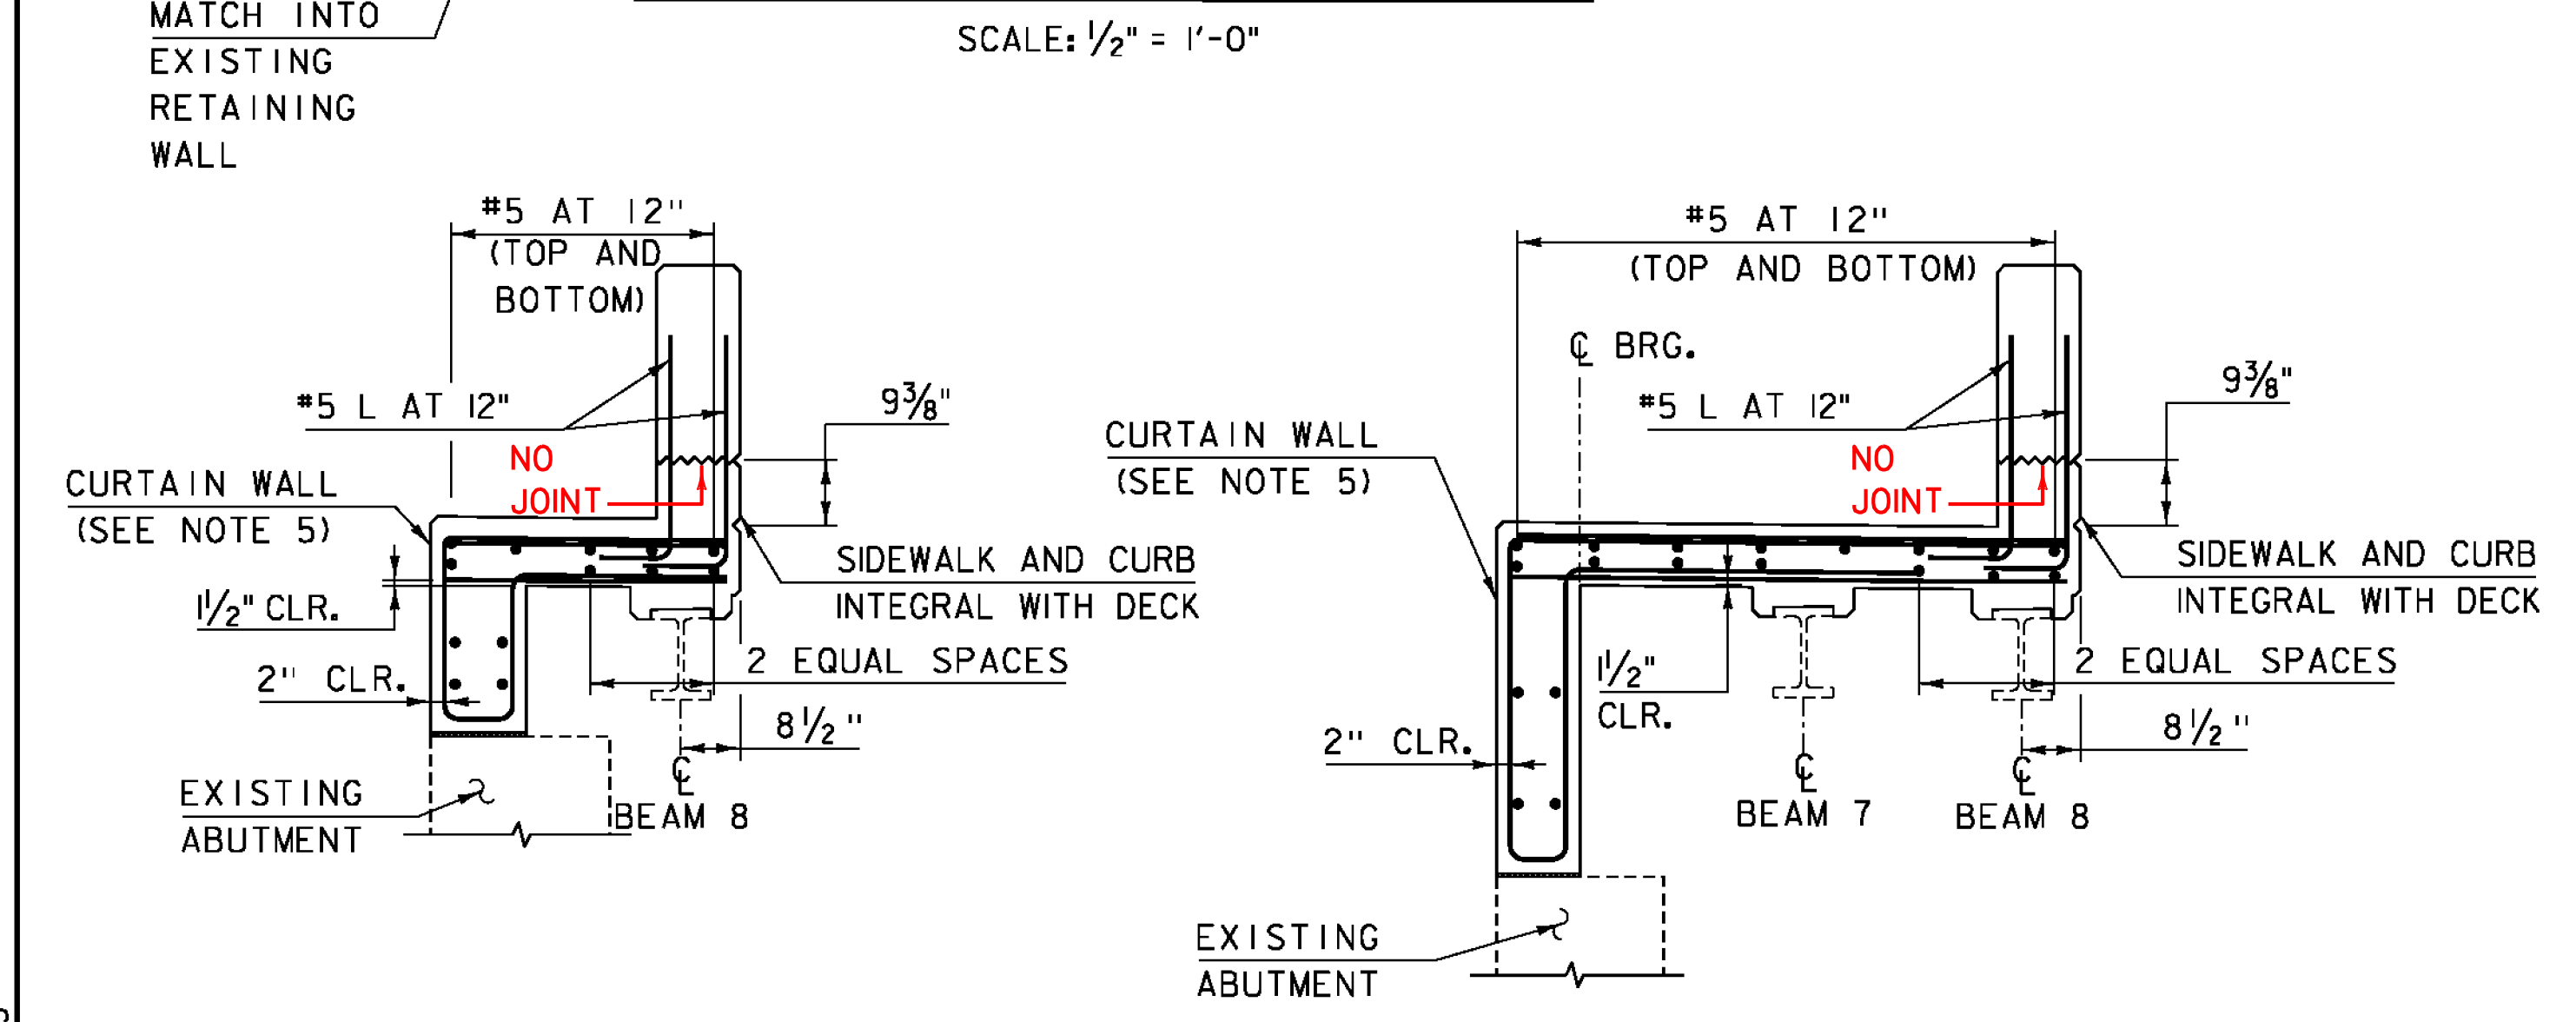


SECTION B-B
SCALE: 1/2" = 1'-0"

SECTION C-C
SCALE: 1/2" = 1'-0"

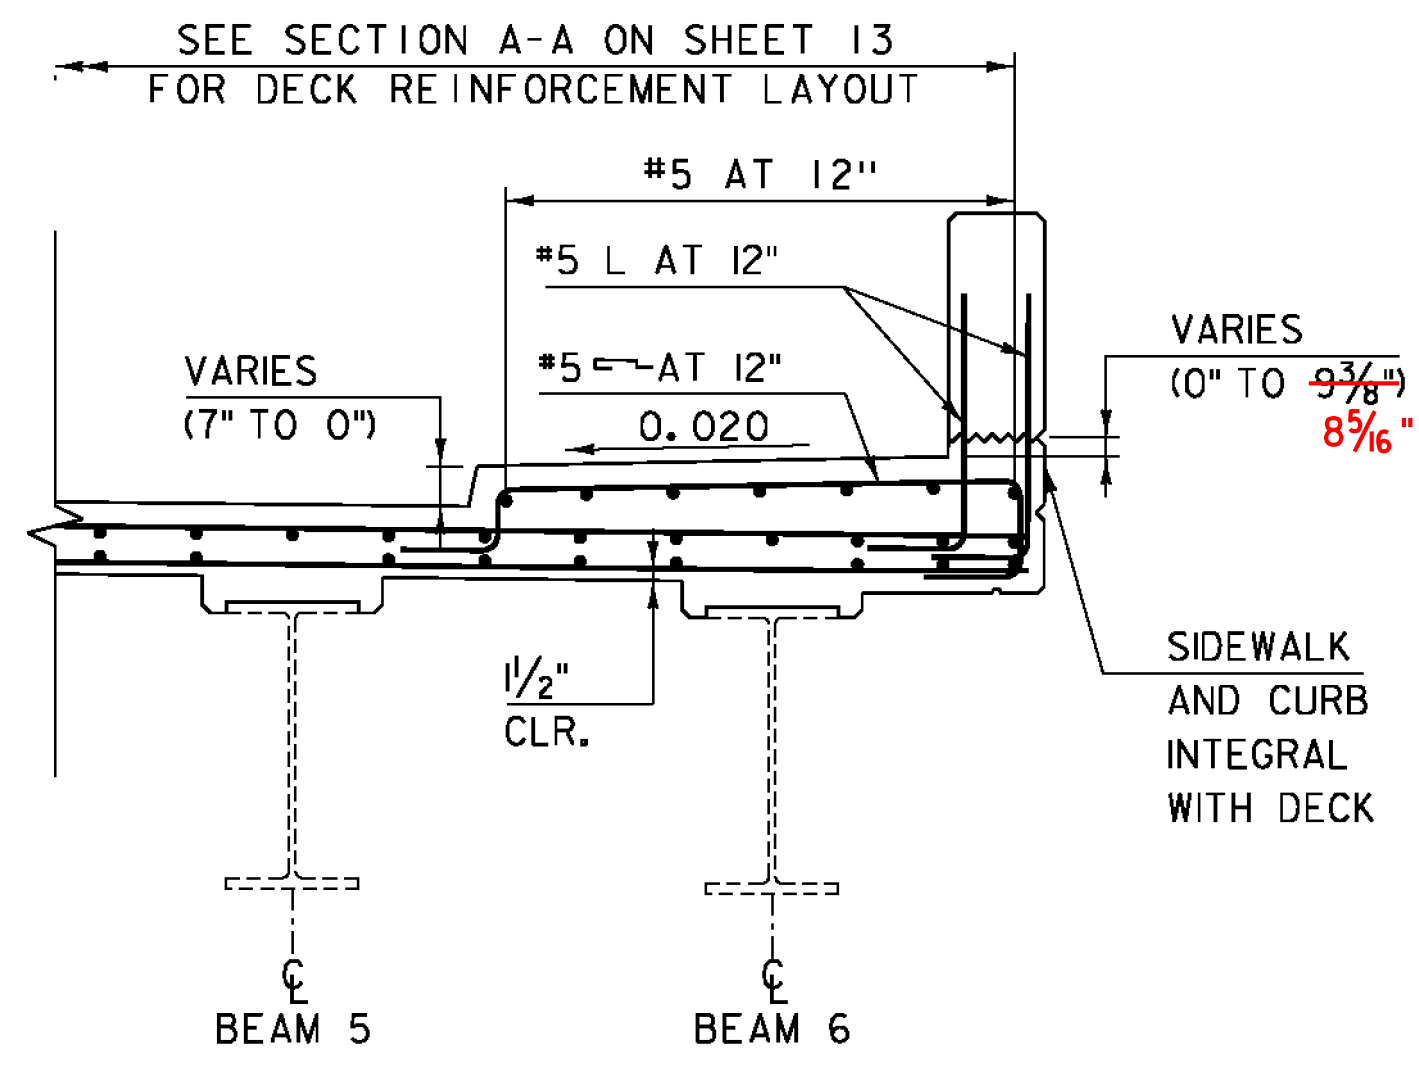


SECTION D-D
SCALE: 1/2" = 1'-0"

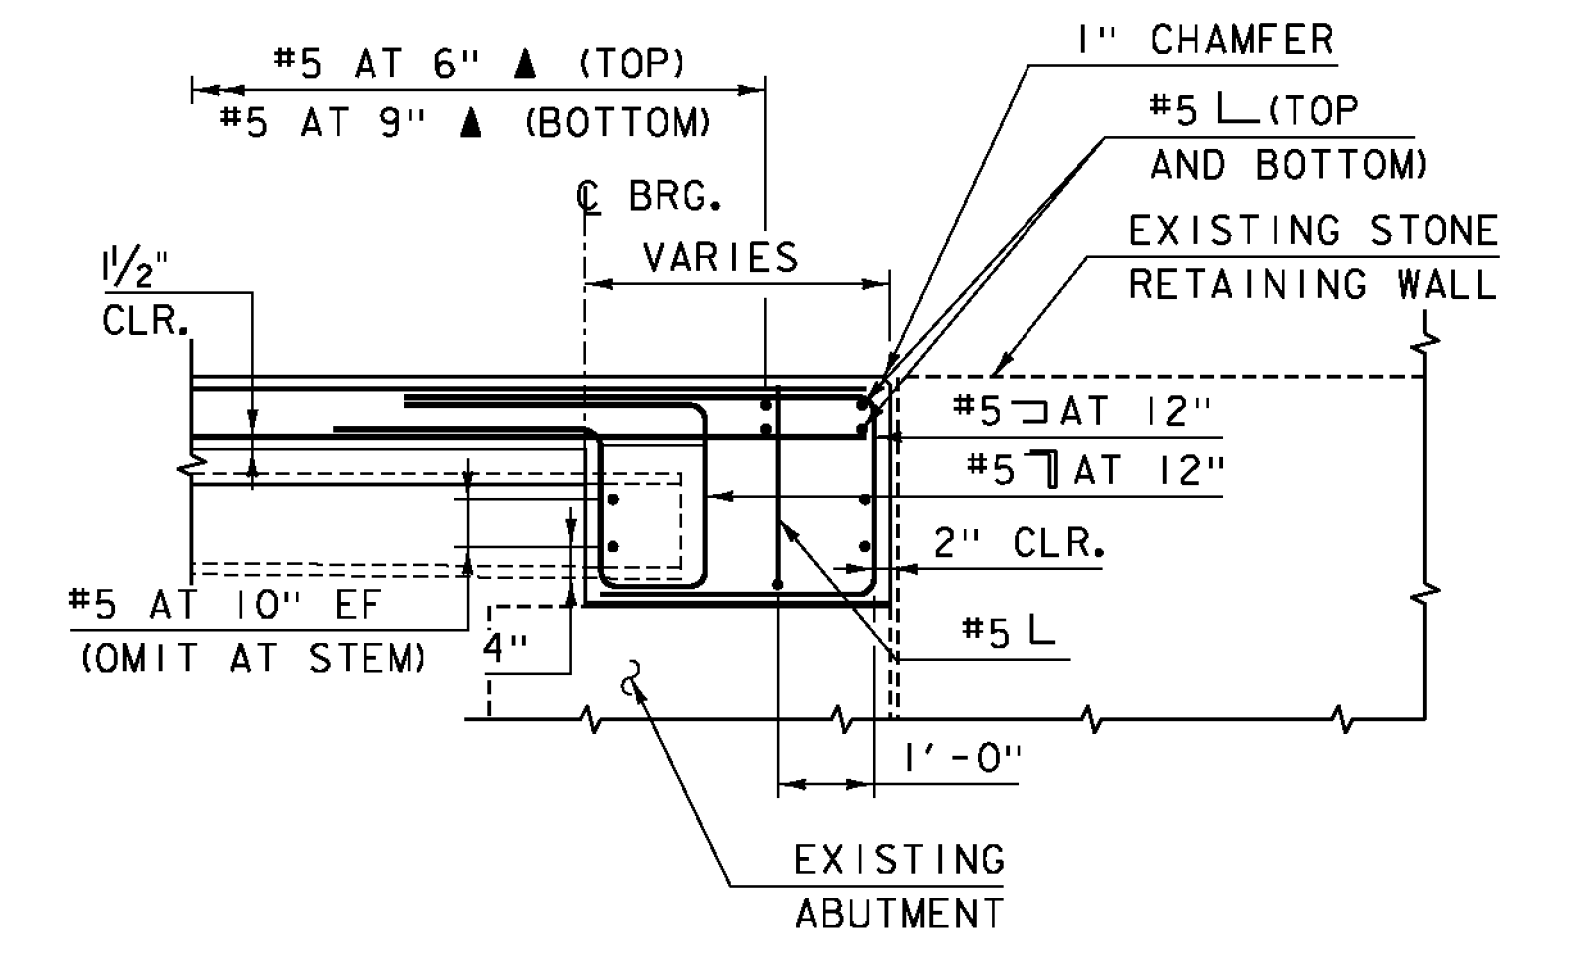


SECTION E-E
SCALE: 1/2" = 1'-0"


* ALL DIMENSIONS ARE BASED ON FIELD MEASUREMENTS AND ARE APPROXIMATE. THE CONTRACTOR SHALL VERIFY ALL EXISTING DIMENSIONS.
** SIDEWALK TO END AT BRIDGE RAIL ANGLE POINT.

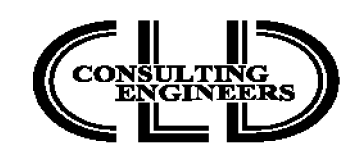


PROJECT NAME:	BRATTLEBORO	PLOT DATE:	2/5/2016
PROJECT NUMBER:	BF 2000(26)	DRAWN BY:	M. SMITH
FILE NAME:	z15j091+yp-31.dgn	DESIGNED BY:	S. BEAUMONT
PROJECT LEADER:	J. BYATT	CHECKED BY:	J. FRENCH
DECK DETAILS SHEET 2		SHEET	14 OF 26

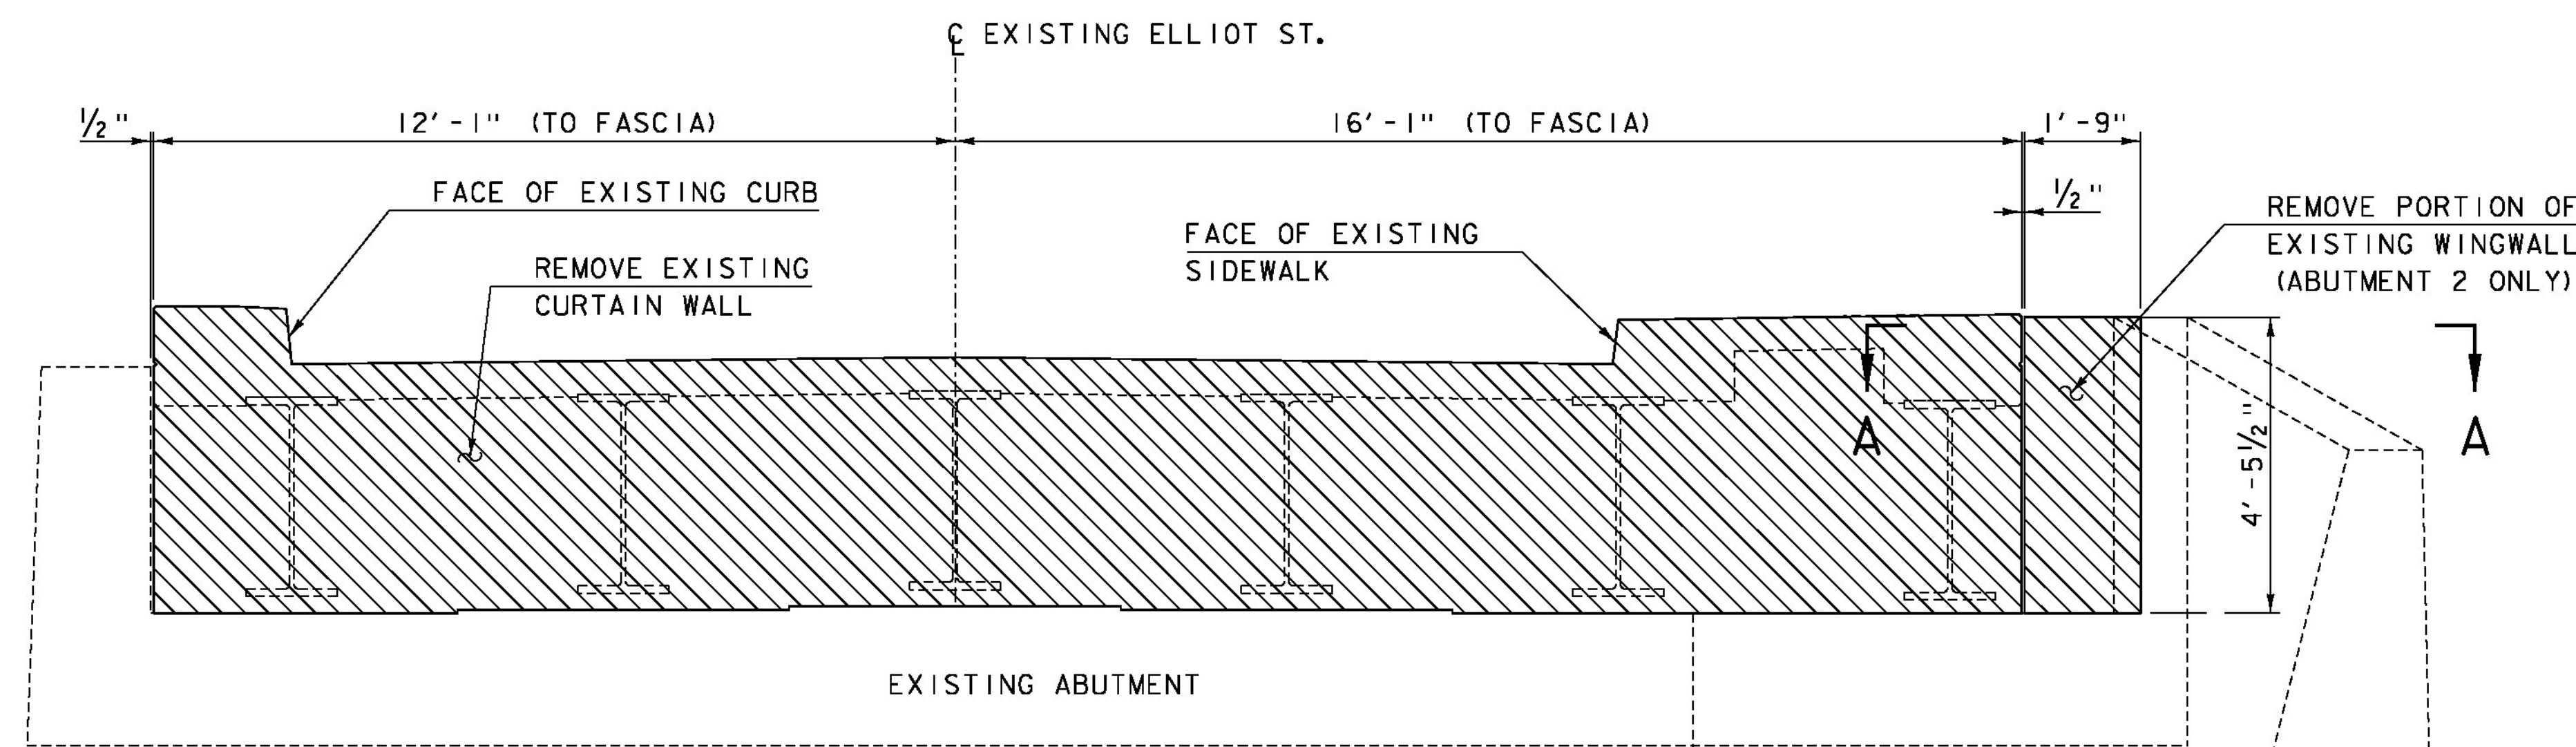

ABUTMENT 2 REMOVAL LIMITS
 (ABUTMENT 2 SHOWN, ABUTMENT 1 SIMILAR)
 SCALE: 1/2" = 1'-0"

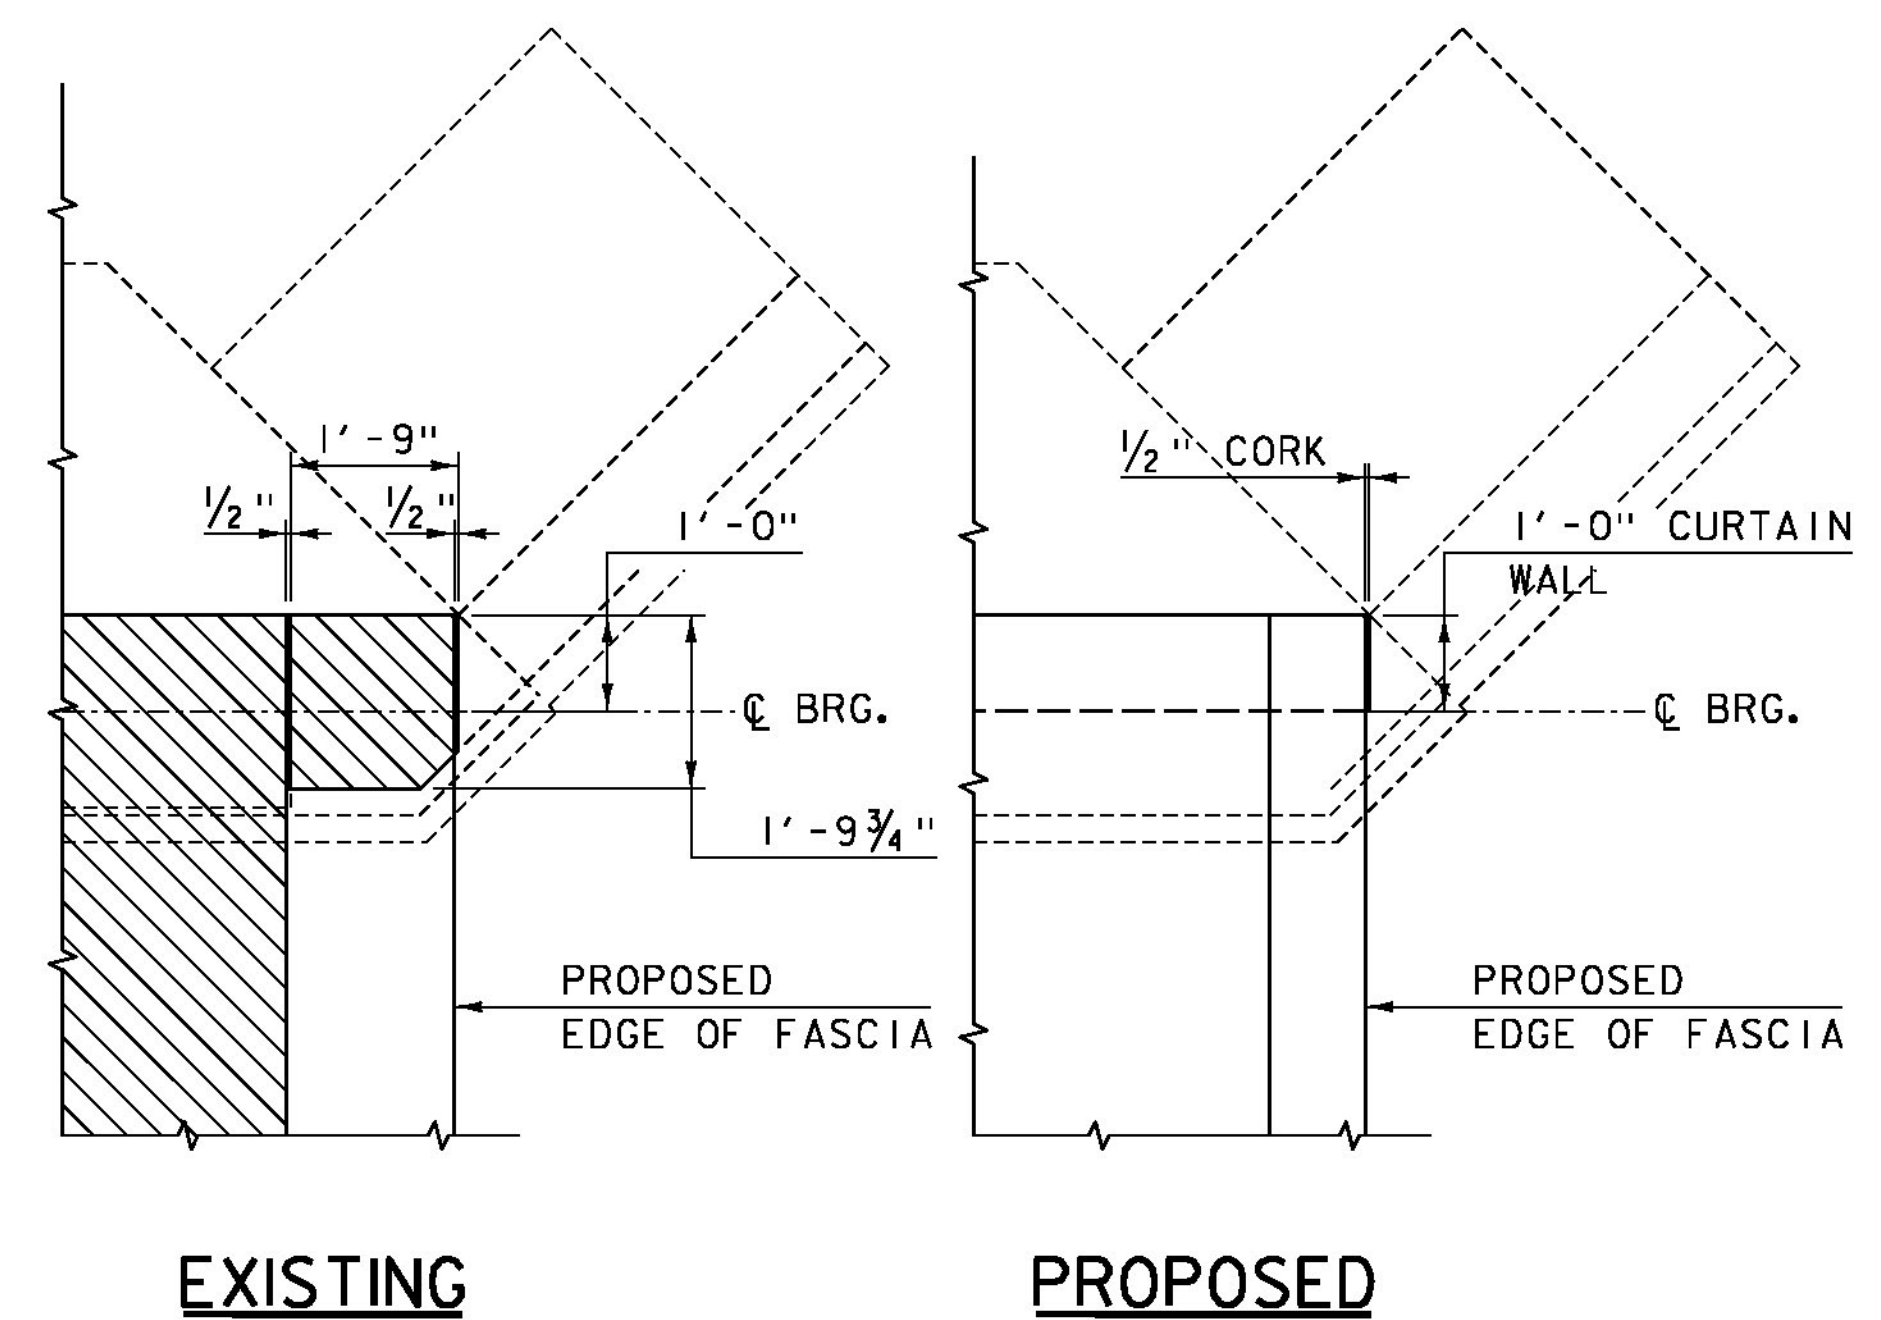

SECTION A-A
 SCALE: 1/2" = 1'-0"

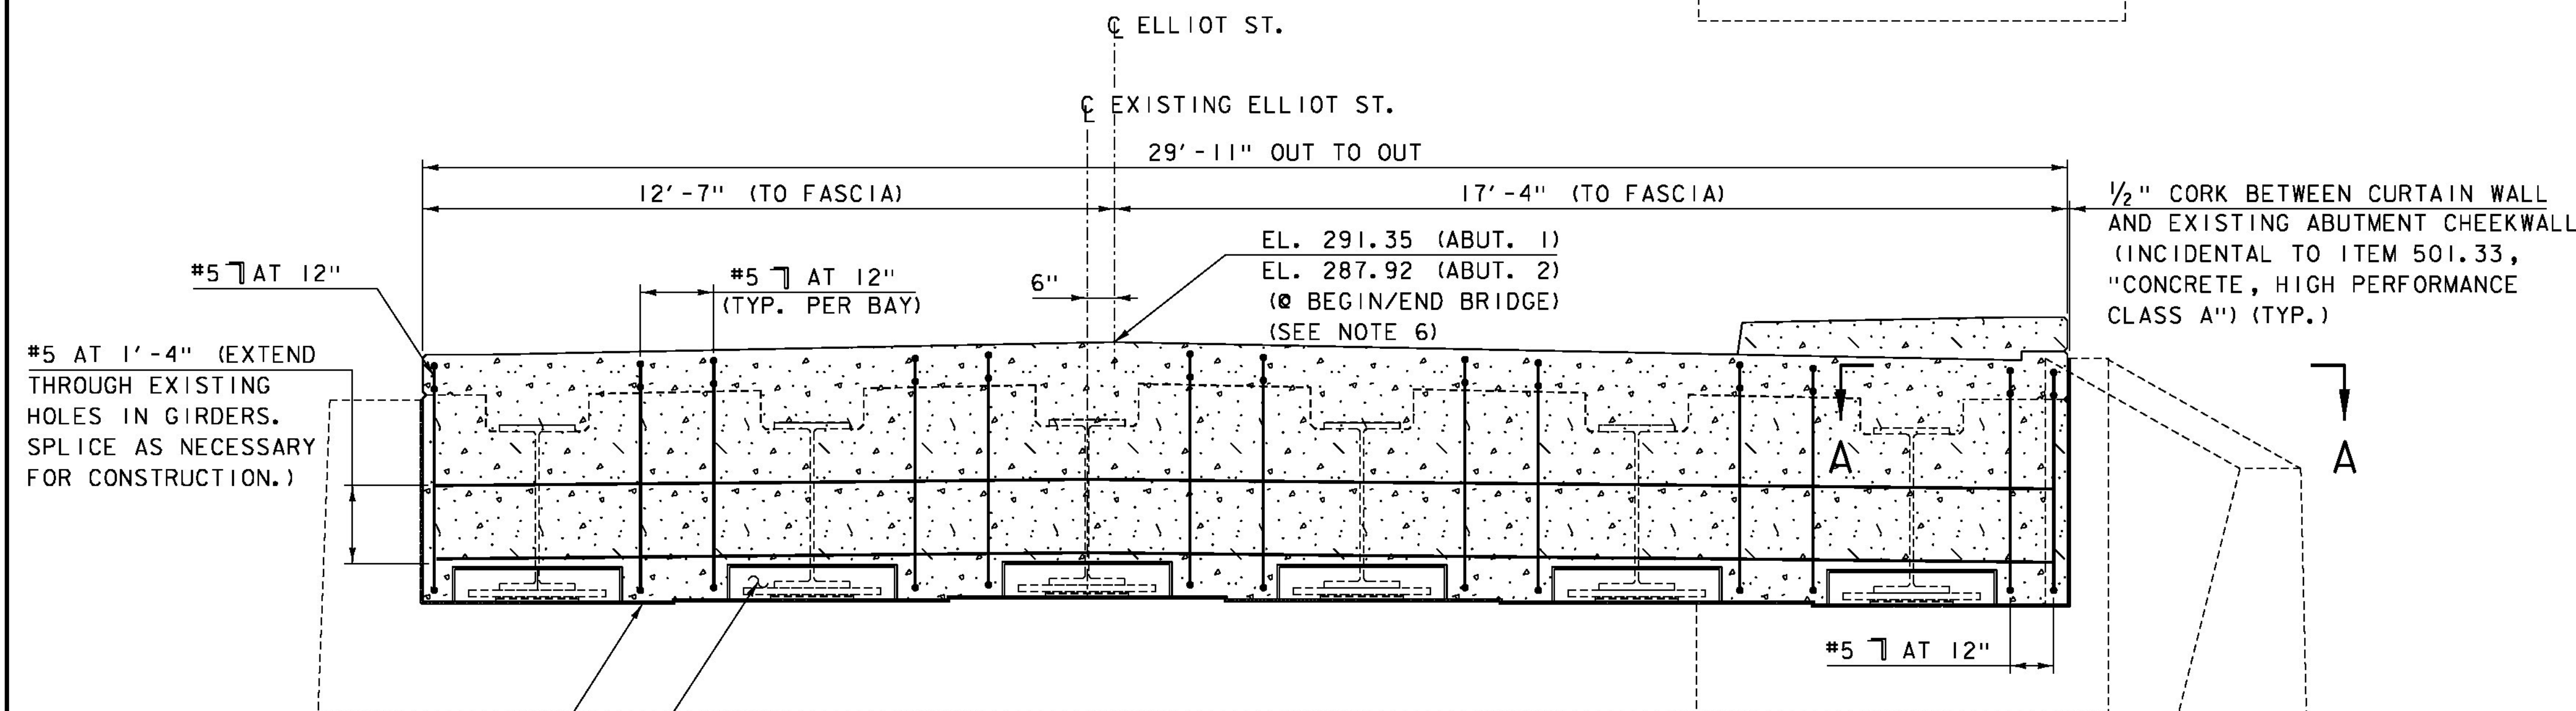

**ABUTMENT 2 CURTAIN WALL
 MASONRY AND REINFORCEMENT ELEVATION**
 (ABUTMENT 2 SHOWN, ABUTMENT 1 SIMILAR)
 SCALE: 1/2" = 1'-0"

- PARTIAL REMOVAL OF STRUCTURE (SEE NOTE 18 ON SHEET 3)
- CONCRETE, HIGH PERFORMANCE CLASS A


NOTES:

1. 3" CLEAR, UNLESS OTHERWISE SPECIFIED ON THE PLANS.
2. 3'-1" BAR LAP UNLESS OTHERWISE SPECIFIED ON THE PLANS.
3. EF = EACH FACE
4. SEE SHEET 16 FOR TYPICAL CURTAIN WALL SECTION AND CURTAIN WALL BLOCKOUT AROUND BEARINGS DETAILS.
5. SEE SECTION F-F ON SHEET 14 FOR CURTAIN WALL AT SIDEWALK RAMP REINFORCEMENT LAYOUT.
6. ELEVATIONS ARE FOR INFORMATIONAL PURPOSES ONLY. FINAL FINISHED GRADE SHALL BE DETERMINED BY VTRANS AFTER EXISTING TOP OF DECK AND TOP OF BEAM ELEVATIONS ARE SURVEYED. SEE PROJECT NOTE 22 ON SHEET 3.

PROJECT NAME: BRATTLEBORO
 PROJECT NUMBER: BF 2000(26)


FILE NAME: z15J091+yp-3i.dgn
 PROJECT LEADER: J. BYATT
 DESIGNED BY: S. BEAUMONT
 PLOT DATE: 2/5/2016
 DRAWN BY: M. SMITH
 CHECKED BY: J. FRENCH
 REMOVAL & CURTAIN WALL DETAILS SHEET 1 SHEET 15 OF 26



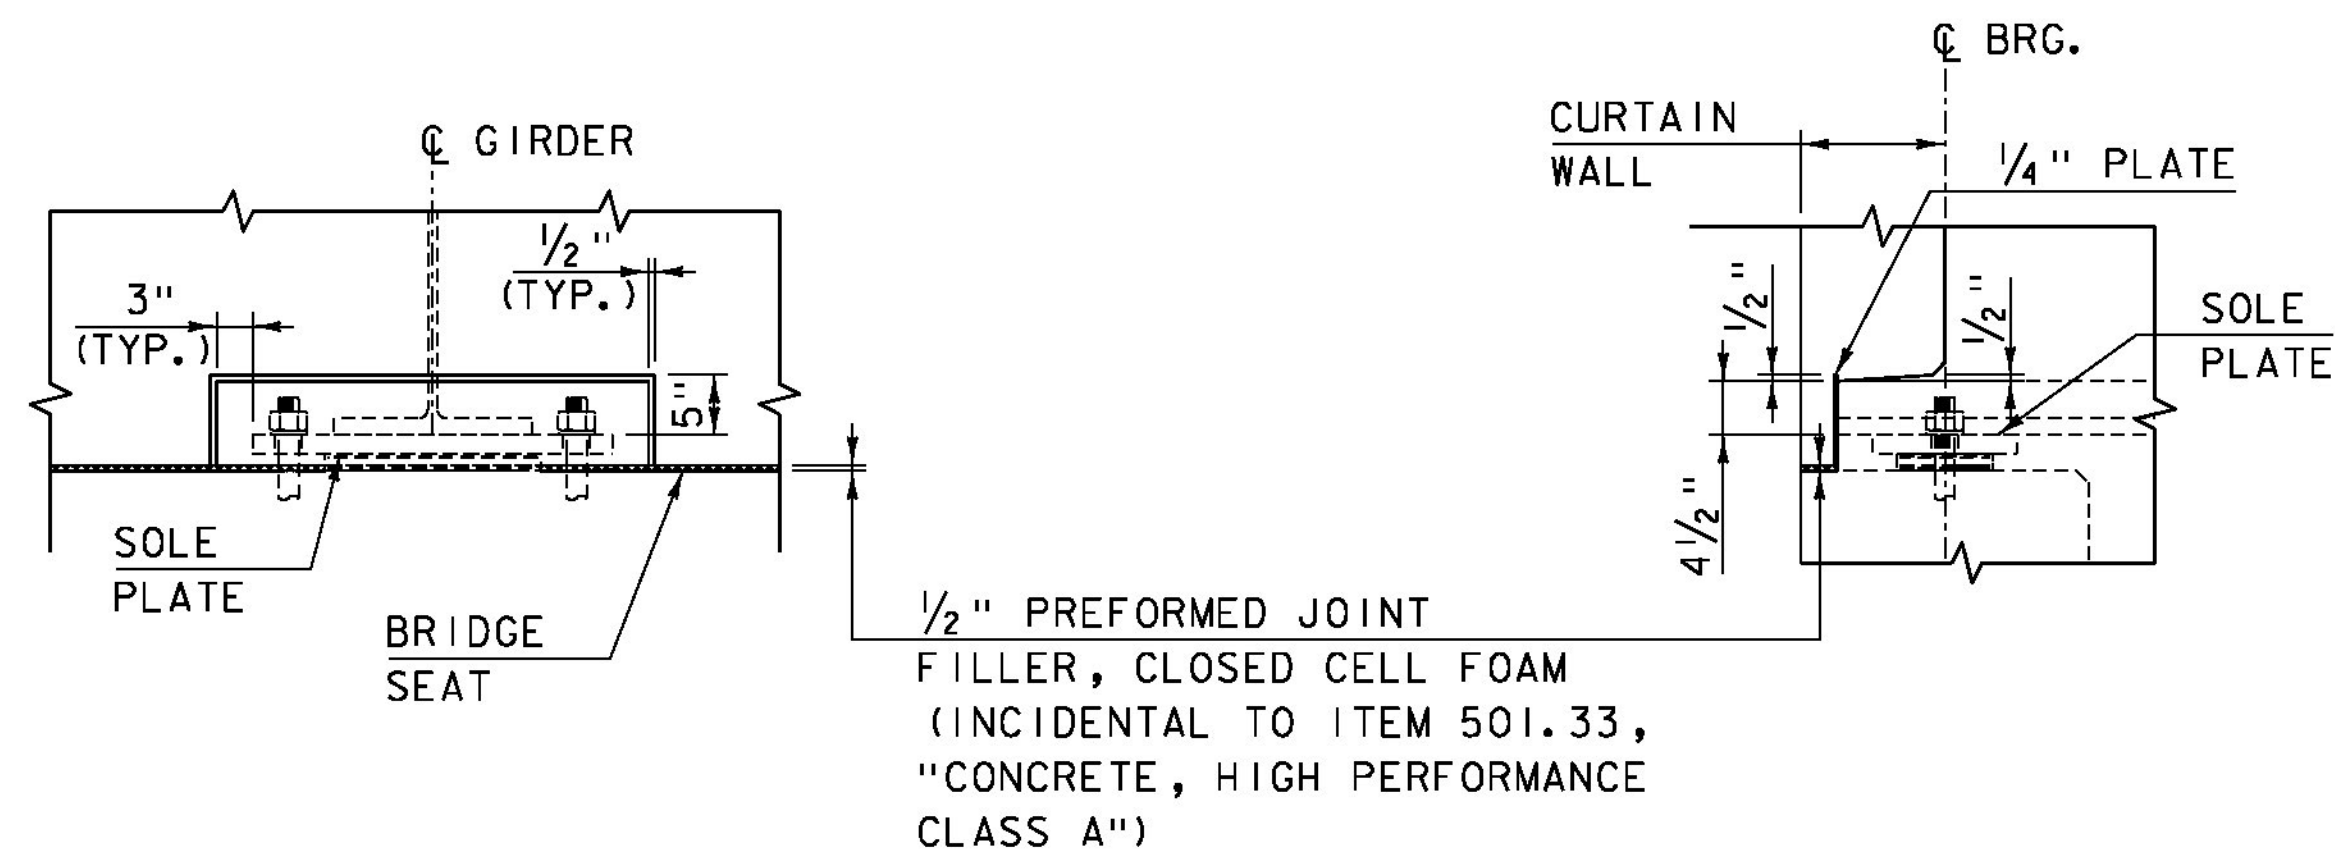

SECTION A-A

SECTION B-B

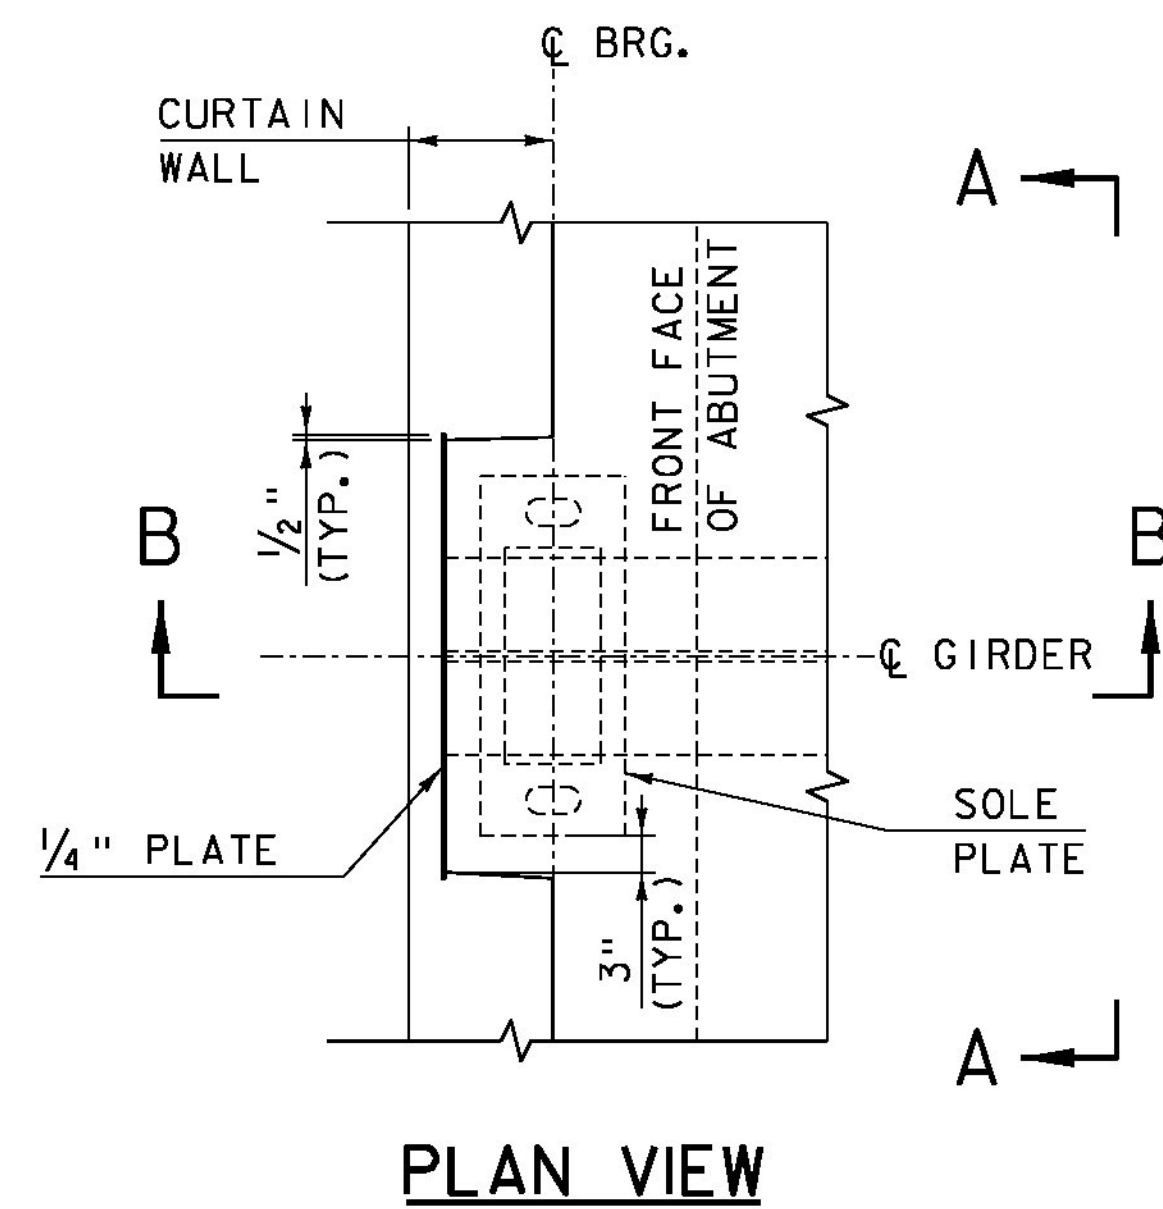


PLAN VIEW

**CONCRETE CURTAIN WALL
BLOCKOUTS AROUND BEARINGS**

SCALE: 3/4" = 1'-0"

NOTES:

1. 3" CLEAR, UNLESS OTHERWISE SPECIFIED ON THE PLANS.
2. 3'-0" BAR LAP UNLESS OTHERWISE SPECIFIED ON THE PLANS.
3. EF = EACH FACE
4. SEE SHEET 15 FOR CURTAIN WALL MASONRY AND REINFORCEMENT ELEVATION.

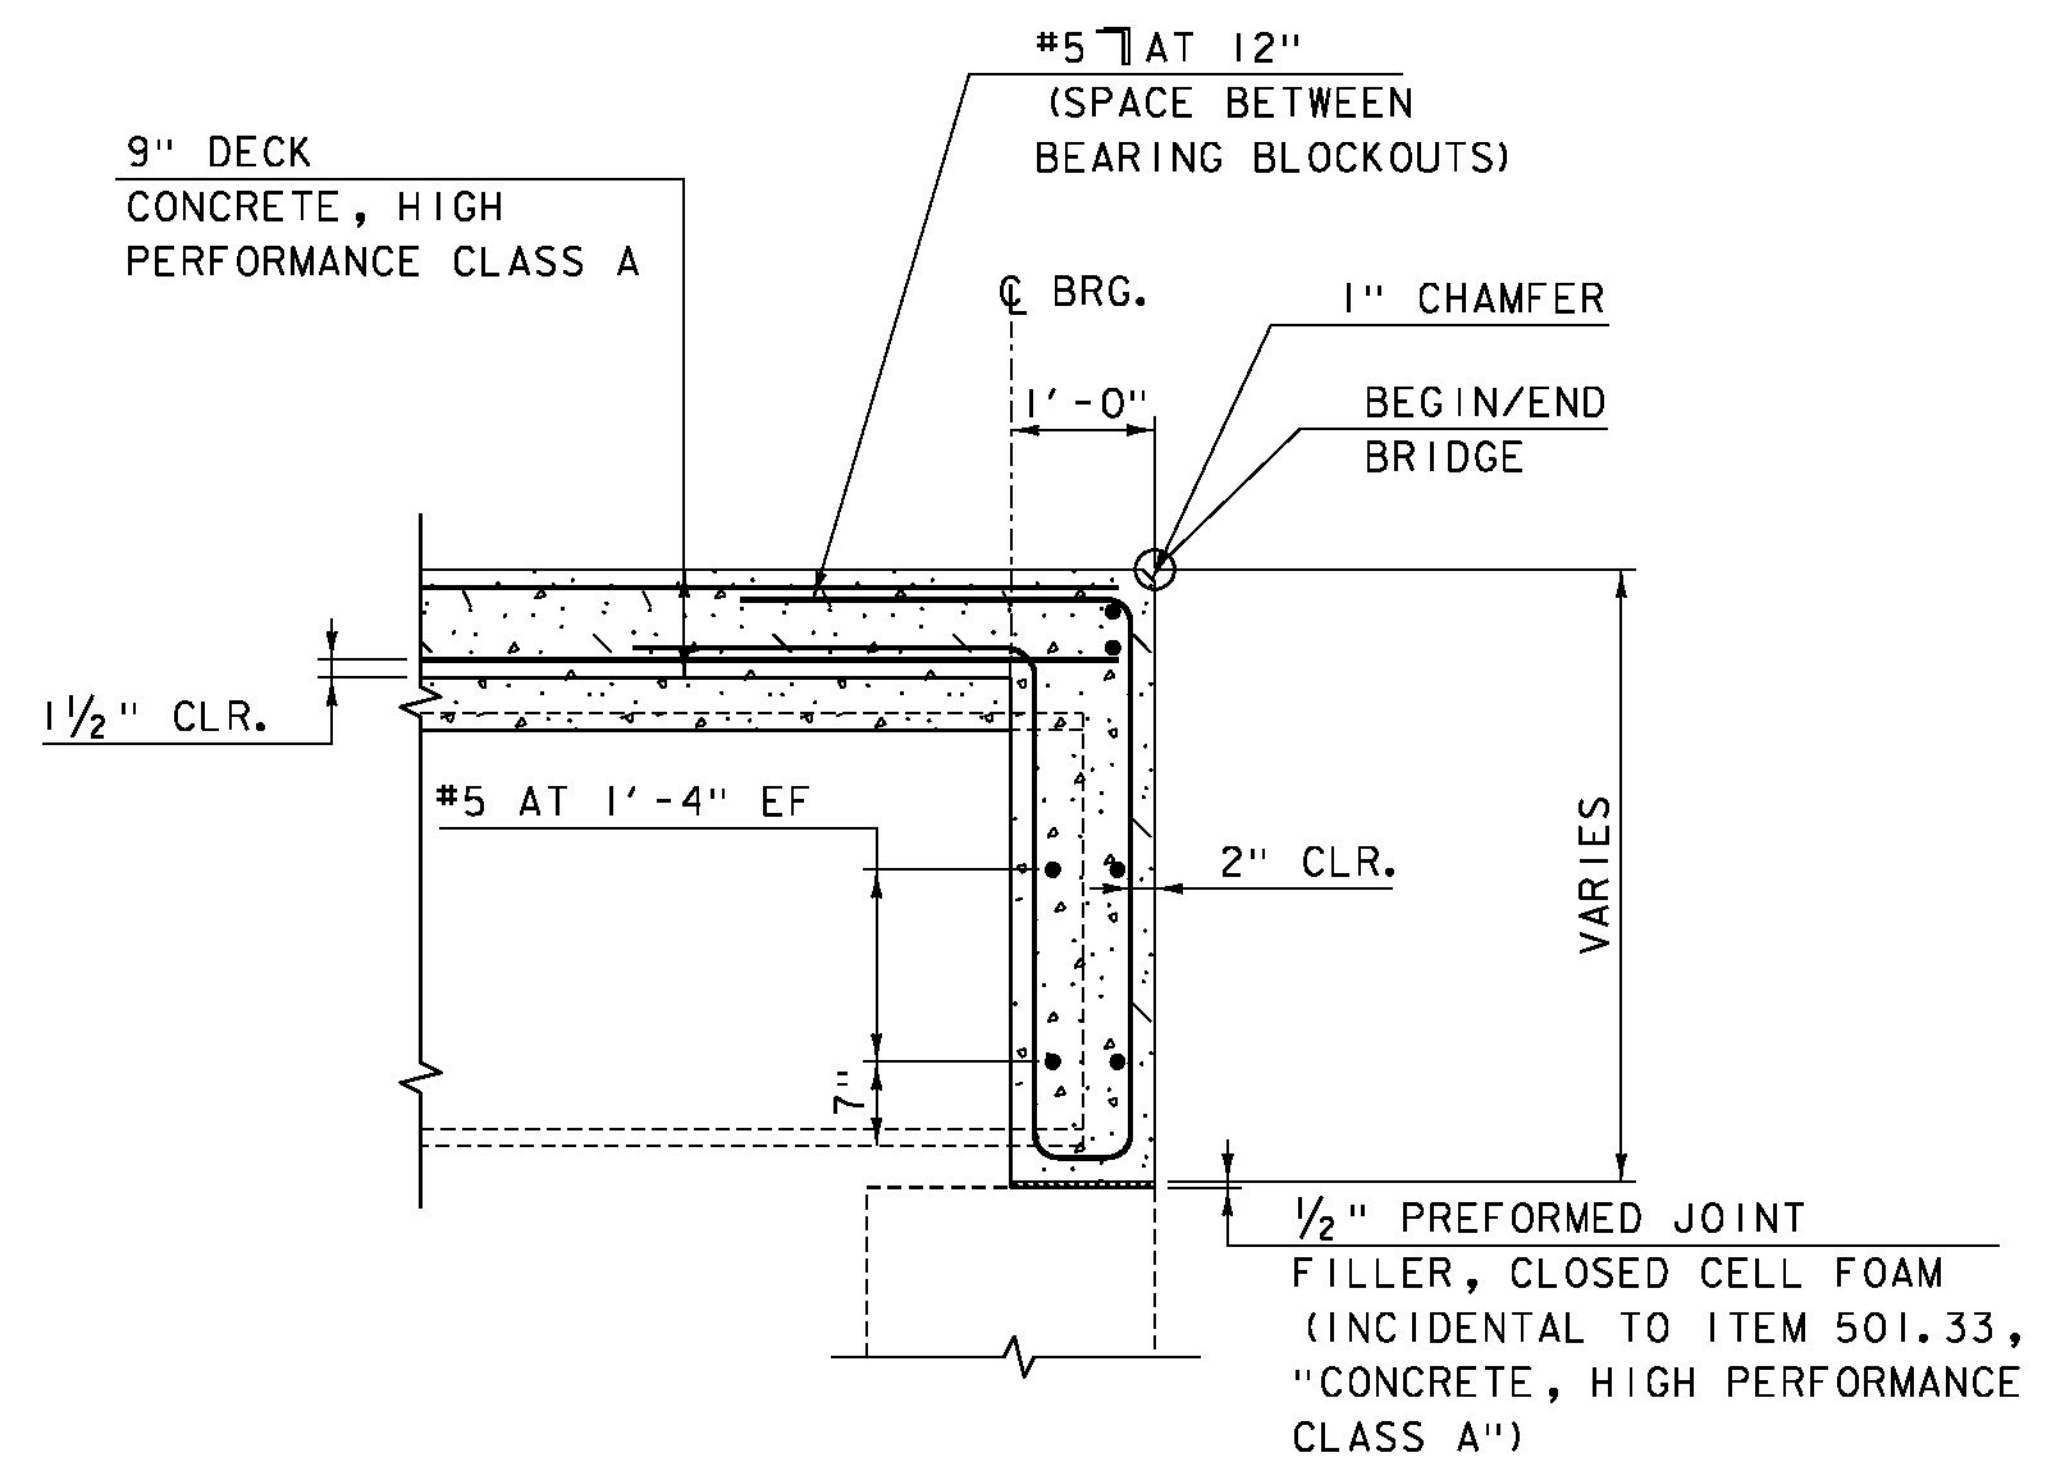


TYPICAL CURTAIN WALL SECTION

SCALE: 3/4" = 1'-0"

PROJECT NAME: BRATTLEBORO
PROJECT NUMBER: BF 2000(26)

FILE NAME: z15J091+yp-3i.dgn
PROJECT LEADER: J. BYATT
DESIGNED BY: S. BEAUMONT
REMOVAL & CURTAIN WALL DETAILS SHEET 2


PLOT DATE: 2/5/2016
DRAWN BY: M. SMITH
CHECKED BY: N. CARON
SHEET 16 OF 26

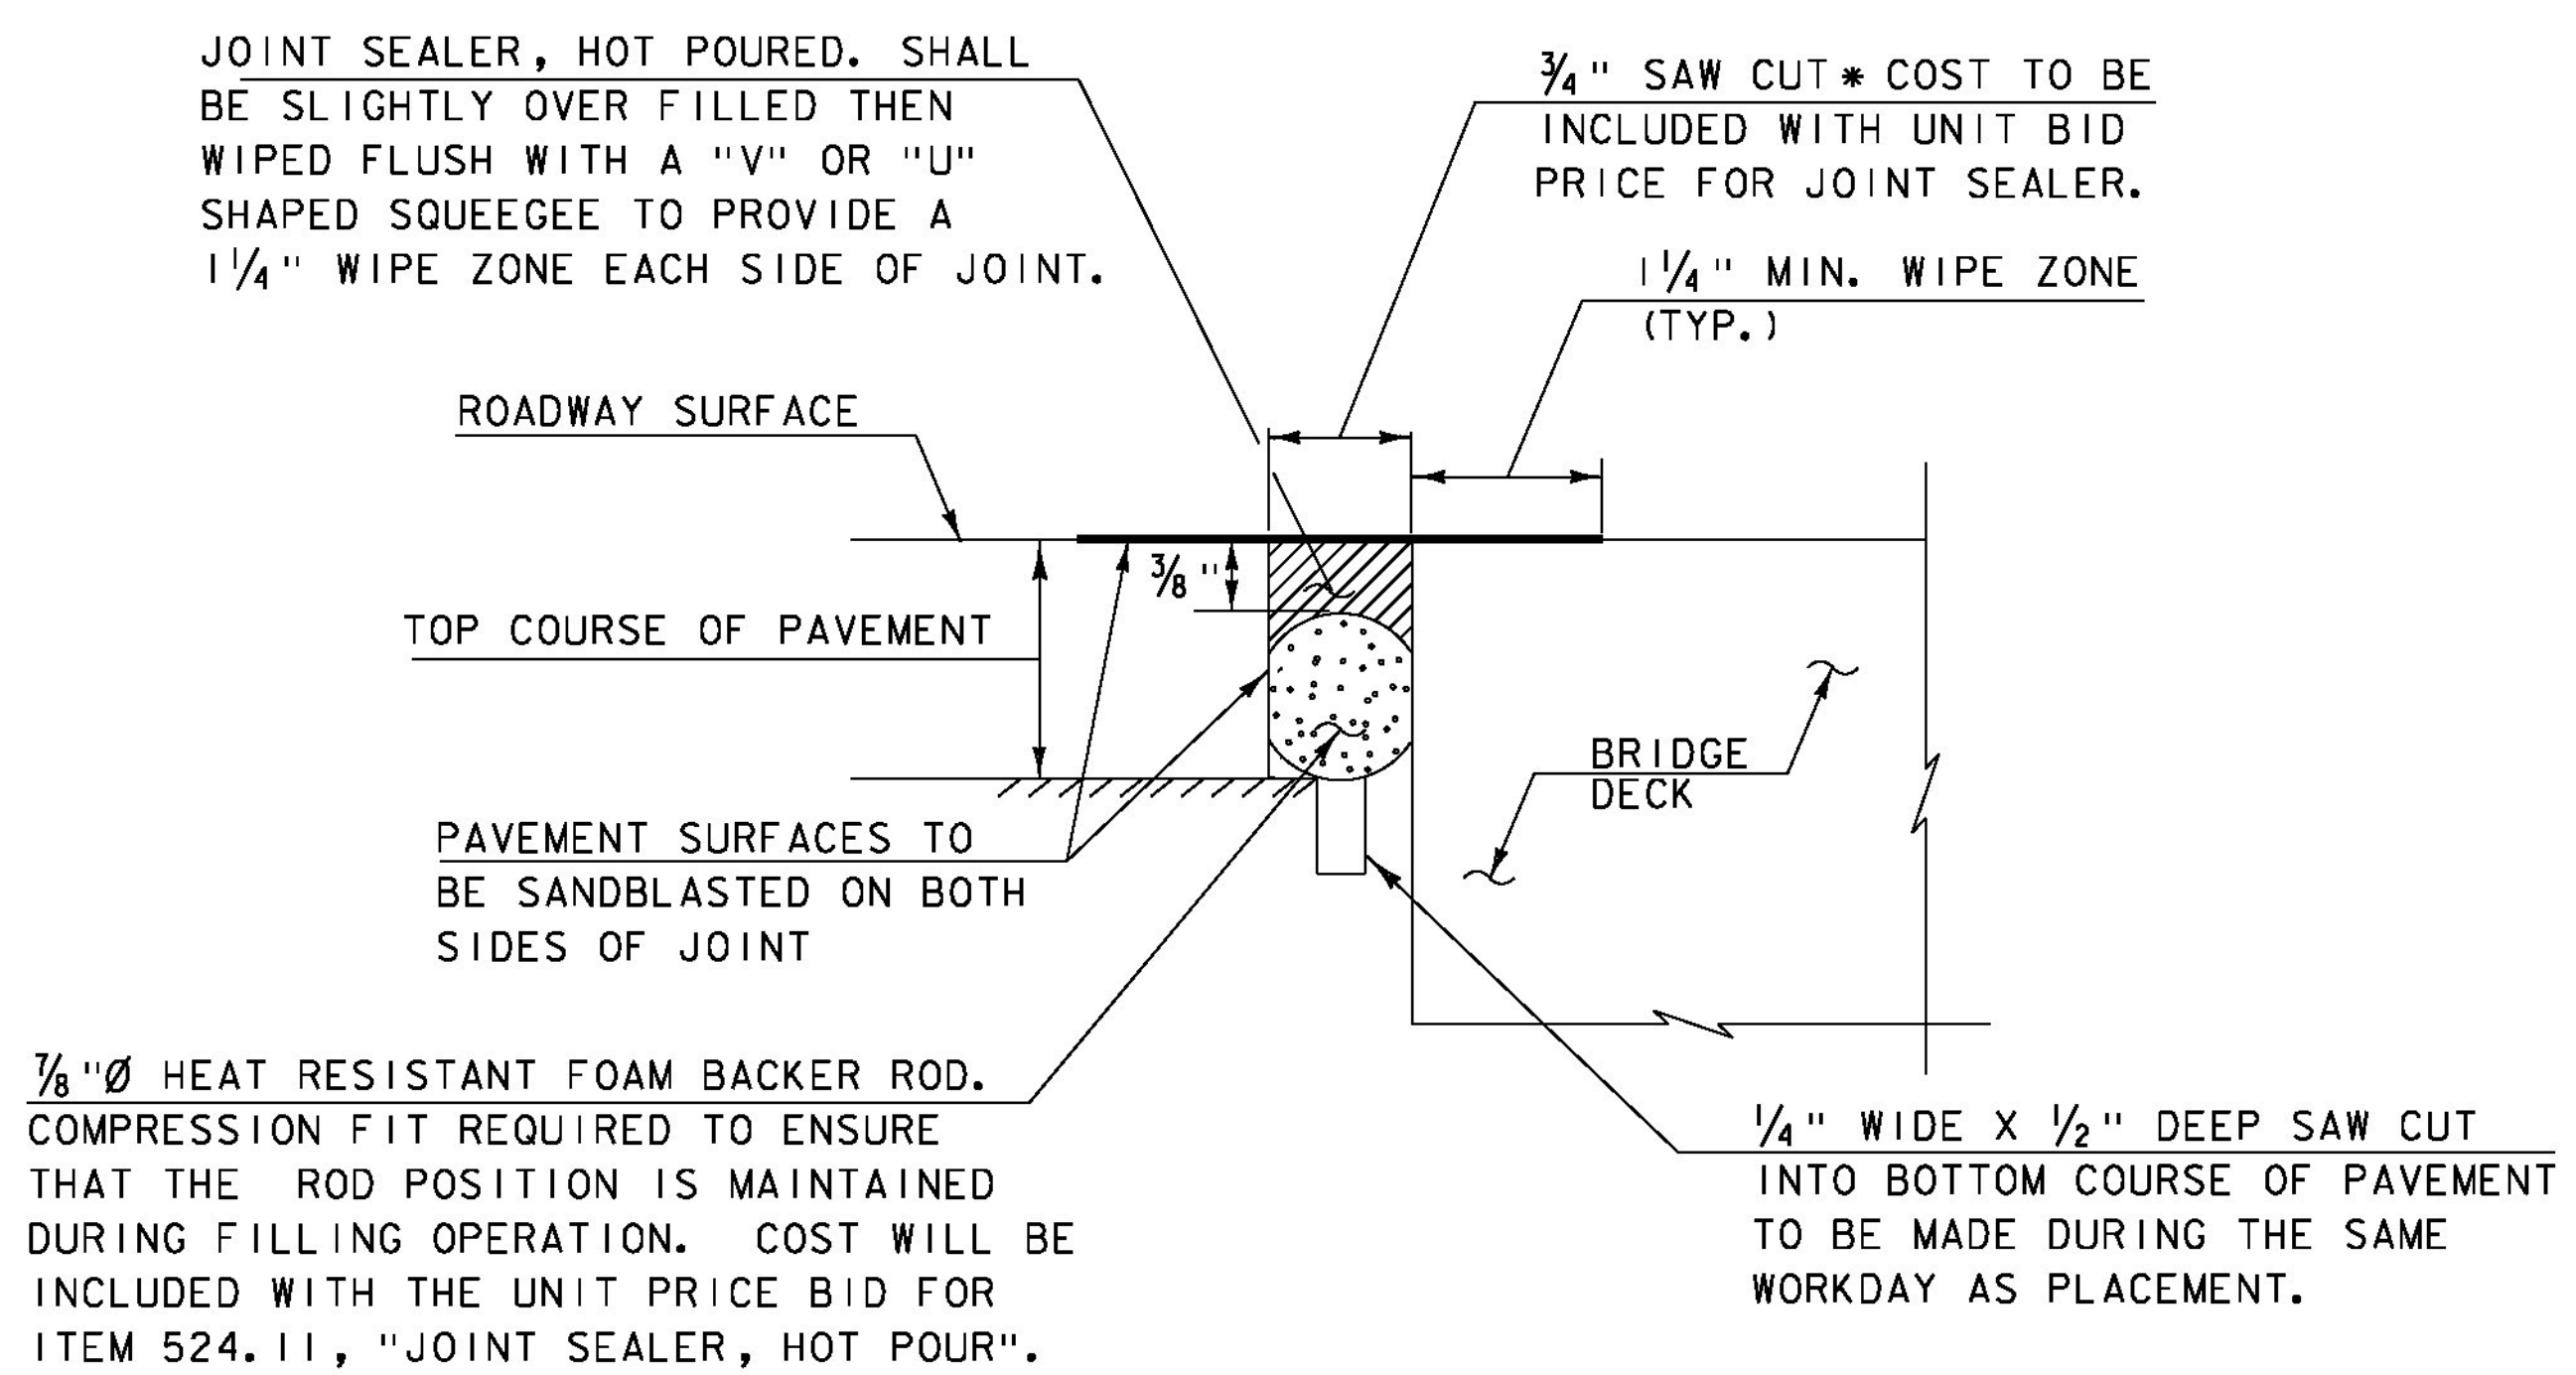

SAWED PAVEMENT JOINT DETAIL

(NOT TO SCALE)

* JOINT IS TO BE LOCATED ACCURATELY BY STRING LINING, OR OTHER MEANS, PRIOR TO PAVING, SO THAT THE SAW CUT WILL BE MADE DIRECTLY OVER THE END OF CONCRETE DECK. JOINT SHALL BE CUT DRY IN A SINGLE PASS AND BE SEALED WITHIN 24 HOURS OR PRIOR TO EXPOSURE TO TRAFFIC. JOINT SHALL BE CLEANED PRIOR TO APPLYING THE JOINT SEALER. ALL WORK WILL BE PAID FOR UNDER ITEM 524.11, "JOINT SEALER, HOT POURED".

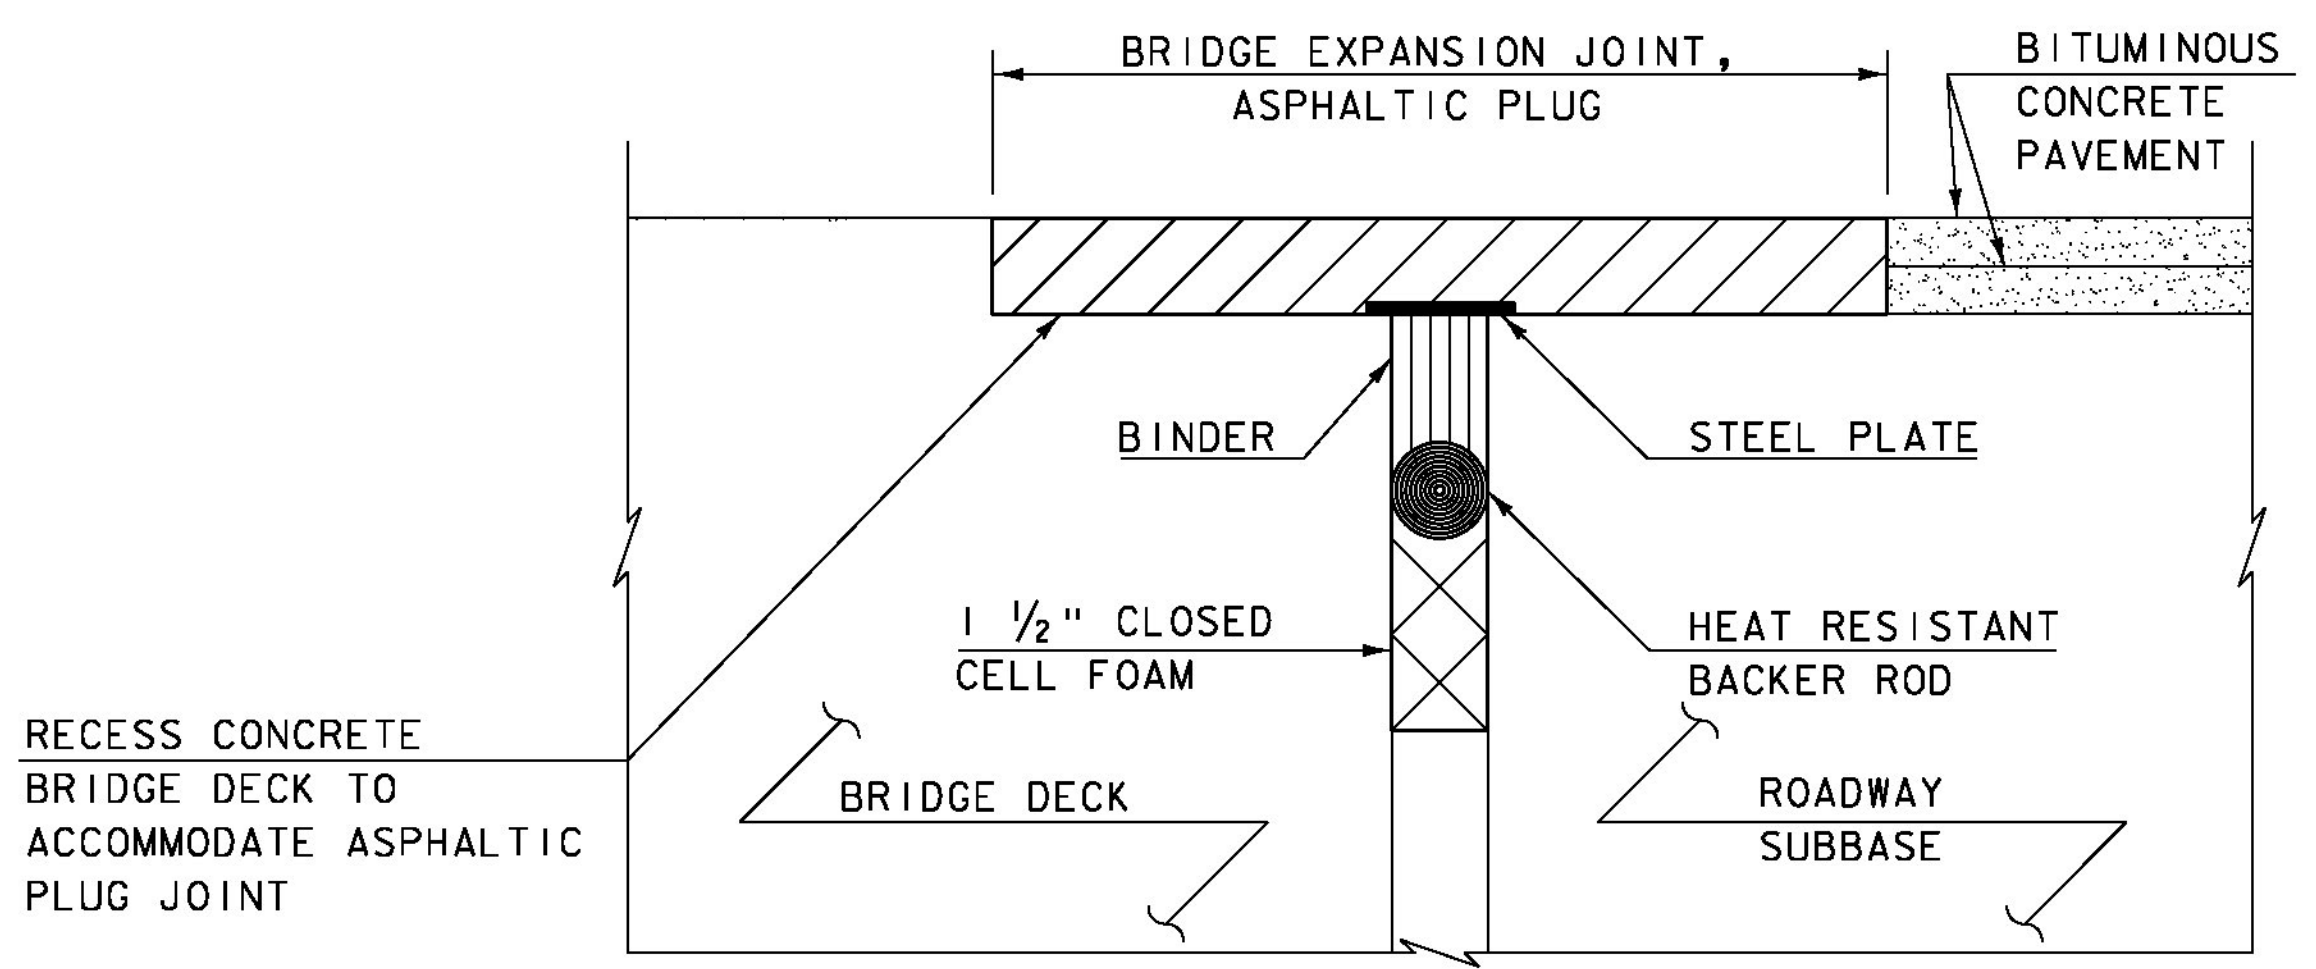

ASPHALTIC PLUG-TYPE JOINT DETAIL


(NOT TO SCALE)

NOTE: SEE STANDARD SD-516.10 FOR ADDITIONAL INFORMATION.

CLD 15-0223 MODEL: TYP08



PROJECT NAME: BRATTLEBORO	PLOT DATE: 2/5/2016
PROJECT NUMBER: BF 2000(26)	DRAWN BY: M. SMITH
FILE NAME: z15j091+yp-3i.dgn	CHECKED BY: S. BEAUMONT
PROJECT LEADER: J. BYATT	SHEET 17 OF 26
DESIGNED BY: N. CARON	
JOINT DETAILS SHEET	

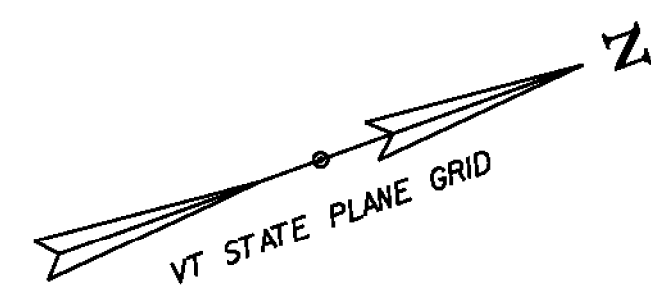


BRG. ABUT. 1
(EXP.)

BRG. ABUT. 2
(FIXED.)

90'-0"
SPECIAL PROVISION (BRIDGE RAILING, GALVANIZED
METAL HAND RAILING/CONCRETE PARAPET COMBINATION)

11'-6" HD STEEL
BEAM GUARDRAIL,
GALVANIZED

25'-0" MANUFACTURED
TERMINAL SECTION, FLARED

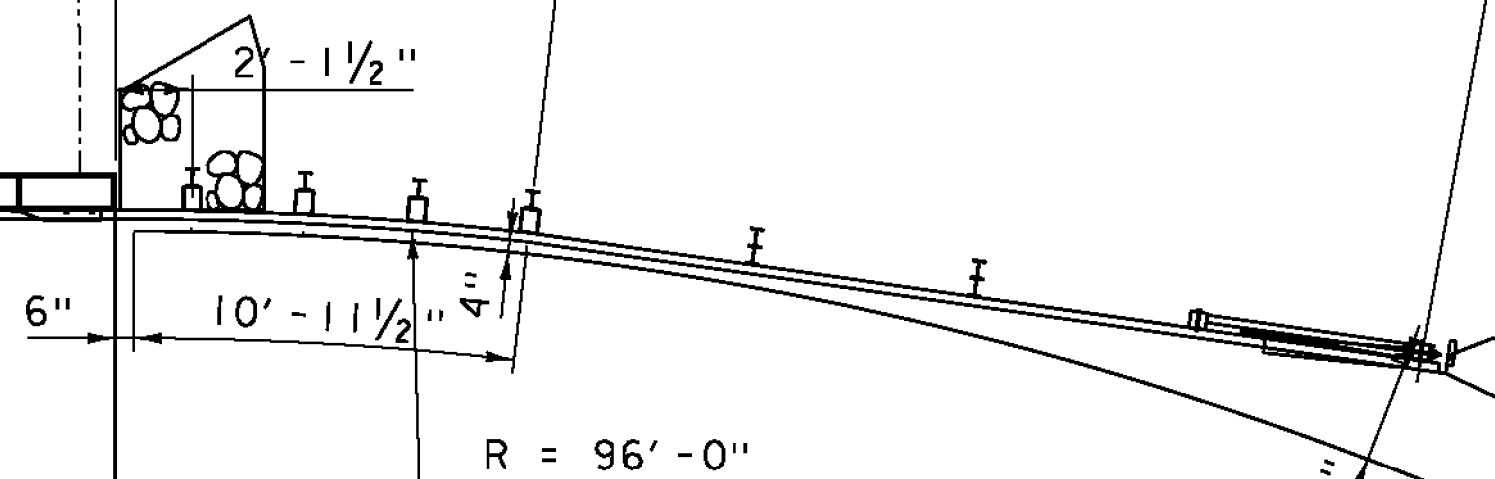

ELL10T ST (TH #446)
TO US 5

0+00 1+00

221°-00'-00"± *

83'-2 3/4"± * (ALONG CENTERLINE OF RAIL)

ELL10T ST (TH #446)
TO US 5

11'-10 3/4"± *
(ALONG
CENTERLINE
OF RAIL)

REMOVE AND RESET
EXISTING CONCRETE
BARRIER WITH METAL
HAND RAIL (PAID FOR
UNDER ITEM 621.95)

R = 5'-0"

ANCHOR FOR
STEEL BEAM RAIL

22'-10 1/2" HD STEEL BEAM
GUARDRAIL, GALVANIZED

SEE INSERT "A"

7'-10 1/4"

ANCHOR FOR
STEEL BEAM RAIL


END GUARDRAIL

ROUNDED "W" BEAM END SECTION
(INCIDENTAL TO ITEM 621.21,
"HD STEEL BEAM GUARDRAIL,
GALVANIZED")

RAIL LAYOUT

SCALE: 3/6" = 1'-0"

95'-1 1/2"± *
SPECIAL PROVISION (BRIDGE RAILING, GALVANIZED
METAL HAND RAILING/CONCRETE PARAPET COMBINATION)

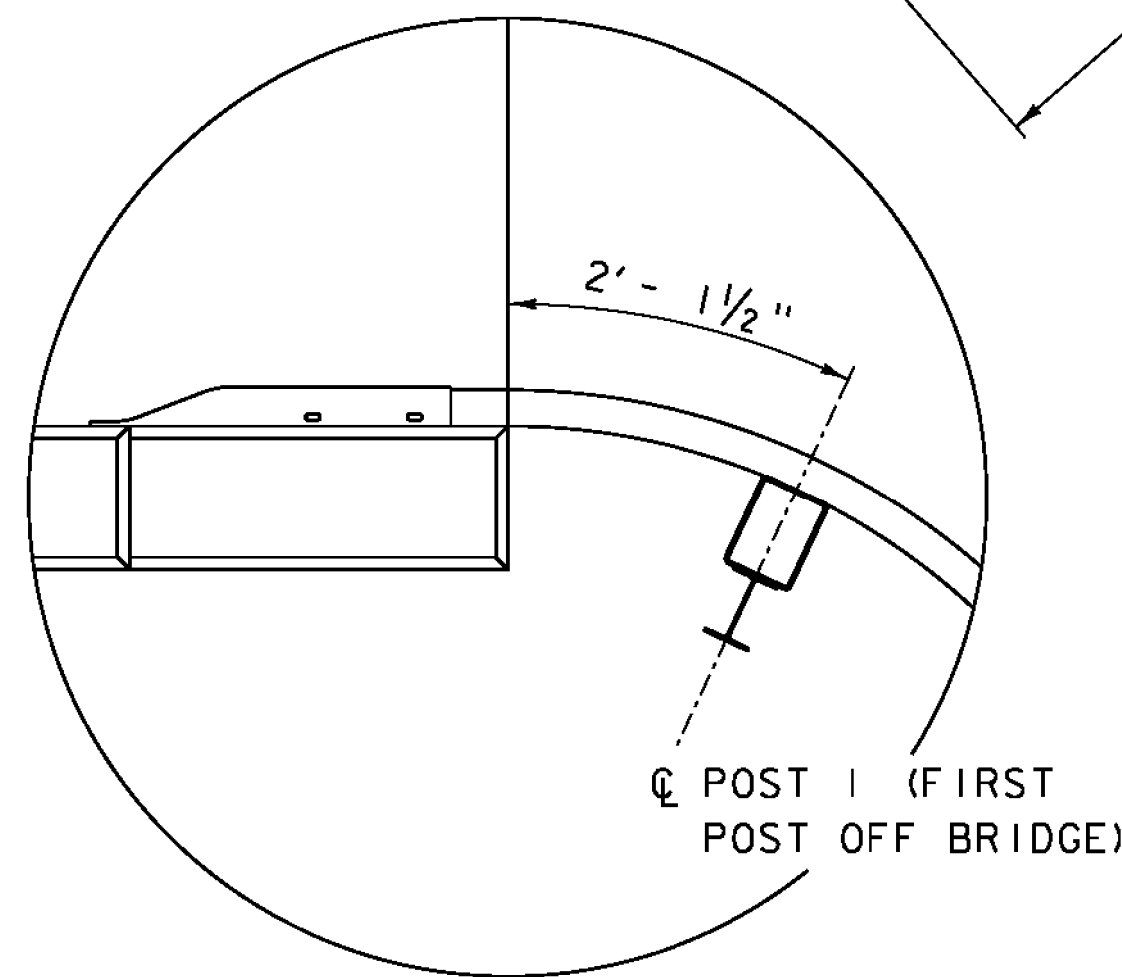

INSERT "A"

(NE CORNER SHOWN, NW CORNER SIMILAR)
SCALE: 3/4" = 1'-0"

* DIMENSIONS ARE BASED ON FIELD MEASUREMENTS
AND ARE APPROXIMATE. THE CONTRACTOR SHALL
VERIFY EXISTING DIMENSIONS AND MAKE
ADJUSTMENTS TO RAIL LAYOUT AS APPLICABLE.
SEE SIDEWALK RAMP MASONRY PLAN ON SHEET 14.

NOTES:


1. REFER TO STANDARDS G-1 AND G-1d.
2. SEE BRIDGE AND APPROACH RAIL DETAILS ON SHEETS 19 TO 23.

PROJECT NAME: BRATTLEBORO
PROJECT NUMBER: BF 2000(26)


FILE NAME: z15j091rail_bdr-3l.dgn
PROJECT LEADER: J. BYATT
DESIGNED BY: M. SMITH
RAIL LAYOUT SHEET

PLOT DATE: 2/5/2016
DRAWN BY: M. SMITH
CHECKED BY: N. CARON
SHEET 18 OF 26



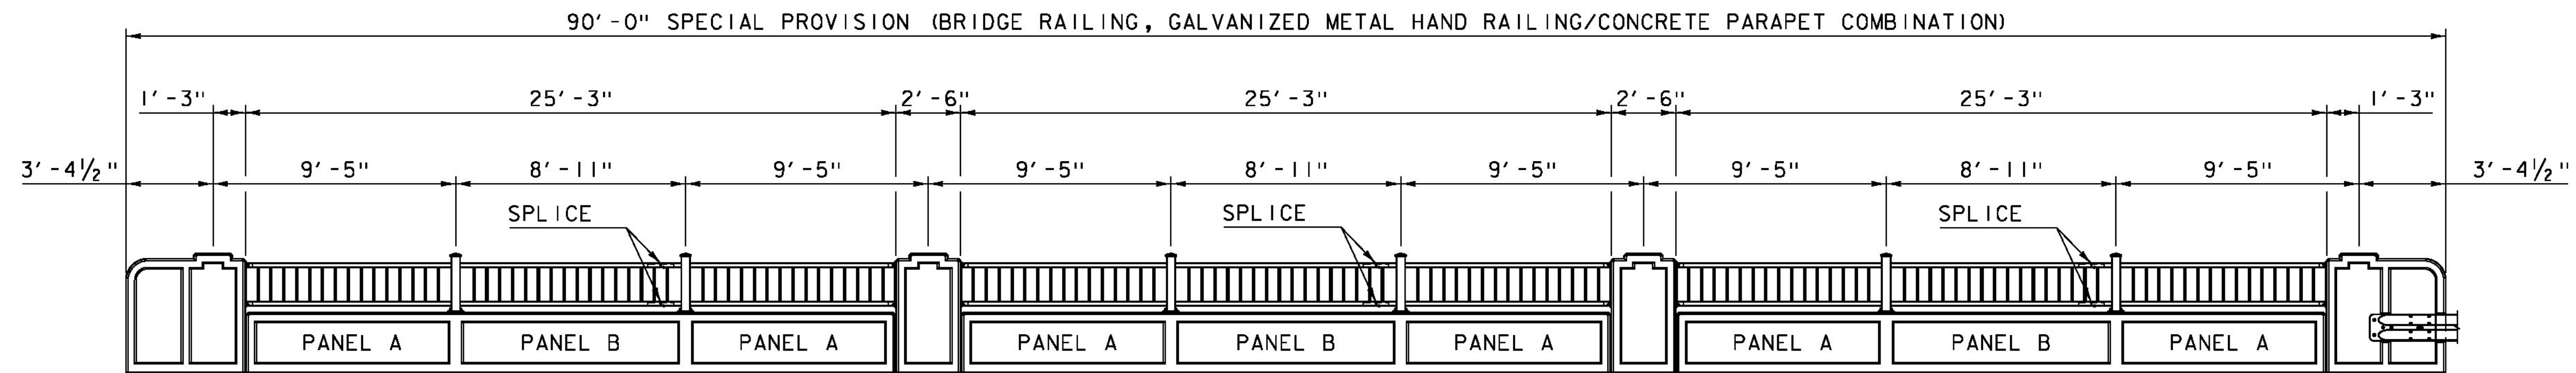

WEST RAIL

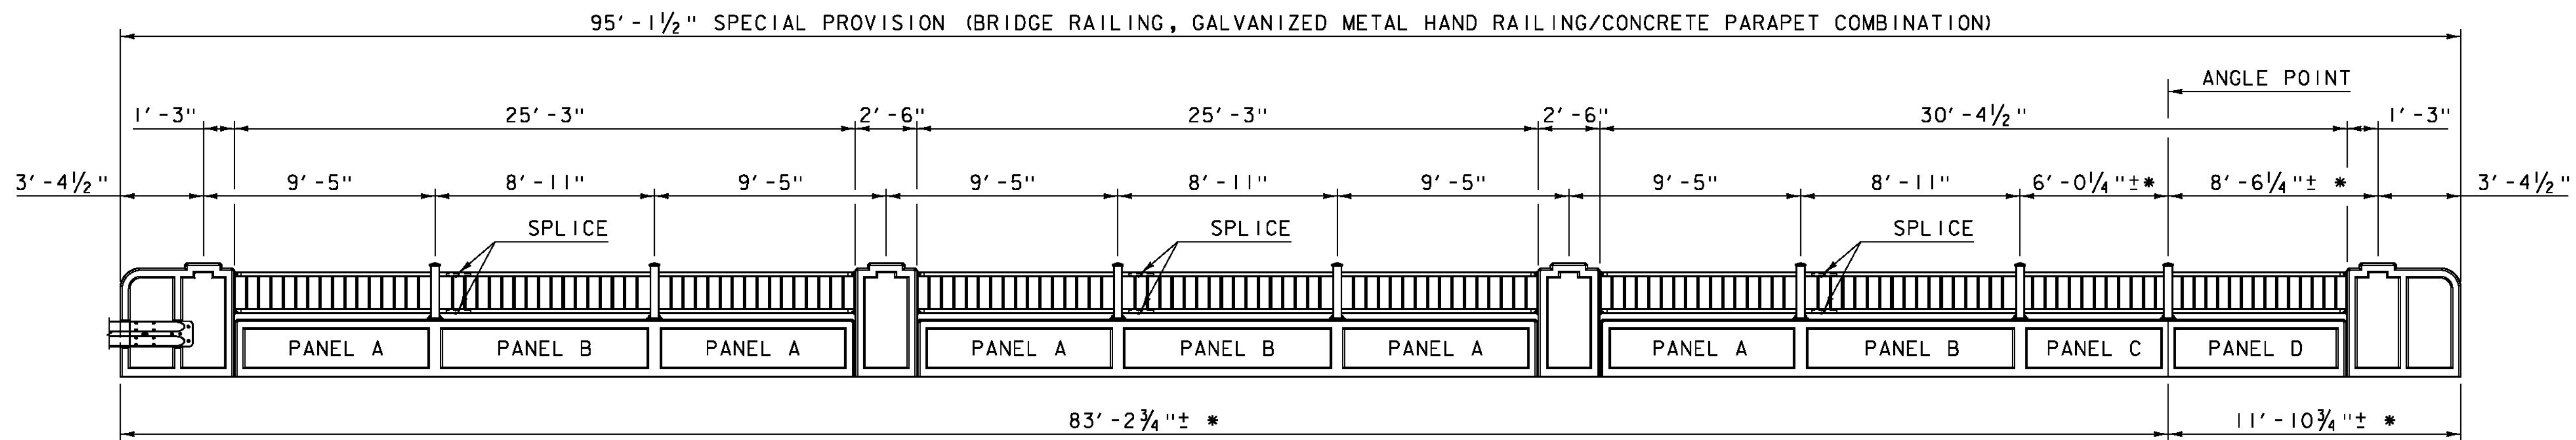


EAST RAIL

BRIDGE RAIL ELEVATION (INTERIOR FACE)

SCALE: 1/4" = 1'-0"

* DIMENSIONS ARE BASED ON FIELD MEASUREMENTS AND ARE APPROXIMATE. THE CONTRACTOR SHALL VERIFY EXISTING DIMENSIONS AND MAKE ADJUSTMENTS TO RAIL LAYOUT AS APPLICABLE. SEE SIDEWALK RAMP MASONRY PLAN ON SHEET 14.

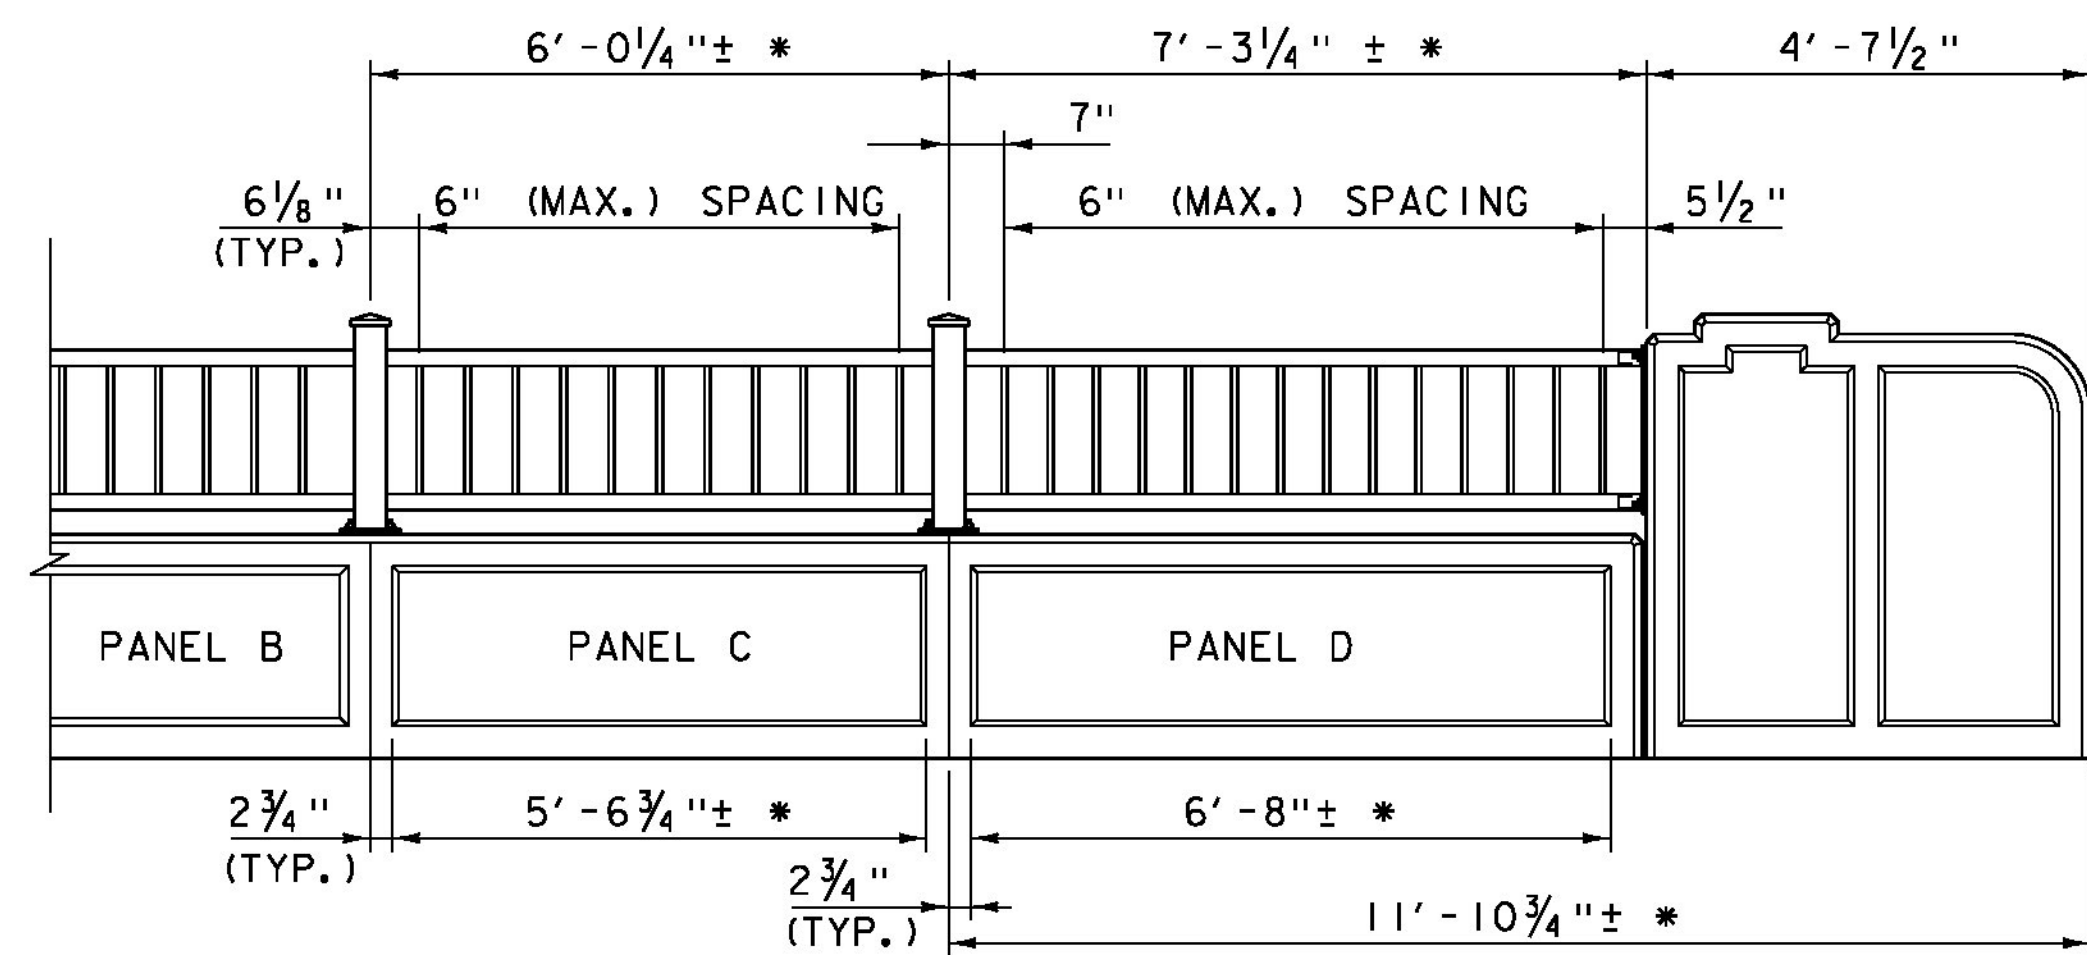

BRIDGE RAIL ELEVATION (INTERIOR FACE) AT SIDEWALK RAMP

SCALE: 1/2" = 1'-0"

NOTES:


1. ALL DIMENSIONS ARE MEASURED ALONG CENTERLINE OF RAIL UNLESS NOTED OTHERWISE ON PLANS.
2. THE BRIDGE PLAQUE FURNISHED BY THE AGENCY SHALL BE CAST INTO THE BACKFACE OF THE CONCRETE RAIL AT THE NORTHEAST END PILASTER. SEE STANDARD SD-502.00 FOR ADDITIONAL INFORMATION.

PROJECT NAME: BRATTLEBORO
PROJECT NUMBER: BF 2000(26)

FILE NAME: z15J091rall_bdr-31.dgn
PROJECT LEADER: J. BYATT
DESIGNED BY: M. SMITH
BRIDGE RAIL DETAILS SHEET 1


PLOT DATE: 2/5/2016
DRAWN BY: M. SMITH
CHECKED BY: N. CARON
SHEET 19 OF 26



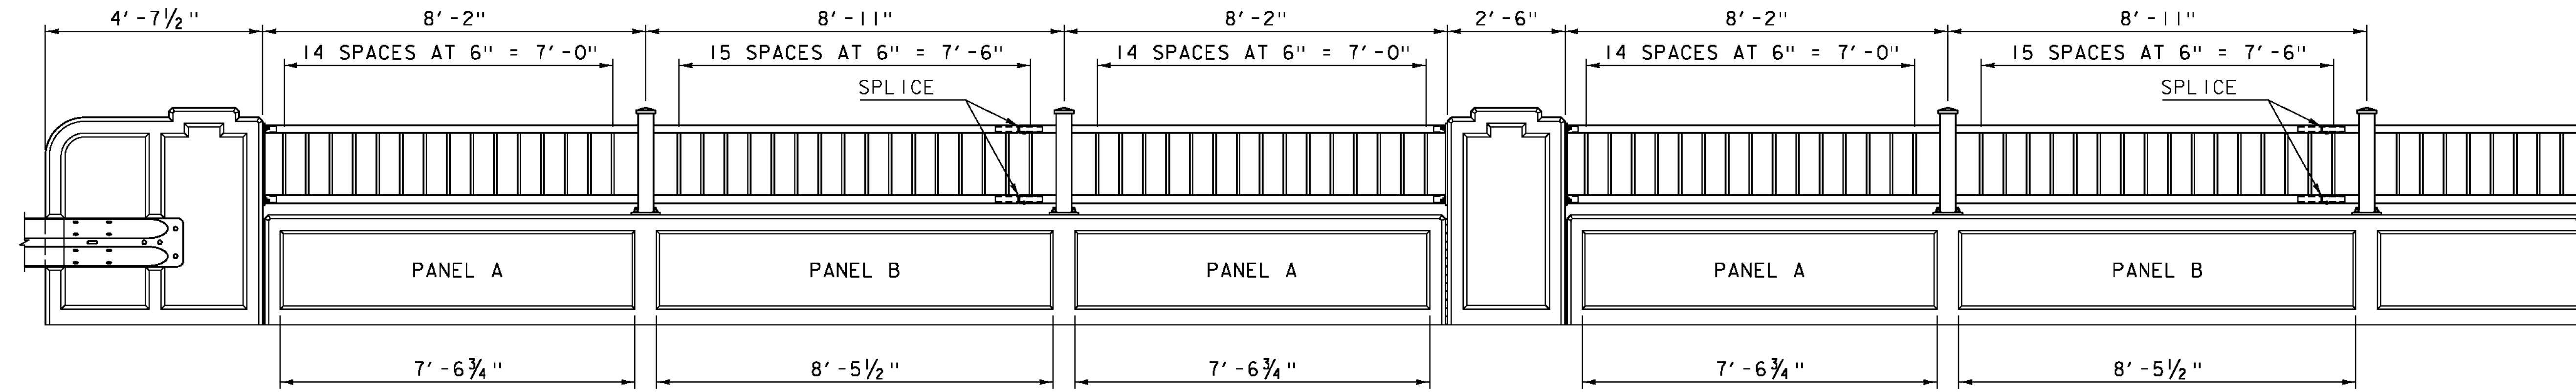


BRIDGE RAIL ELEVATION (INTERIOR FACE)

SCALE: 1/2" = 1'-0"

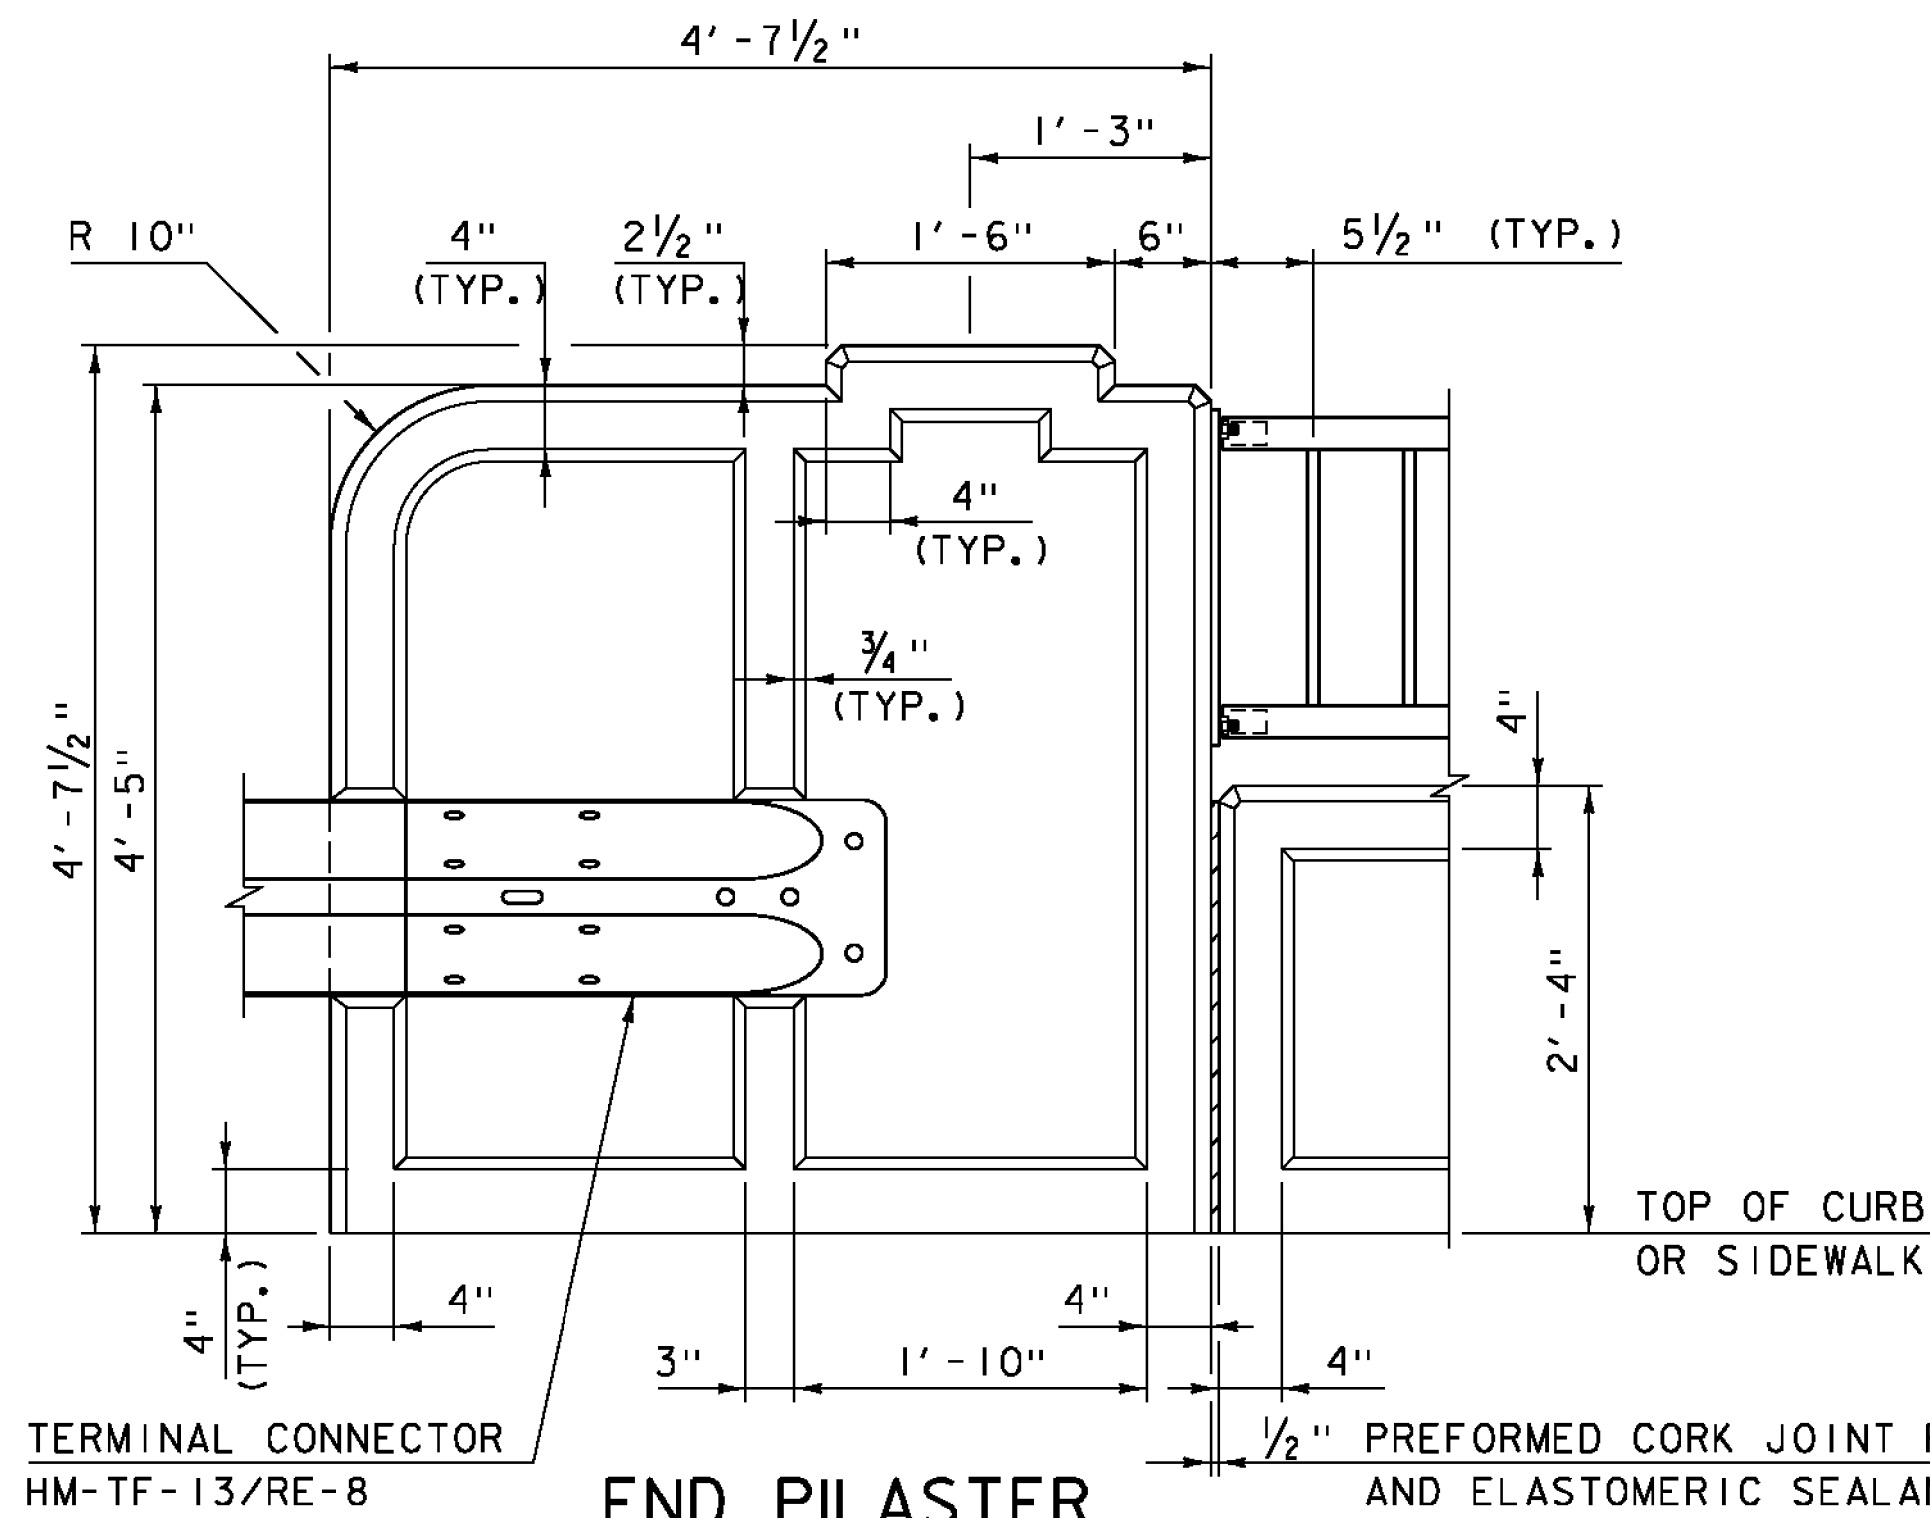


END PILASTER

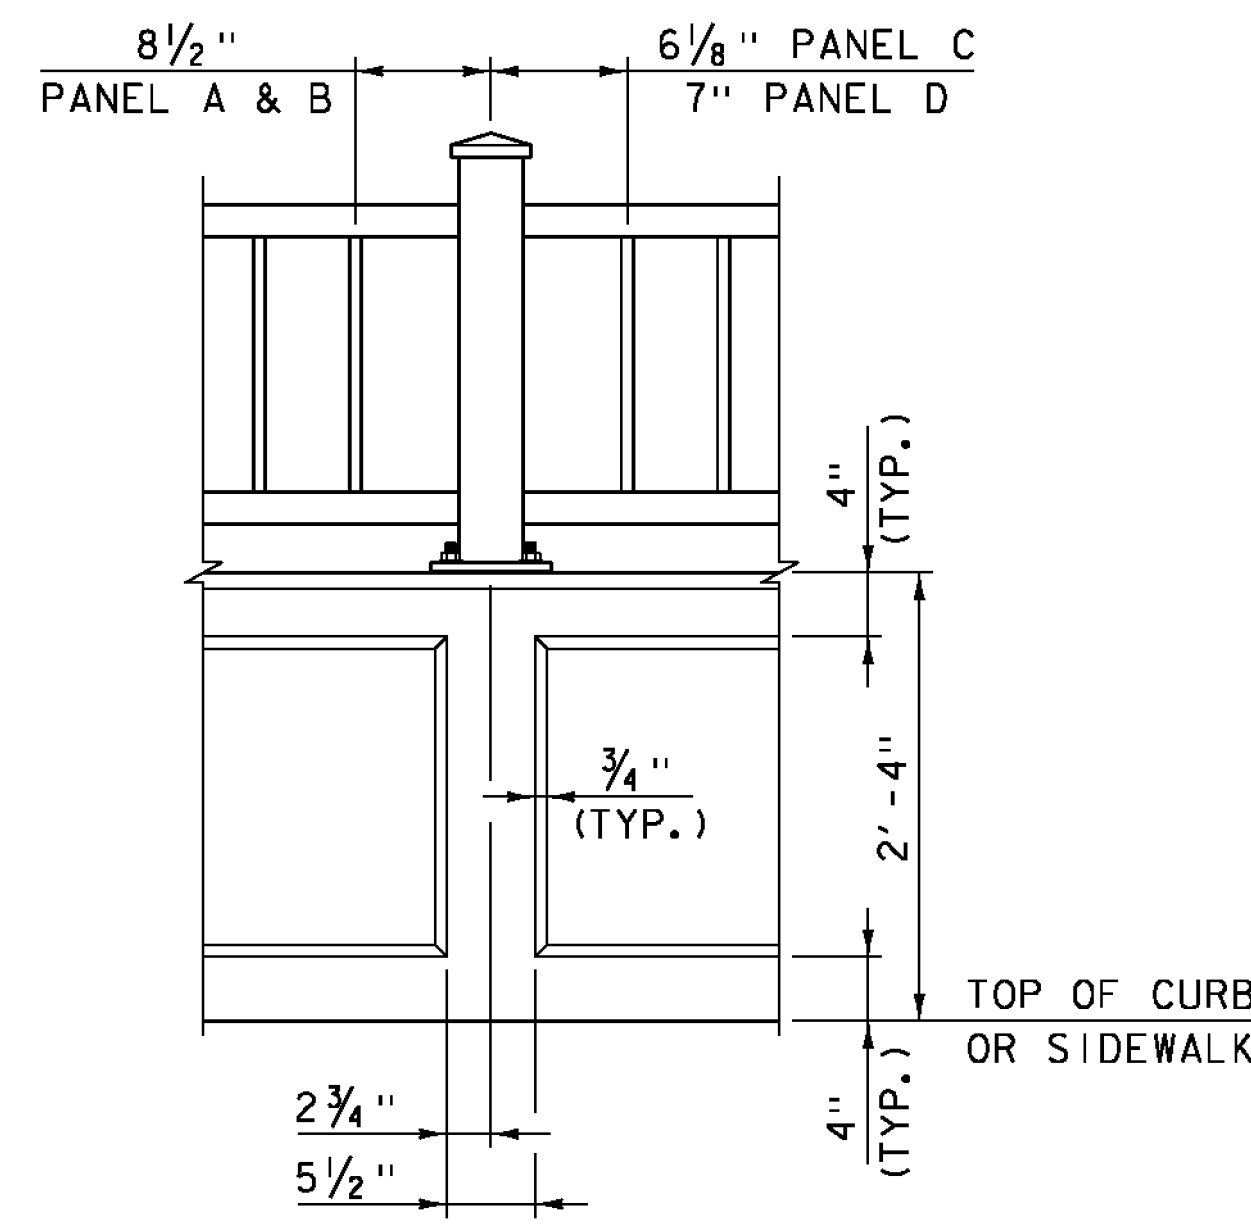

POST

BRIDGE RAIL CONCRETE DETAILS

SCALE: 1" = 1'-0"

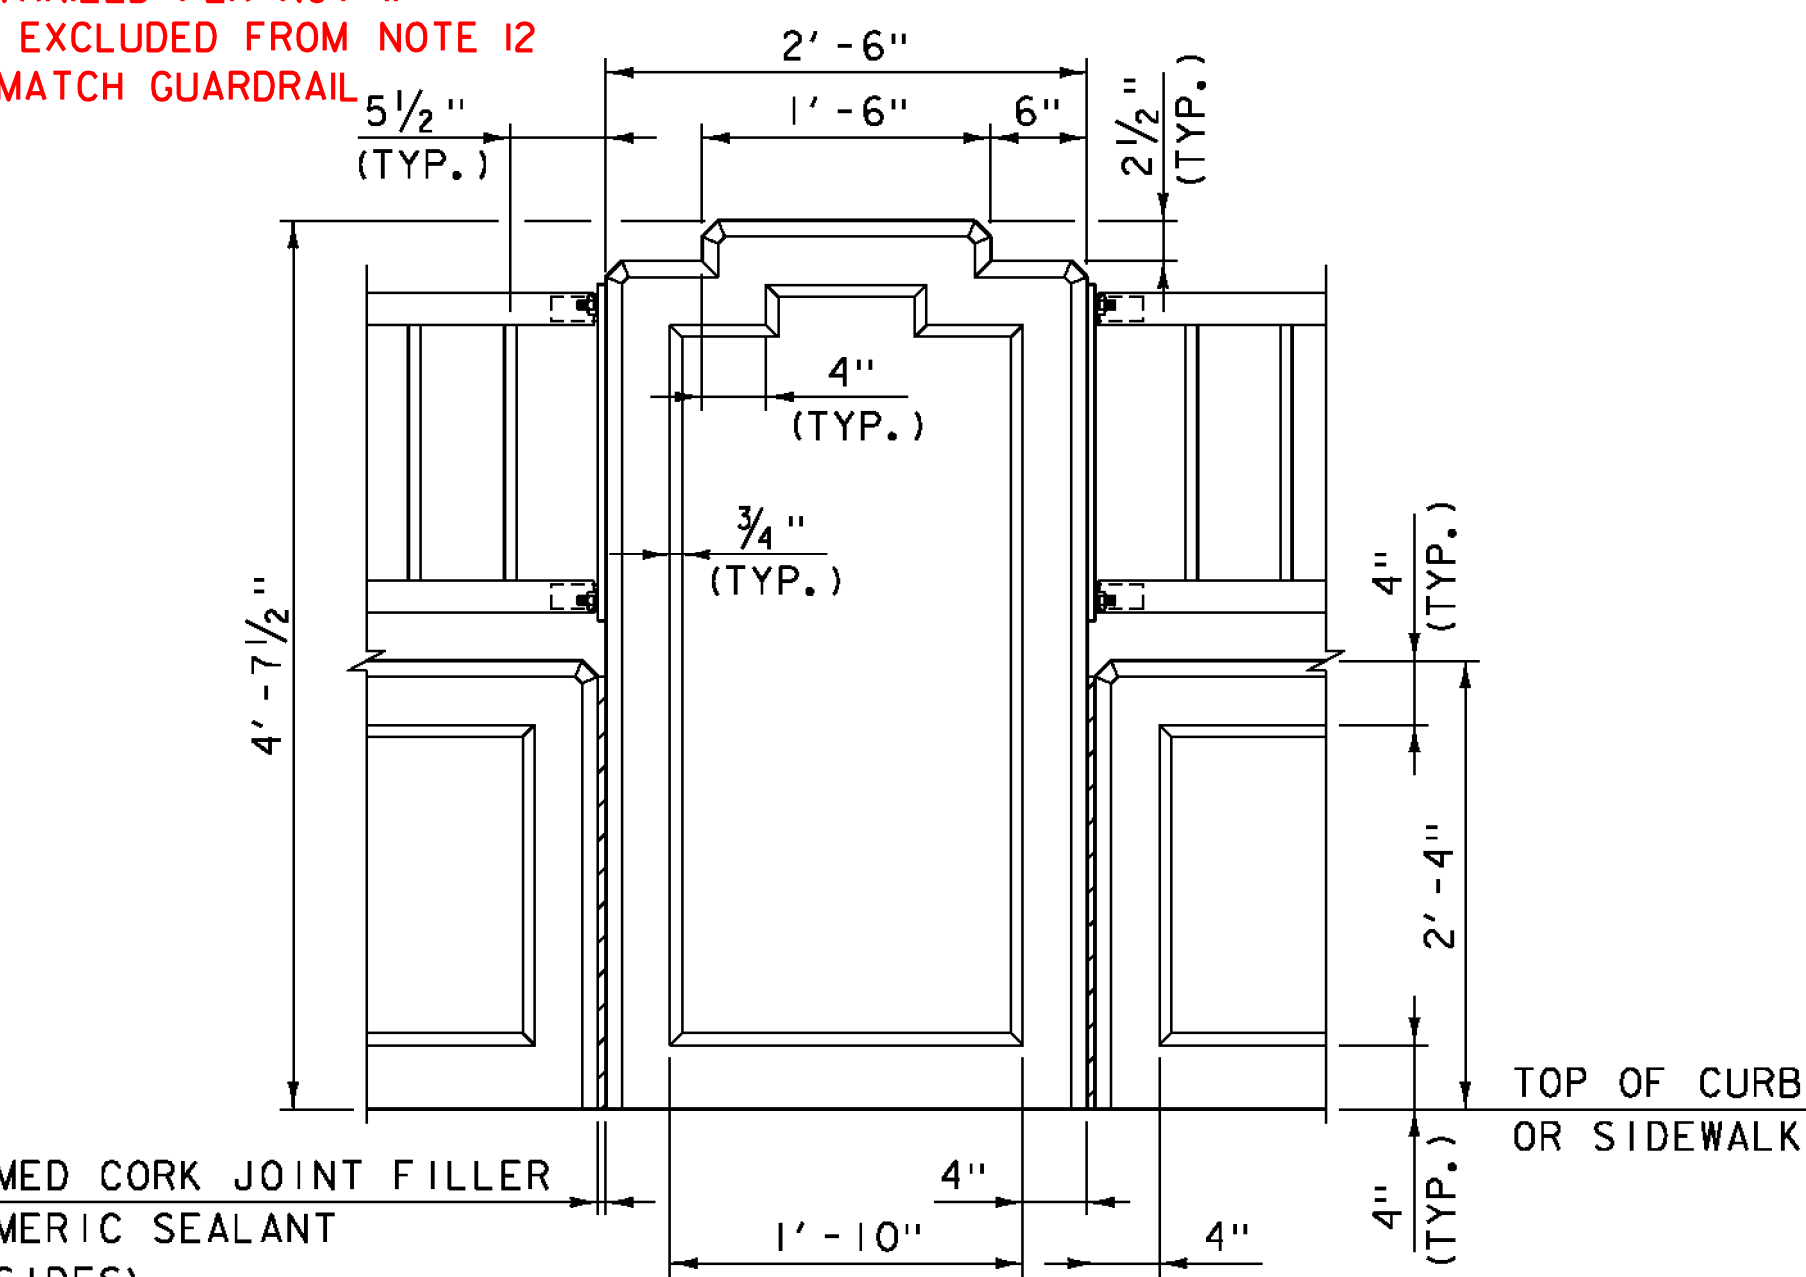

INTERMEDIATE PILASTER

BRIDGE RAIL NOTES

1. ALL DIMENSIONS TO FACE OF CONCRETE UNLESS NOTED OTHERWISE.
2. RAIL POSTS WILL BE SET NORMAL TO GRADE.
3. BRIDGE RAIL WILL BE PAID FOR UNDER ITEM 900.640, "SPECIAL PROVISION (BRIDGE RAILING, GALVANIZED METAL HAND RAILING/CONCRETE PARAPET COMBINATION)".
4. REINFORCING STEEL IN THE BRIDGE RAILING SHALL BE LEVEL 1 - EPOXY COATED, MEET THE REQUIREMENTS OF SECTION 507, AND WILL BE PAID FOR UNDER ITEM 900.640, "SPECIAL PROVISION (BRIDGE RAILING, GALVANIZED METAL HAND RAILING/CONCRETE PARAPET COMBINATION)". REINFORCING STEEL EXTENDING FROM THE CONCRETE BRIDGE DECK INTO THE BRIDGE RAILING SHALL BE PAID FOR UNDER ITEM 507.11, "REINFORCING STEEL, EPOXY COATED". SEE PROJECT NOTE 28 ON SHEET 3.
5. METAL HAND RAILING, TO INCLUDE STEEL PIPES, PLATES AND HARDWARE, WILL BE PAID FOR UNDER ITEM 900.640, "SPECIAL PROVISION (BRIDGE RAILING, GALVANIZED METAL HAND RAILING/CONCRETE PARAPET COMBINATION)".
6. STEEL PIPES FOR POSTS, TOP AND BOTTOM RAIL, AND PALINGS SHALL BE SEAMLESS, CONFORMING TO SUBSECTION 732.01.
7. STEEL FOR BASE AND ANCHORAGE PLATES SHALL CONFORM TO SUBSECTION 732.03 (b).
8. HARDWARE FOR ANCHOR BOLT ASSEMBLIES SHALL CONFORM TO SUBSECTION 732.03 (d).
9. 1/8" PAD SHALL CONFORM TO SUBSECTION 731.01 OR 731.02.
10. ALL EXPOSED CUT OR SHEARED EDGES OF STEEL COMPONENTS SHALL BE ROUNDED TO A 1/16" RADIUS AND BE FREE OF BURRS.
11. ALL PARTS SHALL BE GALVANIZED AFTER FABRICATION IN ACCORDANCE WITH AASHTO M 111M/M 111, EXCEPT HARDWARE, WHICH SHALL MEET THE REQUIREMENTS OF AASHTO M 232M/M 232.
12. ALL PARTS EXCEPT HARDWARE AND ANCHORAGE PLATES SHALL BE PAINTED BLACK (COLOR CHIP #27038).
13. RAIL POST ANCHORING NUTS SHALL BE TIGHTENED TO A SNUG FIT AND GIVEN AN ADDITIONAL ONE-EIGHTH TURN.
14. THE FABRICATOR SHALL SUBMIT FABRICATION DRAWINGS INCLUDING WELDING PROCEDURES FOR METAL HAND RAILING IN ACCORDANCE WITH SECTION 105.

TERMINAL CONNECTOR
HM-TF-13/RE-8
FIELD CHANGED TO BE
GALVANIZED PER NOTE 11
BUT EXCLUDED FROM NOTE 12
TO MATCH GUARDRAIL


1/2" PREFORMED CORK JOINT FILLER
AND ELASTOMERIC SEALANT
(TYP BOTH SIDES)

PROJECT NAME: BRATTLEBORO
PROJECT NUMBER: BF 2000(26)


FILE NAME: z15j091rall_bdr-3l.dgn
PROJECT LEADER: J. BYATT
DESIGNED BY: M. SMITH
BRIDGE RAIL DETAILS SHEET 2

PLOT DATE: 2/5/2016
DRAWN BY: M. SMITH
CHECKED BY: N. CARON
SHEET 20 OF 26




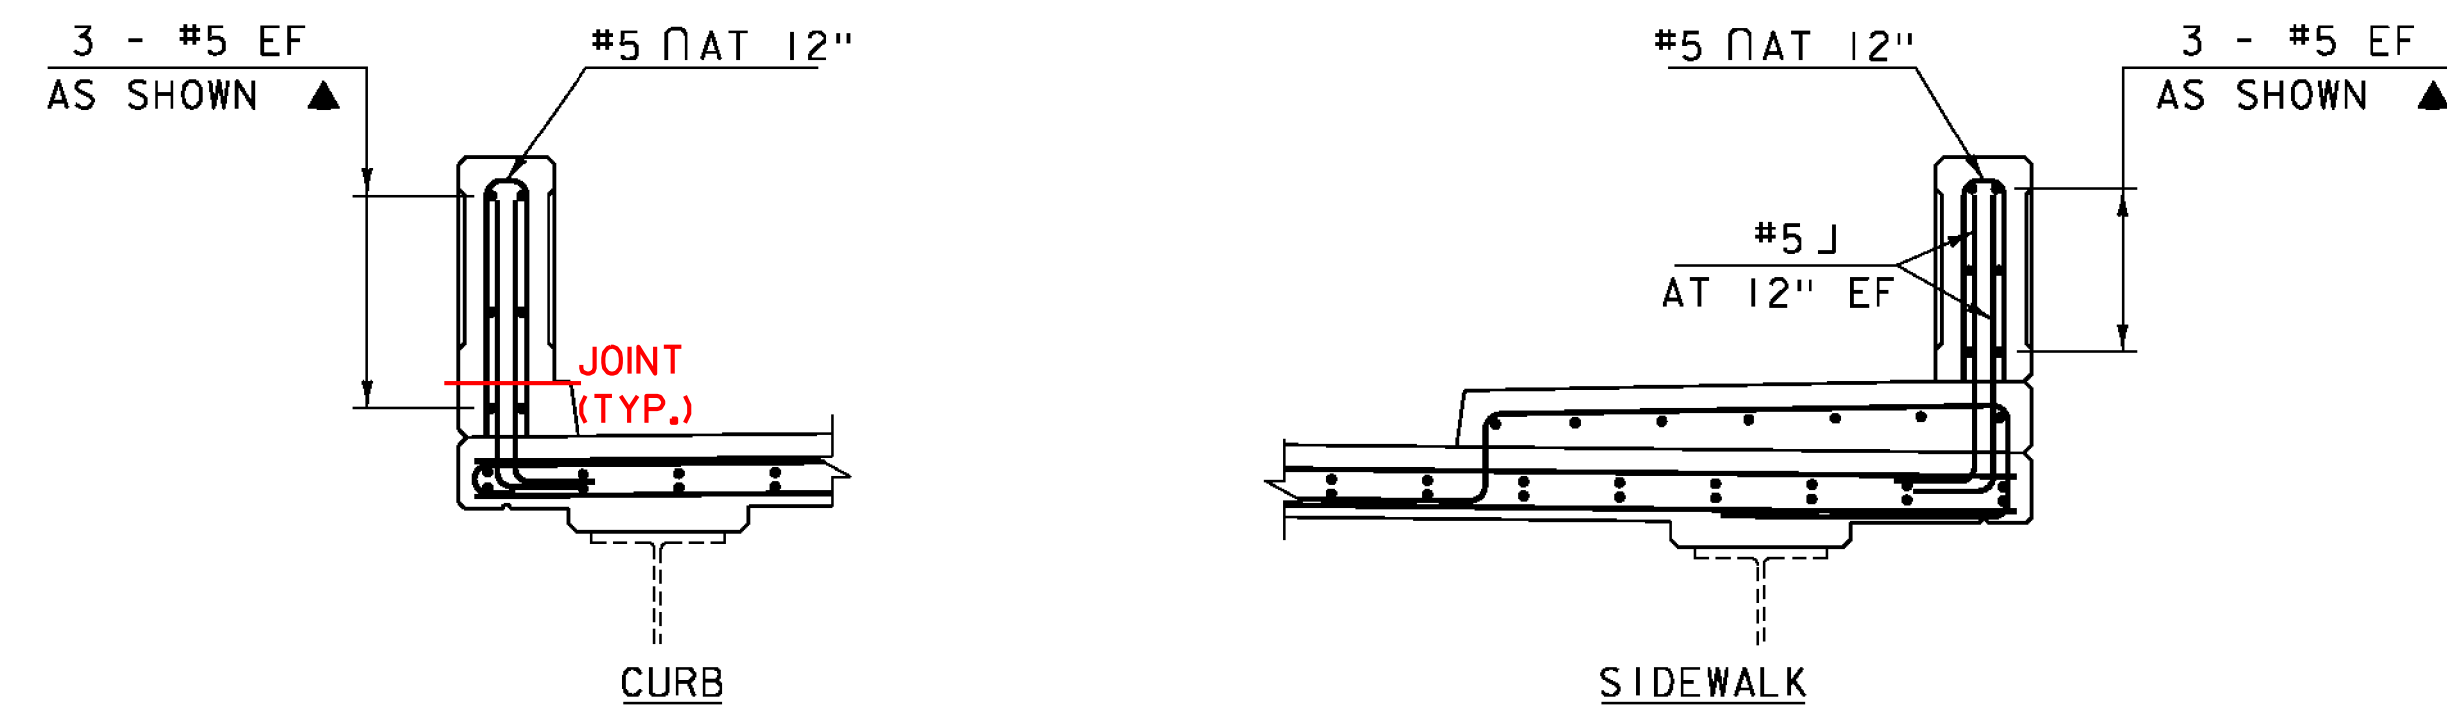


TYPICAL CONCRETE BASE PARAPET SECTIONS
SCALE: 1/2" = 1'-0"

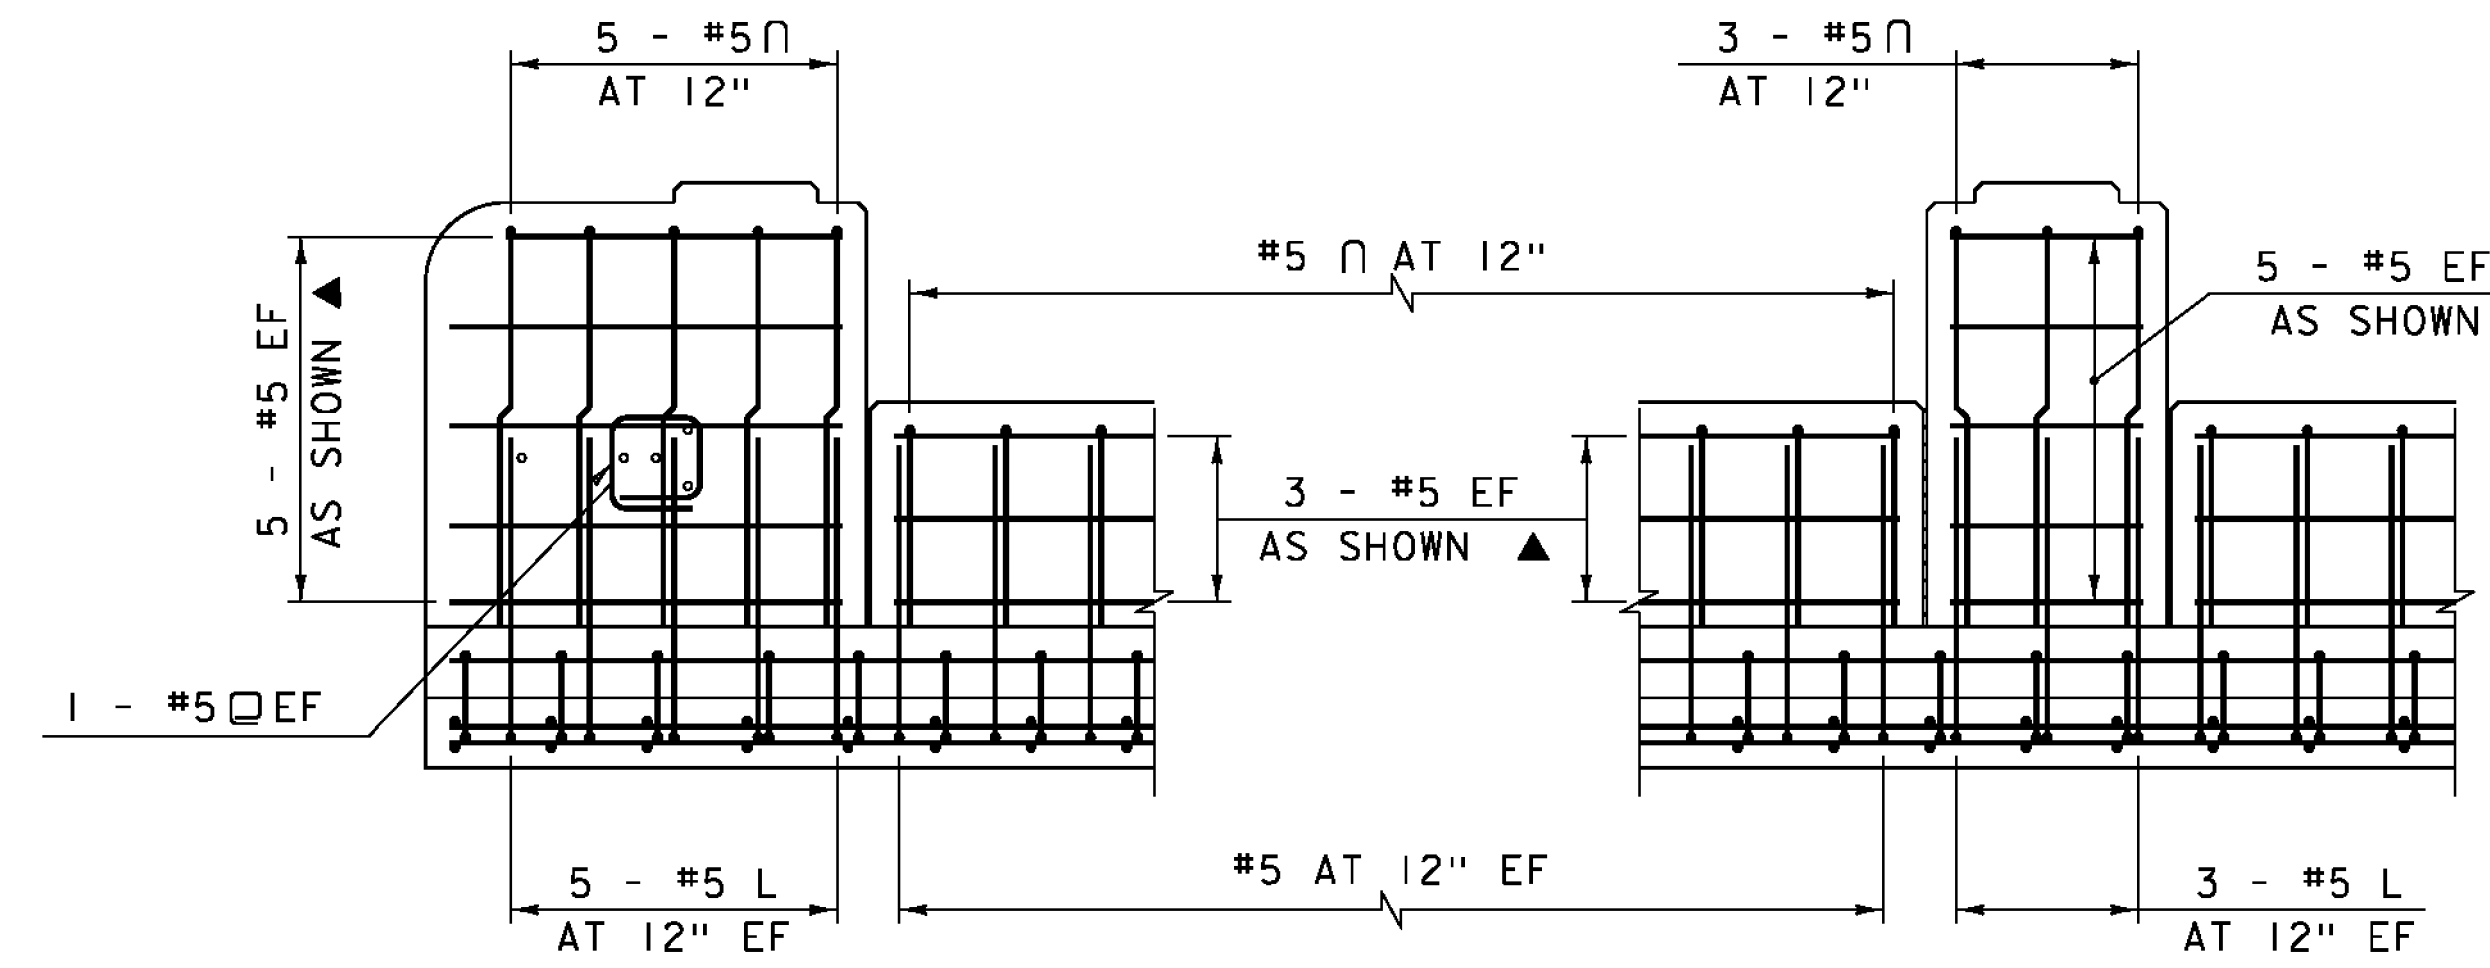


TYPICAL REINFORCING SIDEWALK SIDE
SCALE: 1/2" = 1'-0"

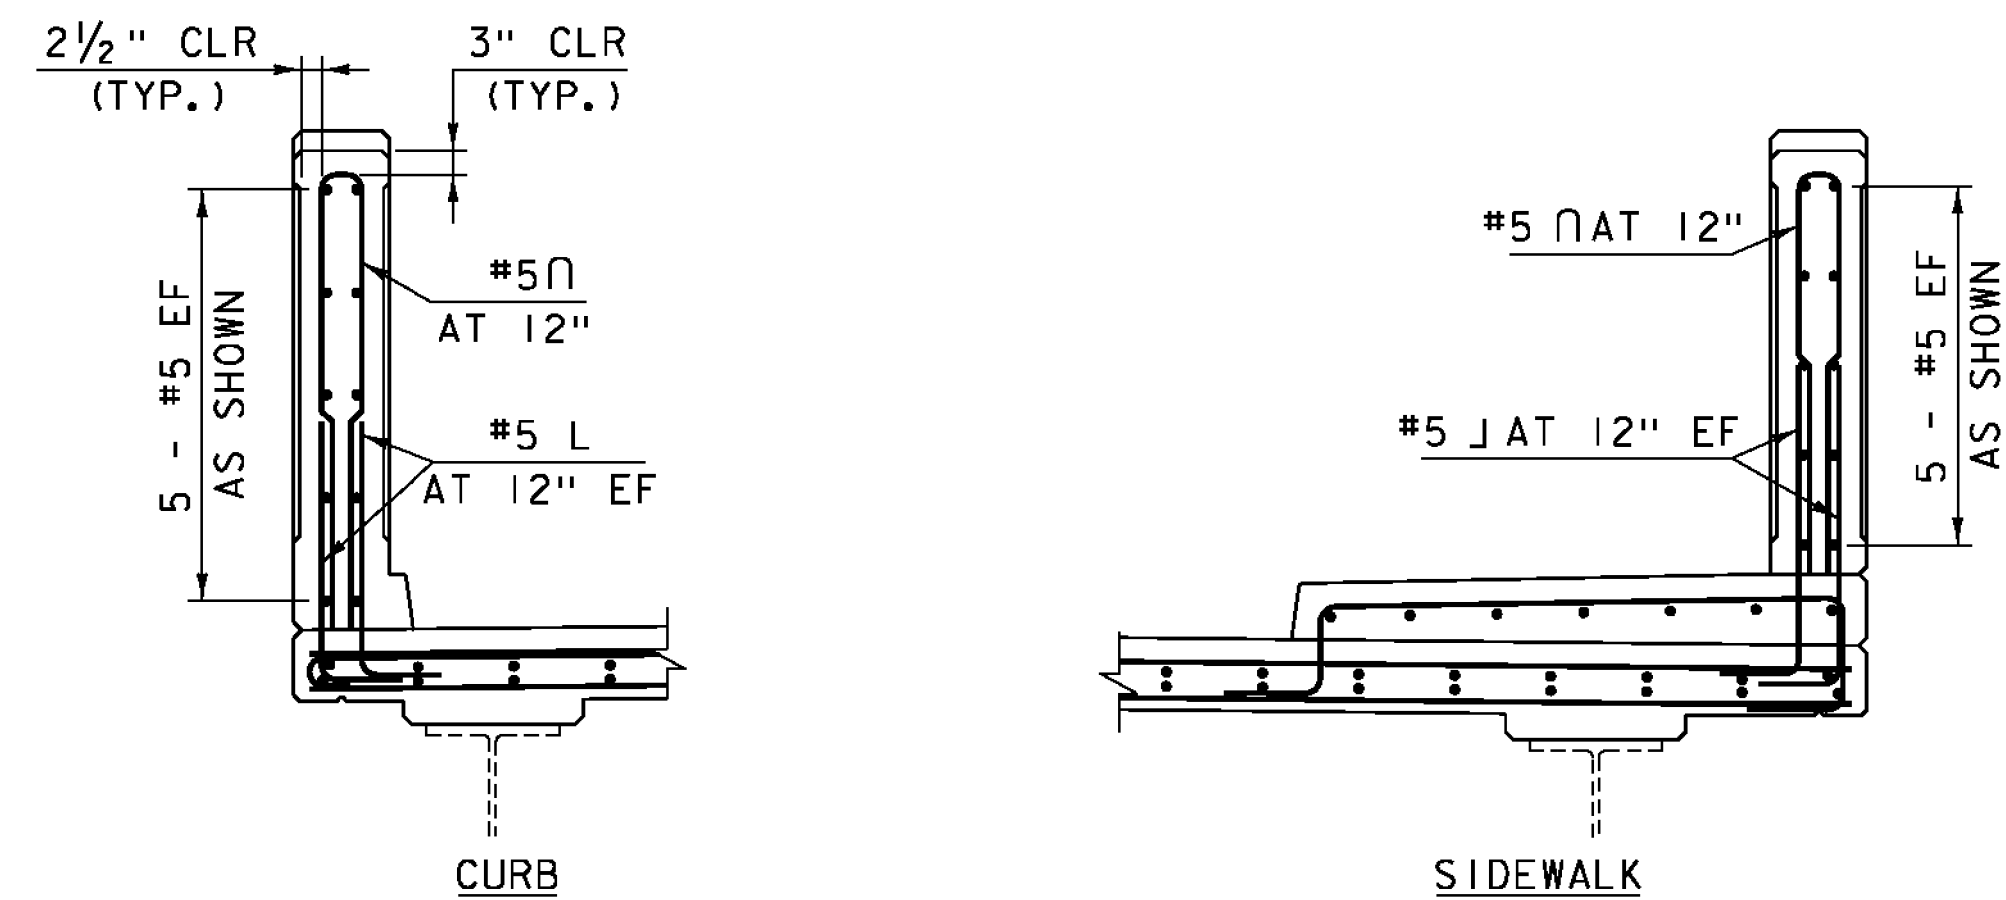


TYPICAL INTERMEDIATE PILASTER SECTIONS
SCALE: 1/2" = 1'-0"
(END PILASTERS ARE SIMILAR)

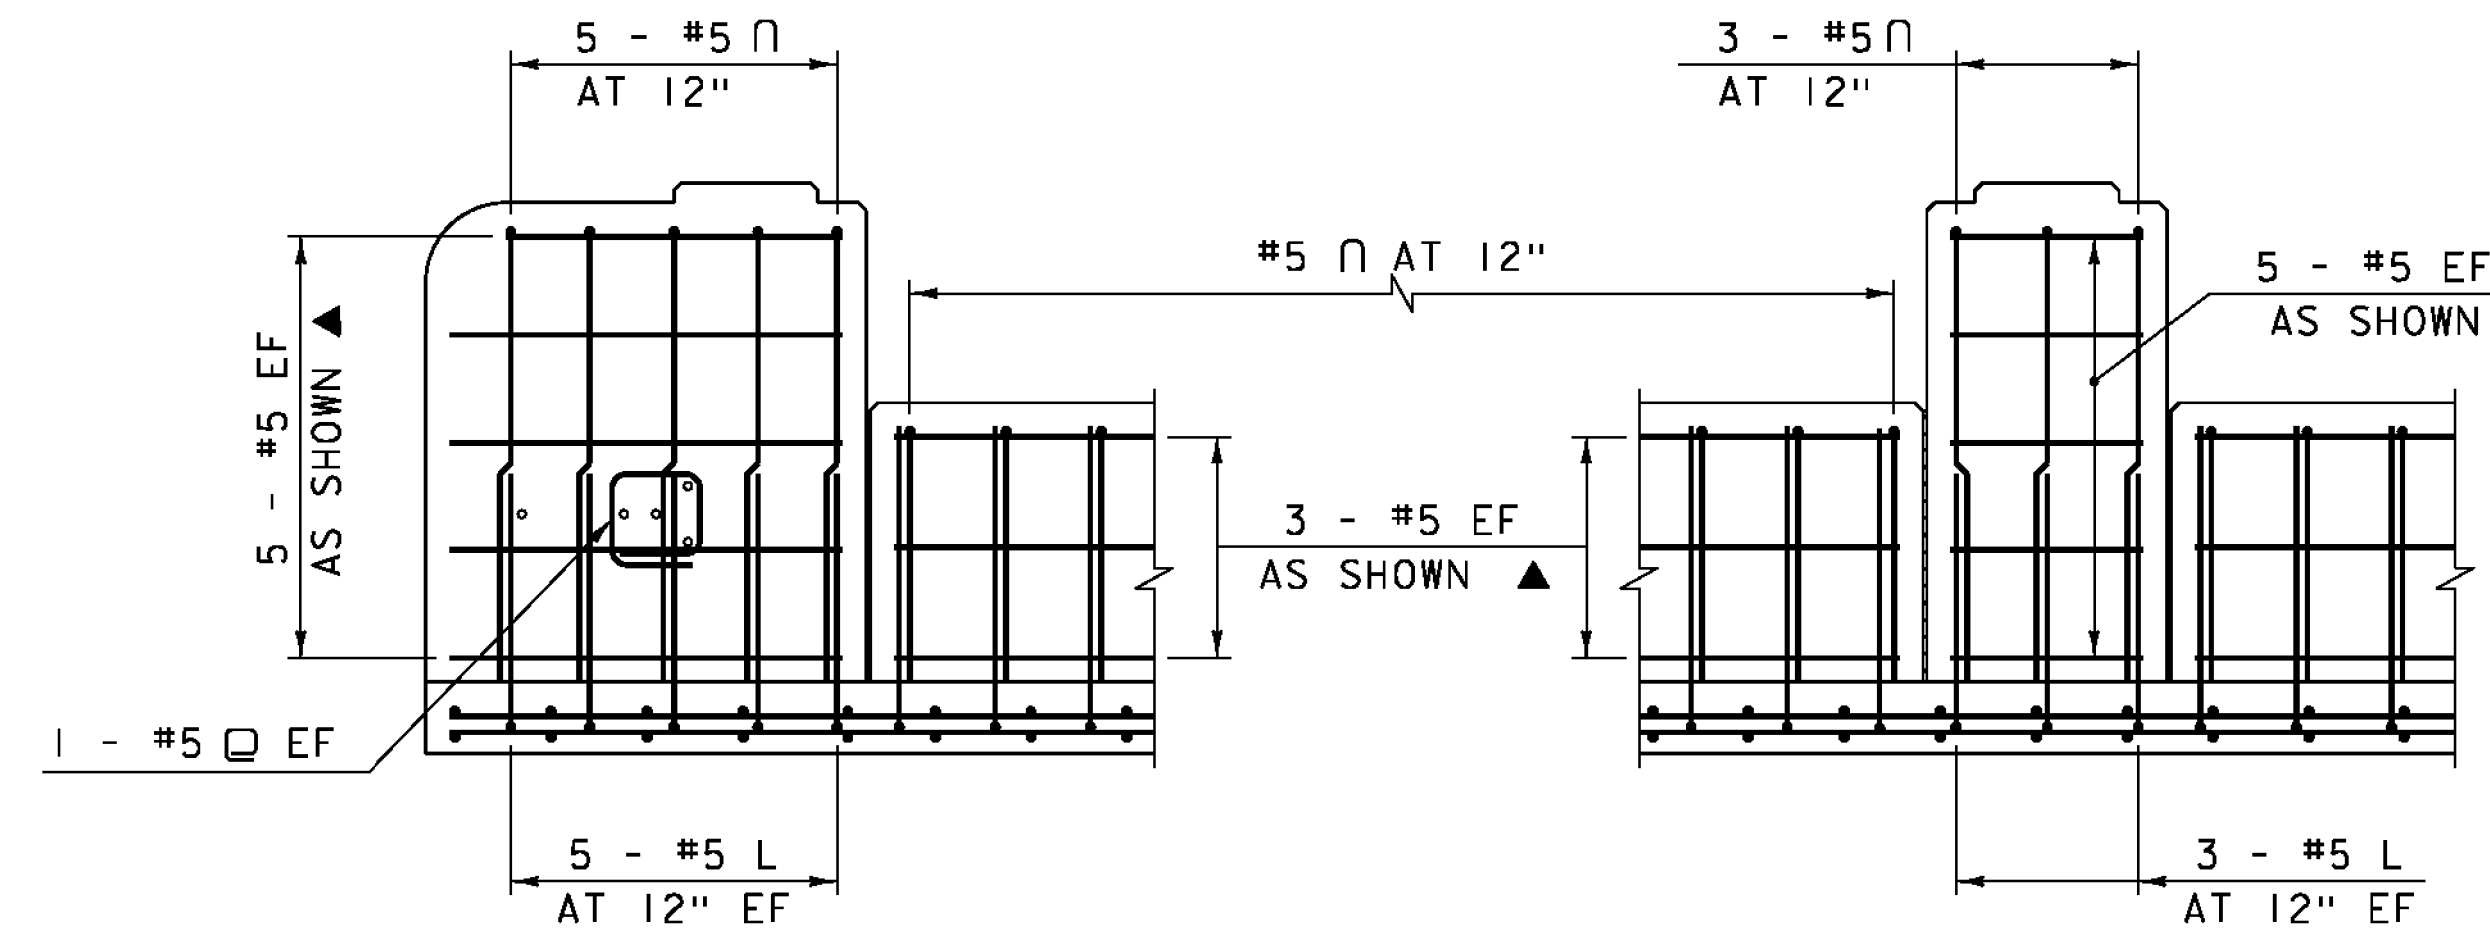


TYPICAL REINFORCING CURB SIDE
SCALE: 1/2" = 1'-0"

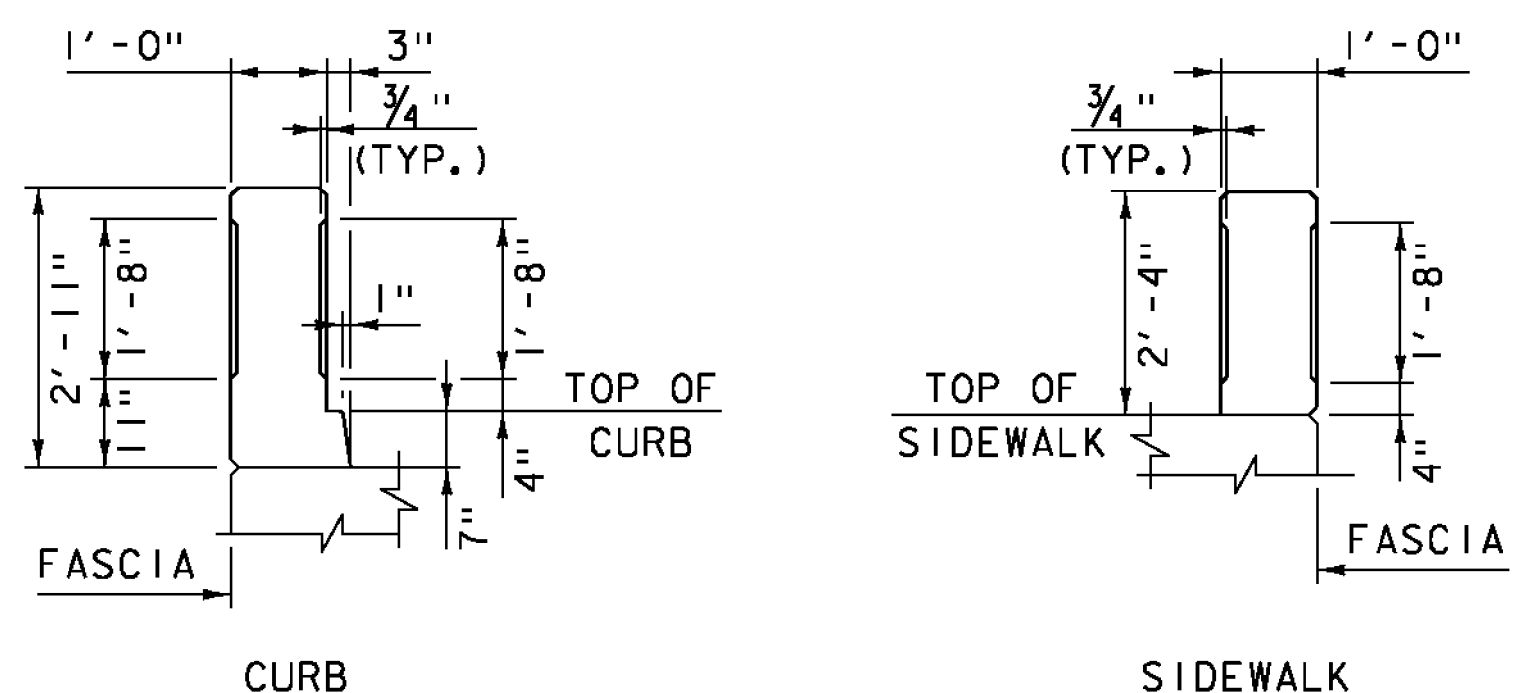

CONCRETE INSERT DETAILS
SCALE: 1/2" = 1'-0"

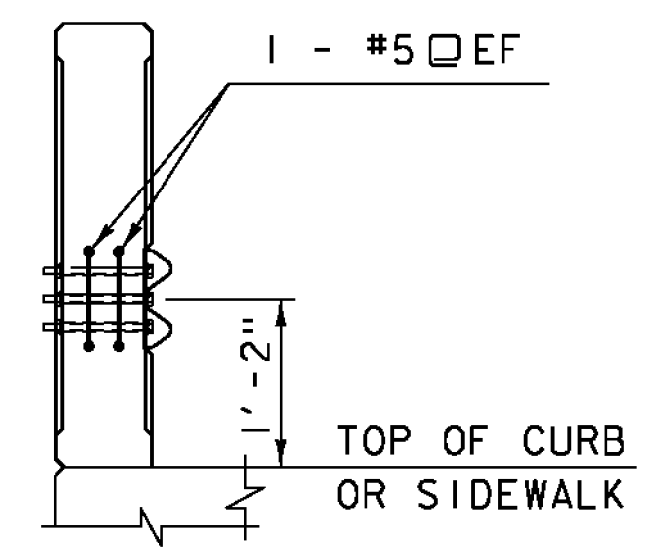


SECTION "A-A"
SCALE: 1/2" = 1'-0"

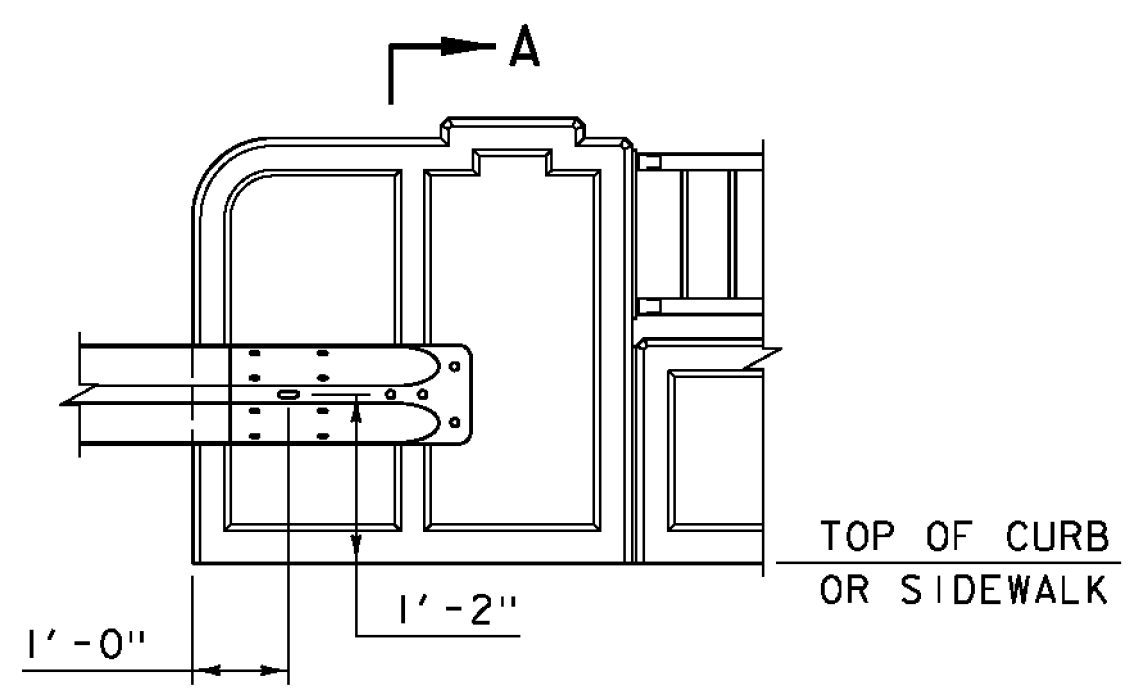


TERMINAL CONNECTOR LOCATION
SCALE: 1/2" = 1'-0"

NOTE:
 NF = NEAR FACE
 FF = FAR FACE
 EF = EACH FACE
 ALL REINFORCING ON THIS SHEET SHALL BE LEVEL I EPOXY COATED REINFORCING STEEL
 ▲ = CUT TO FIT IN FIELD
 3" CLEAR, UNLESS OTHERWISE SPECIFIED ON THE PLANS.
 2'-2" BAR LAP UNLESS OTHERWISE SPECIFIED ON THE PLANS.

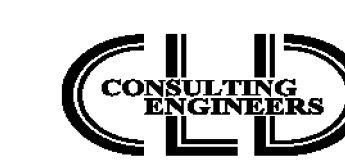


PROJECT NAME:	BRATTLEBORO	PLOT DATE:	2/5/2016
PROJECT NUMBER:	BF 2000(26)	DRAWN BY:	M. SMITH
FILE NAME:	z15j091r011_bdr-31.dgn	DESIGNED BY:	M. SMITH
		CHECKED BY:	N. CARON
		BRIDGE RAIL DETAILS SHEET 3	SHEET 21 OF 26

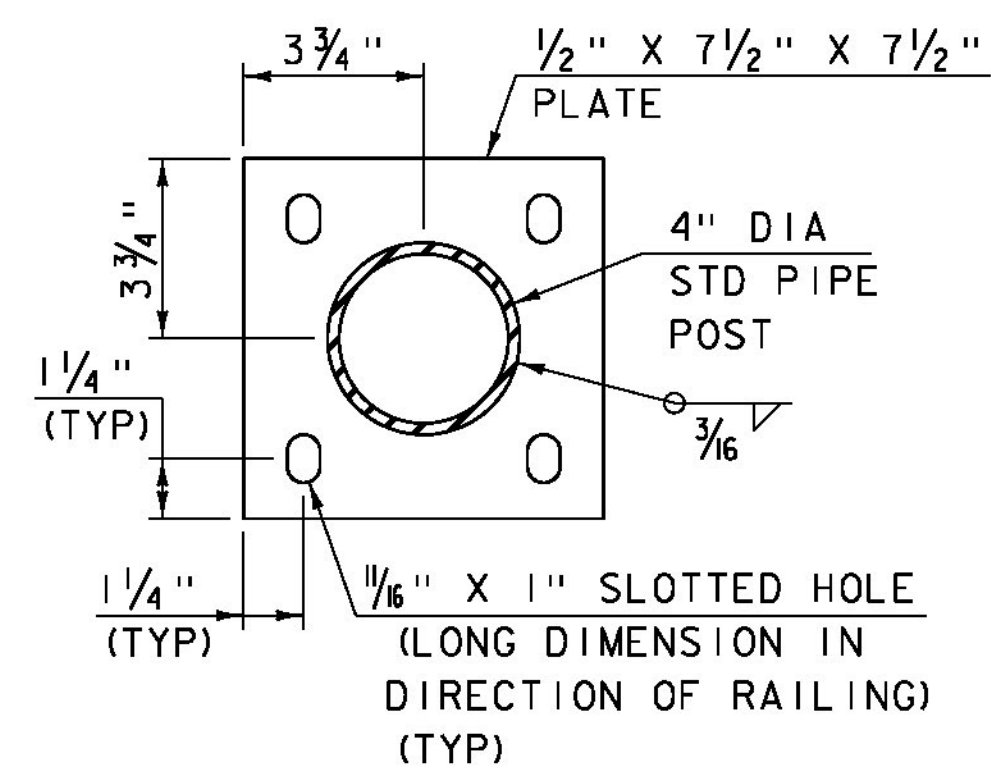


POST BASE PLATE

SCALE: 3" = 1'-0"

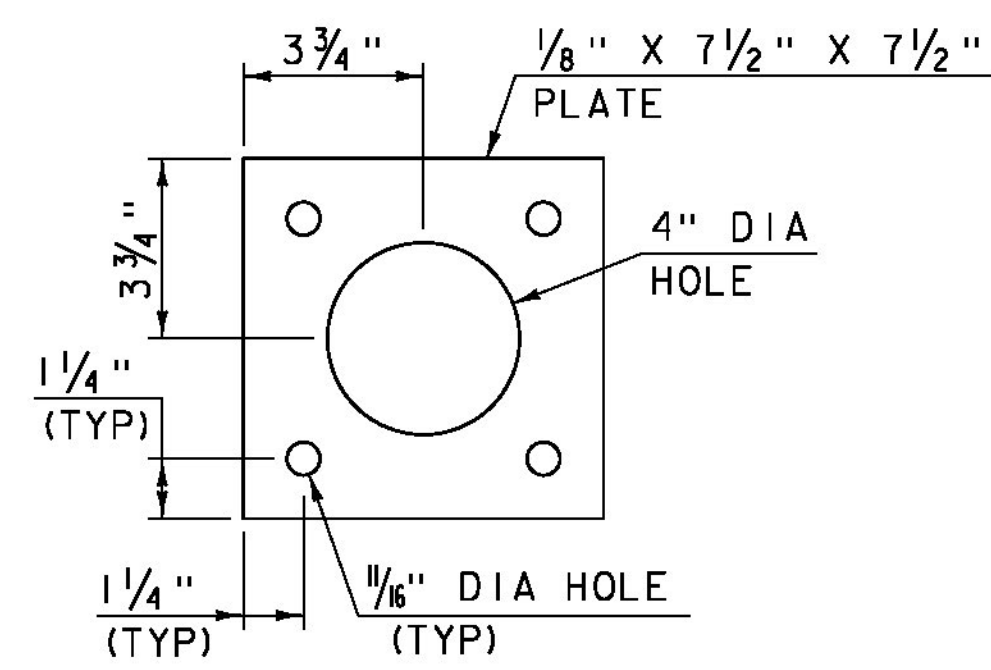


POST ANCHORAGE PLATE

SCALE: 3" = 1'-0"

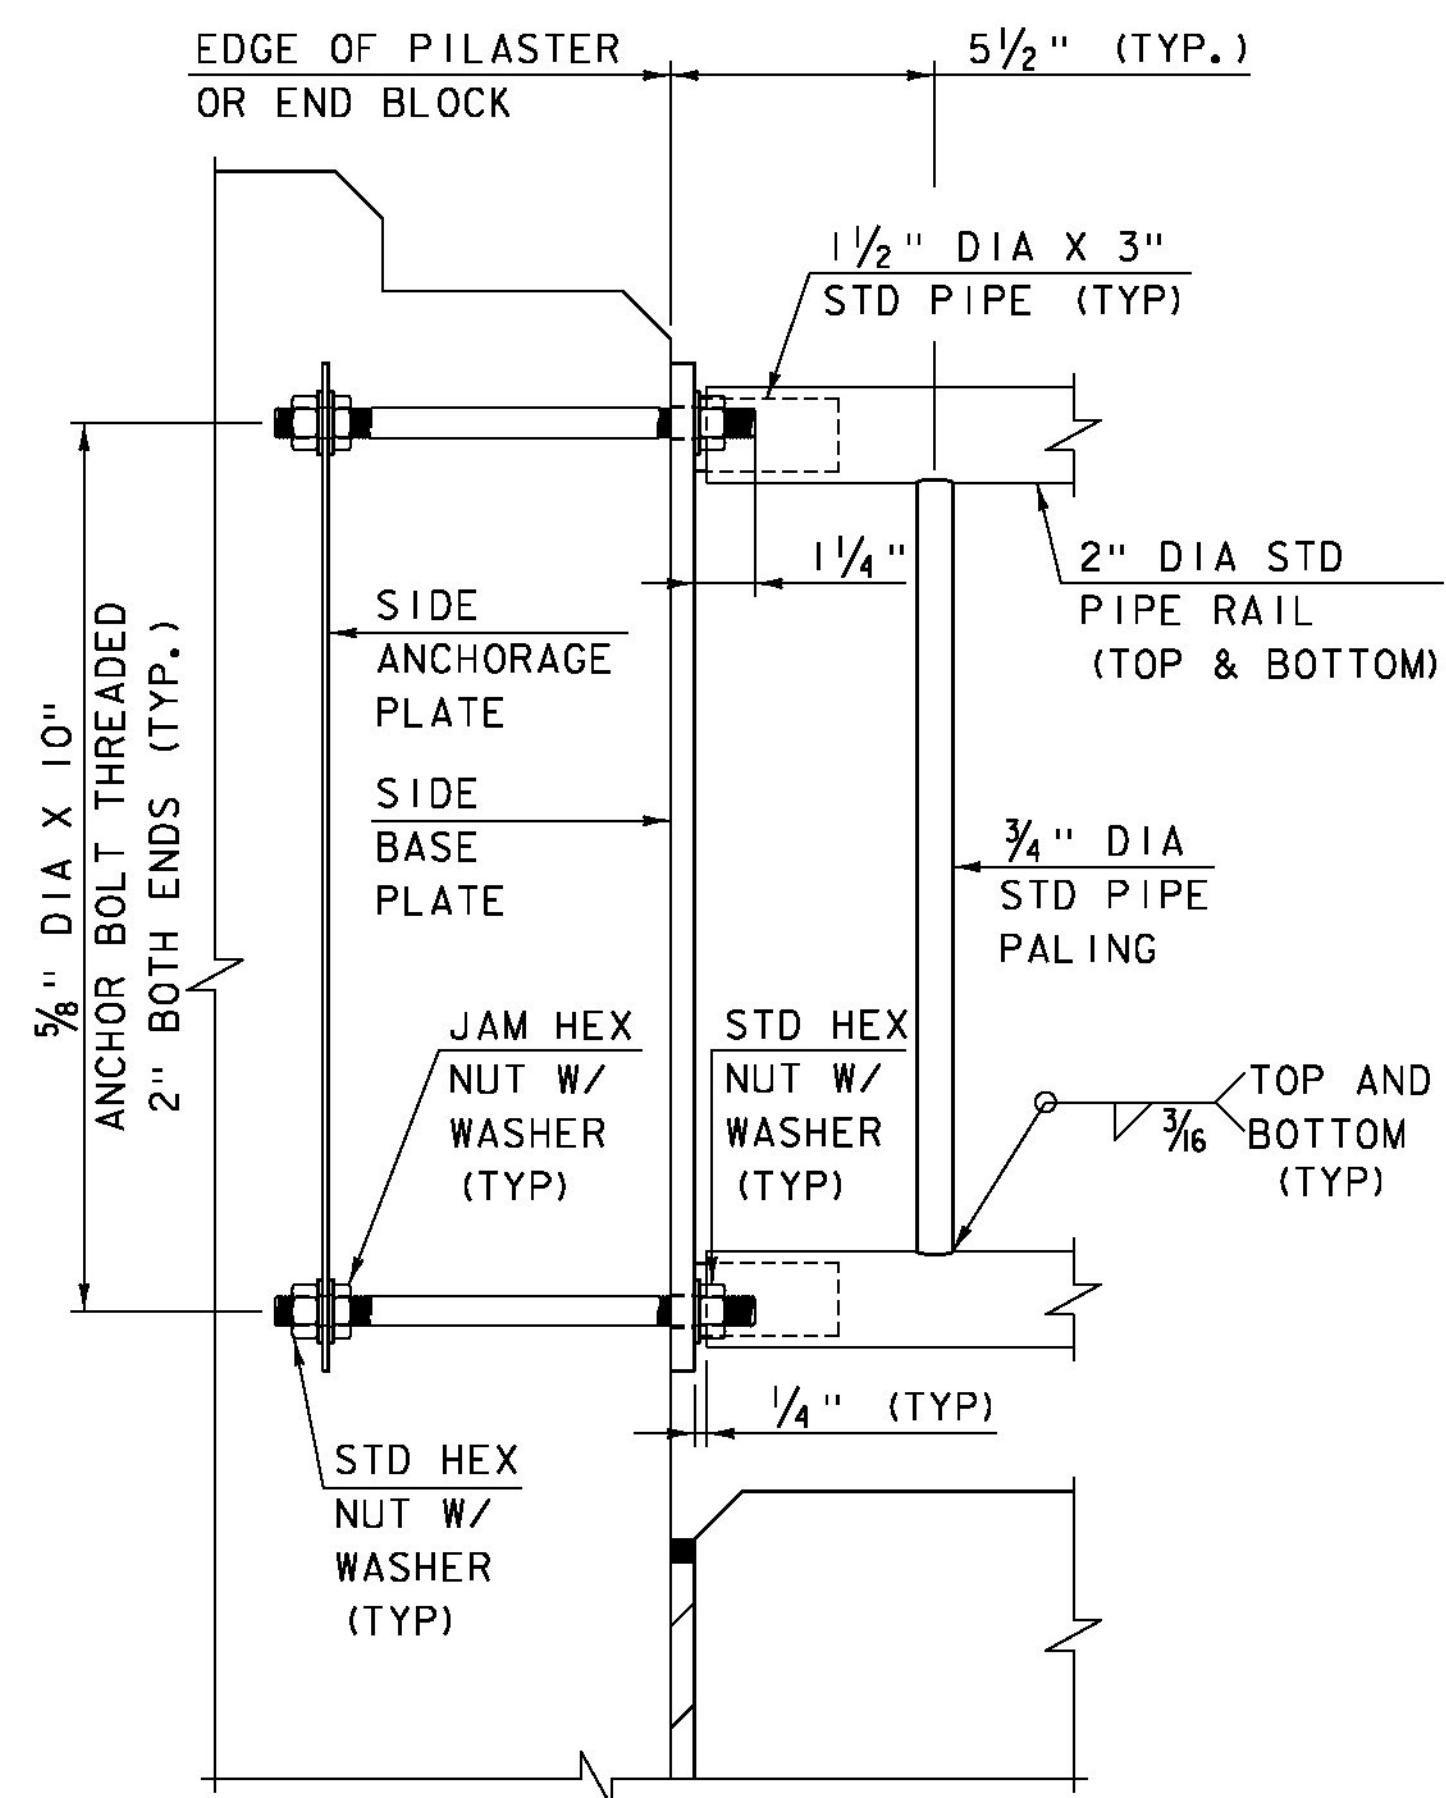


SIDE PLATE CONNECTION DETAIL

SCALE: 3" = 1'-0"

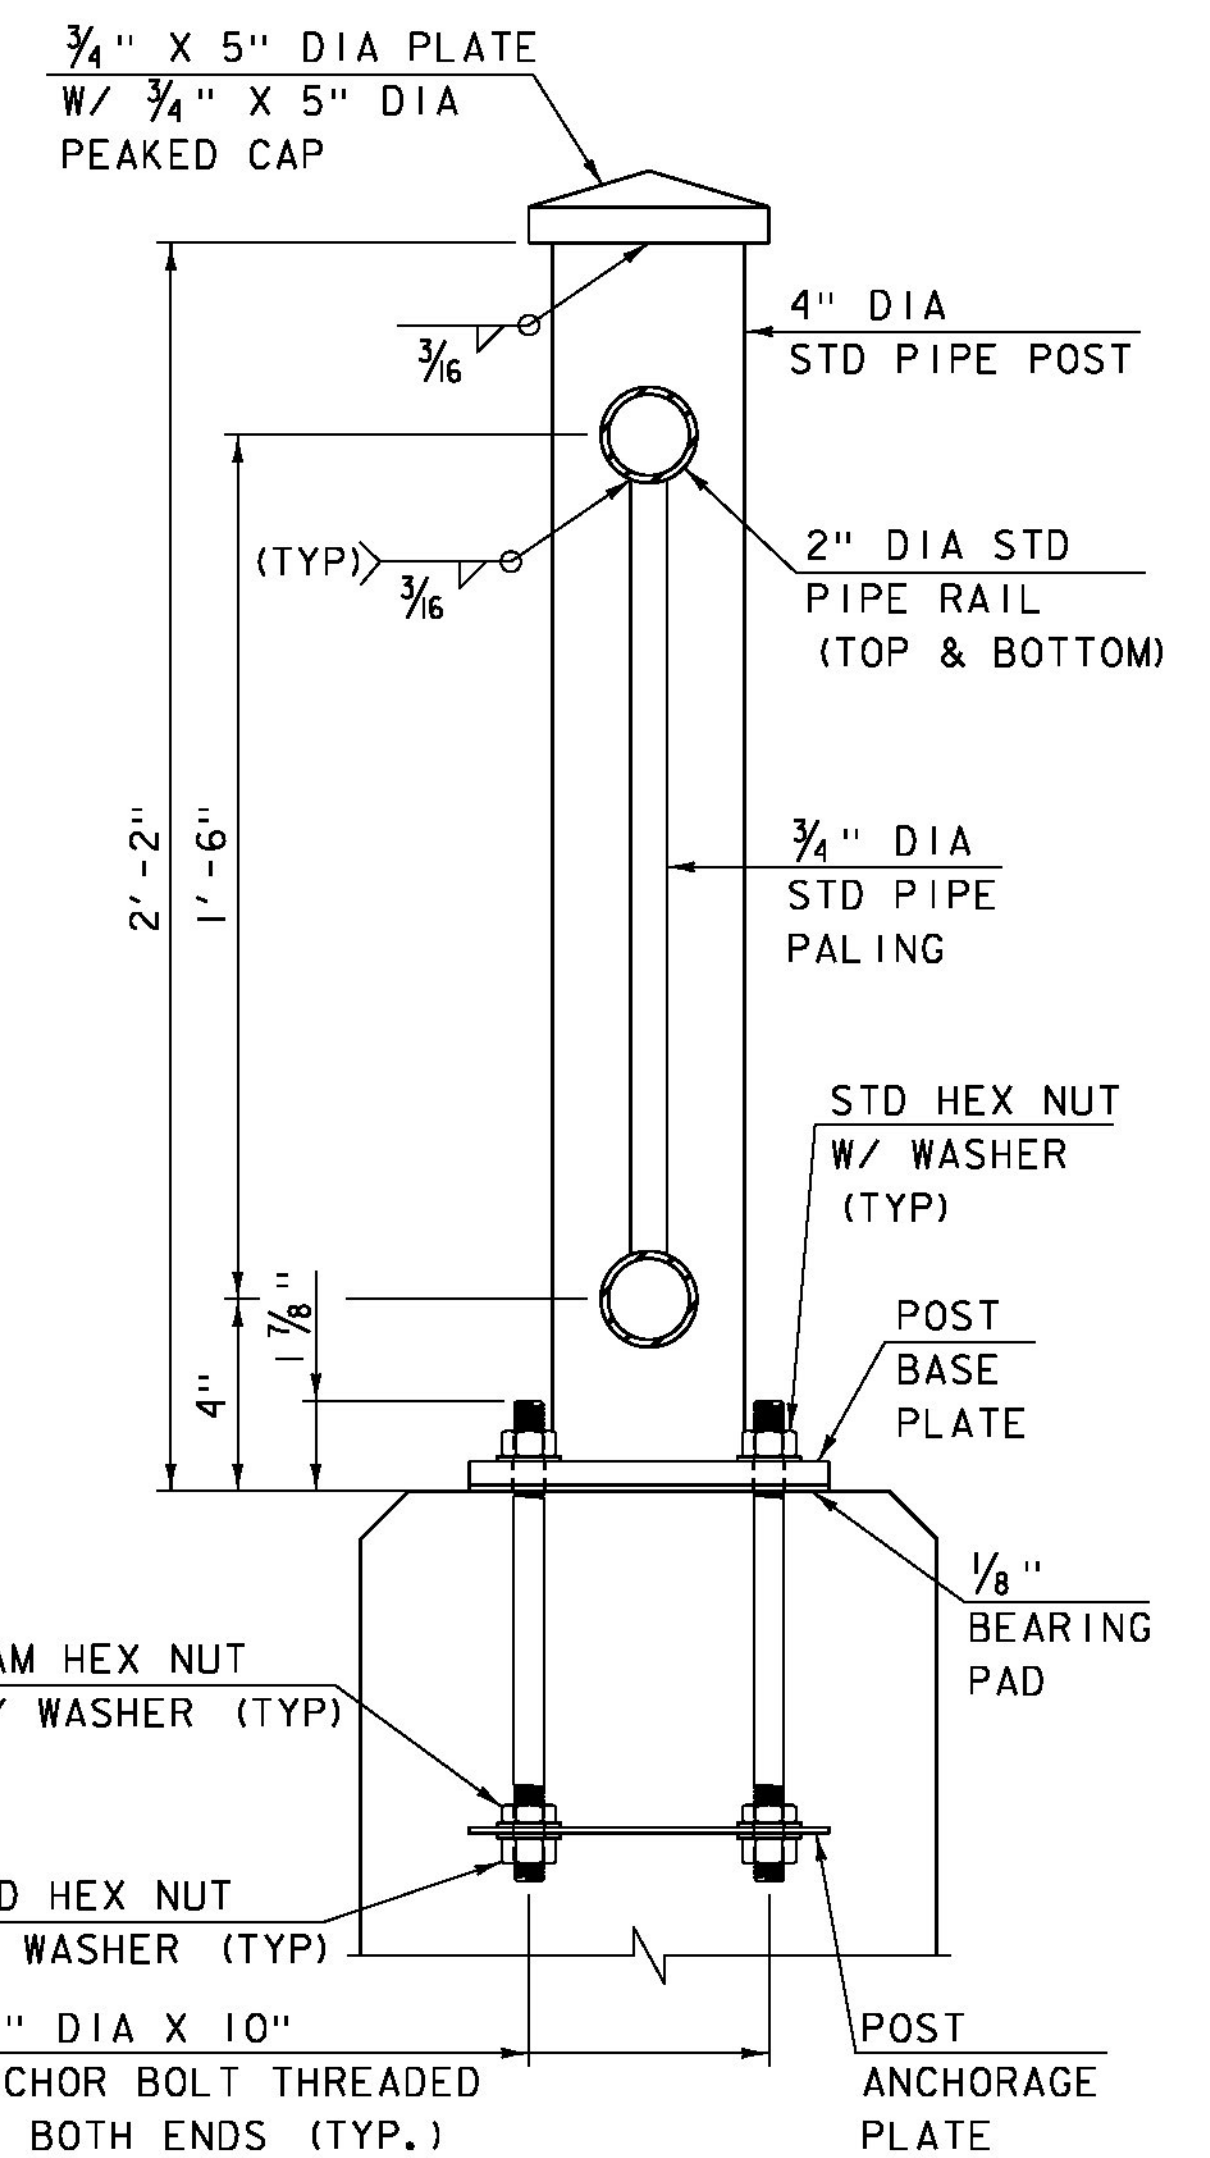


METAL RAILING DETAIL

SCALE: 3" = 1'-0"

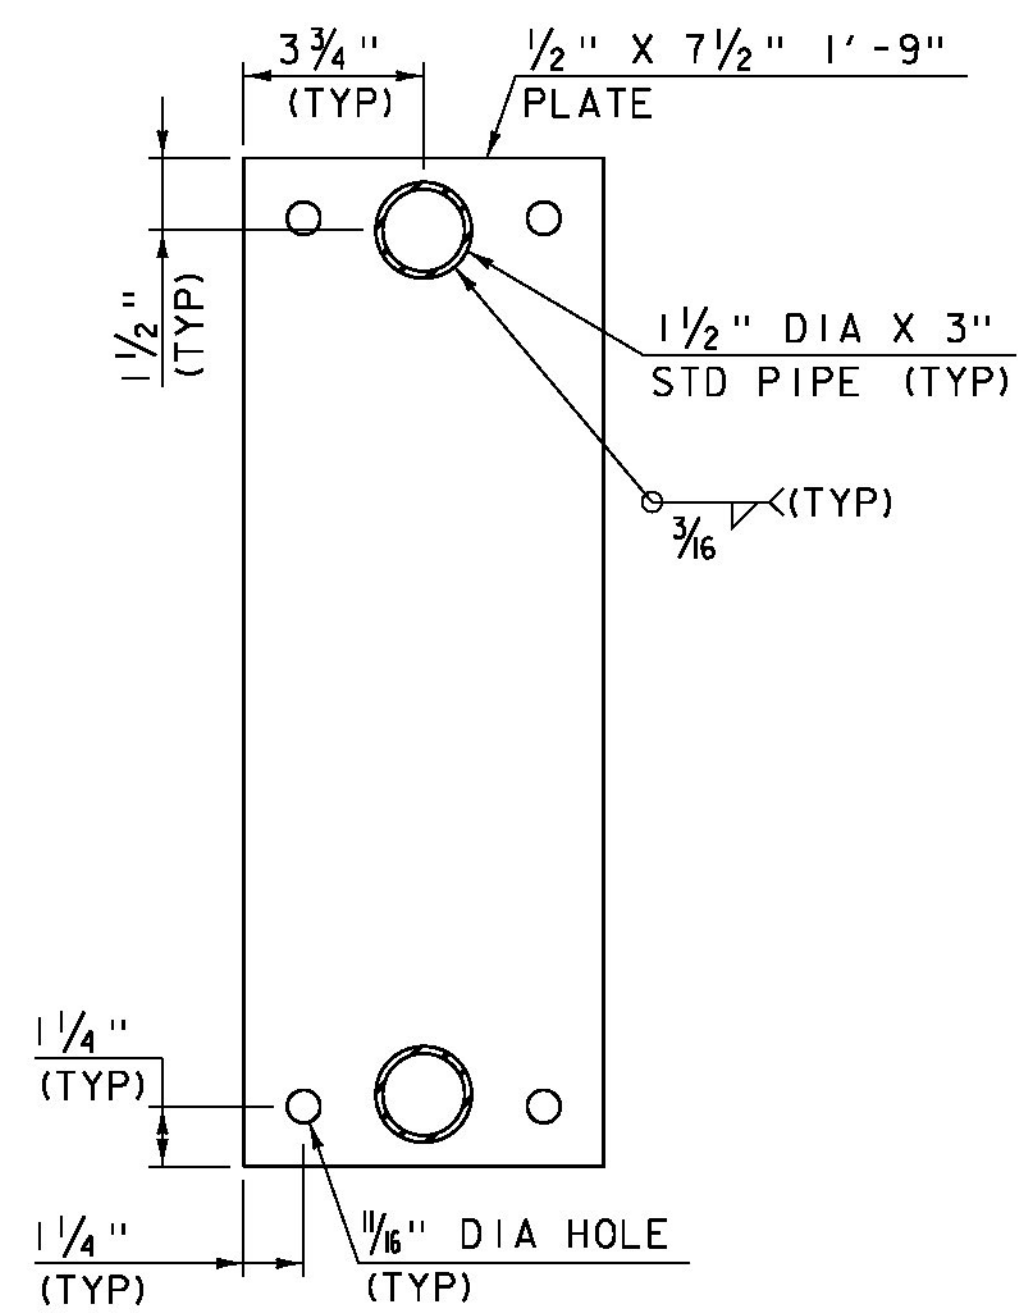


SIDE BASE PLATE

SCALE: 3" = 1'-0"

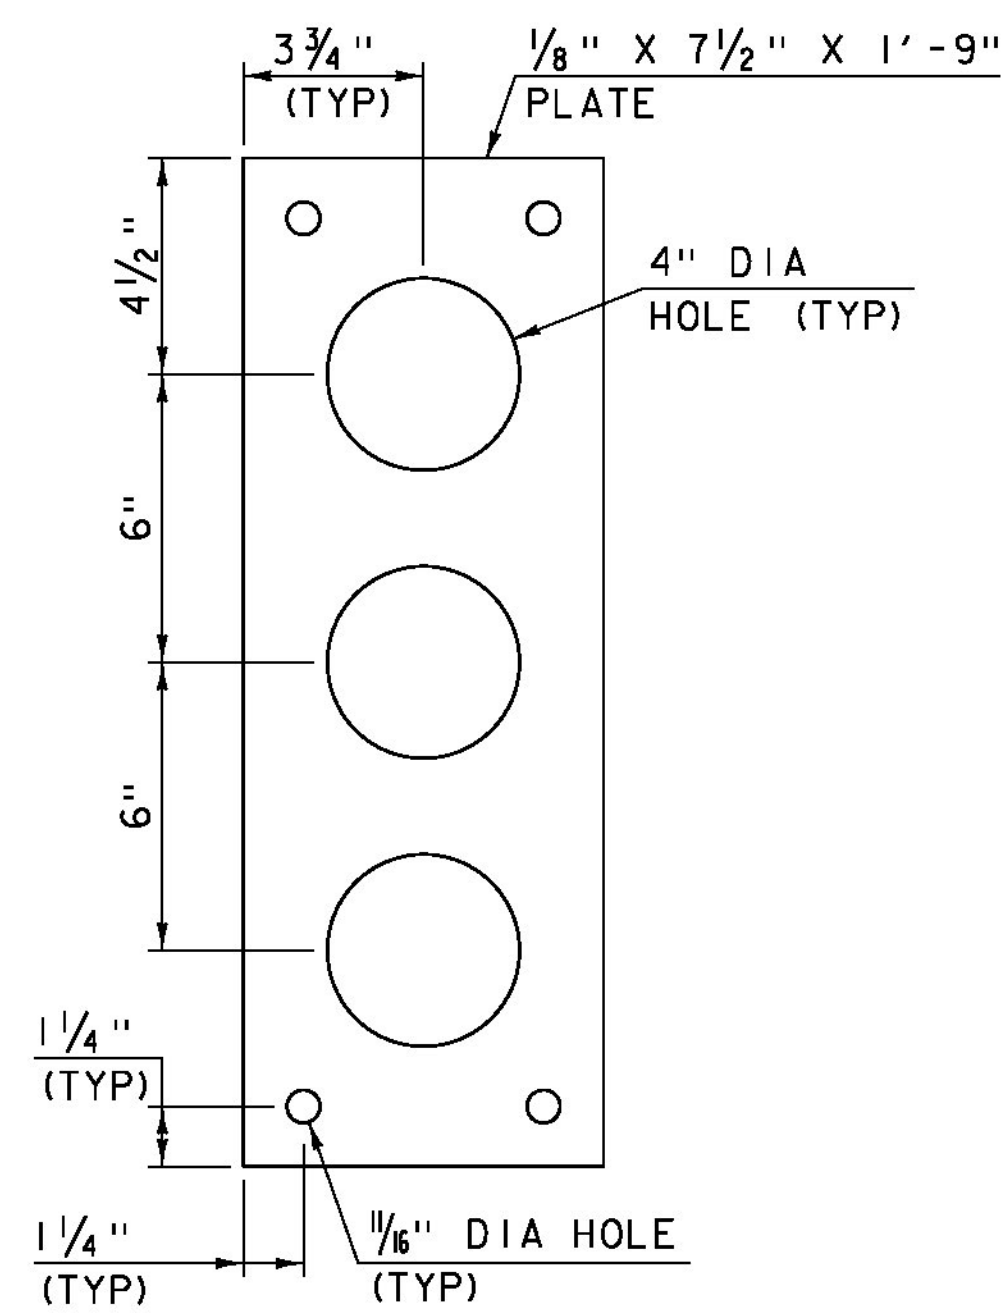

SIDE ANCHORAGE PLATE

SCALE: 3" = 1'-0"

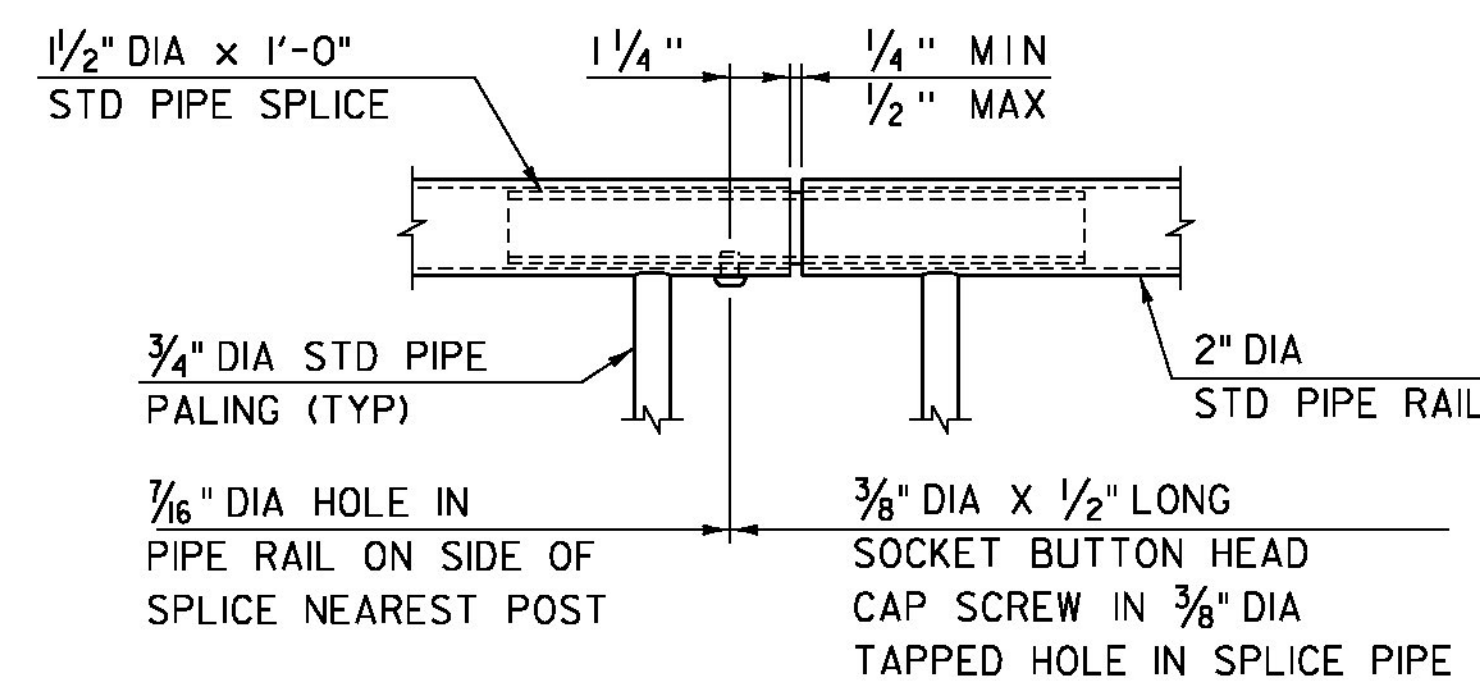

RAIL SPLICE DETAIL

SCALE: 3" = 1'-0"


MODEL: Sheet05
GLD 15-0223



PROJECT NAME: BRATTLEBORO
PROJECT NUMBER: BF 2000(26)

FILE NAME: z15j091rail_bdr-31.dgn
PROJECT LEADER: J. BYATT
DESIGNED BY: M. SMITH
BRIDGE RAIL DETAILS SHEET 4

PLOT DATE: 2/5/2016
DRAWN BY: M. SMITH
CHECKED BY: N. CARON
SHEET 22 OF 26

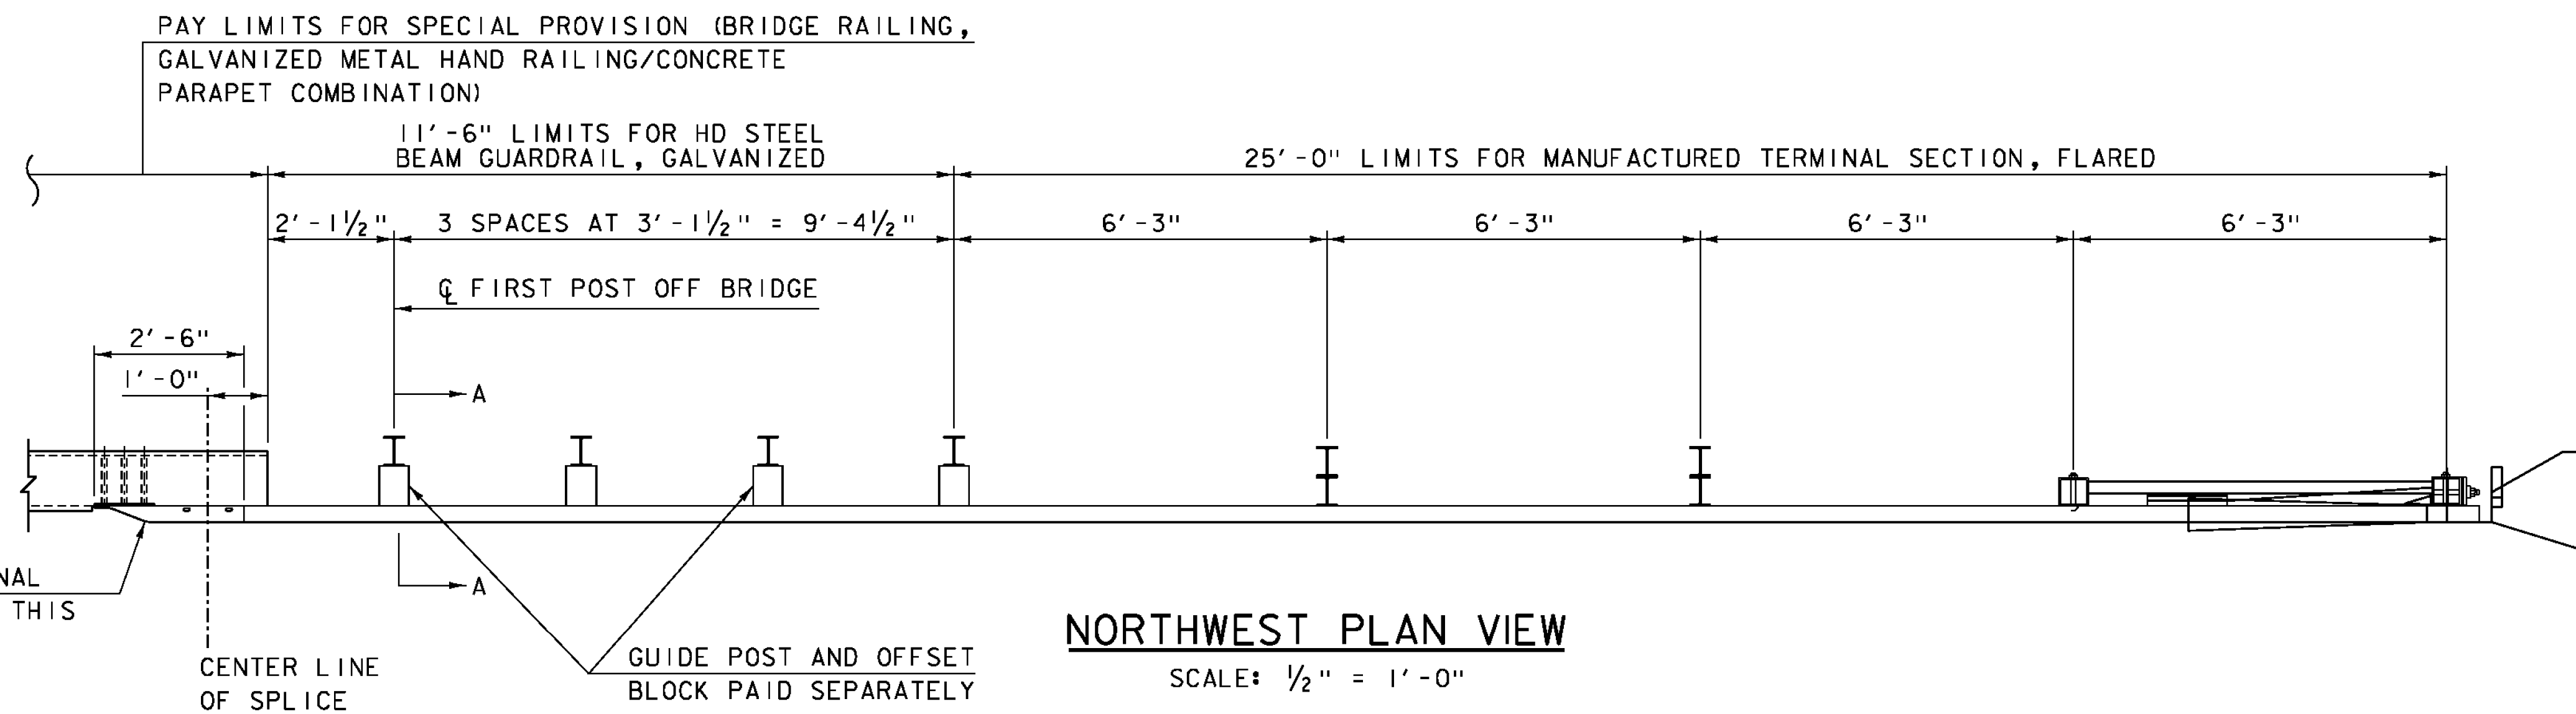


NORTHWEST PLAN VIEW

SCALE: 1/2" = 1'-0"


NOTES

1. A COMPOSITE MATERIAL POST AND/OR BLOCKOUT FROM THE APPROVED PRODUCTS LIST MAY BE SUBSTITUTED FOR A POST AND/OR BLOCKOUT OF SIMILAR DIMENSIONS.
2. REFER TO STANDARD DRAWINGS G-1 AND G-1d FOR ADDITIONAL DETAILS.
3. THE TERMINAL CONNECTOR TO BRIDGE RAIL AND THE CONNECTION PLATE SHALL BE INCLUDED IN THE BID PRICE FOR ITEM 900.640, "SPECIAL PROVISION (BRIDGE RAILING, GALVANIZED METAL HAND RAILING/CONCRETE PARAPET COMBINATION)".

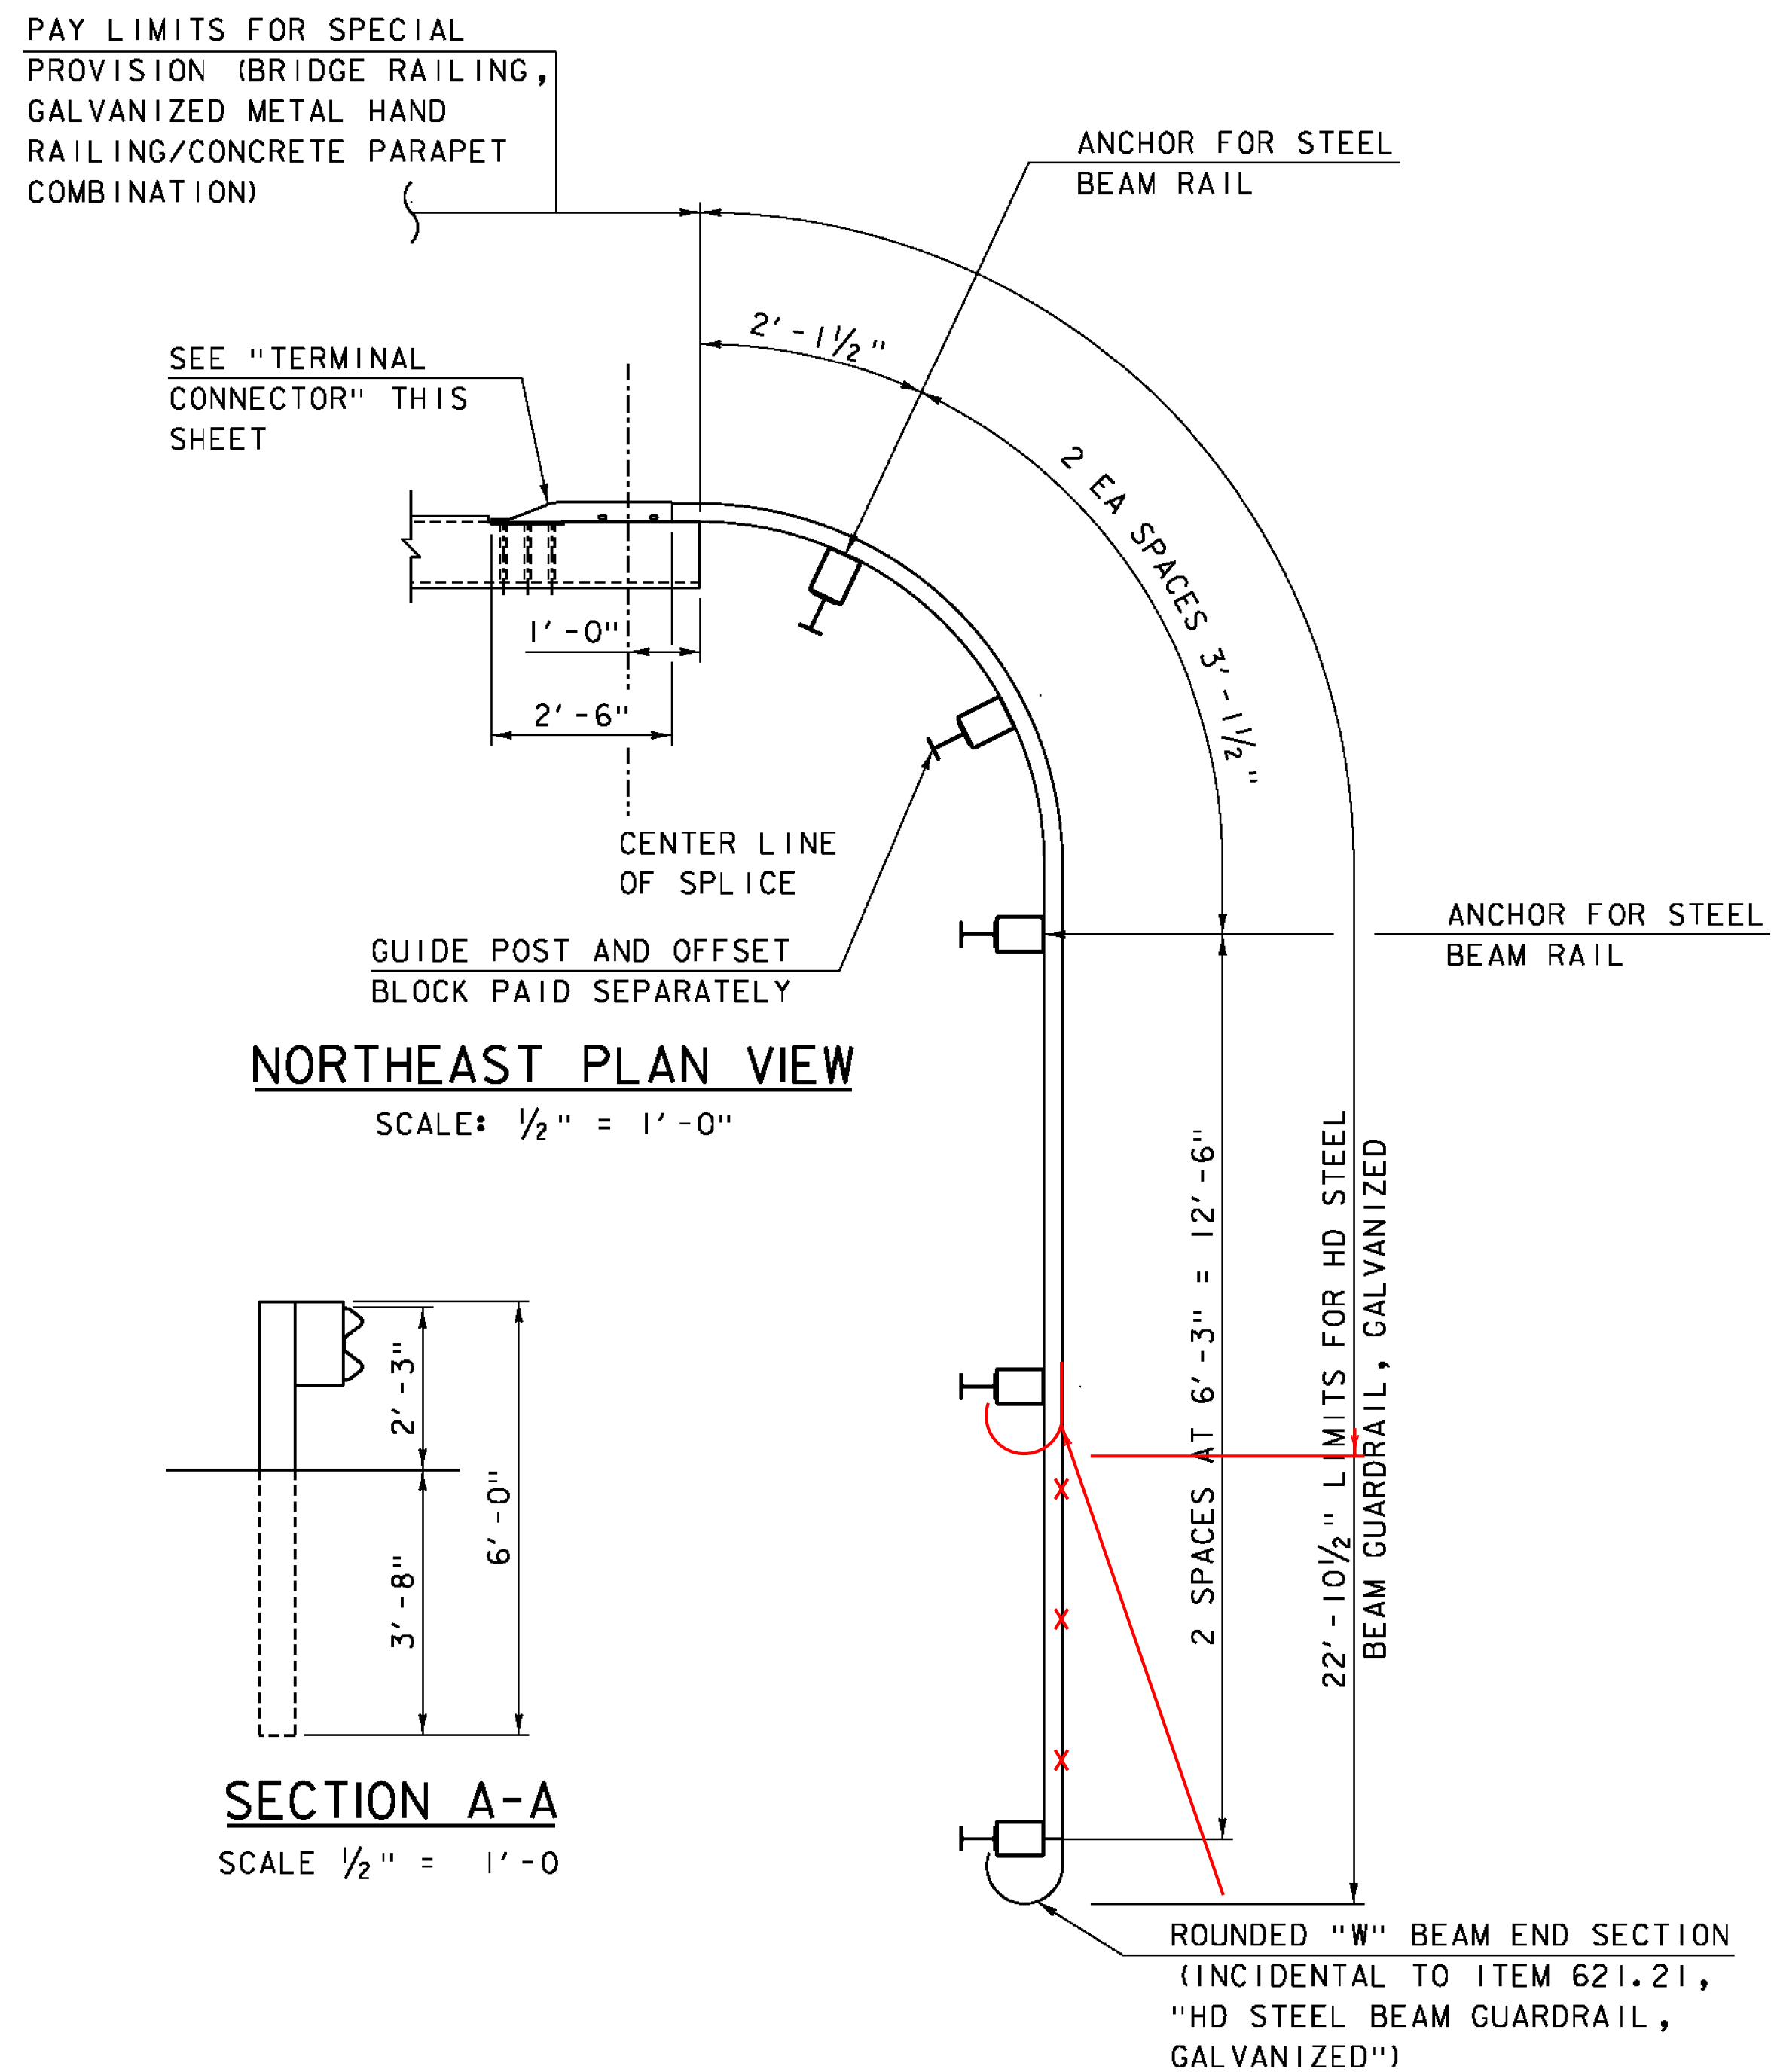


NORTHEAST PLAN VIEW

SCALE: 1/2" = 1'-0"

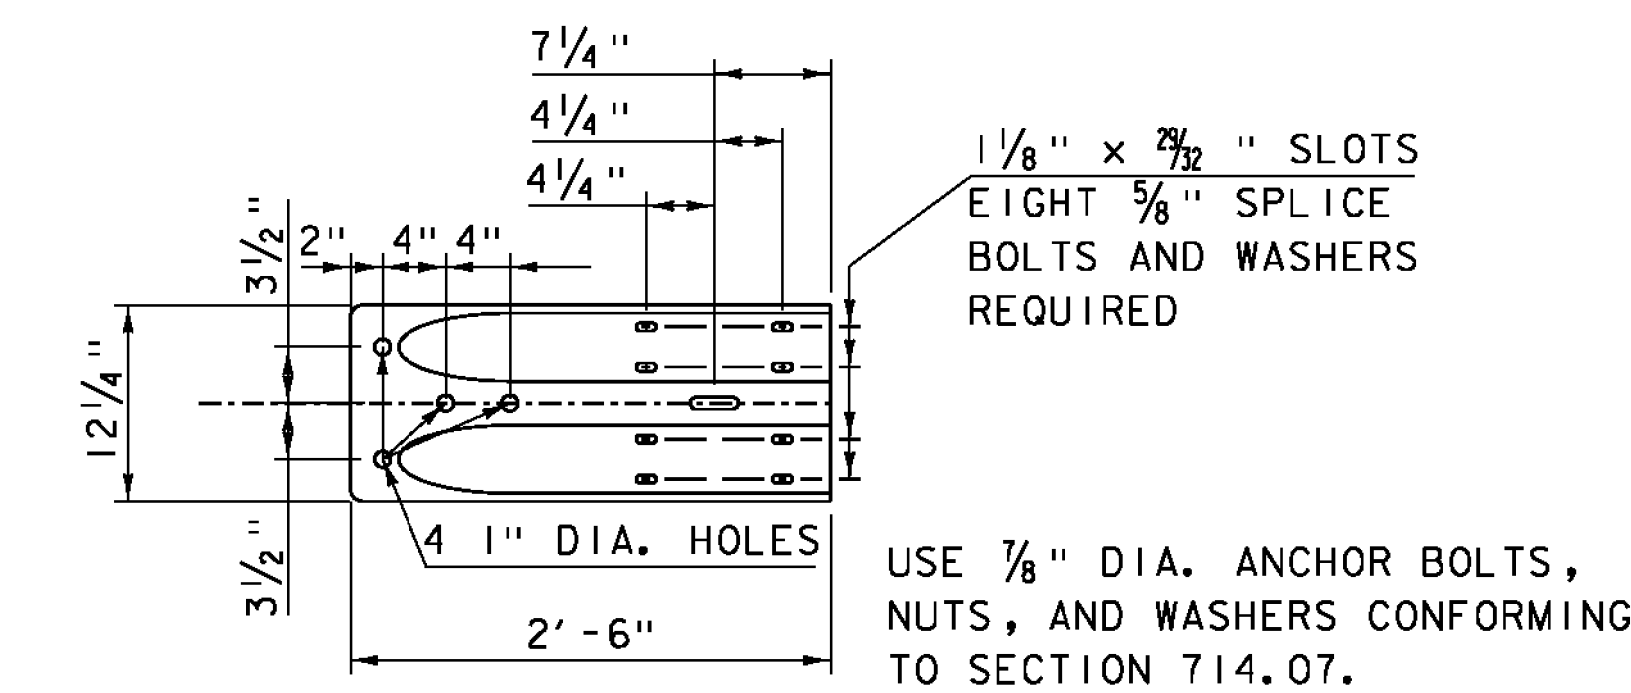


TERMINAL CONNECTOR ELEVATION

SCALE 1" = 1'-0"

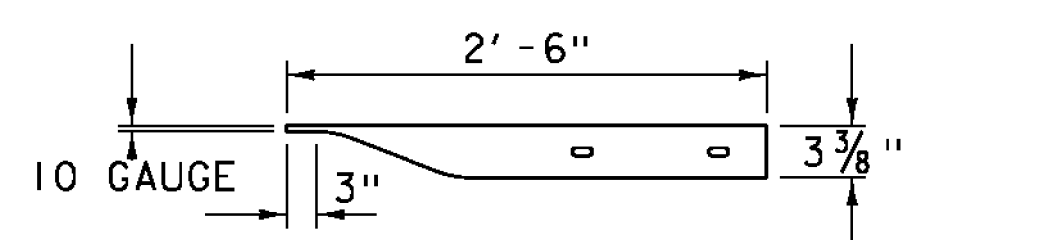


TERMINAL CONNECTOR PLAN

SCALE 1" = 1'-0"

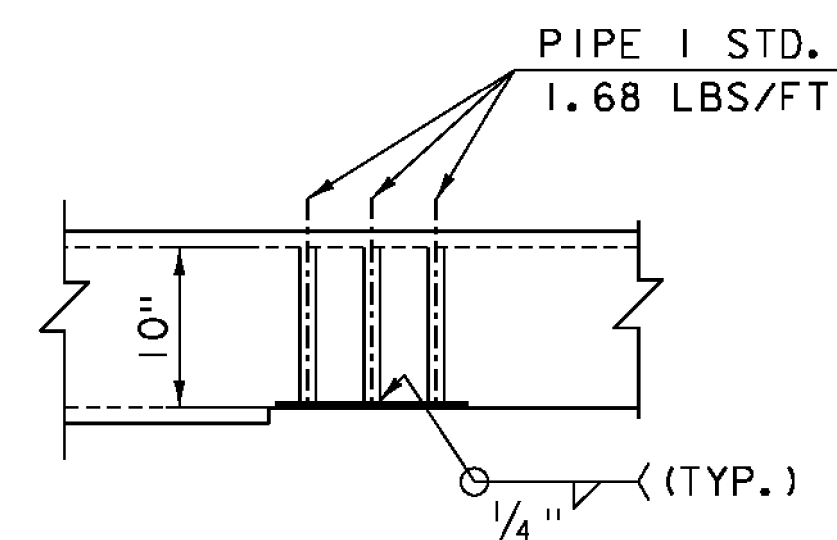


CONNECTION PLATE DETAIL - PLAN

SCALE 1" = 1'-0"

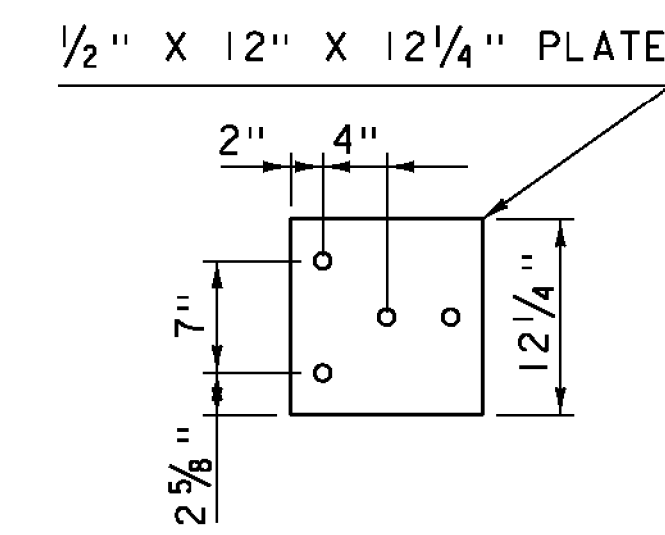

CONNECTION PLATE DETAIL - ELEVATION

SCALE 1" = 1'-0"

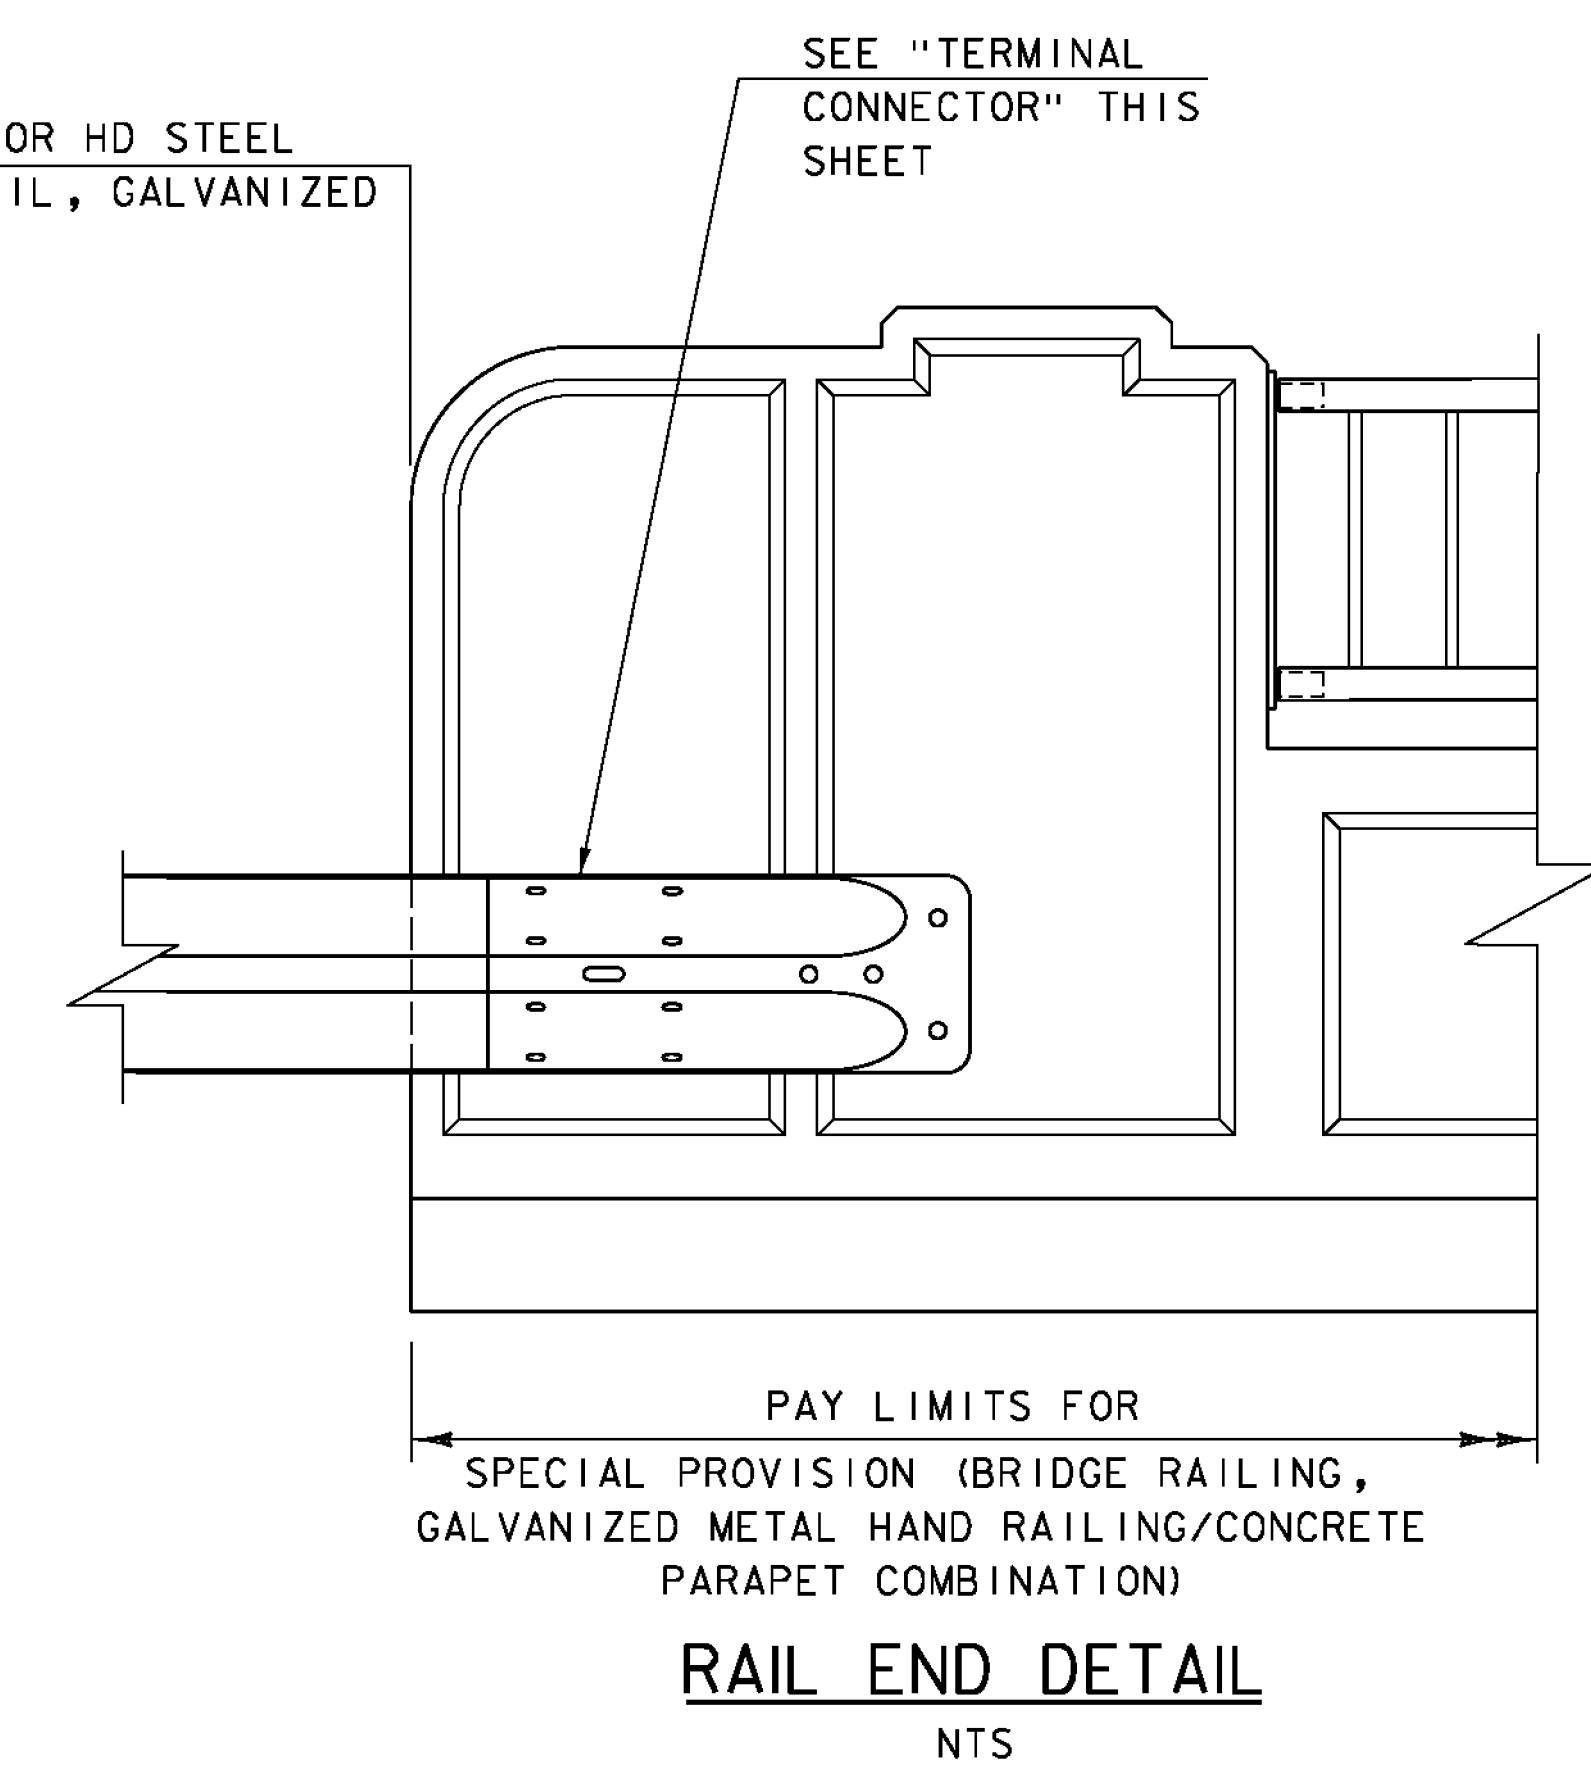

RAIL END DETAIL

NTS


THE USE OF THIS RAILING IS RESTRICTED TO DESIGN SPEEDS OF 45 MPH OR LESS.

PROJECT NAME: BRATTLEBORO
PROJECT NUMBER: BF 2000(26)

FILE NAME: z15j091rall_bdr-3l.dgn
PROJECT LEADER: J. BYATT
DESIGNED BY: N. CARON
APPROACH RAIL DETAILS SHEET


PLOT DATE: 2/5/2016
DRAWN BY: M. SMITH
CHECKED BY: S. BEAUMONT
SHEET 23 OF 26



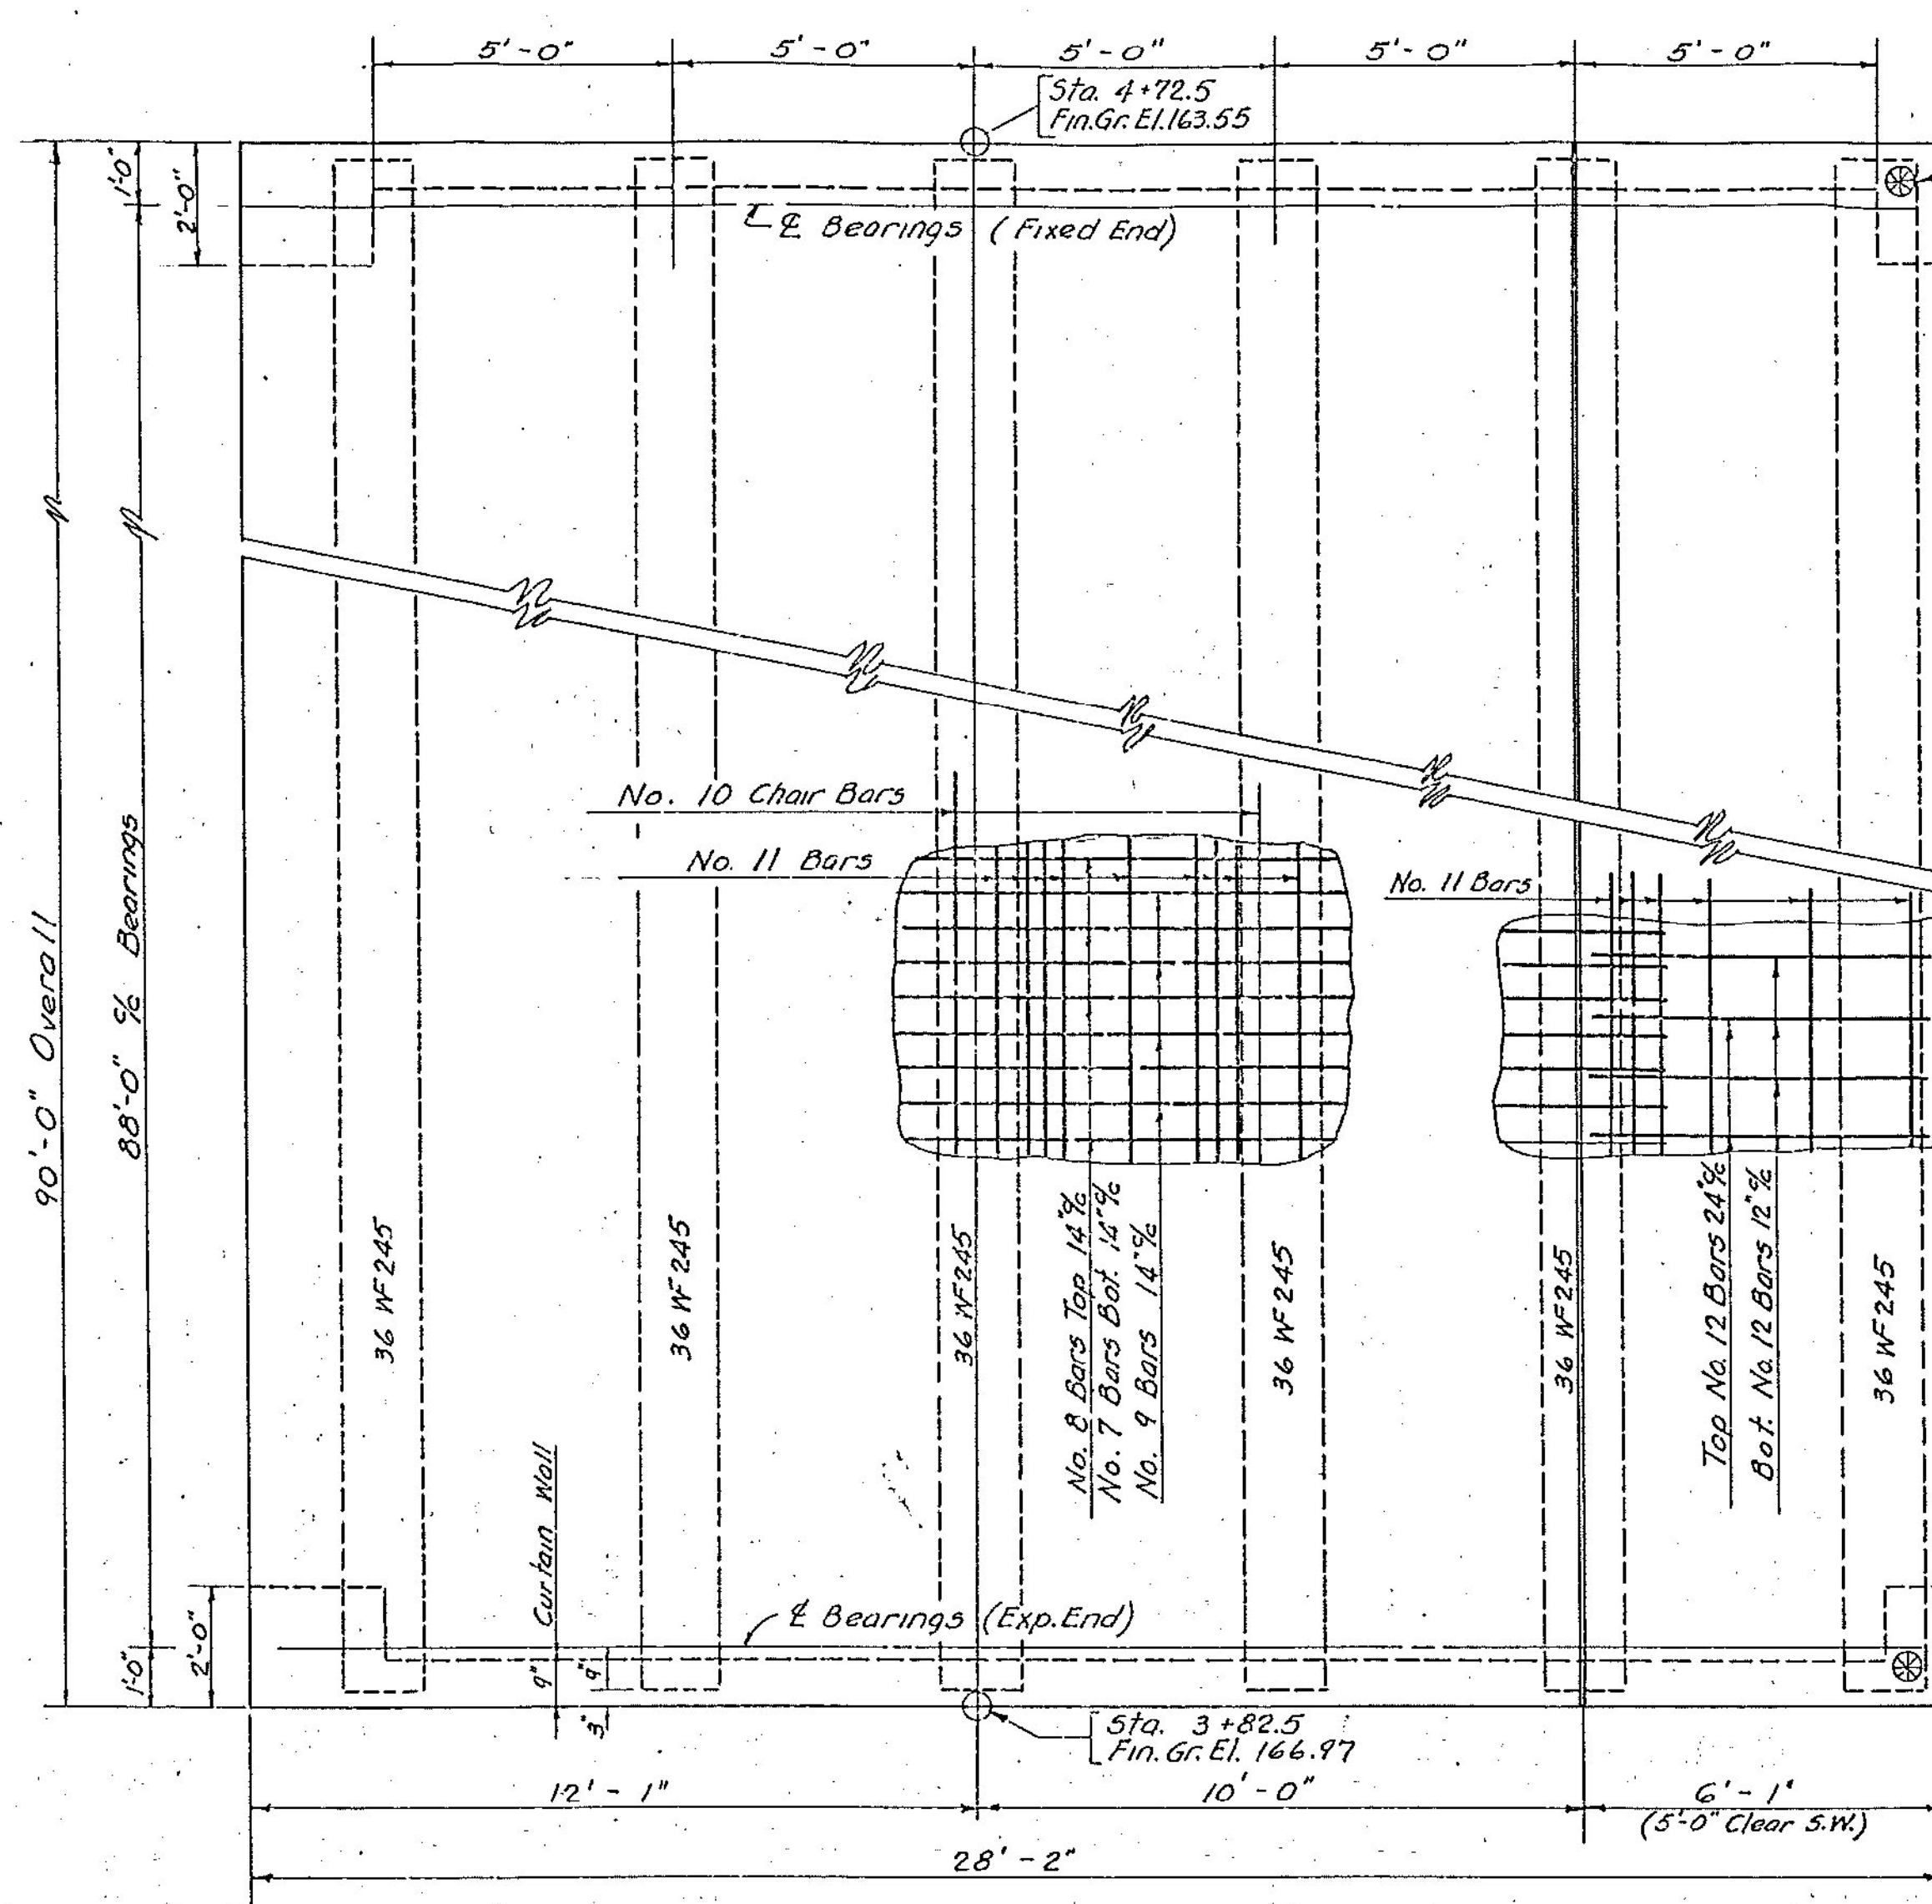


PLAN
scale: $\frac{3}{8}$ " = 1'-0"


Provide Conduit for lighting system in end posts of Bridge. See Std. 5B-20 Detail-M

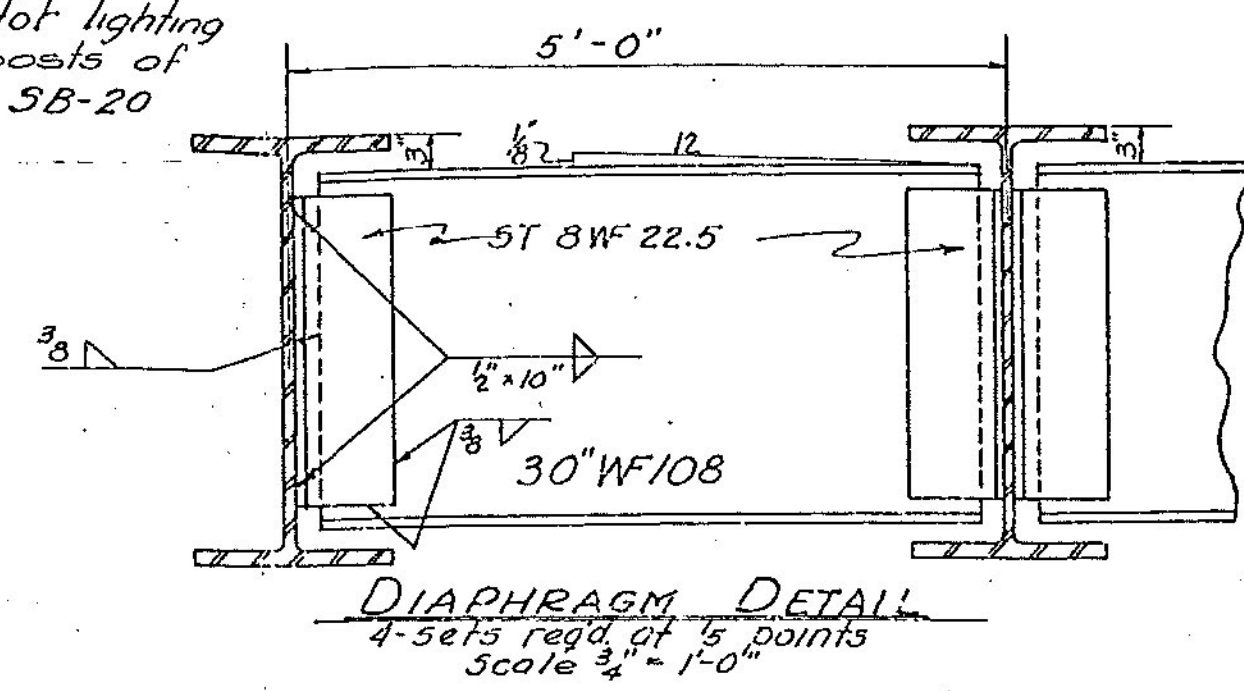

DIAPHRAGM DETAIL
4 sets reqd. at 5 points
scale: $\frac{3}{4}$ " = 1'-0"

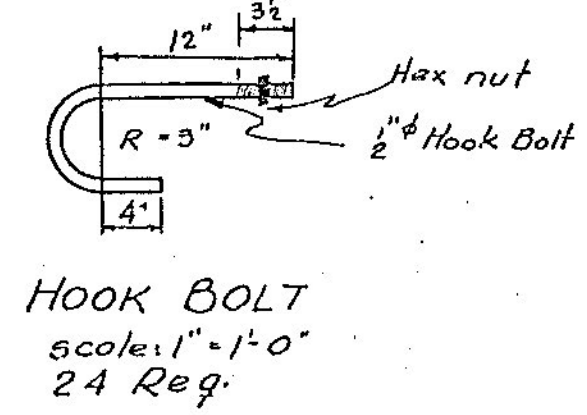


HOOK BOLT
scale: 1" = 1'-0"
24 Req.

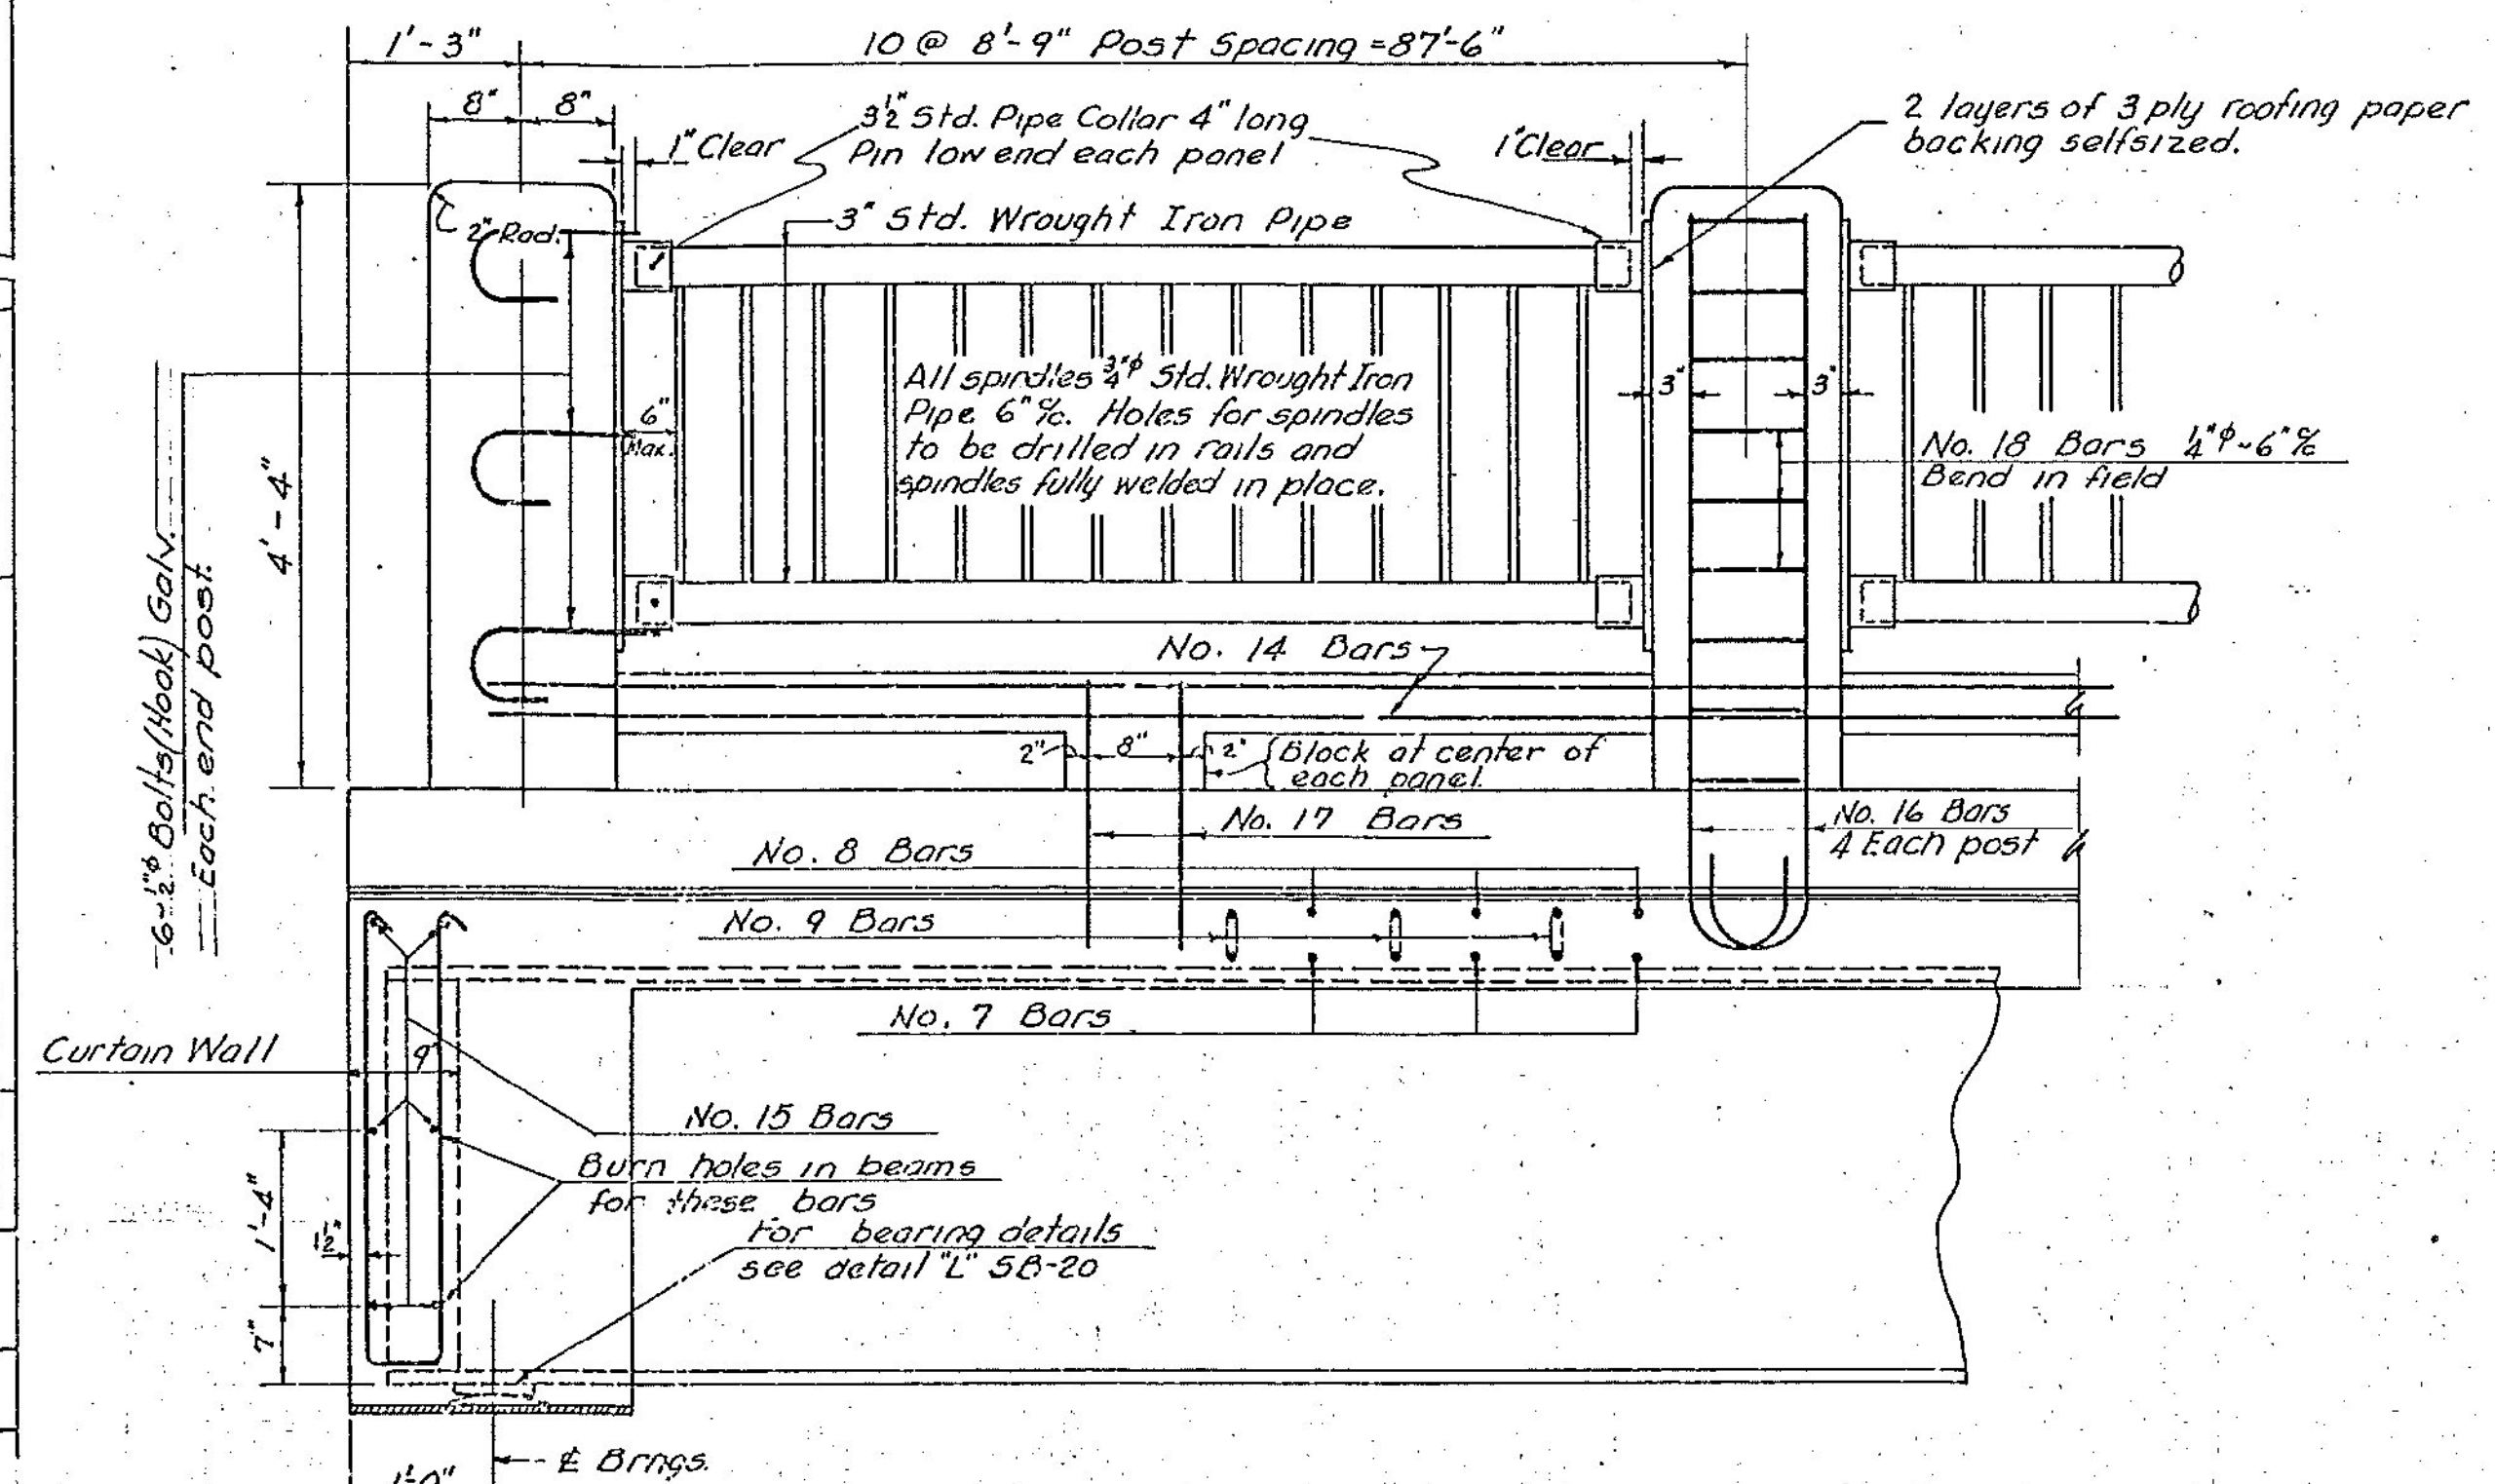


PART LONGITUDINAL SECTION
scale: $\frac{3}{4}$ " = 1'-0"

REINFORCING STEEL SCHEDULE				
BAR NO.	SIZE	TOTAL REQD.	OVERALL LGTH.	DETAIL
7	5/8"	78	23'-4"	straight
8	5/8"	78	24'-8"	
9	5/8"	77	25'-8"	
10	3/4"	15	31'-9"	straight
11	1/2"	156	31'-3"	"
12	5/8"	135	7'-3"	
13	3/8"	34	7'-0"	
13A	3/8"	8	8'-6"	
14	3/4"	24	31'-4"	straight
15	5/8"	12	27'-6"	straight
16	1"	88	6'-5"	
17	1/2"	40	4'-10"	
18	1/4"	198	3'-6"	straight-Bend to fit in field

GENERAL NOTES:
Beams shall be rolled to a true circular camber, the full length of the beam. Middle ordinate for camber $3\frac{1}{2}$ ".
All Structural Steel shall be painted as specified under item 43-B of Pamphlet "E", Standard Road & Bridge Specifications, State of Vermont, 1936. Final coat shall be green.
All material & construction shall conform to the Standard Road & Bridge Specifications, State of Vermont, 1936 & A.A.S.H.O. Specifications of 1944.
Designed for H-15(44) live loading & 25" paving allowance.

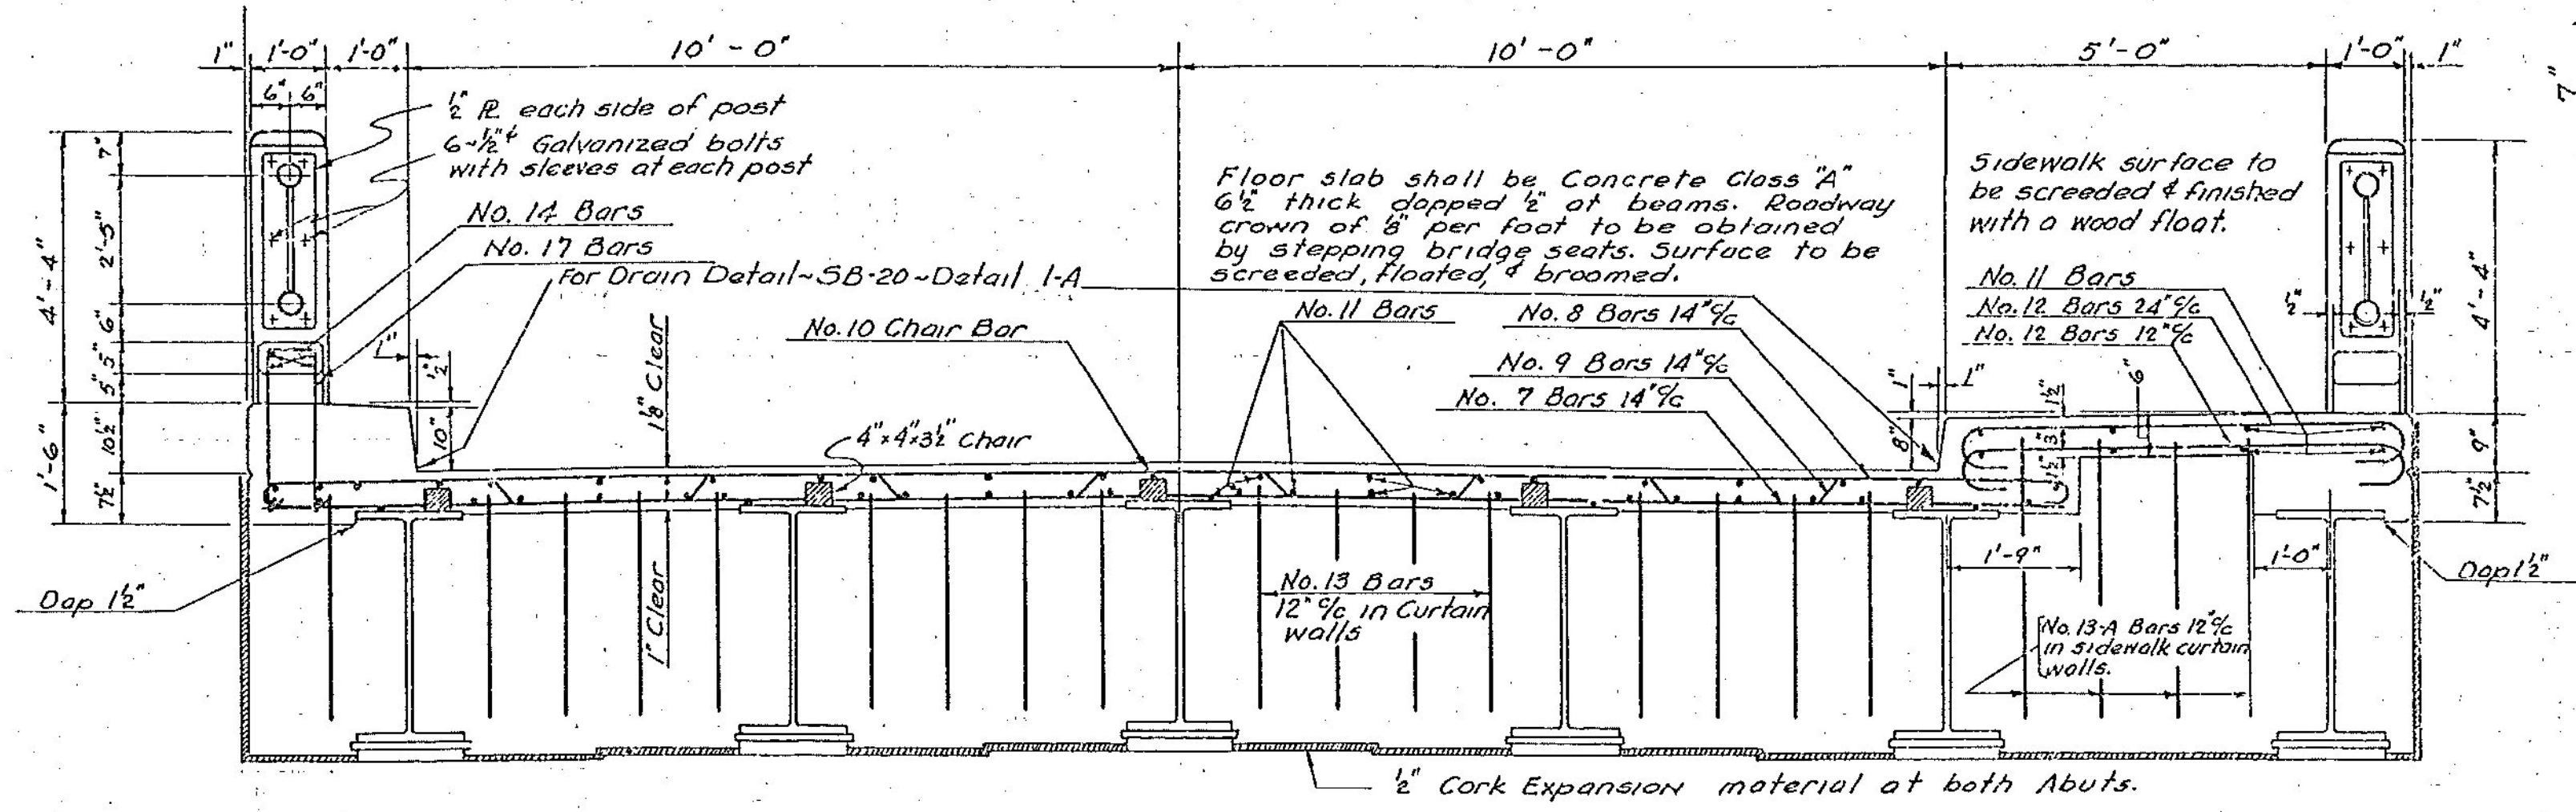

CROSS SECTION OF BRIDGE
scale: $\frac{1}{2}$ " = 1'-0"

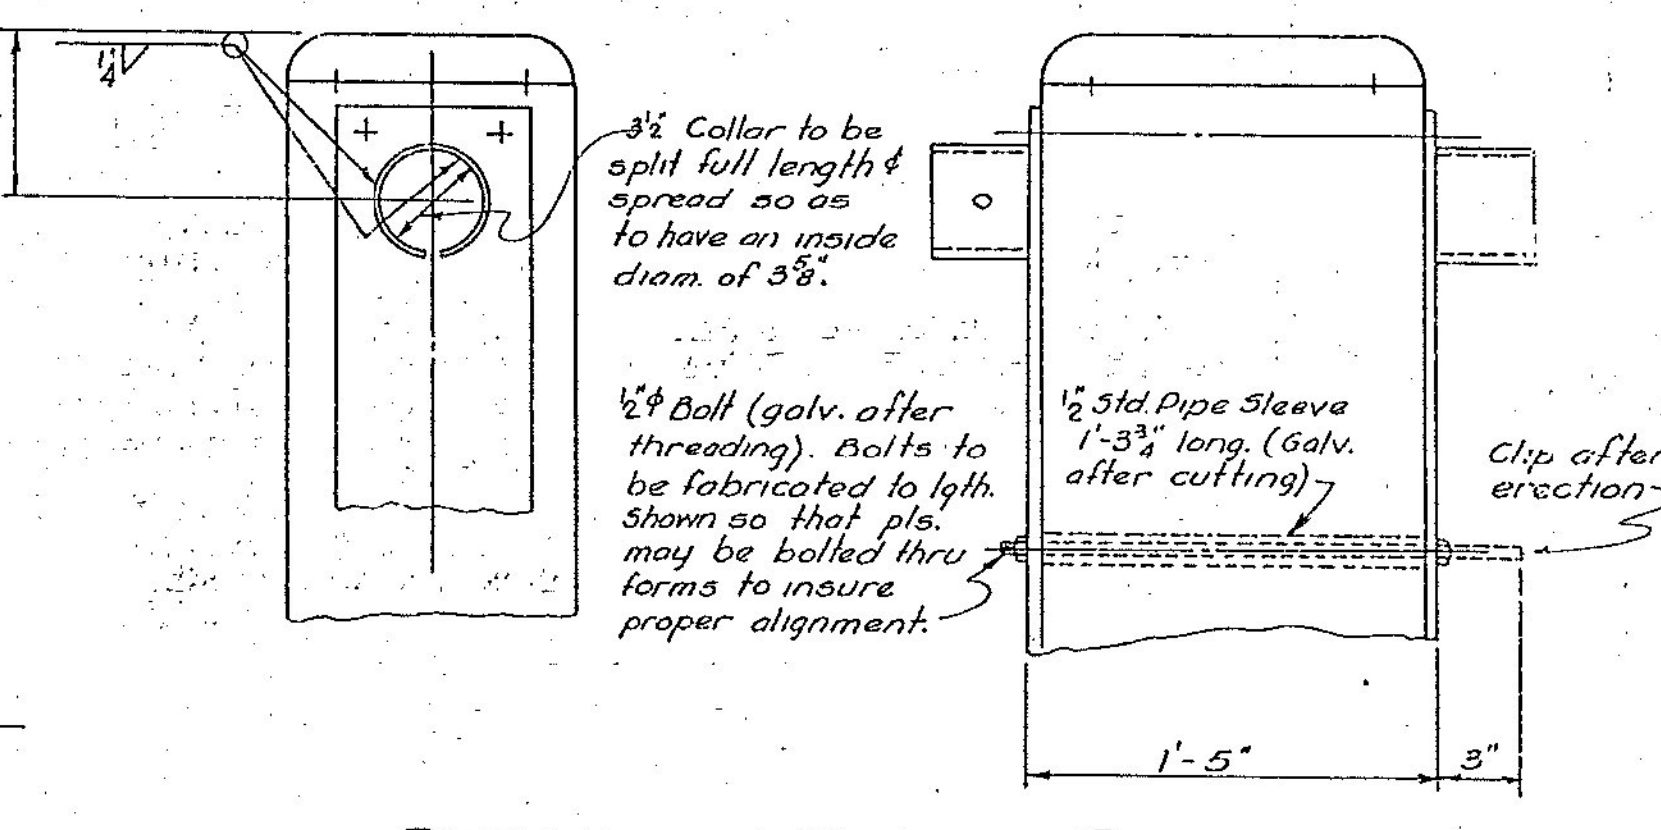

DETAIL OF TOP OF POSTS
scale: $\frac{1}{2}$ " = 1'-0"

SUPERSTRUCTURE DETAILS
ELLIOT STREET BRIDGE
BRATTLEBORO, VT.
scales as noted

BRATTLEBORO
BF 2000(26)
BRIDGE NO. 31
SHEET 26 OF 26
FOR REFERENCE ONLY


ESTIMATED QUANTITIES

Conc. Class "A"	79 cu.
Reinforcing Steel	14,300 lbs.
Steel Superstructure	150,500 lbs.
Conduit for Lighting System	1 LS.

Surveyed by	E.F.P.
Designed by	E.F.P.
Drawn by	H.W.S.
Traced by	L.M.D.
Checked by	L.M.D.
Series	T-7 No. 1946
Filed	
Sheet 3 of 11 Sheets	


CONCRETE GENERAL NOTES

1. ALL EXPOSED EDGES OF CONCRETE SHALL BE CHAMFERED 1" x 1"
2. REINFORCING STEEL SIZE AND SPACING SHOWN IN THE PLANS IS BASED ON 60 KSI STEEL, UNLESS NOTED OTHERWISE. WITH THE ENGINEER'S PERMISSION, BAR SIZE AND SPACING MAY BE MODIFIED ACCORDING TO THE LATEST AASHTO LRFD BRIDGE DESIGN SPECIFICATION AND STRUCTURES DESIGN MANUAL WHEN USING HIGHER STRENGTH STEEL.

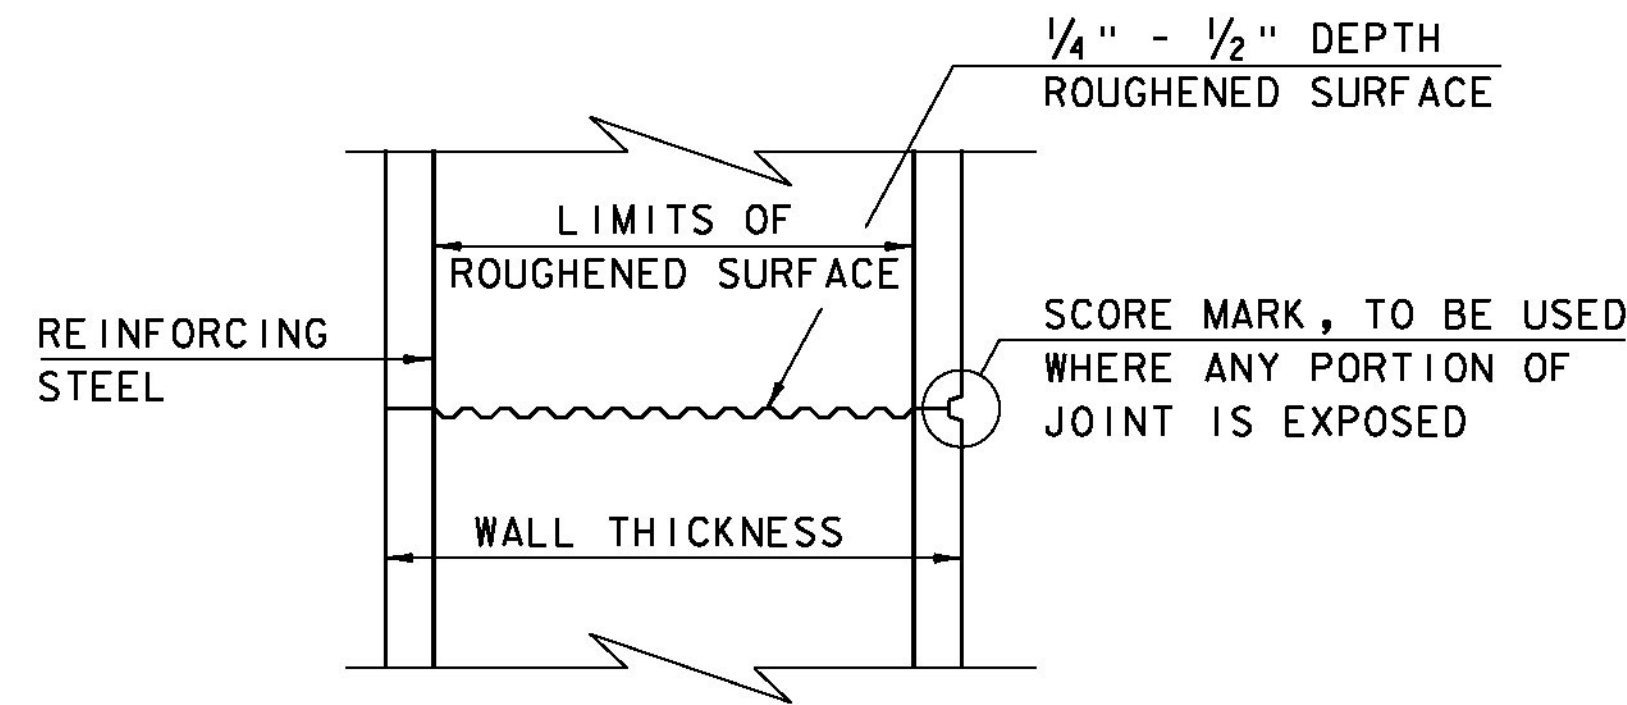


TYPICAL HORIZONTAL CONSTRUCTION JOINT
(NOT TO SCALE)


1. THE SURFACE OF THE CONCRETE CONSTRUCTION JOINTS SHALL BE CLEANED AND FREE OF LAITANCE.
2. IMMEDIATELY BEFORE NEW CONCRETE IS PLACED, ALL CONSTRUCTION JOINTS SHALL BE WETTED AND STANDING WATER REMOVED.

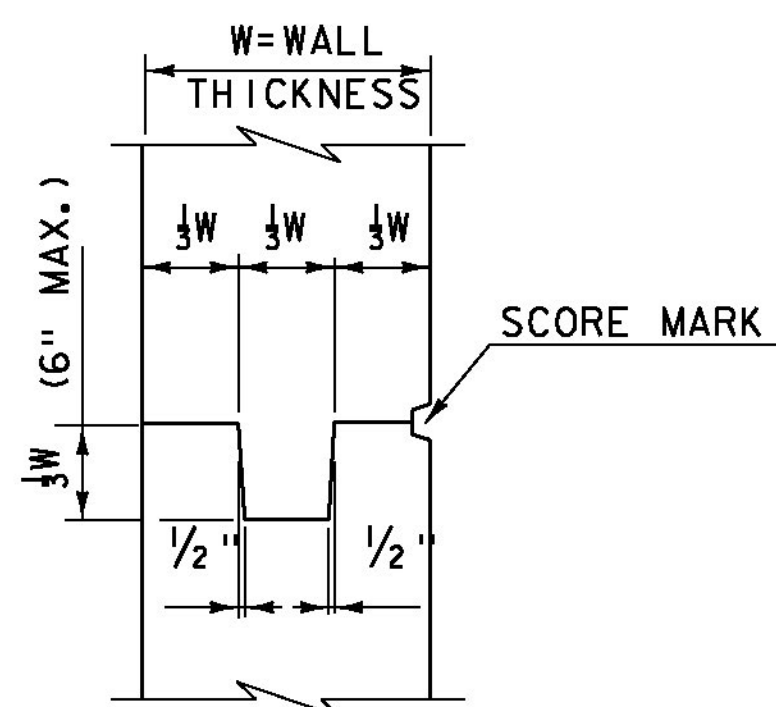


TYPICAL CONCRETE CONSTRUCTION JOINT
(NOT TO SCALE)

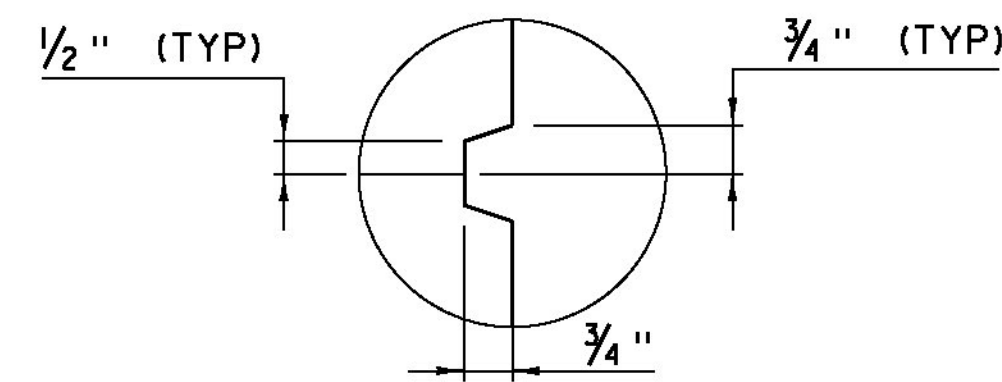

SCORE MARK DETAIL
(NOT TO SCALE)

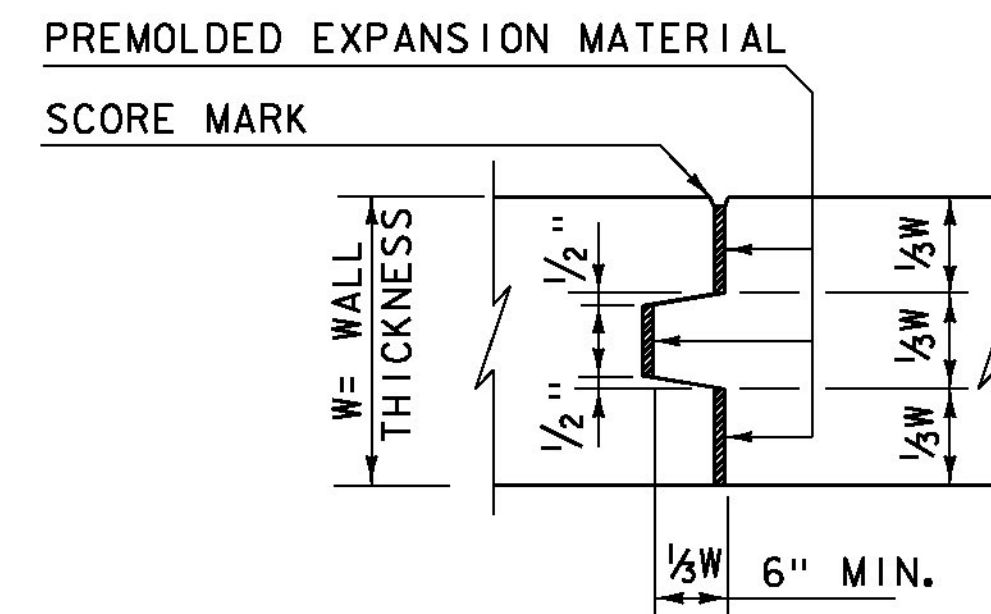

TYPICAL CONCRETE EXPANSION JOINT
(NOT TO SCALE)

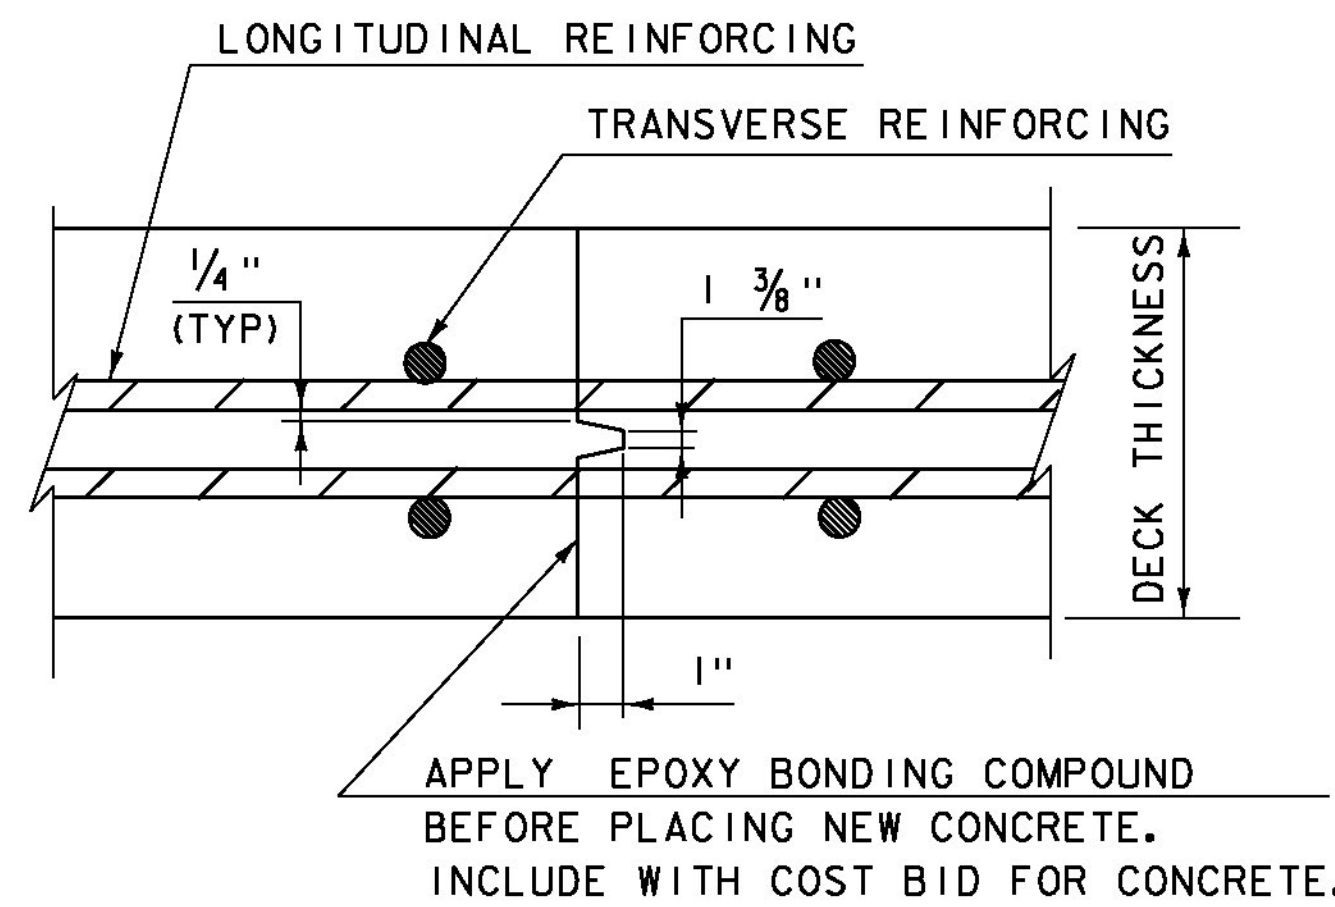


TRANSVERSE BRIDGE SLAB CONSTRUCTION JOINT DETAILS
(NOT TO SCALE)



P.V.C. WATERSTOP FOR CONSTRUCTION JOINTS
(NOT TO SCALE)

PAYMENT FOR THE P.V.C. WATERSTOP SHALL BE INCIDENTAL TO THE UNIT BID PRICE FOR THE ADJACENT CONCRETE.


OTHER CONFIGURATIONS OF WATERSTOP MAY BE USED UPON APPROVAL OF THE ENGINEER.

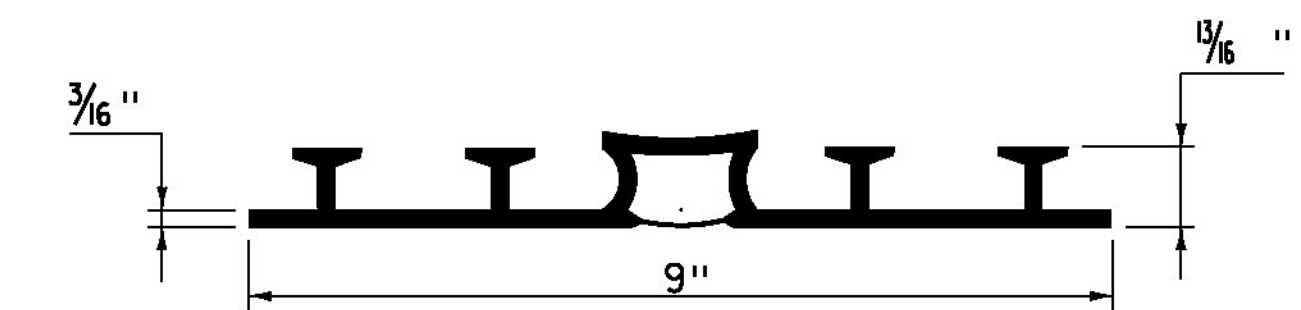

P.V.C. WATERSTOP FOR EXPANSION JOINTS
(NOT TO SCALE)

PAYMENT FOR THE P.V.C. WATERSTOP SHALL BE INCIDENTAL TO THE UNIT BID PRICE FOR THE ADJACENT CONCRETE.


OTHER CONFIGURATIONS OF WATERSTOP MAY BE USED UPON APPROVAL OF THE ENGINEER.

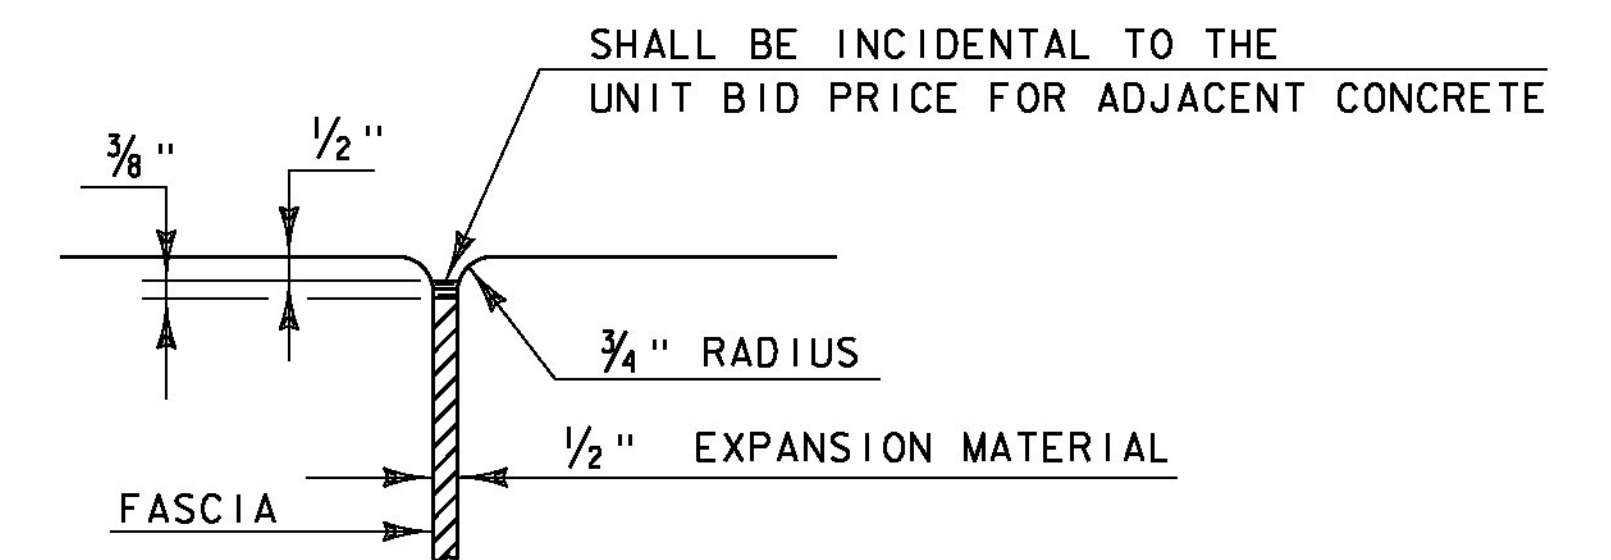


JOINT BETWEEN FASCIA AND WINGWALL
(NOT TO SCALE)

REVISIONS	
MAY 7, 2010	APPROVED FOR USE BY VAOT STRUCTURES SECTION
FEBRUARY 9, 2012	REBAR SUBSTITUTION ALLOWANCE ADDED TO CONCRETE GENERAL NOTES.


**CONCRETE
DETAILS AND NOTES**

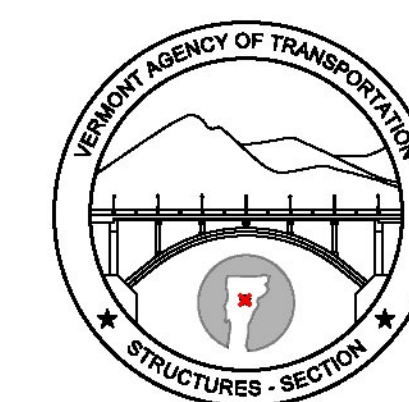


**STRUCTURES
DETAIL
SD-501.00**

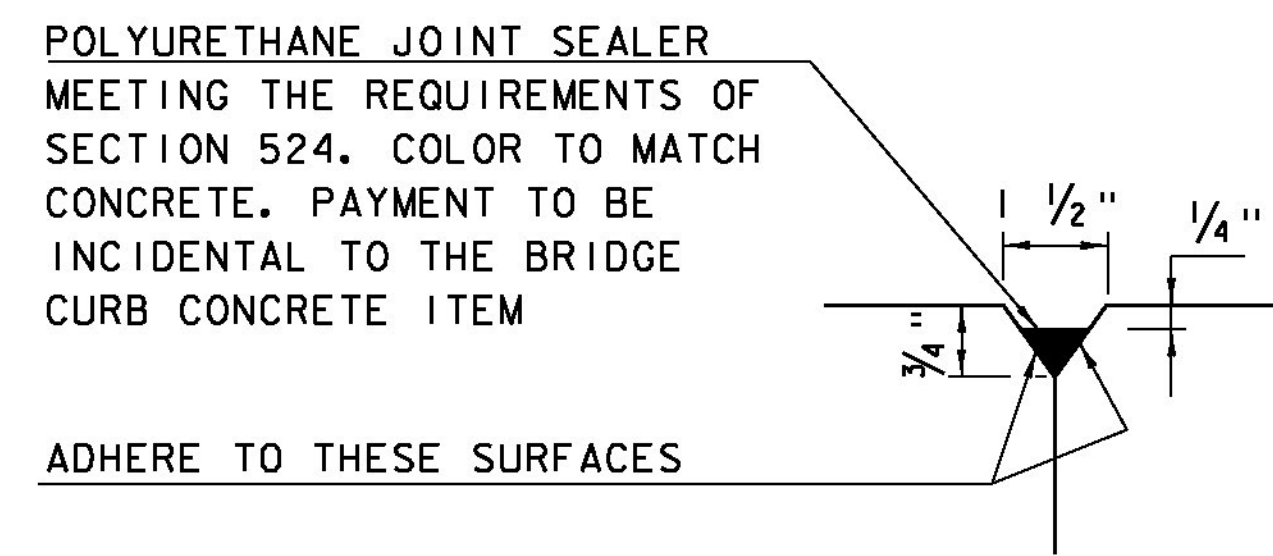


DETAIL "B"
(NOT TO SCALE)

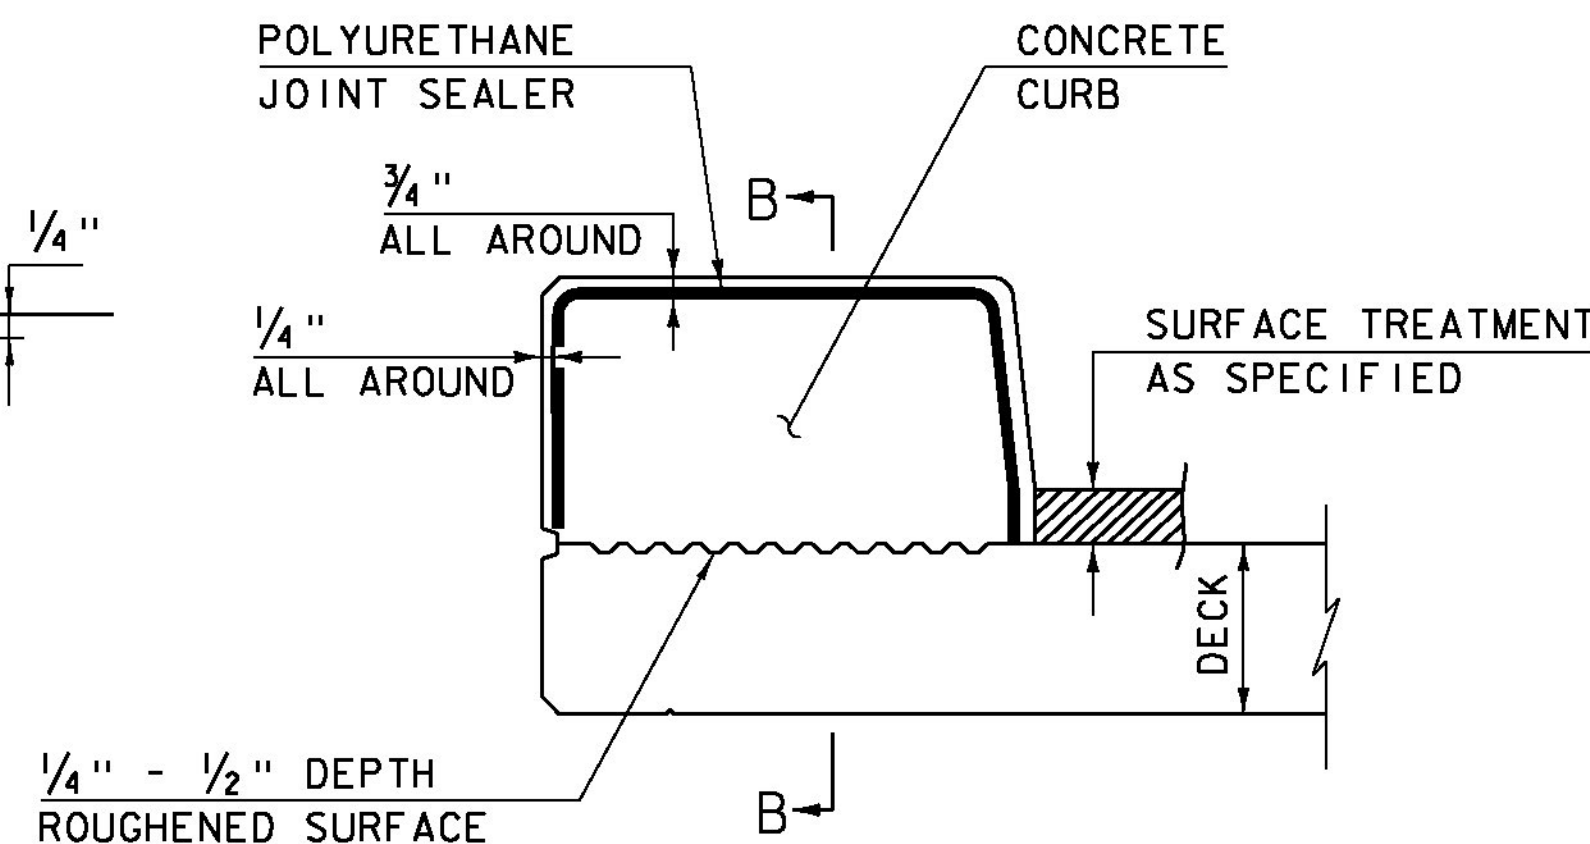

CONCRETE CURB JOINT SECTION
(NOT TO SCALE)

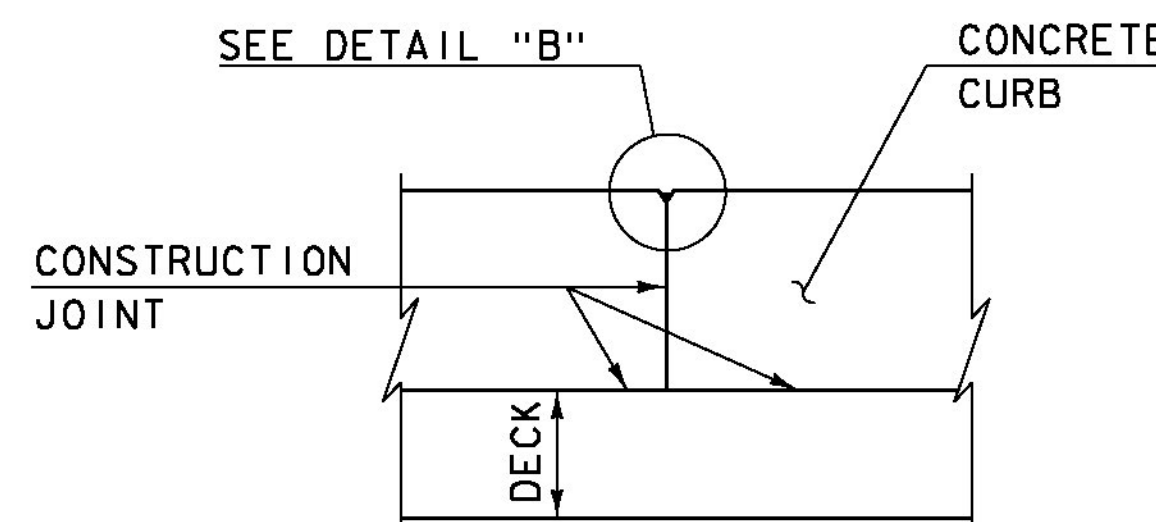


SECTION B - B
(NOT TO SCALE)

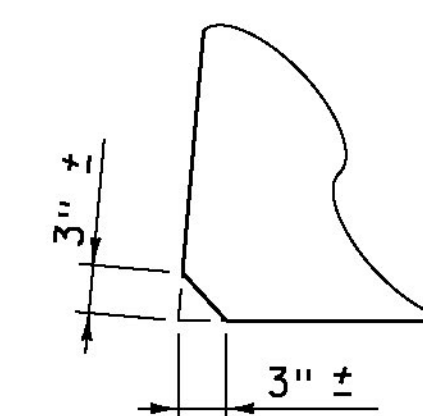


ACUTE ANGLE
CLIP DETAIL
(NOT TO SCALE)



- SEE TYPICAL HORIZONTAL CONSTRUCTION JOINT DETAIL FOR ADDITIONAL INFORMATION

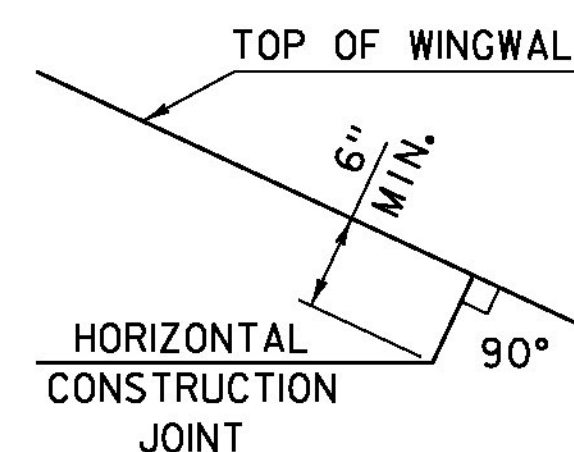

HORIZONTAL WINGWALL
CONSTRUCTION JOINT
(NOT TO SCALE)

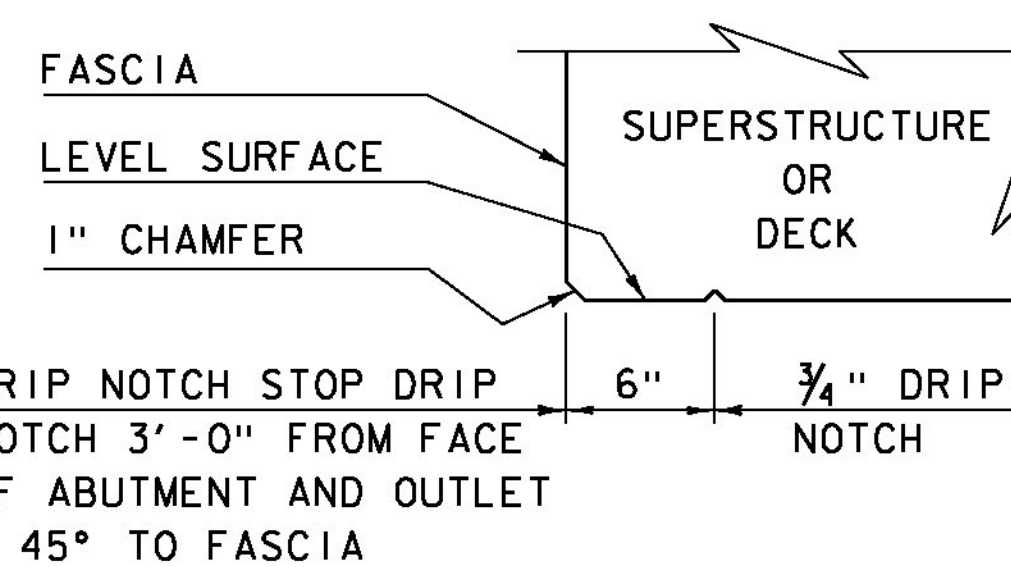

DRIP NOTCH DETAIL
(NOT TO SCALE)

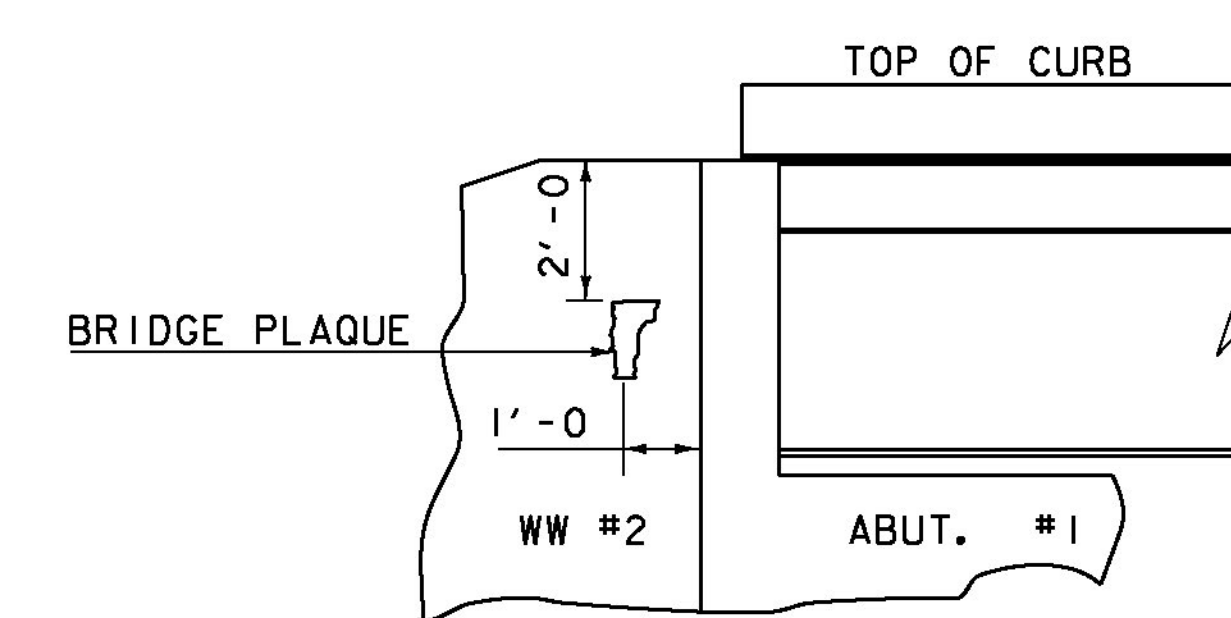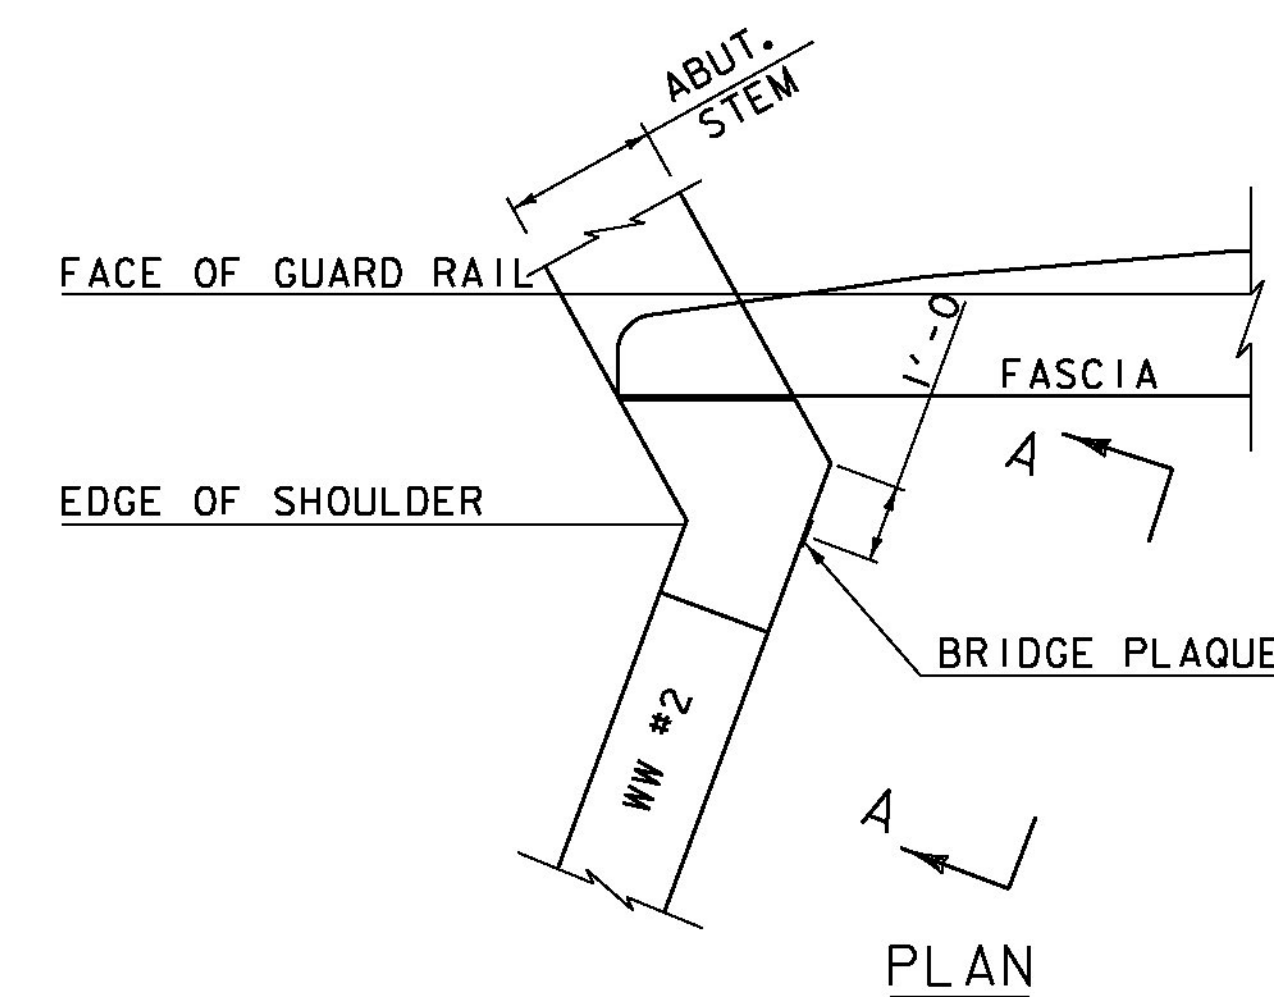

THE BRIDGE PLAQUE WILL BE SUPPLIED BY THE AGENCY OF TRANSPORTATION AND SHALL BE INSTALLED BY THE CONTRACTOR AT ABUTMENT #1 ON THE RIGHT SIDE AS SHOWN OR AS DIRECTED BY THE ENGINEER.

PAYMENT FOR INSTALLATION OF THE BRIDGE PLAQUE SHALL BE INCIDENTAL TO THE ADJACENT CONCRETE.


CONCRETE CURB JOINT NOTES

- CONCRETE CURBS MAY BE PLACED IN ONE CONTINUOUS OPERATION IF AN APPROVED SHRINKAGE REDUCING ADMIXTURE LISTED IN THE SPECIAL PROVISIONS IS USED WITH THE CONCRETE MIX DESIGN. PAYMENT FOR THE SHRINKAGE REDUCING ADMIXTURE WILL BE INCIDENTAL TO THE BRIDGE CURB CONCRETE ITEM.
- IF THE CONTRACTOR CHOOSES NOT TO USE AN APPROVED SHRINKAGE REDUCING ADMIXTURE, THE CURBS SHALL BE CONSTRUCTED WITH CONSTRUCTION JOINTS SPACED AT A MAXIMUM OF 15'-0" CENTER TO CENTER AND 2'-0" MINIMUM FROM THE CENTER OF NEAREST BRIDGE RAILING POST.
- ON MULTI-SPAN CONTINUOUS SUPERSTRUCTURES, REGARDLESS OF WHETHER APPROVED SHRINKAGE REDUCING ADMIXTURE IS USED, CURB JOINTS SHALL BE LOCATED OVER THE CENTERLINE OF PIERS AND 7'-0" EACH SIDE OF THE CENTERLINE OF EACH PIER.
- WHEN CURB JOINTS ARE USED THE CURBS SHALL BE PLACED IN ALTERNATE SECTIONS WITH A MINIMUM OF 48 HOUR DELAY BETWEEN ADJACENT PLACEMENTS.
- LONGITUDINAL REINFORCING SHALL BE CONTINUOUS THROUGH CURB CONSTRUCTION JOINTS. CURB STIRRUP BARS SHALL BE TURNED AS NECESSARY TO MAINTAIN COVER IN THE FLARED CURB ENDS.
- THE JOINT SPACING AND DETAILS SHOWN SHALL APPLY TO SIDEWALKS WHEN SHOWN IN THE PLANS.


REVISIONS

MAY 7, 2010	APPROVED FOR USE BY VAOT STRUCTURES SECTION
JUNE 4, 2010	MODIFIED AND ADDED TWO DETAILS
OCTOBER 10, 2012	MODIFIED HORZ. JOINT WINGWALL ADD 6" MIN. DIMENSION

CONCRETE DETAILS AND NOTES

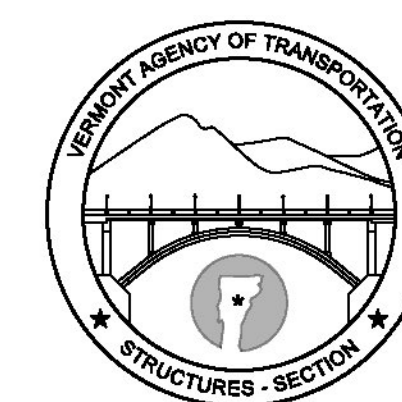


STRUCTURES
DETAIL
SD-502.00

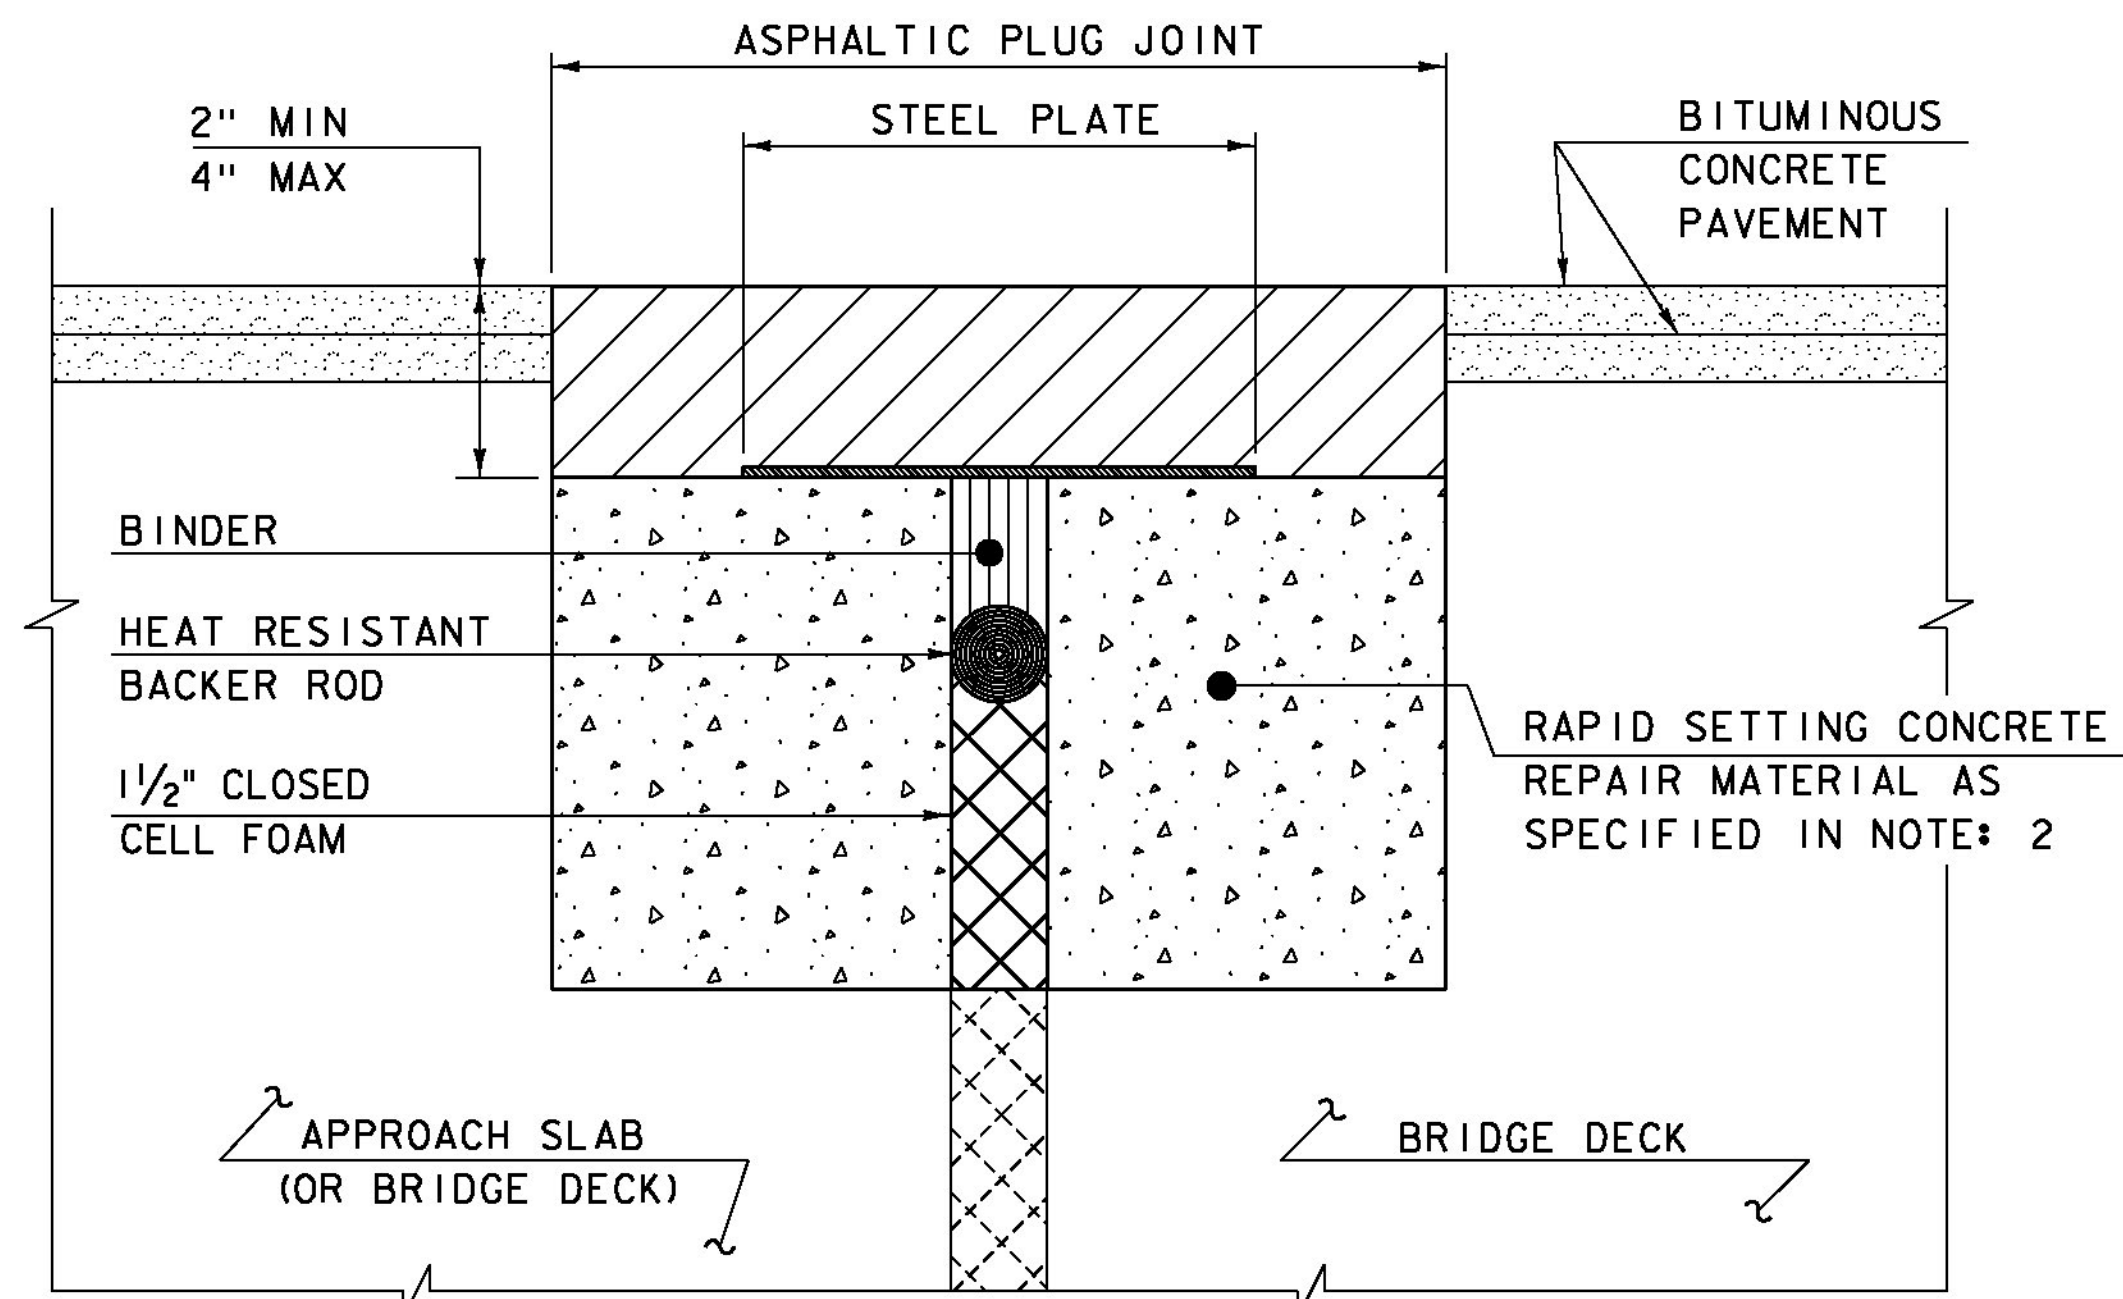

ASPHALTIC PLUG JOINT DETAIL - REHAB

NOTES:


1. THE CONTRACTOR SHALL REMOVE ALL ASPHALTIC PLUG JOINT MATERIAL AND DETERIORATED CONCRETE AS DIRECTED BY THE ENGINEER. REMOVAL OF THE FIRST 4 INCHES OF MATERIAL SHALL BE INCLUDED IN THE BID PRICE FOR ITEM 516.10 BRIDGE EXPANSION JOINT, ASPHALTIC PLUG. ANY REMOVAL OF MATERIAL GREATER THAN 4 INCHES SHALL BE INCLUDED IN THE BID PRICE OF ITEM 580.20 RAPID SETTING CONCRETE REPAIR MATERIAL WITH COARSE AGGREGATE.
2. THE CONTRACTOR SHALL REPLACE REMOVED MATERIAL THAT IS LESS THAN 4" FROM FINISHED GRADE WITH ASPHALTIC PLUG JOINT MATERIAL MEETING THE REQUIREMENTS OF SUBSECTION 707.15. ALL REMOVED MATERIAL THAT IS GREATER THAN 4 INCHES FROM FINISHED GRADE SHALL BE REPLACED WITH RAPID SETTING CONCRETE REPAIR MATERIAL WITH COARSE AGGREGATE MEETING THE REQUIREMENTS OF SUBSECTION 780.04.
3. REINFORCING STEEL NOT SHOWN FOR CLARITY.
4. PLACE 1/4" THICK BY 8" WIDE SECTIONS OF STEEL PLATE OVER THE CENTER OF THE MOVEMENT GAP. SECURE THE PLATES FROM MOVING BY INSERTING LOCATING PINS THROUGH THE PRE-STAMPED HOLES INTO BACKER ROD AND COVER WITH HOT BINDER. THE STEEL PLATES MAY BE OMITTED WHERE THE ENGINEER DETERMINES THAT THE APPROACH SLAB OR BRIDGE DECK WILL PROVIDE INADEQUATE SUPPORT AND WHERE VERTICAL MOVEMENT OF THE PLATES MIGHT OCCUR.

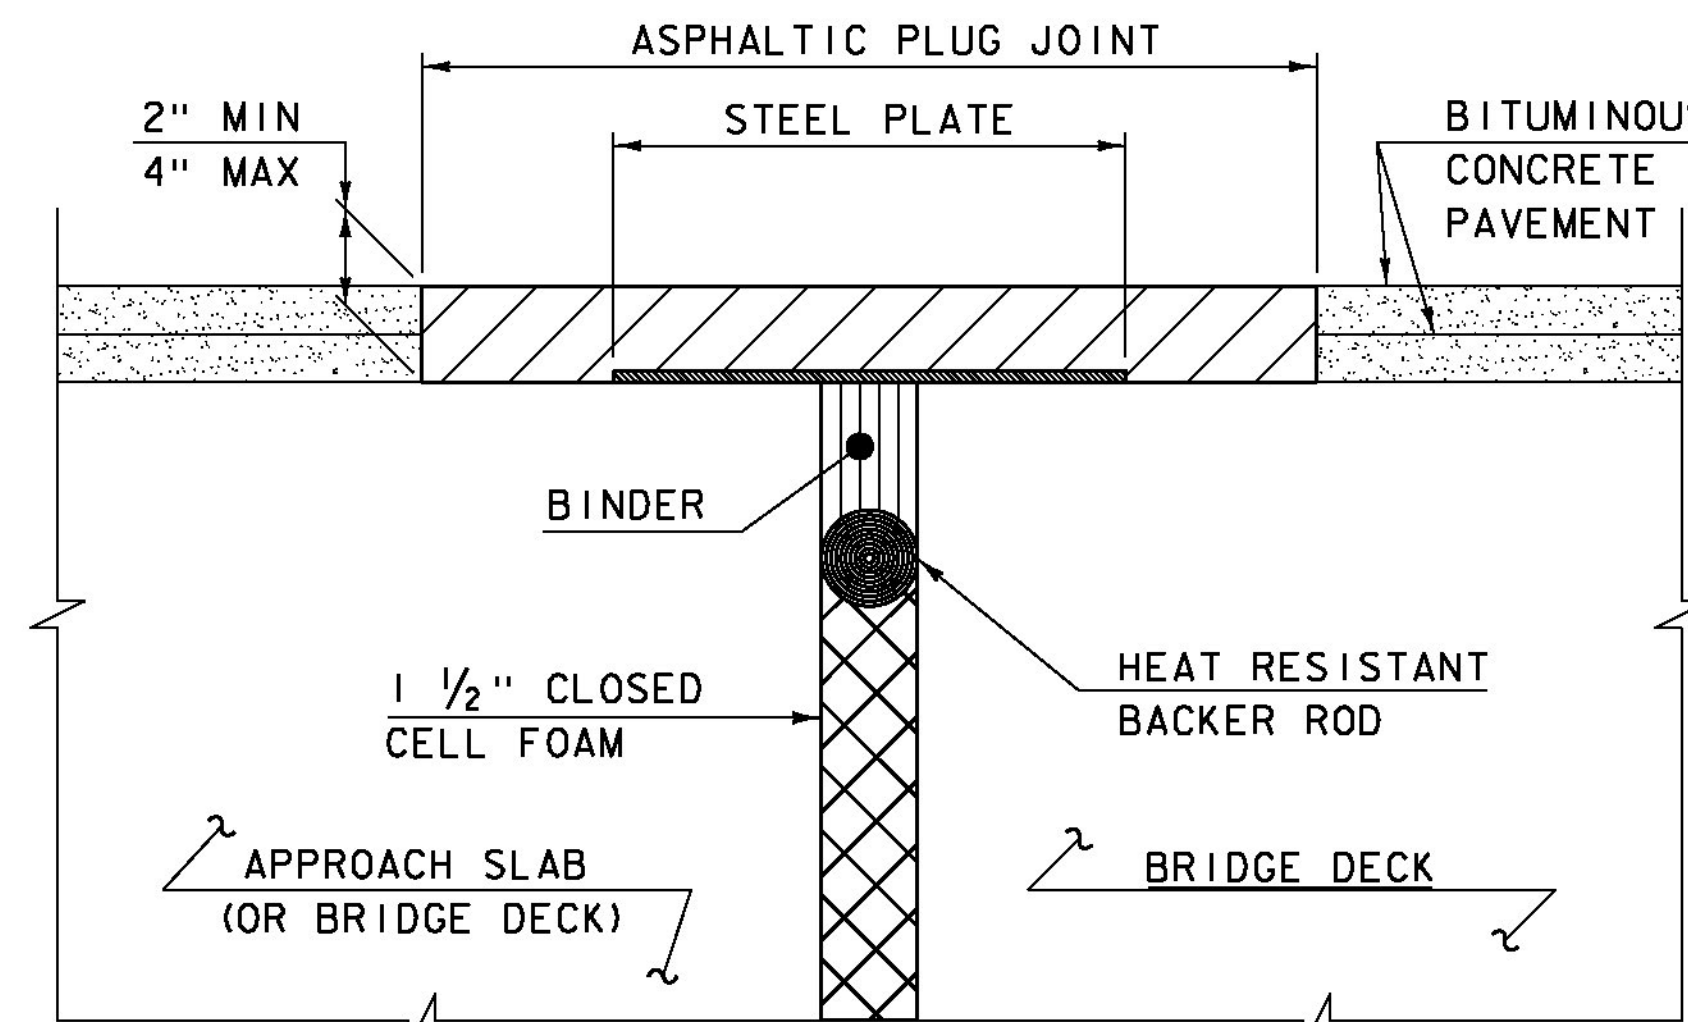

ASPHALTIC PLUG JOINT DETAIL "A" - NEW

NOTE:

PLACE 1/4" THICK BY 8" WIDE SECTIONS OF STEEL PLATE OVER THE CENTER OF THE MOVEMENT GAP. SECURE THE PLATES FROM MOVING BY INSERTING LOCATING PINS THROUGH THE PRE-STAMPED HOLES INTO BACKER ROD AND COVER WITH HOT BINDER.

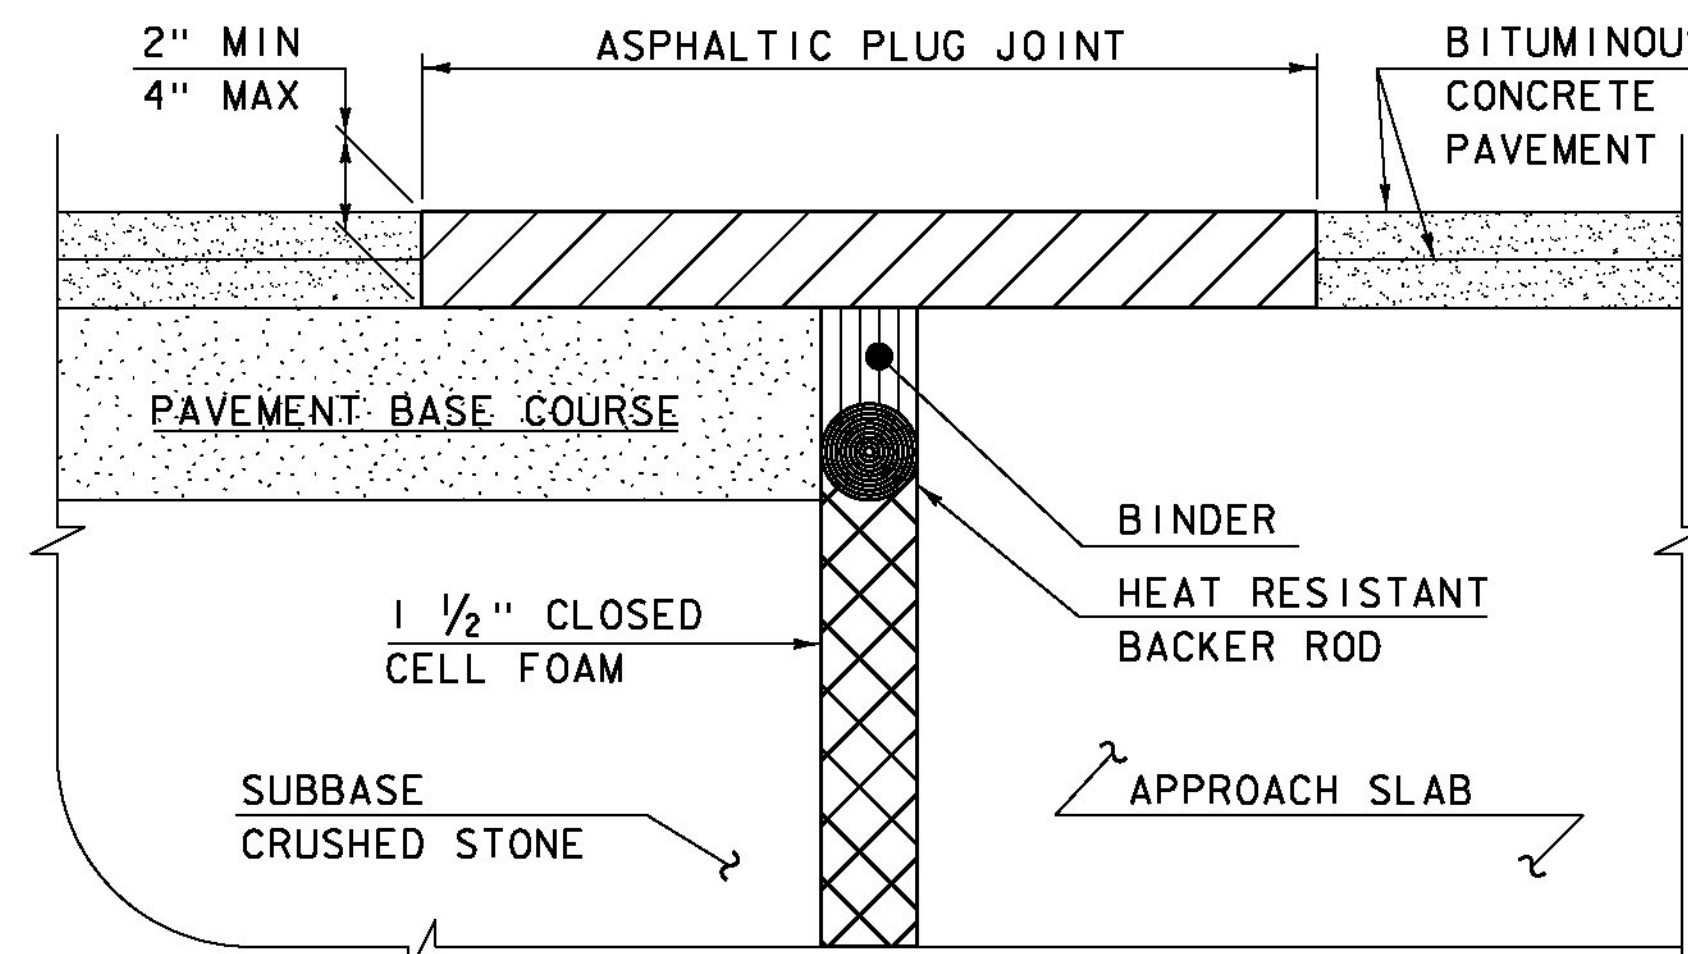

ASPHALTIC PLUG JOINT DETAIL "B" - NEW

ASPHALTIC PLUG JOINT NOTES

INSTALLATION:

1. LOCATE THE JOINT CENTRALLY OVER THE DECK OVERLAY EXPANSION GAP OR FIXED JOINT, MARKED OUT TO THE MANUFACTURER'S RECOMMENDED WIDTH.
2. REMOVE THE BITUMINOUS CONCRETE PAVEMENT FULL DEPTH AS SHOWN ON THE PLANS. THE PAVEMENT SHALL BE DRY AND SAW CUT TO THE LIMITS REQUIRED TO PLACE THE JOINT. A PNEUMATIC HAMMER AND CHISEL MAY BE USED ADJACENT TO THE CURB ONLY WHEN SAW CUTTING IS NOT POSSIBLE.
3. BLAST CLEAN THE JOINT AREA OF DEBRIS, ASPHALT AND SHEET MEMBRANE. THOROUGHLY DRY THE JOINT AREA WITH COMPRESSED AIR PRIOR TO APPLYING BINDER MATERIAL.
4. PLACE PROPERLY SIZED HEAT RESISTANT BACKER ROD IN THE MOVEMENT GAP ALLOWING FOR 1" +/- OF BINDER ABOVE THE ROD.
5. HEAT AND PLACE THE BINDER MATERIAL AS RECOMMENDED BY THE MANUFACTURER.
6. IMMEDIATELY AFTER TOP COATING, CAST AN ANTI-SKID MATERIAL OVER THE JOINT TO REDUCE THE RISK OF TRACKING.

WEATHER LIMITATIONS


APPLY BINDER MATERIAL ONLY WHEN THE FOLLOWING CONDITIONS PREVAIL OR AS RECOMMENDED BY THE MANUFACTURER:

1. THE AMBIENT AIR TEMPERATURE IS AT LEAST 10 DEG C (50 DEG F) AND RISING.
2. THE ROAD SURFACE IS DRY.
3. WEATHER CONDITIONS OR OTHER CONDITIONS ARE FAVORABLE AND ARE EXPECTED TO REMAIN SO FOR THE PERFORMANCE OF SATISFACTORY WORK.

DETAILS ON THIS SHEET ARE NOT TO SCALE.

REVISIONS	
MAY 7, 2010	APPROVED FOR USE BY VAOT STRUCTURES SECTION
AUGUST 29, 2011	ADD DETAIL "B" AND REV. NOTES


**BRIDGE JOINT
ASPHALTIC PLUG**

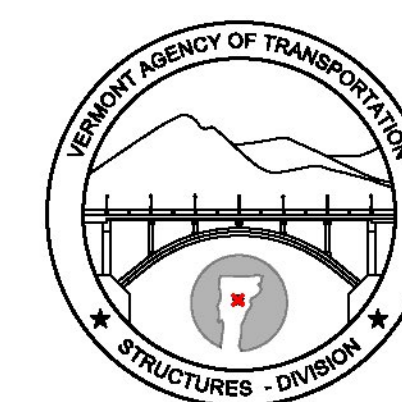

**STRUCTURES
DETAIL
SD-516.10**

STRUCTURAL STEEL GENERAL NOTES:


1. ALL FIELD CONNECTIONS SHALL BE MADE WITH 7/8" DIAMETER HIGH-STRENGTH BOLTS IN 15/16" DIAMETER HOLES, PER SUBSECTION 506.I9, UNLESS OTHERWISE SPECIFIED.
2. ALL HOLES IN THE WEBS OF THE FASCIA GIRDERS THAT ARE NOT OTHERWISE FILLED, SHALL BE FILLED WITH EITHER BUTTON HEAD OR HEX HEAD BOLTS. THESE BOLTS SHALL BE TIGHTENED IN ACCORDANCE WITH SUBSECTION 506.I9.
3. ALL WELDING SHALL CONFORM TO THE PROVISIONS OF SUBSECTION 506.I0.
4. ANY CONNECTIONS THAT ARE NOT DETAILED ON THE PLANS SHALL BE DETAILED BY THE FABRICATOR AND SUBMITTED TO THE STRUCTURES ENGINEER FOR APPROVAL.
5. STRUCTURAL STEEL MEMBERS DESIGNATED "CVN" IN THE PLANS SHALL BE CHARPY V-NOTCH TESTED IN ACCORDANCE WITH SUBSECTION 714.01 OF THE STANDARD SPECIFICATIONS.
6. ENDS OF GIRDERS ARE TO BE VERTICAL IN THEIR FINAL POSITION.
7. AFTER SUPERSTRUCTURE STEEL HAS BEEN ERECTED, ELEVATIONS ALONG THE TOP OF THE GIRDERS SHALL BE TAKEN AS DIRECTED BY THE RESIDENT ENGINEER FOR USE IN DETERMINING FINISHED GRADES.

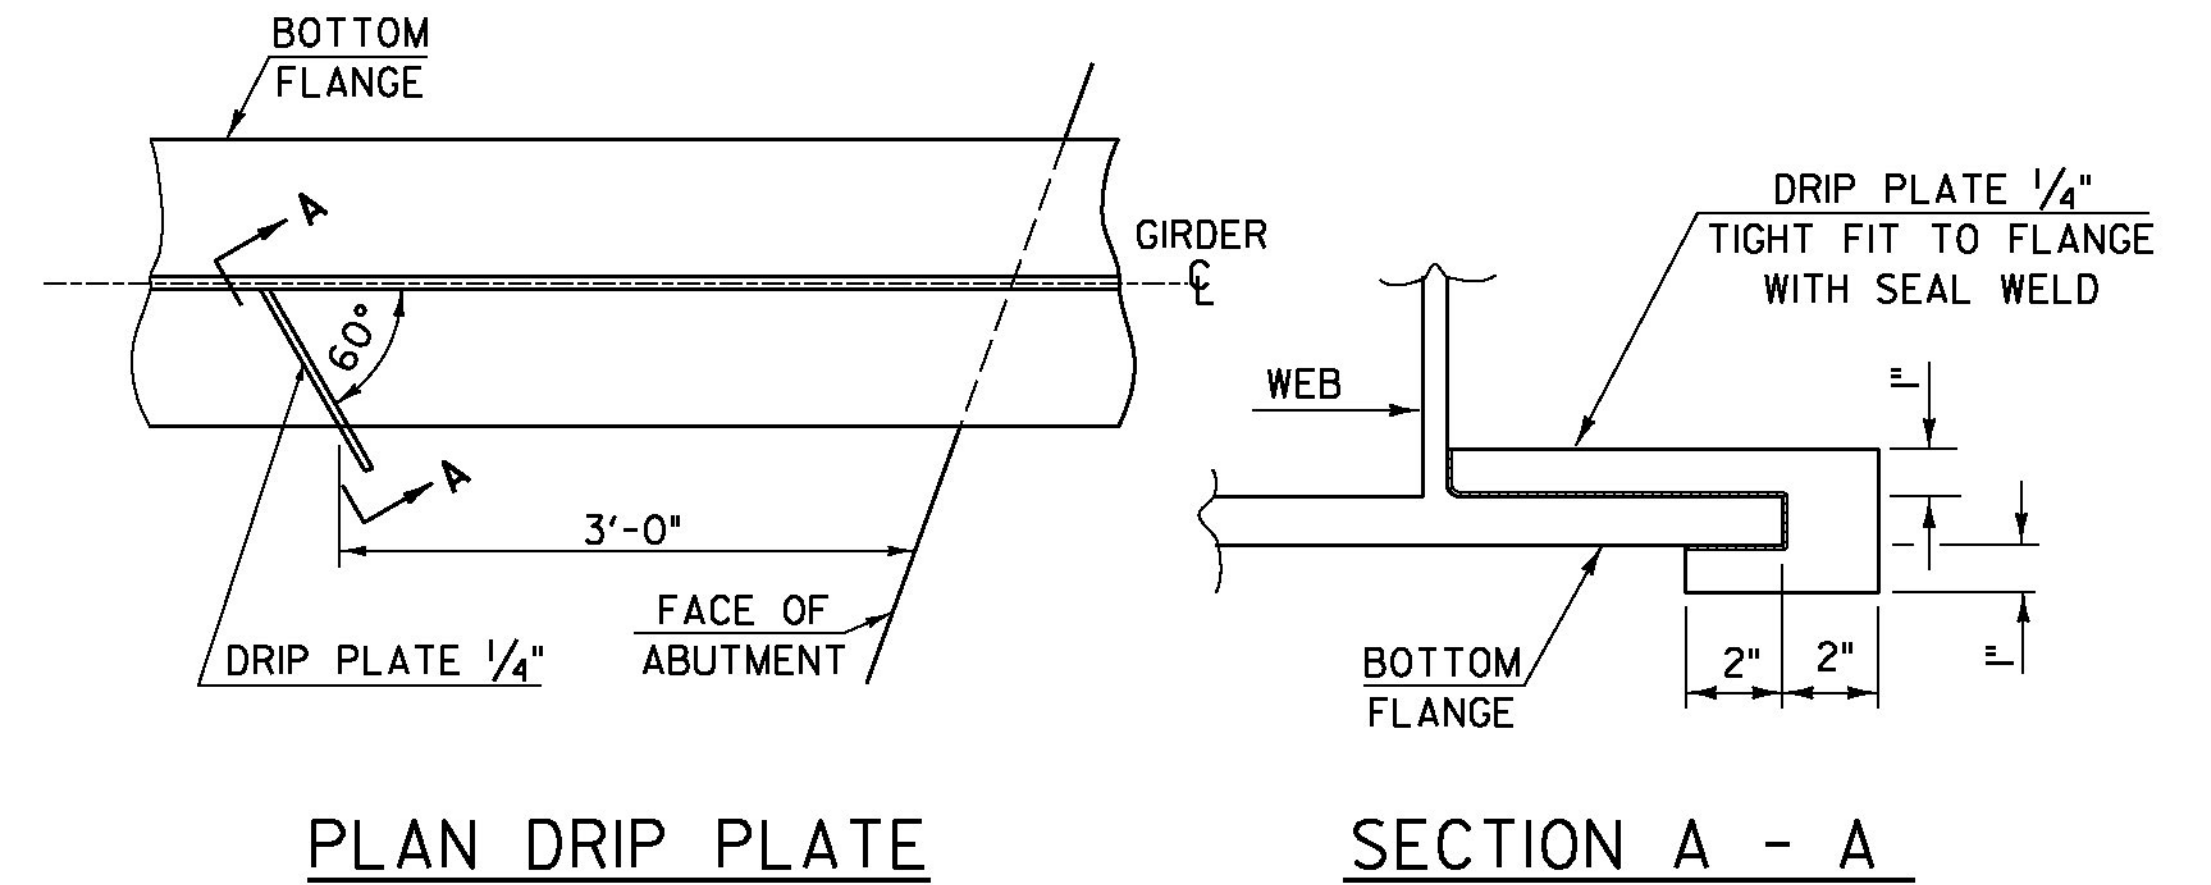

PLAN DRIP PLATE


SECTION A - A

NOTE: DRIP PLATES SHALL BE PLACED ON OUTSIDE EDGE OF FASCIA GIRDERS ON THE HIGH SIDE OF ALL PIERS AND ABUTMENTS OR AS INDICATED ON PROJECT PLANS.

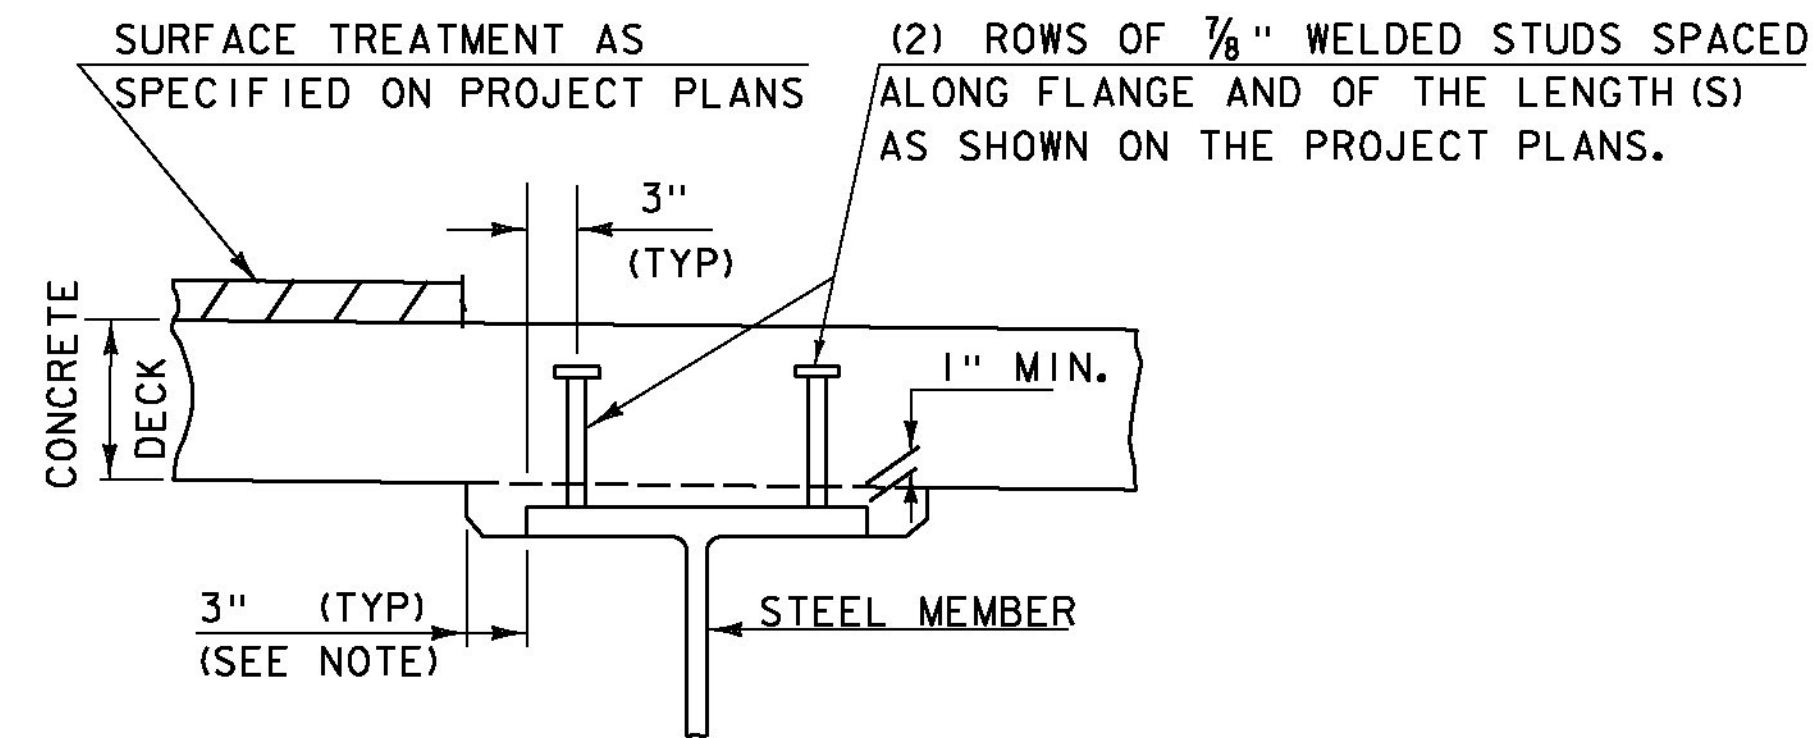

NOTE:
THE 3" HORIZONTAL SECTION MAY BE ELIMINATED FOR FORMING SYSTEMS DESIGNED FOR THE CONSTRUCTION OF VERTICAL HAUNCHES. ANY VOIDS RESULTING FROM FORMING SYSTEM ELEMENTS SHALL BE FILLED WITH JOINT SEALER, POLYURETHANE MEETING THE REQUIREMENTS OF SECTION 524. THE COST OF THE JOINT SEALER, POLYURETHANE SHALL BE INCIDENTAL TO THE ADJACENT CONCRETE.


HAUNCH AND SHEAR CONNECTOR DETAIL

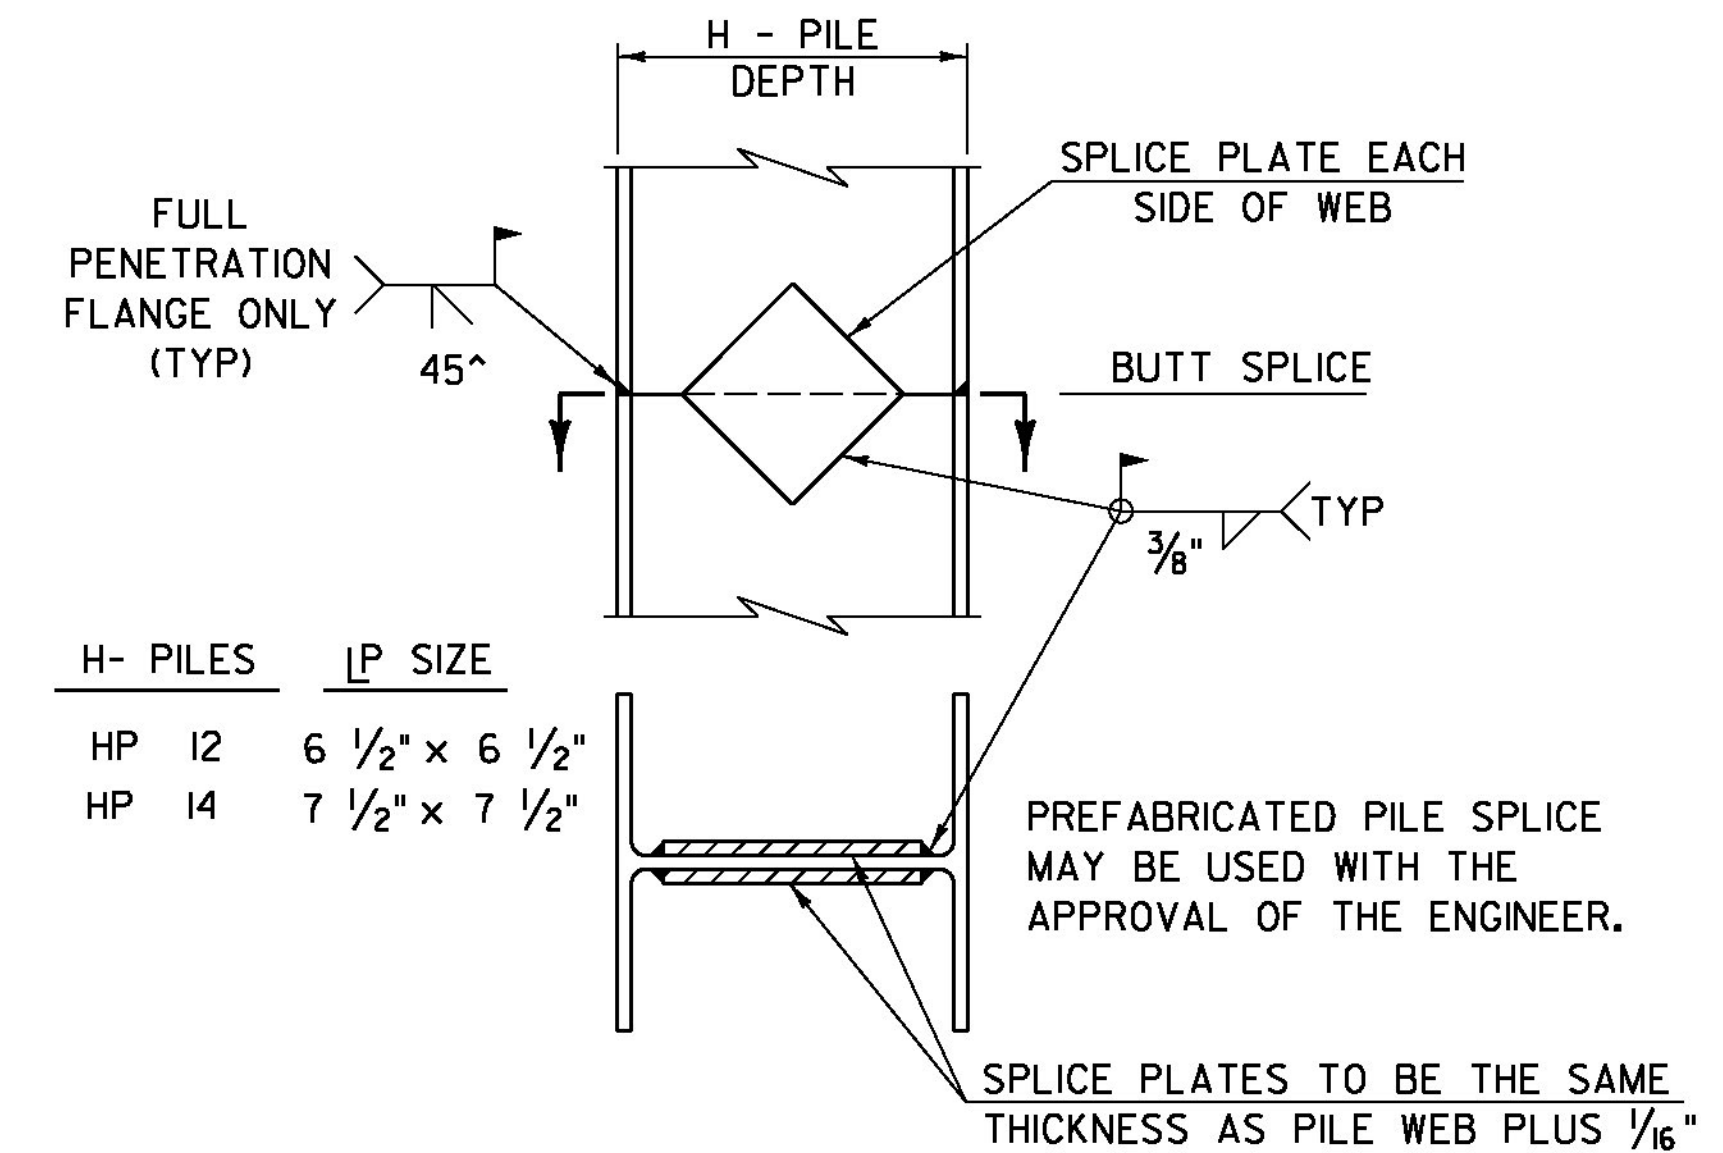

DETAIL OF PILE SPLICE


DETAILS ON THIS SHEET ARE "NOT TO SCALE" UNLESS NOTED OTHERWISE.

**STRUCTURAL STEEL
DETAILS & NOTES**

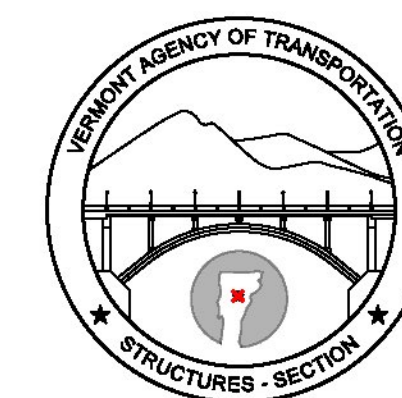

**STRUCTURES
DETAIL
SD-601.00**

REVISIONS	
MAY 7, 2010	APPROVED FOR USE BY VAOT STRUCTURES SECTION
JUNE 4, 2010	MODIFIED NOTES

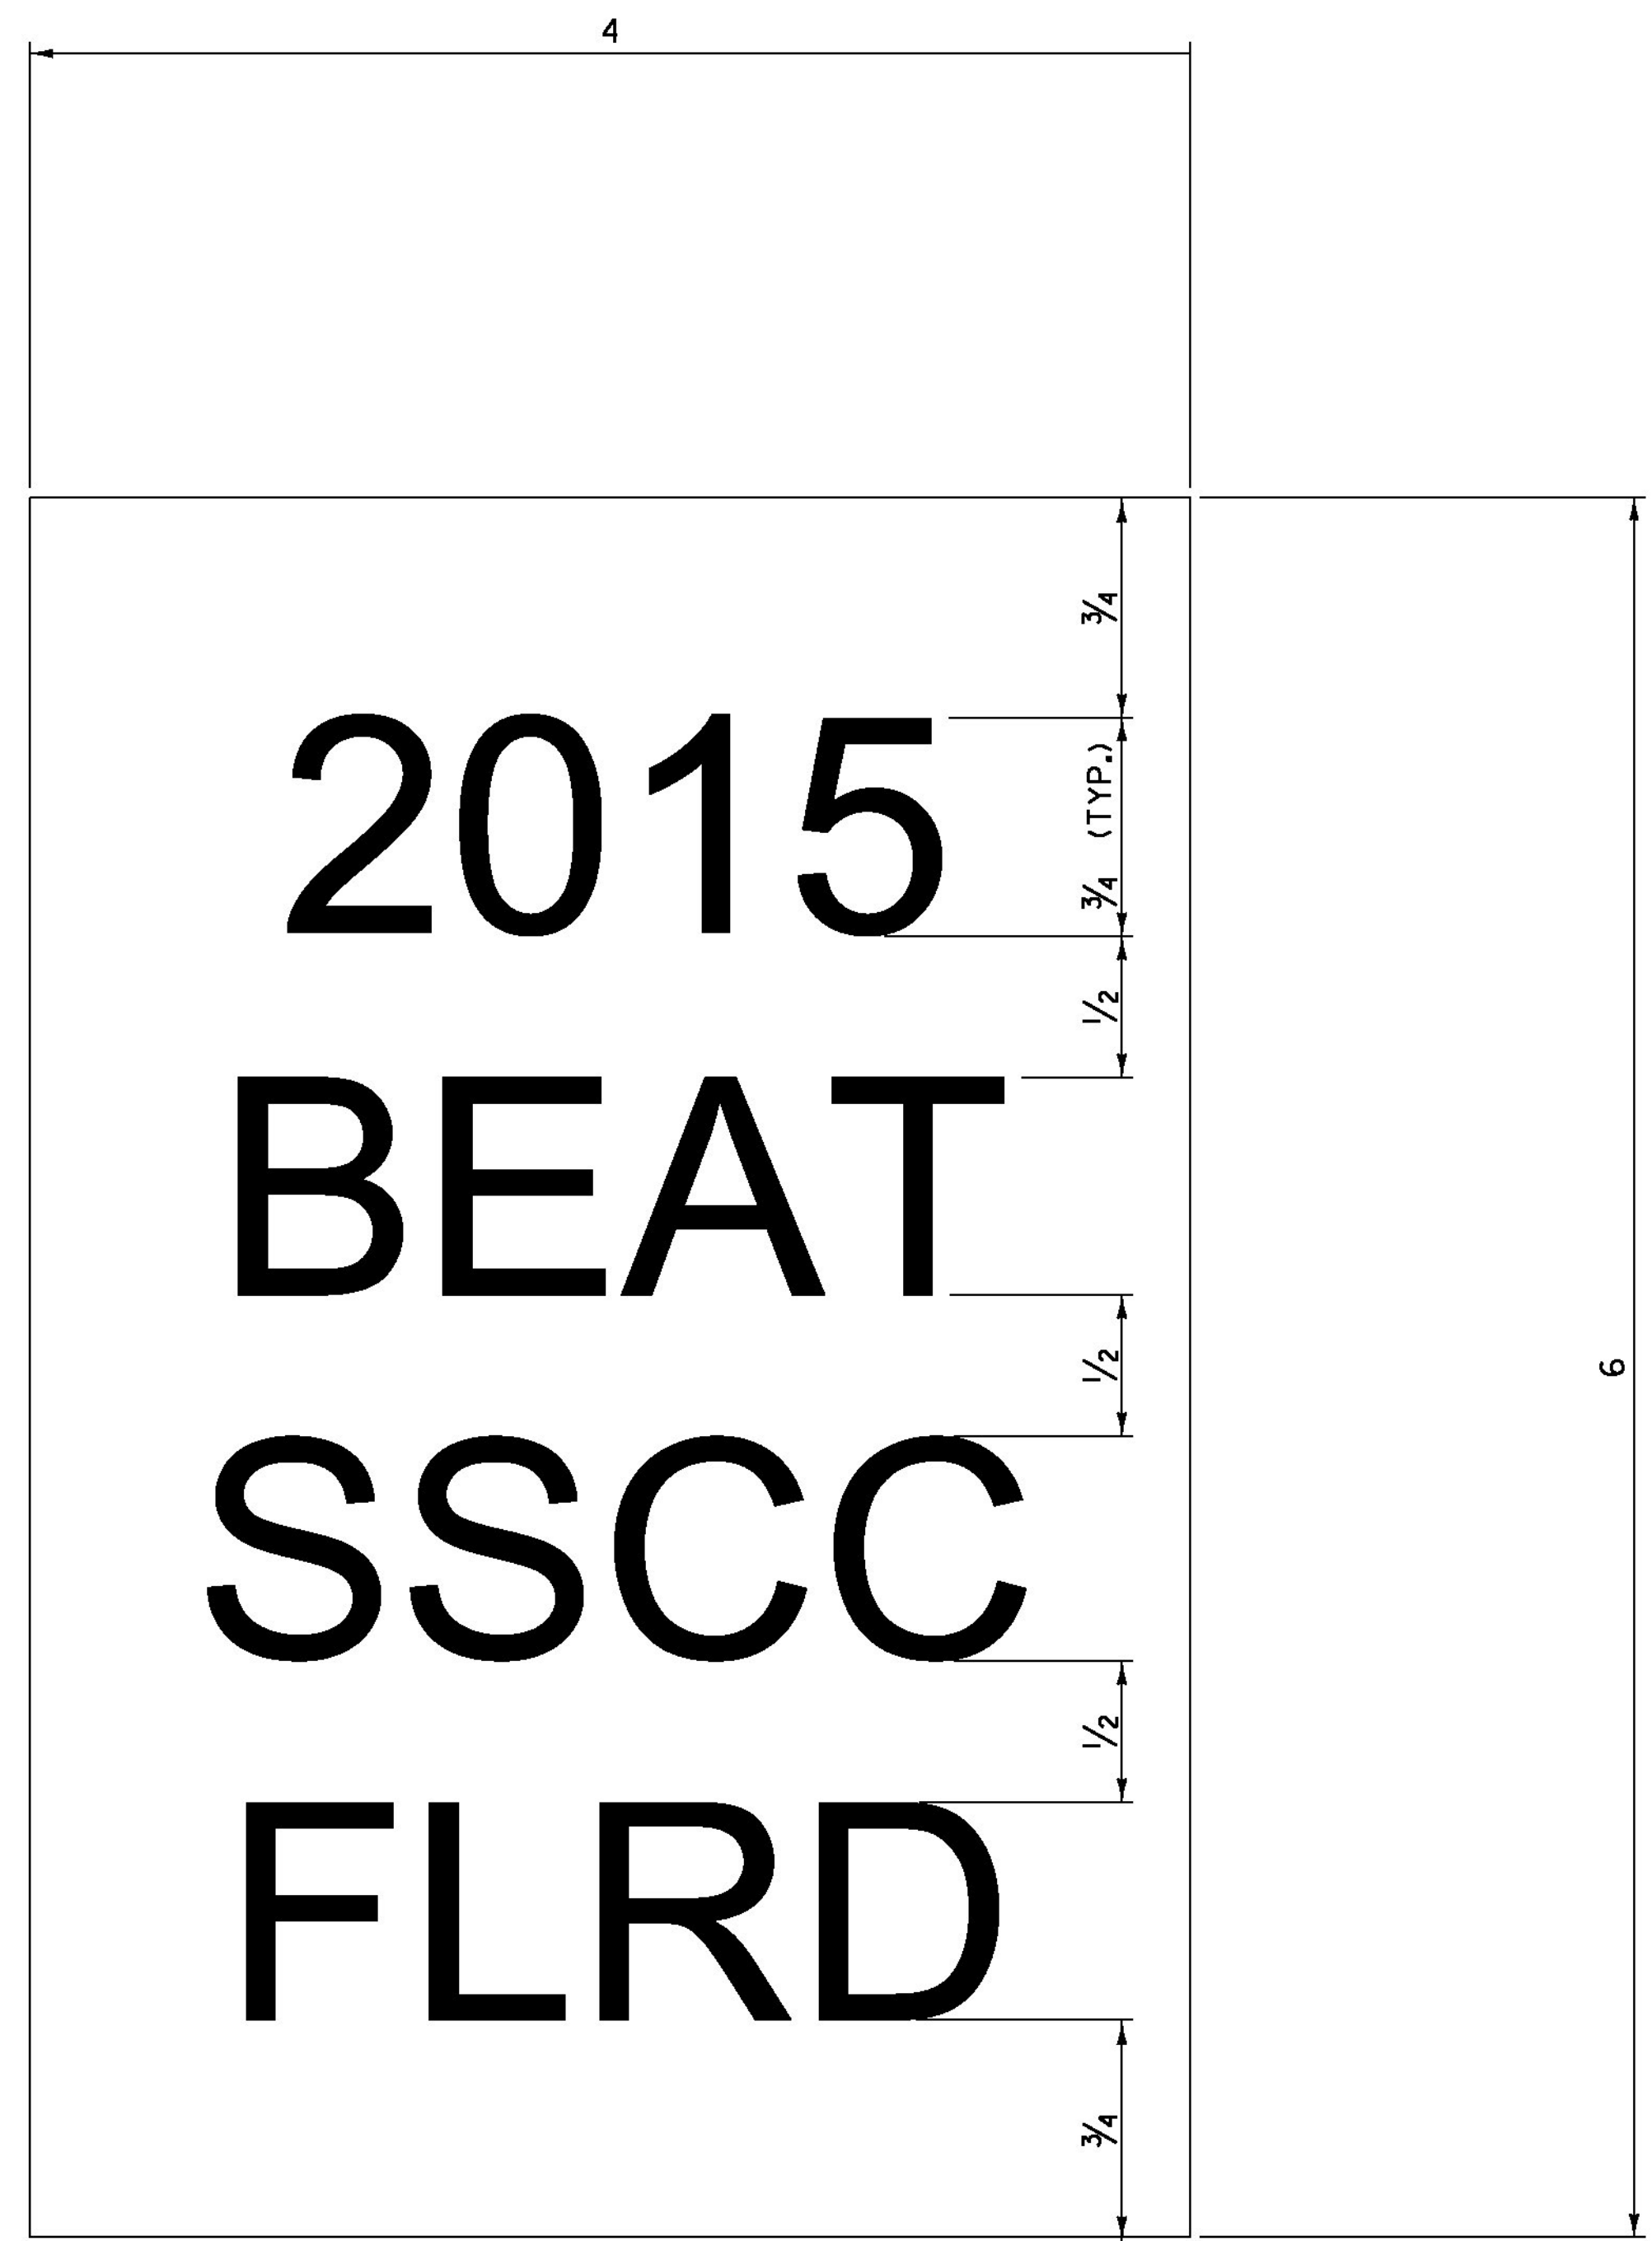


GENERAL NOTES:

1. LINE ONE SHALL INDICATE THE INSTALLATION YEAR (YYYY).
2. LINE TWO SHALL INDICATE THE MODEL AS IDENTIFIED ON THE APPROVED PRODUCTS LIST. FOR GENERIC INSTALLATIONS THE STANDARD DRAWING DESIGNATION OR NAME AS IDENTIFIED IN THE FHWA ELIGIBILITY LETTER SHALL BE USED.
3. LINE THREE SHALL INDICATE ADDITIONAL MODEL INFORMATION IF NECESSARY.
4. LINE FOUR SHALL INDICATE FLARED (FLRD) OR TANGENT (TANG).
5. LEGEND SHALL BE ONE ARIEL FONT.
6. LEGEND SHALL BE BLACK ON A WHITE BACKGROUND, LEGEND AND BACKGROUND SHALL NOT BE REFLECTIVE.
7. SUITABLE MATERIAL SHALL BE USED SO AS TO NOT DETERIORATE DURING EXPOSURE TO WEATHER.
8. LABELS SHALL BE APPLIED IN SUCH A WAY THAT THEY REMAIN INTACT DURING THE LIFE OF THE TERMINAL.
9. FOR W-BEAM GUARDRAIL, LABEL SHALL BE PLACED ON THE TOP OF POST ONE FACING AWAY FROM TRAFFIC.
10. FOR BOX BEAM GUARDRAIL, LABEL SHALL BE PLACED ON THE BOX BEAM ADJACENT TO POST ONE FACING AWAY FROM TRAFFIC.
11. PAYMENT SHALL BE INCIDENTAL TO OTHER TRAFFIC BARRIER ITEMS.
12. ALL DIMENSIONS IN INCHES.


REV.	DATE	DESCRIPTION
0	NOV. 3, 2015	ORIGINAL APPROVAL
OTHER DETAILS REQUIRED: NONE		
DETAILS APPROVED FOR USE BY HIGHWAY SAFETY & DESIGN		

GUARDRAIL TERMINAL LABEL DETAIL

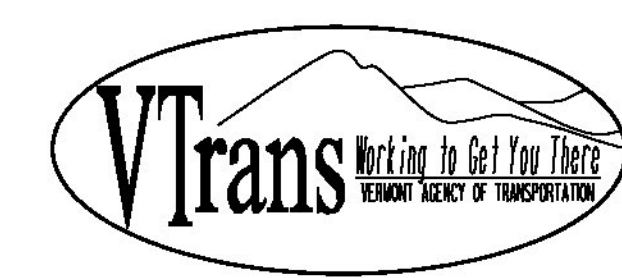


HIGHWAY SAFETY & DESIGN DETAIL

HSD-621.06


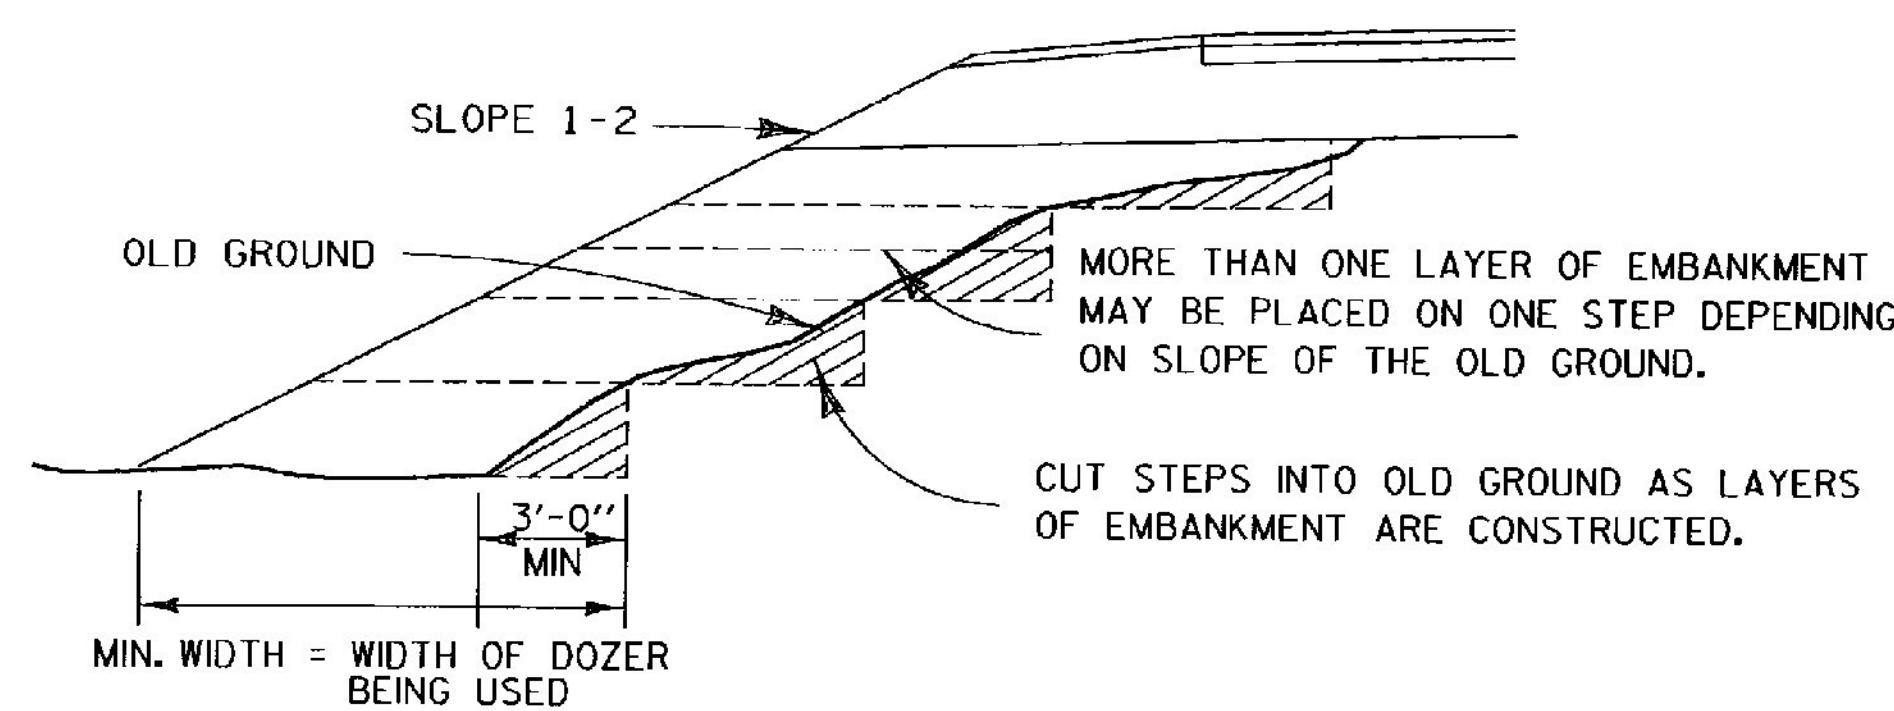


METHOD FOR CONSTRUCTING AN EMBANKMENT ON EARTH SLOPE

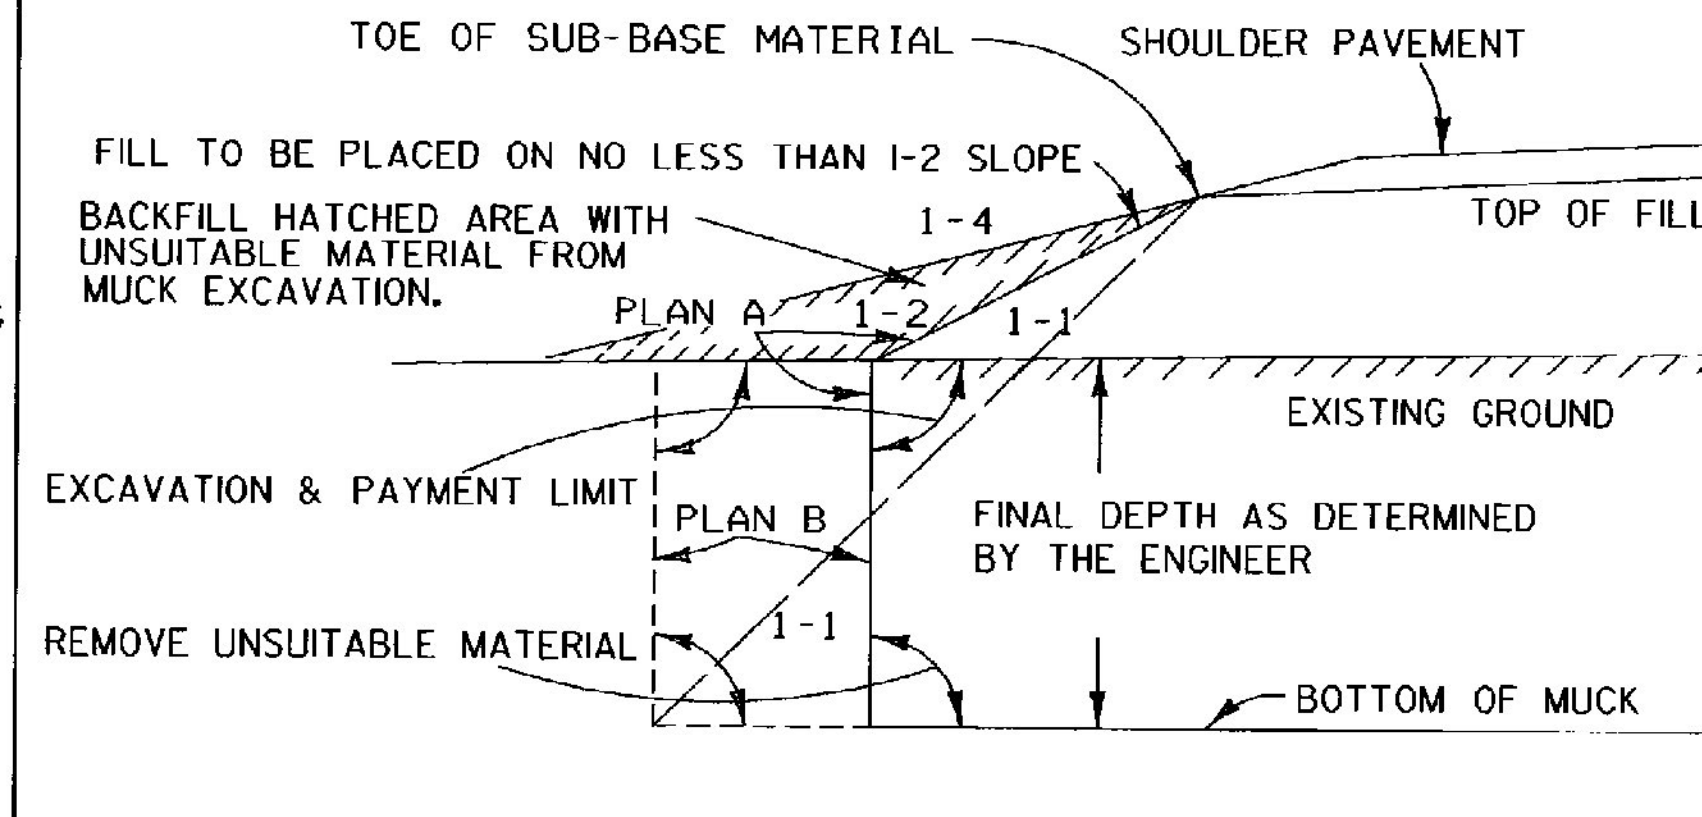




GENERAL NOTES:
 THE MUCK OR UNSUITABLE MATERIAL SHALL BE EXCAVATED TO THE NEAT LINES SHOWN ON THE PLANS OR AS DETERMINED BY THE ENGINEER.
 EXCAVATION AND PAYMENT LIMIT WILL BE DETERMINED FROM EITHER PLAN "A" OR PLAN "B", WHICHEVER PRODUCES THE GREATER WIDTH IN A GIVEN MUCK AREA.
 BACKFILL MATERIAL MUST MEET THE REQUIREMENTS SET FORTH UNDER MUCK EXCAVATION, SECTION 203

TYPICAL NEAT PAY LINES FOR MUCK EXCAVATION

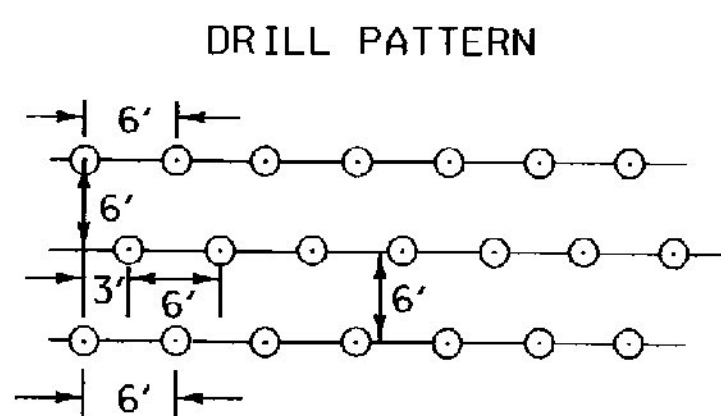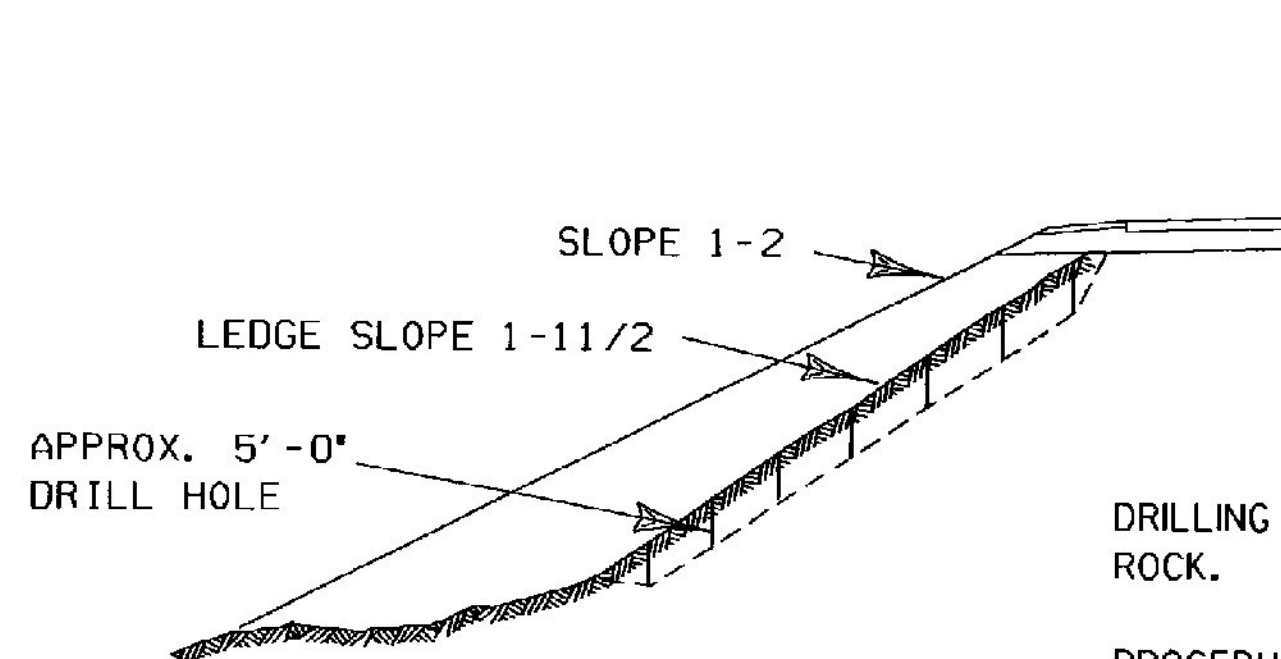

DRILLING AND BLASTING OF SOLID ROCK.
 PROCEDURE TO BE FOLLOWED WHEN LEDGE SLOPE ON OLD GROUND IS BETWEEN A 1-1 AND A 1-5 SLOPE.
 ALL HOLES TO BE APPROXIMATELY 5'-0" DEEP. HOLES TO BE IN ROWS, SPACED AND STAGGERED AS SHOWN IN DRILL PATTERN, OR AS DIRECTED BY THE ENGINEER, SEE SECTION 205

A METHOD FOR PREPARING LEDGE SLOPE BEFORE CONSTRUCTING AN EMBANKMENT

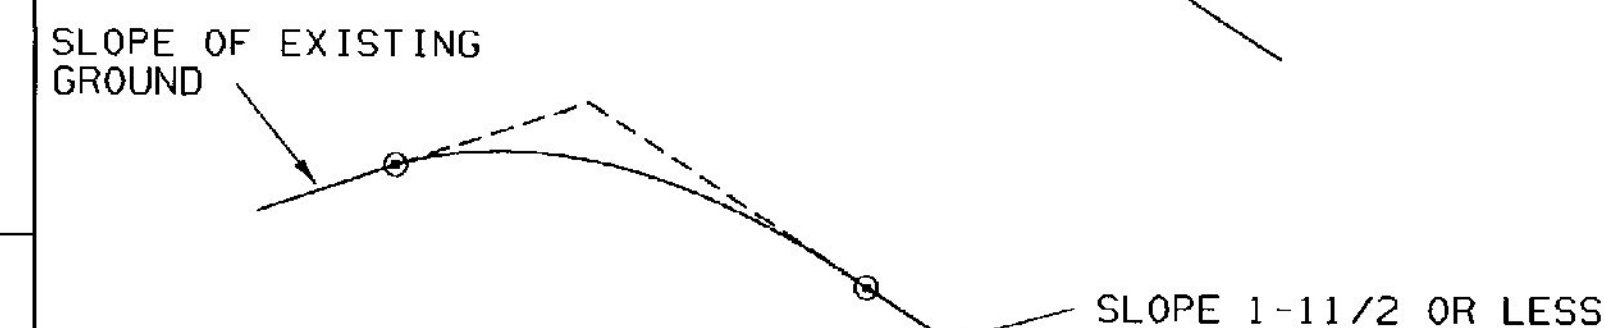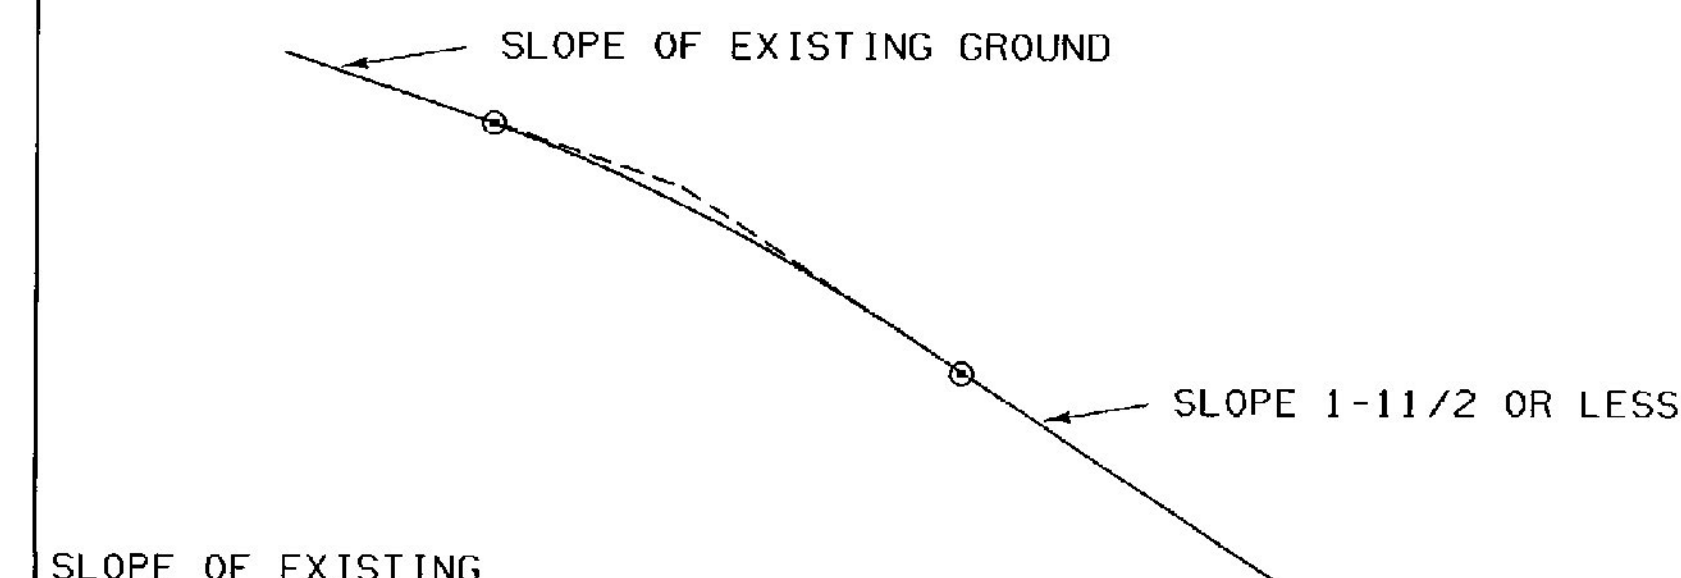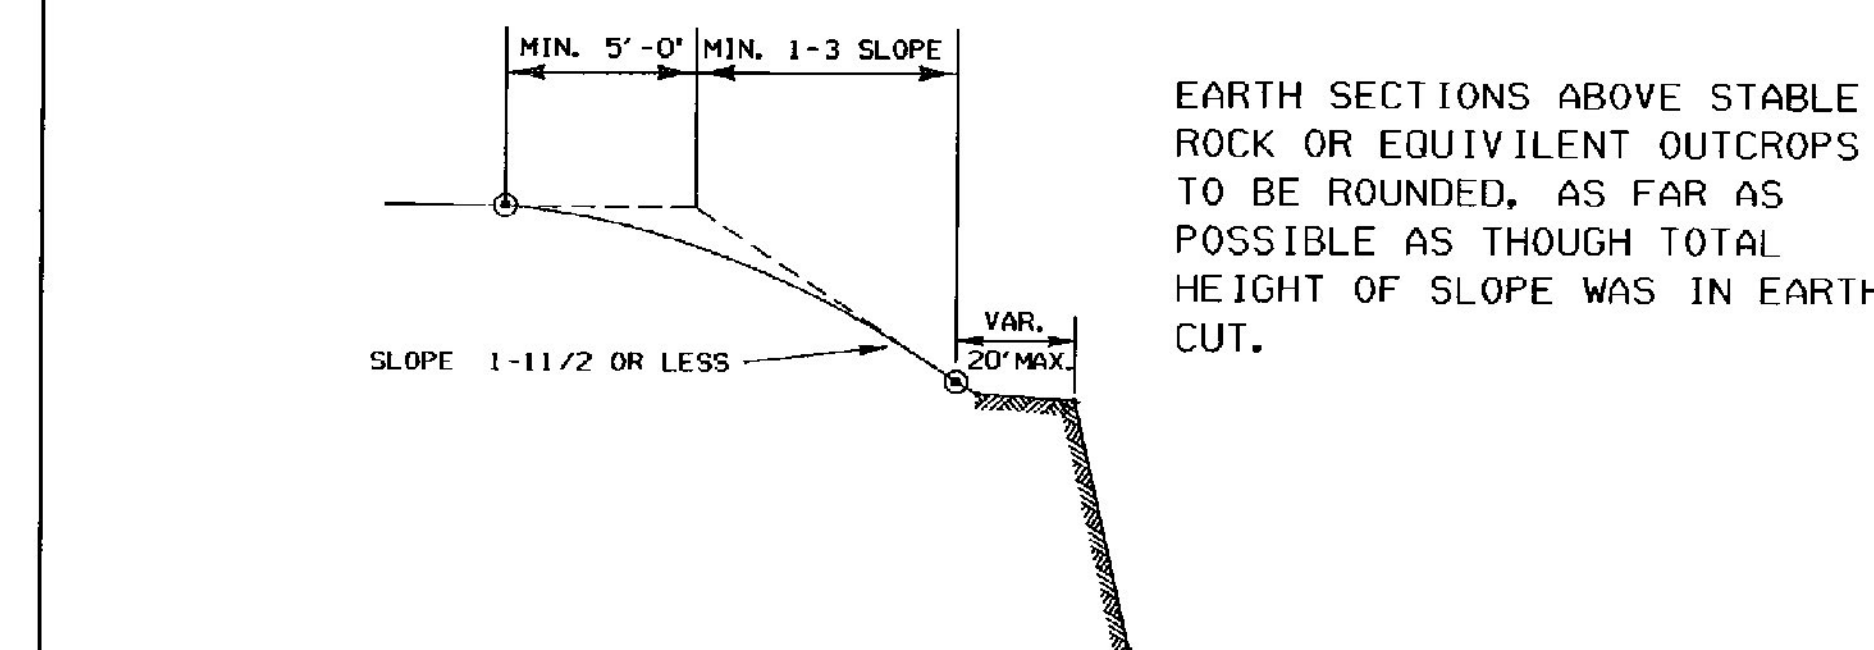


EARTH SECTIONS ABOVE STABLE ROCK OR EQUIVALENT OUTCROPS TO BE ROUNDED, AS FAR AS POSSIBLE AS THOUGH TOTAL HEIGHT OF SLOPE WAS IN EARTH CUT.

SLOPES TO BE ROUNDED AS SHOWN IN ORDER TO ALLOW FOR PERSPECTIVE FORESHORTENING AS SEEN FROM THE ROAD AND SO THAT FINISHED SLOPES WILL BETTER SUPPORT VEGETATIVE COVER.

ROUNDING TO MERGE WITH EXISTING GROUND SURFACE SO THAT NO HARD GRADE LINE WILL REMAIN WITHIN THE LINE OF SIGHT

WHEN STEEPNESS OF EXISTING GROUND OR PRESENCE OF EXISTING VEGETATION IS CONSIDERED A FACTOR PREVENTING NORMAL ROUNDING, THE EXTENT OF THE ROUNDING SHOULD BE MODIFIED TO MEET CONDITIONS.

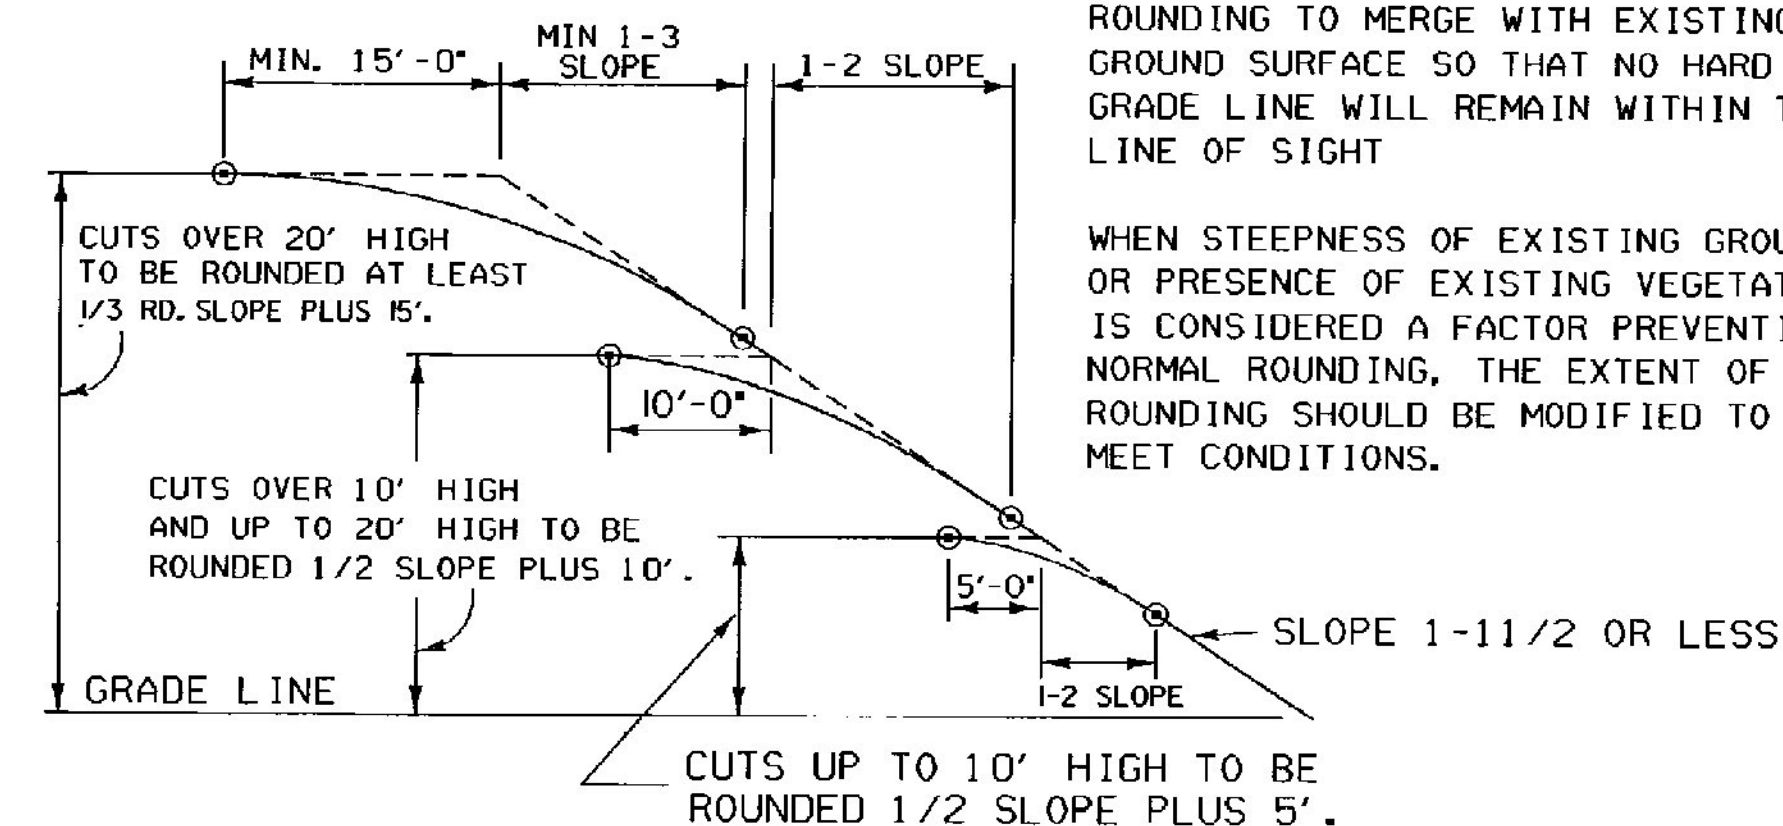

TYPICAL SLOPE ROUNDING




REVISIONS AND CORRECTIONS
 DEC. 6, 1971 - ORIGINAL APPROVAL DATE
 JUNE 1, 1994 - REISSUED, WITHOUT CHANGE, UNDER NEW SIGNATURES.

APPROVED
 APPROVED FOR THIS PROJECT AND/OR DESIGN IMPLEMENTATION. FHWA FINAL APPROVAL PENDING.
 Gordon D. MacArthur, P.E. DIRECTOR OF ENGINEERING
 John M. Murphy, P.E. DESIGN ENGINEER







EMBANKMENT ON EARTH SLOPE
 EMBANKMENT ON ROCK SLOPE
 MUCK EXCAVATION
 TYPICAL SLOPE ROUNDING



STANDARD
 B-5

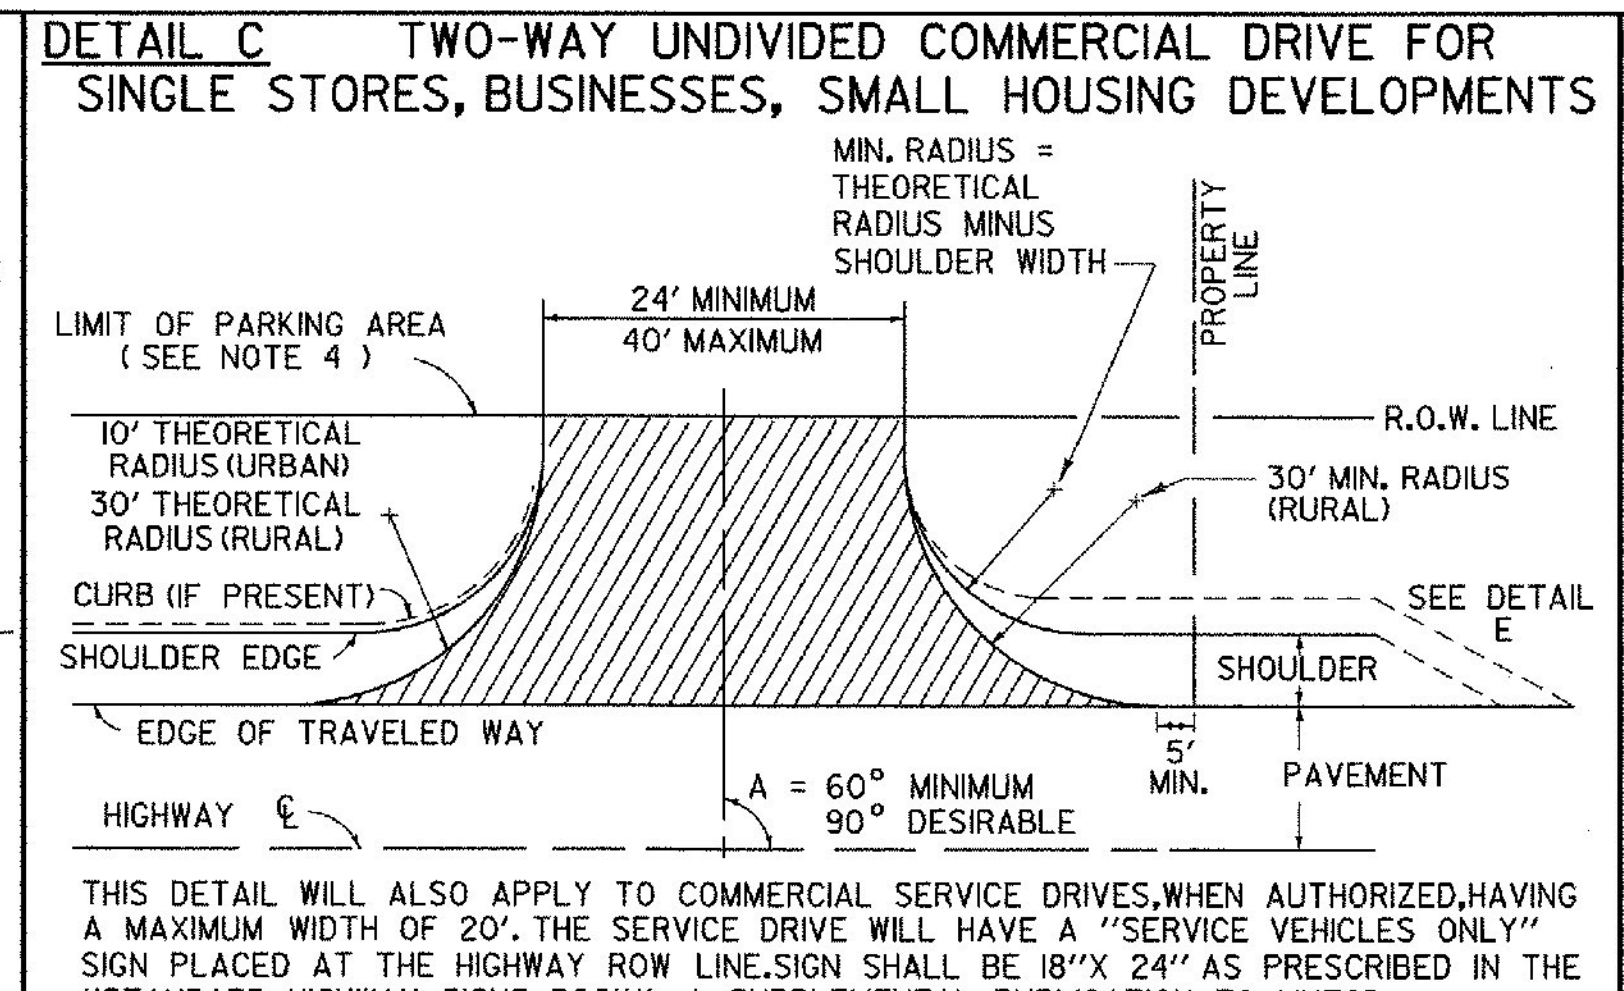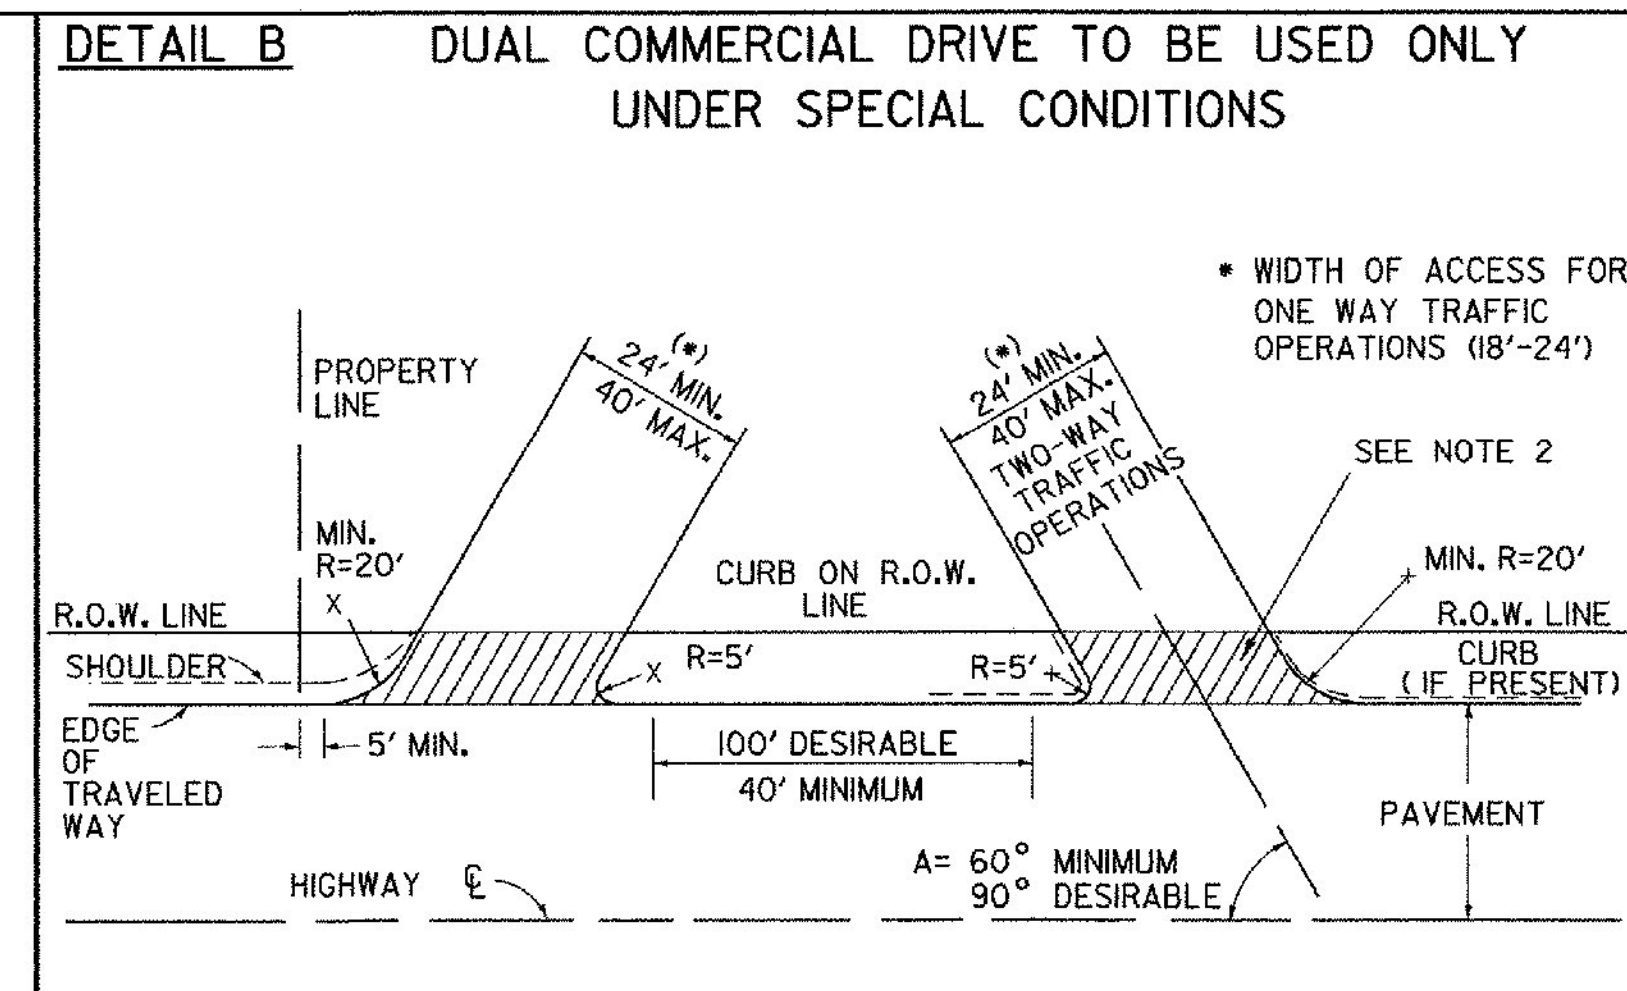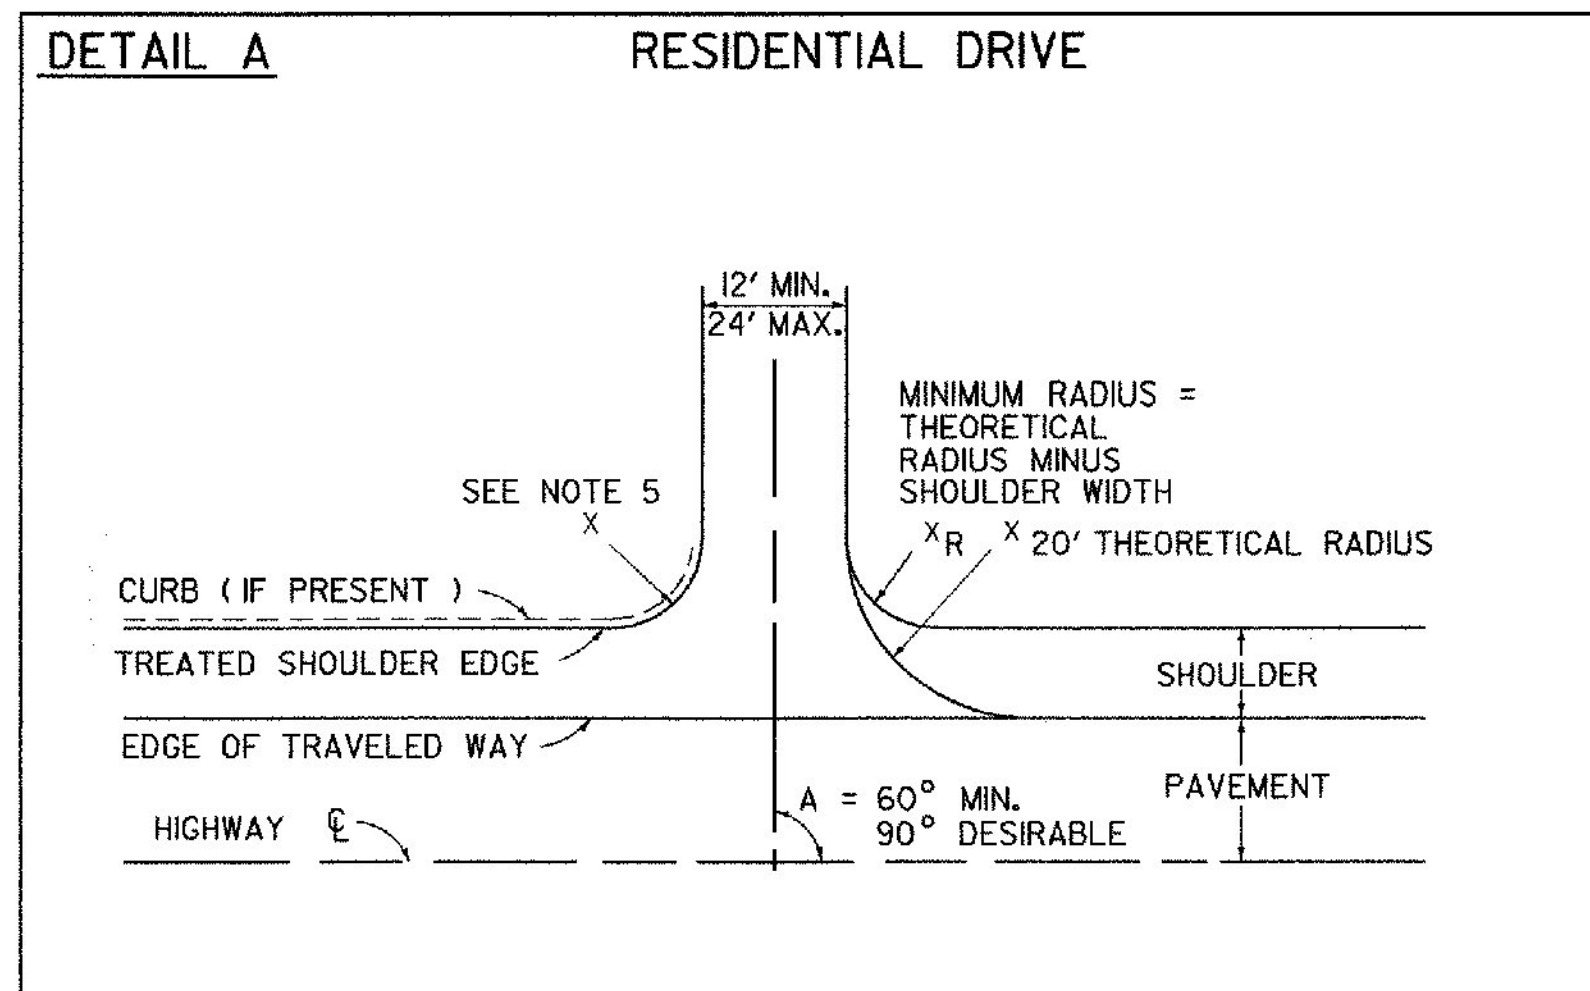


- NOTES:**
- THIS SHEET IS INTENDED FOR USE BY DESIGNERS ON HIGHWAY PROJECTS AND IN CONJUNCTION WITH A PERMIT FOR WORK WITHIN HIGHWAY RIGHTS OF WAY (FORM TA 210). ALL CONSTRUCTION REQUIRED BY THE PERMIT AND INDICATED ON THIS SHEET SHALL BE THE RESPONSIBILITY OF THE APPLICANT AND IS SUBJECT TO THE APPROVAL OF THE VT. AGENCY OF TRANSPORTATION. WHEN USED WITH THE PLANS FOR A HIGHWAY CONSTRUCTION PROJECT, THIS SHEET IS INTENDED TO BE A GUIDE FOR THE DESIGNER CONCERNING DRIVE WIDTHS, HORIZONTAL, VERTICAL AND GEOMETRIC CHARACTERISTICS.
 - ALL COMMERCIAL DRIVES SHALL BE PAVED FROM THE EDGE OF THE TRAVELED WAY TO THE HIGHWAY RIGHT-OF-WAY, TO THE FARTHEST POINT OF CURVATURE ON THE DRIVEWAY EDGE OR AS DIRECTED BY THE DISTRICT TRANSPORTATION ADMINISTRATOR. THIS PAVING IS INDICATED IN DETAILS (B THRU E) BY HATCHING.
 - DEPTH OF SUBBASE AND PAVEMENT TO BE THE SAME AS HIGHWAY OR AS SHOWN IN DETAIL J WITHIN THE LIMITS OF THE HIGHWAY RIGHT-OF-WAY.
 - VEHICULAR ACCESS FROM PARKING AREAS TO THE RIGHT-OF-WAY AT OTHER THAN APPROVED ACCESS POINTS WILL BE PREVENTED BY THE CONSTRUCTION OF CURBING OR OTHER SUITABLE PHYSICAL BARRIER.
 - IF CURB IS PRESENT, SEE APPROPRIATE CURB DETAIL STANDARD OR MATCH TOWN/CITY STANDARD CURB TREATMENT.
 - WHERE TRAFFIC VOLUME FOR A PROJECT IS SUBSTANTIAL THE AGENCY MAY REQUIRE SPECIAL LANES FOR TURNING, SIGNALS OR OTHER MODIFICATIONS. BASED ON TRAFFIC STUDIES THE AGENCY WILL DETERMINE SPECIFIC TREATMENT TO BE USED. ON DEVELOPER PROJECTS THE AGENCY WILL WORK WITH THE APPLICANT TO IMPLEMENT CHANGES TO THE STATE HIGHWAY.
 - CIRCULAR DRAINAGE CULVERTS UNDER DRIVES SHALL HAVE A MINIMUM INSIDE DIAMETER (I.D.) OF 15". PIPE ARCHES USED UNDER DRIVES SHALL HAVE A MINIMUM INSIDE CROSS-SECTIONAL AREA EQUIVALENT TO THAT PROVIDED BY A 15" CIRCULAR PIPE.
 - THE OFFSET BETWEEN THE PROPERTY LINE AND THE EDGE OF THE DRIVEWAY MAY BE GOVERNED BY LOCAL ZONING LAWS. DRIVEWAY WIDTH RESTRICTIONS SHOWN PERTAIN ONLY TO THE AREA WITHIN THE HIGHWAY R.O.W. OR THE END OF THE TURNING RADIUS WHICHEVER IS GREATEST.
 - DRIVEWAY GRADES STEEPER THAN THOSE SHOWN MAY BE ALLOWED AS LONG AS A 20' APPROACH AREA IS ACHIEVED FOR THE VEHICLE TO PAUSE BEFORE ENTERING THE HIGHWAY. (WHERE CURB & SIDEWALKS EXIST, SEE STANDARDS C-2A & C-2B)
 - INTERSECTION SIGHT DISTANCES, EQUAL TO OR GREATER THAN THOSE SHOWN BELOW SHOULD BE PROVIDED IN BOTH DIRECTIONS FOR ALL DRIVES ENTERING ON PUBLIC HIGHWAYS, UNLESS OTHERWISE APPROVED BY THE AGENCY OF TRANSPORTATION. INTERSECTION SIGHT DISTANCE IS MEASURED FROM A POINT ON THE DRIVE AT LEAST 15 FEET FROM THE EDGE OF TRAVELED WAY OF THE ADJACENT ROADWAY AND MEASURED FROM A HEIGHT OF EYE OF 3.5 FEET ON THE DRIVE TO A HEIGHT OF 3.5 FEET ON THE ROADWAY.

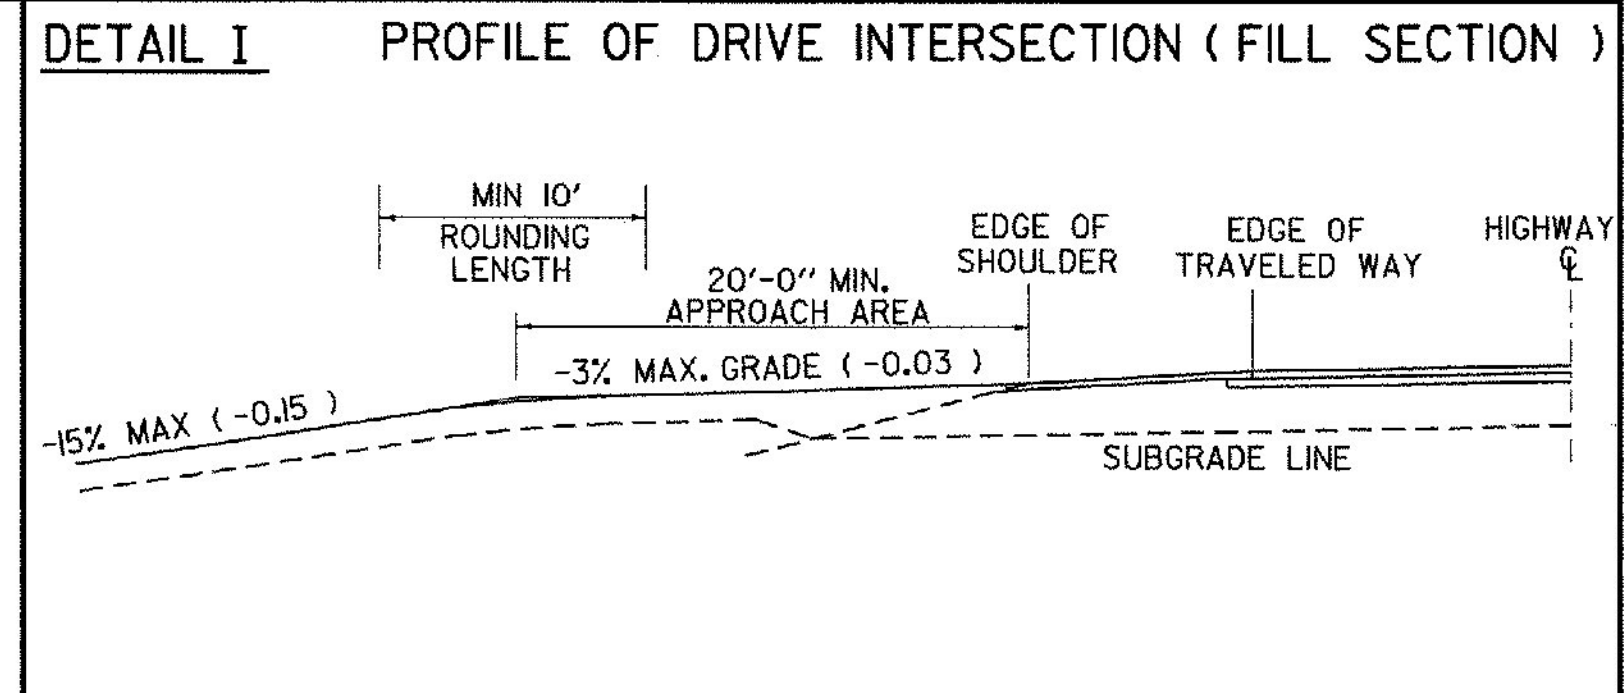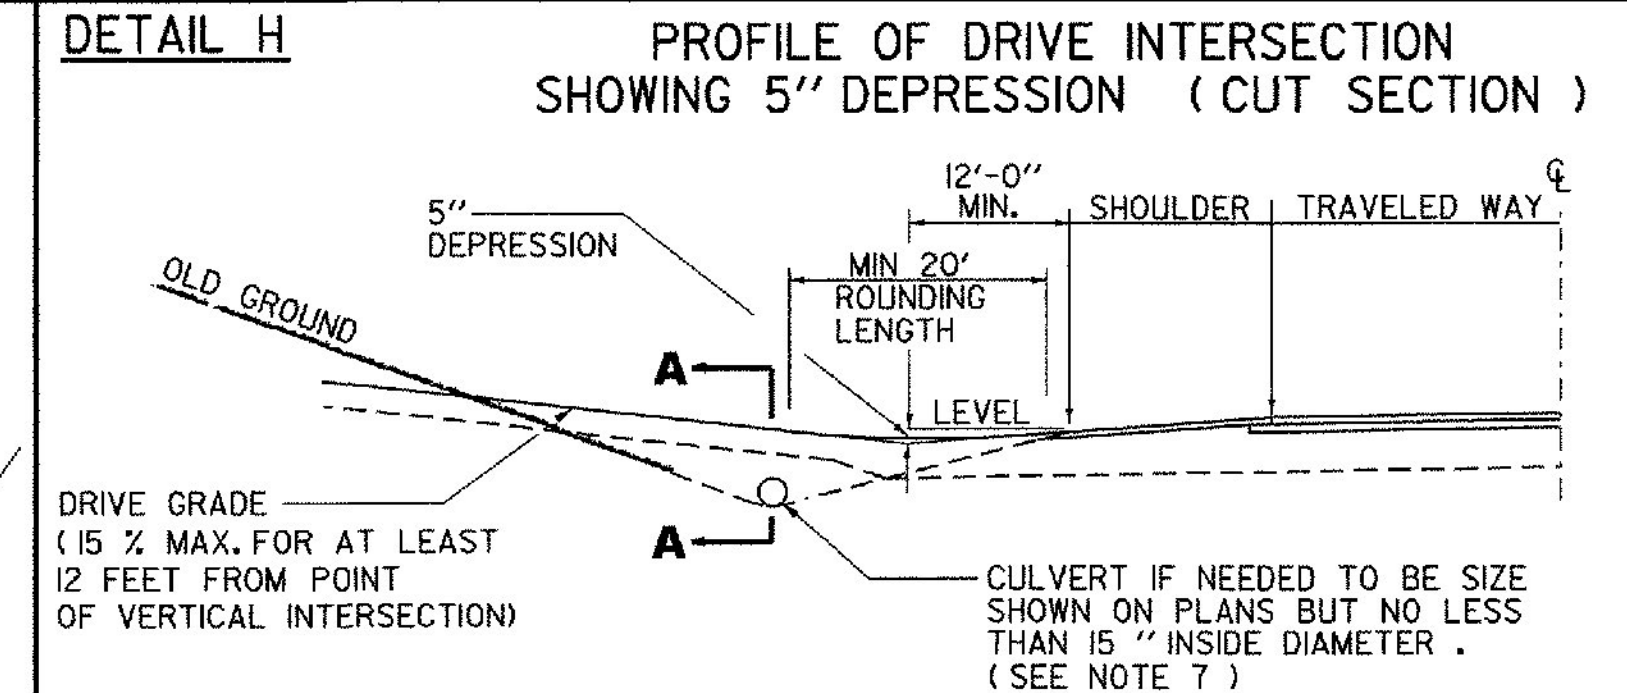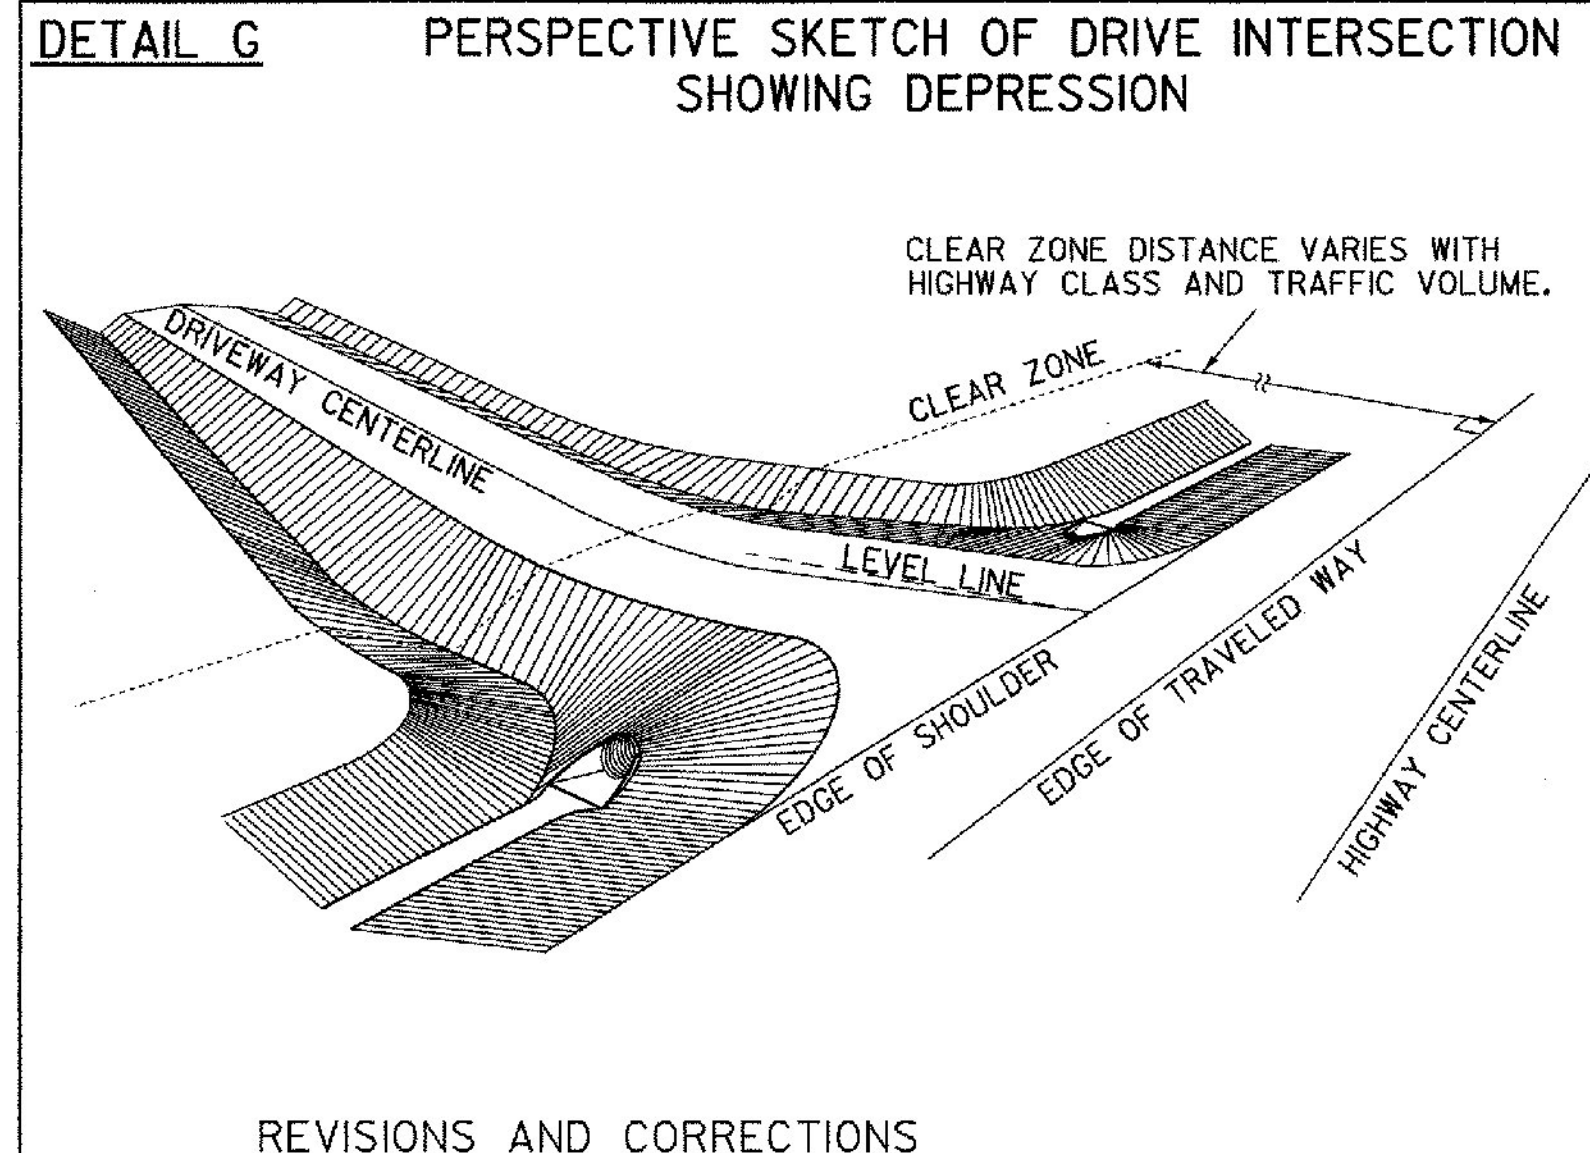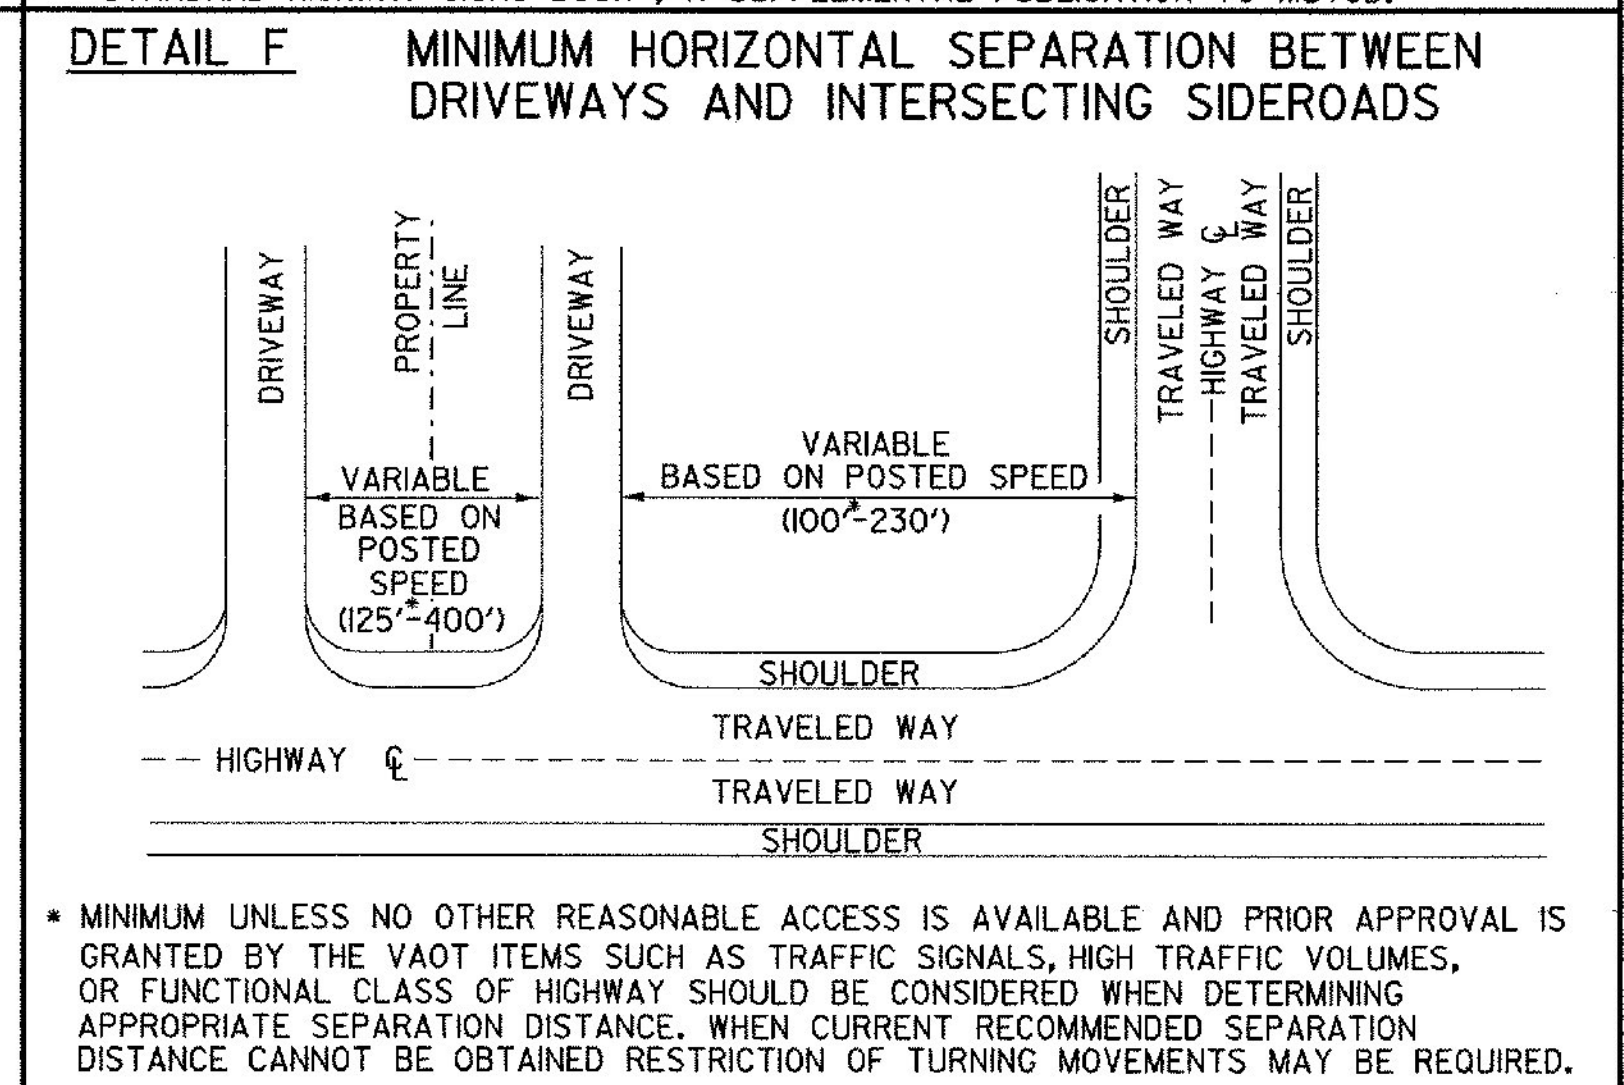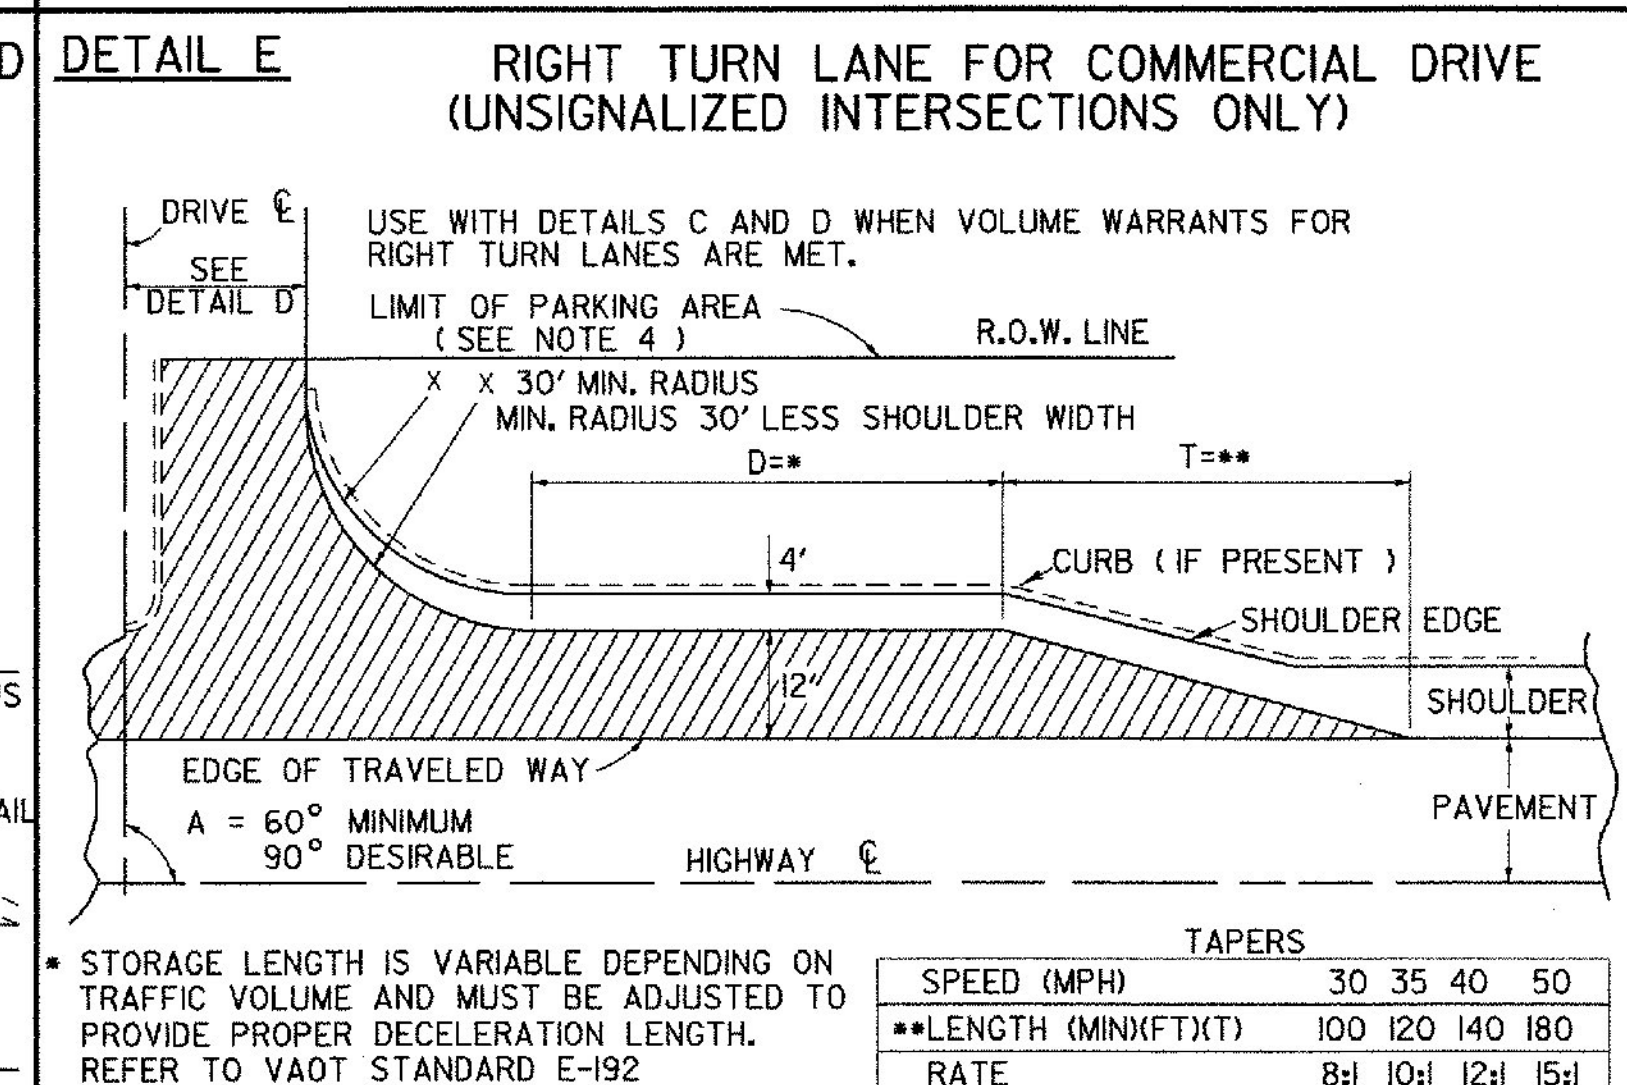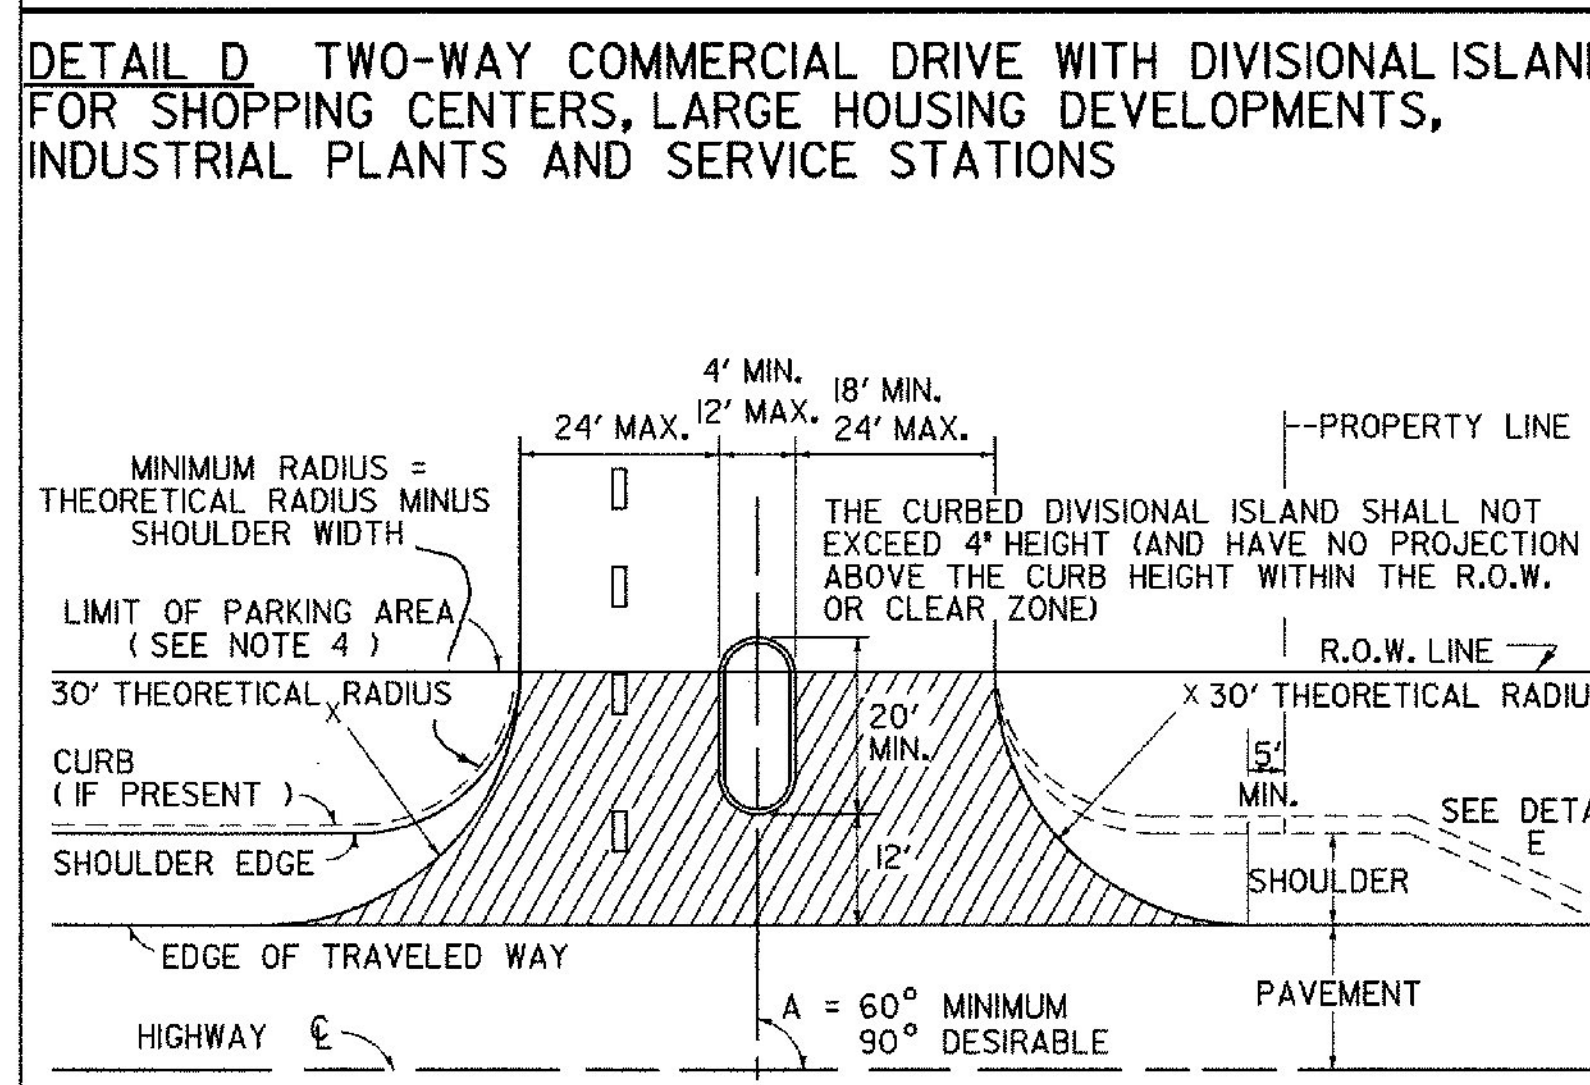

SIGHT DISTANCE CHART

POSTED SPEED OR DESIGN SPEED (M.P.H.)	MINIMUM STOPPING SIGHT DISTANCE (FT)	MINIMUM INTERSECTION SIGHT DISTANCE * (FT)
25	155	280
30	200	335
35	250	390
40	305	445
45	360	500
50	425	555
55	495	610
60	570	665
65	645	720

THE ABOVE VALUES ARE TAKEN FROM THE 2004 AASHTO "A POLICY ON GEOMETRIC DESIGN OF HIGHWAYS & STREETS."

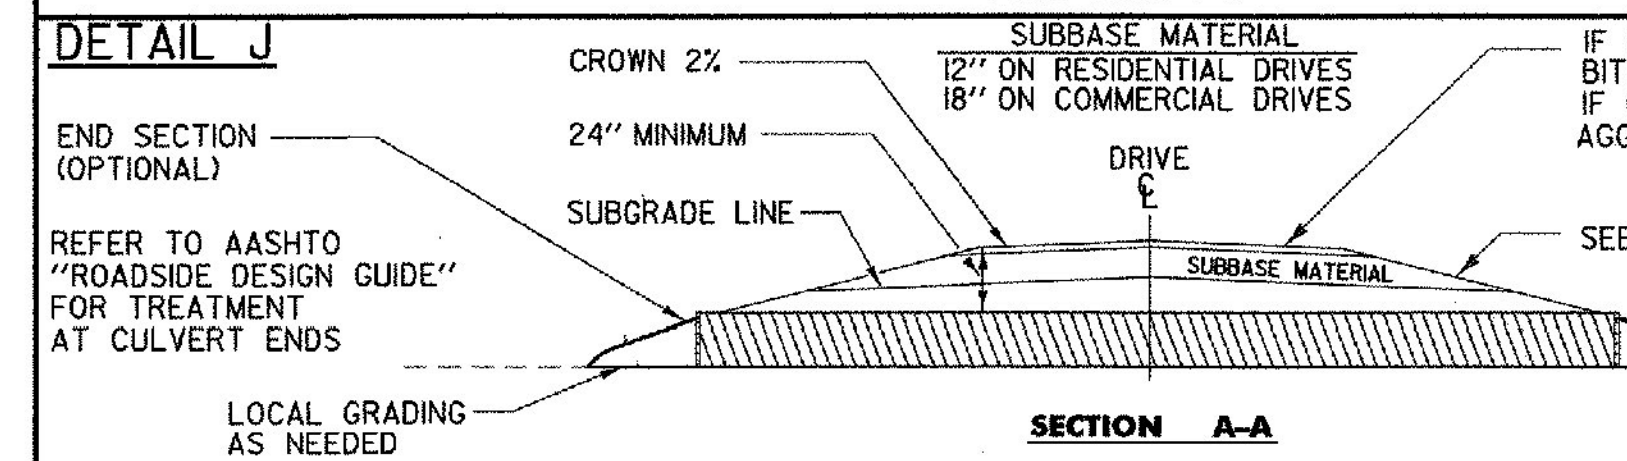

- REVISIONS AND CORRECTIONS**
- DEC. 11, 1992 - THIS STANDARD SUPERCEDES B-71(7/23/80R), B-71A (3/12/90), AND B-13 (12/14/71).
 - JUNE 1, 1994 - REISSUED, WITHOUT CHANGE, UNDER NEW SIGNATURES.
 - MAR. 10, 1995 - REISSUED, WITHOUT CHANGE, UNDER NEW SIGNATURES.
 - NOV. 16, 2000 - CHANGES MADE TO CONFORM WITH LANGUAGE AND DIMENSIONS IN ACCESS MANAGEMENT PROGRAM GUIDELINES.
 - FEB 1, 2004 - CHANGES MADE TO SIGHT DISTANCE CHART TO CONFORM WITH NEWEST AASHTO CRITERIA.
 - JULY 8, 2005 - CHANGE MADE TO OBJECT HEIGHT TO CONFORM WITH NEWEST AASHTO CRITERIA


APPROVED




Richard F. ...
DIRECTOR OF PROGRAM DEVELOPMENT

Wray S. ...
CHIEF OF UTILITIES AND PERMITS



Michael ...
FEDERAL HIGHWAY ADMINISTRATION

STANDARDS FOR RESIDENTIAL AND COMMERCIAL DRIVES

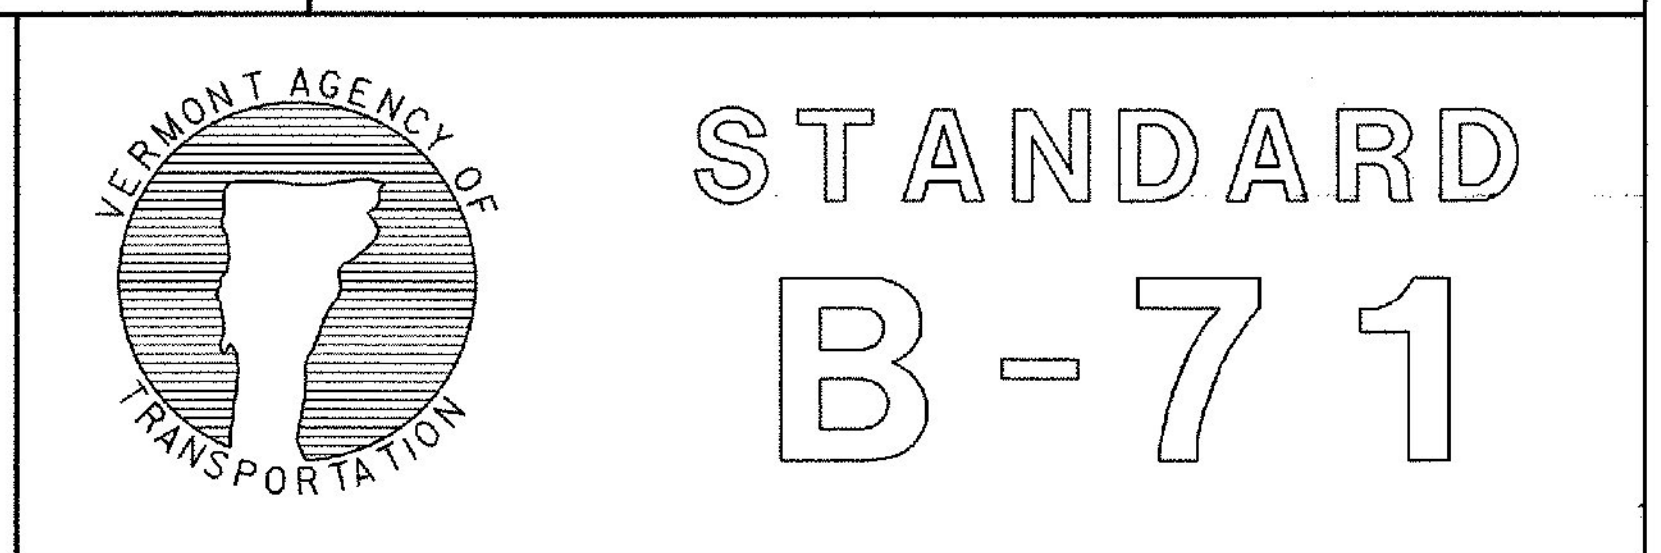

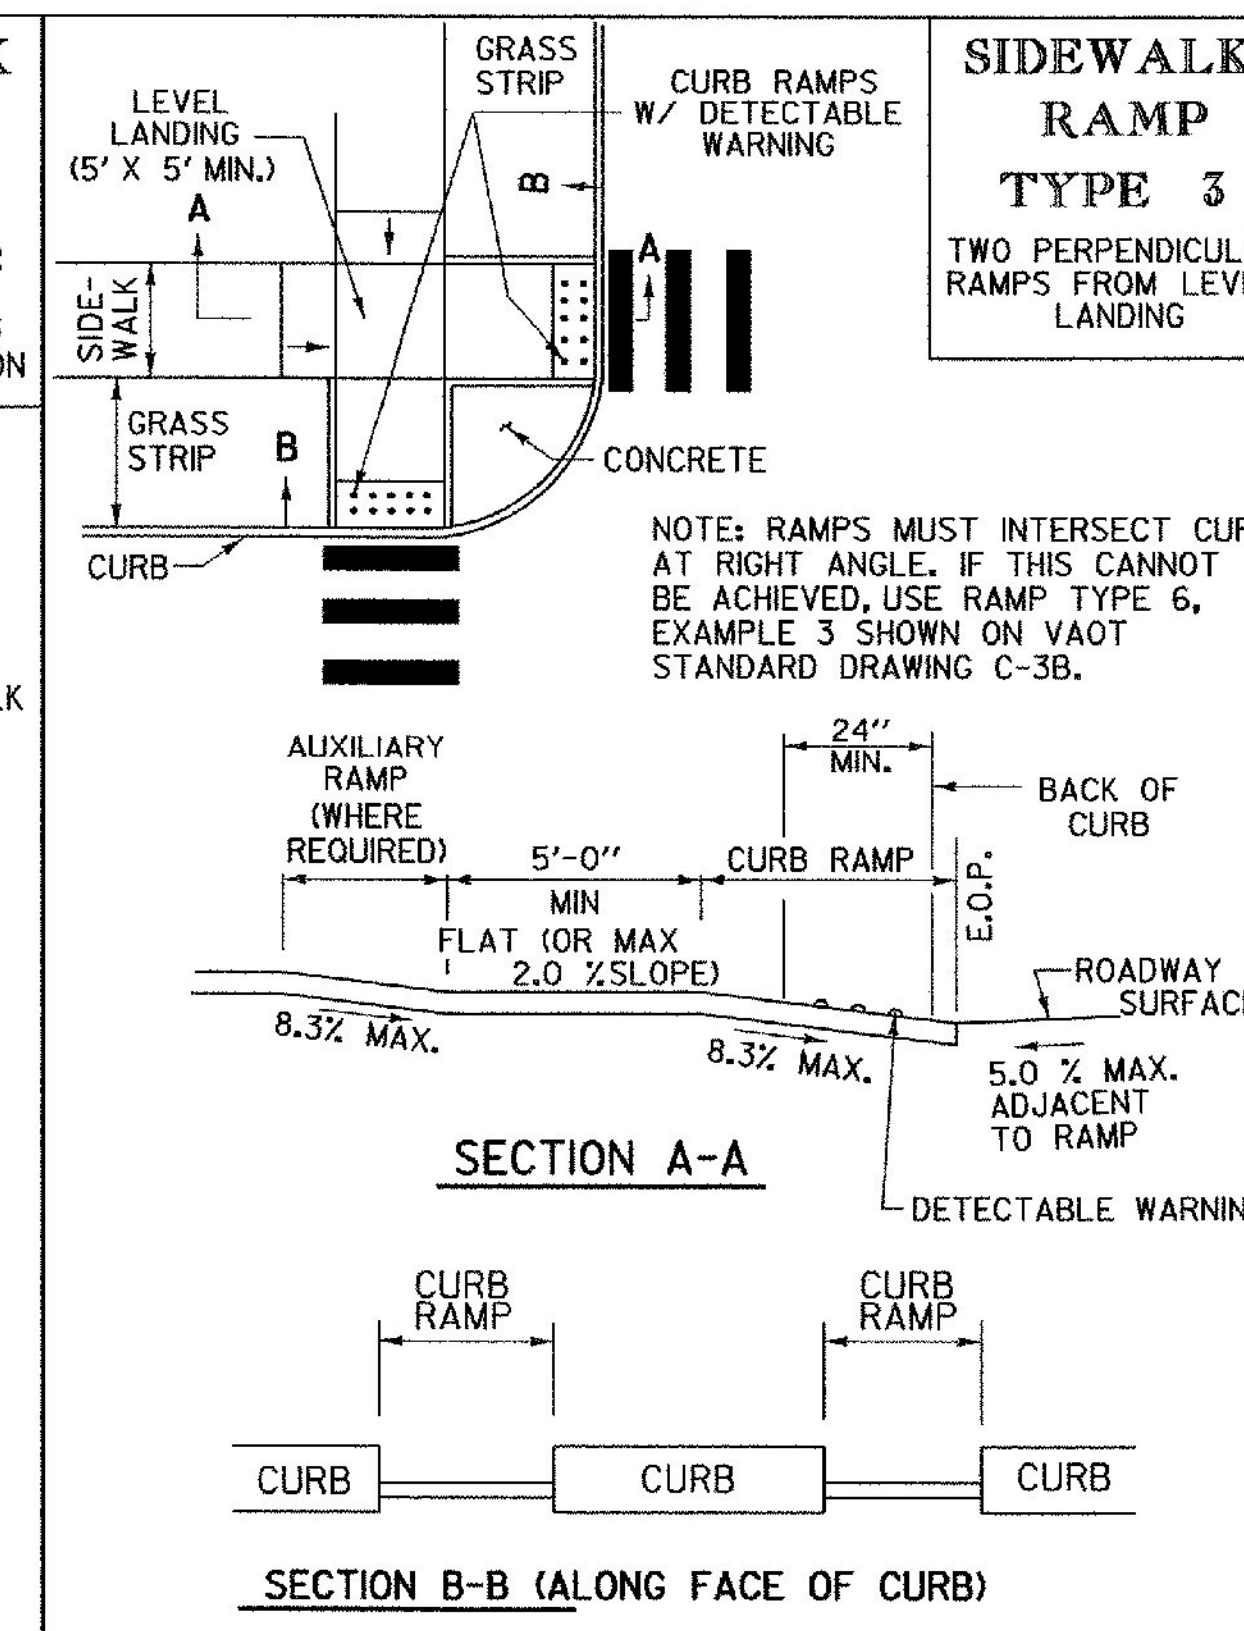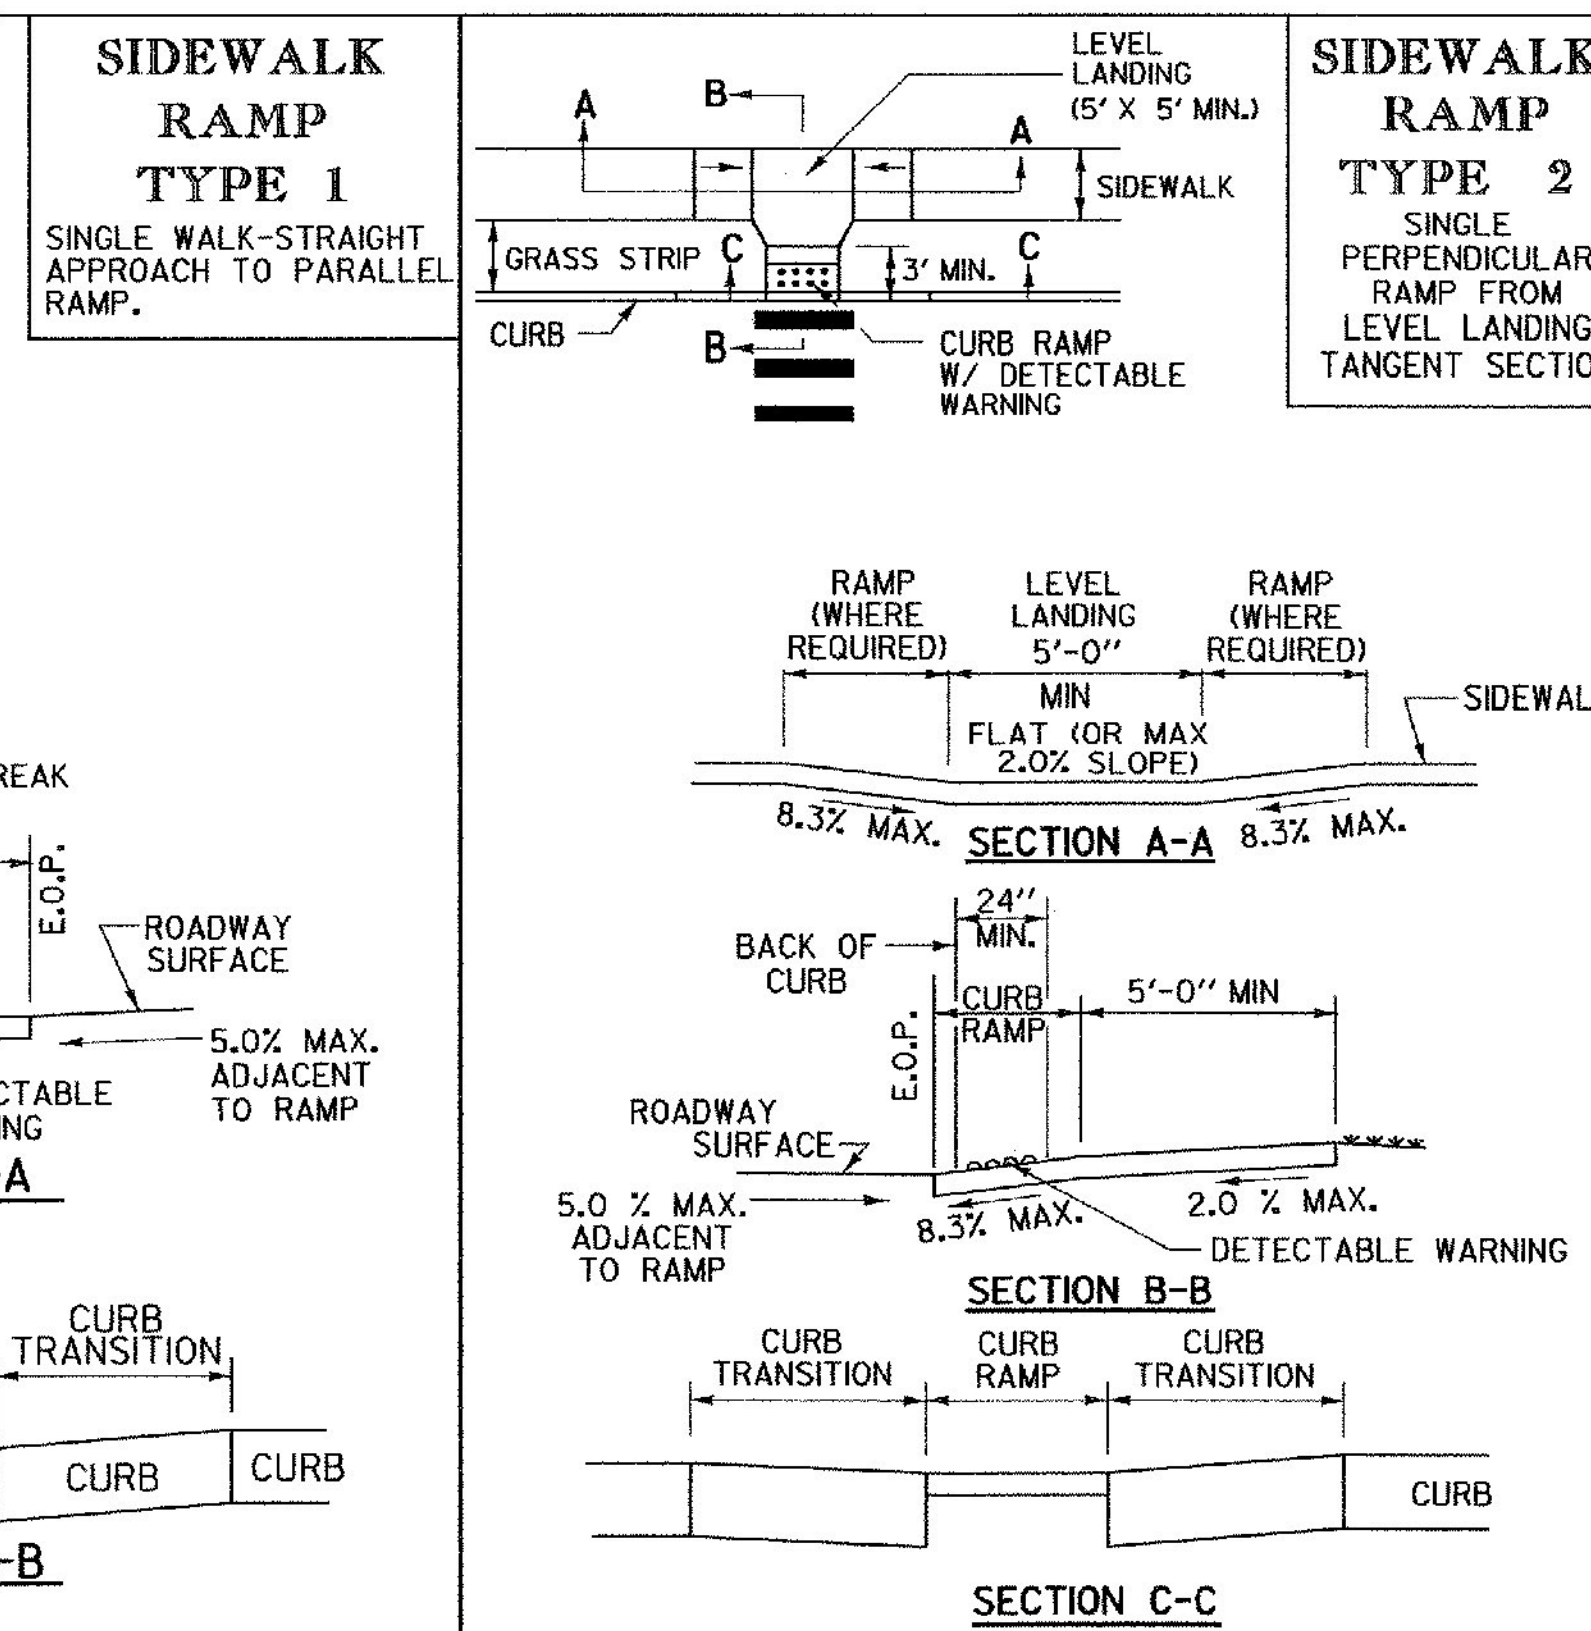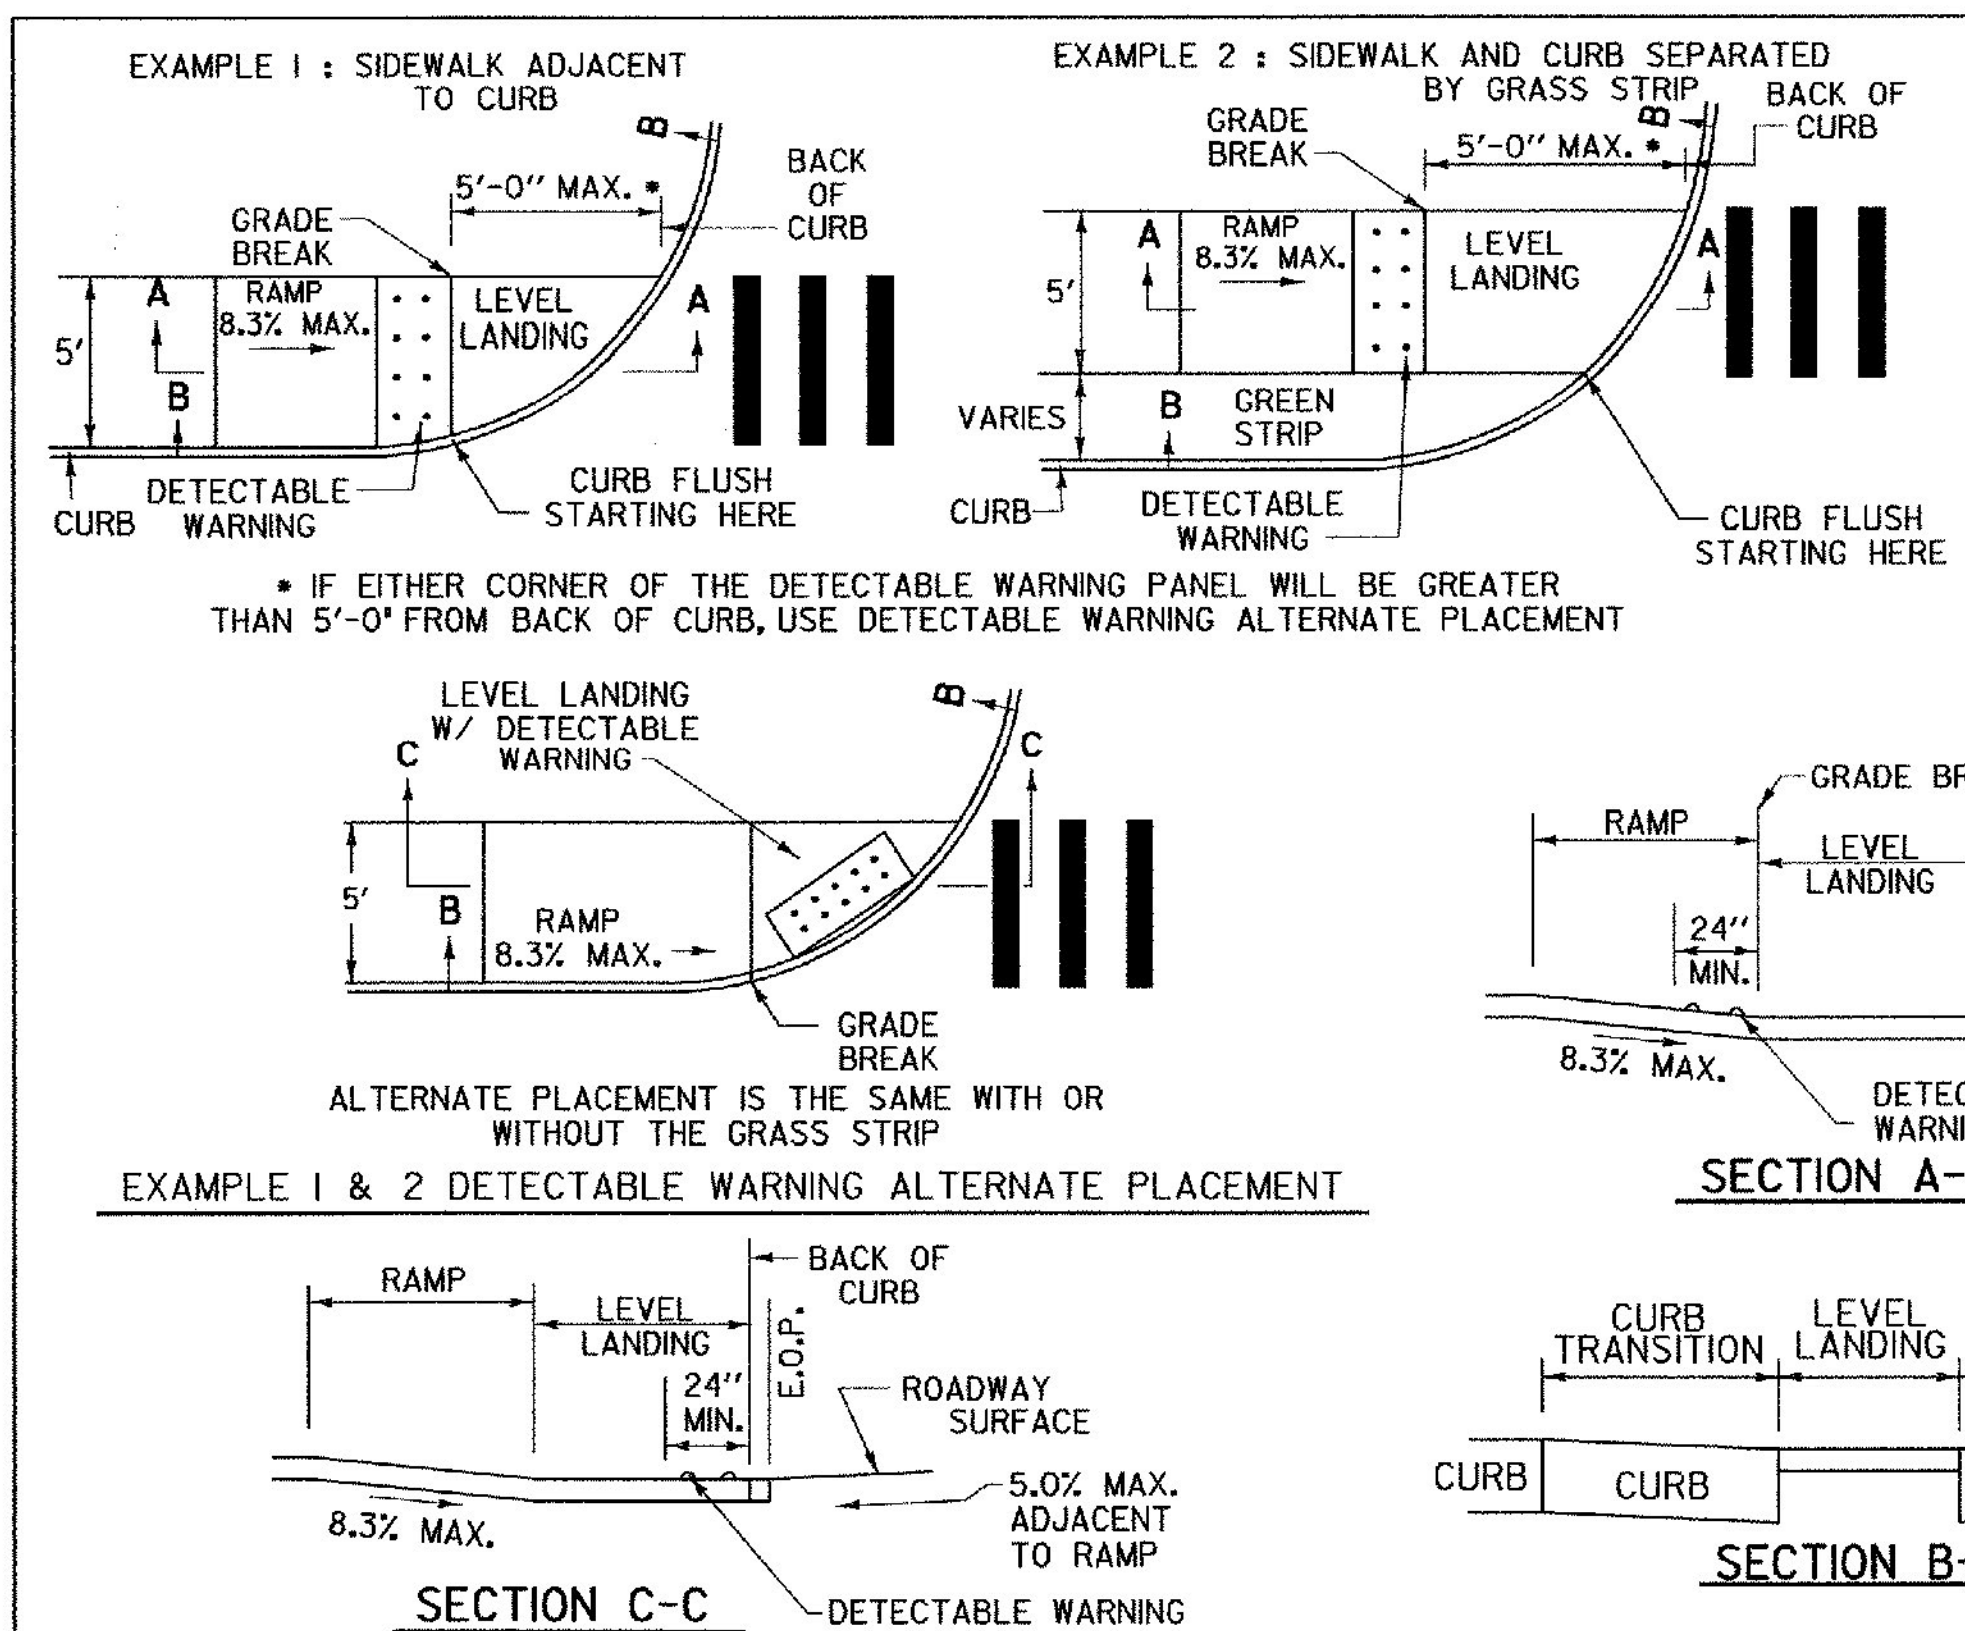

- GENERAL NOTES:**
- THE DIMENSIONS AND GRADES SHOWN ON THIS STANDARD WILL BE ADHERED TO IN THE DESIGN AND THE CONSTRUCTION OF SIDEWALK RAMP. WHERE SIDEWALKS RUN ADJACENT TO ROADWAYS ON STEEP (5% OR GREATER) GRADES, RAMP GRADES WILL BE AS FLAT AS POSSIBLE. (ON LOW SIDE OF DRIVES AND INTERSECTING SIDE STREETS, RAMP SHALL SLOPE TOWARDS DRIVE OR SIDE STREET @ 2%.)
 - NOMINAL RAMP DIMENSIONS AND GRADES:
RAMP WIDTH - 4'-0" MINIMUM
RAMP SLOPE - 8.3% MAXIMUM
FLARE SLOPE - 10% MAXIMUM
RAMP CROSS SLOPE - 2.0% MAXIMUM
 - A LEVEL LANDING (NO GREATER THAN 2.0% SLOPE IN ANY DIRECTION) SHALL BE PROVIDED AT THE TOP OF SIDEWALK RAMP TO ALLOW FOR STOPPING AND MANEUVERING OF WHEELCHAIRS.
 - LEVEL LANDINGS (NO GREATER THAN 2.0% SLOPE IN ANY DIRECTION) AT THE BOTTOM OF PERPENDICULAR RAMP SHALL BE WHOLLY CONTAINED WITHIN MARKED CROSSWALKS.
 - DUMMY JOINTS SHALL BE PROVIDED AT TRANSITIONS (GRADE CHANGES) AT TOPS AND BOTTOMS OF RAMP AND FLARES.
 - VERTICAL DROP-OFF EDGES TO RAMP WILL NOT BE BUILT UNLESS THE RAMP ABUTS AN AREA WHICH WILL NOT BE USED BY PEDESTRIANS.
 - NO VERTICAL "LIP" OR "CURB REVEAL" WILL BE PROVIDED WHERE THE RAMP ADJOINS THE ROADWAY.
 - AT MARKED CROSSWALKS, THE FULL WIDTH OF THE RAMP OR LANDING SHALL BE CONTAINED WITHIN THE PAVEMENT MARKINGS.
 - WHERE POSSIBLE, RAMP FLARES SHOULD BE LOCATED OUTSIDE THE DIRECT LINE OF TRAVEL MOST LIKELY TO BE FOLLOWED BY THE VISUALLY IMPAIRED.
 - SIGNS, POLES, PLANTERS, MAILBOXES, ETC. SHALL NOT BE LOCATED WHERE THEY WILL INTERFERE WITH THE USE OF SIDEWALK RAMP.
 - WHERE POSSIBLE, SIDEWALK RAMP SHOULD NOT BE LOCATED WHERE USERS MUST CROSS DROP INLET GRATES, MANHOLE COVERS OR OTHER ACCESS LIDS. IF THIS CANNOT BE AVOIDED THEN GRATE DESIGN AND PLACEMENT SHALL CONFORM TO ADA REQUIREMENTS.
 - CURB DRAINAGE SHOULD BE CONSTRUCTED SO AS TO PRECLUDE THE FLOW OF WATER PAST THE SIDEWALK RAMP.
 - WHEREVER FEASIBLE, TWO SIDEWALK RAMP ARE RECOMMENDED IN PREFERENCE TO A SINGLE RAMP.
 - JOINTS WILL BE CONSTRUCTED IN ACCORDANCE WITH CURRENT SIDEWALK SPECIFICATIONS, HOWEVER EXPANSION JOINTS WITHIN THE SIDEWALK RAMP AREA WILL BE AVOIDED WHEREVER POSSIBLE.
 - SIDEWALKS THAT ARE LESS THAN 5' WIDE REQUIRE 5' WIDE BY 5' LONG PASSING AREAS (NO GREATER THAN 2.0% CROSS SLOPE) AT INTERVALS NOT TO EXCEED 200 FEET.
 - E.O.P. = EDGE OF PAVEMENT
 - THE PUBLIC SIDEWALK CURB RAMP STANDARDS DEPICTED HERE MAY NOT BE APPROPRIATE FOR ALL LOCATIONS. FIELD CONDITIONS AT INDIVIDUAL LOCATIONS MAY REQUIRE SPECIFIC DESIGNS. DESIGNS MUST BE CONSISTENT WITH THE PROVISIONS OF THIS SHEET TO THE MAXIMUM EXTENT FEASIBLE ON ALTERATION PROJECTS AND WHEN STRUCTURALLY PRACTICABLE ON NEW CONSTRUCTION PROJECTS AS REQUIRED BY THE AMERICANS WITH DISABILITIES ACT ACCESSIBILITY GUIDELINES.
 - IF ANY PORTION OF THE EDGE OF THE DETECTABLE WARNING CLOSEST TO THE CURB WILL BE GREATER THAN 5'-0" FROM THE BACK OF CURB, THEN THE PANEL(S) SHALL BE LOCATED ON THE LEVEL LANDING AS CLOSE TO PARALLEL TO THE CURB LINE AS POSSIBLE.
- OTHER STANDARDS REQUIRED: C-2A, C-2B, C-3B AND C-10

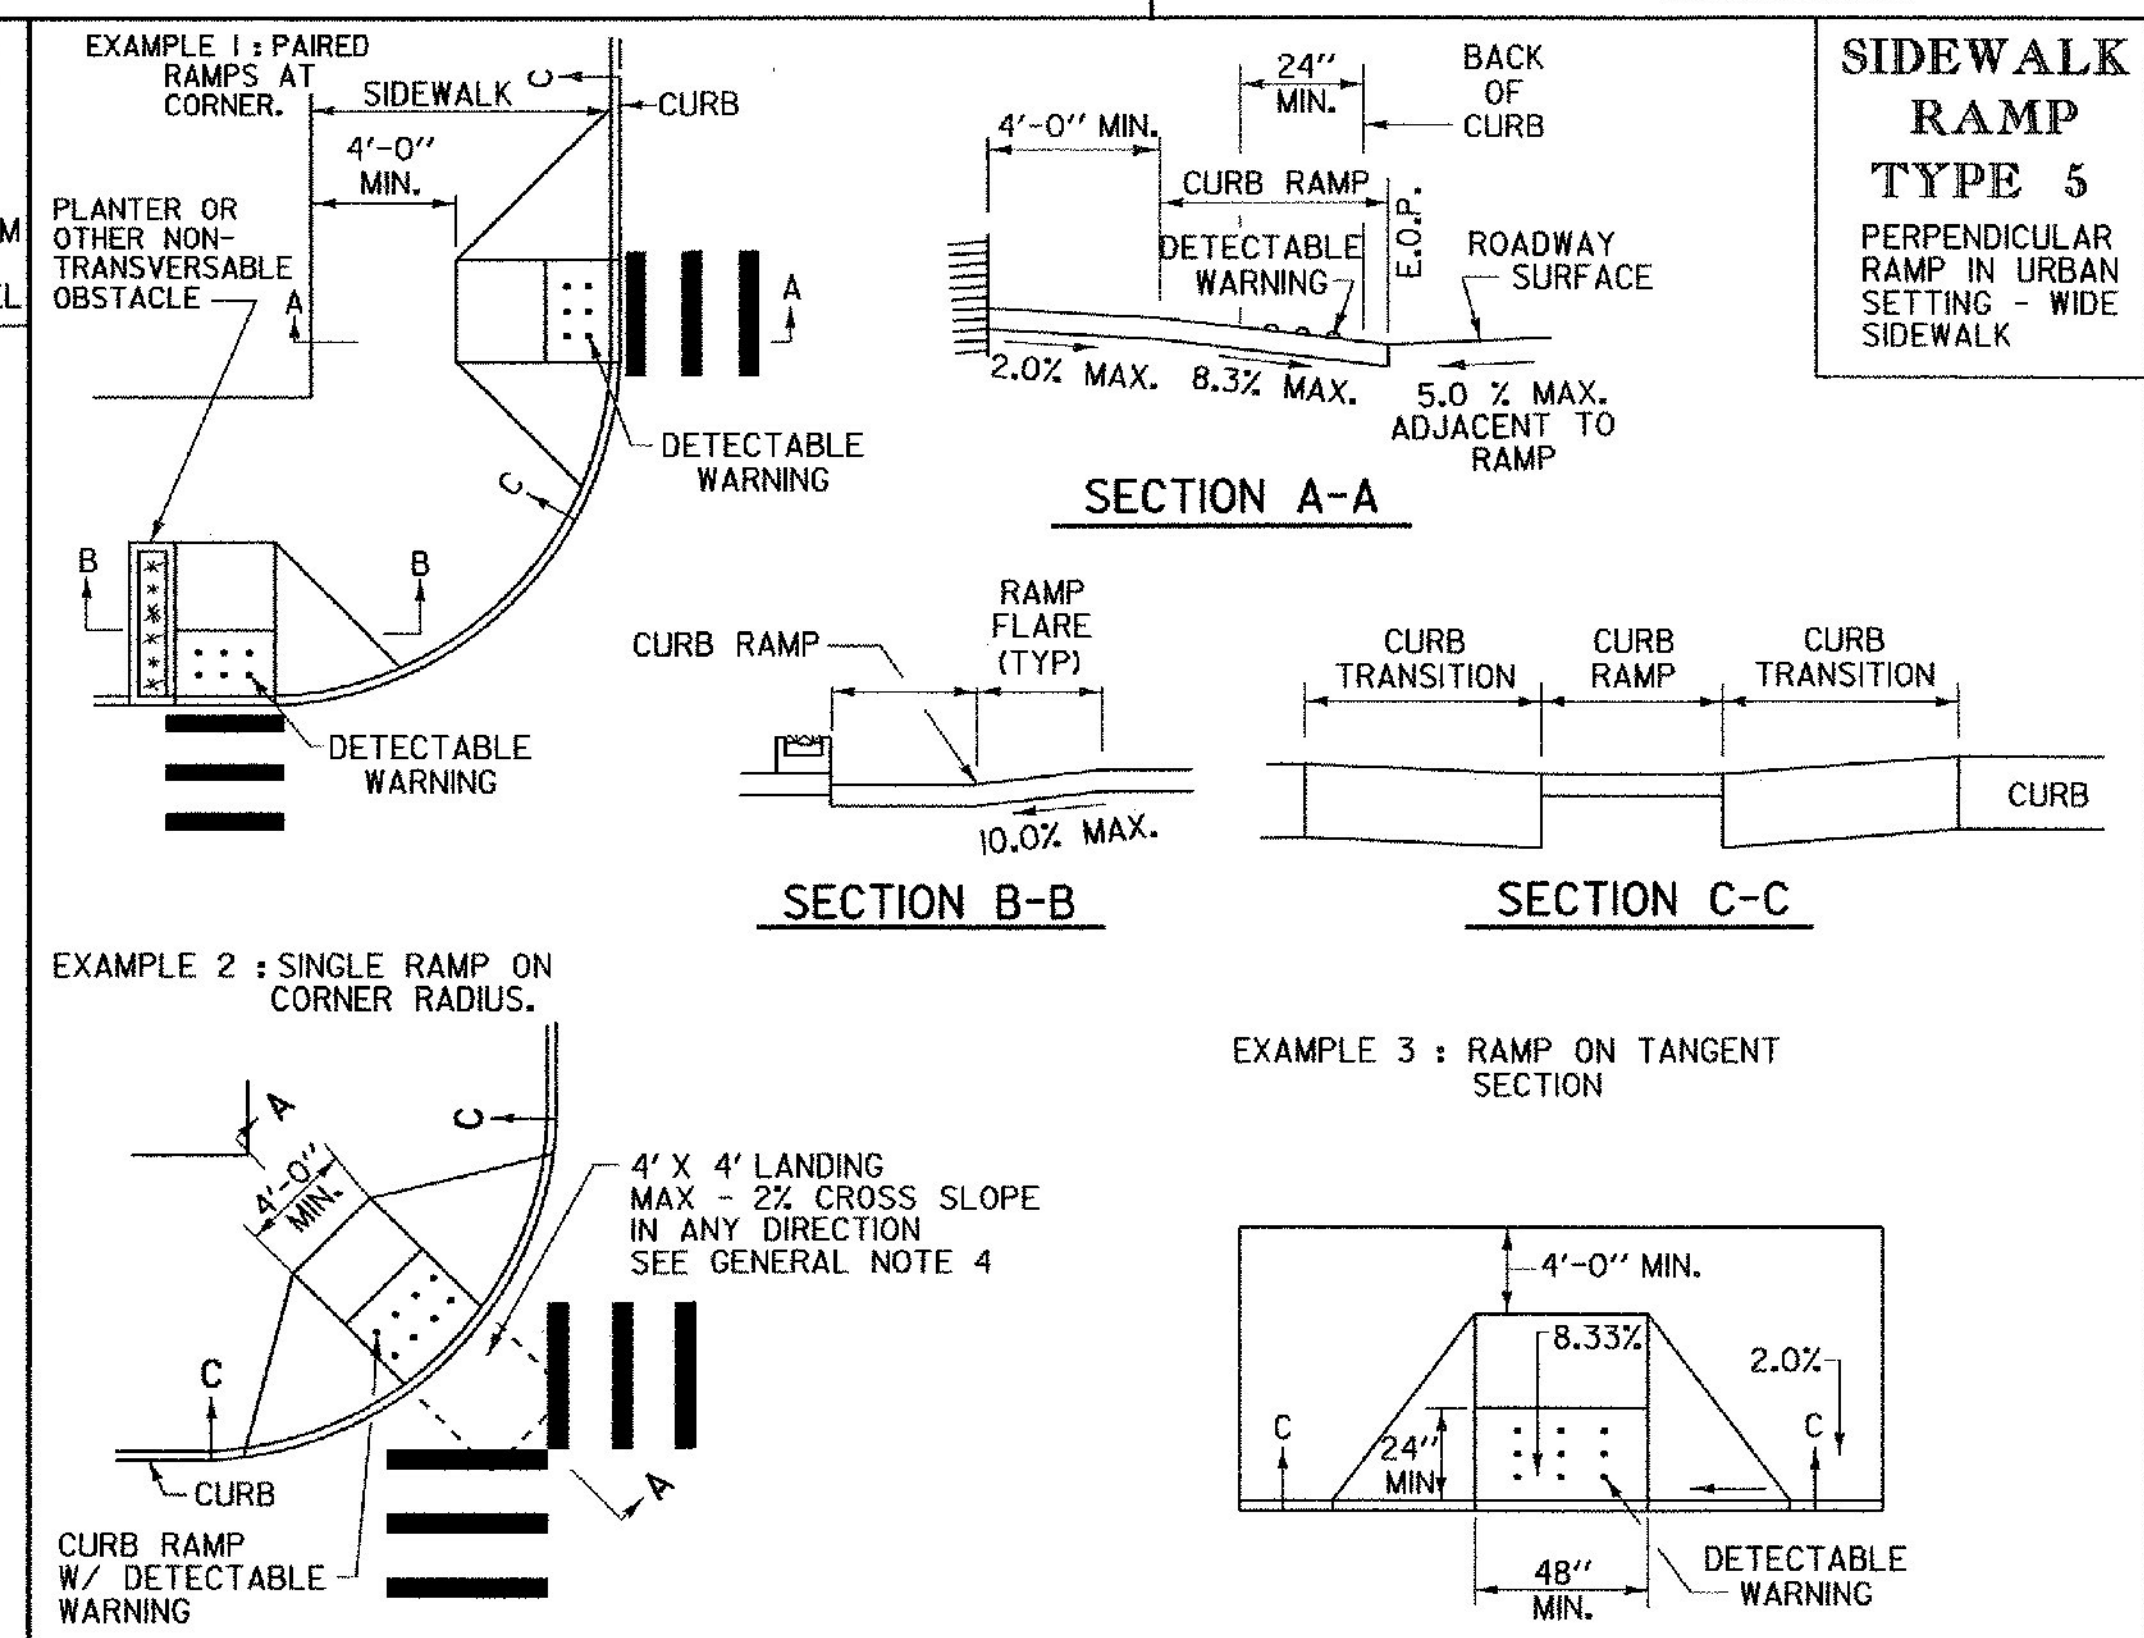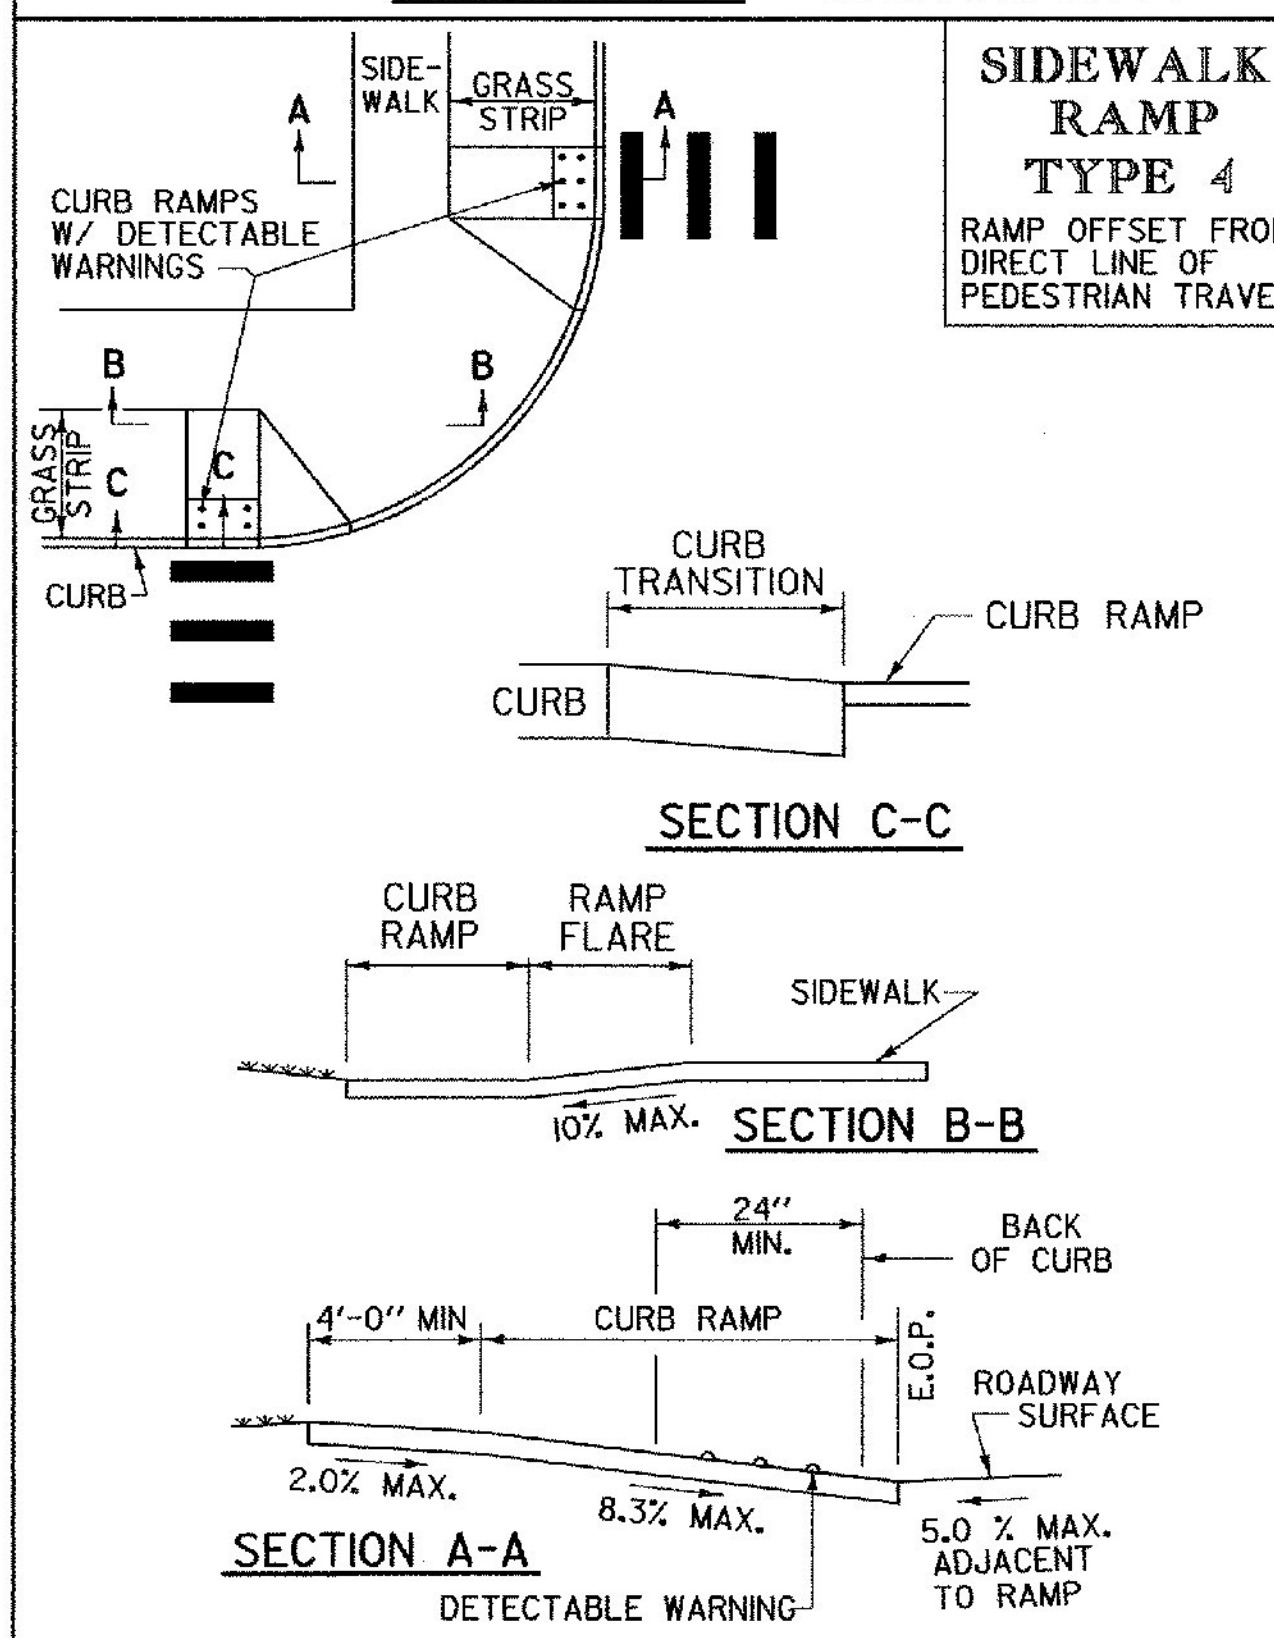

REVISIONS AND CORRECTIONS


FEB. 2, 2004 - DATE OF ORIGINAL ISSUE
SEPT. 1, 2004 - MINOR REVISIONS TO COMPLY WITH ADAAG
MAR. 10, 2008 - MINOR REVISIONS TO COMPLY WITH ADA STANDARDS








APPROVED

Alan E. Devan
LOCAL TRANSPORTATION FACILITIES PROGRAM MANAGER

Mark D. Richter
DIRECTOR OF PROGRAM DEVELOPMENT
FEDERAL HIGHWAY ADMINISTRATION

SIDEWALK RAMPS

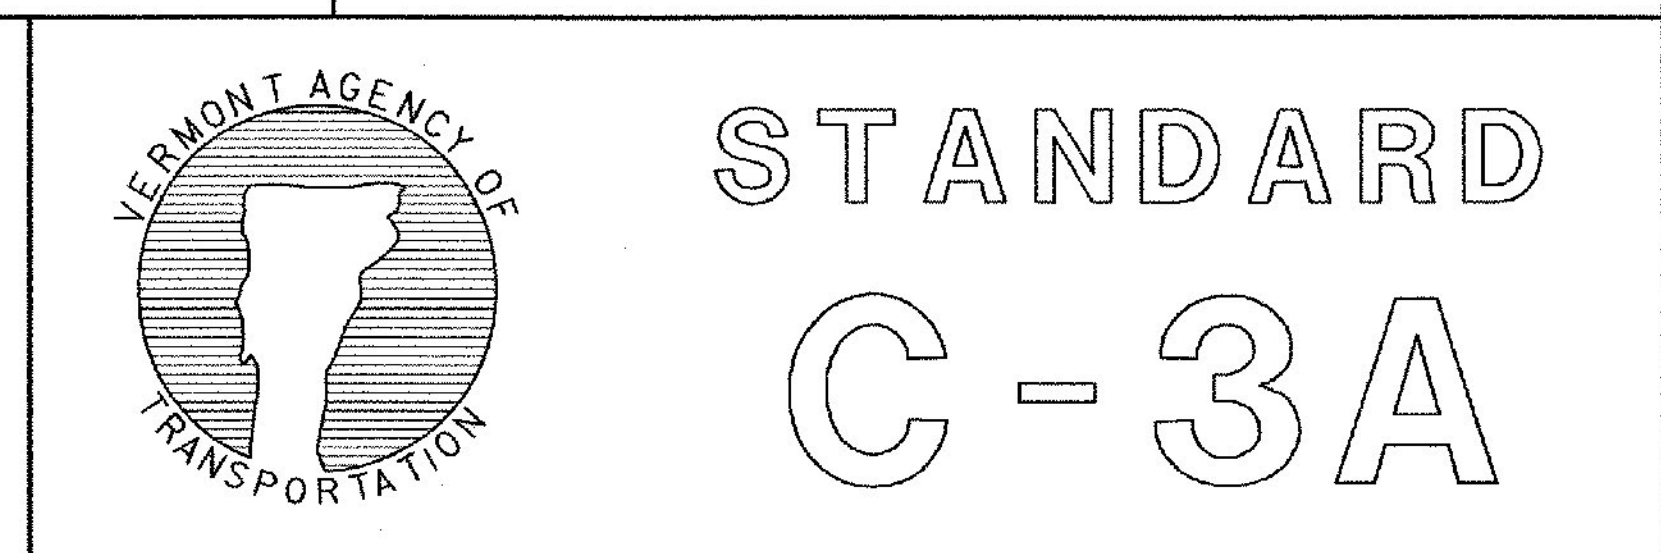

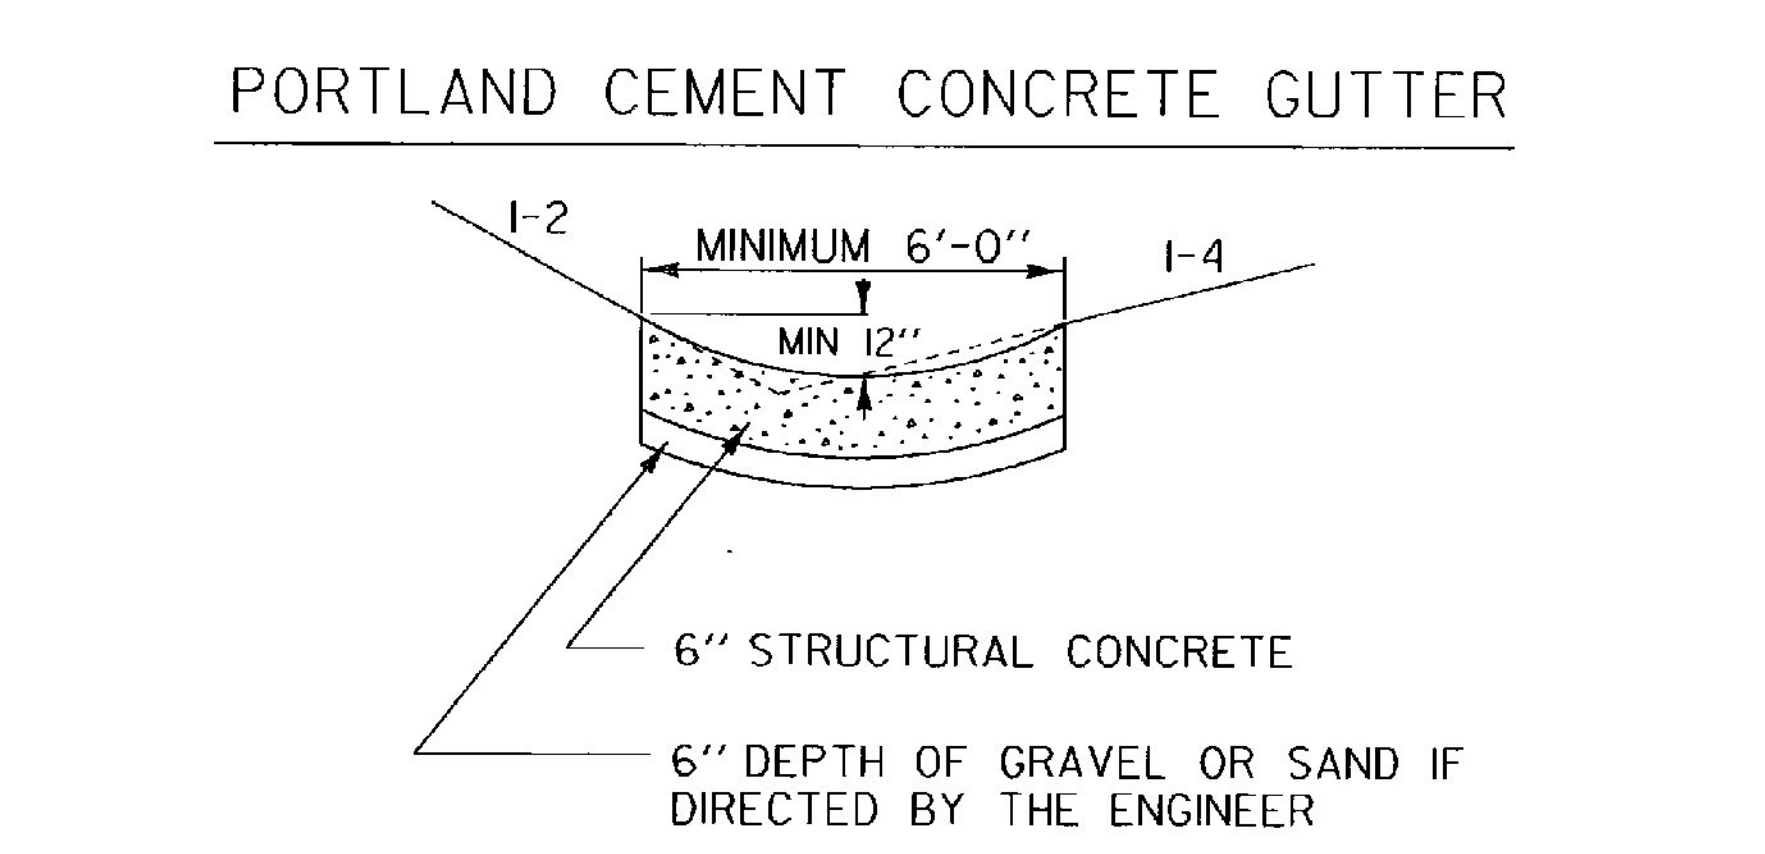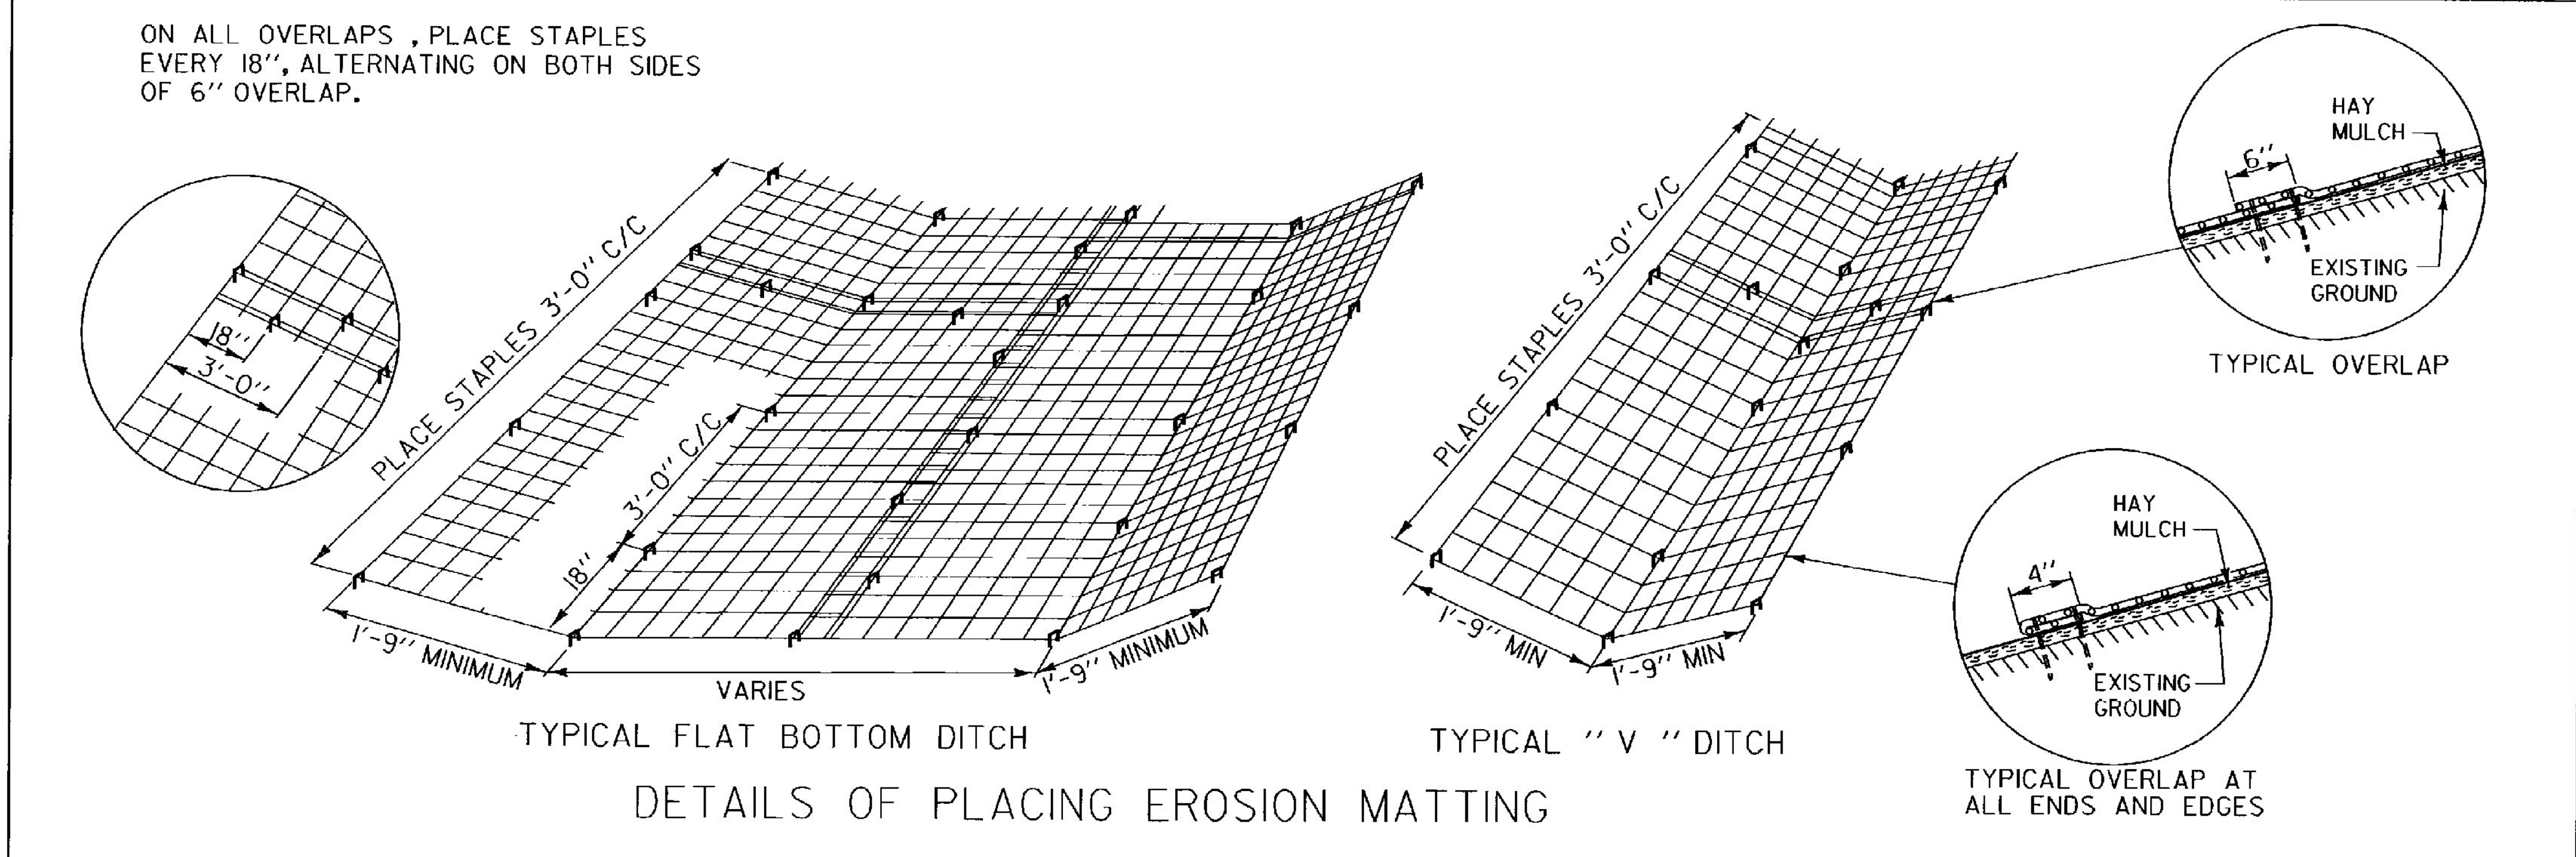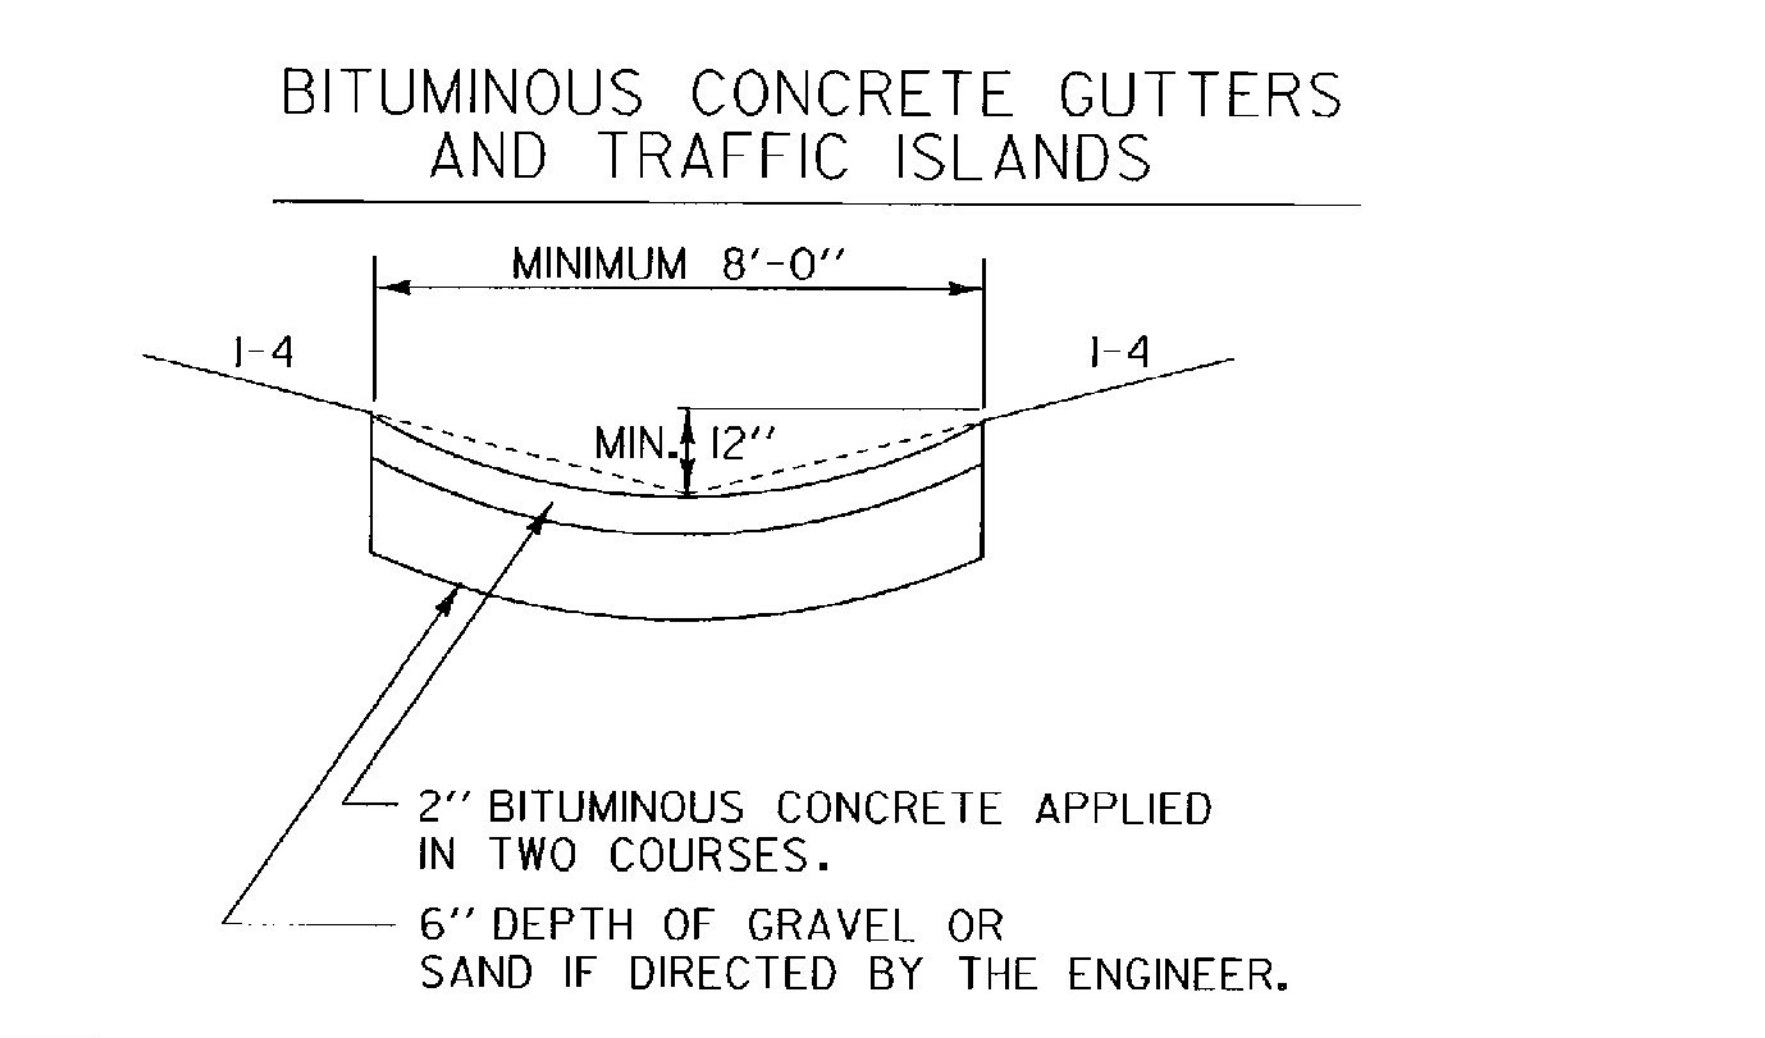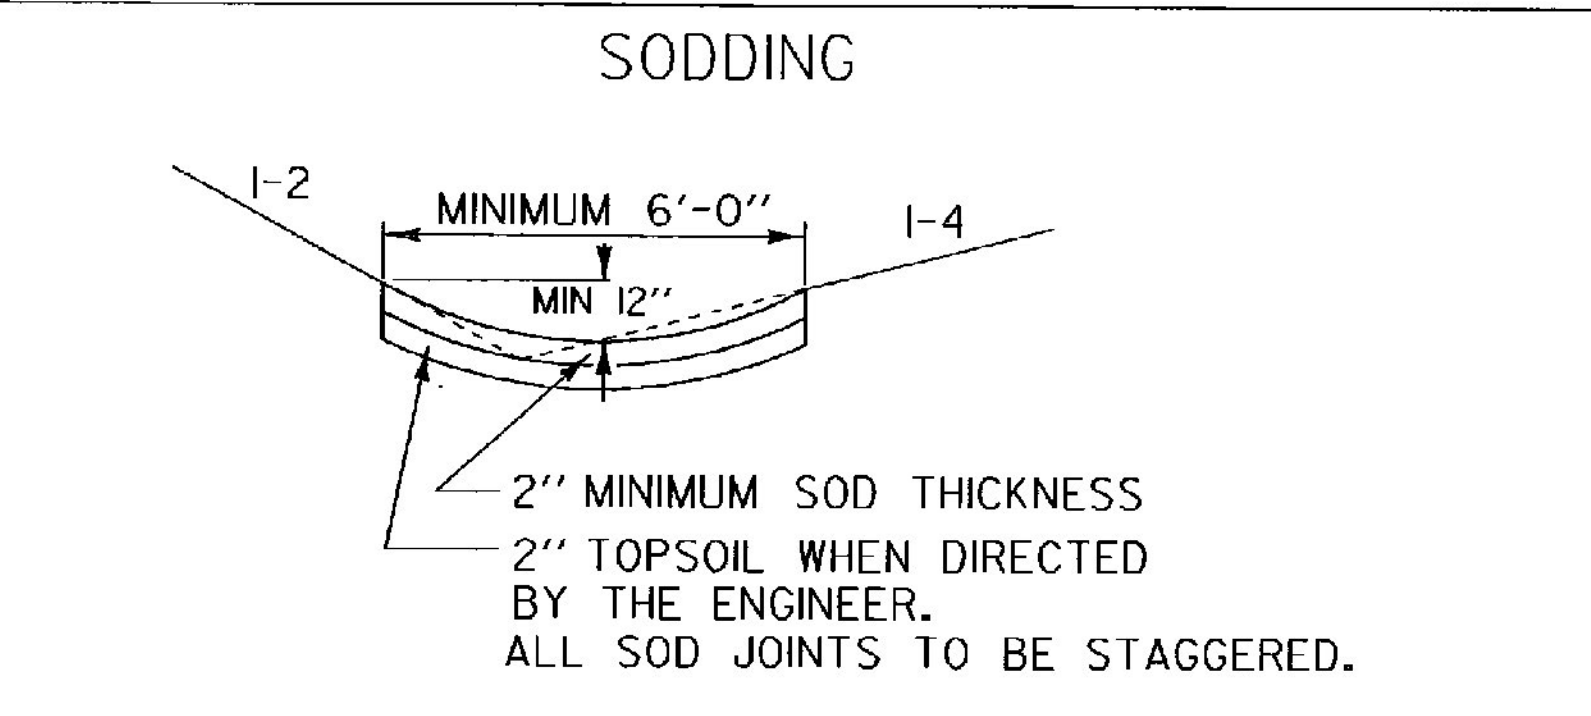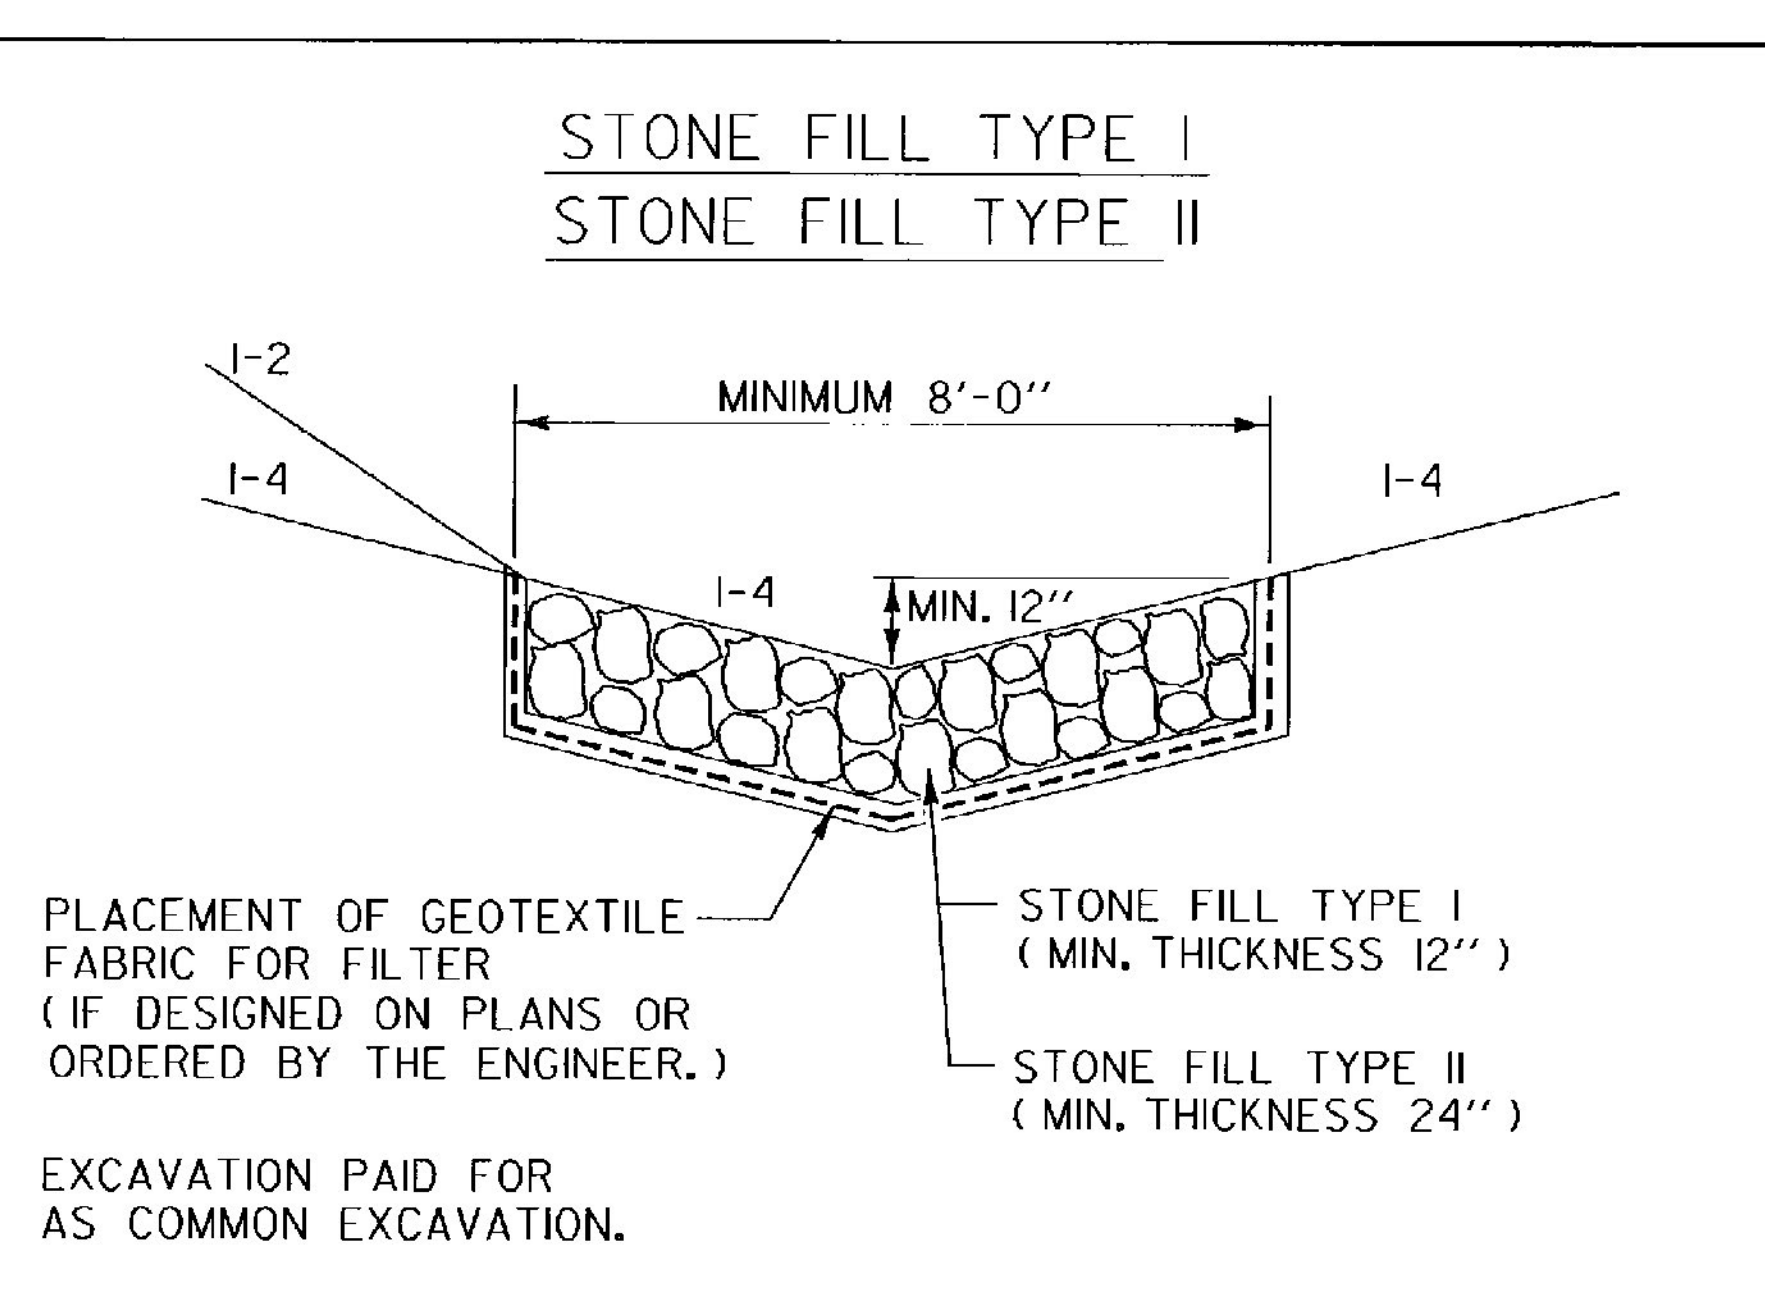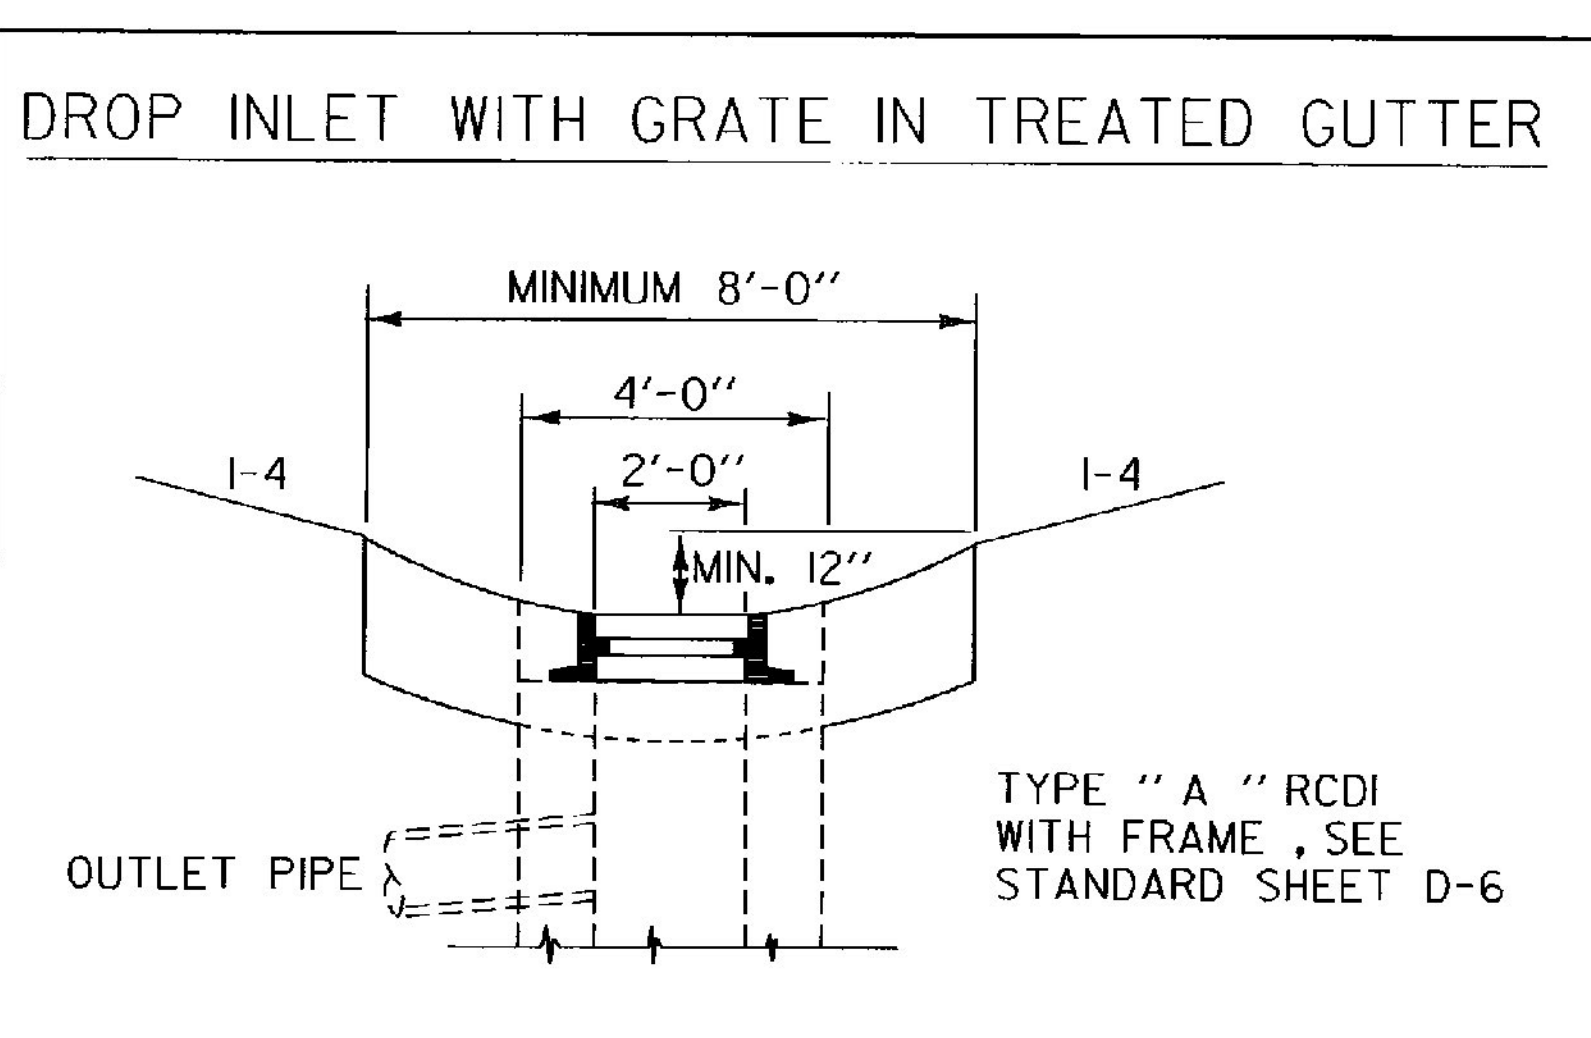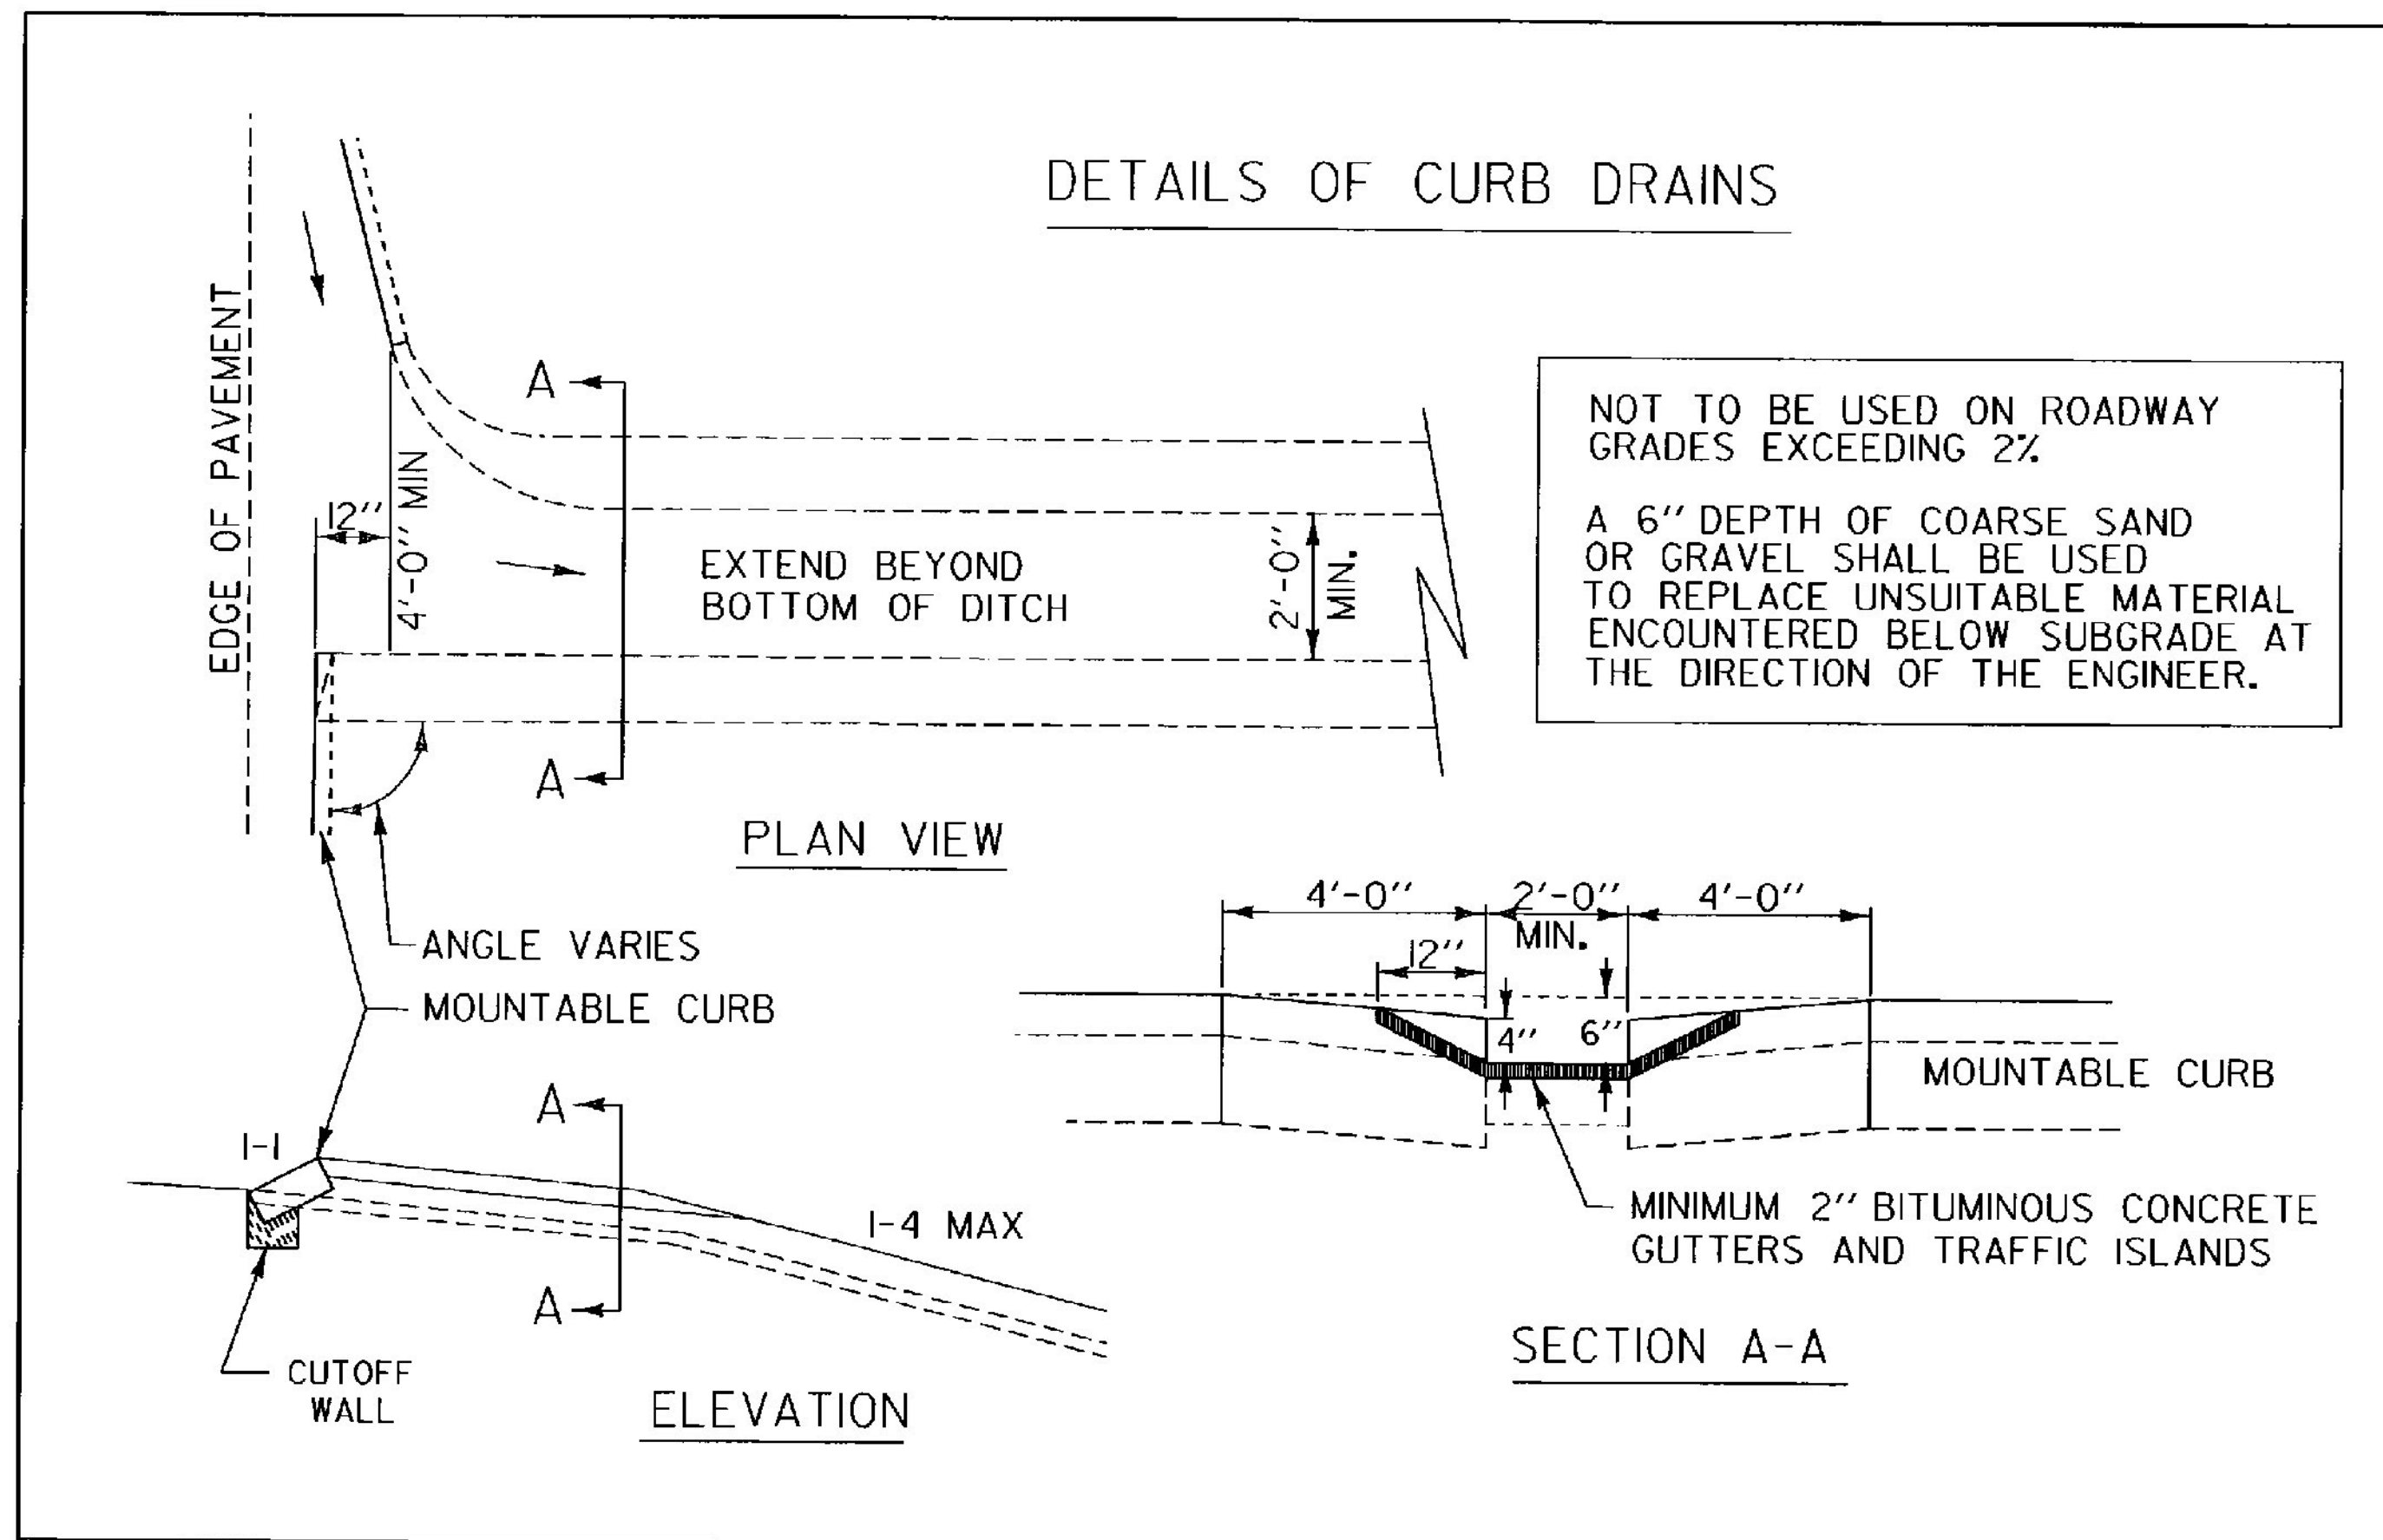

REVISIONS AND CORRECTIONS

APR. 2, 1986 - ORIGINAL APPROVAL DATE

JUNE 1, 1994 - REISSUED, WITHOUT CHANGE, UNDER NEW SIGNATURES.

APPROVED



APPROVED FOR THIS PROJECT AND/OR DESIGN IMPLEMENTATION. FHWA FINAL APPROVAL PENDING.

Stanley W. McNeil, P.E.
DIRECTOR OF ENGINEERING

John M. Murphy, P.E.
DESIGN ENGINEER



TREATED GUTTERS

"W" BEAM GUARDRAIL WITH STEEL POSTS

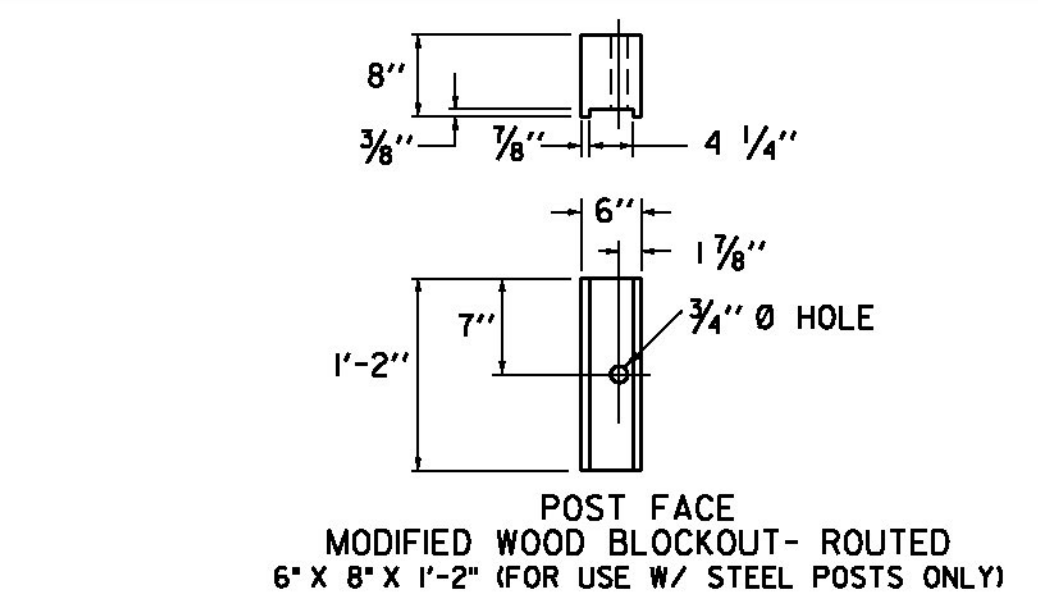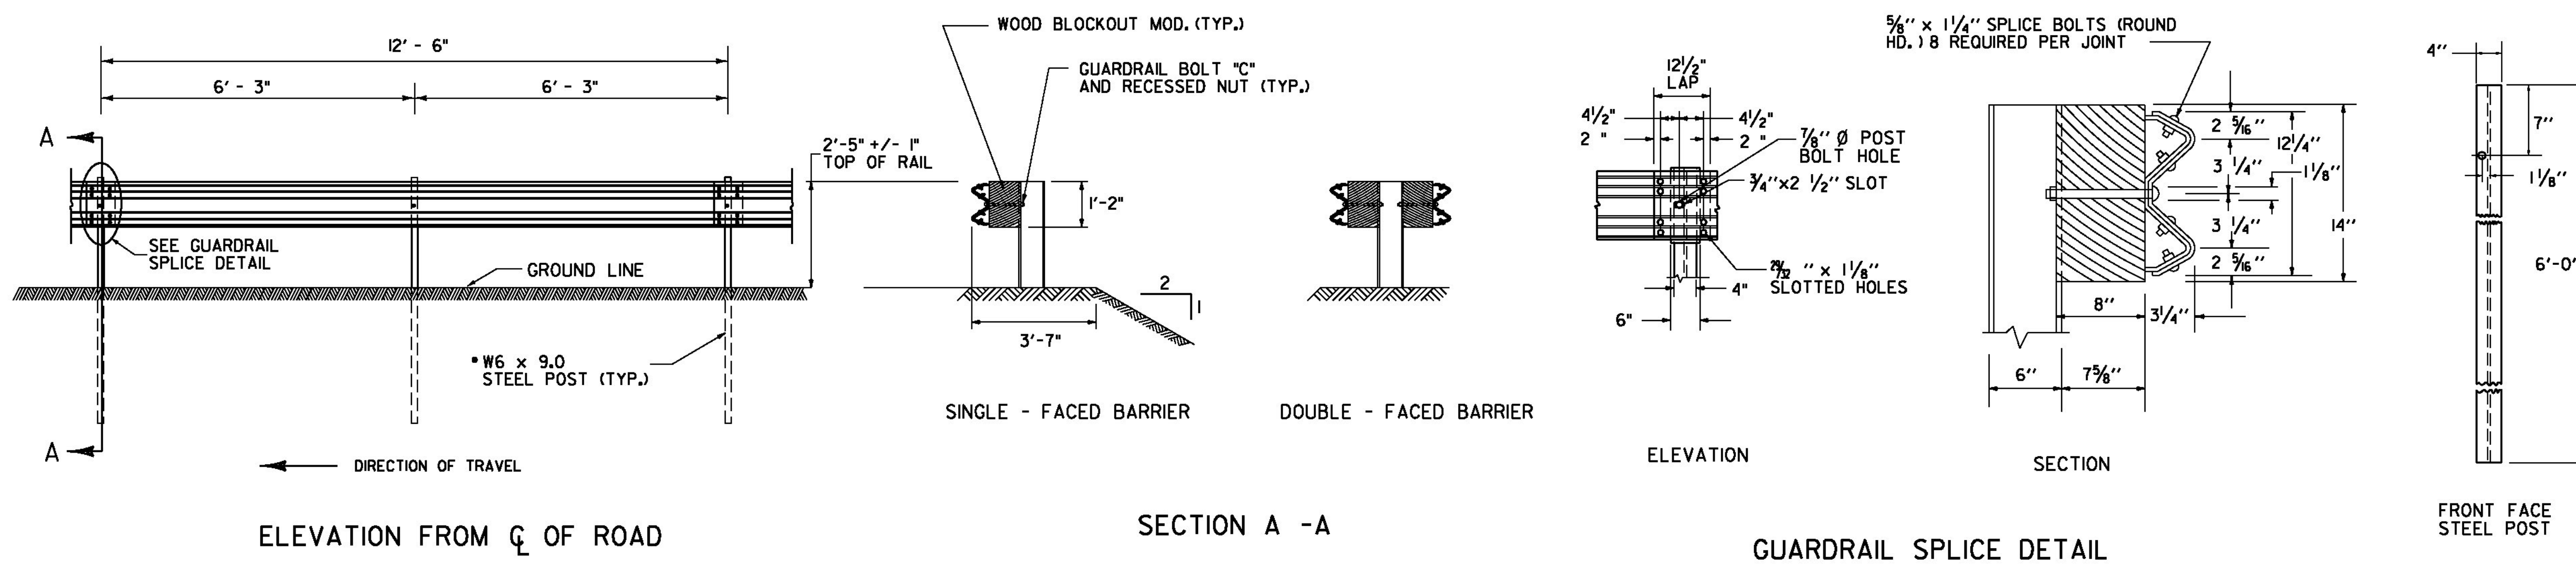


- NOTES:
- BLOCKS SHALL BE MADE OF TIMBER WITH A STRESS GRADE OF 1200 PSI OR MORE. TESTING SHALL BE IN ACCORDANCE WITH WEST COAST LUMBER INSPECTION BUREAU, SOUTHERN PINE INSPECTION BUREAU OR OTHER APPROPRIATE ASSOCIATION. TIMBER FOR BLOCKS SHALL BE ROUGH SAWN (UNPLANED) WITH DIMENSIONS INDICATED. THE SIZE TOLERANCE OF ROUGH SAWN BLOCKS IN THE DIRECTION OF THE BOLT HOLES SHALL BE NOT MORE THAN +/- 1/4".
 - SUPPLY WOOD BLOCKS PER AASHTO M 168.
 - TREAT WITH PRESERVATIVE PER AASHTO M 133.
 - BLOCKOUTS MAY ALSO BE MADE OF APPROVED ALTERNATIVE MATERIAL.

"W" BEAM GUARDRAIL WITH WOOD POSTS

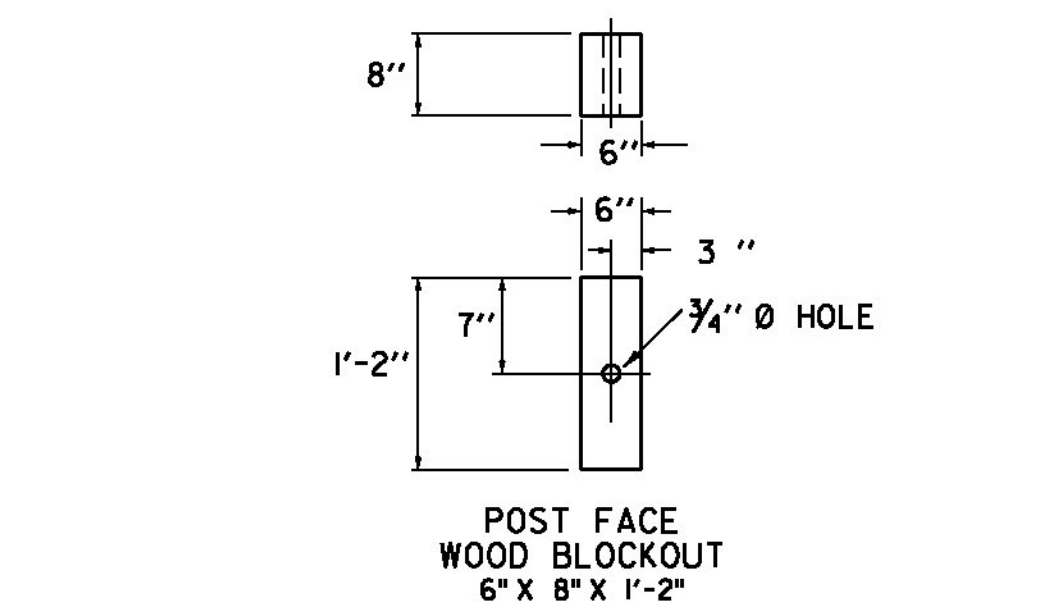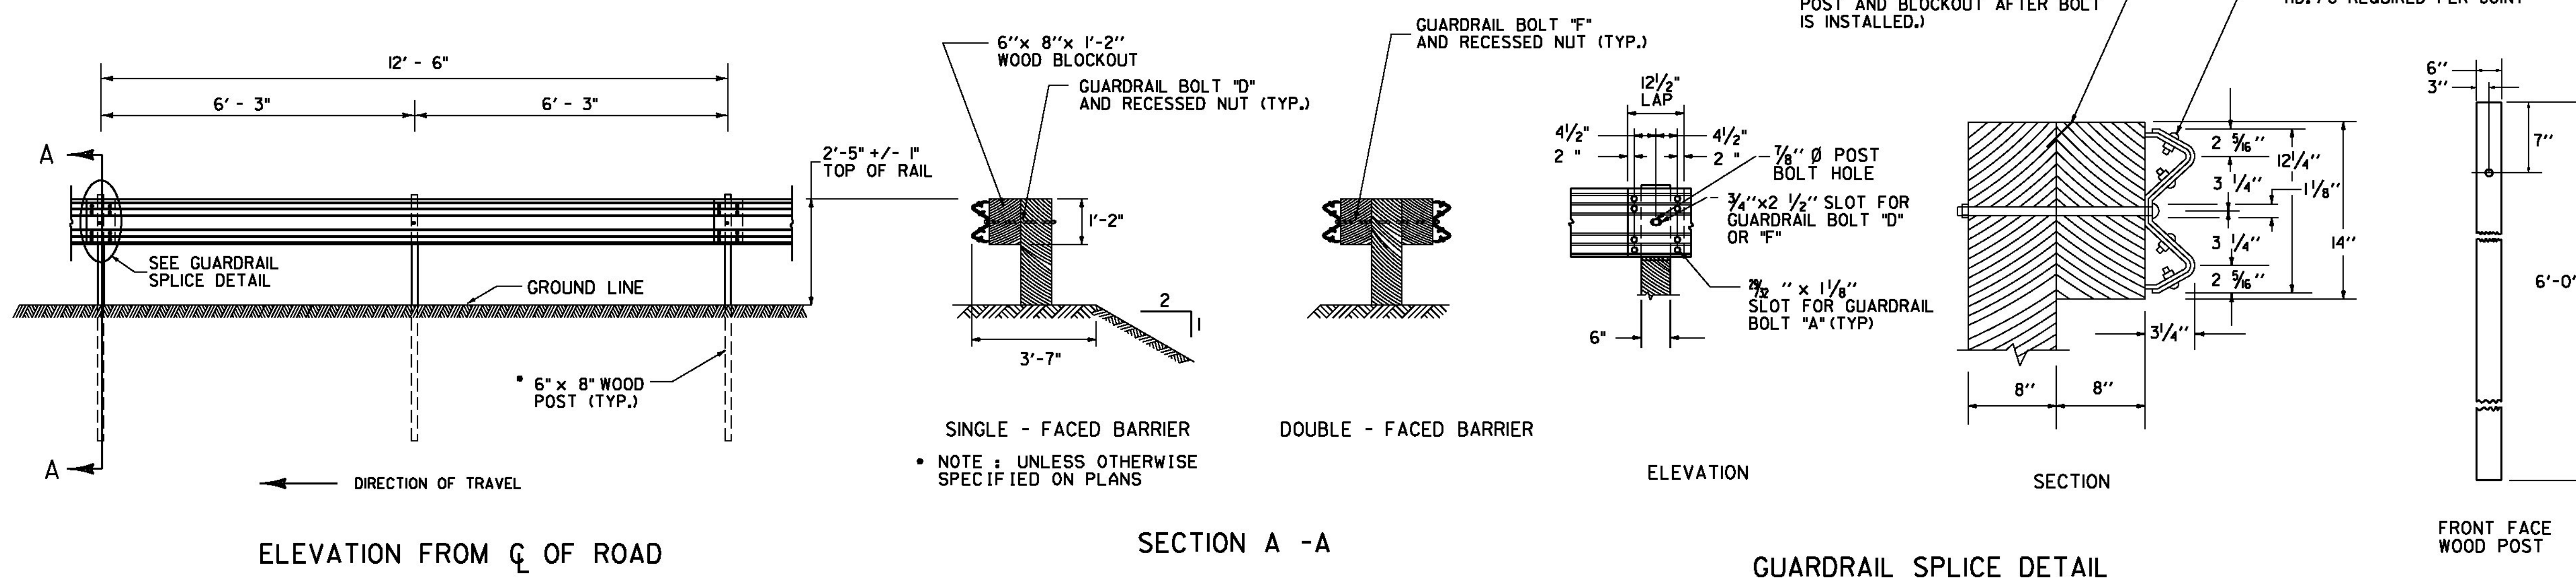


- NOTES:
- BLOCKS SHALL BE MADE OF TIMBER WITH A STRESS GRADE OF 1200 PSI OR MORE. TESTING SHALL BE IN ACCORDANCE WITH WEST COAST LUMBER INSPECTION BUREAU, SOUTHERN PINE INSPECTION BUREAU OR OTHER APPROPRIATE ASSOCIATION. TIMBER FOR BLOCKS SHALL BE ROUGH SAWN (UNPLANED) WITH DIMENSIONS INDICATED. THE SIZE TOLERANCE OF ROUGH SAWN BLOCKS IN THE DIRECTION OF THE BOLT HOLES SHALL BE NOT MORE THAN +/- 1/4".
 - SUPPLY WOOD BLOCKS PER AASHTO M 168.
 - TREAT WITH PRESERVATIVE PER AASHTO M 133.
 - BLOCKOUTS MAY ALSO BE MADE OF APPROVED ALTERNATIVE MATERIAL.

GUARDRAIL DELINEATOR

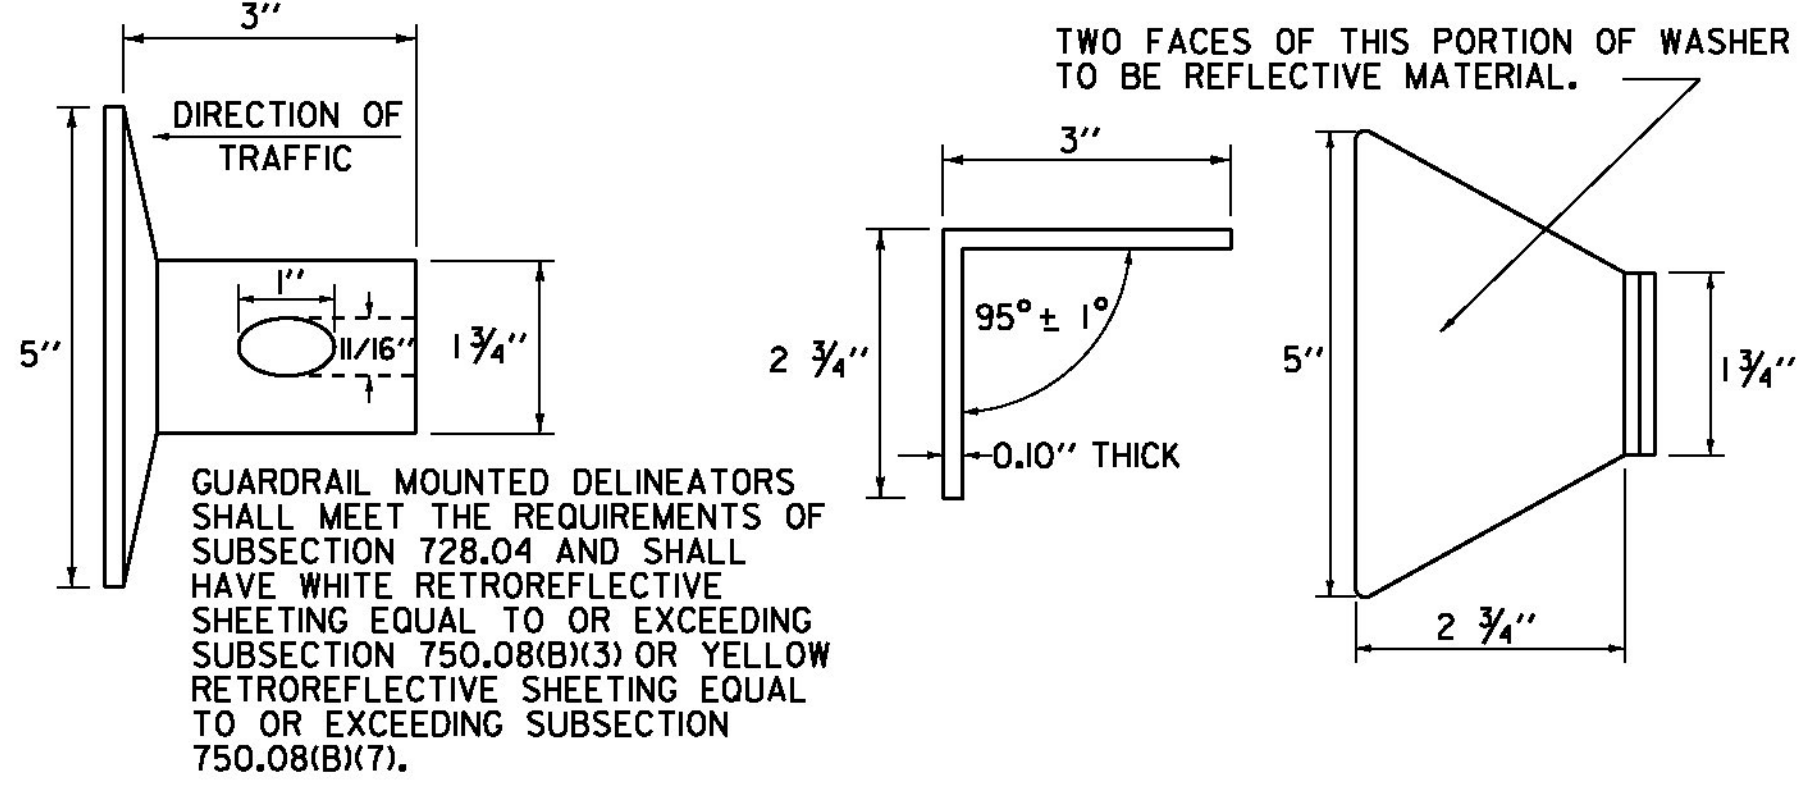


GUARDRAIL MOUNTED DELINEATORS SHALL MEET THE REQUIREMENTS OF SUBSECTION 728.04 AND SHALL HAVE WHITE RETROREFLECTIVE SHEETING EQUAL TO OR EXCEEDING SUBSECTION 750.08(B)(3) OR YELLOW RETROREFLECTIVE SHEETING EQUAL TO OR EXCEEDING SUBSECTION 750.08(B)(7).

THIS REFLECTORIZED ALUMINUM WASHER IS TO BE PLACED IN VALLEY OF BEAM WHEN MOUNTING BEAM ONTO EACH FIFTH POST. WASHER SHALL MEET SPECIFICATION REQUIREMENTS FOR A.S.T.M. B-209 ALLOY 5052-H32.

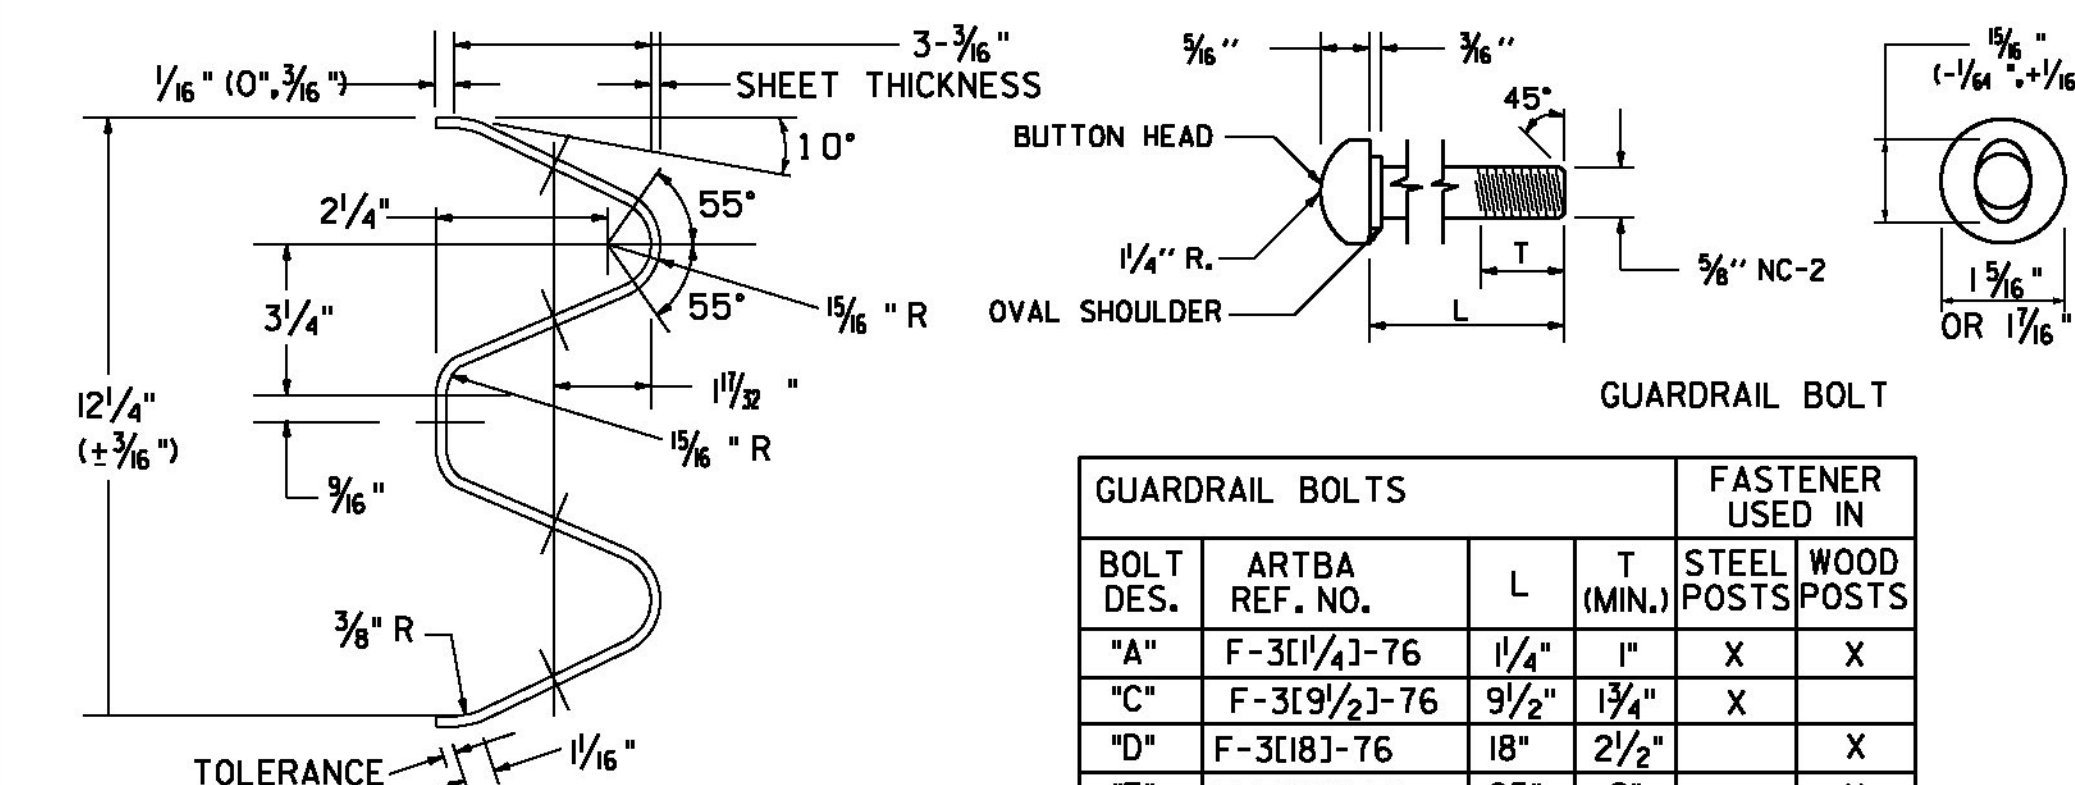

ARTBA RE-31205'-3"=12'-6" CLASS A, TYPE 11-73
TYPICAL GUARDRAIL SECTION

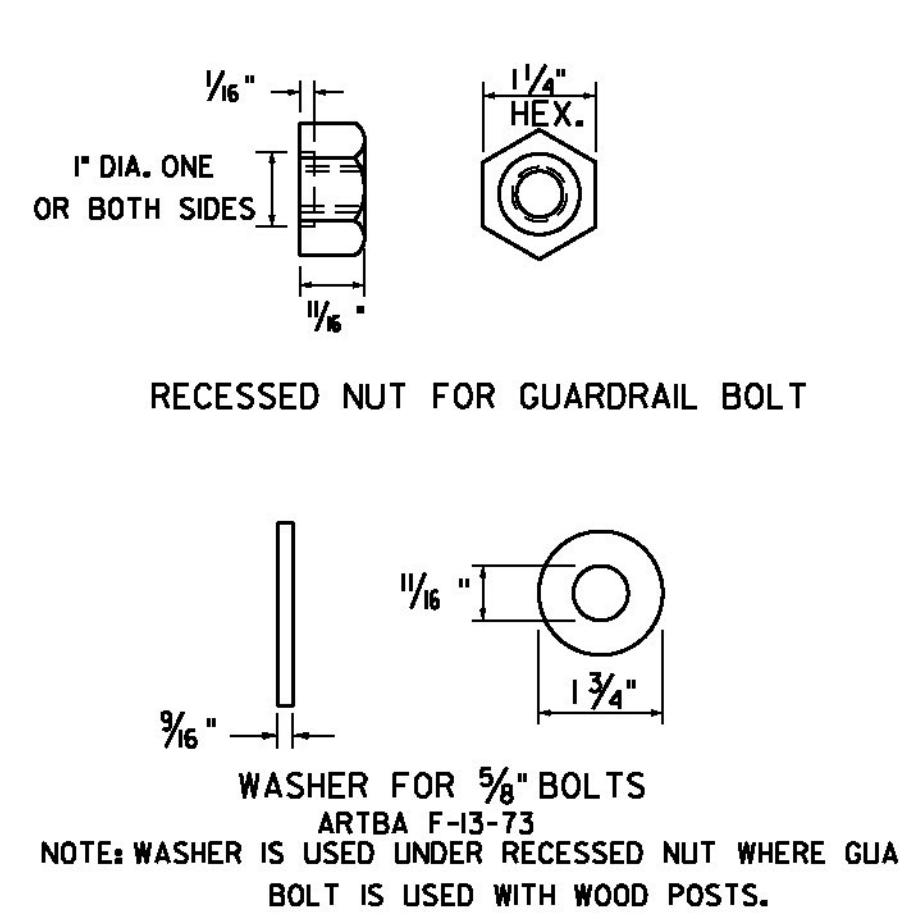


- GENERAL NOTES:
- GUARDRAIL SHALL MEET THE REQUIREMENTS OF AASHTO M 180, CLASS A, TYPE 1, UNLESS OTHERWISE DESIGNATED.
 - GUARDRAIL SHALL BE SINGLE FACED UNLESS OTHERWISE DESIGNATED.
 - GUARDRAIL SECTIONS SHALL BE LAPPED IN THE DIRECTION OF TRAFFIC FLOW FOR THE LANE NEAREST THE GUARDRAIL.
 - FOR DESCRIPTION AND SPECIFICATION OF PARTS IDENTIFIED BY (ARTBA ...) AND OTHER DETAILS OF BOLTS, POST ACCESSORIES, FASTENERS & RAIL ELEMENTS, SEE AASHTO-AGC-ARTBA JOINT TASK FORCE NO. 13, TITLED "A GUIDE TO STANDARDIZED HIGHWAY BARRIER HARDWARE", LATEST EDITION.
 - STANDARD STEEL BEAM TO BE 1/8" AND THE HEAVY DUTY TO BE 3/4" THICK.

REV.	DATE	DESCRIPTION
--	JAN. 3, 2000	UPDATED TO REFLECT METRIC STD. CHANGES
--	FEB. 10, 2014	UPDATED TO REFLECT GUARDRAIL HEIGHT OF 29"; FHWA LETTER (MAY 17, 2010)
--	NOV. 10, 2015	UPDATED DELINEATOR RETROREFLECTIVE SHEETING NOTES


OTHER STANDARDS REQUIRED: G-ID
VTRANS AND FHWA APPROVAL ON FILE WITH CONTRACT ADMINISTRATION

STEEL BEAM GUARDRAIL WITH STEEL POSTS
STEEL BEAM GUARDRAIL WITH WOOD POSTS



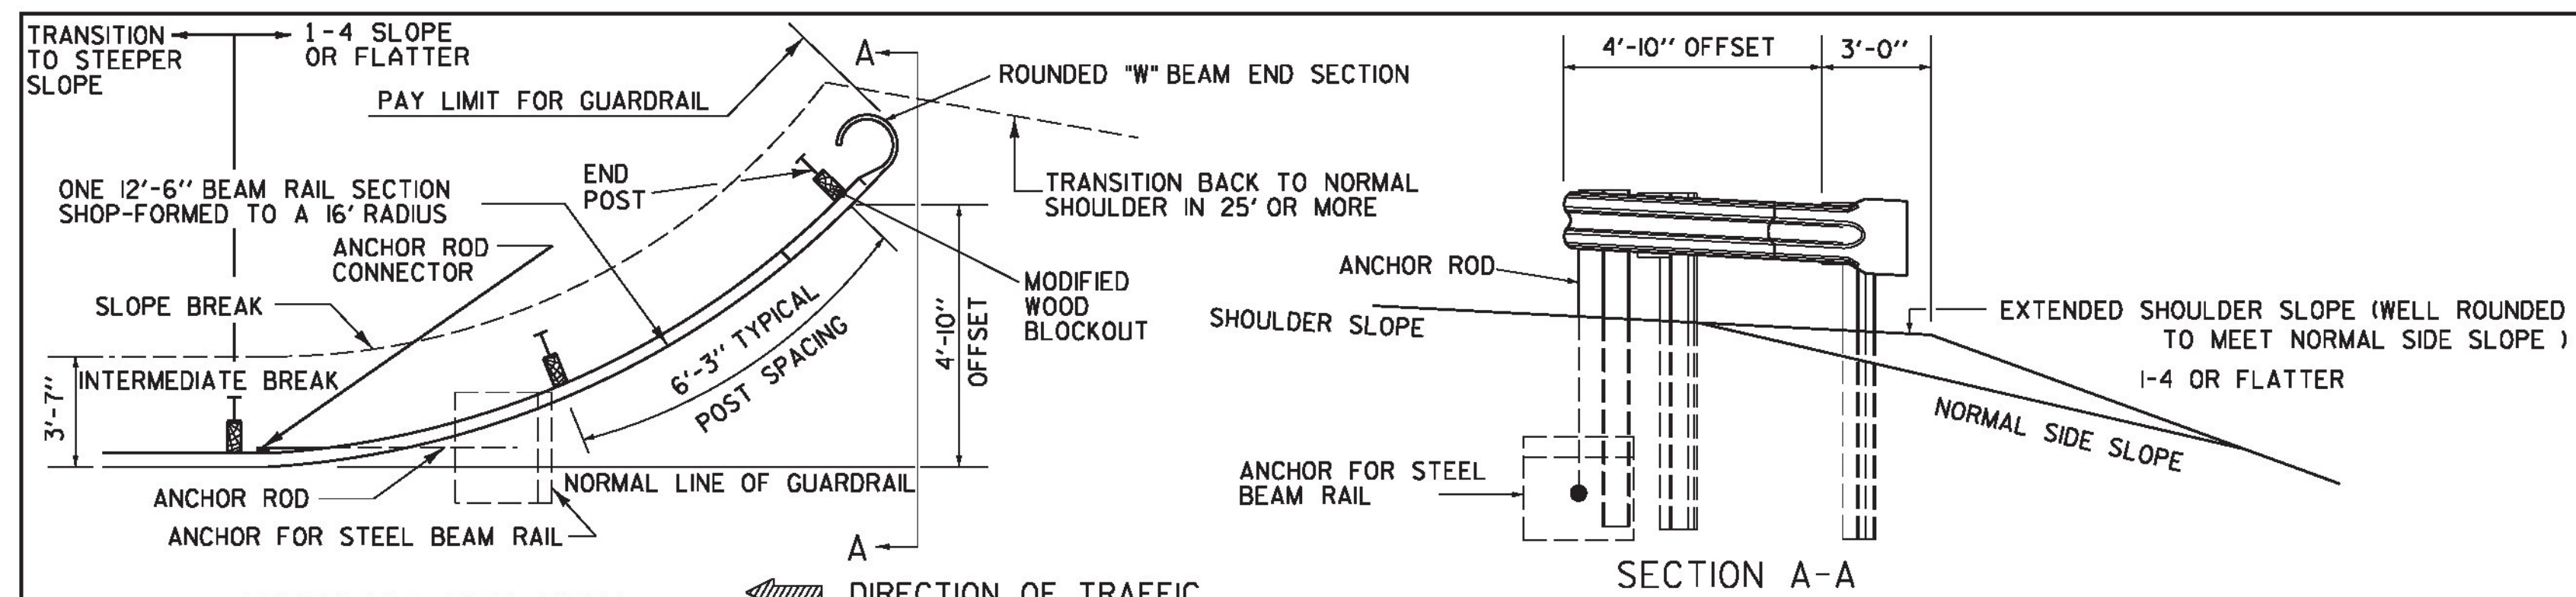

APPROACH END DETAIL
 NHS APPROVED FOR USE WHERE DESIGN SPEED IS 40 OR LESS MPH
 NON-NHS APPROVED FOR USE WHERE DESIGN SPEED IS 50 OR LESS MPH

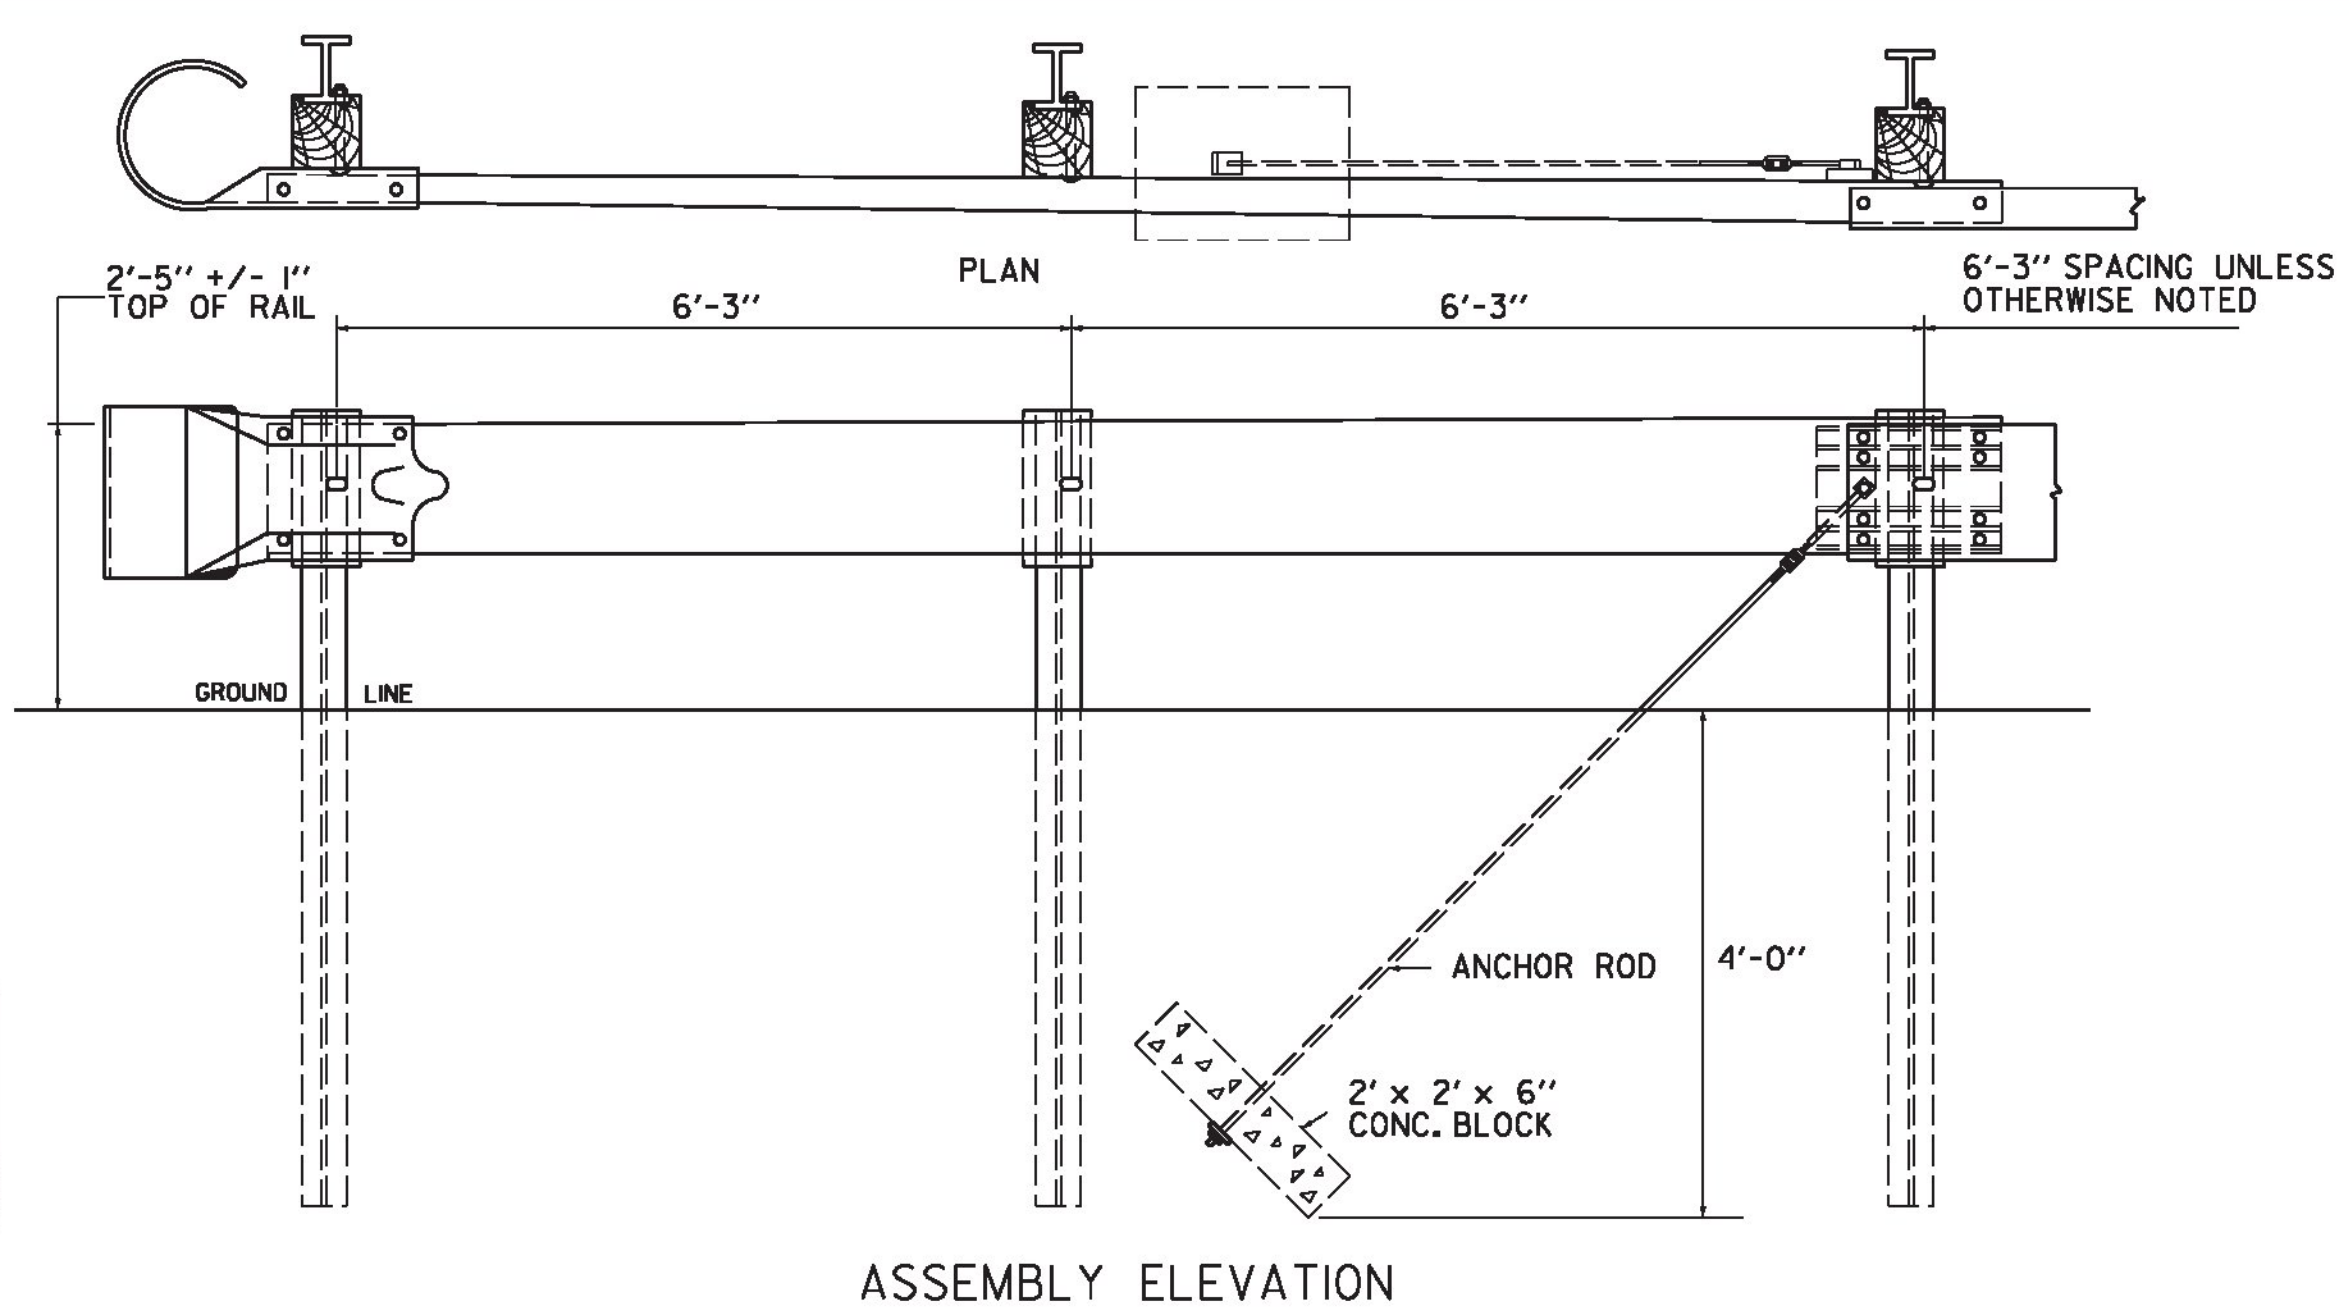


ASSEMBLY ELEVATION


TRAILING END TERMINAL FOR USE ON ONE-WAY HIGHWAYS

GENERAL NOTES:

1. ALL METAL PARTS SHALL BE GALVANIZED
2. ALL WOOD POSTS SHALL BE GIVEN A PRESERVATIVE TREATMENT
3. DETAILS PERTINENT TO THE STANDARD INSTALLATION OF "W" BEAM SECTIONS WILL BE FOUND ON STANDARD DRAWING G-1.
4. FOR DESCRIPTION AND SPECIFICATIONS OF PARTS IDENTIFIED BY "ARTBA..." AND OTHER DETAILS OF POSTS, POST ACCESSORIES, FASTENERS AND RAIL ELEMENTS, SEE AASHTO-ACC-ARTBA JOINT TASK FORCE NO. 13, TITLED "A GUIDE TO STANDARDIZED HIGHWAY BARRIER HARDWARE", LATEST EDITION.
5. THE TRANSITION FROM THE APPROACH END TO THE STANDARD STEEL BEAM GUARDRAIL SHALL BE 25'-0" UNLESS OTHERWISE SPECIFIED.
6. WHEN STANDARD STEEL BEAM CONNECTS TO BRIDGE APPROACH RAIL OF A DIFFERENT HEIGHT THE LENGTH NEEDED TO TRANSITION THE HEIGHT OF STANDARD STEEL BEAM TO MATCH THE BRIDGE APPROACH RAIL SHALL BE 25'-0" UNLESS OTHERWISE SPECIFIED.
7. WHEN STANDARD STEEL BEAM CONNECTS TO A MANUFACTURED TERMINAL SECTION OF A DIFFERENT HEIGHT THE LENGTH NEEDED TO TRANSITION THE HEIGHT OF STANDARD STEEL BEAM TO MATCH THE MANUFACTURED TERMINAL SECTION SHALL BE 25'-0" UNLESS OTHERWISE SPECIFIED.

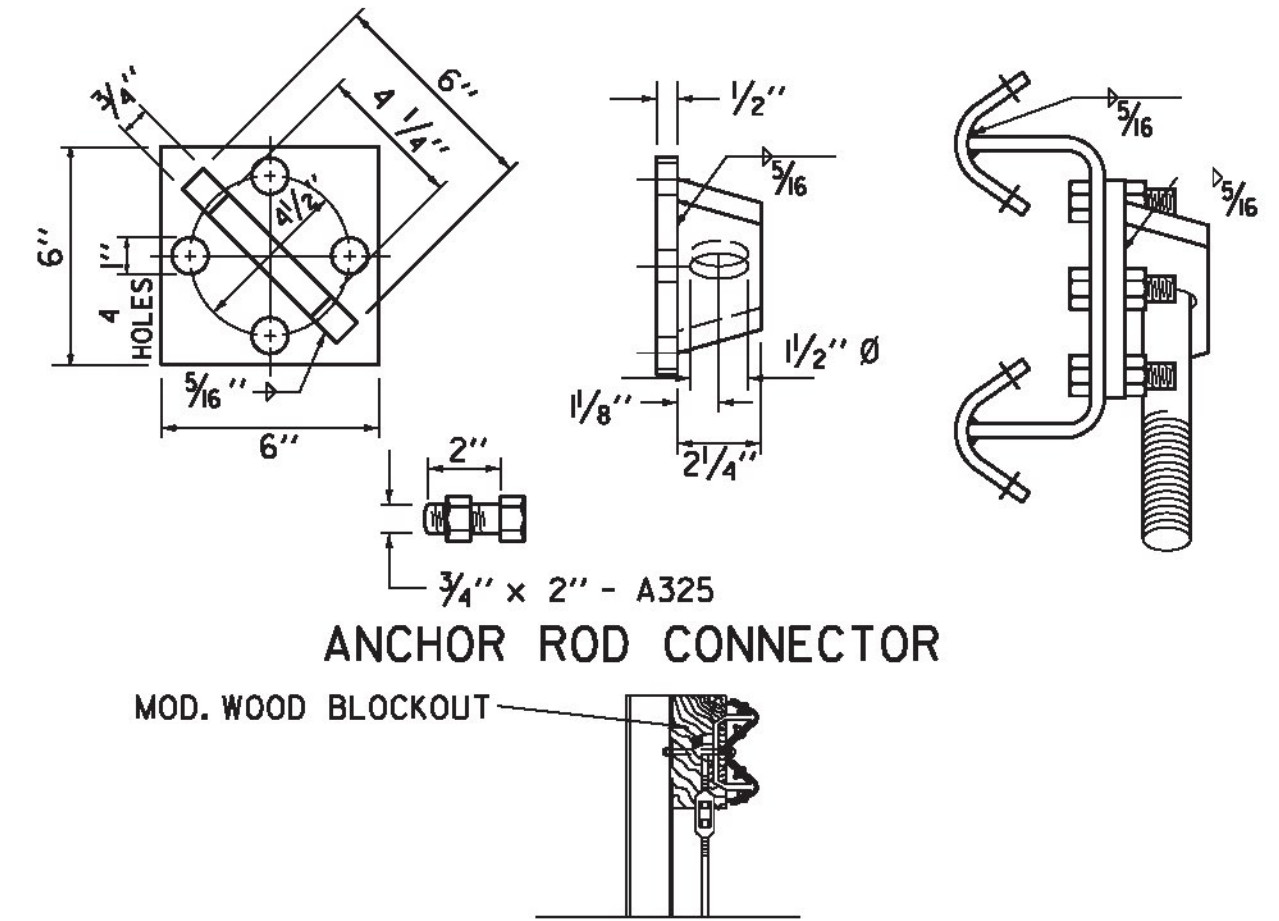


ANCHOR ROD CONNECTOR

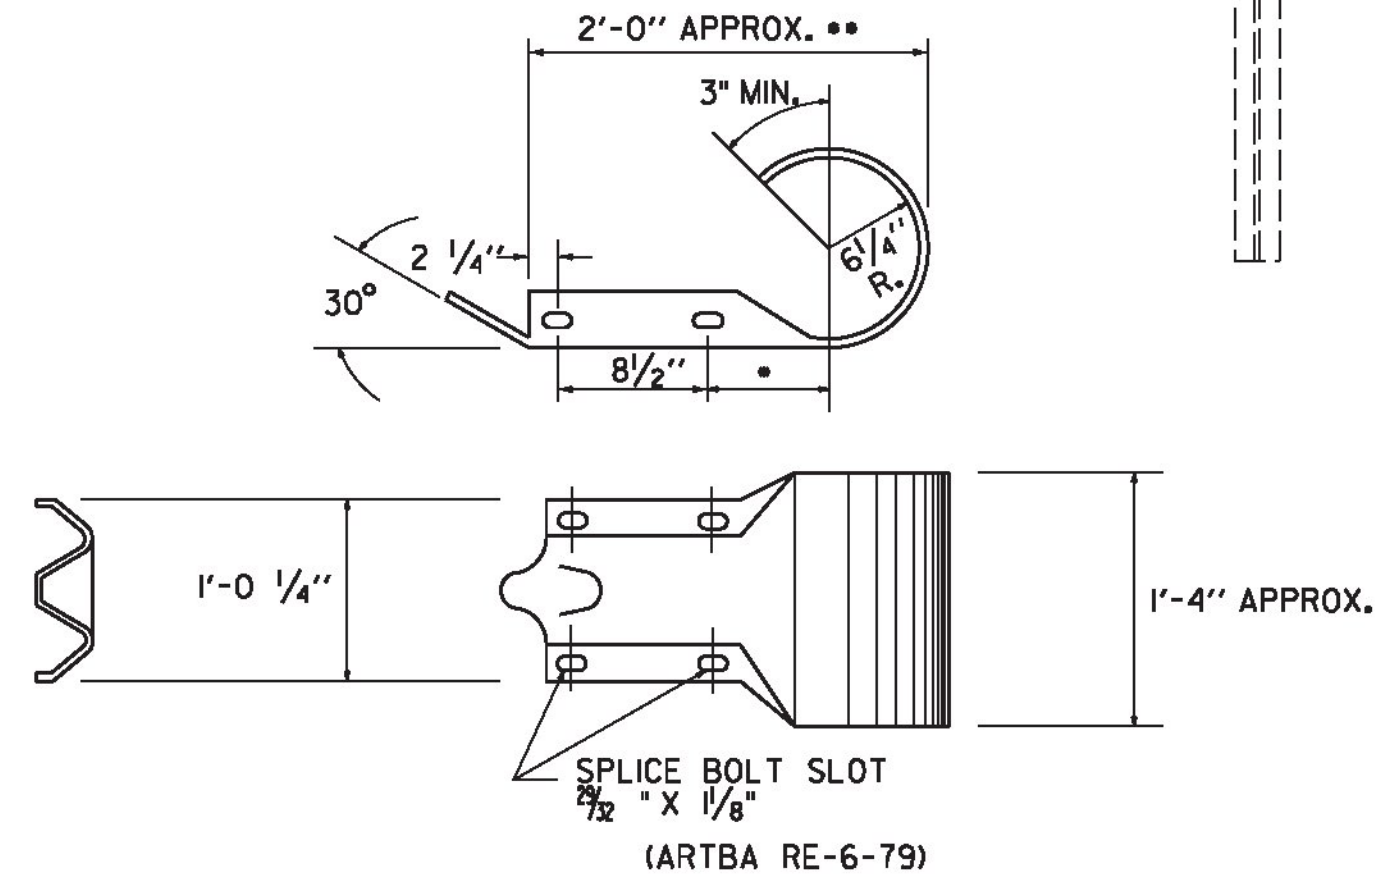


ROUNDED "W" BEAM END SECTION


* THIS DIMENSION IS 7 1/2" INRE-7-79. IF THE DIMENSION IS USED IN THIS PART, IT WILL GIVE AN ACCEPTABLE OVERALL LENGTH (**) OF APPROXIMATELY 2'-11/2."

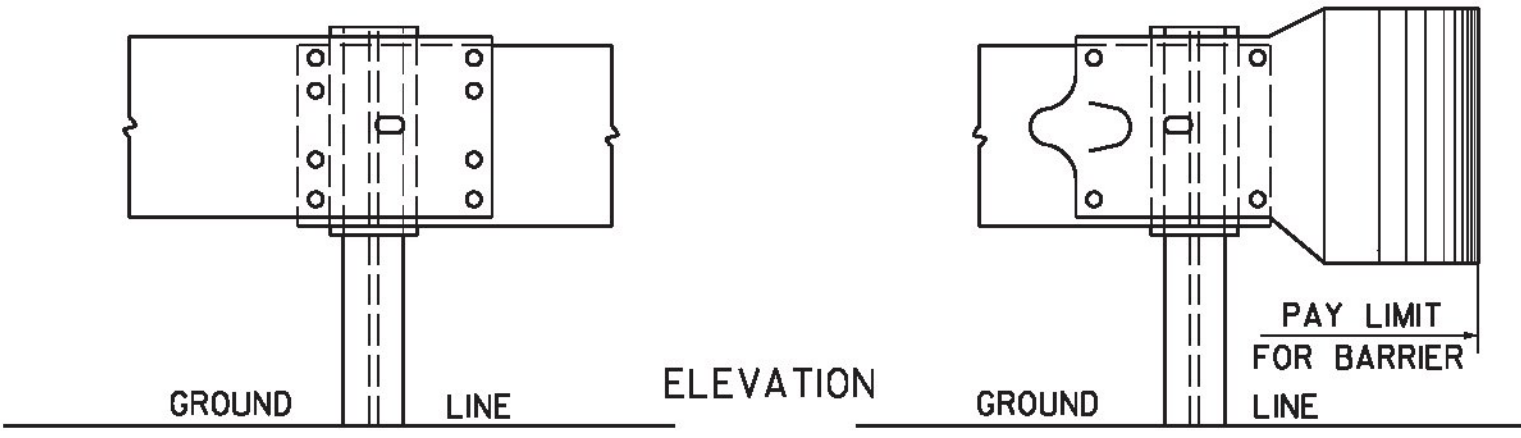


STEEL BEAM MEDIAN BARRIER
 NOTE: TO BE USED OUTSIDE CLEAR ZONE ONLY.

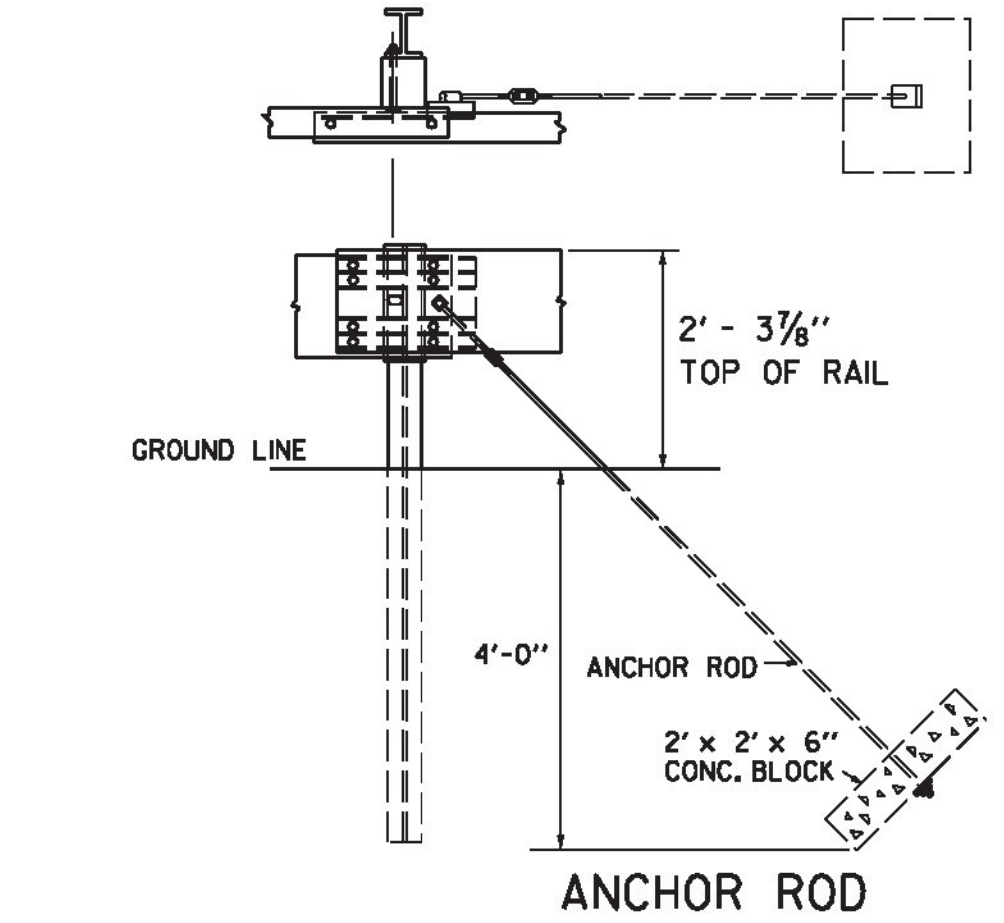


ANCHOR ROD

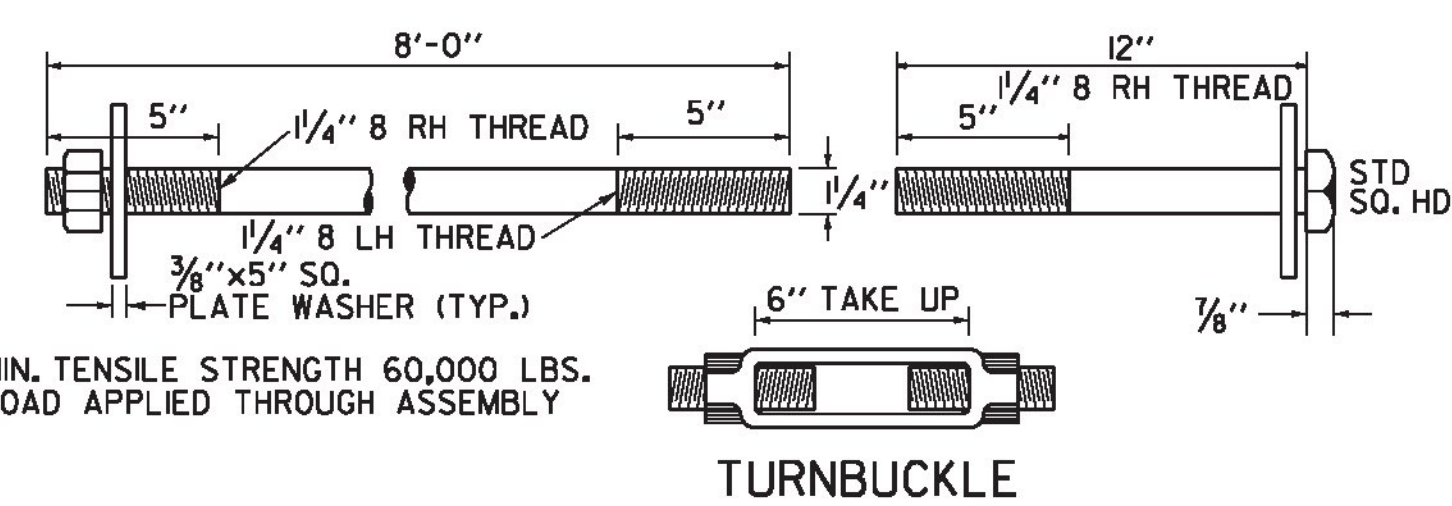


TURNBUCKLE

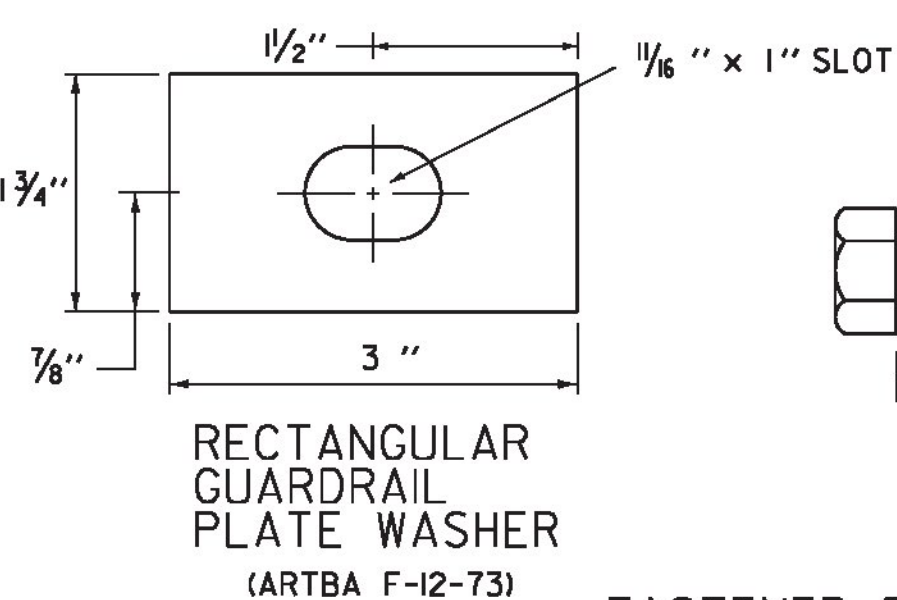

RECTANGULAR GUARDRAIL PLATE WASHER (ARTBA F-12-73)

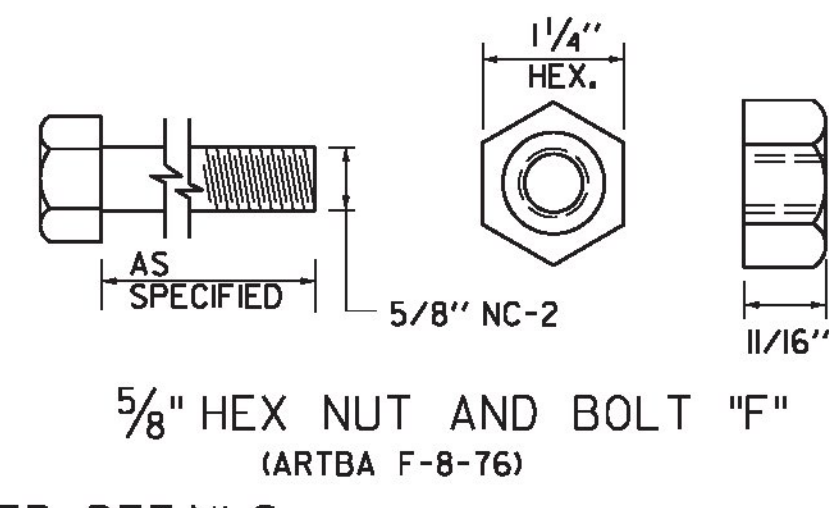

FASTENER DETAILS

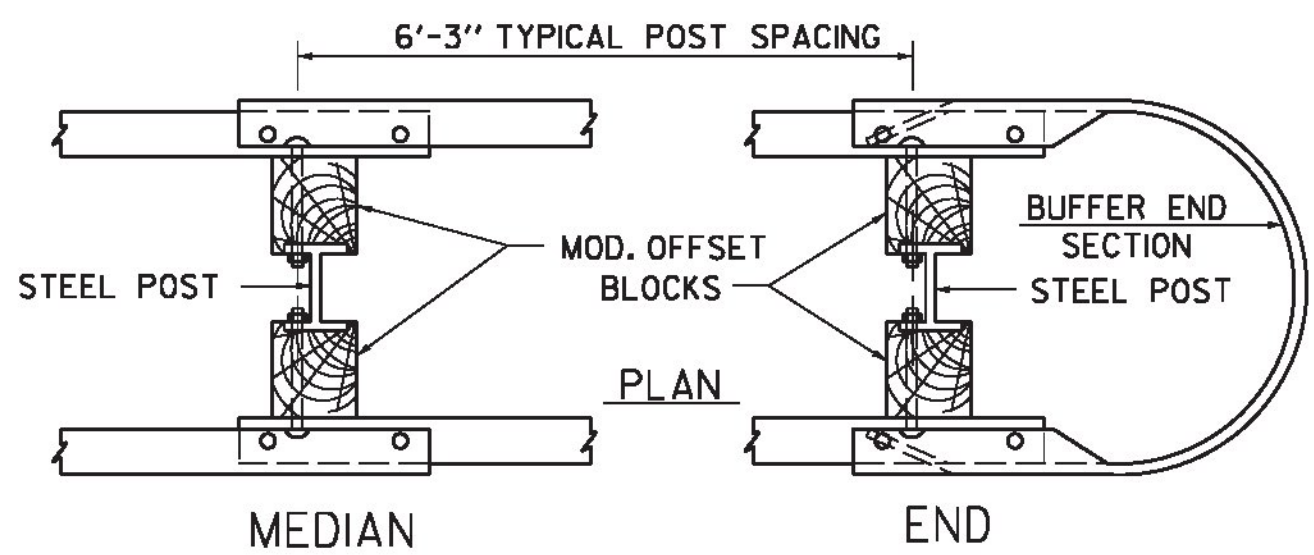

STEEL BEAM MEDIAN BARRIER

OTHER STANDARD REQUIRED: G-1

REVISIONS AND CORRECTIONS
 JUNE 1, 1994 - REISSUED, WITHOUT CHANGE, UNDER NEW SIGNATURES.
 JAN. 3, 2000 - UPDATED TO REFLECT METRIC STD. CHANGES
 FEB. 10, 2014 - UPDATED TO REFLECT GUARDRAIL HEIGHT OF 29"; AS NOTED IN FHWA LETTER DATED MAY 17, 2010

APPROVED
[Signature]
 HIGHWAY SAFETY & DESIGN ENGINEER
[Signature]
 DIRECTOR OF PROGRAM DEVELOPMENT
[Signature]
 FEDERAL HIGHWAY ADMINISTRATION

STEEL BEAM GUARDRAIL APPROACH END TERMINAL
 STEEL BEAM GUARDRAIL TRAILING END TERMINAL
 ANCHOR FOR STEEL BEAM GUARDRAIL
 STEEL BEAM MEDIAN BARRIER



STANDARD
 G-1d

- I. TRAFFIC CONTROL DEVICES NOT DETAILED IN THE VERMONT AGENCY OF TRANSPORTATION (VAOT) "STANDARD DRAWINGS" OR THE PROJECT PLANS SHALL BE IN ACCORDANCE WITH THE "MANUAL ON TRAFFIC CONTROL DEVICES" (MUTCD) AND THE "STANDARD HIGHWAY SIGNS AND MARKINGS" BOOK (SHSM) PUBLISHED BY THE FEDERAL HIGHWAY ADMINISTRATION (FHWA).
2. CONSTRUCTION SIGNS SHALL BE ERECTED BEFORE THE START OF ANY WORK AND SHALL BE COVERED UNTIL WORK COMMENCES, DURING PERIODS OF INACTIVITY OR UPON COMPLETION OF THE WORK. EACH SIGN SHALL BE ERECTED IN A NEAT AND WORKMANLIKE MANNER.
3. CONSTRUCTION SIGN COVERS SHALL CONSIST OF A PANEL, PAINTED FLAT BLACK, THE SAME SIZE AS THE SIGN IT COVERS. THE PANEL SHALL BE OF WOOD, PLYWOOD, HARDBOARD OR ANY MATERIAL SATISFACTORY TO THE ENGINEER. NO MATERIAL WILL BE APPROVED THAT WILL DETERIORATE BY EXPOSURE TO THE WEATHER DURING THE PROJECT. MOUNTING OF THE PANEL SHALL BE DONE IN SUCH A WAY AS NOT TO DAMAGE THE SIGN FACE MATERIAL.
4. SIGNS SHALL BE MAINTAINED IN A CLEAN AND LEGIBLE CONDITION SATISFACTORY TO THE ENGINEER. THEY SHALL BE KEPT PLUMB AND LEVEL, AND ALWAYS PRESENT A NEAT APPEARANCE. DAMAGED, DEFACTED OR DIRTY SIGNS SHALL BE REPAIRED, CLEANED OR REPLACED AS ORDERED BY THE ENGINEER.
5. NO CROSS-BRACING OR BACK-BRACING TO KEEP POSTS PLUMB WILL BE ALLOWED. CONCRETE FOUNDATIONS, COLLARS OR SOIL BEARING PLATES ARE NOT PERMITTED. CONSTRUCTION SIGNS SHALL BE PLACED ON TWO POSTS.
6. CONSTRUCTION SIGNS INSTALLED ON POSTS SHALL BE SET SECURELY IN THE GROUND. THE BOTTOM OF A SIGN SHALL BE AT LEAST FIVE FEET ABOVE THE EDGE OF PAVEMENT AND THE NEAREST EDGE OF A SIGN SHALL BE AT LEAST SIX FEET OUTSIDE THE SHOULDER POINT, FOUR FEET OUTSIDE GUARDRAIL, OR TWO FEET OUTSIDE CURBING OR SIDEWALK. THE INSTALLATION OF SIGNS SHALL BE SUBJECT TO APPROVAL OF THE ENGINEER. IN URBAN AREAS, THE BOTTOM OF THE SIGN SHALL BE AT LEAST SEVEN FEET ABOVE THE SIDEWALK OR EDGE OF PAVEMENT, WHICHEVER IS HIGHER.
7. PORTABLE SIGNS SHALL BE PLACED ON THE EDGE OF ROADWAY AND A MINIMUM OF ONE FOOT ABOVE THE TRAVELED WAY. ALL VEGETATION THAT INTERFERES WITH VISIBILITY OF THE SIGNS SHALL BE REMOVED. WHEN PLACED BEHIND GUARDRAIL, THE BOTTOM OF THE SIGN FACE SHALL BE ABOVE THE TOP OF THE GUARDRAIL.
8. SIGNS SHALL BE REMOVED UPON COMPLETION OF THE WORK AT THE DISCRETION OF THE ENGINEER.
9. ROLL UP CONSTRUCTION SIGNS SHALL HAVE RETROREFLECTIVE SHEETING EQUAL TO OR EXCEEDING THE "AMERICAN ASSOCIATION OF STATE HIGHWAY AND TRANSPORTATION OFFICIALS" (AASHTO) M 268 ["AMERICAN SOCIETY FOR TESTING AND MATERIALS" (ASTM) D 4956J TYPE VI AND TYPE VII UNLESS OTHERWISE NOTED.
10. SOLID SUBSTRATE CONSTRUCTION SIGNS SHALL HAVE RETROREFLECTIVE SHEETING EQUAL TO OR EXCEEDING THE "AMERICAN ASSOCIATION OF STATE HIGHWAY AND TRANSPORTATION OFFICIALS" (AASHTO) M 268 ["AMERICAN SOCIETY FOR TESTING AND MATERIALS" (ASTM) D 4956J TYPE VIII OR IX REQUIREMENTS UNLESS OTHERWISE NOTED.
11. WHERE CONSTRUCTION SIGN INSTALLATIONS ARE NOT PROTECTED BY GUARDRAIL OR OTHER APPROVED TRAFFIC BARRIERS, ALL SIGN STANDS AND POST INSTALLATIONS SHALL MEET "NATIONAL COOPERATIVE HIGHWAY RESEARCH PROGRAM" (NCHRP) REPORT 350 OR THE AASHTO "MANUAL FOR ASSESSING SAFETY HARDWARE" (MASH). THE APPROPRIATE RESOURCE SHALL BE DETERMINED AS DESCRIBED IN THE MASH PUBLICATION. NO SIGN POSTS SHALL EXTEND OVER THE TOP OF THE SIGN INSTALLED ON SAID POSTS. WHEN ANCHORS ARE INSTALLED, STUBS SHALL NOT BE GREATER THAN FOUR INCHES ABOVE EXISTING GROUND.
12. ROADWAY AND SHOULDER WIDTHS DEPICTED ON THE STANDARD DRAWINGS MAY VARY.
13. THESE STANDARD DRAWINGS ARE INTENDED TO SERVE AS VTRANS STANDARD OPERATING PROCEDURE. IT IS NOTED THAT COMPONENT PARTS OF A TEMPORARY TRAFFIC CONTROL WORK ZONE MAY BE MODIFIED DUE TO FIELD CONDITIONS, AT THE DISCRETION OF THE ENGINEER.

OTHER STDS. REQUIRED: **NONE**


REVISIONS AND CORRECTIONS
AUG. 6, 2012 - ORIGINAL APPROVAL DATE

APPROVED
[Signature]
HIGHWAY SAFETY & DESIGN ENGINEER
[Signature]
DIRECTOR OF PROGRAM DEVELOPMENT
[Signature]
MARK D. RICHTER
FEDERAL HIGHWAY ADMINISTRATION

TRAFFIC CONTROL GENERAL NOTES



STANDARD
T-1

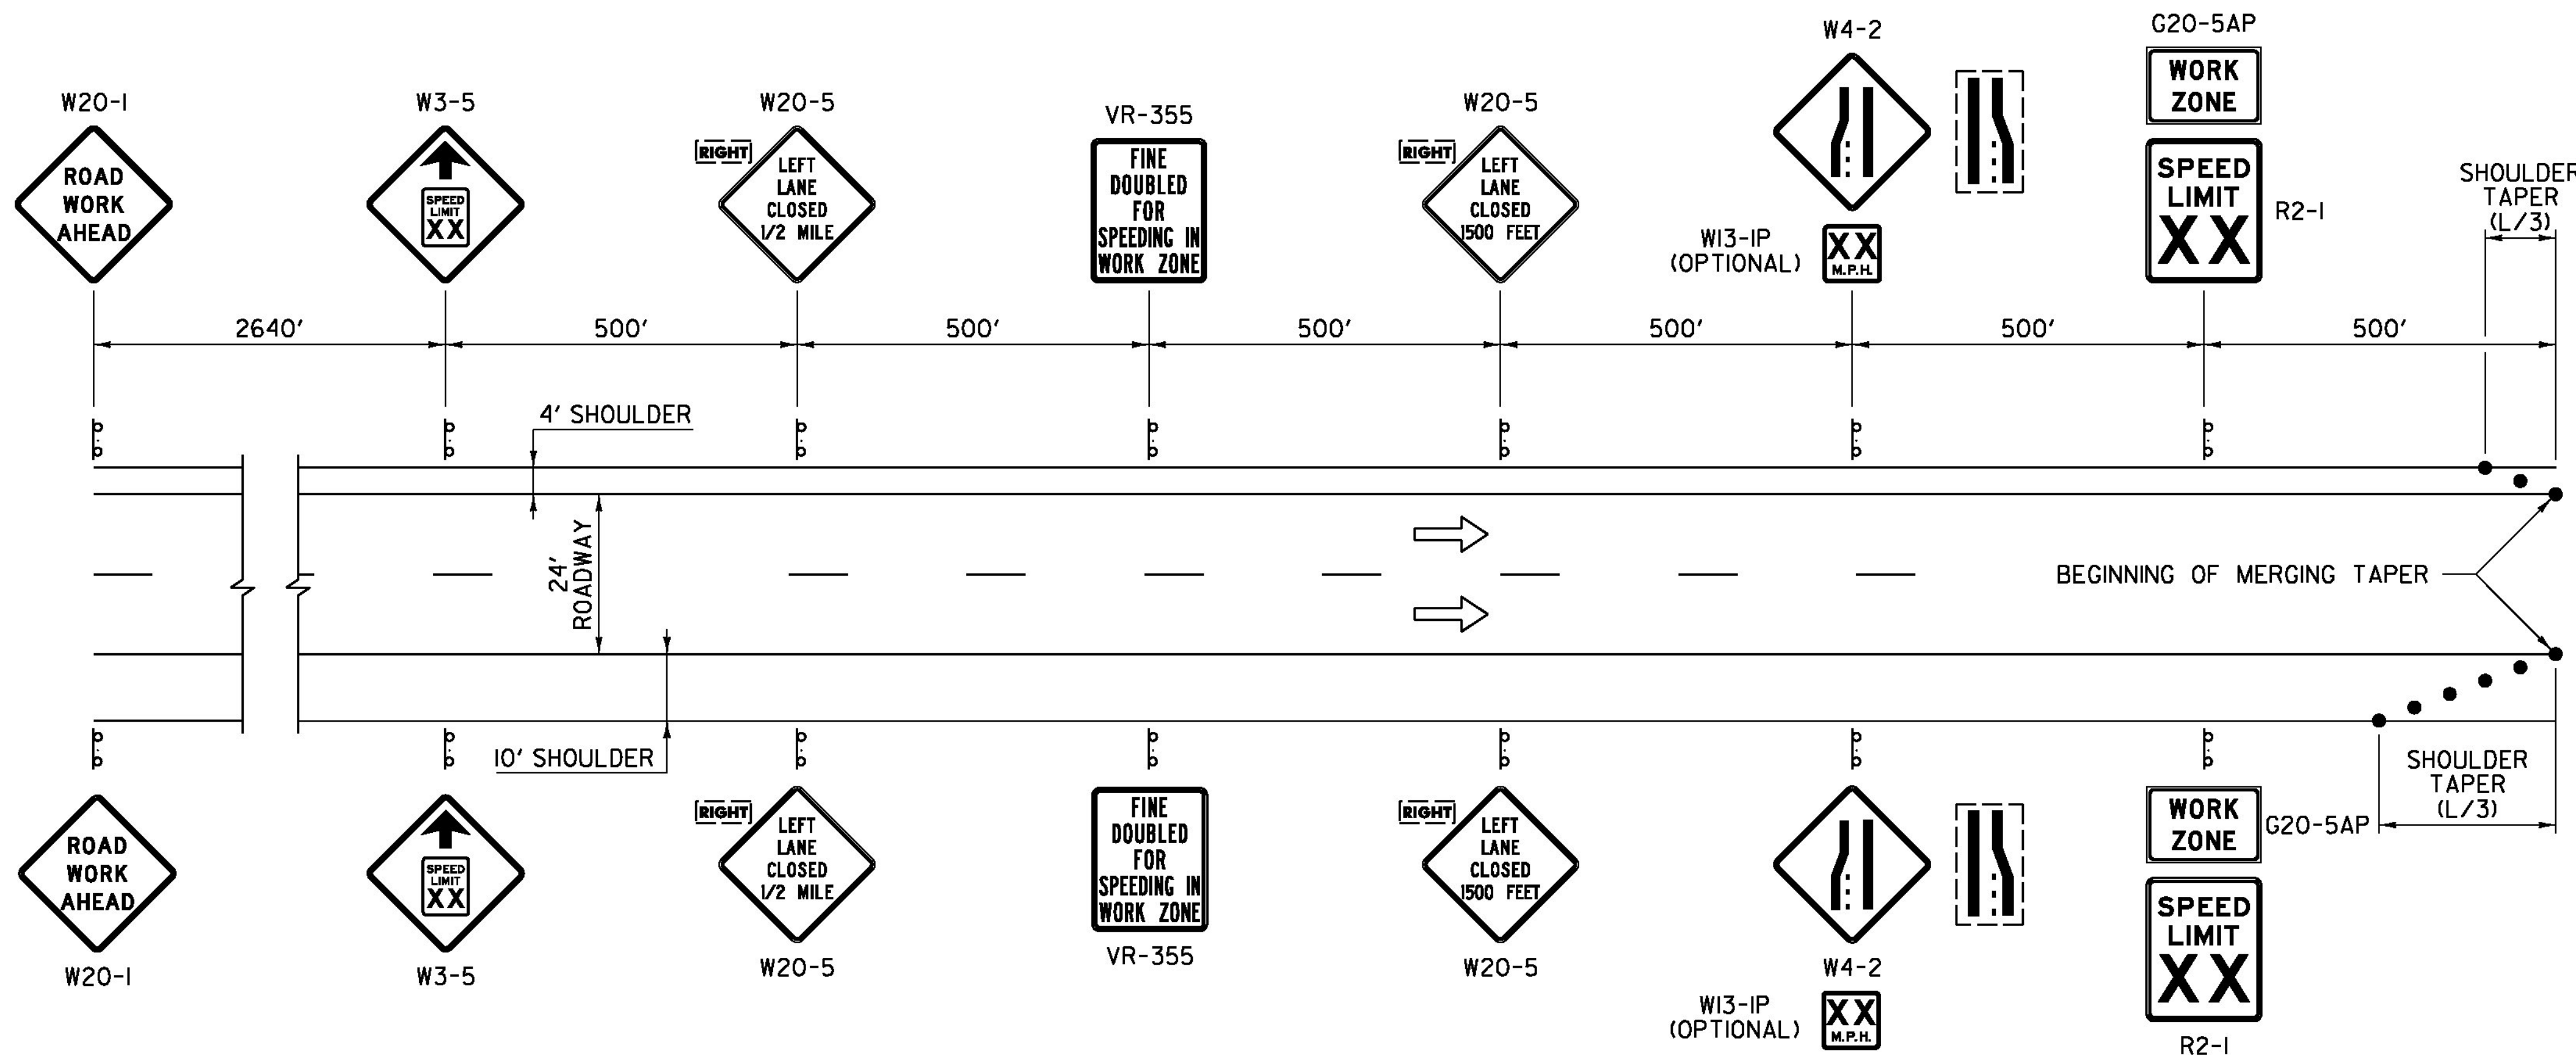

GENERAL NOTES:

1. IF APPLICABLE, THE CONTRACTOR SHALL HAVE SIGNS FOR CLOSURE OF RIGHT AND LEFT LANES ON PROJECT BEFORE WORK COMMENCES.
2. THE "SPEED LIMIT XX" (R2-1) AND "SPEED REDUCTION WARNING" (W3-5) SIGNS SHALL ONLY BE USED IF A TEMPORARY SPEED LIMIT CERTIFICATE HAS BEEN APPROVED. THE "SPEED LIMIT XX" (R2-1) AND OTHER RELATED SIGNS SHALL BE REMOVED OR COVERED WHEN WORK IS NOT IN PROGRESS AND ROADWAY IS NOT RESTRICTED.
3. "FINE DOUBLED FOR SPEEDING IN WORK ZONE" (VR-355) SHALL ONLY BE USED IF TEMPORARY SPEED LIMIT CERTIFICATE HAS BEEN APPROVED.
4. EXISTING SPEED LIMIT SIGNS SHALL BE COVERED WHEN TEMPORARY SPEED LIMIT SIGNS ARE POSTED.
5. FOR SHORT TERM PROJECTS (THREE CONSECUTIVE DAYS OR LESS) WITH NO OFFICIAL TEMPORARY SPEED LIMIT, THE "SPEED LIMIT XX" (R2-1) AND "SPEED REDUCTION WARNING" (W3-5) SIGNS MAY BE SUBSTITUTED WITH ADVISORY SPEED PLAQUES (W13-IP) MOUNTED AS SUPPLEMENTAL SIGNS BELOW THE "LANE ENDS" (W4-2) SIGNS.
6. FOR AN ANTICIPATED LONG TERM CLOSURE (GREATER THAN THREE CONSECUTIVE DAYS) WITH A NON-MOVING OPERATION, ALL SIGNS SHALL BE POST MOUNTED.
7. FOR A LONG TERM CLOSURE WITH A MOVING OPERATION, THE "ROAD WORK AHEAD" (W20-1) SIGN SHALL BE POST MOUNTED. THE REMAINING SIGNS MAY BE PORTABLE AND SHALL MOVE AS THE WORK AREA CHANGES.
8. FOR A SHORT TERM PROJECT (THREE CONSECUTIVE DAYS OR LESS), SIGNS MAY BE POST MOUNTED OR PORTABLE.
9. THE "SPEED LIMIT XX" (R2-1) SOLID SUBSTRATE SIGNS SHALL HAVE RETROREFLECTIVE SHEETING EQUAL TO OR EXCEEDING AASHTO M 268 [ASTM D 4956] TYPE III.

OTHER STDS. REQUIRED: T-1, T-12, T-31

LEGEND
 → FLOW OF TRAFFIC
 • RETROREFLECTIVE PLASTIC DRUM


REVISIONS AND CORRECTIONS
 AUG. 6, 2012 - ORIGINAL APPROVAL DATE

APPROVED
[Signature]
 HIGHWAY SAFETY & DESIGN ENGINEER
[Signature]
 DIRECTOR OF PROGRAM DEVELOPMENT
[Signature]
 FEDERAL HIGHWAY ADMINISTRATION

**CONSTRUCTION APPROACH
 SIGNING DIVIDED HIGHWAY
 ONE LANE CLOSED**



**STANDARD
 T-11**

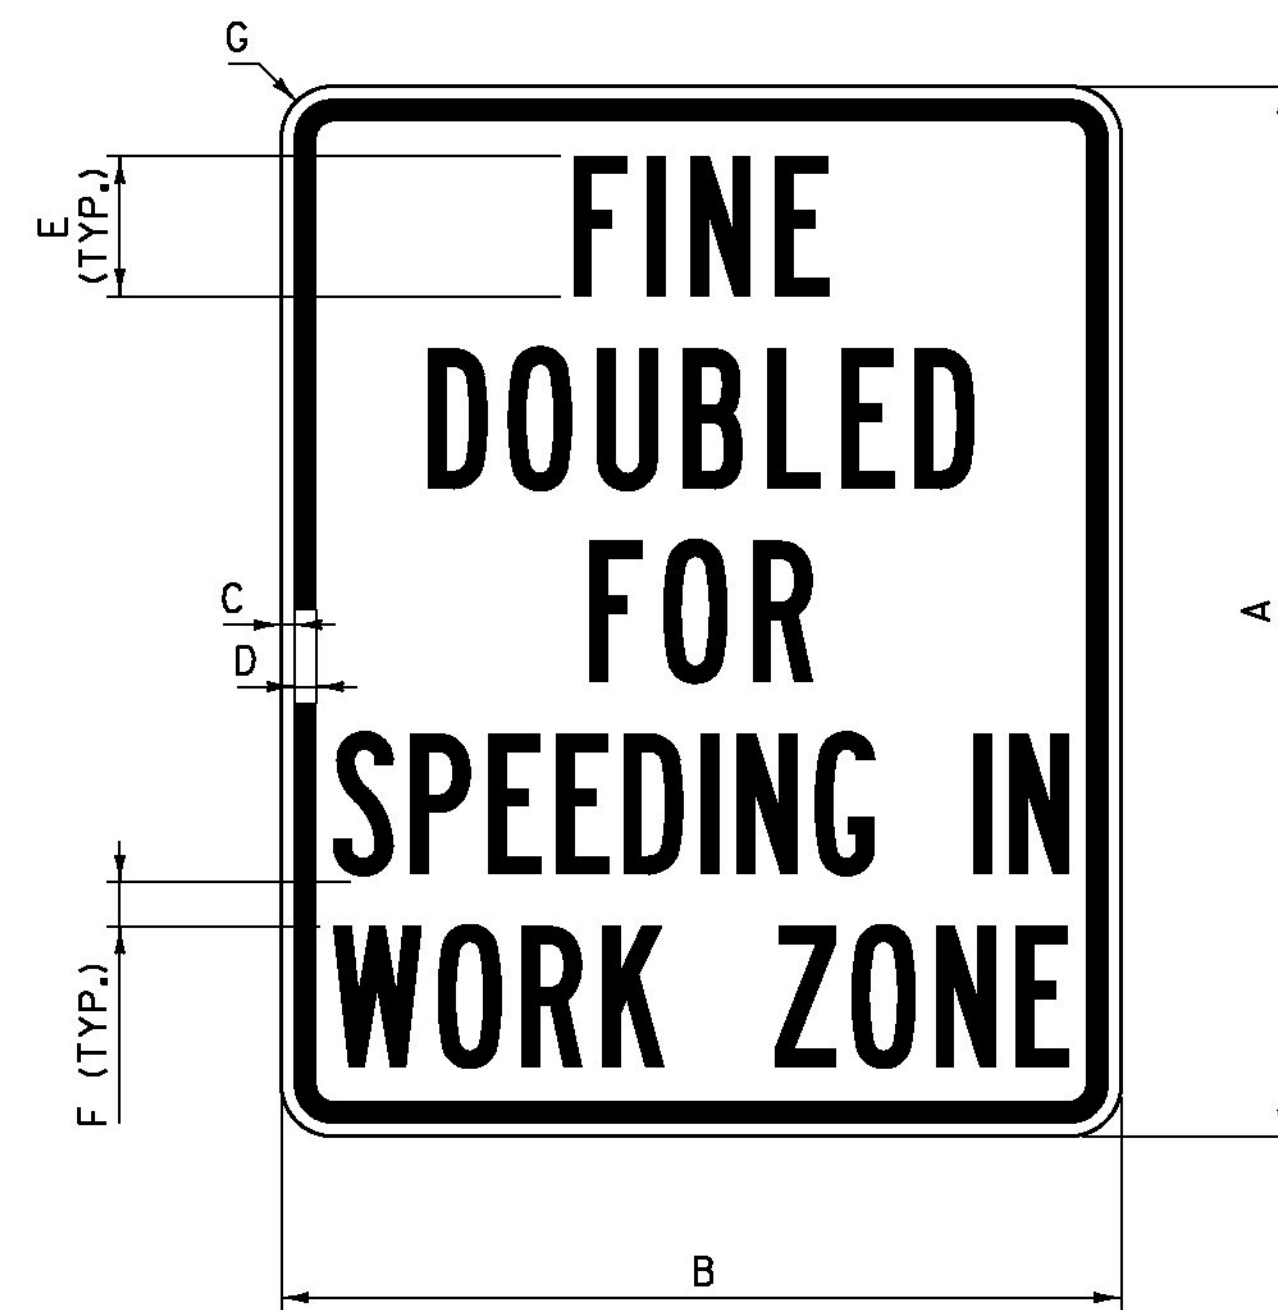


VR-355

SIGN	DIMENSIONS						
	A	B	C	D	E	F	G
STANDARD	36	30	1/2	3/4	4C	2 1/4	1 7/8
EXPRESSWAY/ FREEWAY	60	48	3/4	1 1/4	8B	3	3

NOTES:

- "SPEEDING IN" AND "WORK ZONE" SHALL EACH HAVE A SPECIFIED WIDTH OF 26 INCHES FOR STANDARD AND 42 INCHES FOR EXPRESSWAY/FREEWAY.
- THE SIGN SHALL HAVE BLACK LEGEND AND BORDER ON A WHITE BACKGROUND WITH RETROREFLECTIVE SHEETING EQUAL TO OR EXCEEDING "AMERICAN ASSOCIATION OF STATE HIGHWAY AND TRANSPORTATION OFFICIALS" (AASHTO) M 268 ["AMERICAN SOCIETY FOR TESTING AND MATERIALS" (ASTM) D 4956] TYPE III.
- LEGEND SHALL BE CENTERED HORIZONTALLY AND VERTICALLY.

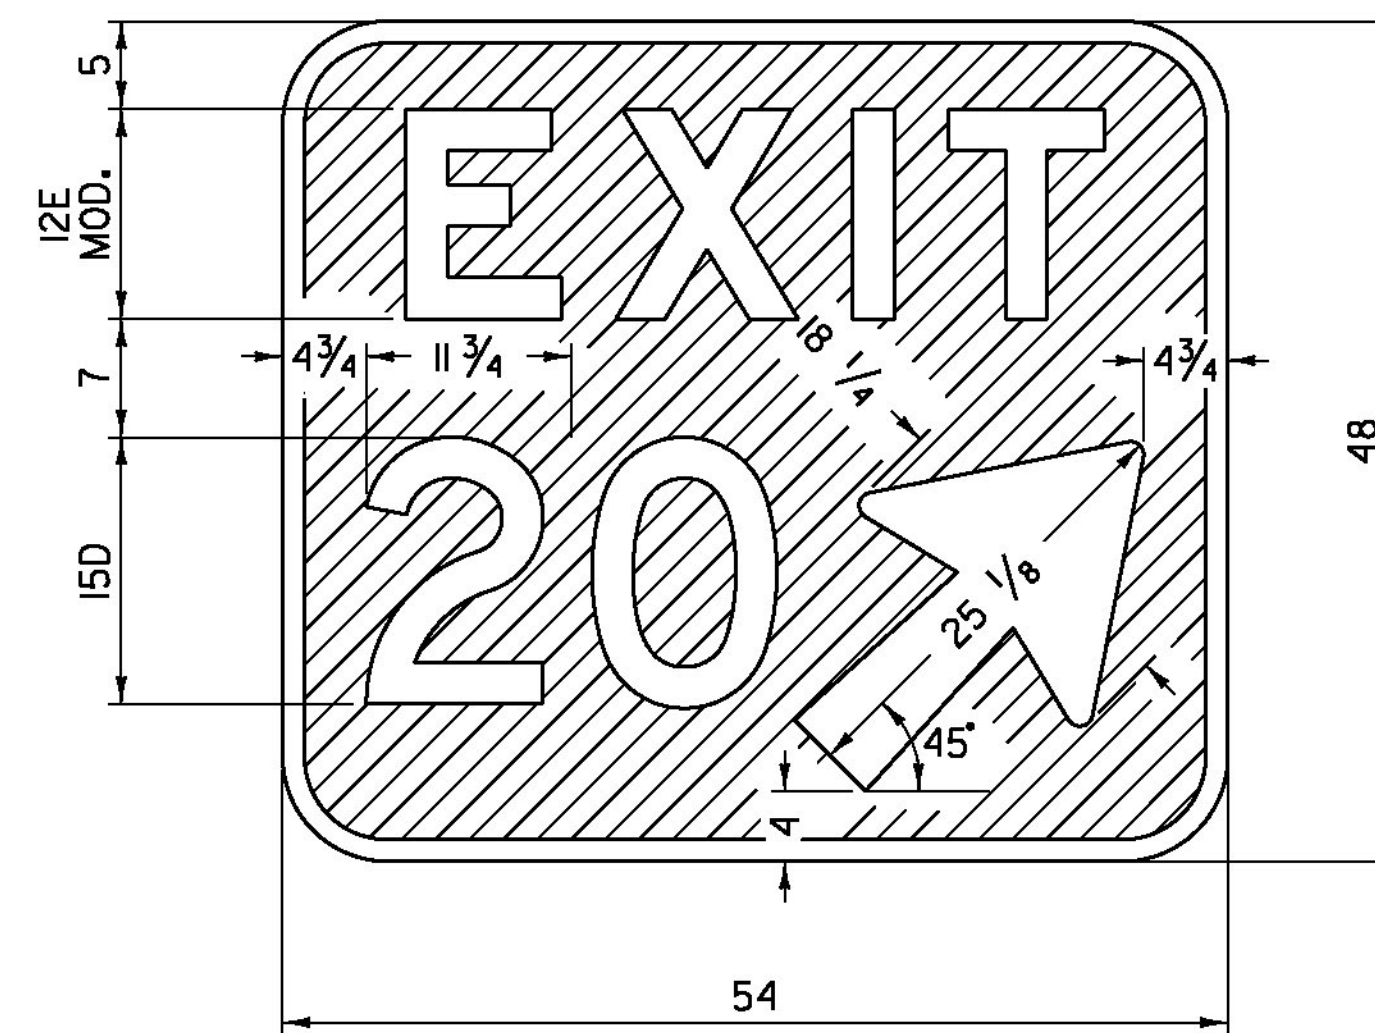

VC5-1A

NOTES:

- THE SIGN SHALL BE WHITE RETROREFLECTIVE LEGEND ON A GREEN RETROREFLECTIVE BACKGROUND, BOTH SHALL HAVE RETROREFLECTIVE SHEETING EQUAL TO OR EXCEEDING "AMERICAN ASSOCIATION OF STATE HIGHWAY AND TRANSPORTATION OFFICIALS" (AASHTO) M 268 ["AMERICAN SOCIETY FOR TESTING AND MATERIALS" (ASTM) D 4956] TYPE III.
- CORNERS SHALL BE ROUNDED TO A SIX INCH RADIUS.
- THE SIGN SHALL HAVE A 1 1/4 INCH WIDE BORDER ALONG THE EDGE OF THE SIGN.
- EXIT NUMBER SHALL BE AS PER PLANS, OPTICALLY SPACED.
- "EXIT" SHALL BE CENTERED HORIZONTALLY.

GENERAL NOTES:

- ALL DIMENSIONS IN INCHES.

OTHER STDS. REQUIRED: T-1

REVISIONS AND CORRECTIONS
AUG. 6, 2012 - ORIGINAL APPROVAL DATE

APPROVED
[Signature]
HIGHWAY SAFETY & DESIGN ENGINEER
[Signature]
DIRECTOR OF PROGRAM DEVELOPMENT
[Signature]
MARK D. RICHTER
FEDERAL HIGHWAY ADMINISTRATION

CONSTRUCTION SIGN
DETAILS



STANDARD
T-31

1 - ADDISON	2 - BENNINGTON	3 - CALEDONIA	4 - CHITTENDEN	5 - ESSEX	6 - FRANKLIN	7 - GRAND ISLE	8 - LAMOILLE
0101 ADDISON 0102 BRIDPORT 0103 BRISTOL 0104 CORNWALL 0105 FERRISBURGH 0106 GOSHEN 0107 GRANVILLE 0108 HANCOCK 0109 LEICESTER 0110 LINCOLN 0111 MIDDLEBURY 0112 MONKTON 0113 NEW HAVEN 0114 ORWELL 0115 PANTON 0116 RIPTON 0117 SALISBURY 0118 SHOREHAM 0119 STARKSBORO 0120 VERGENNES 0121 WALTHAM 0122 WEYBRIDGE 0123 WHITING	0201 ARLINGTON 0202 BENNINGTON 0203 DORSET 0204 GLASTENBURY 0205 LANDGROVE 0206 MANCHESTER 0207 PERU 0208 POWNAL 0209 READSBORO 0210 RUPERT 0211 SANDGATE 0212 SEARSBURG 0213 SHAFTSBURY 0214 STAMFORD 0215 SUNDERLAND 0216 WINHALL 0217 WOODFORD	0301 BARNET 0302 BURKE 0303 DANVILLE 0304 GROTON 0305 HARDWICK 0306 KIRBY 0307 LYNDON 0308 NEWARK 0309 PEACHAM 0310 RYEGATE 0311 ST JOHNSBURY 0312 SHEFFIELD 0313 STANNARD 0314 SUTTON 0315 WALDEN 0316 WATERFORD 0317 WHEELOCK	0401 BOLTON 0402 BUELS GORE 0403 BURLINGTON 0404 CHARLOTTE 0405 COLCHESTER 0406 ESSEX 0407 HINESBURG 0408 HUNTINGTON 0409 JERICHO 0410 MILTON 0411 RICHMOND 0412 ST GEORGE 0413 SHELburne 0414 SO BURLINGTON 0415 UNDERHILL 0416 WESTFORD 0417 WILLISTON 0418 WINOOSKI	0501 AVERILL 0502 AVERYS GORE 0503 BLOOMFIELD 0504 BRIGHTON 0505 BRUNSWICK 0506 CANAAN 0507 CONCORD 0508 EAST HAVEN 0509 FERDINAND 0510 GRANBY 0511 GUILDHALL 0512 LEMINGTON 0513 LEWIS 0514 LUNENBURG 0515 MAIDSTONE 0516 NORTON 0517 VICTORY 0518 WARNERS GRANT 0519 WARREN GORE	0601 BAKERSFIELD 0602 BERKSHIRE 0603 ENOSBURG 0604 FAIRFAX 0605 FAIRFIELD 0606 FLETCHER 0607 FRANKLIN 0608 GEORGIA 0609 HIGHGATE 0610 MONTGOMERY 0611 RICHFORD 0612 ST ALBANS CITY 0613 ST ALBANS TOWN 0614 SHELDON 0615 SWANTON	0701 ALBURGH 0702 GRAND ISLE 0703 ISLE LA MOTTE 0704 NORTH HERO 0705 SOUTH HERO	0801 BELVIDERE 0802 CAMBRIDGE 0803 EDEN 0804 ELMORE 0805 HYDE PARK 0806 JOHNSON 0807 MORRISTOWN 0808 STOWE 0809 WATERVILLE 0810 WOLCOTT

9 - ORANGE	10 - ORLEANS	11 - RUTLAND	12 - WASHINGTON	13 - WINDHAM	14 - WINDSOR
0901 BRADFORD 0902 BRAINTREE 0903 BROOKFIELD 0904 CHELSEA 0905 CORINTH 0906 FAIRLEE 0907 NEWBURY 0908 ORANGE 0909 RANDOLPH 0910 STRAFFORD 0911 THETFORD 0912 TOPSHAM 0913 TUNBRIDGE 0914 VERSHIRE 0915 WASHINGTON 0916 WEST FAIRLEE 0917 WILLIAMSTOWN	1001 ALBANY 1002 BARTON 1003 BROWNINGTON 1004 CHARLESTON 1005 COVENTRY 1006 CRAFTSBURY 1007 DERBY 1008 GLOVER 1009 GREENSBORO 1010 HOLLAND 1011 IRASBURG 1012 JAY 1013 LOWELL 1014 MORGAN 1015 NEWPORT CITY 1016 NEWPORT TOWN 1017 TROY 1018 WESTFIELD 1019 WESTMORE	1101 BENSON 1102 BRANDON 1103 CASTLETON 1104 CHITTENDEN 1105 CLARENDON 1106 DANBY 1107 FAIR HAVEN 1108 HUBBARDTON 1109 IRA 1110 MENDON 1111 MIDDLETOWN SPRINGS 1112 MT HOLLY 1113 MT TABOR 1114 PAWLET 1115 PITTSFIELD 1116 PITTSFORD 1117 POULTNEY 1118 PROCTOR 1119 RUTLAND CITY 1120 RUTLAND TOWN 1121 KILLINGTON 1122 SHREWSBURY 1123 SUDBURY 1124 TINMOUTH 1125 WALLINGFORD 1126 WELLS 1127 WEST HAVEN 1128 WEST RUTLAND	1201 BARRE CITY 1202 BARRE TOWN 1203 BERLIN 1204 CABOT 1205 CALAIS 1206 DUXBURY 1207 E MONTPELIER 1208 FAYSTON 1209 MARSHFIELD 1210 MIDDLESEX 1211 MONTPELIER 1212 MORETOWN 1213 NORTHFIELD 1214 PLAINFIELD 1215 ROXBURY 1216 WAITSFIELD 1217 WARREN 1218 WATERBURY 1219 WOODBURY 1220 WORCESTER	1301 ATHENS 1302 BRATTLEBORO 1303 BROOKLINE 1304 DOVER 1305 DUMMERSTON 1306 GRAFTON 1307 GUILFORD 1308 HALIFAX 1309 JAMAICA 1310 LONDONDERRY 1311 MARLBORO 1312 NEWFANE 1313 PUTNEY 1314 ROCKINGHAM 1315 SOMERSET 1316 STRATTON 1317 TOWNSHEND 1318 VERNON 1319 WARDSBORO 1320 WESTMINSTER 1321 WHITINGHAM 1322 WILMINGTON 1323 WINDHAM	1401 ANDOVER 1402 BALTIMORE 1403 BARNARD 1404 BETHEL 1405 BRIDGEWATER 1406 CAVENDISH 1407 CHESTER 1408 HARTFORD 1409 HARTLAND 1410 LUDLOW 1411 NORWICH 1412 PLYMOUTH 1413 POMFRET 1414 READING 1415 ROCHESTER 1416 ROYALTON 1417 SHARON 1418 SPRINGFIELD 1419 STOCKBRIDGE 1420 WEATHERSFIELD 1421 WESTON 1422 WEST WINDSOR 1423 WINDSOR 1424 WOODSTOCK

COUNTY AND TOWN DESIGNATIONS




9020 BARNET STATE HIGHWAY
9025 BENNINGTON NORTH STATE HIGHWAY
9030 BERLIN STATE HIGHWAY
9090 BRATTLEBORO STATE HIGHWAY
9150 CASTLETON STATE HIGHWAY
9180 COVENTRY STATE HIGHWAY
9210 FAIR HAVEN STATE HIGHWAY
9240 FAIRLEE STATE HIGHWAY
9270 FERRISBURGH STATE HIGHWAY
9330 MAIDSTONE STATE HIGHWAY
9360 MIDDLESEX STATE HIGHWAY
9390 MONTPELIER STATE HIGHWAY
9420 MONTPELIER JUNCTION STATE HIGHWAY
9430 NEWBURY STATE HIGHWAY
9480 NORTON STATE HIGHWAY
9540 NORWICH STATE HIGHWAY
9600 PUTNEY STATE HIGHWAY
9630 QUECHEE STATE HIGHWAY
9720 ST ALBANS STATE HIGHWAY SOUTH
9730 ST JOHNSBURY STATE HIGHWAY
9750 SOUTH ALBURGH STATE HIGHWAY
9840 WESTMINSTER STATE HIGHWAY
9870 WILDER STATE HIGHWAY
9900 WINHALL STATE HIGHWAY
9990 WEST RUTLAND - RUTLAND (BUSINESS US-4)
9991 BELLOW FALLS S0117 (ROCK - WEST ST)
9992 BELLOW FALLS S0117 (BRIDGE ST)
9993 BURLINGTON (ALTERNATE US-7)
9994 DERBY (ALTERNATE US-5)
9995 MONTPELIER (BUSINESS US-2)
9996 NEWPORT (ALTERNATE US-5)
9997 ST JOHNSBURY (ALTERNATE US-5)
9998 SO BURLINGTON - KENNEDY DRIVE

NAMED STATE AND TOWN HIGHWAYS ROUTE NUMBERS

GENERAL NOTES:

- MILEMARKERS ARE TO BE INSTALLED ALONG THE FEDERAL AID HIGHWAY SYSTEM INCLUDING ALL STATE HIGHWAYS AND TOWN HIGHWAYS ON THE FEDERAL AID HIGHWAY SYSTEM.
- MILEMARKERS WILL NORMALLY BE INSTALLED AT EACH 0.20 MILE INTERVAL, ALTERNATING SIDES OF THE ROAD, RESULTING IN A SIGN FACING TRAFFIC EACH 0.40 MILES. A MILEMARKER WILL ALSO BE INSTALLED AT EACH INTERSECTION, ON THE SAME POST AS THE STOP SIGN (MILEMARKER TO BE PLACED PARALLEL TO MAINLINE TRAVELED WAY, VISIBLE TO TRAFFIC). ANY MILEMARKER LOCATION FALLING WITHIN 0.05 MILE OF AN INTERSECTION WILL BE OMITTED. WHEN THE NORMAL LOCATION OF A MILEMARKER IS UNDESIRABLE, SUCH AS ON A LAWN, DRIVEWAY, OR LEDGE, AN ATTEMPT WILL BE MADE TO LOCATE IT ON THE OPPOSITE SIDE OF THE ROAD. IF NO SUITABLE LOCATION CAN BE FOUND WITHIN 20 FEET OF THE NORMAL LOCATION, IT MAY BE OMITTED.
- ON CLASS I TOWN HIGHWAYS OR OTHER CONGESTED LOCATIONS MILEMARKERS WILL ONLY BE INSTALLED ON EXISTING SIGN POSTS AND WILL CARRY THE ACTUAL MILEAGE TO THAT LOCATION. A MILEMARKER LOCATED EVERY 0.10 MILES IS DESIRABLE THROUGH THESE LOCATIONS.
- THE FIRST LINE OF TEXT ON MILEMARKERS INDICATE THE STATE ROUTE NUMBER. THE FOURTH NUMERAL BEING THE CORRESPONDING ROUTE NUMBER LETTER DESIGNATION. FOR EXAMPLE US-2 (WHICH HAS NO LETTER DESIGNATION) WOULD BE IDENTIFIED USING 0020 AND VT-100B WOULD BE IDENTIFIED USING 1002. FOR ANY NAMED FEDERAL AID HIGHWAY SYSTEM HIGHWAYS, THE FOUR DIGIT ROUTE NUMBER (9000 SERIES) LISTED UNDER "NAMED STATE AND TOWN HIGHWAYS ROUTE NUMBERS" SHALL BE UTILIZED.
- THE SECOND LINE OF TEXT ON MILEMARKERS INDICATE THE COUNTY AND TOWN. THE COUNTY IS INDICATED IN THE FIRST AND SECOND NUMERALS AND THE TOWN IN THE THIRD AND FOURTH NUMERALS. THE APPROPRIATE FOUR DIGIT DESIGNATIONS ARE LISTED PER TOWN, UNDER "COUNTY AND TOWN DESIGNATIONS."
- THE THIRD LINE OF TEXT ON MILEMARKERS INDICATE THE MILEAGE, IN HUNDRETHS, FROM THE TOWN LINE OR BEGINNING OF A ROUTE. MILEAGE IS ALWAYS MEASURED TRAVELING FROM THE SOUTH TO NORTH OR FROM THE WEST TO EAST. THE ROUTE DIRECTION IS ESTABLISHED USING THE VERMONT AGENCY OF TRANSPORTATION (VAOT) ROUTE LOGS.
- THE SIGN BASE MATERIAL SHALL BE 0.063 INCH FLAT SHEET ALUMINUM.
- THE SIGN SHALL BE WHITE RETROREFLECTIVE LEGEND ON A GREEN RETROREFLECTIVE BACKGROUND, BOTH SHALL HAVE RETROREFLECTIVE SHEETING EQUAL TO OR EXCEEDING "AMERICAN ASSOCIATION OF STATE HIGHWAY AND TRANSPORTATION OFFICIALS" (AASHTO) M 268 ("AMERICAN SOCIETY FOR TESTING AND MATERIALS" (ASTM) D 4956J TYPE III.
- CORNERS SHALL BE ROUNDED TO A 1/2 INCH RADIUS.
- ALL LINES OF TEXT SHALL BE CENTERED HORIZONTALLY AND SHALL BE AS IDENTIFIED IN THE PLANS. THE THREE LINES OF TEXT WILL EACH CONTAIN FOUR NUMERALS.
- WHEN INSTALLED ON ITS OWN POST, A SINGLE 14 GAGE, 1.75 INCH SQUARE STEEL POST AND 12 GAGE, 2 INCH SQUARE ANCHOR SHALL BE USED FOR INSTALLATION. THE ANCHOR SHALL BE A MINIMUM OF 30 INCHES IN LENGTH.
- ALL DIMENSIONS SHOWN IN INCHES.


OTHER STDS. REQUIRED: T-45

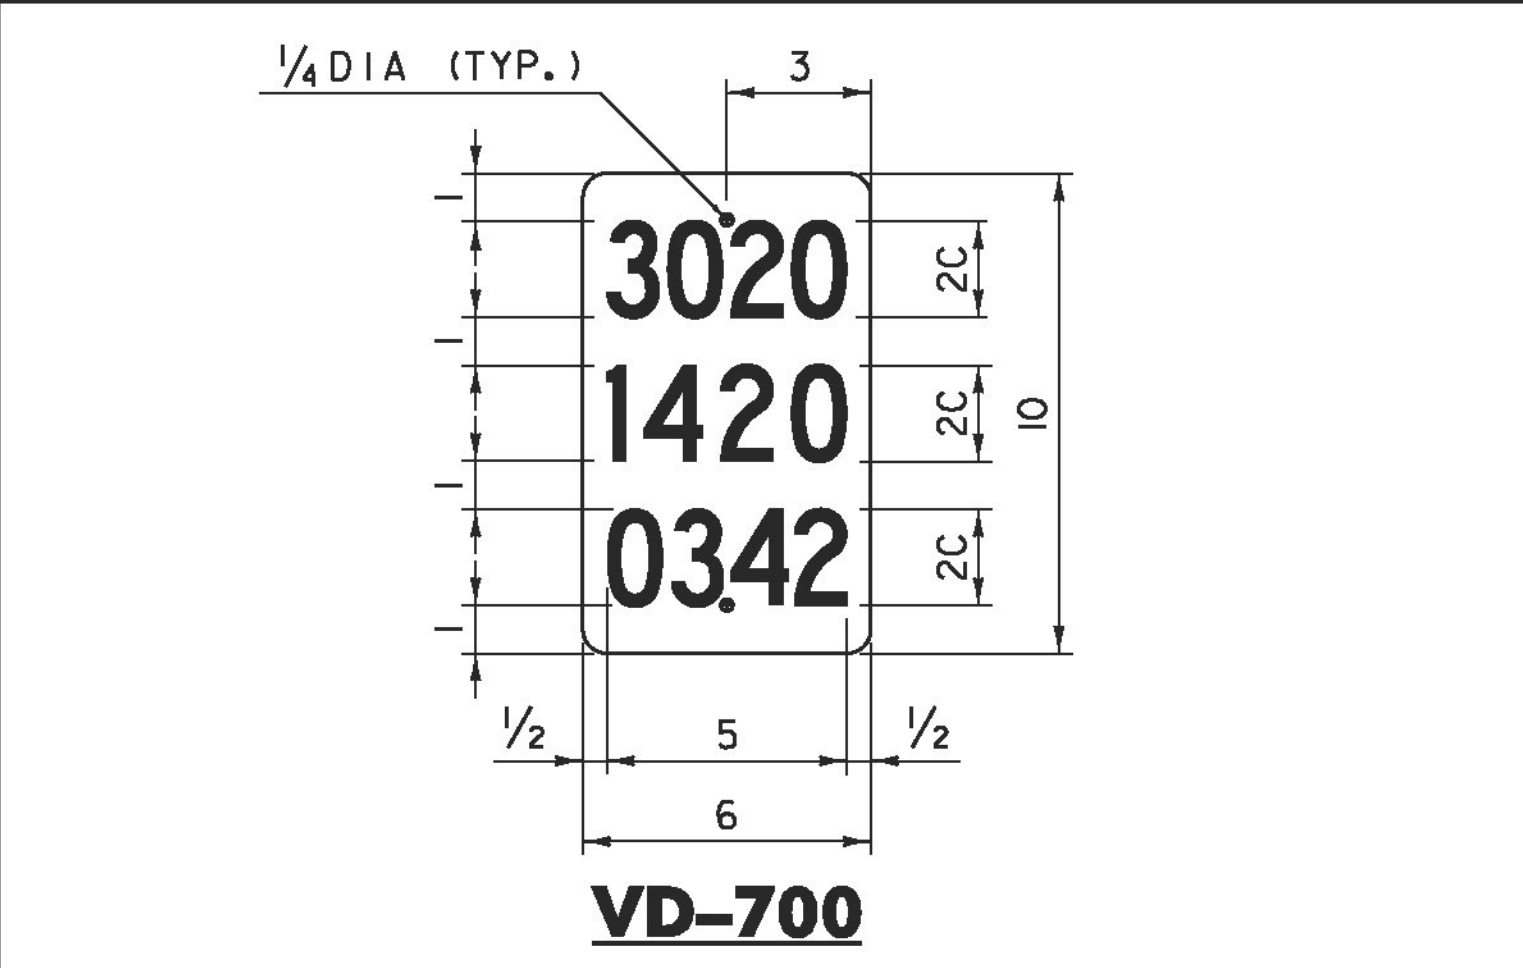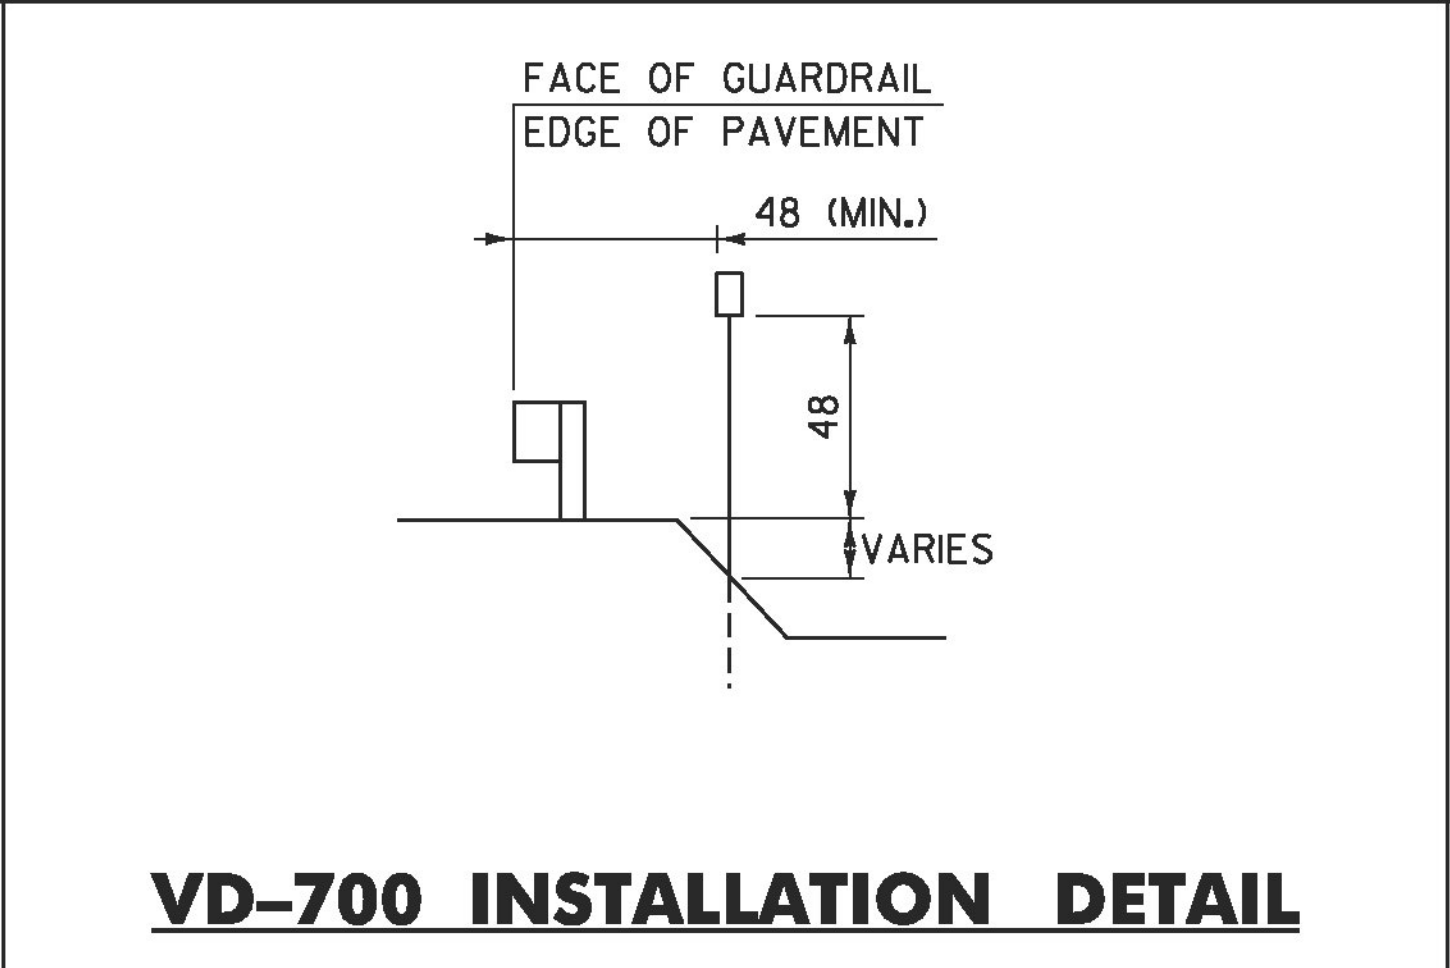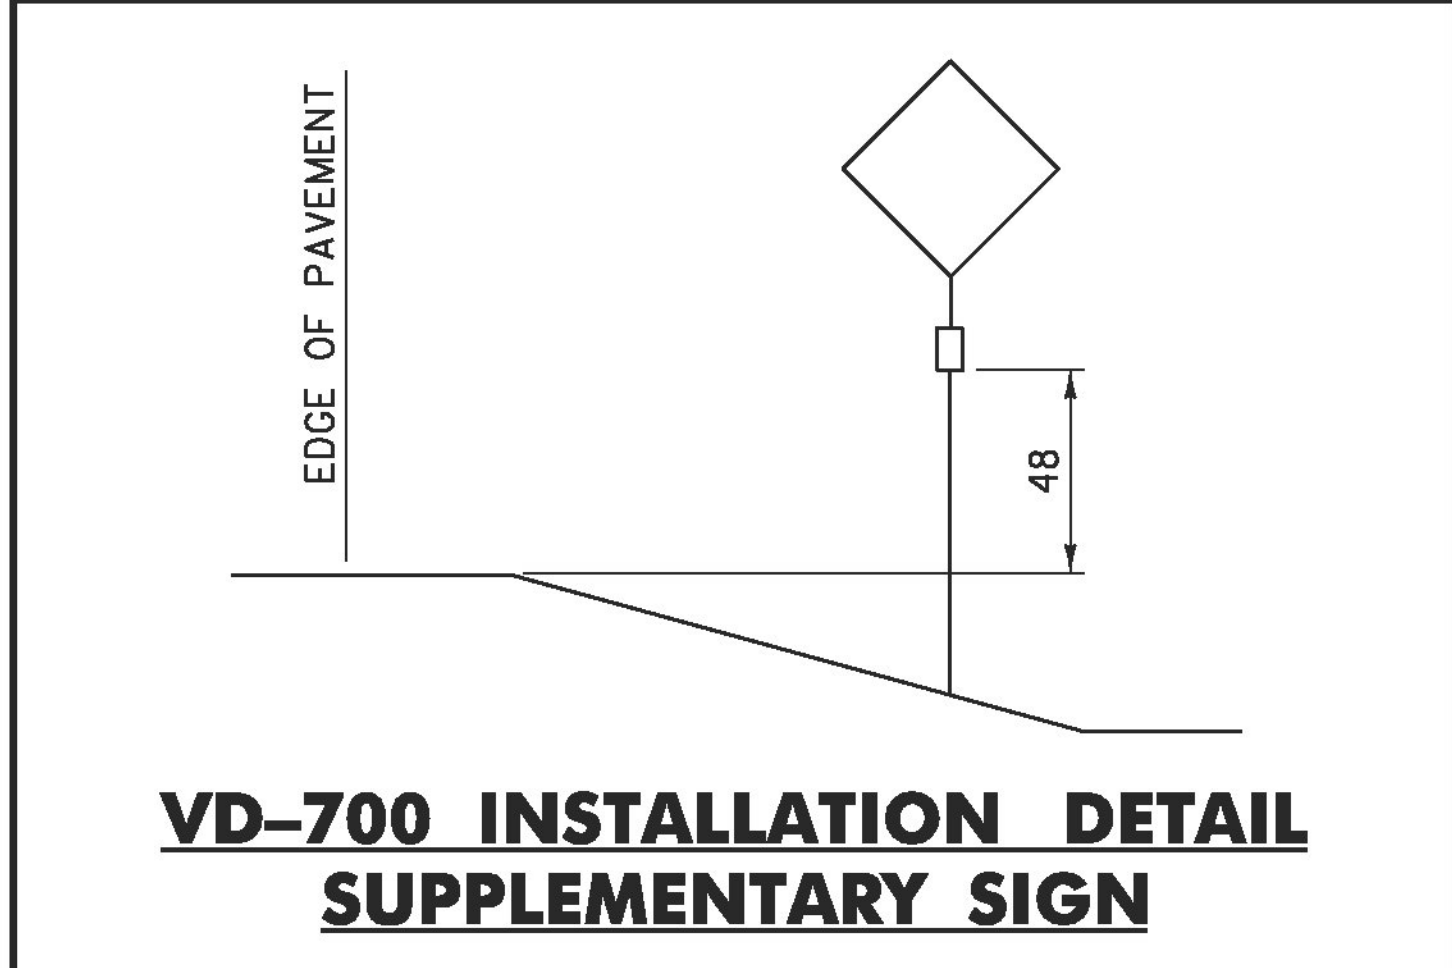


REVISIONS AND CORRECTIONS
APRIL 9, 2014 - ORIGINAL APPROVAL DATE

APPROVED
[Signature]
HIGHWAY SAFETY & DESIGN ENGINEER
[Signature]
DIRECTOR OF PROGRAM DEVELOPMENT
[Signature]
FEDERAL HIGHWAY ADMINISTRATION

**MILEMARKER DETAILS
STATE AND TOWN
HIGHWAYS**

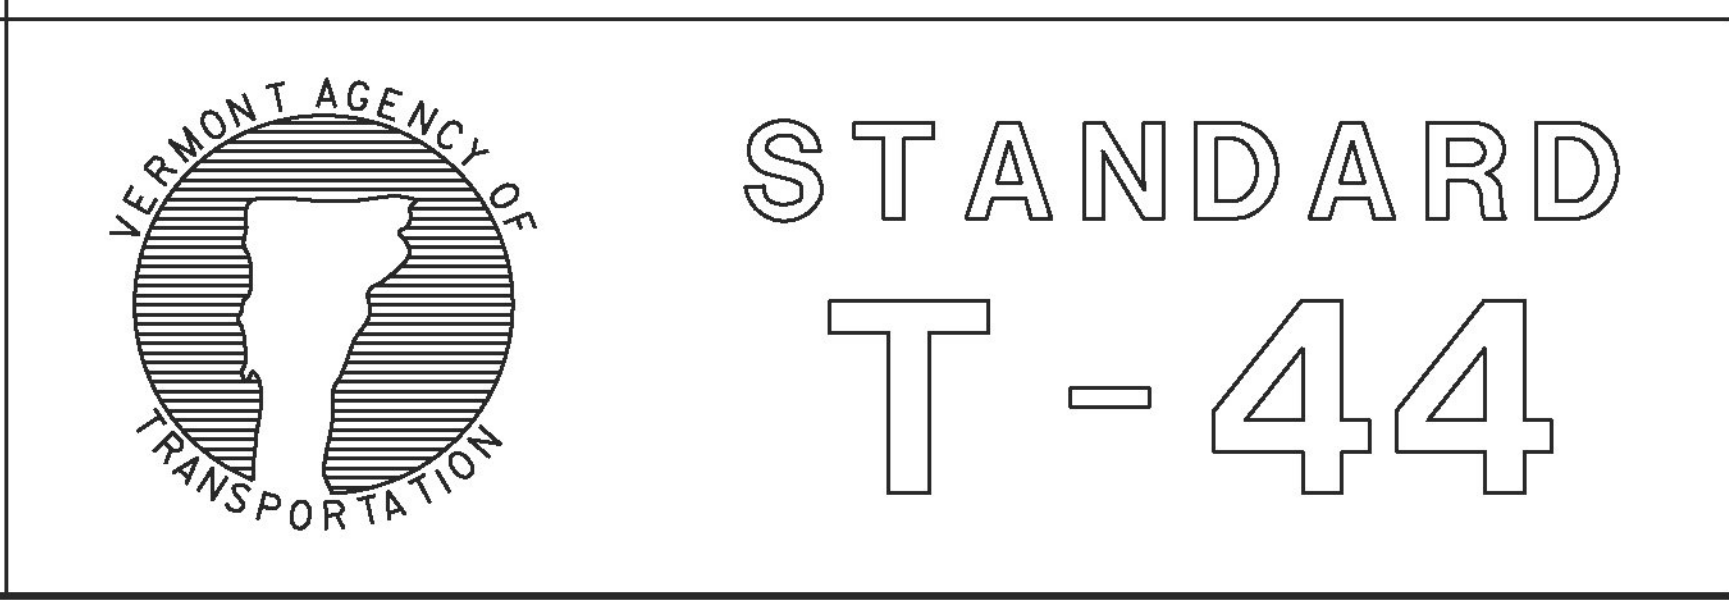


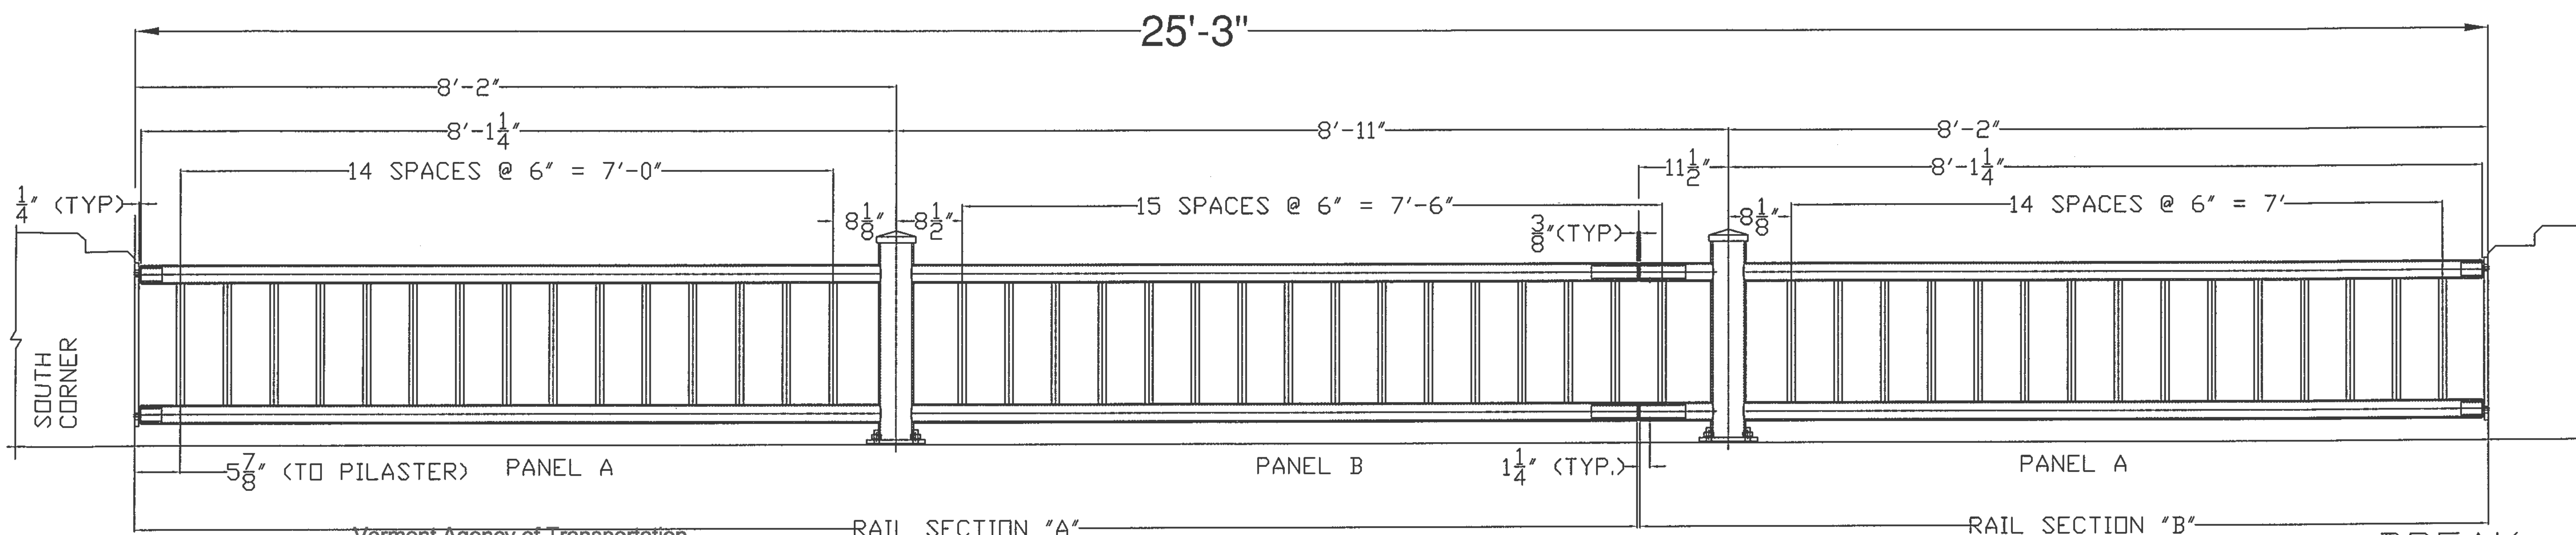

Vermont Agency of Transportation
RECEIVED
 ON: June 2, 2016
 and Checked for
CONFORMANCE
 BY: Jennifer Fitch DATE: 06/03/16

WEST RAILING, FACING WEST

BREAK
 LINE "A"

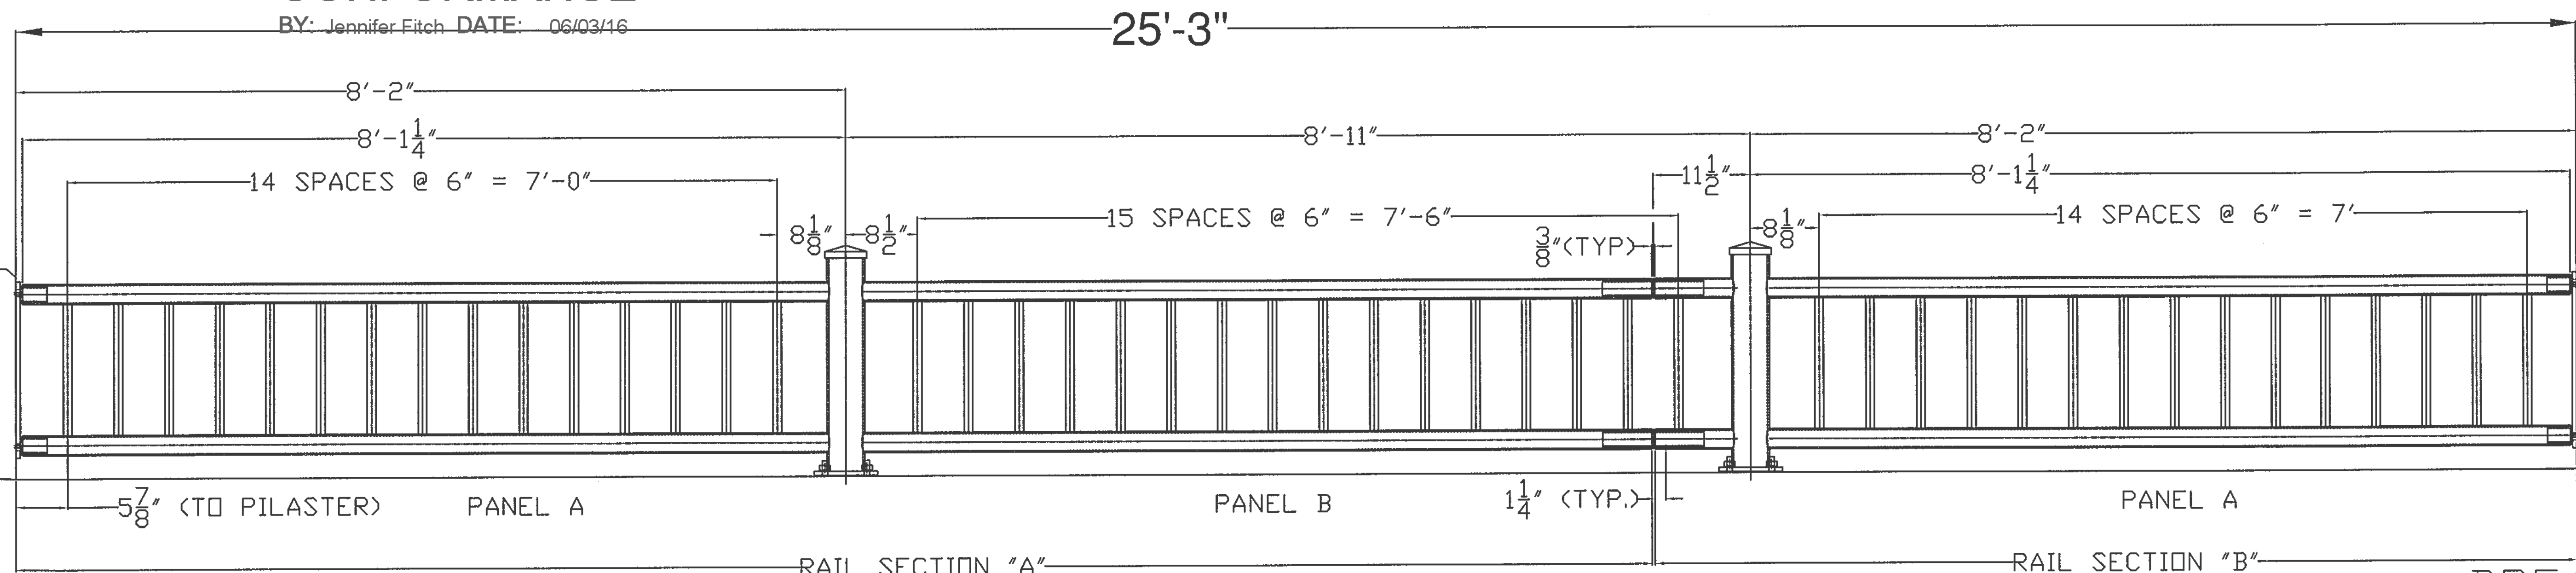

BREAK
 LINE "A"

WEST RAILING, FACING WEST

BREAK
 LINE "B"

- BRIDGE RAIL NOTES**
1. ALL DIMENSIONS TO FACE OF CONCRETE UNLESS NOTED OTHERWISE.
 2. RAIL POSTS SHALL BE SET NORMAL TO GRADE.
 3. PAYMENT SHALL BE MADE UNDER PAY ITEM 900.640 SPECIAL PROVISION (BRIDGE RAILING, GALVANIZED METAL HAND RAILING/CONCRETE PARAPET COMBINATION).
 4. REINFORCING STEEL SHALL CONFORM TO SECTION 507 FOR LEVEL II REINFORCEMENT. PAYMENT SHALL BE MADE UNDER PAY ITEM SPECIAL PROVISION (BRIDGE RAILING, GALVANIZED METAL HAND RAILING/CONCRETE PARAPET COMBINATION).
 5. METAL HAND RAILING, TO INCLUDE STEEL PIPES, PLATES AND HARDWARE, SHALL BE PAID FOR UNDER ITEM SPECIAL PROVISION (BRIDGE RAILING, GALVANIZED METAL HAND RAILING/CONCRETE PARAPET COMBINATION).
 6. STEEL PIPES FOR POSTS, TOP AND BOTTOM RAIL AND PALINGS SHALL BE SEAMLESS, CONFORMING TO SUBSECTION 732.01.
 7. STEEL FOR BASE AND ANCHORAGE PLATES SHALL CONFORM TO SUBSECTION 732.03(b).
 8. HARDWARE FOR ANCHOR BOLT ASSEMBLIES SHALL CONFORM TO SUBSECTION 732.03(d).
 9. 1/8" PAD SHALL CONFORM TO SUBSECTION 731.01 OR 731.02.
 10. ALL EXPOSED CUT OR SHEARED EDGES OF STEEL COMPONENTS SHALL BE ROUNDED TO A 1/16" RADIUS AND BE FREE OF BURRS.
 11. ALL PARTS SHALL BE GALVANIZED AFTER FABRICATION IN ACCORDANCE WITH AASHTO M 111/M 111 (ASTM A123), EXCEPT HARDWARE, WHICH SHALL MEET THE REQUIREMENTS OF AASHTO M 232/M 232 (ASTM A153).
 12. ALL PARTS EXCEPT HARDWARE AND ANCHORAGE PLATES SHALL BE PAINTED BLACK (COLOR CHIP #27038).
 13. RAIL POST ANCHORING NUTS SHALL BE TIGHTENED TO A SNUG FIT AND GIVEN AN ADDITIONAL ONE-EIGHTH TURN.
 14. THE FABRICATOR SHALL SUBMIT FABRICATION DRAWINGS INCLUDING WELDING PROCEDURES FOR METAL HAND RAILING IN ACCORDANCE WITH SECTION 105.

SHOP DRAWING REVIEW

REVIEWED AS REQUIRED BY THE CONSTRUCTION CONTRACT DOCUMENTS AND APPROVED, BUT ONLY FOR CONFORMANCE TO THE DESIGN AND SUBJECT TO FURTHER LIMITATIONS AND REQUIREMENTS CONTAINED IN THE CONSTRUCTION CONTRACT DOCUMENTS.

REVISIONS REQUESTED APPROVED AS NOTED

CORRECTIONS OR COMMENTS MADE ON THE SHOP DRAWINGS DURING THIS REVIEW DID NOT RELIEVE CONTRACTOR FROM COMPLIANCE WITH REQUIREMENTS OF THE DRAWINGS AND SPECIFICATIONS. THIS CHECK IS ONLY FOR REVIEW OF GENERAL CONFORMANCE WITH THE DESIGN CONCEPT OF THE PROJECT AND GENERAL COMPLIANCE WITH THE INFORMATION GIVEN IN THE CONTRACT DOCUMENTS. THE CONTRACTOR IS RESPONSIBLE FOR CONFIRMING AND CORRELATING ALL QUANTITIES AND DIMENSIONS, SELECTING FABRICATION PROCESSES AND TECHNIQUES OF CONSTRUCTION, COORDINATING THEIR WORK WITH THAT OF ALL OTHER TRADES, AND PERFORMING THEIR WORK IN A SAFE AND SATISFACTORY MANNER.

Job Number: 150223
 Reviewed by: SRB
 Date: 06/03/2016

ITEM #: 900.640

APPROVED BY:

BRIDGE RAIL DETAILS SHEET
 BRATTLEBORO BR 2000 (26)
 VERMONT


R NO.	DATE	DESCRIPTION	BY	R NO.	DATE	DESCRIPTION	BY
E 1	6/2/16	REVISED PER 5/18/16 DWG REVIEW	E.P.	E 1			

ELDERLEE, INC.
 OAKS CORNERS, NEW YORK 14518
 E-Mail: dlong@elderlee.com
 Tel: 315-789-6670 Fax: 315-789-6615

CERTIFIED FABRICATOR


DRAWN	E.P.	5/4/16
CHECKED	D.L.	5/4/16
APPROVED		
SCALE	SCHEMATIC	
DRAWING NO. F.R. LAFAYETTE-BRATTLEBORO (26)		

SHEET 1 OF 5

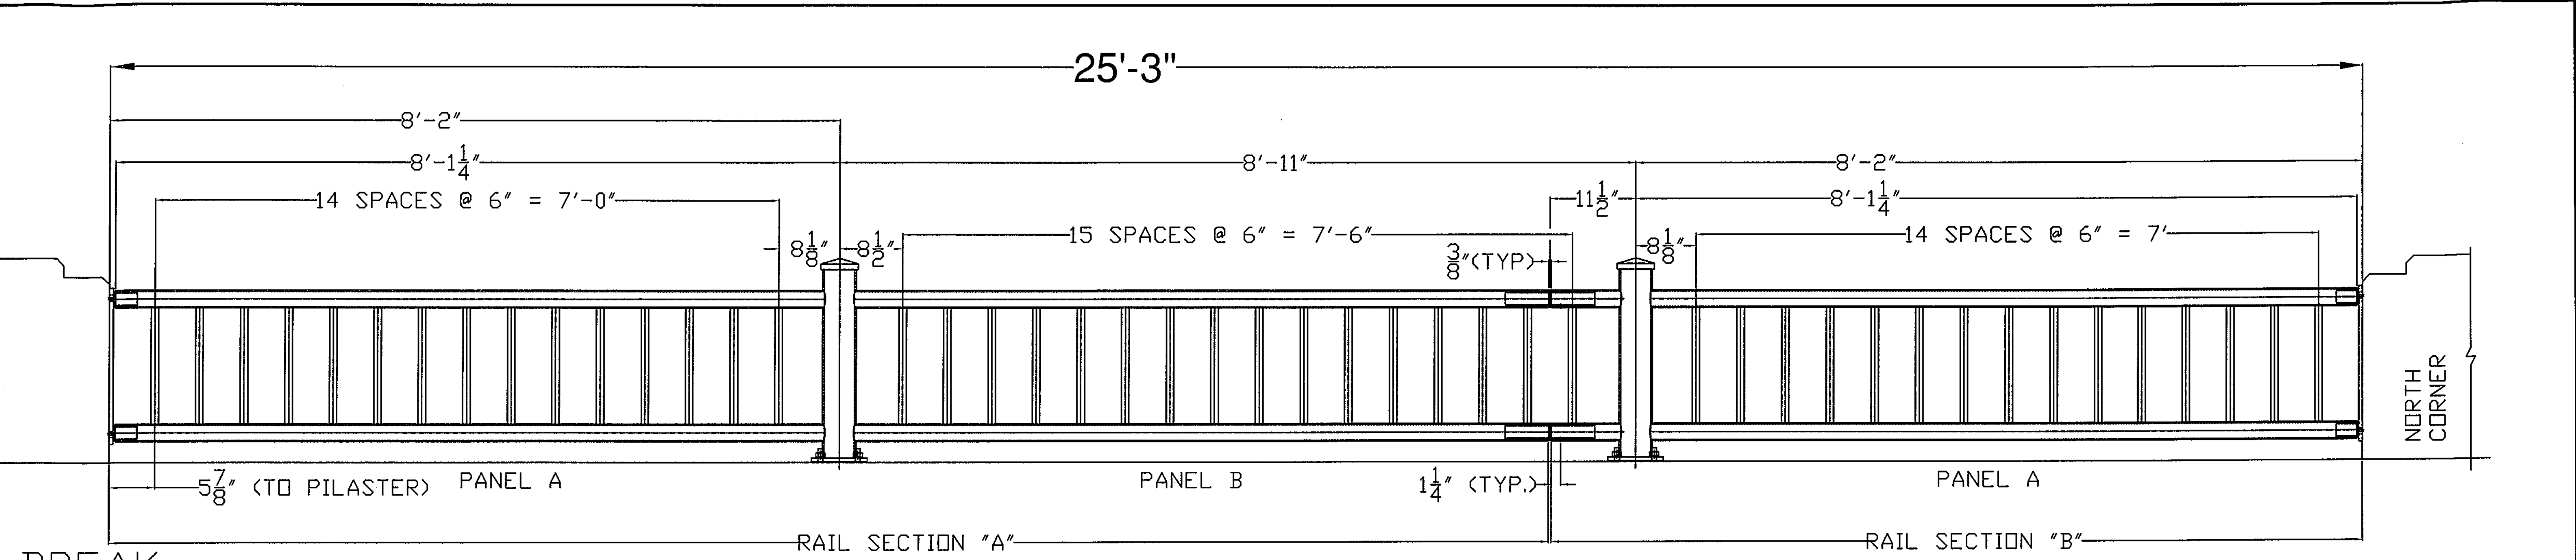

BREAK
LINE "B"

WEST RAILING, FACING WEST

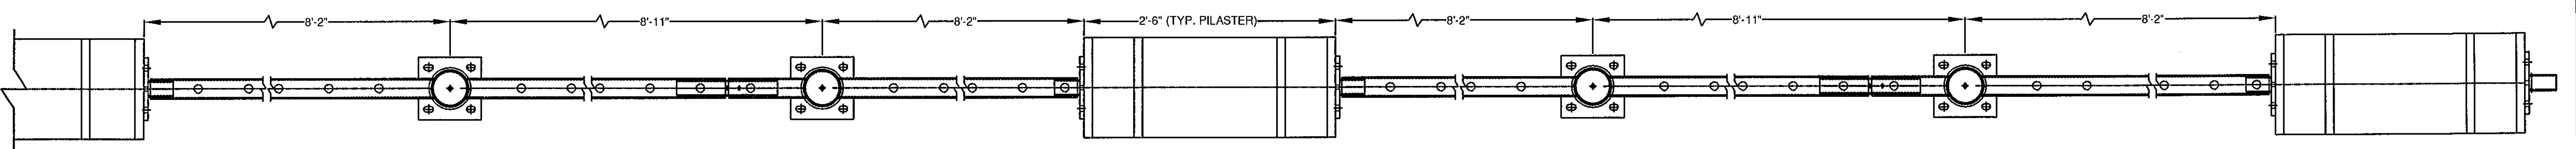


SOUTH CORNER

PLAN VIEW OF A SECTION OF THE WEST RAIL


BILL OF MATERIAL			
ITEM	QTY	DESCRIPTION	ASTM DESIGNATION
1	5	RAIL SECTION "A" W/ BASE PLATE	A500/A53 Gr. B/A572 Gr. 50 CVN
2	6	RAIL SECTION "B" W/ BASE PLATE	A500/A53 Gr. B/A572 Gr. 50 CVN
3	1	RAIL SECTION "C" W/ BASE PLATE	A500/A53 Gr. B/A572 Gr. 50 CVN
4	12	RAIL SPLICE (1 1/2" SCHEDULE 40)	A500/A53 Grade B
5	12	Ø3/8" X 1/2" SOCKET, BUTTON HEAD CAP SCREW	A307 (ZINC PLATED - IMPORTS)
6	13	POST ANCHOR PLATES, 1/8" X 7 1/2" X 7 1/2"	A36
7	12	SIDE ANCHOR PLATES, 1/8" X 7 1/2" X 1'-9"	A36
8	12	SIDE BASE PLATES, 1/2" X 7 1/2" X 1'-9"	A572 Gr. 50 CVN
9	*102	Ø 5/8" X 10" FULLY THREADED ANCHOR STUDS	A449
10	100	Ø 5/8" HEX JAM NUTS	A563
11	202	Ø 5/8" HEAVY HEX NUTS	A563
12	302	Ø 5/8" FLAT WASHERS	F436
13	13	1/8" X 7 1/2" X 7 1/2" POST BEARING PAD	AASHTO M251
14	2	"W" PANEL TERMINAL CONNECTOR, 10 Ga.	AASHTO M180
15	2	CONNECTION PLATE W/ 1" SCHED. 40 PIPE	A500/A53 Grade B/A36
16	16	Ø 5/8" PANEL BOLTS, NUTS	A307
17	12	Ø 7/8" X 12" FULLY THREADED ANCHOR STUDS	A449
18	24	Ø 7/8" HEAVY HEX NUTS	A563
19	24	Ø 7/8" FLAT WASHERS	F436

* - TWO ADDITIONAL FOR Vtrans QA TESTING

Vermont Agency of Transportation
RECEIVED
ON: June 2, 2016
and Checked for
CONFORMANCE
BY: Jennifer Fitch DATE: 06/03/16

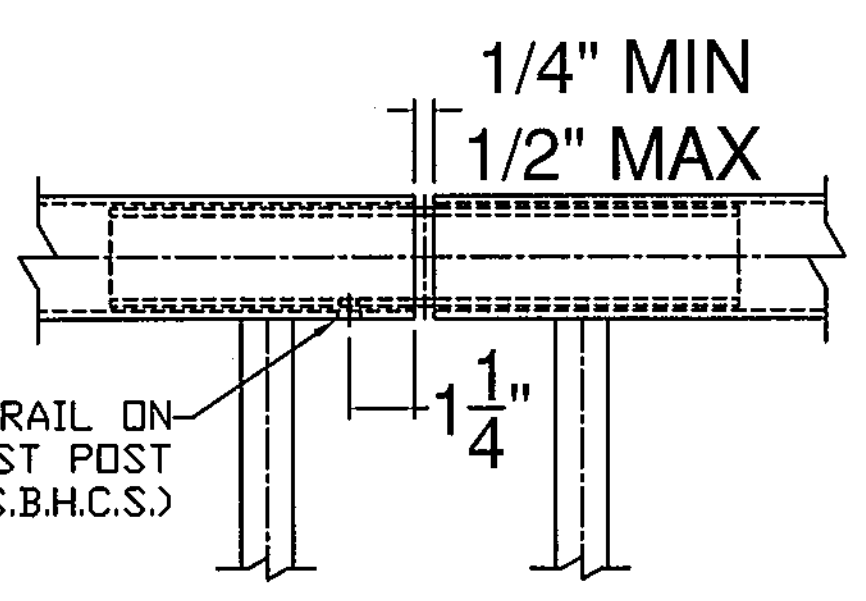

RAIL SPLICE DETAIL

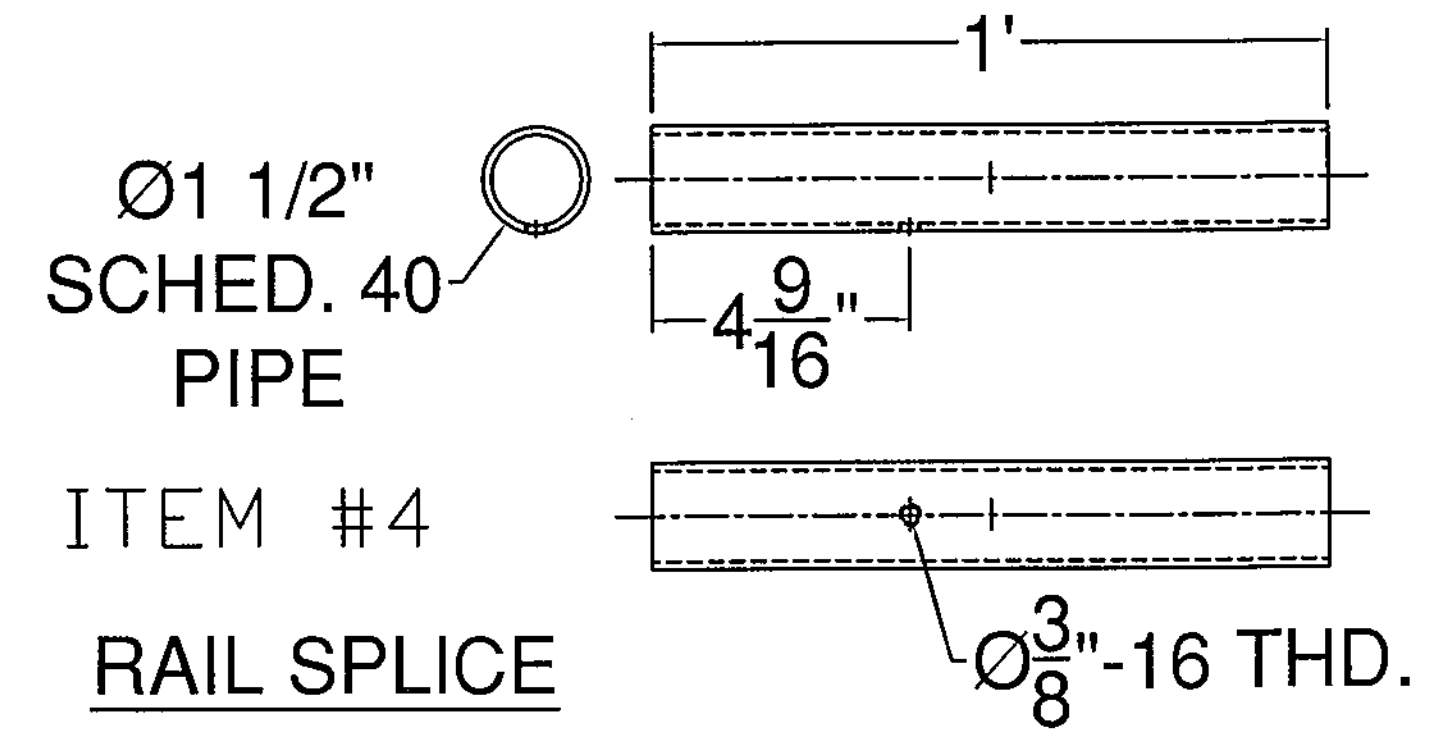

ITEM #4

RAIL SPLICE

SHOP DRAWING REVIEW

REVIEWED AS REQUIRED BY THE CONSTRUCTION CONTRACT DOCUMENTS AND APPROVED, BUT ONLY FOR CONFORMANCE TO THE DESIGN CONCEPT OF THE WORK, AND SUBJECT TO FURTHER LIMITATIONS AND REQUIREMENTS CONTAINED IN THE CONSTRUCTION CONTRACT DOCUMENTS.

REJECTED REVISE AND RESUBMIT APPROVED AS NOTED

CORRECTIONS OR COMMENTS MADE ON THE SHOP DRAWINGS DURING THIS REVIEW DID NOT RELIEVE CONTRACTOR FROM COMPLIANCE WITH REQUIREMENTS OF THE DRAWINGS AND SPECIFICATIONS. THIS CHECK IS ONLY FOR REVIEW OF GENERAL CONFORMANCE WITH THE DESIGN CONCEPT OF THE PROJECT AND GENERAL COMPLIANCE WITH THE INFORMATION GIVEN IN THE CONTRACT DOCUMENTS. THE CONTRACTOR IS RESPONSIBLE FOR CONFIRMING AND CORRELATING ALL QUANTITIES AND DIMENSIONS, SELECTING FABRICATION PROCESSES AND TECHNIQUES OF CONSTRUCTION, COORDINATING THEIR WORK WITH THAT OF ALL OTHER TRADES, AND PERFORMING THEIR WORK IN A SAFE AND SATISFACTORY MANNER.

GLD Consulting Engineers
240 Commercial Street
Manchester, NH 03101
603-688-8223

Job Number: 150223
Reviewed by: SRB
Date: 06/03/2016

ITEM #: 900.640

APPROVED BY:

SHEET 2 OF 5

BRIDGE RAIL DETAILS SHEET
BRATTLEBORO BR 2000 (26)
VERMONT


R NO.	DATE	DESCRIPTION	BY	R NO.	DATE	DESCRIPTION	BY
1	6/2/16	REVISED PER 5/18/16 DWG REVIEW	E.P.				

ELDERLEE, INC.
OAKS CORNERS, NEW YORK 14518
E-Mail: along@elderlee.com
Tel: 315-789-6670 Fax: 315-789-6615

CERTIFIED FABRICATOR


DRAWN	E.P.	5/4/16
CHECKED	D.L.	5/4/16
APPROVED		
SCALE	SCHEMATIC	

DRAWING NO. F.R. LAFAYETTE-BRATTLEBORO (26)

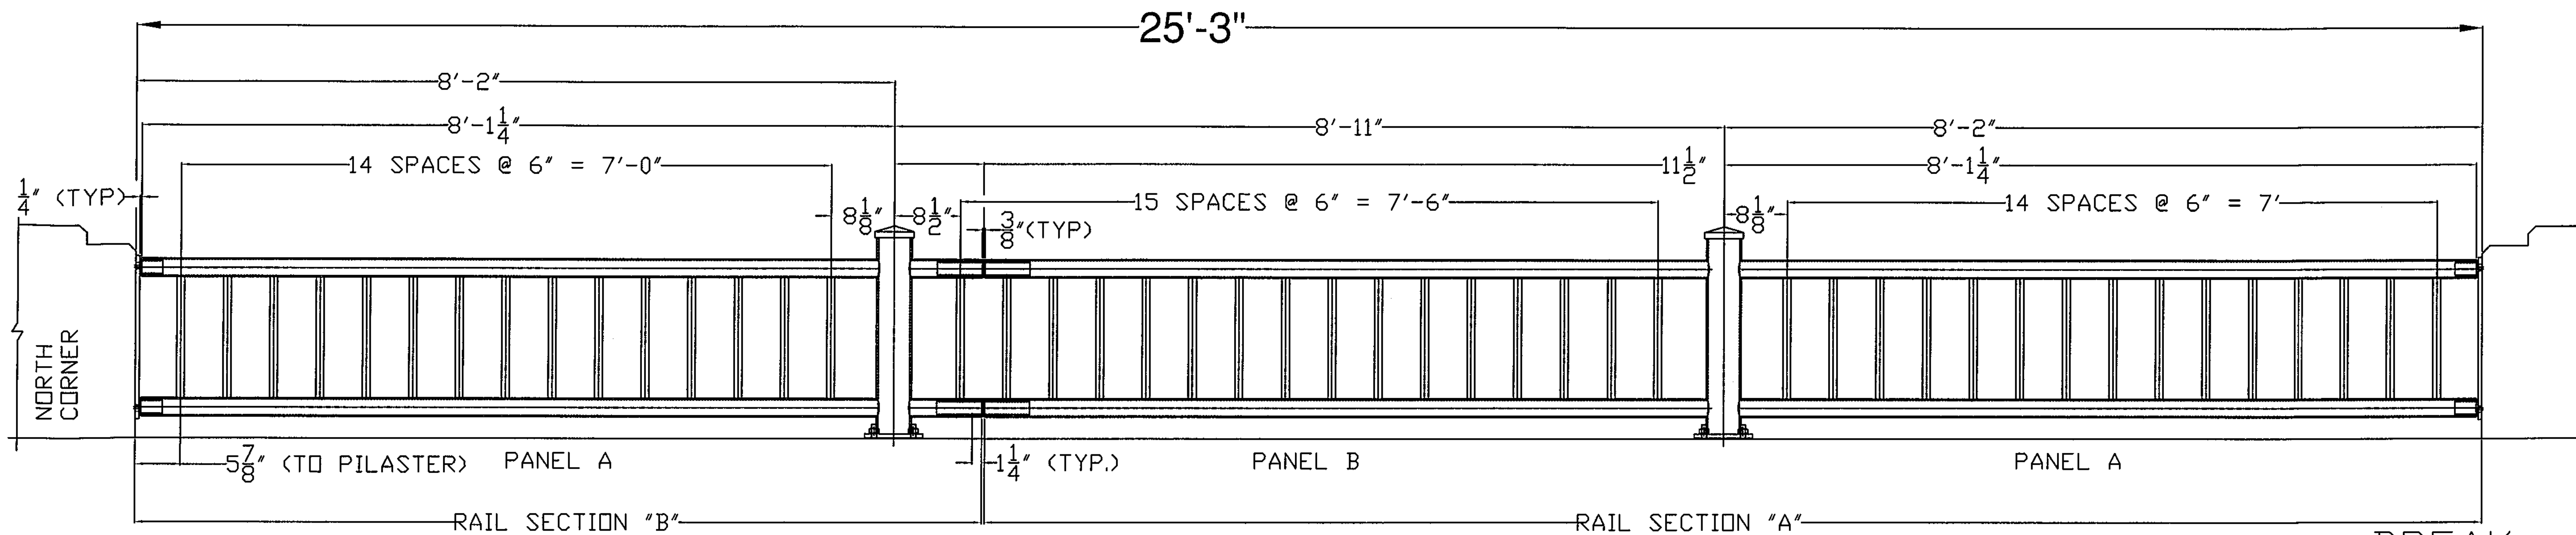

EAST RAILING, FACING EAST

BREAK LINE "A"

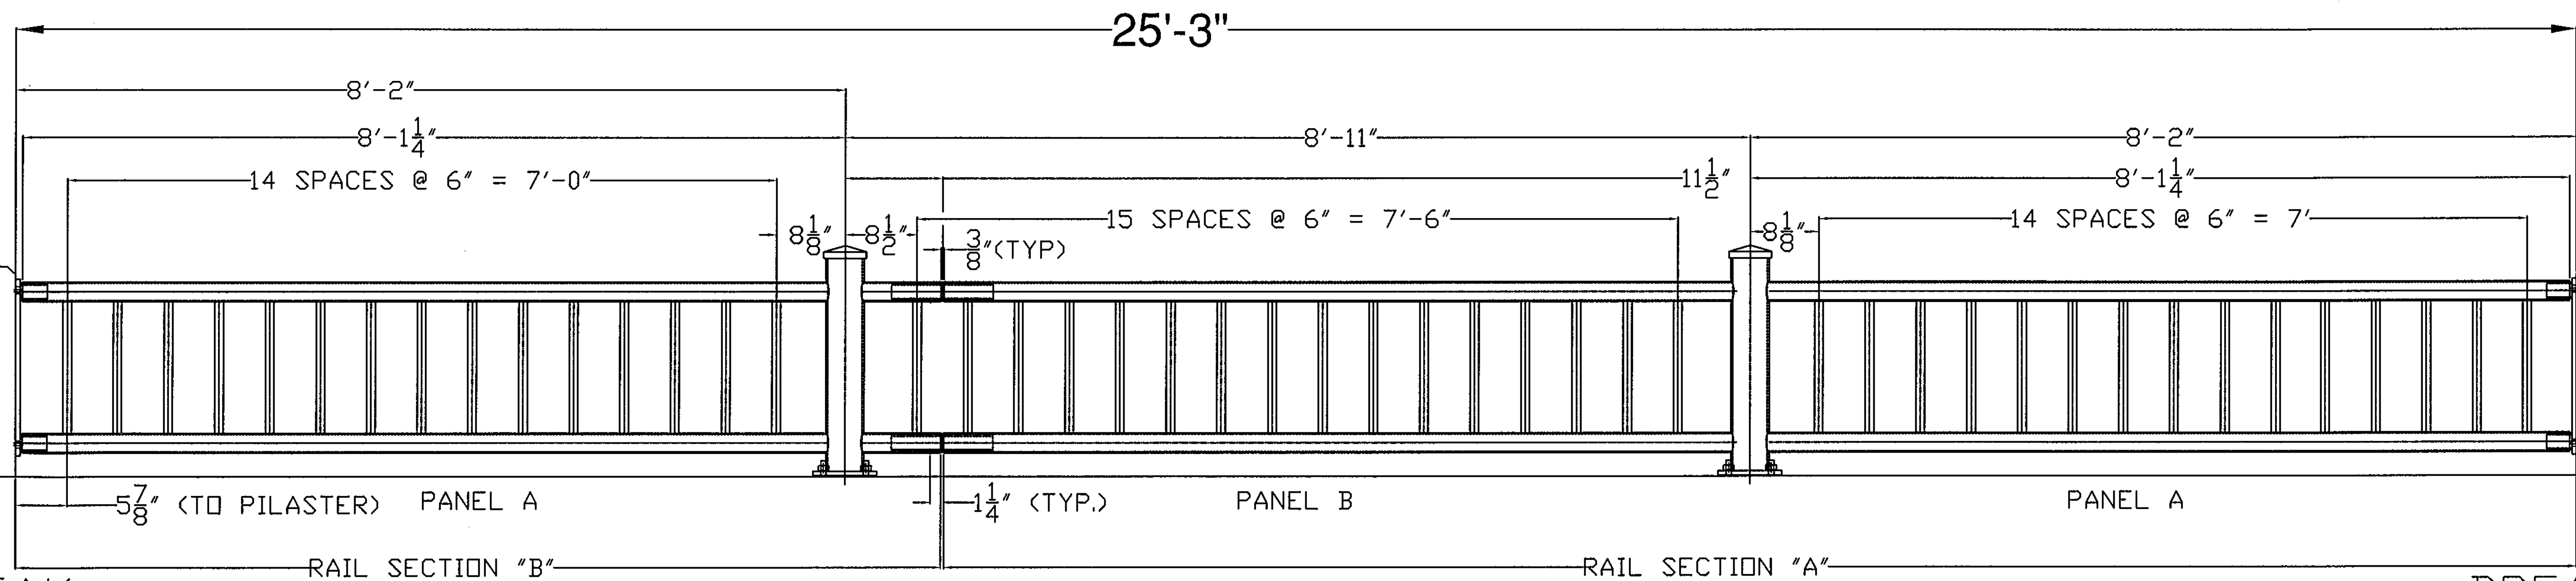

EAST RAILING, FACING EAST

BREAK LINE "A"

BREAK LINE "B"

SHOP DRAWING REVIEW

REVIEWED AS REQUIRED BY THE CONSTRUCTION CONTRACT DOCUMENTS AND APPROVED, BUT ONLY FOR CONFORMANCE TO THE DESIGN CONCEPT OF THE WORK, AND SUBJECT TO FURTHER LIMITATIONS AND REQUIREMENTS CONTAINED IN THE CONSTRUCTION CONTRACT DOCUMENTS.

REJECTED REVISE AND RESUBMIT APPROVED AS NOTED

CORRECTIONS OR COMMENTS MADE ON THE SHOP DRAWINGS DURING THIS REVIEW DID NOT RELIEVE CONTRACTOR FROM COMPLIANCE WITH REQUIREMENTS OF THE DRAWINGS AND SPECIFICATIONS. THIS CHECK IS ONLY FOR REVIEW OF GENERAL CONFORMANCE WITH THE DESIGN CONCEPT OF THE PROJECT AND GENERAL COMPLIANCE WITH THE INFORMATION GIVEN IN THE CONTRACT DOCUMENTS. THE CONTRACTOR IS RESPONSIBLE FOR CONFIRMING AND CORRELATING ALL QUANTITIES AND DIMENSIONS, SELECTING FABRICATION PROCESSES AND TECHNIQUES OF CONSTRUCTION, COORDINATING THEIR WORK WITH THAT OF ALL OTHER TRADES, AND PERFORMING THEIR WORK IN A SAFE AND SATISFACTORY MANNER.

 CLD Consulting Engineers
 540 Commercial Street
 Manchester, NH 03101
 603-498-8252

Job Number: 150223
 Reviewed by: SRB
 Date: 06/03/2016

Vermont Agency of Transportation
RECEIVED
 ON: June 2, 2016
 and Checked for
CONFORMANCE
 BY: Jennifer Fitch DATE: 06/03/16

ITEM #: 900.640



APPROVED BY:


SHEET 3 OF 5

BRIDGE RAIL DETAILS SHEET

BRATTLEBORO BR 2000 (26)
 VERMONT

R	NO.	DATE	DESCRIPTION	BY	R	NO.	DATE	DESCRIPTION	BY
E	1	6/2/16	REVISED PER 5/18/16 DWG REVIEW	E.P.	E				
V					V				


	ELDERLEE, INC. OAKS CORNERS, NEW YORK 14518 E-Mail: dlong@elderlee.com Tel: 315-789-6670 Fax: 315-789-6615		DRAWN	E.P.	5/4/16
			CHECKED	D.L.	5/4/16
			APPROVED		
			SCALE	SCHEMATIC	
			DRAWING NO. F.R. LAFAYETTE-BRATTLEBORO (26)		

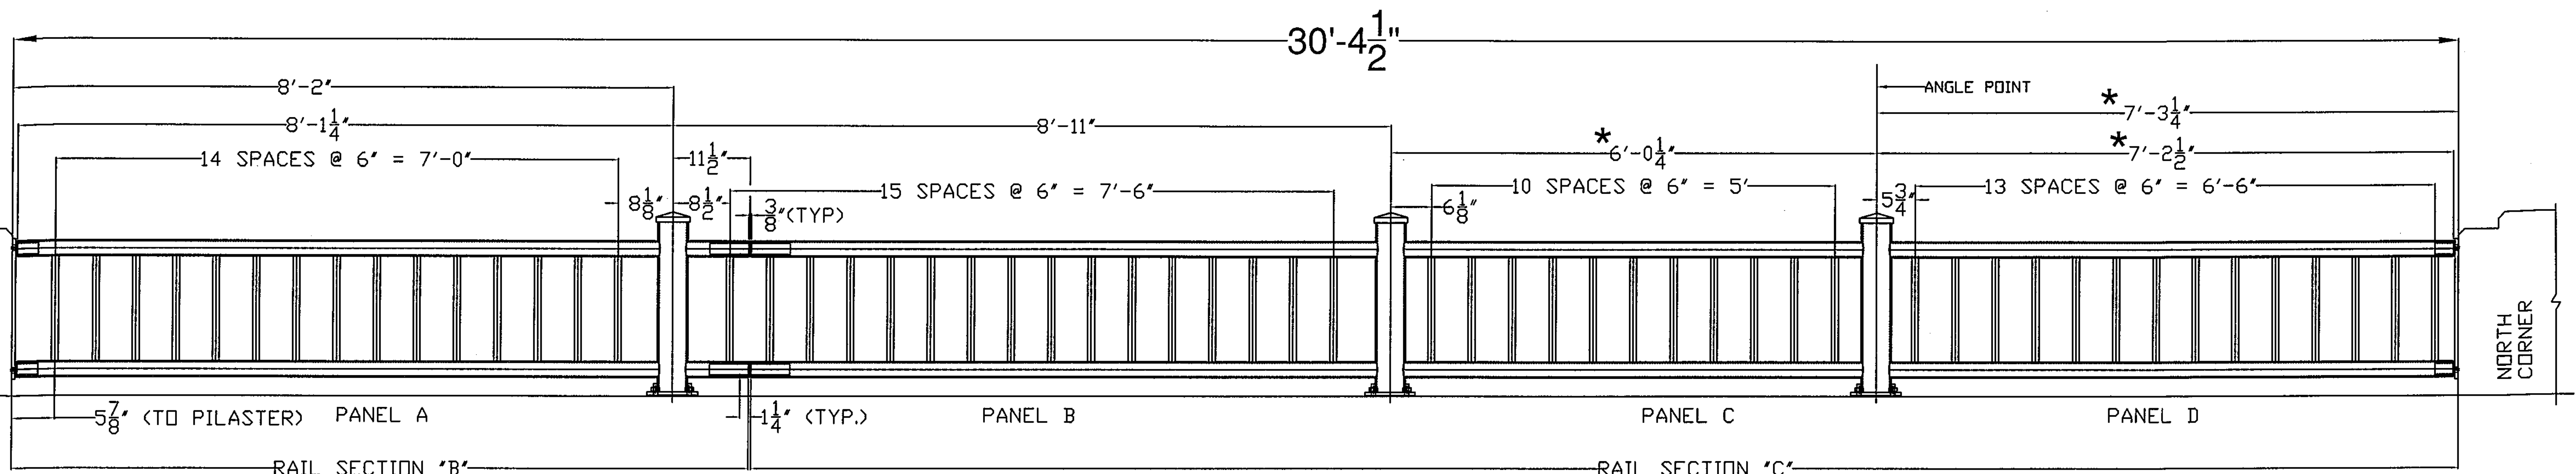


EAST RAILING, FACING EAST

BREAK LINE "B"

* - FIELD VERIFY DIMENSIONS

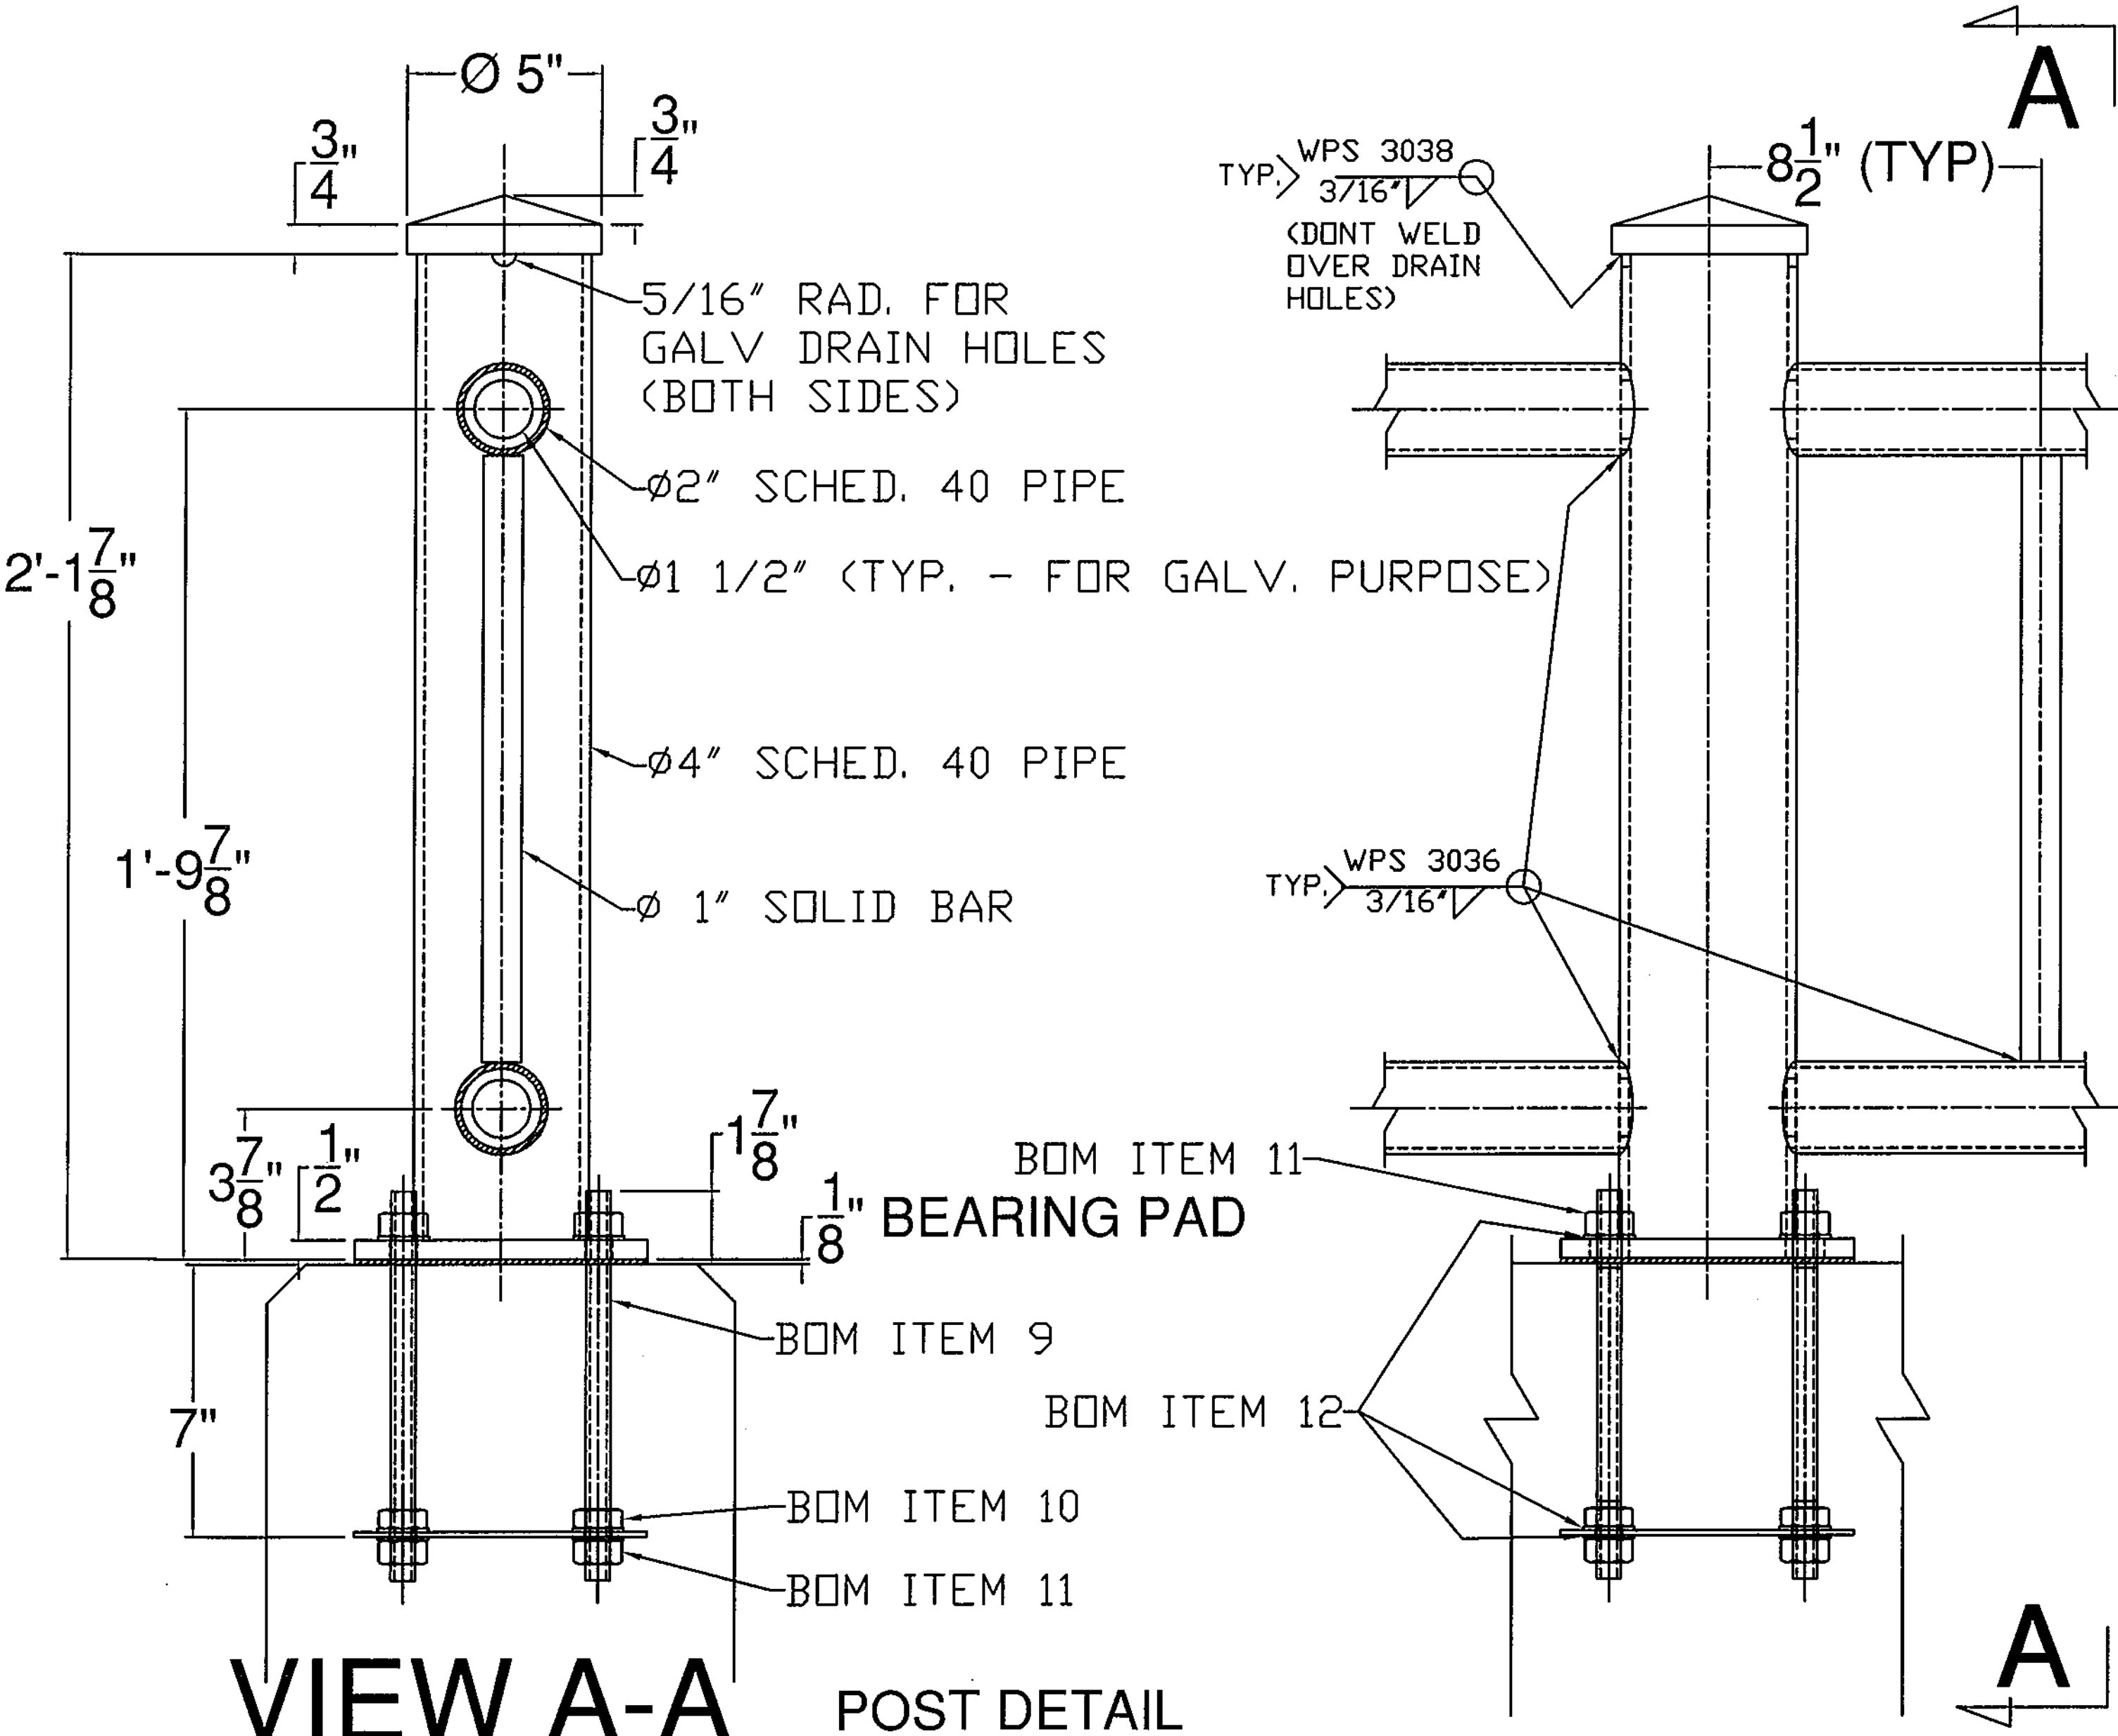

VIEW A-A POST DETAIL

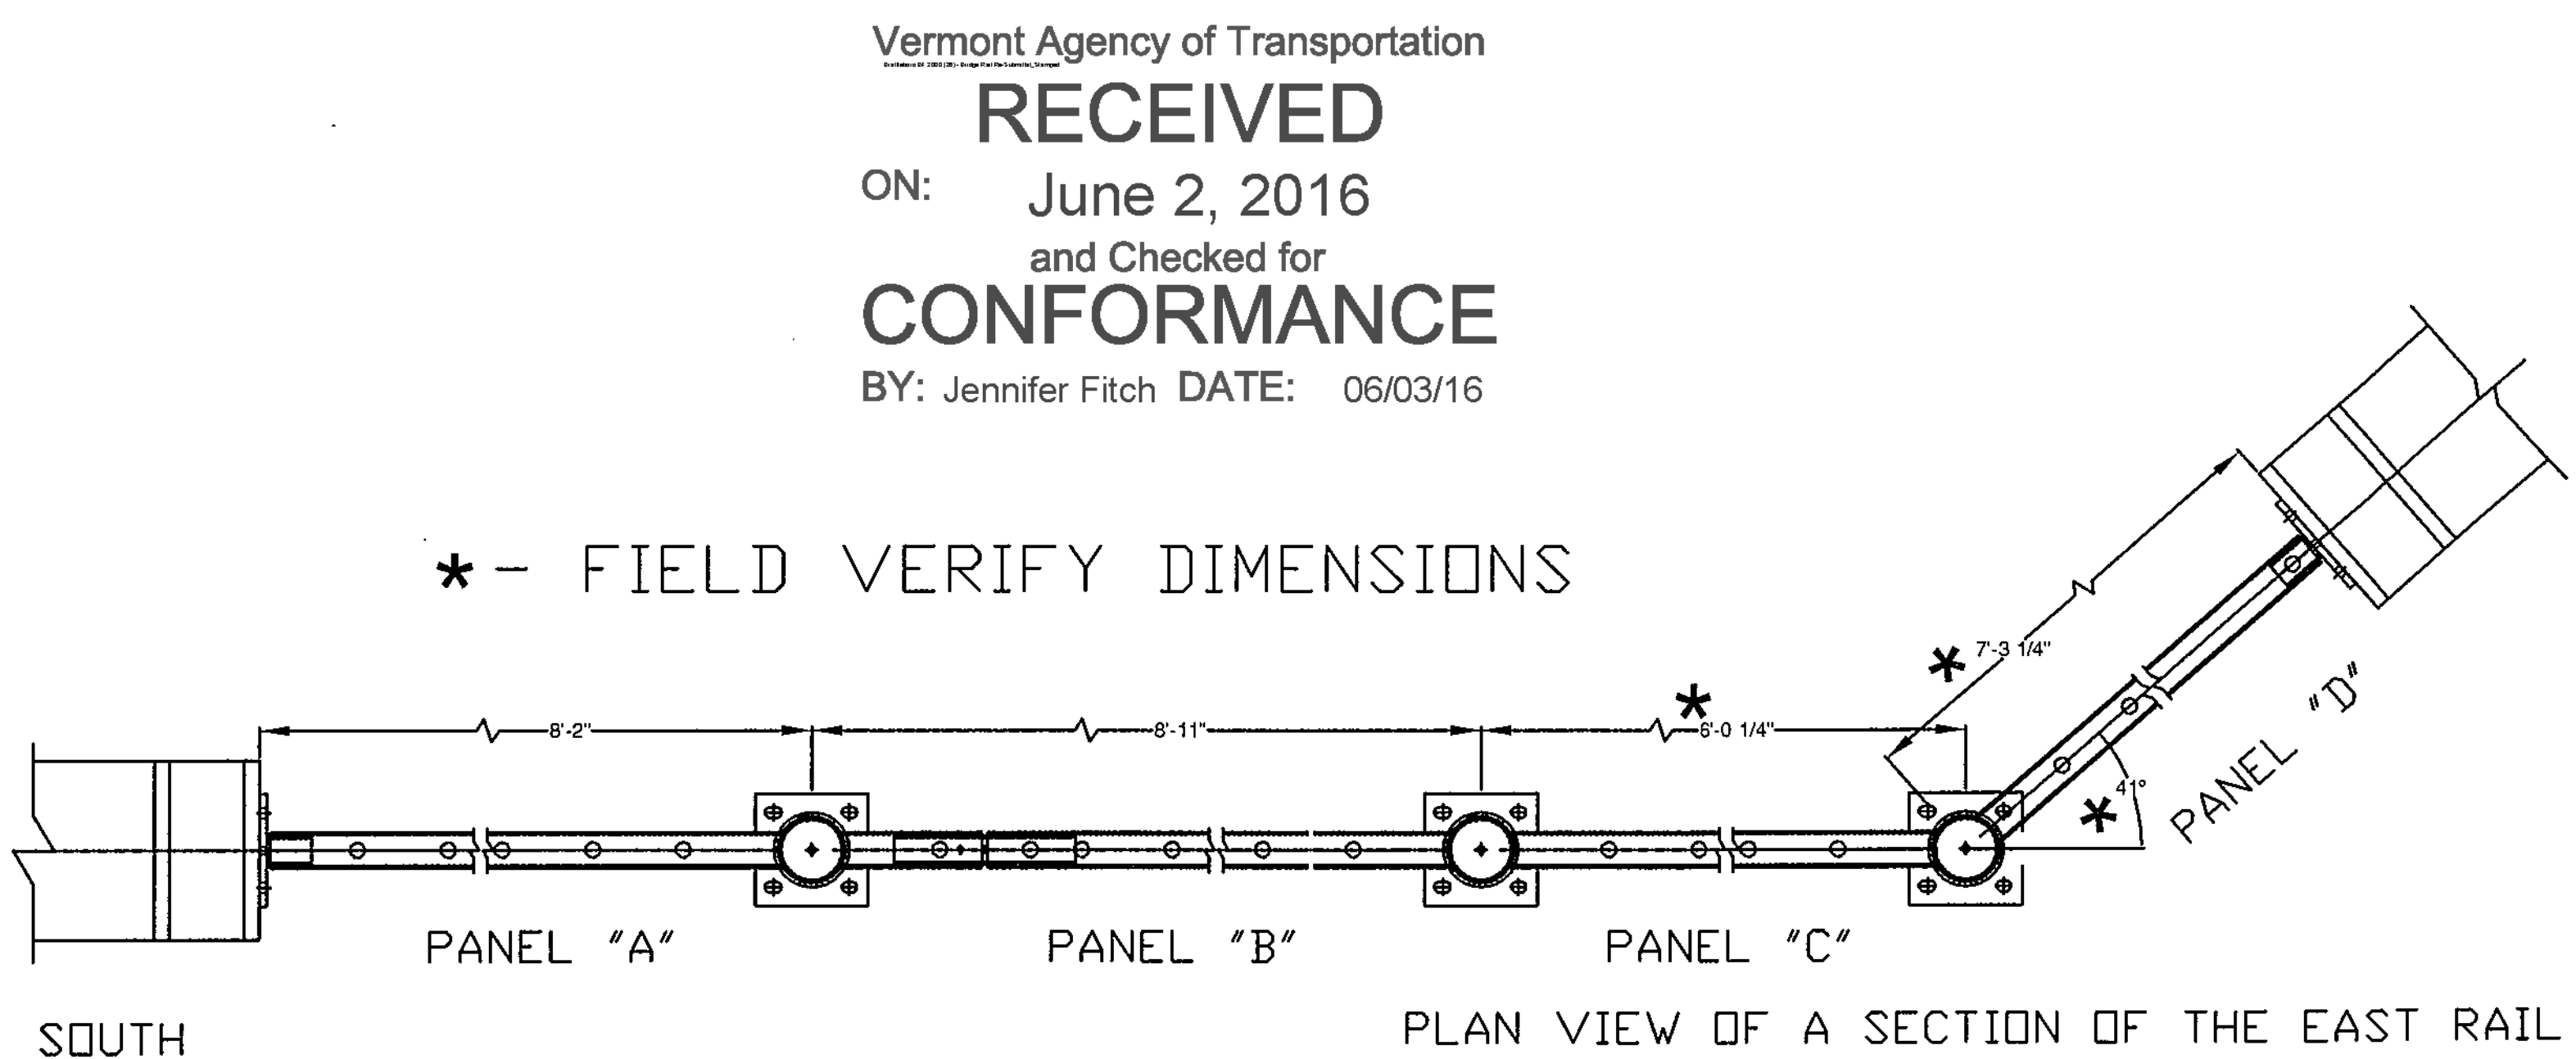

PLAN VIEW OF A SECTION OF THE EAST RAIL

Vermont Agency of Transportation
RECEIVED
 ON: June 2, 2016
 and Checked for
CONFORMANCE
 BY: Jennifer Fitch DATE: 06/03/16

NOTE: HANDRAIL TUBING TO BE WELDED PER D1.1, POST TO BASE TO BE PER D1.5

SHOP DRAWING REVIEW

REVIEWED AS REQUIRED BY THE CONSTRUCTION CONTRACT DOCUMENTS AND APPROVED, BUT ONLY FOR CONFORMANCE TO THE DESIGN CONCEPT OF THE WORK, AND SUBJECT TO FURTHER LIMITATIONS AND REQUIREMENTS CONTAINED IN THE CONSTRUCTION CONTRACT DOCUMENTS.

REJECTED REVISE AND RESUBMIT APPROVED AS NOTED

CORRECTIONS OR COMMENTS MADE ON THE SHOP DRAWINGS DURING THIS REVIEW DID NOT RELIEVE CONTRACTOR FROM COMPLIANCE WITH REQUIREMENTS OF THE DRAWINGS AND SPECIFICATIONS. THIS CHECK IS ONLY FOR REVIEW OF GENERAL CONFORMANCE WITH THE DESIGN CONCEPT OF THE PROJECT AND GENERAL COMPLIANCE WITH THE INFORMATION GIVEN IN THE CONTRACT DOCUMENTS. THE CONTRACTOR IS RESPONSIBLE FOR CONFIRMING AND CORRELATING ALL QUANTITIES AND DIMENSIONS, SELECTING FABRICATION PROCESSES AND TECHNIQUES OF CONSTRUCTION, COORDINATING THEIR WORK WITH THAT OF ALL OTHER TRADES, AND PERFORMING THEIR WORK IN A SAFE AND SATISFACTORY MANNER.

ELD Consulting Engineers
 540 Commercial Street
 Manchester, NH 03101
 603-668-8223

Job Number: 150223
 Revised by: SRB
 Date: 06/03/2016

ITEM #: 900.640

APPROVED BY:

SHEET 4 OF 5






BRIDGE RAIL DETAILS SHEET
 BRATTLEBORO BR 2000 (26)
 VERMONT

R NO.	DATE	DESCRIPTION	BY	R NO.	DATE	DESCRIPTION	BY
E 1	6/2/16	REVISED PER 5/18/16 DWG REVIEW	E.P.	E			

ELDERLEE, INC.
 OAKS CORNERS, NEW YORK 14518
 E-Mail: diong@elderlee.com
 Tel: 315-789-6670 Fax: 315-789-6615

VERMONT CERTIFIED FABRICATOR

DRAWN	E.P.	5/4/16
CHECKED	D.L.	5/4/16
APPROVED		
SCALE	SCHEMATIC	
DRAWING NO. F.R. LAFAYETTE-BRATTLEBORO (26)		

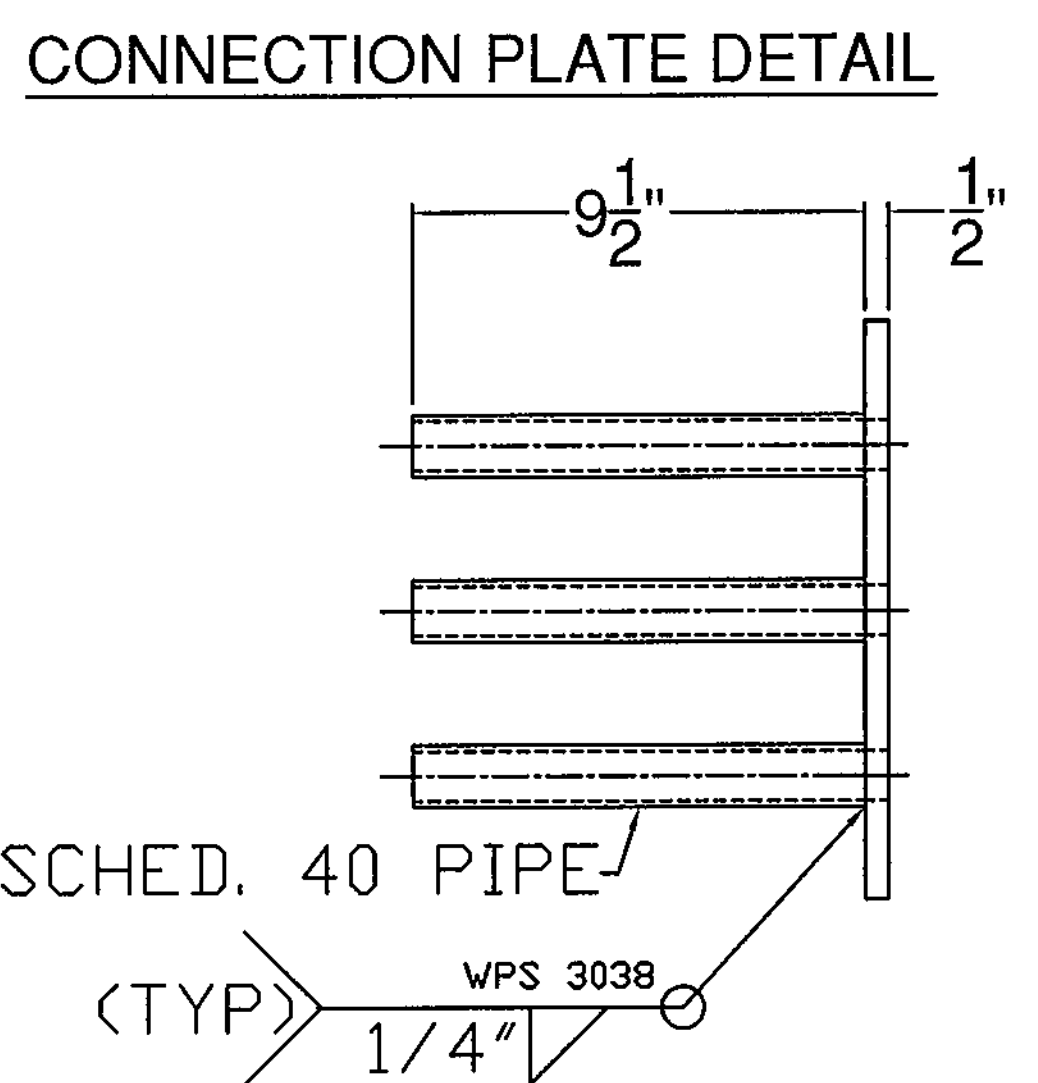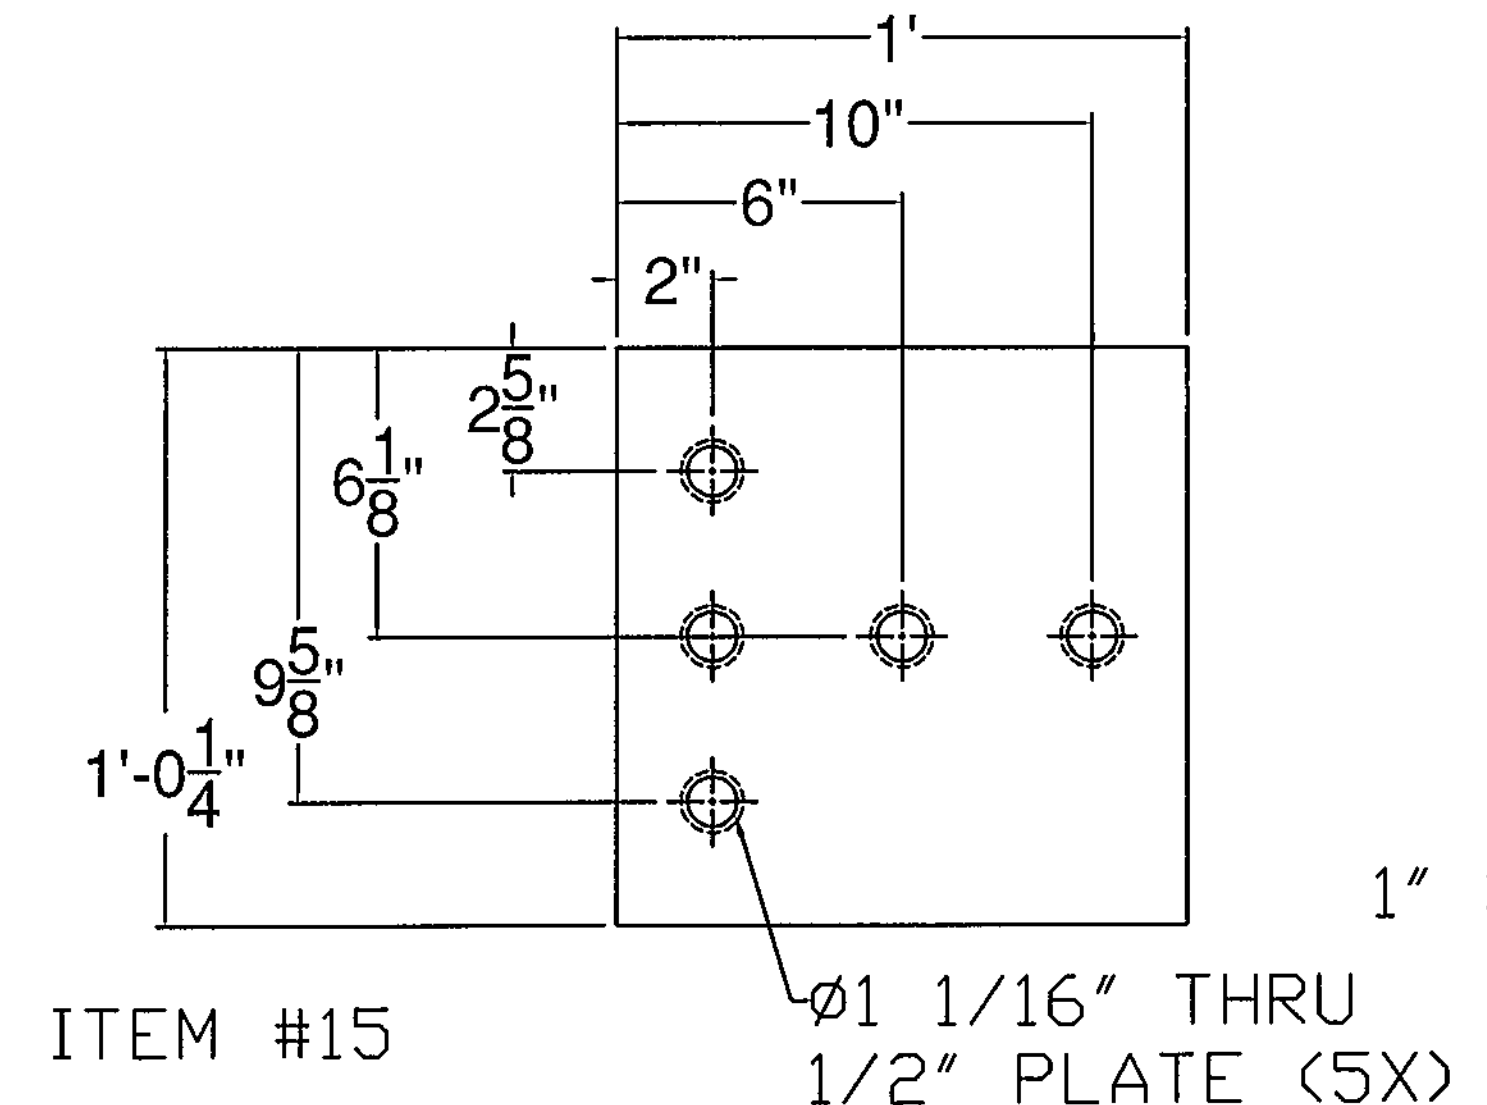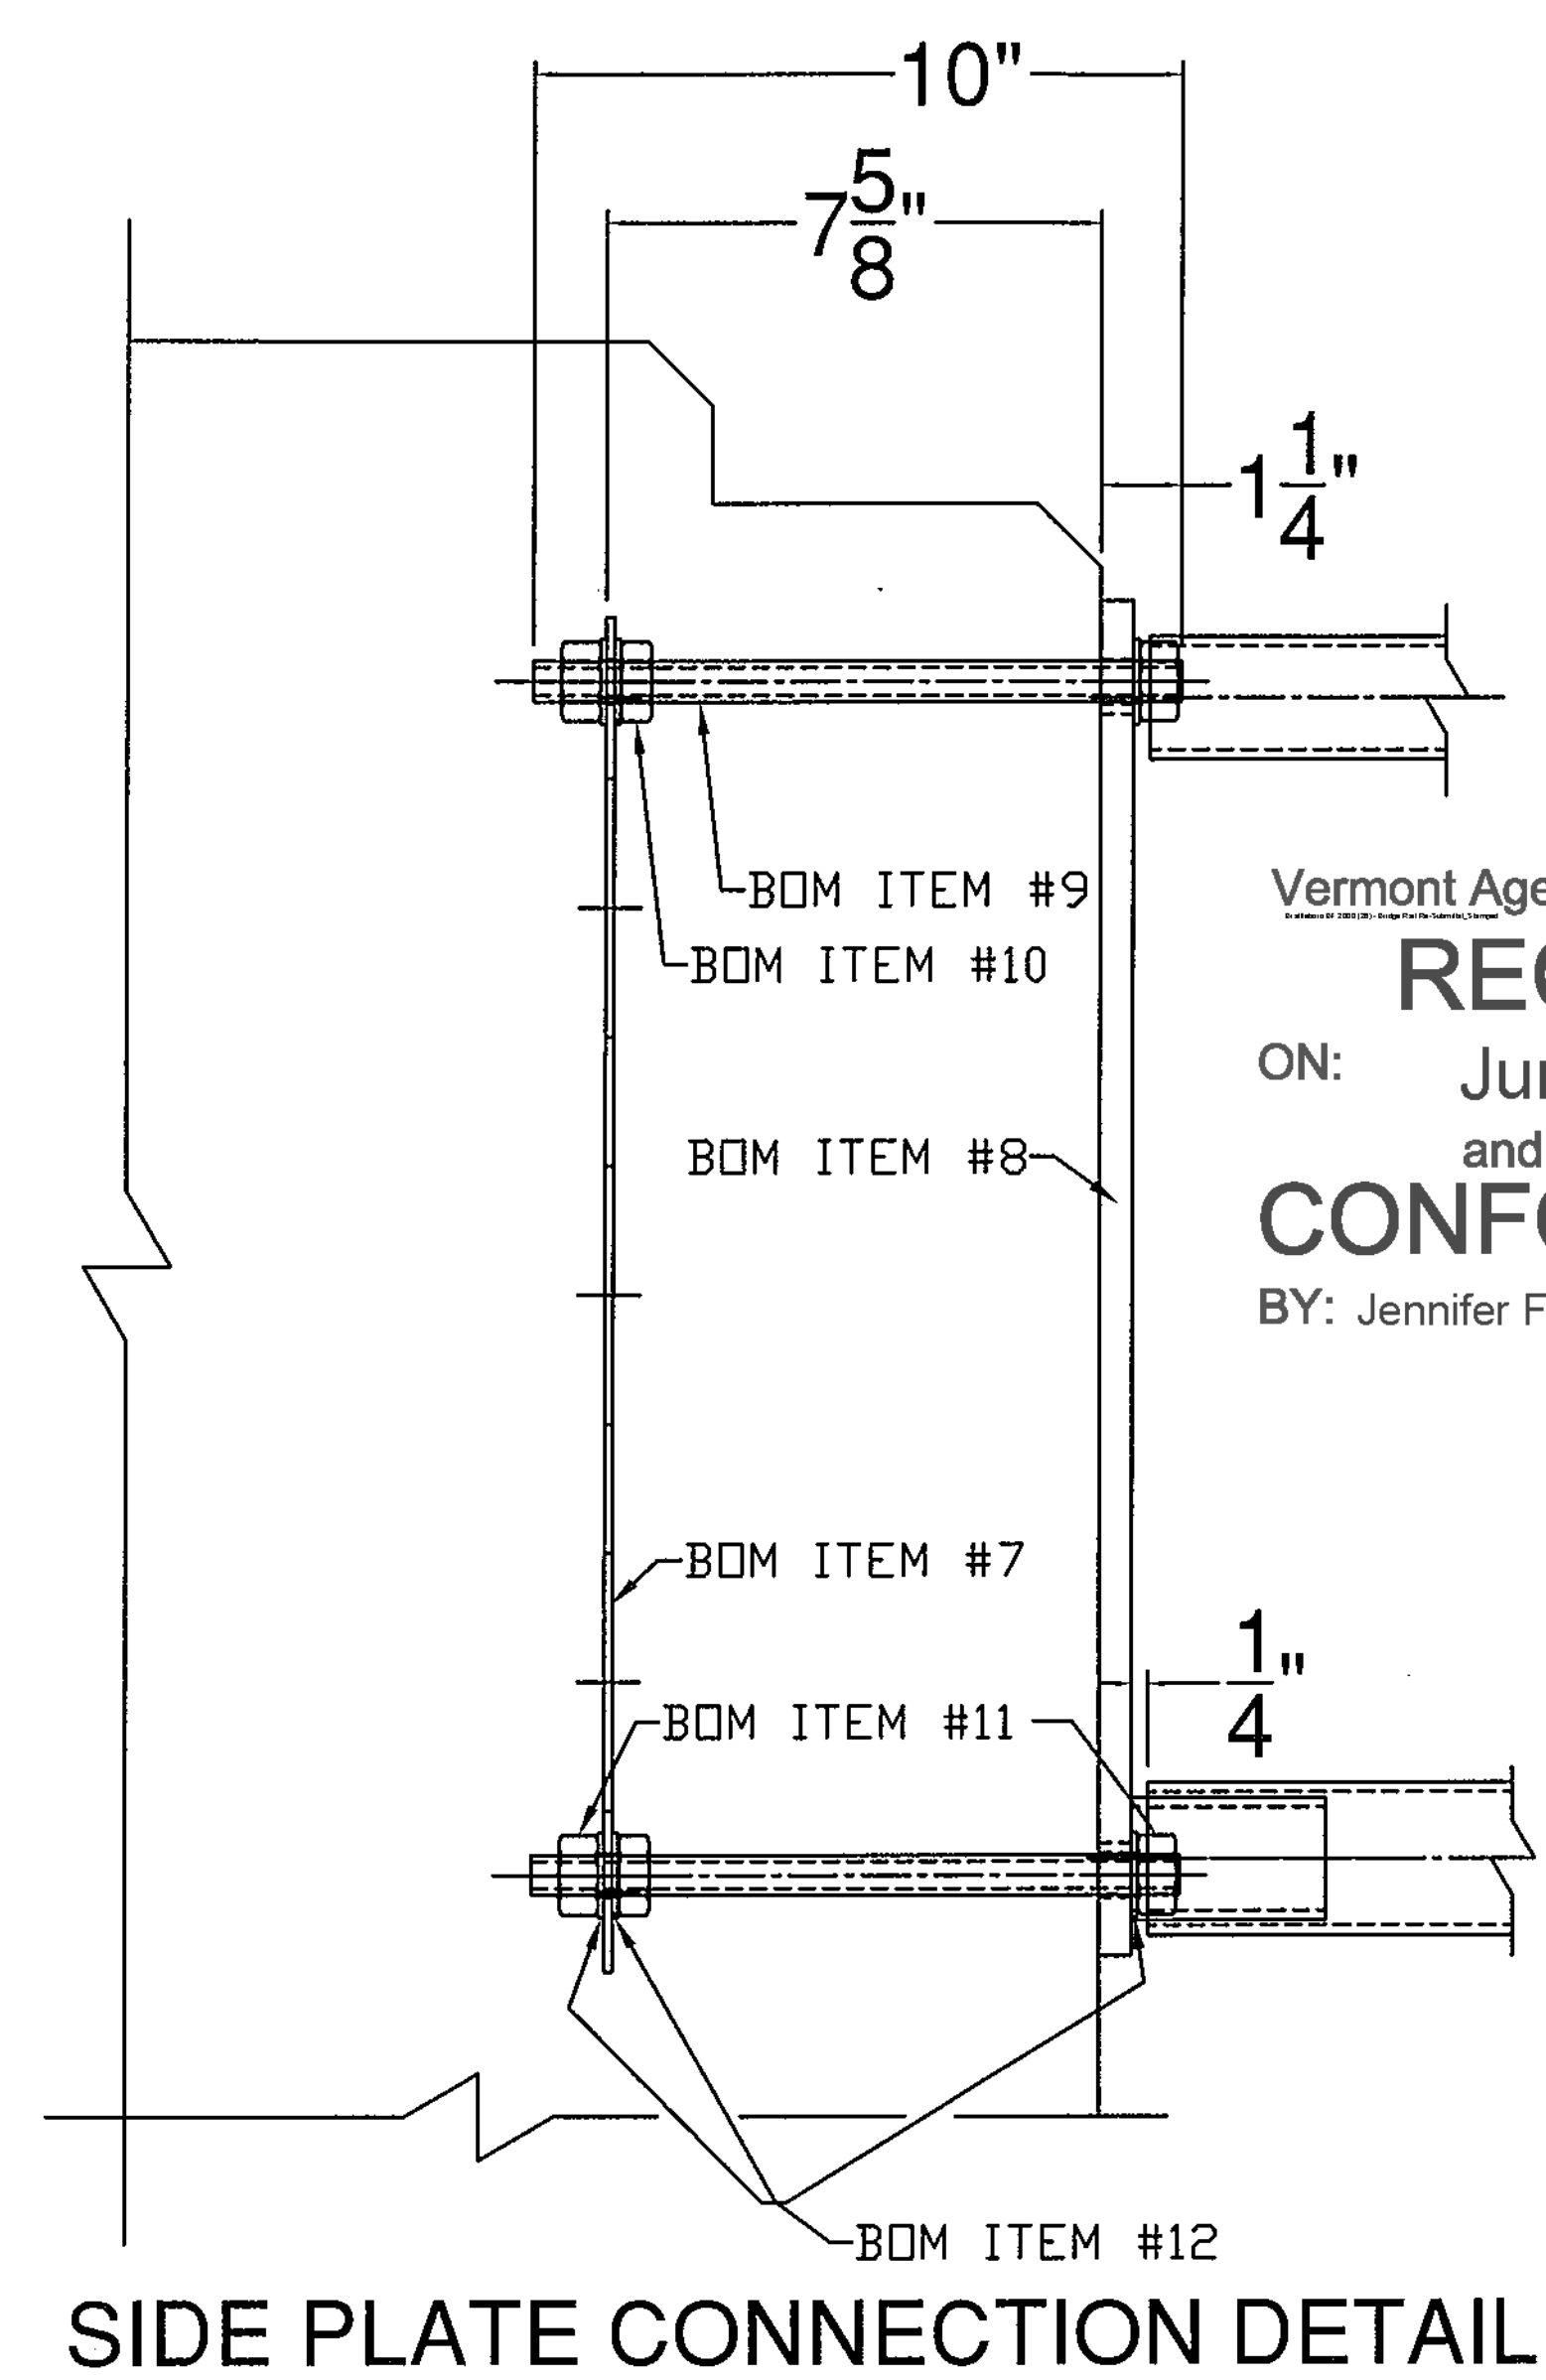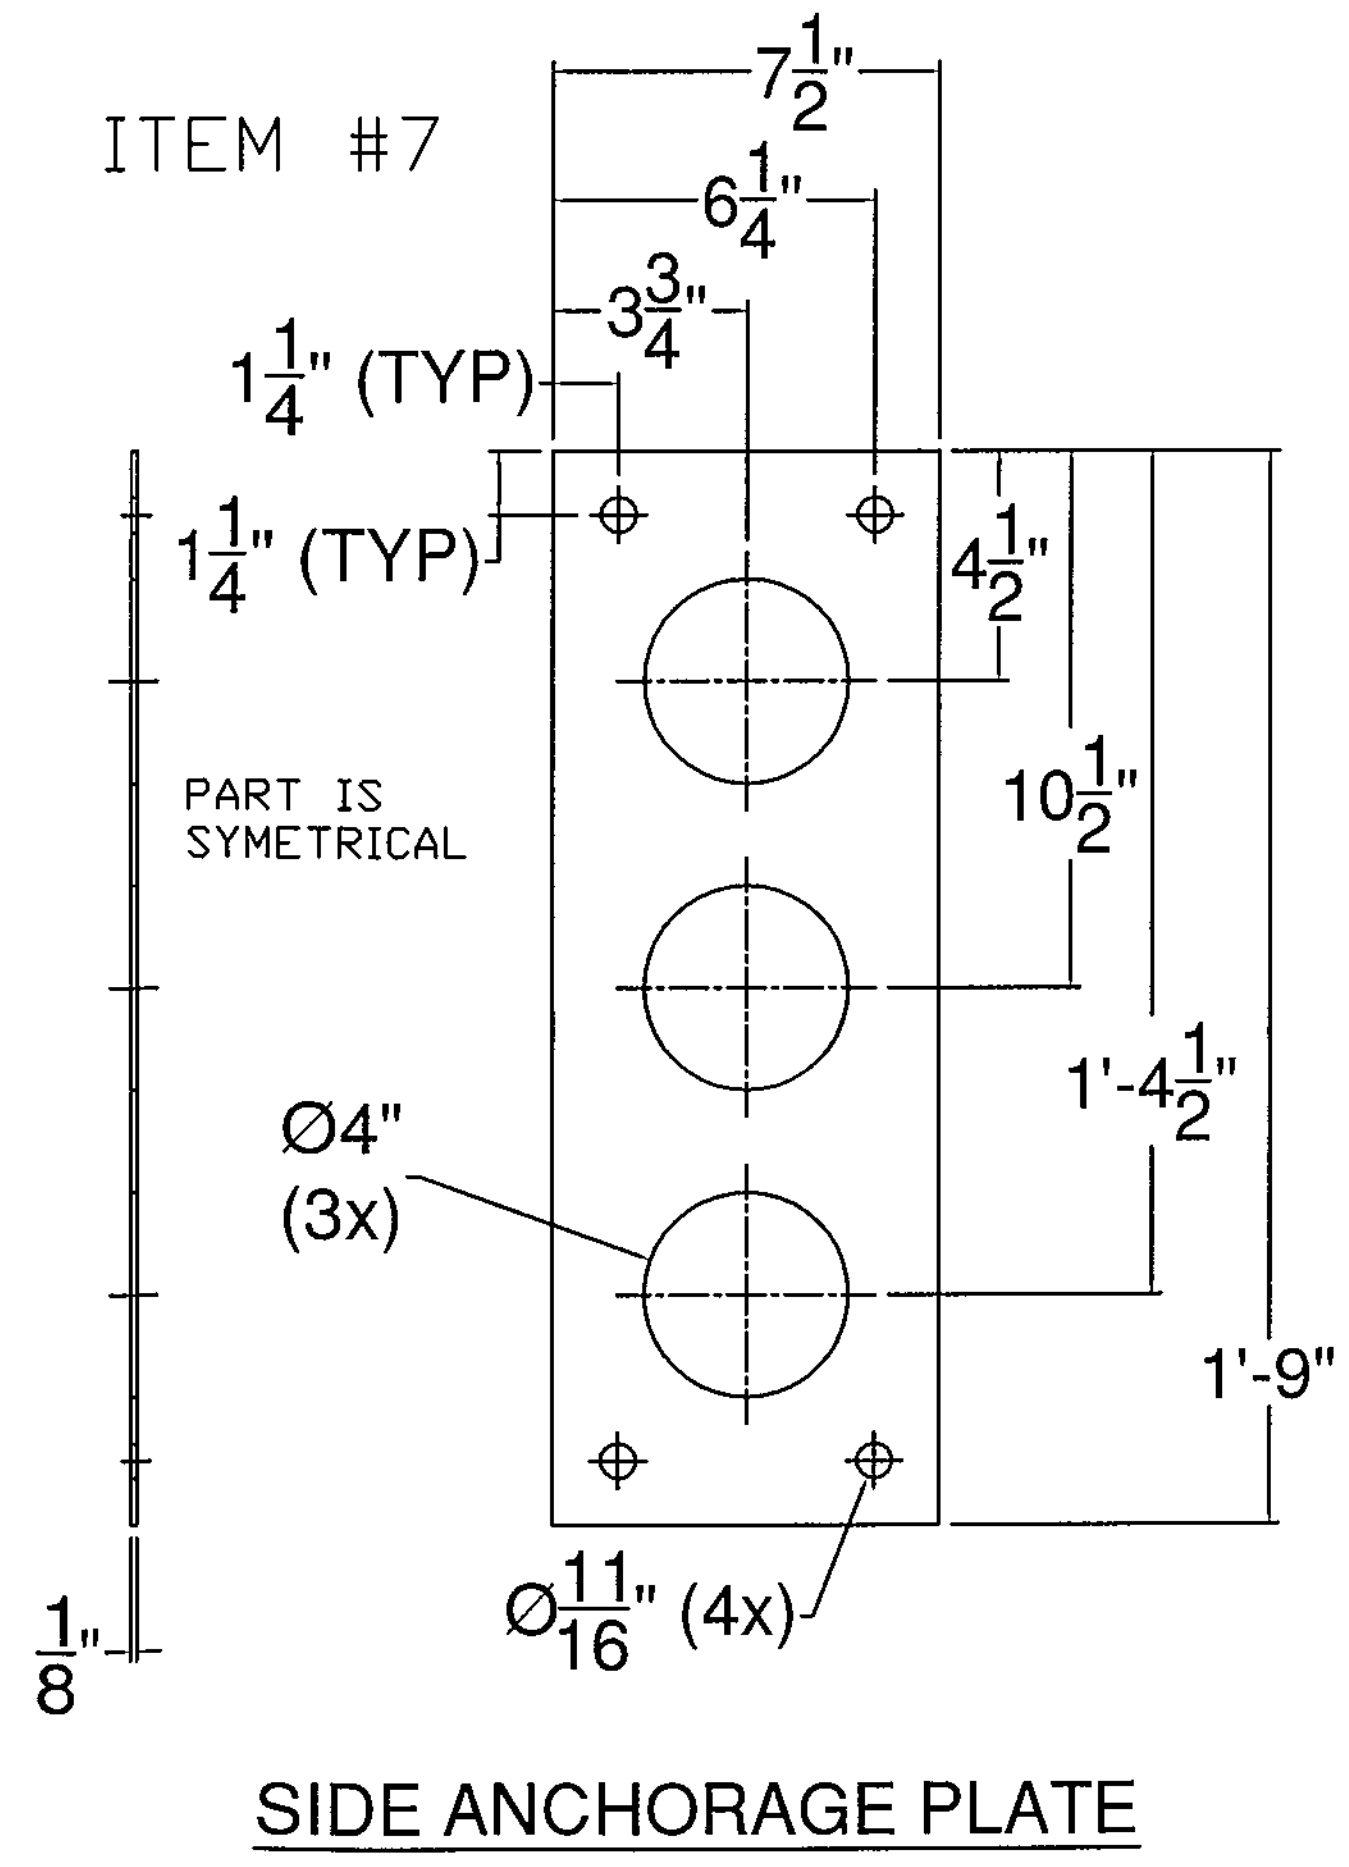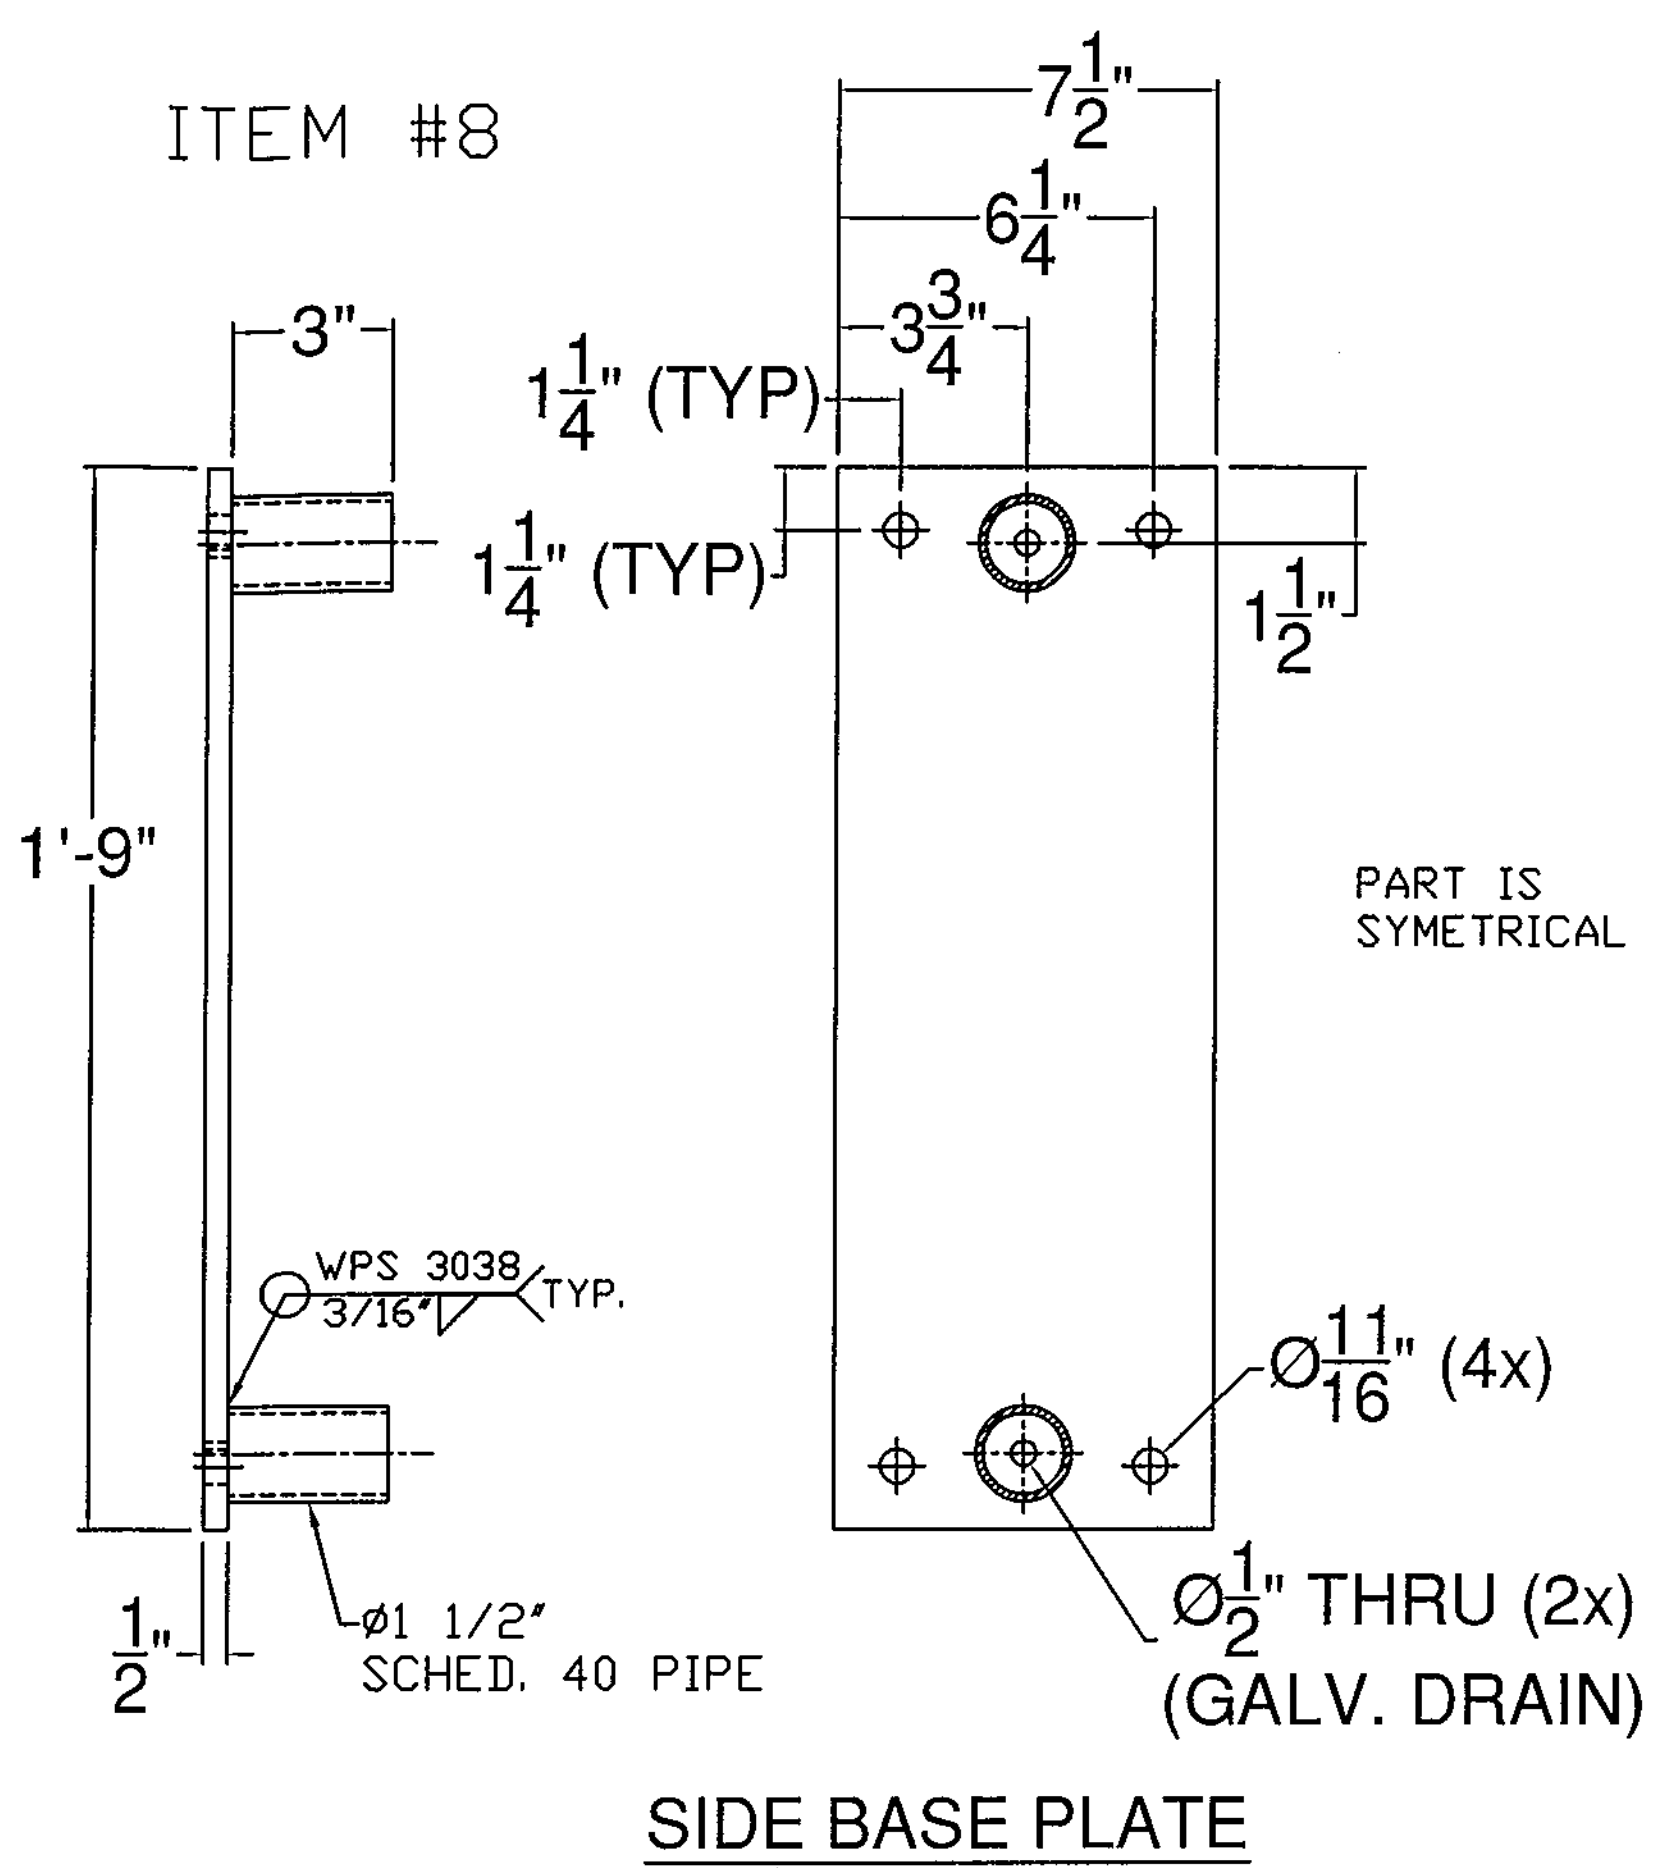

SHOP DRAWING REVIEW

REVIEWED AS REQUIRED BY THE CONSTRUCTION CONTRACT DOCUMENTS AND APPROVED, BUT ONLY FOR CONFORMANCE TO THE DESIGN CONCEPT OF THE WORK, AND SUBJECT TO FURTHER LIMITATIONS AND REQUIREMENTS CONTAINED IN THE CONSTRUCTION CONTRACT DOCUMENTS.





REJECTED REVISE AND RESUBMIT APPROVED AS NOTED

CORRECTIONS OR COMMENTS MADE ON THE SHOP DRAWINGS DURING THIS REVIEW DID NOT RELIEVE CONTRACTOR FROM COMPLIANCE WITH REQUIREMENTS OF THE DRAWINGS AND SPECIFICATIONS. THIS CHECK IS ONLY FOR REVIEW OF GENERAL CONFORMANCE WITH THE DESIGN CONCEPT OF THE PROJECT AND GENERAL COMPLIANCE WITH THE INFORMATION GIVEN IN THE CONTRACT DOCUMENTS. THE CONTRACTOR IS RESPONSIBLE FOR CONFIRMING AND CORRELATING ALL QUANTITIES AND DIMENSIONS, SELECTING FABRICATION PROCESSES AND TECHNIQUES OF CONSTRUCTION, COORDINATING THEIR WORK WITH THAT OF ALL OTHER TRADES, AND PERFORMING THEIR WORK IN A SAFE AND SATISFACTORY MANNER.

CLD Consulting Engineers
540 Commercial Street
Manchester, NH 03101
603-668-8223

Job Number: 1502223
Reviewed by: SRB
Date: 06/03/2016

Vermont Agency of Transportation
RECEIVED
ON: June 2, 2016
and Checked for
CONFORMANCE
BY: Jennifer Fitch DATE: 06/03/16

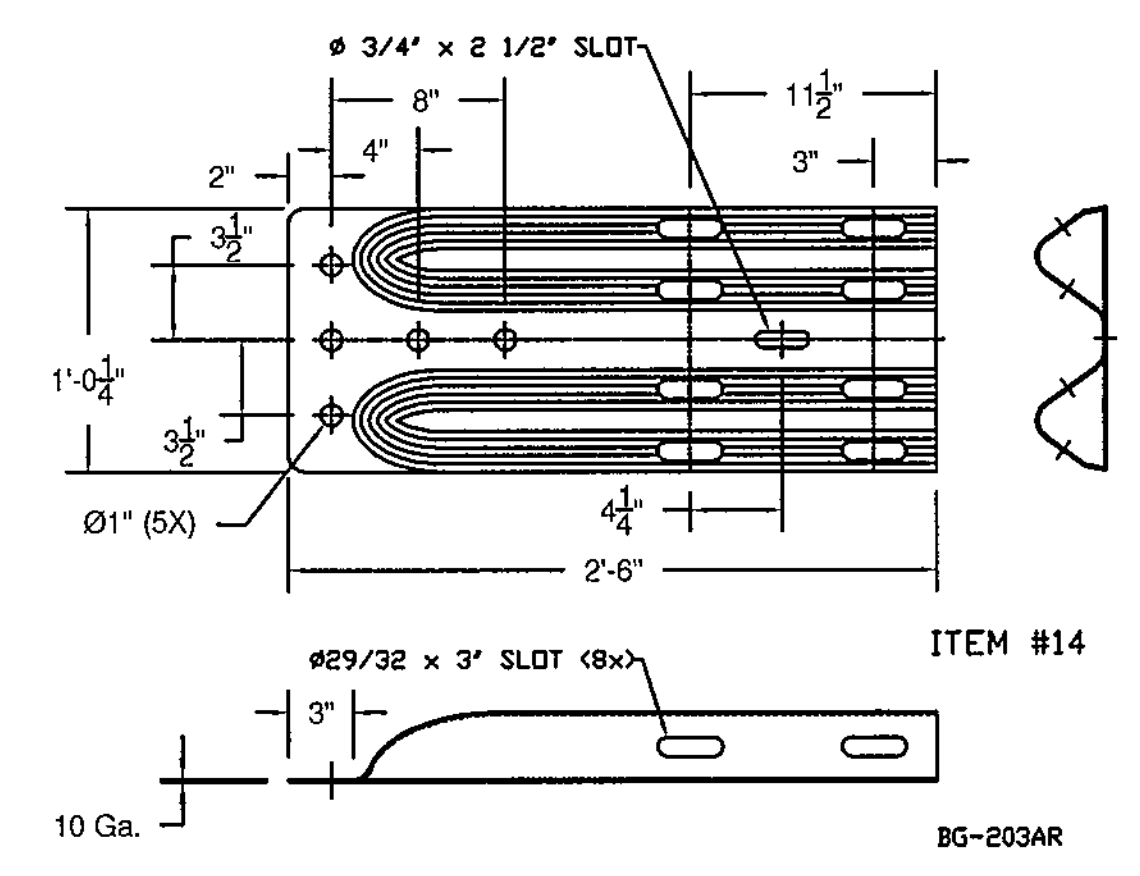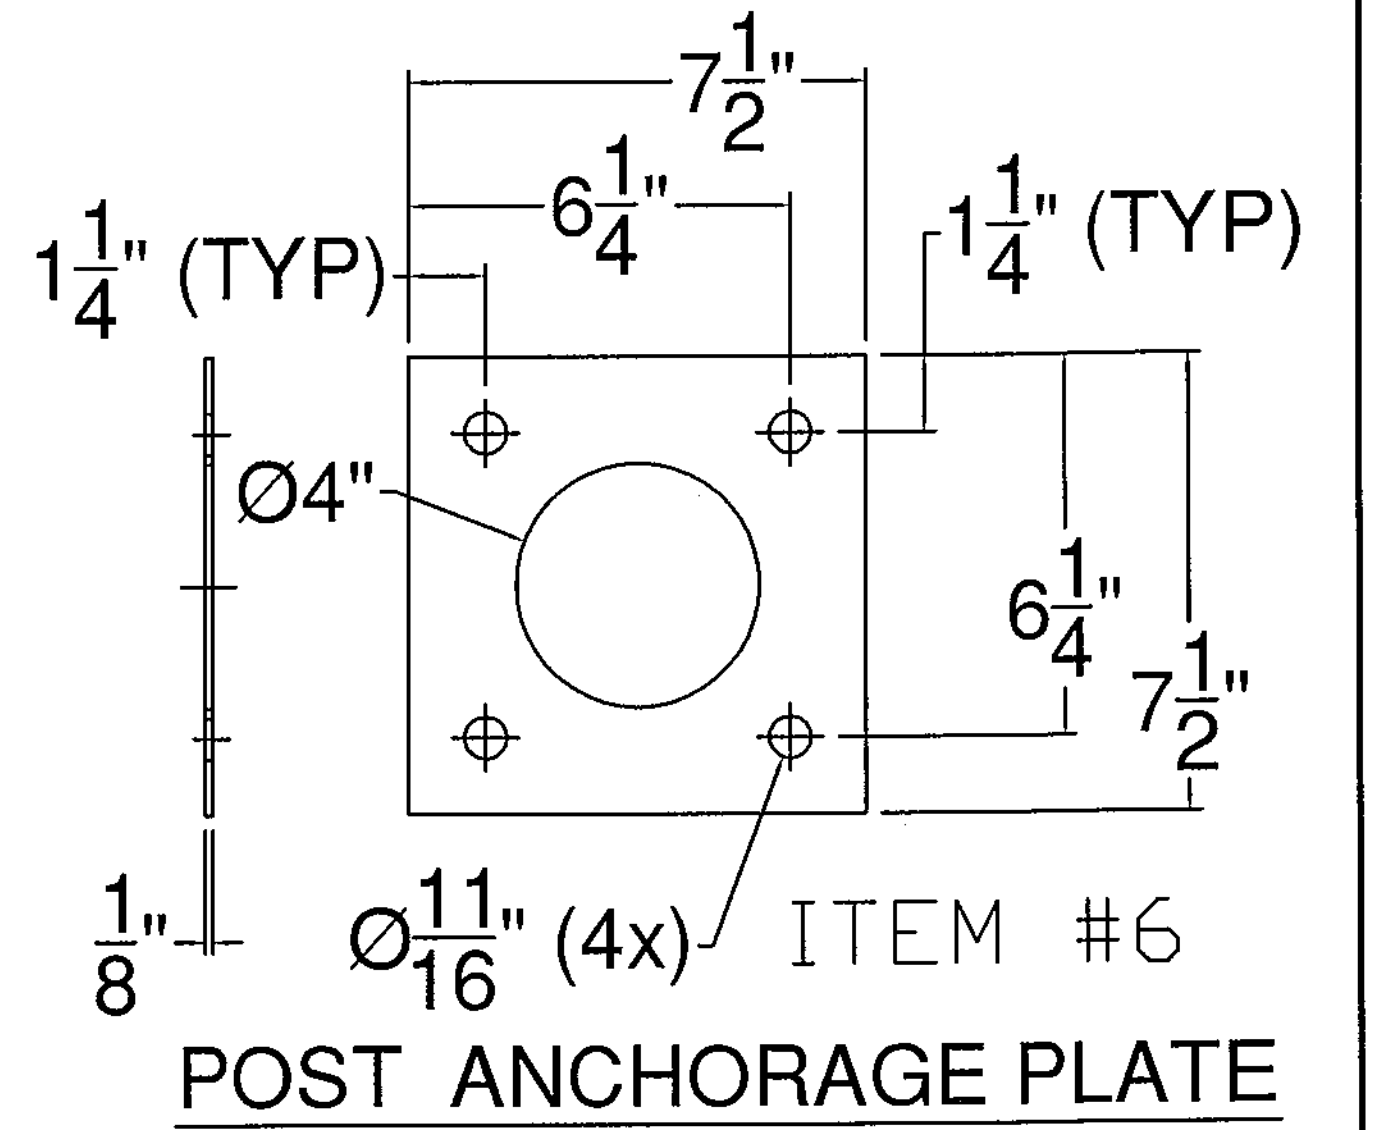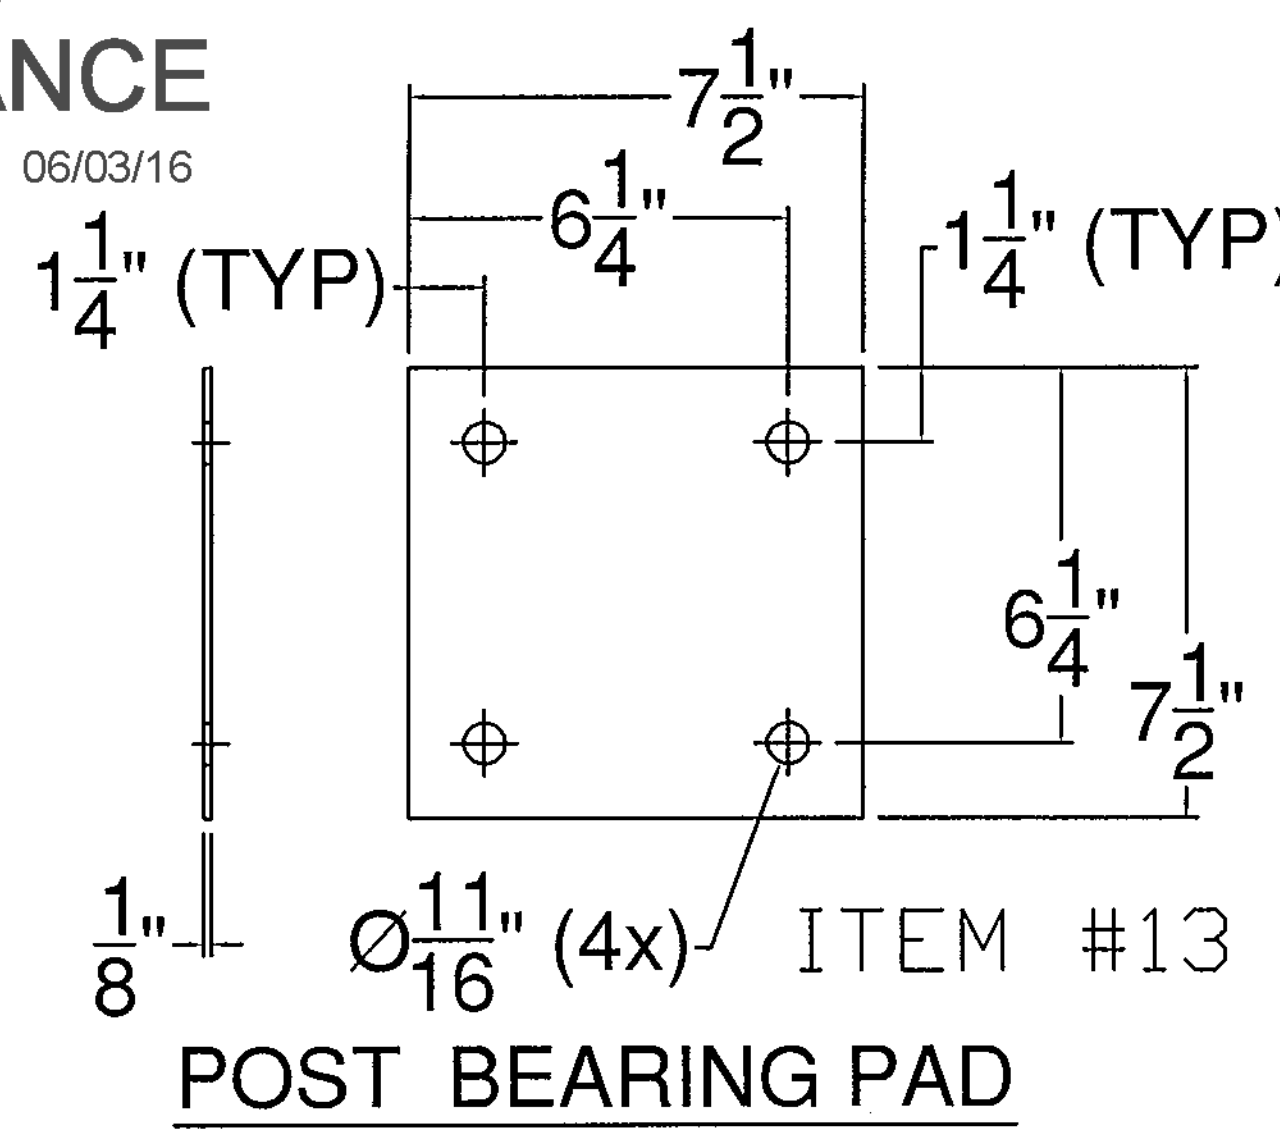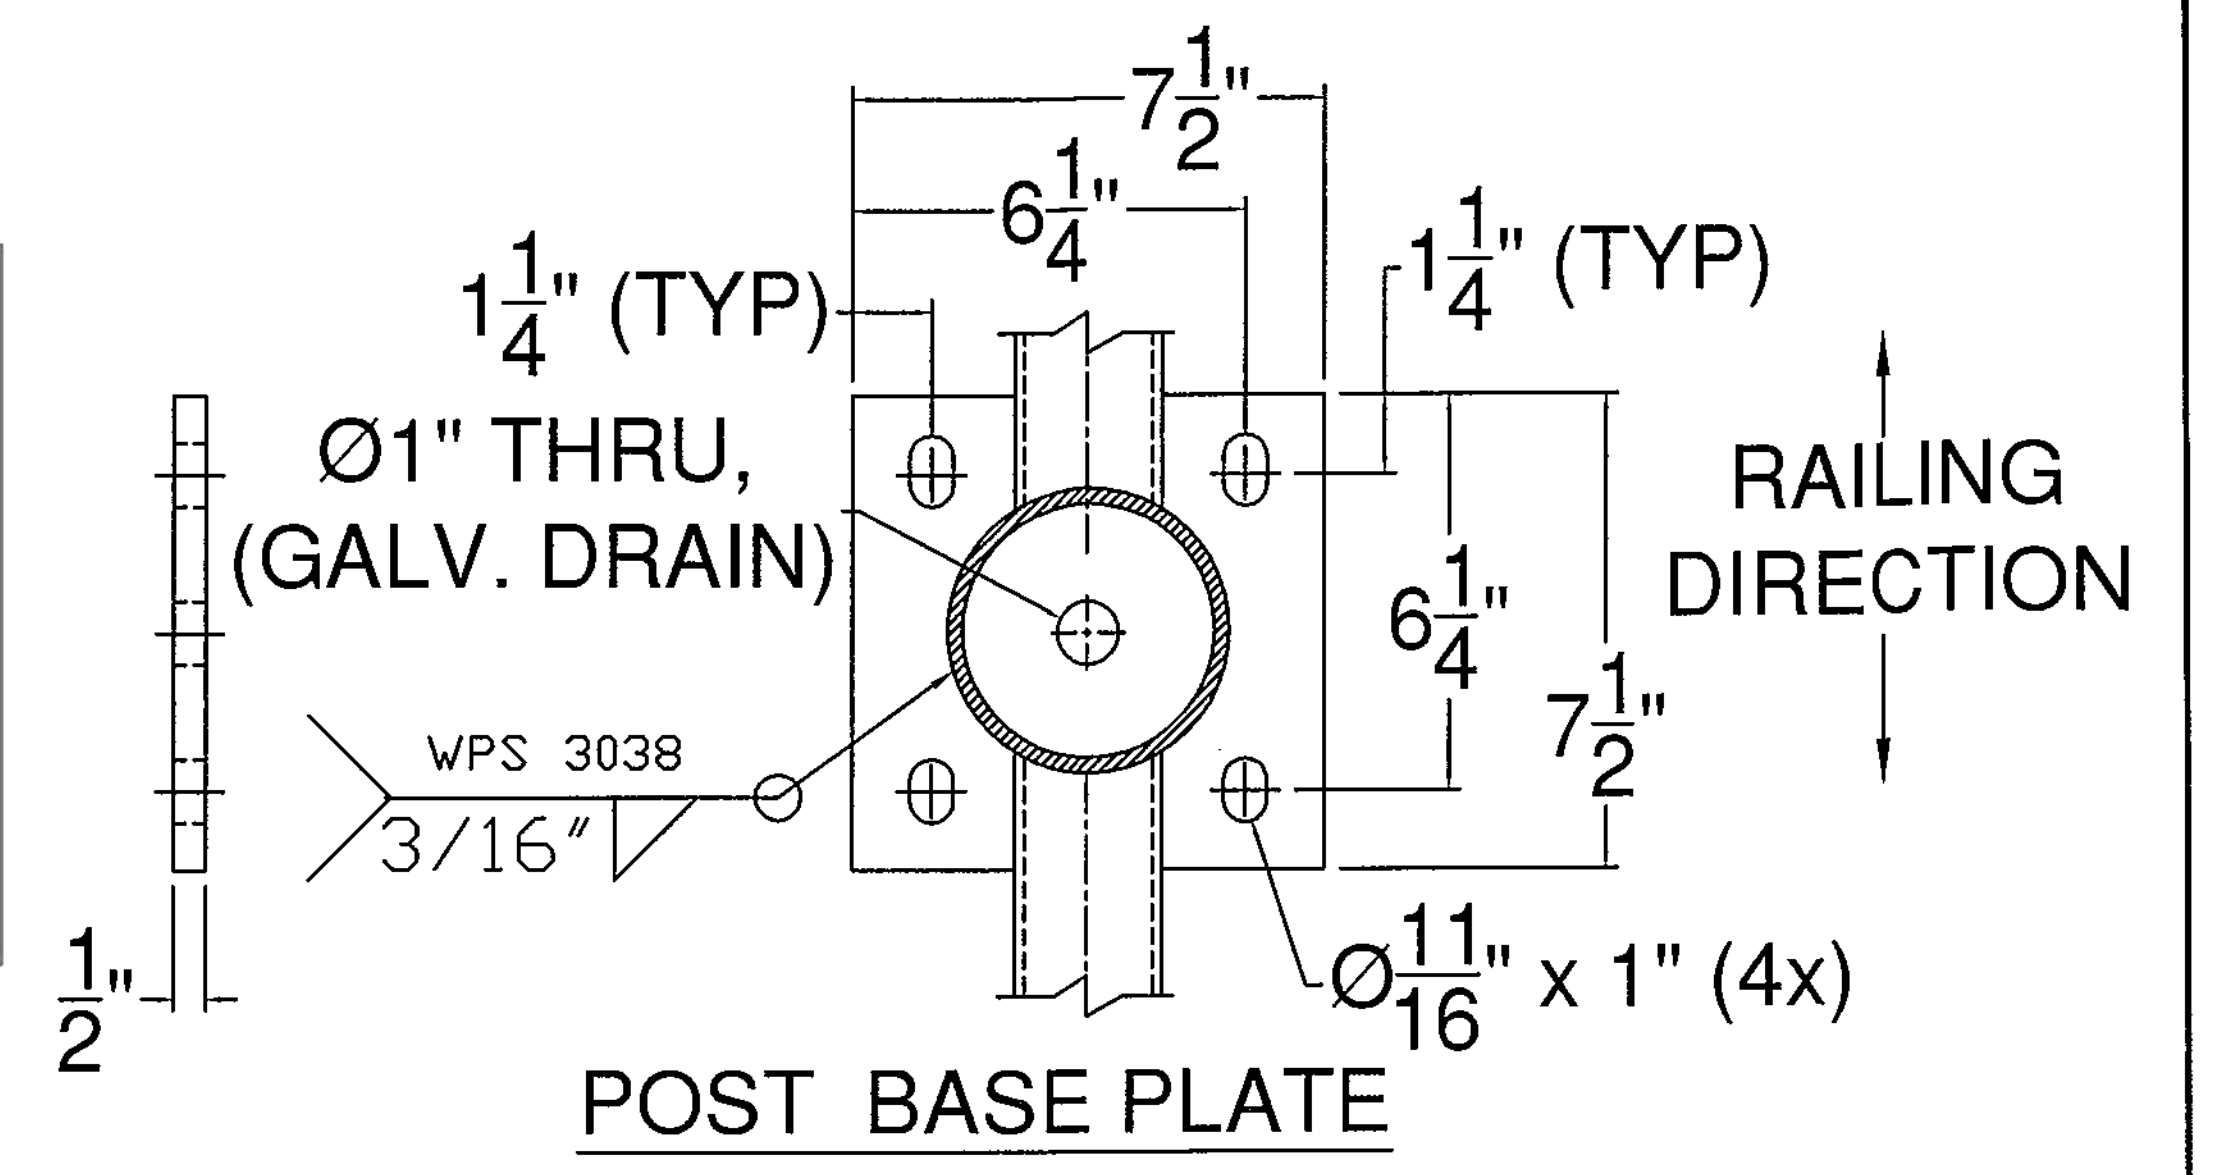

ITEM #: 900.640 SHEET 5 OF 5

APPROVED BY: _____

BRIDGE RAIL DETAILS SHEET
BRATTLEBORO BR 2000 (26)
VERMONT

R NO.	DATE	DESCRIPTION	BY	R NO.	DATE	DESCRIPTION	BY
E 1	6/2/16	REVISED PER 5/18/16 DWG REVIEW	E.P.				

ELDERLEE, INC.
OAKS CORNERS, NEW YORK 14578
E-Mail: dlong@elderlee.com
Tel: 315-789-6670 Fax: 315-789-6615

CERTIFIED FABRICATOR

DRAWN	E.P.	5/4/16
CHECKED	D.L.	5/4/16
APPROVED		
SCALE	SCHEMATIC	
DRAWING NO. F.R. LAFAYETTE-BRATTLEBORO (26)		

WELDING PROCEDURE SPECIFICATION

Material Specification ASTM-A500-A53-GRADE B TO A572 GRADE 50
 Welding Process FCAW
 Manual or Machine SEMAUTOMATIC
 Position of Welding FLAT VERTICAL OVERHEAD 5G
 Filler Metal Specification A5.20
 Filler Metal Classification E71T-1/T-1M ESAB DUAL SHIELD 7000
 Flux N/A
 Shielding Gas CO 2 Dew Point -40DEG F FLOW RATE 50 CFH
 Single or Multiple Pass SINGLE
 Single or Multiple Arc SINGLE
 Welding Current DC
 Polarity REVERSE ELECTRODE POSITIVE
 Welding Progression STRINGER
 Root Treatment PER D1.1
 Preheat and Interpass Temperature PER D1.1
 Postheat Temperature NONE
 Heat Input Min _____ Max _____

WELDING PROCEDURE

Pass no.	Electrode size	Welding Current		Travel speed	Joint detail
		Amperes	Volts		
1	.035	110	21	6IPM	
Variable	LIMITS	121	23	7	
		TO 99	TO 19	TO 5	

This procedure may vary due to fabrication sequence, fit-up, pass size, etc., within the limitation of variables given in Section 5.

Procedure No. 3036 Contractor Elderlee, Inc.
 Revision No. _____ Authorized By RANDY SCOTT
 Date 6/2/2016

SHOP DRAWING REVIEW	
<input checked="" type="checkbox"/> REVIEWED AS REQUIRED BY THE CONSTRUCTION CONTRACT DOCUMENTS AND APPROVED, BUT ONLY FOR CONFORMANCE TO THE DESIGN CONCEPT OF THE WORK, AND SUBJECT TO FURTHER LIMITATIONS AND REQUIREMENTS CONTAINED IN THE CONSTRUCTION CONTRACT DOCUMENTS.	
<input type="checkbox"/> REJECTED <input type="checkbox"/> REVISE AND RESUBMIT <input type="checkbox"/> APPROVED AS NOTED	
CORRECTIONS OR COMMENTS MADE ON THE SHOP DRAWINGS DURING THIS REVIEW DID NOT RELIEVE CONTRACTOR FROM COMPLIANCE WITH REQUIREMENTS OF THE DRAWINGS AND SPECIFICATIONS. THIS CHECK IS ONLY FOR REVIEW OF GENERAL CONFORMANCE WITH THE DESIGN CONCEPT OF THE PROJECT AND GENERAL COMPLIANCE WITH THE INFORMATION GIVEN IN THE CONTRACT DOCUMENTS. THE CONTRACTOR IS RESPONSIBLE FOR CONFIRMING AND CORRELATING ALL QUANTITIES AND DIMENSIONS; SELECTING FABRICATION PROCESSES AND TECHNIQUES OF CONSTRUCTION; COORDINATING THEIR WORK WITH THAT OF ALL OTHER TRADES; AND PERFORMING THEIR WORK IN A SAFE AND SATISFACTORY MANNER.	
	Job Number <u>150223</u> Reviewed by <u>SRB</u> Date <u>06/03/2016</u>

Vermont Agency of Transportation

RECEIVED

ON: June 2, 2016

and Checked for

CONFORMANCE

BY: Jennifer Fitch DATE: 06/03/16

WELDING PROCEDURE SPECIFICATION

PQR ELDERLEE #3

Material Specification ASTM-A500-A53-GRADE B TO A572 GRADE 50
 Welding Process FCAW-G
 Manual or Machine SEMAUTOMATIC
 Position of Welding FLAT/HORIZONTAL
 Filler Metal Specification A5.29
 Filler Metal Classification E81T1-Ni1C-JH4
 Flux N/A
 Shielding Gas CO 2 Dew Point -40DEG F Flow Rate 50CFH
 Single or Multiple Pass SINGLE
 Single or Multiple Arc SINGLE
 Welding Current DC
 Polarity REVERSE ELECTRODE POSITIVE
 Welding Progression STRINGER
 Root Treatment D1.5
 Preheat and Interpass Temperature D1.5
 Postheat Temperature NONE
 Heat Input Min _____ Max _____

WELDING PROCEDURE

Pass no.	Electrode size	Welding Current		Travel speed	Joint detail
		Amperes	Volts		
1	1/16	310	25	11	
Variable	LIMITS	341	27	12	
		TO 279	TO 23	TO 10	

This procedure may vary due to fabrication sequence, fit-up, pass size, etc., within the limitation of variables given in Section 5.

Procedure No. 3038

Revision No. _____

Contractor Elderlee, Inc.

Authorized By RANDY SCOTT

Date 6/2/2016

SHOP DRAWING REVIEW	
<input checked="" type="checkbox"/> REVIEWED AS REQUIRED BY THE CONSTRUCTION CONTRACT DOCUMENTS AND APPROVED, BUT ONLY FOR CONFORMANCE TO THE DESIGN CONCEPT OF THE WORK, AND SUBJECT TO FURTHER LIMITATIONS AND REQUIREMENTS CONTAINED IN THE CONSTRUCTION CONTRACT DOCUMENTS.	
<input type="checkbox"/> REJECTED <input type="checkbox"/> REVISE AND RESUBMIT <input type="checkbox"/> APPROVED AS NOTED	
CORRECTIONS OR COMMENTS MADE ON THE SHOP DRAWINGS DURING THIS REVIEW DID NOT RELIEVE CONTRACTOR FROM COMPLIANCE WITH REQUIREMENTS OF THE DRAWINGS AND SPECIFICATIONS. THIS CHECK IS ONLY FOR REVIEW OF GENERAL CONFORMANCE WITH THE DESIGN CONCEPT OF THE PROJECT AND GENERAL COMPLIANCE WITH THE INFORMATION GIVEN IN THE CONTRACT DOCUMENTS. THE CONTRACTOR IS RESPONSIBLE FOR CONFIRMING AND CORRELATING ALL QUANTITIES AND DIMENSIONS; SELECTING FABRICATION PROCESSES AND TECHNIQUES OF CONSTRUCTION; COORDINATING THEIR WORK WITH THAT OF ALL OTHER TRADES; AND PERFORMING THEIR WORK IN A SAFE AND SATISFACTORY MANNER.	
	Job Number: <u>150223</u> Reviewed by: <u>SRB</u> Date: <u>06/03/2016</u>

Vermont Agency of Transportation


RECEIVED

ON: June 2, 2016

and Checked for


CONFORMANCE

BY: Jennifer Fitch DATE: 06/03/16

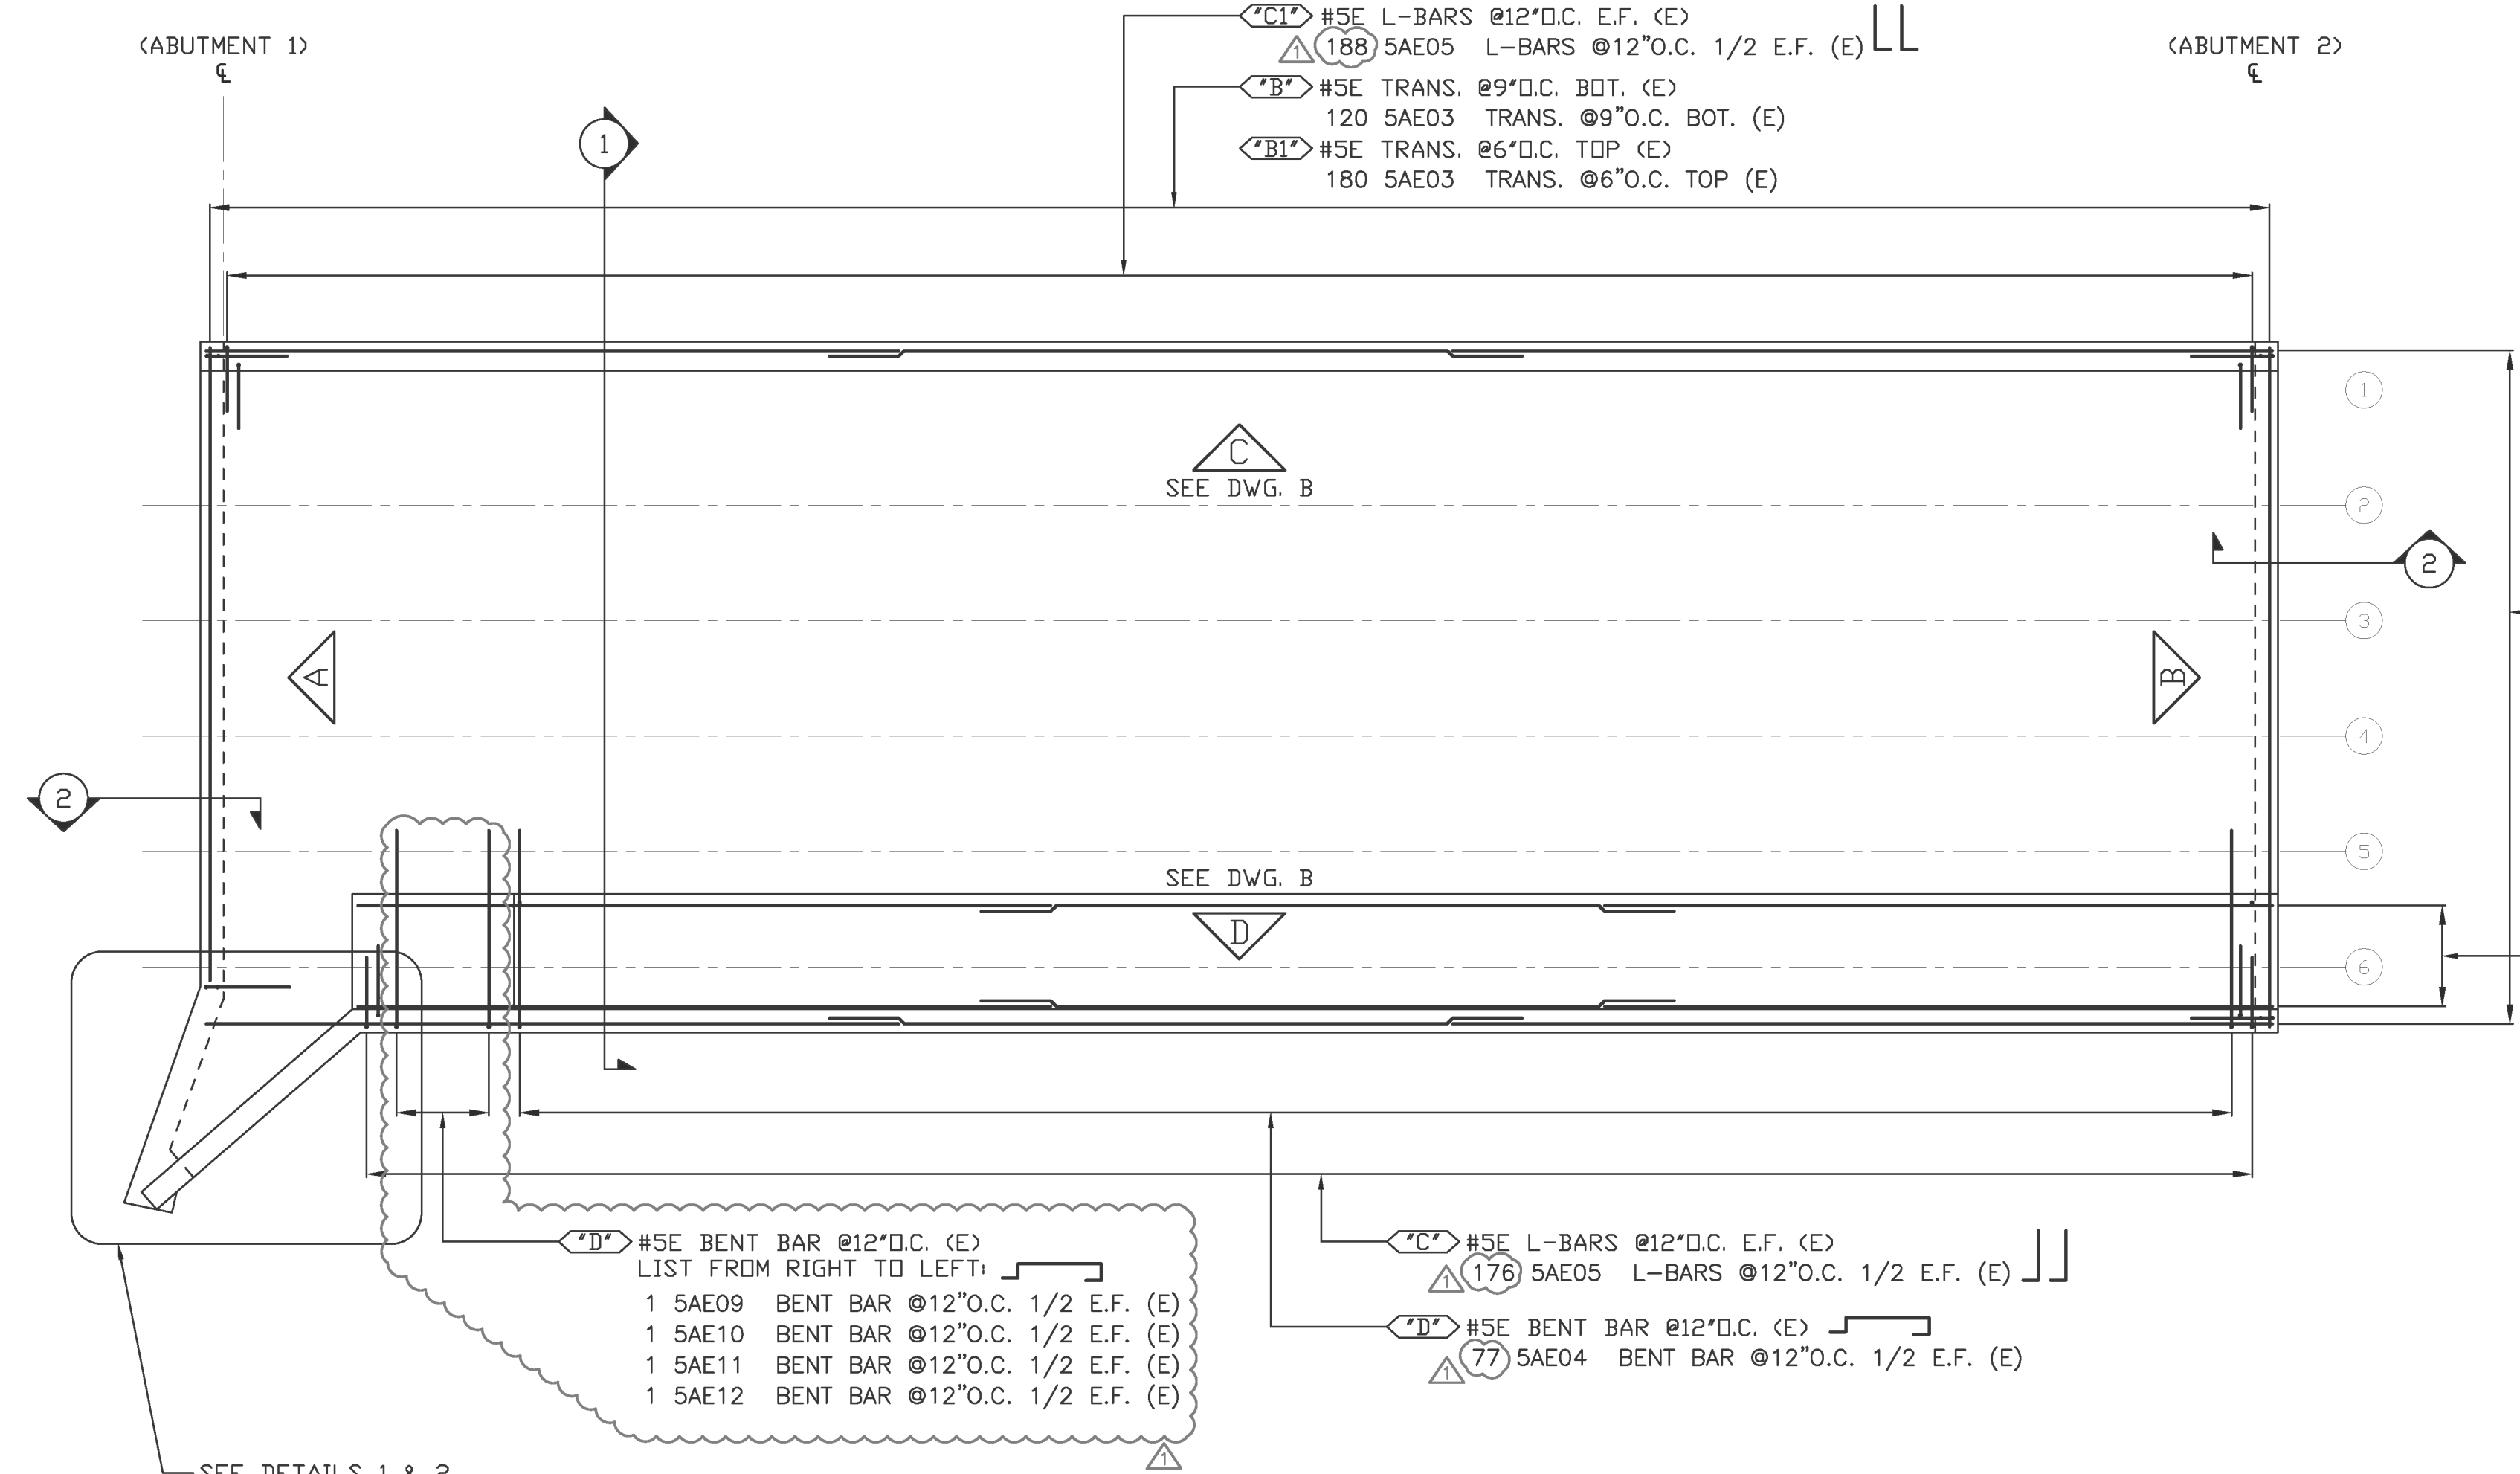


DECK REINFORCEMENT PLAN
CONTRACT REF. SHEET 13

PLEASE NOTE - THE FINISHED GRADE ELEVATIONS HAVE BEEN REVISED ALONG THE LENGTH OF THE BRIDGE. SEE NEW ELEVATIONS BELOW. HOWEVER, IT APPEARS THAT THE CURTAIN WALL BAR LENGTHS ARE OK AS CURRENTLY SHOWN IN BAR LIST.

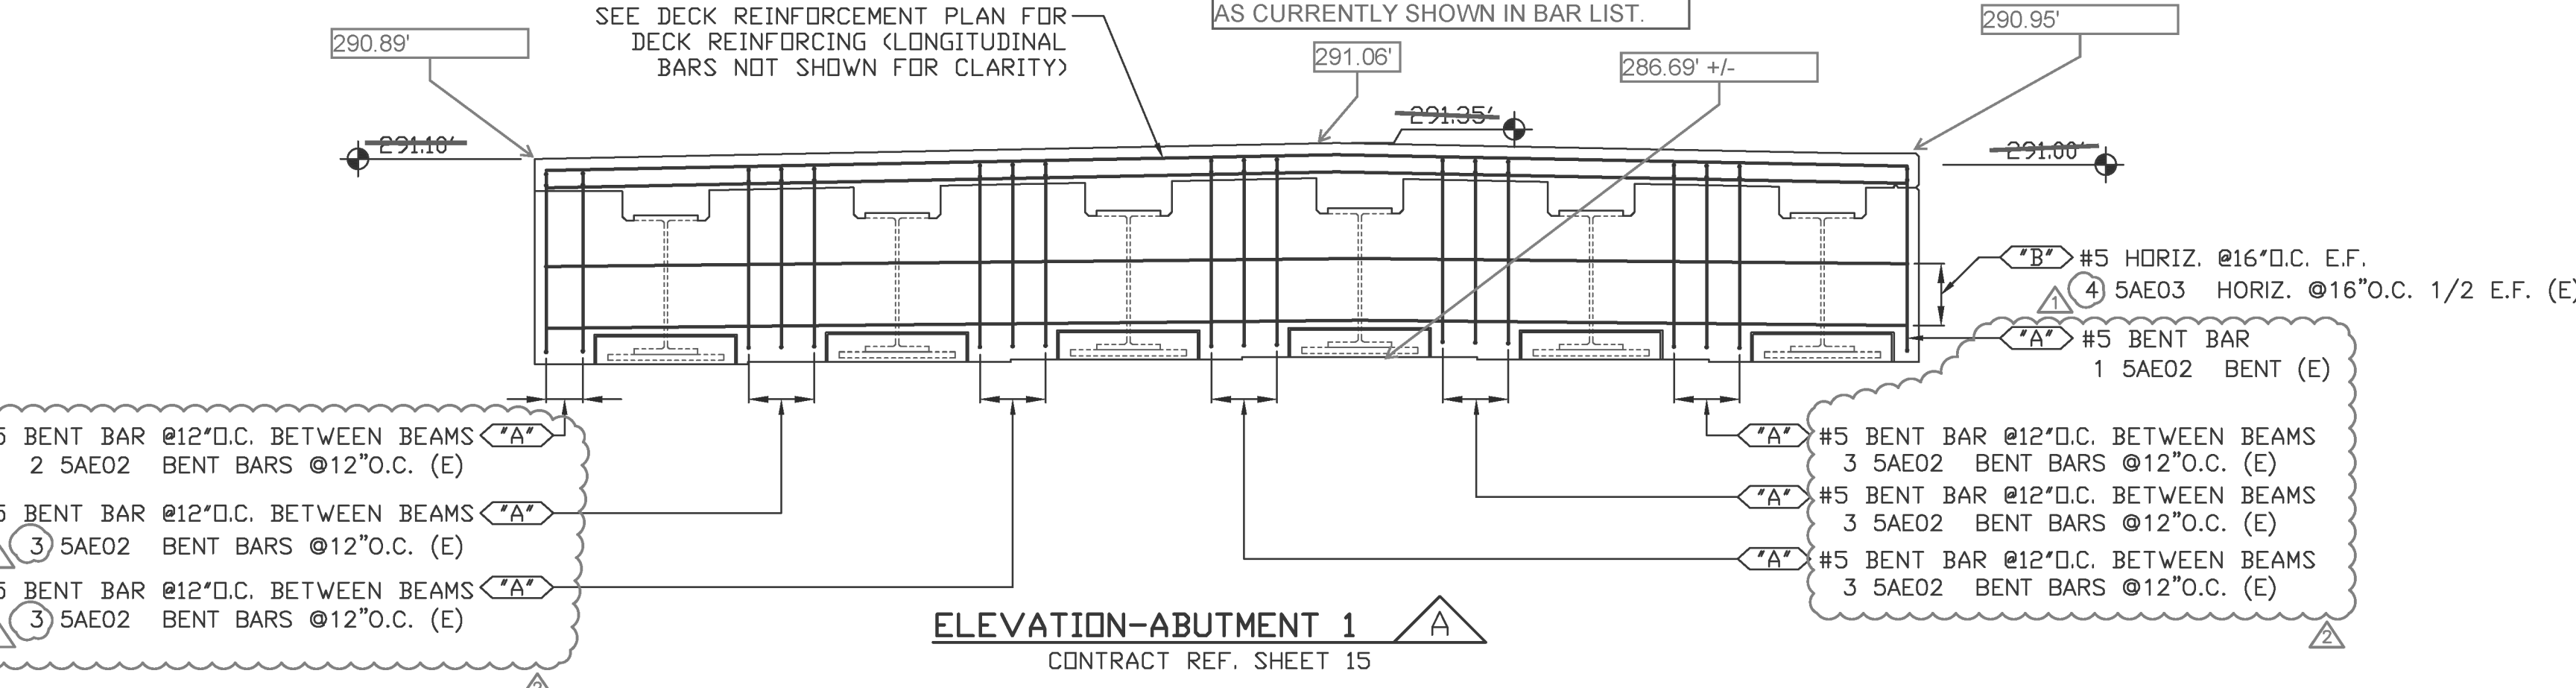


ELEVATION-ABUTMENT 1
CONTRACT REF. SHEET 15

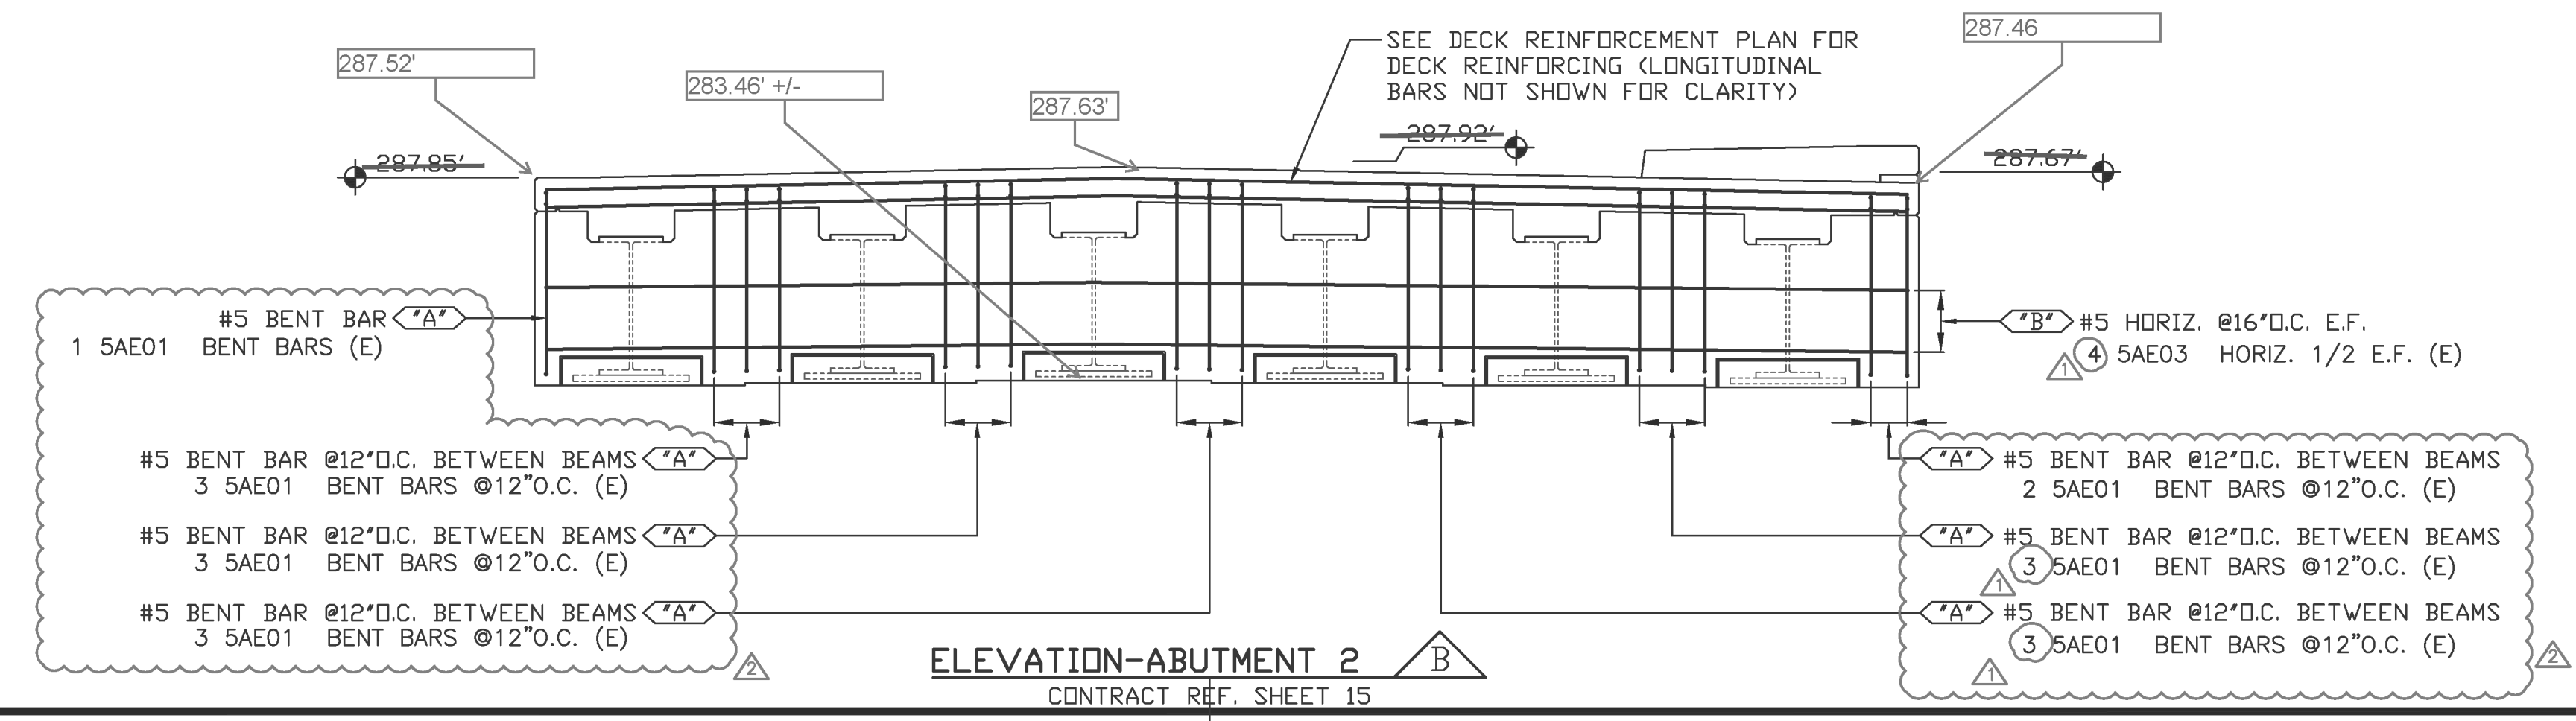

ELEVATION-ABUTMENT 2
CONTRACT REF. SHEET 15


Release Number:		BAR LIST															
Bar Mark	Qty	Size	Total Length	Type	'A'	'B'	'C'	'D'	'E'	'F'	'G'	'H'	'J'	'K'	'O'	'R'	
5AE01	18	#5	13'-7"	H68		3'-0"	3'-4 1/2"	△ 0'-7"	3'-7 1/2"	3'-0"							
5AE02	18	#5	14'-0"	H68		3'-0"	3'-7"	△ 0'-7"	3'-10"	3'-0"							
5AE03	308	#5	29'-5"														
5AE04	77	#5	9'-1"	H68		0'-10"	0'-11"	5'-5"	1'-1"	0'-10"							
5AE05	364	#5	4'-3"	17		1'-0"	3'-3"										
5AE06	7	#5	28'-6"														
5AE07	126	#5	30'-0"														
5AE08	56	#5	35'-6"														
5AE09	1	#5	8'-11"	H68		0'-10"	0'-10"	5'-5"	1'-0"	0'-10"							
5AE10	1	#5	8'-8"	H68		0'-10"	0'-8 1/2"	5'-5"	0'-10 1/2"	0'-10"							
5AE11	1	#5	8'-6"	H68		0'-10"	0'-7 1/2"	5'-5"	0'-9 1/2"	0'-10"							
5AE12	1	#5	8'-3"	H68		0'-10"	0'-6"	5'-5"	0'-8"	0'-10"							

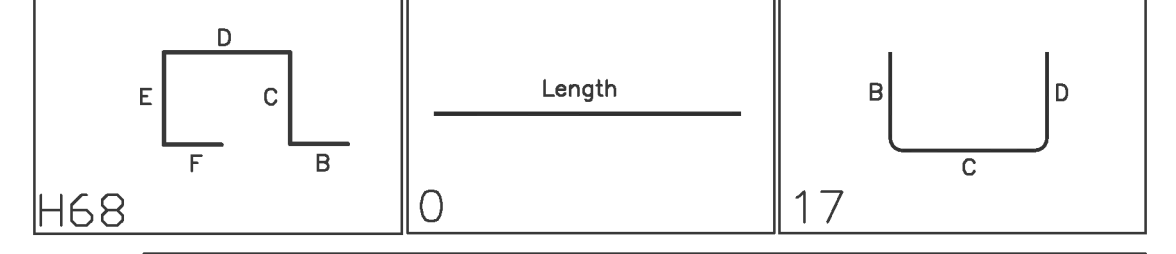

ALL REINF. EPOXY

Vermont Agency of Transportation
RECEIVED
ON: June 29, 2016
and Checked for
CONFORMANCE
BY: Jennifer Fitch DATE: 06/29/16

FIELD ADJUST CONT. SIDEWALK BARS AS REQUIRED AT RAMP

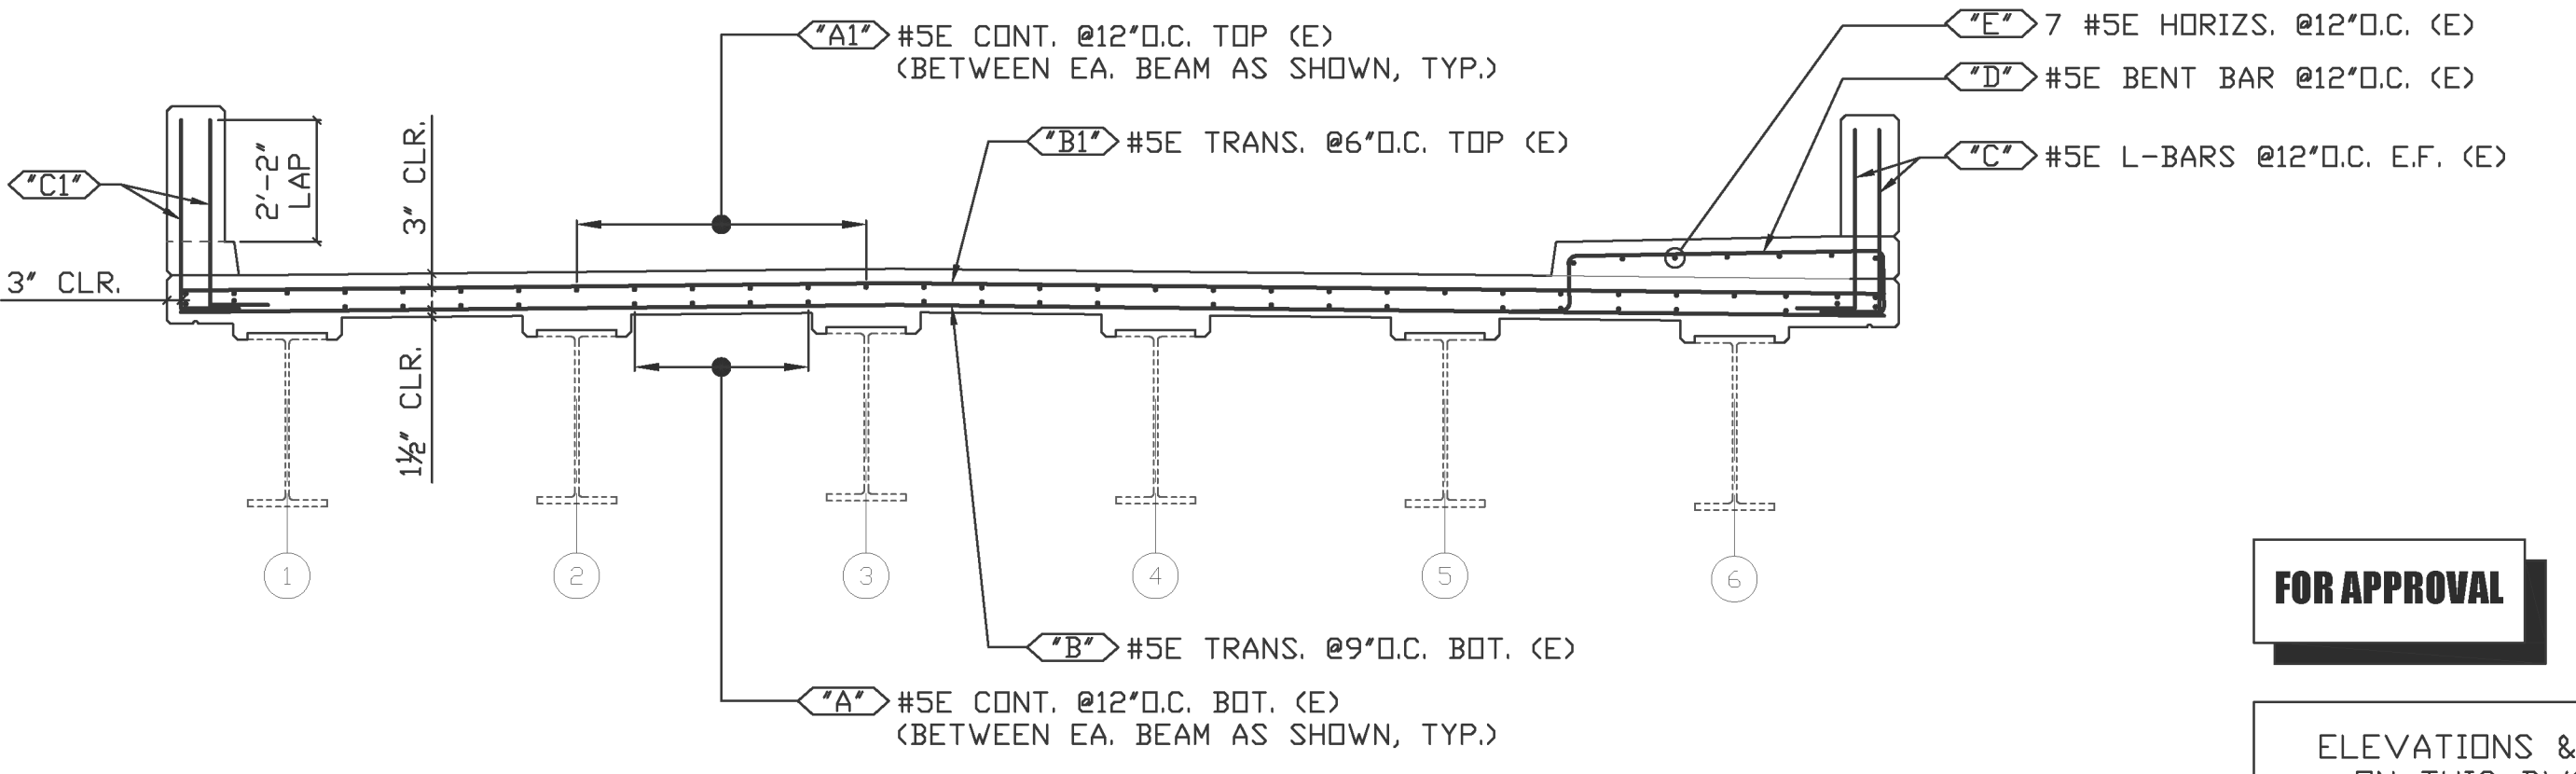

SECTION 1
CONTRACT REF. SHEET 13

LEGEND:
CONT.-CONTINUOUS
TRANS.-TRANSVERSE
LONG.-LONGITUDINAL
LAT.-LATITUDINAL
DWLS.-DOWELS
VERTS.-VERTICAL
T&B -TOP & BOTTOM
I.F.-INNER FACE
O.F.-OUTER FACE
E.E.-EACH END
E.F.-EACH FACE
R.F.-FRONT FACE
E.W.-EACH WAY
O.C.-ON CENTER
L.W.-LONG WAY
S.W.-SHORT WAY

FOR APPROVAL

ELEVATIONS & DIMENSIONS SHOWN ON THIS DWG. ARE FOR REINF. DETAILING PURPOSES ONLY AND ARE NOT INTENDED FOR DIMENSIONAL CONSTRUCTION.

EPOXY REINF. BARS ASTM A615 GRADE 60, MARKED (E)

VERIFICATION OF UNCLEAR INFORMATION MAY BE REQUESTED ON THIS DRAWING. SHOULD VERIFICATION BE LEFT UN-ADDRESSED IT WILL REMAIN AS SHOWN AND ASSUME TO BE CORRECT.

SHOP DRAWING REVIEW


REVIEWED AS REQUIRED BY THE CONSTRUCTION CONTRACT DOCUMENTS AND APPROVED, BUT ONLY FOR CONFORMANCE TO THE DESIGN CONCEPT OF THE WORK, AND SUBJECT TO FURTHER LIMITATIONS AND REQUIREMENTS CONTAINED IN THE CONSTRUCTION CONTRACT DOCUMENTS.

REJECTED REVISE AND RESUBMIT APPROVED AS NOTED

CORRECTIONS OR COMMENTS MADE ON THE SHOP DRAWINGS DURING THIS REVIEW DID NOT RELIEVE CONTRACTOR FROM COMPLIANCE WITH REQUIREMENTS OF THE DRAWINGS AND SPECIFICATIONS. THIS CHECK IS ONLY FOR REVIEW OF GENERAL CONFORMANCE WITH THE DESIGN CONCEPT OF THE PROJECT AND GENERAL COMPLIANCE WITH THE INFORMATION GIVEN IN THE CONTRACT DOCUMENTS. THE CONTRACTOR IS RESPONSIBLE FOR CONFIRMING AND CORRELATING ALL QUANTITIES AND DIMENSIONS; SELECTING FABRICATION PROCESSES AND TECHNIQUES OF CONSTRUCTION; COORDINATING THEIR WORK WITH THAT OF ALL OTHER TRADES; AND PERFORMING THEIR WORK IN A SAFE AND SATISFACTORY MANNER.

CLD Consulting Engineers
540 Commercial Street
Manchester, NH 03101
603-688-8223

Job Number: 150223
Revised by: SRB
Date: 06/30/2016

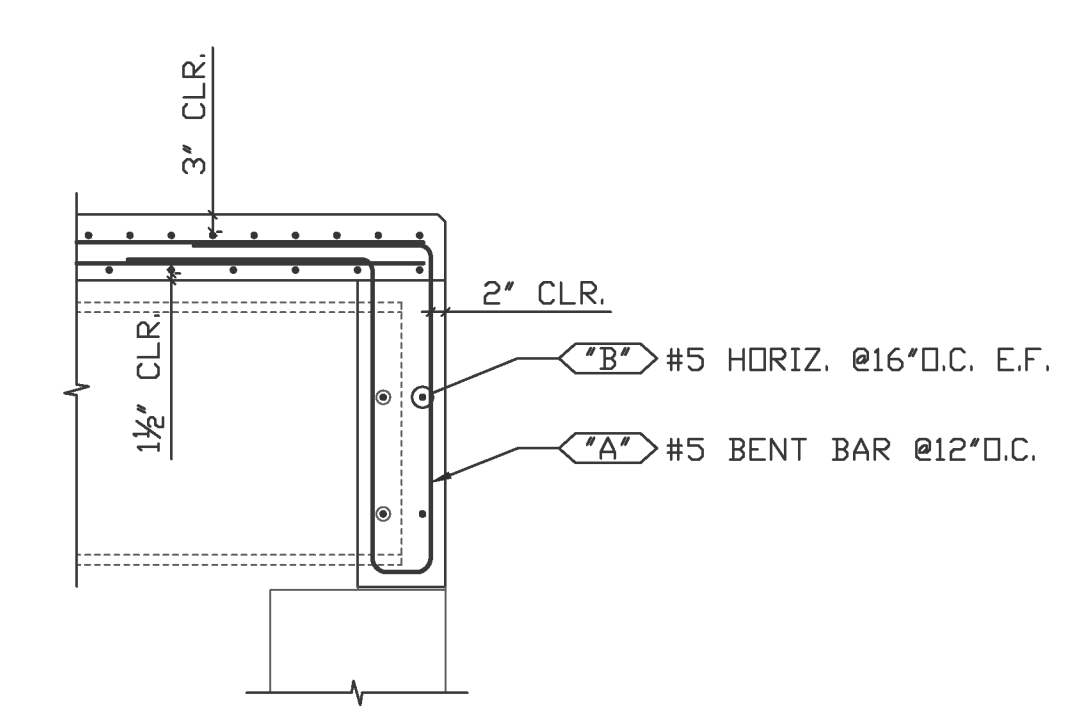

SECTION 2
CONTRACT REF. SHEET 16

DATE	REV.#	SENT FOR
6/27/16	△	REVISED AS NOTED/FOR APPROVAL
6/21/16	△	REVISED AS NOTED/FOR APPROVAL
6/13/16	-	FOR APPROVAL

DATE: 5/13/16 REV.#: 9744

DIMENSION
DIMENSION FABRICATORS INC.
2000 7TH STREET
SCOTIA, N.Y. 12502
PH: (518) 374-1936
FAX: (518) 374-4830
www.dimensionfabricators.com

STRUCTURE: VTAOT BRATTLEBORO BF2000(26)

LOCATION: ELLITO ST. OVER WHETSTONE BROOK
BRATTLEBORO, VT



ARCHITECT: N/A

ENGINEER: CLD CONSULTING ENGINEERS

CUSTOMER: RENAUD BROS., INC.

DRAWN BY: STEPHEN B. DATE: 5/13/16 DFN # 9744


DRAWING COVERS: DECK & SIDEWALK REINF. DRAWING # A

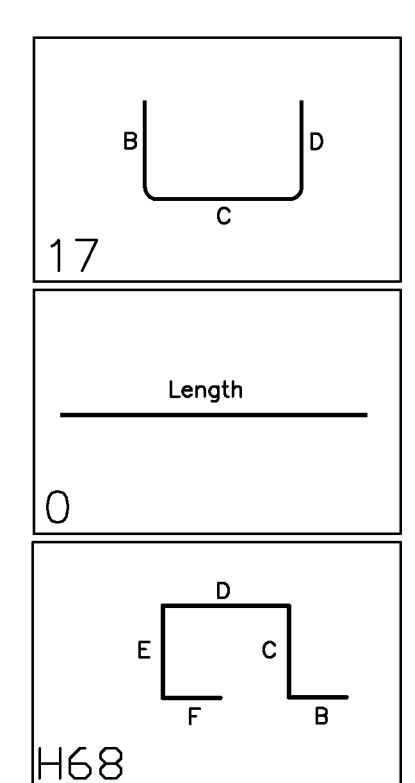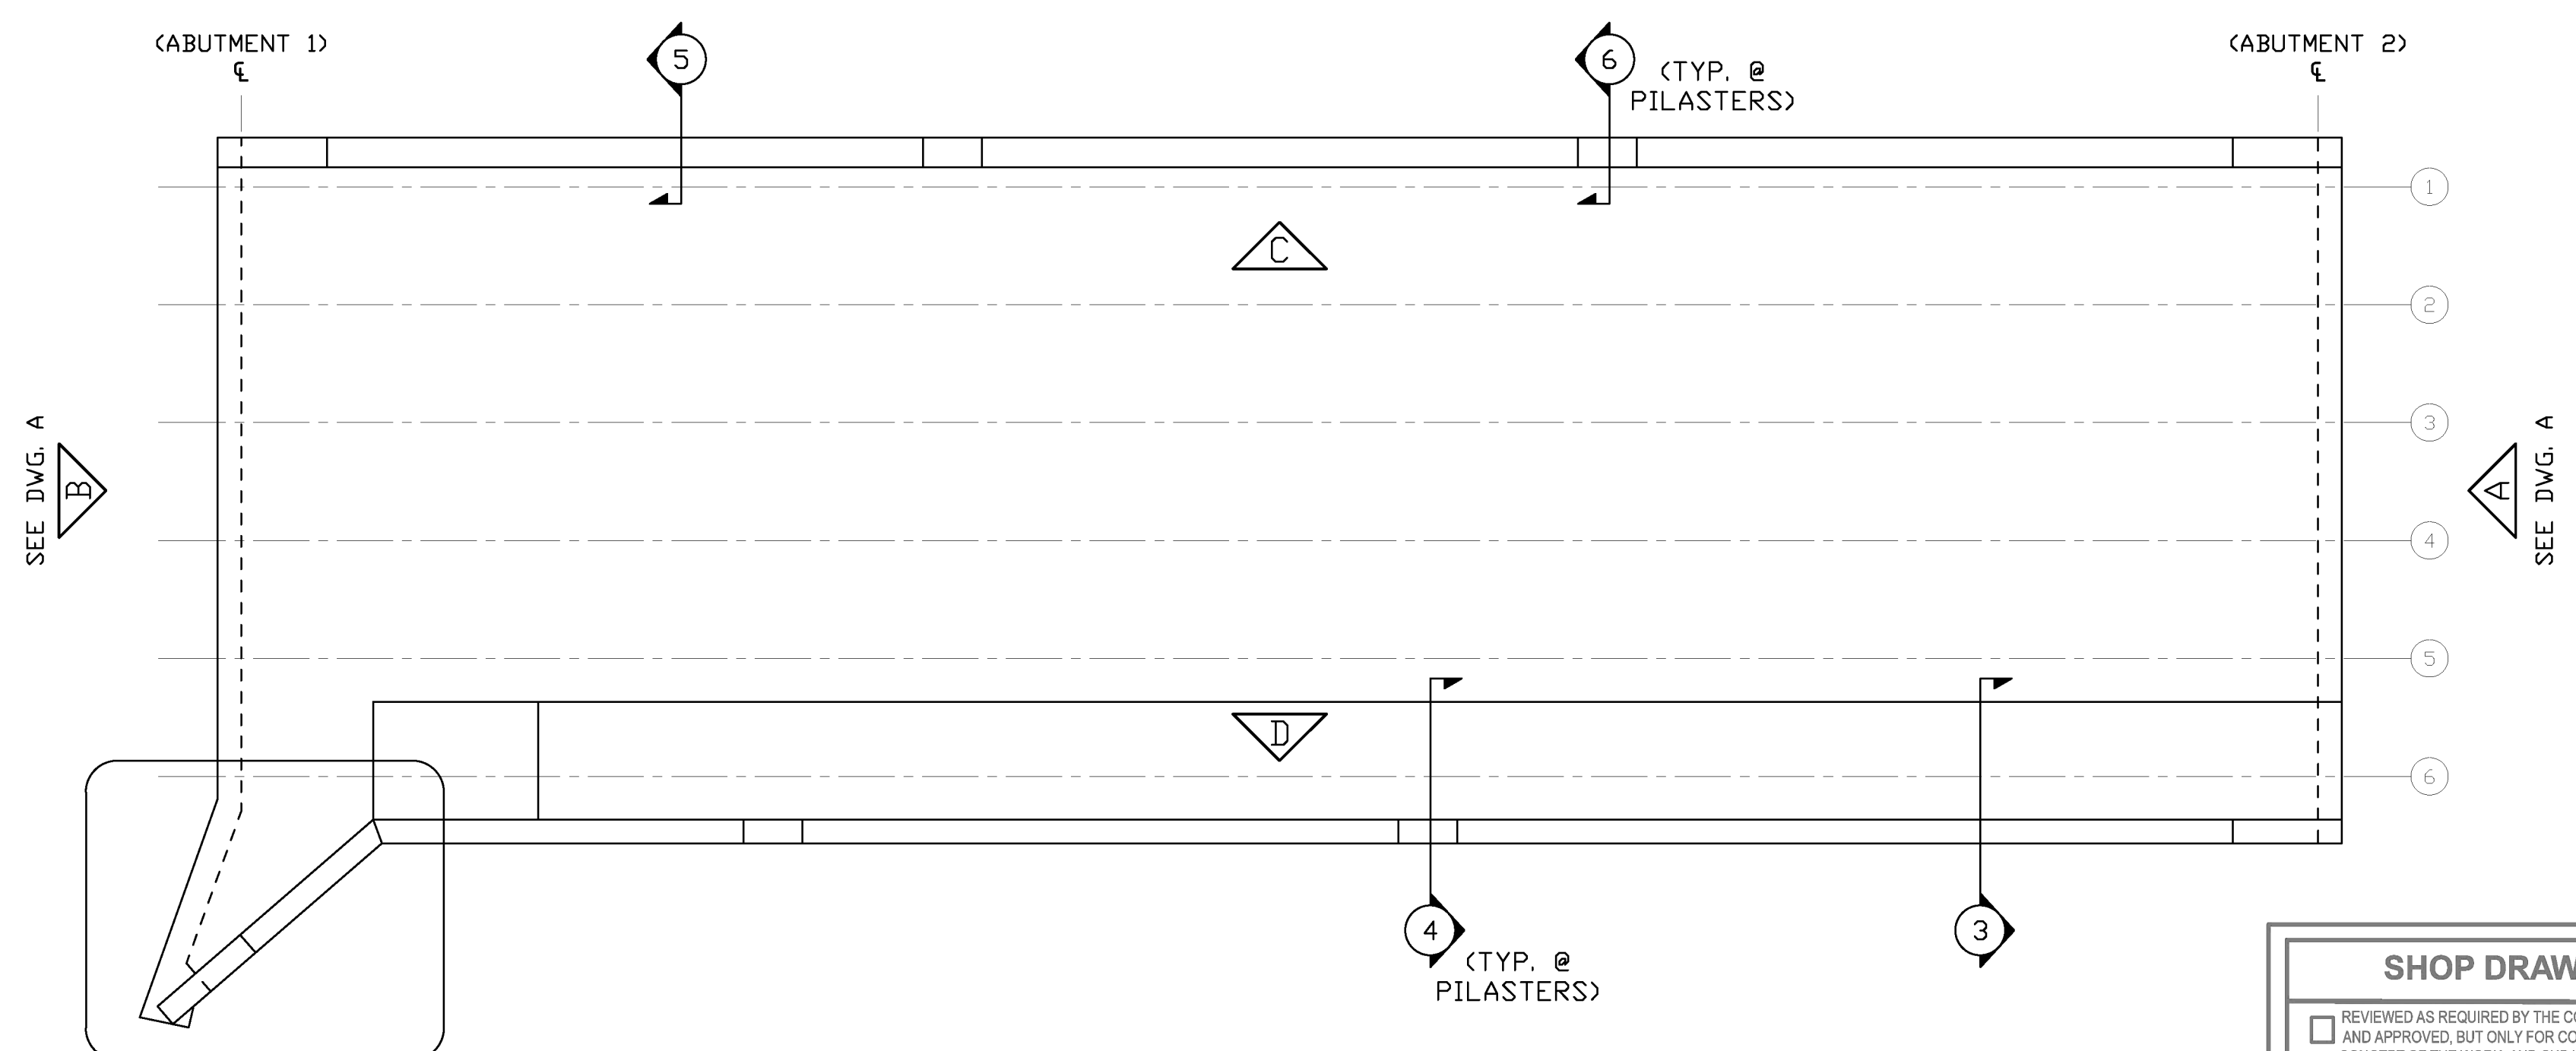


Release Number:				BAR LIST															
Bar Mark	Qty	Size	Total Length	Type	'A'	'B'	'C'	'D'	'E'	'F'	'G'	'H'	'J'	'K'	'O'	'R'			
5AE01	28	#5	4'-3"	17		1'-0"	3'-3"												
5AE02	2	#5	18'-0"			18'-0"													
5AE03	2	#5	17'-7"			17'-7"													
5AE04	2	#5	2'-9"	17		1'-0"	1'-9"												
5AE05	2	#5	14'-11"			14'-11"													
5AE06	2	#5	12'-3"			12'-3"													
5AE07	2	#5	9'-6"			9'-6"													
5AE08	2	#5	6'-10"			6'-10"													
5AE09	2	#5	4'-1"			4'-1"													
5AE10a	1	#5	1'-7"			1'-7"													
5AE10b	1	#5	2'-2"			2'-2"													
5AE10c	1	#5	2'-10"			2'-10"													
5AE10d	1	#5	3'-5"			3'-5"													
5AE10e	1	#5	4'-1"			4'-1"													
5AE10f	1	#5	4'-8"			4'-8"													
5AE10g	1	#5	5'-4"			5'-4"													
5AE10h	1	#5	5'-11"			5'-11"													
5AE10i	1	#5	6'-7"			6'-7"													
5AE10j	1	#5	7'-2"			7'-2"													
5AE10k	1	#5	7'-10"			7'-10"													
5AE11a	1	#5	1'-7"			1'-7"													
5AE11b	1	#5	1'-11"			1'-11"													
5AE11c	1	#5	2'-4"			2'-4"													
5AE11d	1	#5	2'-9"			2'-9"													
5AE11e	1	#5	3'-1"			3'-1"													
5AE11f	1	#5	3'-6"			3'-6"													
5AE11g	1	#5	3'-11"			3'-11"													
5AE11h	1	#5	4'-3"			4'-3"													
5AE11i	1	#5	4'-8"			4'-8"													
5AE11j	1	#5	5'-1"			5'-1"													
5AE11k	1	#5	5'-5"			5'-5"													
5AE11l	1	#5	5'-10"			5'-10"													
5AE11m	1	#5	6'-3"			6'-3"													
5AE11n	1	#5	6'-7"			6'-7"													
5AE11o	1	#5	7'-0"			7'-0"													
5AE11p	1	#5	7'-5"			7'-5"													
5AE11q	1	#5	7'-10"			7'-10"													
5AE12	1	#5	5'-4"	17		1'-7"	2'-2"	1'-7"											
5AE13	2	#5	7'-4"	17		2'-7"	1'-9"	3'-0"											
5AE14	2	#5	10'-4"	H68		3'-0"	1'-7"	1'-0"											
5AE15	9	#5	9'-2"	H68		3'-0"	1'-6"	0'-7"	1'-7"										
5AE16	6	#5	13'-6"			13'-6"													

KEY PLAN
CONTRACT REF. SHEET 13

CONTRACTOR IS TO CONFIRM ELEVATIONS DURING DEMOLITION

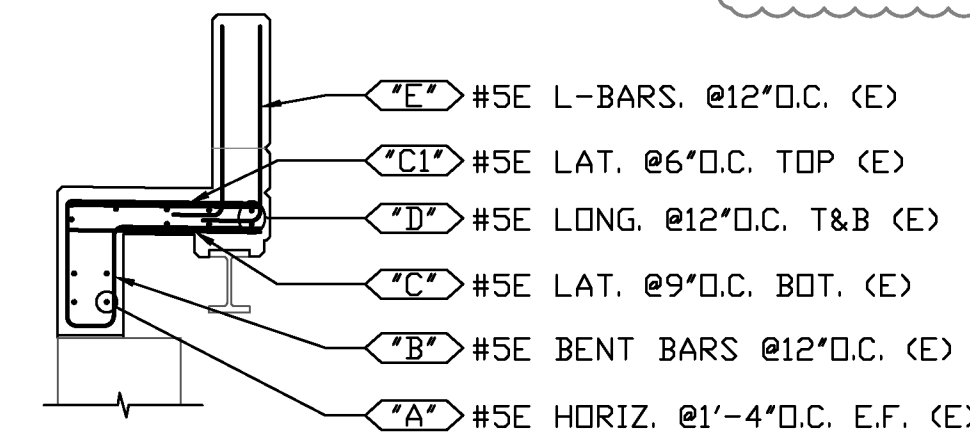

SECTION 1
CONTRACT REF. SHEET 13

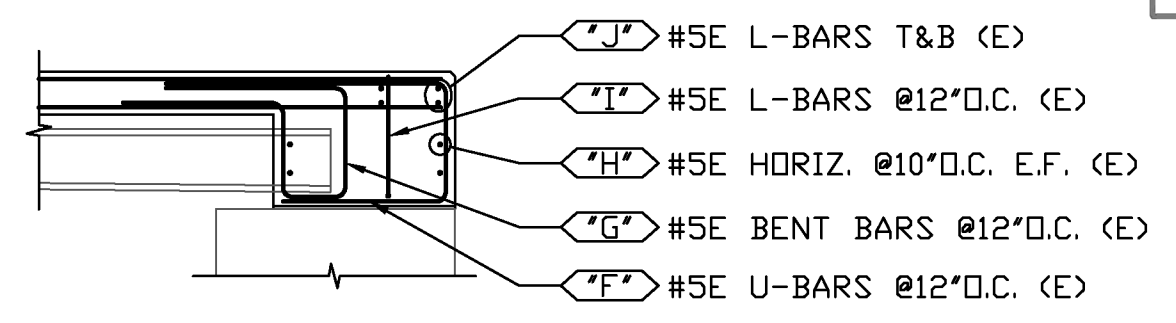

SECTION 2
CONTRACT REF. SHEET 13

SHOP DRAWING REVIEW

REVIEWED AS REQUIRED BY THE CONSTRUCTION CONTRACT DOCUMENTS AND APPROVED, BUT ONLY FOR CONFORMANCE TO THE DESIGN CONCEPT OF THE WORK, AND SUBJECT TO FURTHER LIMITATIONS AND REQUIREMENTS CONTAINED IN THE CONSTRUCTION CONTRACT DOCUMENTS.

REJECTED REVISE AND RESUBMIT APPROVED AS NOTED

CORRECTIONS OR COMMENTS MADE ON THE SHOP DRAWINGS DURING THIS REVIEW DID NOT RELIEVE CONTRACTOR FROM COMPLIANCE WITH REQUIREMENTS OF THE DRAWINGS AND SPECIFICATIONS. THIS CHECK IS ONLY FOR REVIEW OF GENERAL CONFORMANCE WITH THE DESIGN CONCEPT OF THE PROJECT AND GENERAL COMPLIANCE WITH THE INFORMATION GIVEN IN THE CONTRACT DOCUMENTS. THE CONTRACTOR IS RESPONSIBLE FOR CONFIRMING AND CORRELATING ALL QUANTITIES AND DIMENSIONS; SELECTING FABRICATION PROCESSES AND TECHNIQUES OF CONSTRUCTION; COORDINATING THEIR WORK WITH THAT OF ALL OTHER TRADES; AND PERFORMING THEIR WORK IN A SAFE AND SATISFACTORY MANNER.

CLD Consulting Engineers
540 Commercial Street
Manchester, NH 03101
603-668-8223

Job Number: 150223
Reviewed by: SRB
Date: 06/30/2016

Vermont Agency of Transportation
RECEIVED
ON: June 29, 2016
and Checked for
CONFORMANCE
BY: Jennifer Fitch DATE: 06/29/16


FOR APPROVAL

ALL REINF. EPOXY


ELEVATIONS & DIMENSIONS SHOWN ON THIS DWG. ARE FOR REINF. DETAILING PURPOSES ONLY AND ARE NOT INTENDED FOR DIMENSIONAL CONSTRUCTION.

EPOXY REINF. BARS ASTM A615 GRADE 60, MARKED (E)

VERIFICATION OF UNCLEAR INFORMATION MAY BE REQUESTED ON THIS DRAWING. SHOULD VERIFICATION BE LEFT UN-ADDRESSED IT WILL REMAIN AS SHOWN AND ASSUME TO BE CORRECT.

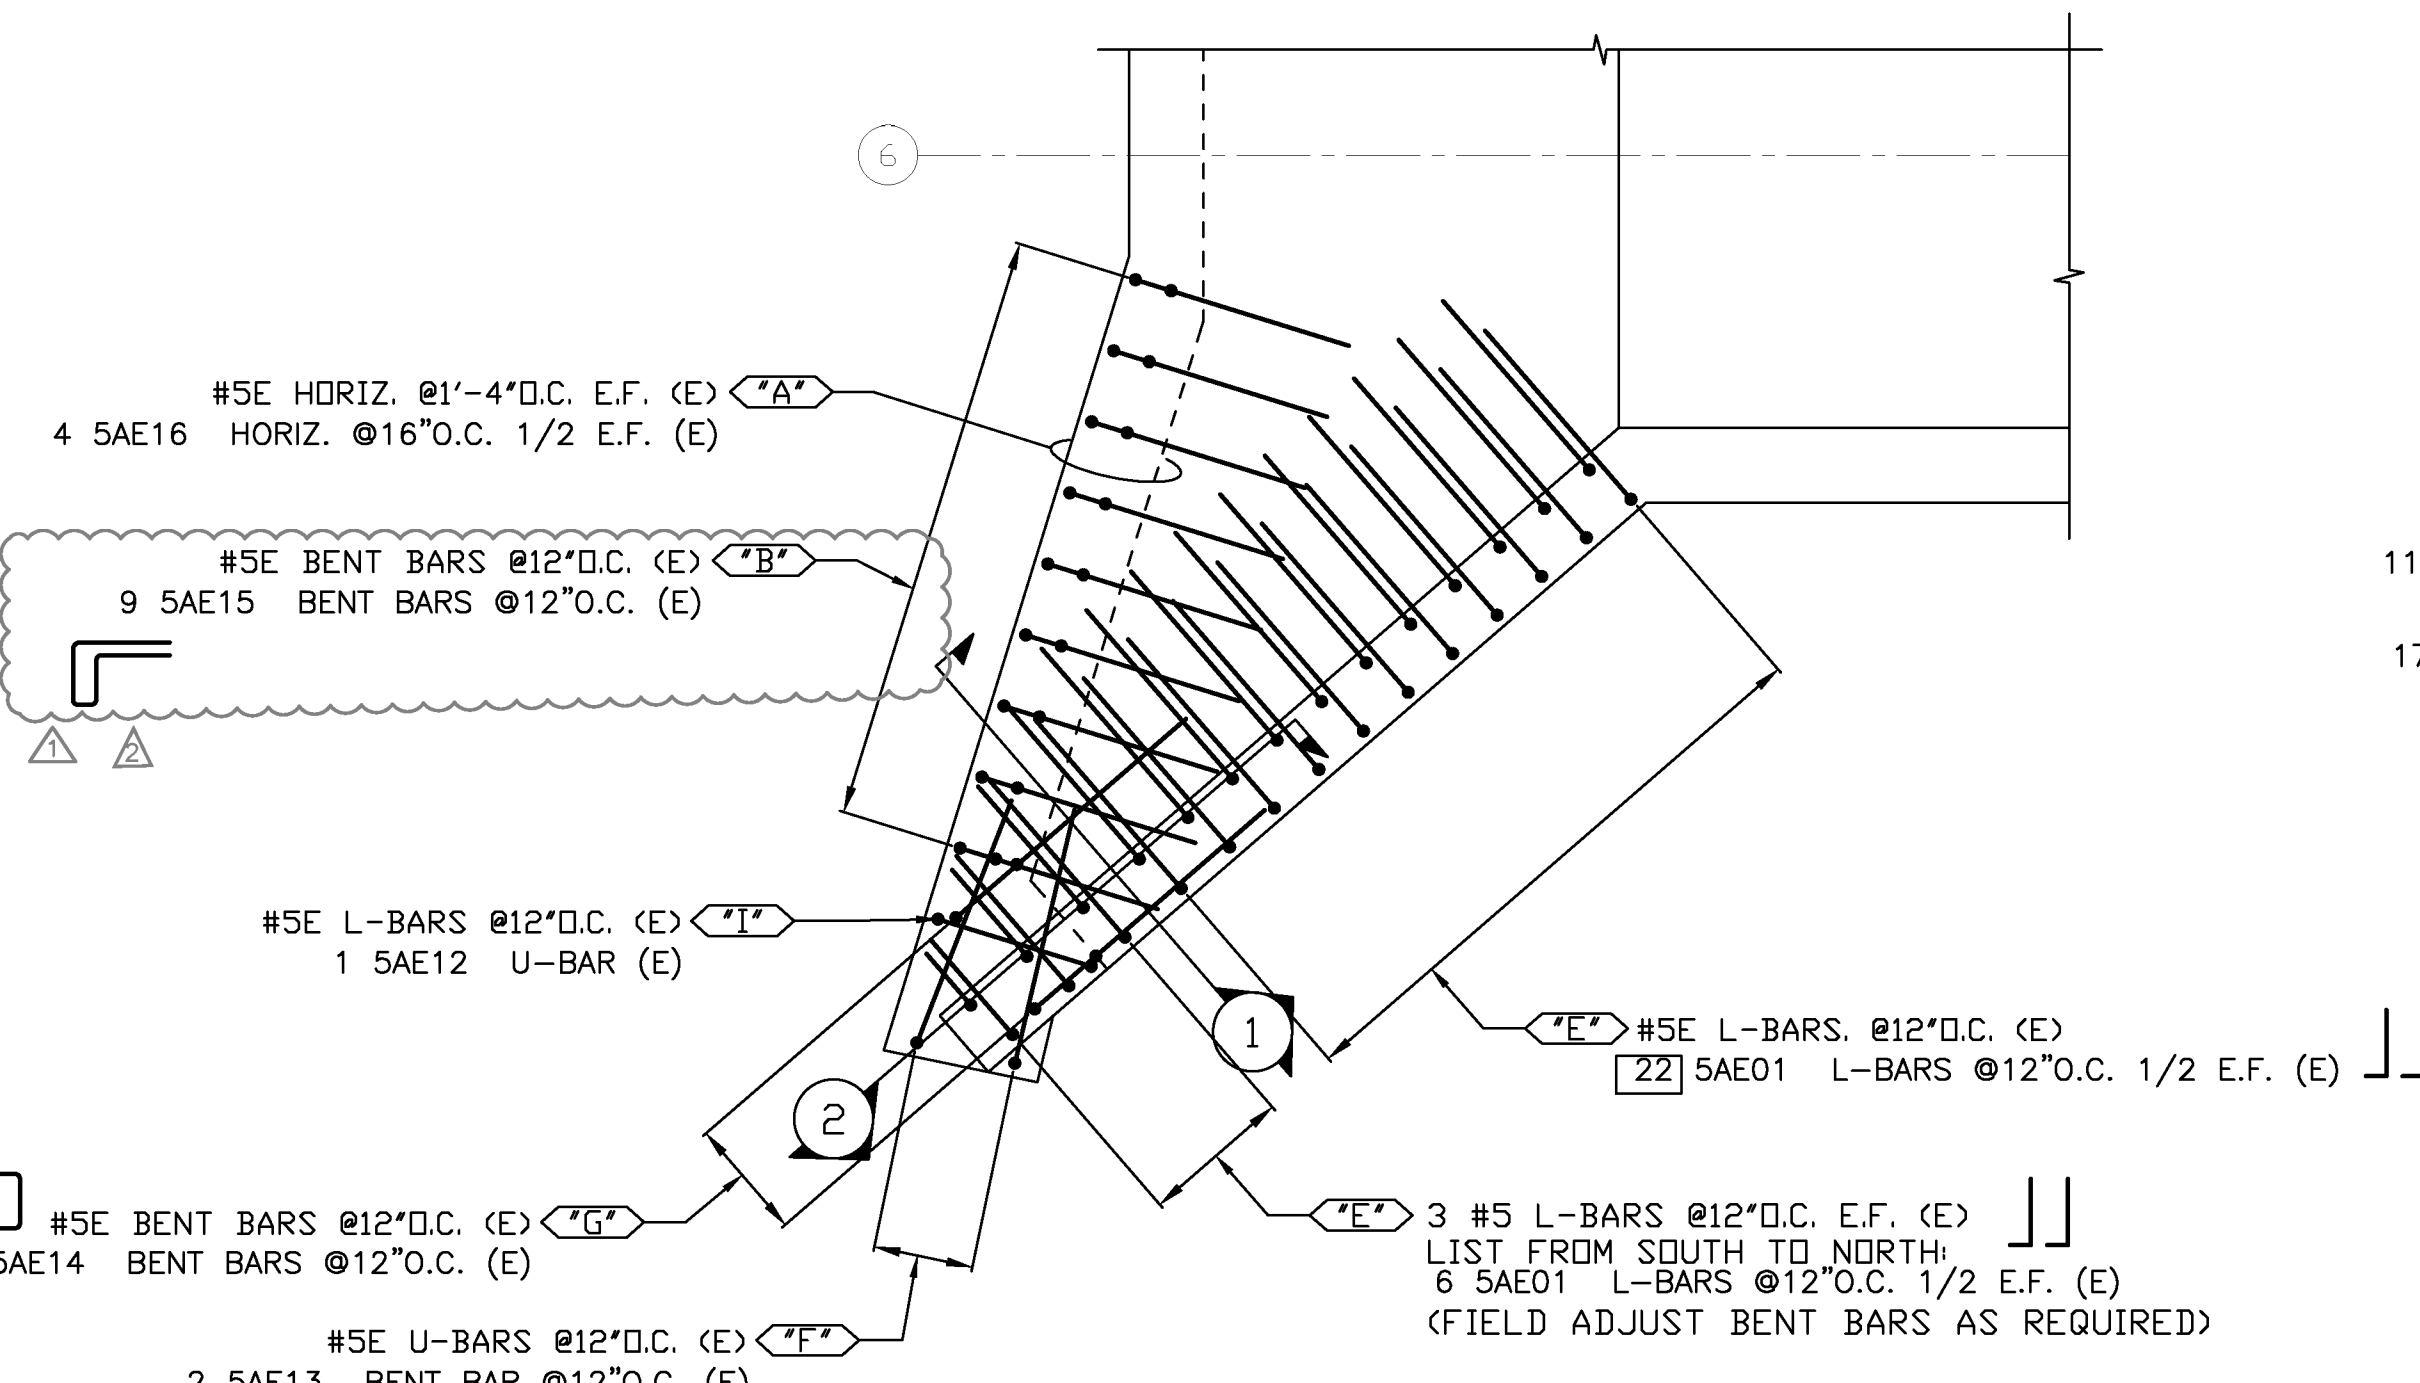


DETAIL 1 - BACKWALL AND BARRIER REINF.
CONTRACT REF. SHEET 13

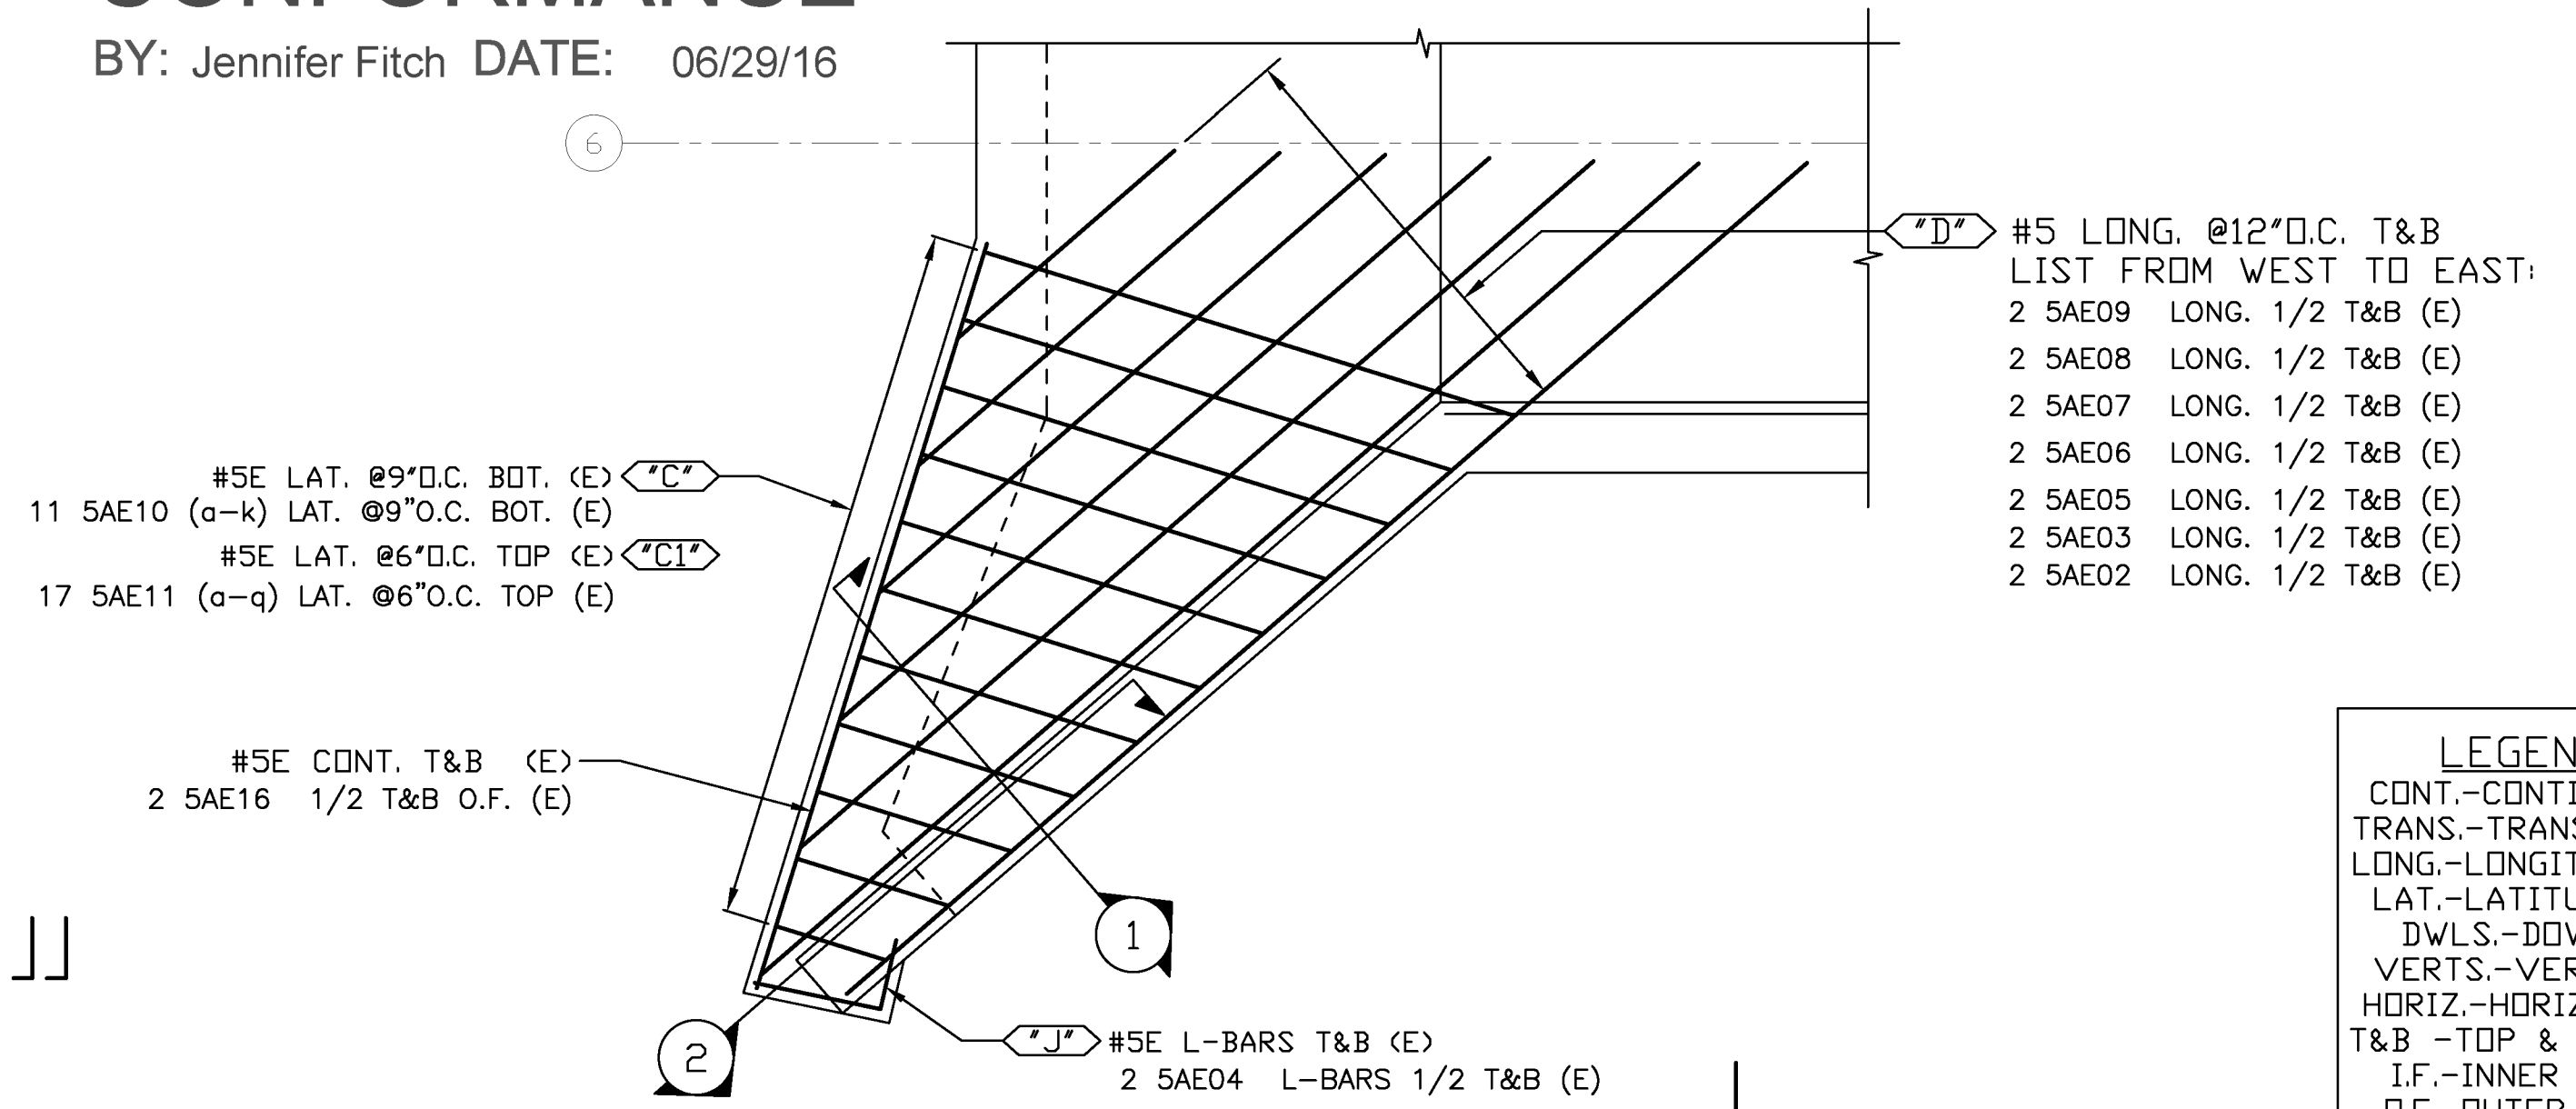

DETAIL 2 - CONT. & TRANS. REINF.
CONTRACT REF. SHEET 14


LEGEND:
CONT.-CONTINUOUS
TRANS.-TRANSVERSE
LONG.-LONGITUDINAL
LAT.-LATITUDINAL
DWLS.-DOWELS
VERTS.-VERTICAL
HORIZ.-HORIZONTAL
T&B -TOP & BOTTOM
I.F.-INNER FACE
O.F.-OUTER FACE
E.E.-EACH END
E.F.-EACH FACE
F.F.-FRONT FACE
R.F.-REAR FACE
E.W.-EACH WAY
O.C.-ON CENTER
L.W.-LONG WAY
S.W.-SHORT WAY

6			
5			
4			
3	6/29/16	Revised 5AE15	
2	6/21/16	REVISED AS NOTED/FOR APPROVAL	
1	6/13/16	FOR APPROVAL	
DATE	REV.#	SENT FOR	
DIMENSION			
DIMENSION FABRICATORS INC.			
VTAOT BRATTLEBORO VF 2000(26)			
LOCATION	ELLIOT ST. OVER WHETSTONE BROOK BRATTLEBORO, VT		
ARCHITECT	N/A		
ENGINEER	CLD CONSULTING ENGINEERS		
CUSTOMER	RENAUD BROS., INC.		
DRAWN BY	STEPHEN B	DATE	5/13/16
DATE		DATE	5/13/16
OFF #		OFF #	9744
DRAWING COVERS		DRAWING #	
DECK REINFORCING DETAIL		B	

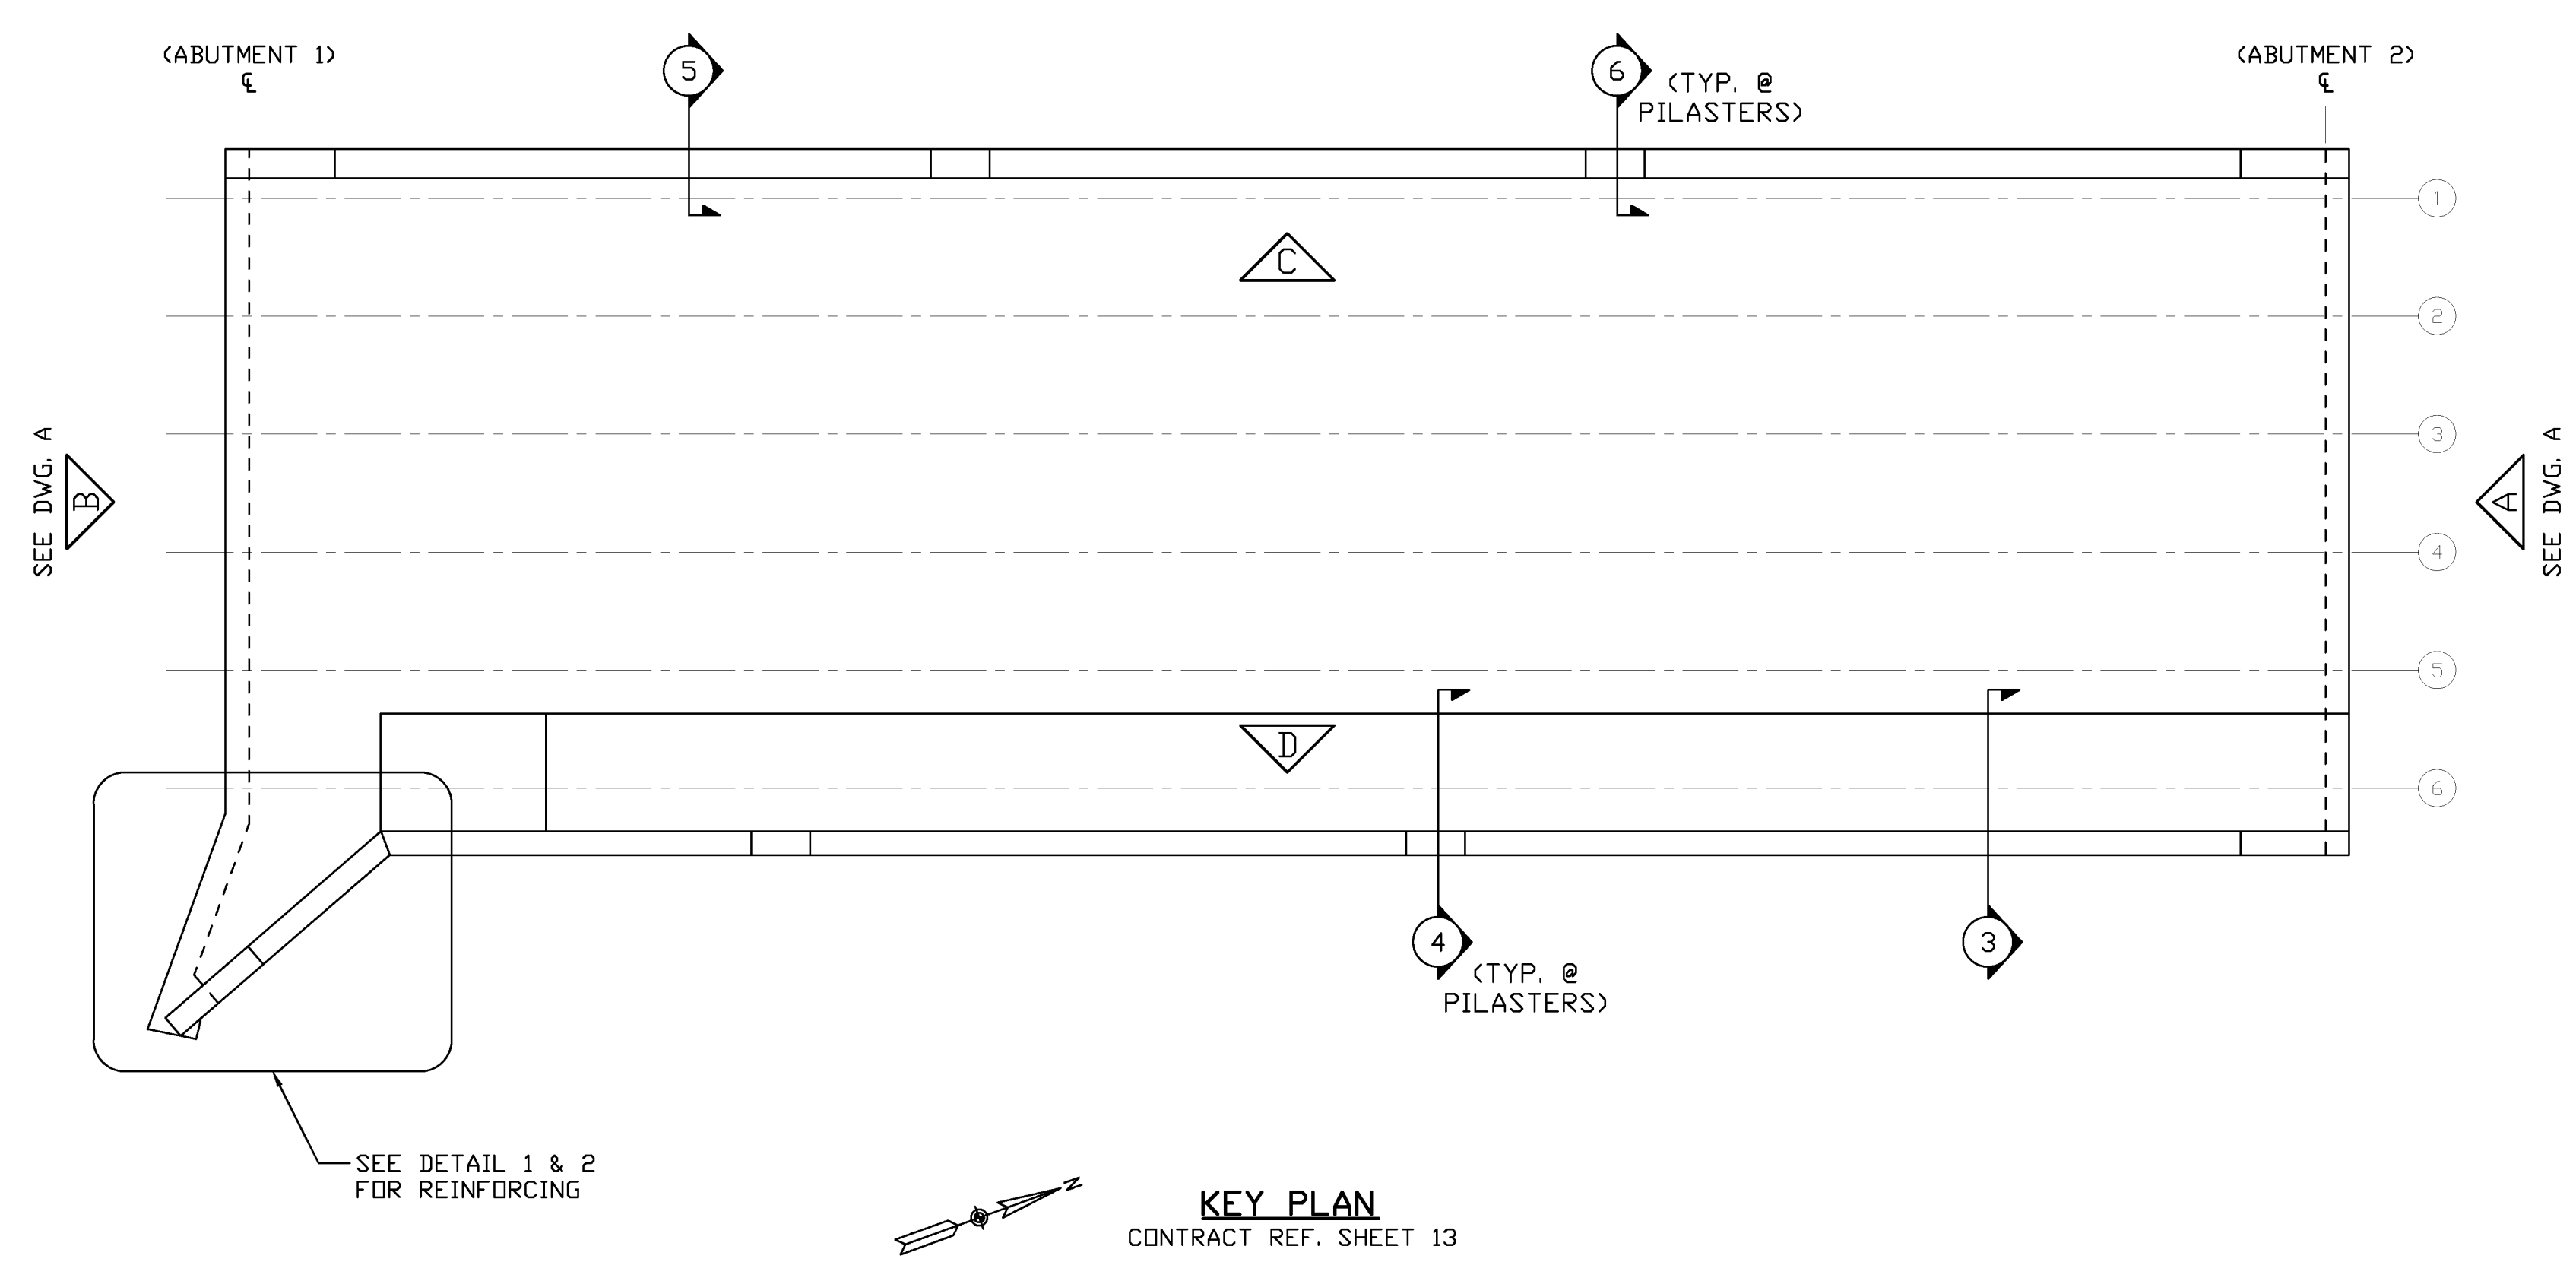

Release Number: _____ BAR LIST

Bar Mark	Qty	Size	Total Length	Type	'A'	'B'	'C'	'D'	'E'	'F'	'G'	'H'	'J'	'K'	'O'	'R'
5CE01	6	#5	6'-0"	3		3'-0"	3'-0"					1'-11 1/2"		2'-3 1/2"	5'-3 1/2"	
5CE02	6	#5	6'-9"			6'-9"										
5CE03	6	#5	23'-10"			23'-10"										
5CE04	40	#5	2'-0"			2'-0"										
5CE05	30	#5	24'-9"			24'-9"										
5CE06	40	#5	4'-2"			4'-2"										
5CE07	164	#5	4'-8"	17		2'-1"	0'-6"	2'-1"								
5CE08	32	#5	8'-10"	17		4'-2"	0'-6"	4'-2"								
5CE09	4	#5	5'-0"	T2	0'-6"	1'-0"	1'-0"	1'-0"	1'-0"		0'-6"					
5CE10	2	#5	5'-0"			5'-0"										

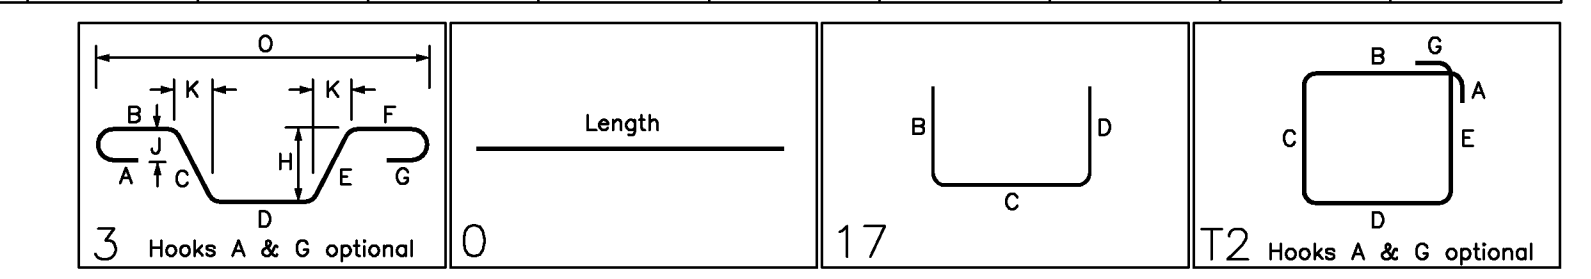

SHOP DRAWING REVIEW

REVIEWED AS REQUIRED BY THE CONSTRUCTION CONTRACT DOCUMENTS AND APPROVED, BUT ONLY FOR CONFORMANCE TO THE DESIGN CONCEPT OF THE WORK, AND SUBJECT TO FURTHER LIMITATIONS AND REQUIREMENTS CONTAINED IN THE CONSTRUCTION CONTRACT DOCUMENTS.

REJECTED REVISE AND RESUBMIT APPROVED AS NOTED

CORRECTIONS OR COMMENTS MADE ON THE SHOP DRAWINGS DURING THIS REVIEW DID NOT RELIEVE CONTRACTOR FROM COMPLIANCE WITH REQUIREMENTS OF THE DRAWINGS AND SPECIFICATIONS. THIS CHECK IS ONLY FOR REVIEW OF GENERAL CONFORMANCE WITH THE DESIGN CONCEPT OF THE PROJECT AND GENERAL COMPLIANCE WITH THE INFORMATION GIVEN IN THE CONTRACT DOCUMENTS. THE CONTRACTOR IS RESPONSIBLE FOR CONFIRMING AND CORRELATING ALL QUANTITIES AND DIMENSIONS, SELECTING FABRICATION PROCESSES AND TECHNIQUES OF CONSTRUCTION, COORDINATING THEIR WORK WITH THAT OF ALL OTHER TRADES, AND PERFORMING THEIR WORK IN A SAFE AND SATISFACTORY MANNER.

CLD Consulting Engineers
540 Commercial Street
Manchester, NH 03101
603-689-6223

Job Number: 150223
Reviewed by: SRB
Date: 06/30/2016

Vermont Agency of Transportation
RECEIVED
ON: June 29, 2016
and Checked for
CONFORMANCE
BY: Jennifer Fitch DATE: 06/29/16

ALL REINF. EPOXY

TEST BARS:
2 5CE10 #5 EPOXY COATED TEST BARS

LEGEND:
CONT.-CONTINUOUS
TRANS.-TRANSVERSE
LONG.-LONGITUDINAL
LAT.-LATITUDINAL
DWLS.-DOWELS
VERTS.-VERTICAL
HORIZ.-HORIZONTAL
T&B -TOP & BOTTOM
I.F.-INNER FACE
O.F.-OUTER FACE
E.E.-EACH END
E.F.-EACH FACE
F.F.-FRONT FACE
R.F.-REAR FACE
E.W.-EACH WAY
O.C.-ON CENTER
L.W.-LONG WAY
S.W.-SHORT WAY

FOR APPROVAL

ELEVATIONS & DIMENSIONS SHOWN ON THIS DWG. ARE FOR REINF. DETAILING PURPOSES ONLY AND ARE NOT INTENDED FOR DIMENSIONAL CONSTRUCTION.

EPOXY REINF. BARS ASTM A615 GRADE 60, MARKED (E)

VERIFICATION OF UNCLEAR INFORMATION MAY BE REQUESTED ON THIS DRAWING. SHOULD VERIFICATION BE LEFT UN-ADDRESSED IT WILL REMAIN AS SHOWN AND ASSUME TO BE CORRECT.

DATE	REV.	SENT FOR
6/27/16	1	REVISED AS NOTED/FOR APPROVAL
6/21/16	2	REVISED AS NOTED/FOR APPROVAL
6/13/16	1	FOR APPROVAL

DATE: 5/13/16 OFF # 9744

DIMENSION
DIMENSION FABRICATORS INC.
2000 7TH STREET
SCOTIA, N.Y. 12502
PH: (518) 374-1938
FAX: (518) 374-4830
www.dimensionfabricators.com

STRUCTURE: VTAOT BRATTLEBORO VF 2000(26)

LOCATION: ELLIOT ST. OVER WHETSTONE BROOK
BRATTLEBORO, VT

ARCHITECT: N/A

ENGINEER: CLD CONSULTING ENGINEERS

CUSTOMER: RENAUD BROS., INC.

DRAWING COVERS: DECK REINFORCING DETAIL

DRAWING # C

