

STATE OF VERMONT AGENCY OF TRANSPORTATION




PROPOSED IMPROVEMENT BRIDGE PROJECT


TOWN OF MIDDLEBURY
COUNTY OF ADDISON

MAIN ST (MINOR ARTERIAL), BRIDGE NO. 102 - MERCHANTS ROW (MAJOR COLLECTOR), BRIDGE NO. 2

RECORD PLANS	
CONTRACTOR:	KUBRICKY CONSTRUCTION CORP. - GLENS FALLS, NY
RESIDENT ENGINEER:	TIM POCKETTE
CONSTRUCTION BEGAN:	JUNE 02, 2017
CONSTRUCTION COMPLETE:	SEPTEMBER 08, 2017
RECORD PLANS BY:	TIM POCKETTE & AARON WEAVER
I HEREBY CERTIFY THAT ALL THE CONSTRUCTION REQUIRED BY THIS SET OF DRAWINGS HAS BEEN ACCOMPLISHED AS INDICATED HEREIN.	
BY:	RESIDENT ENGINEER
DATE:	06-29-2018
NOTE: Any further information concerning final quantities, amounts or other details relative to this project may be found at Central Files in the electronic archives.	

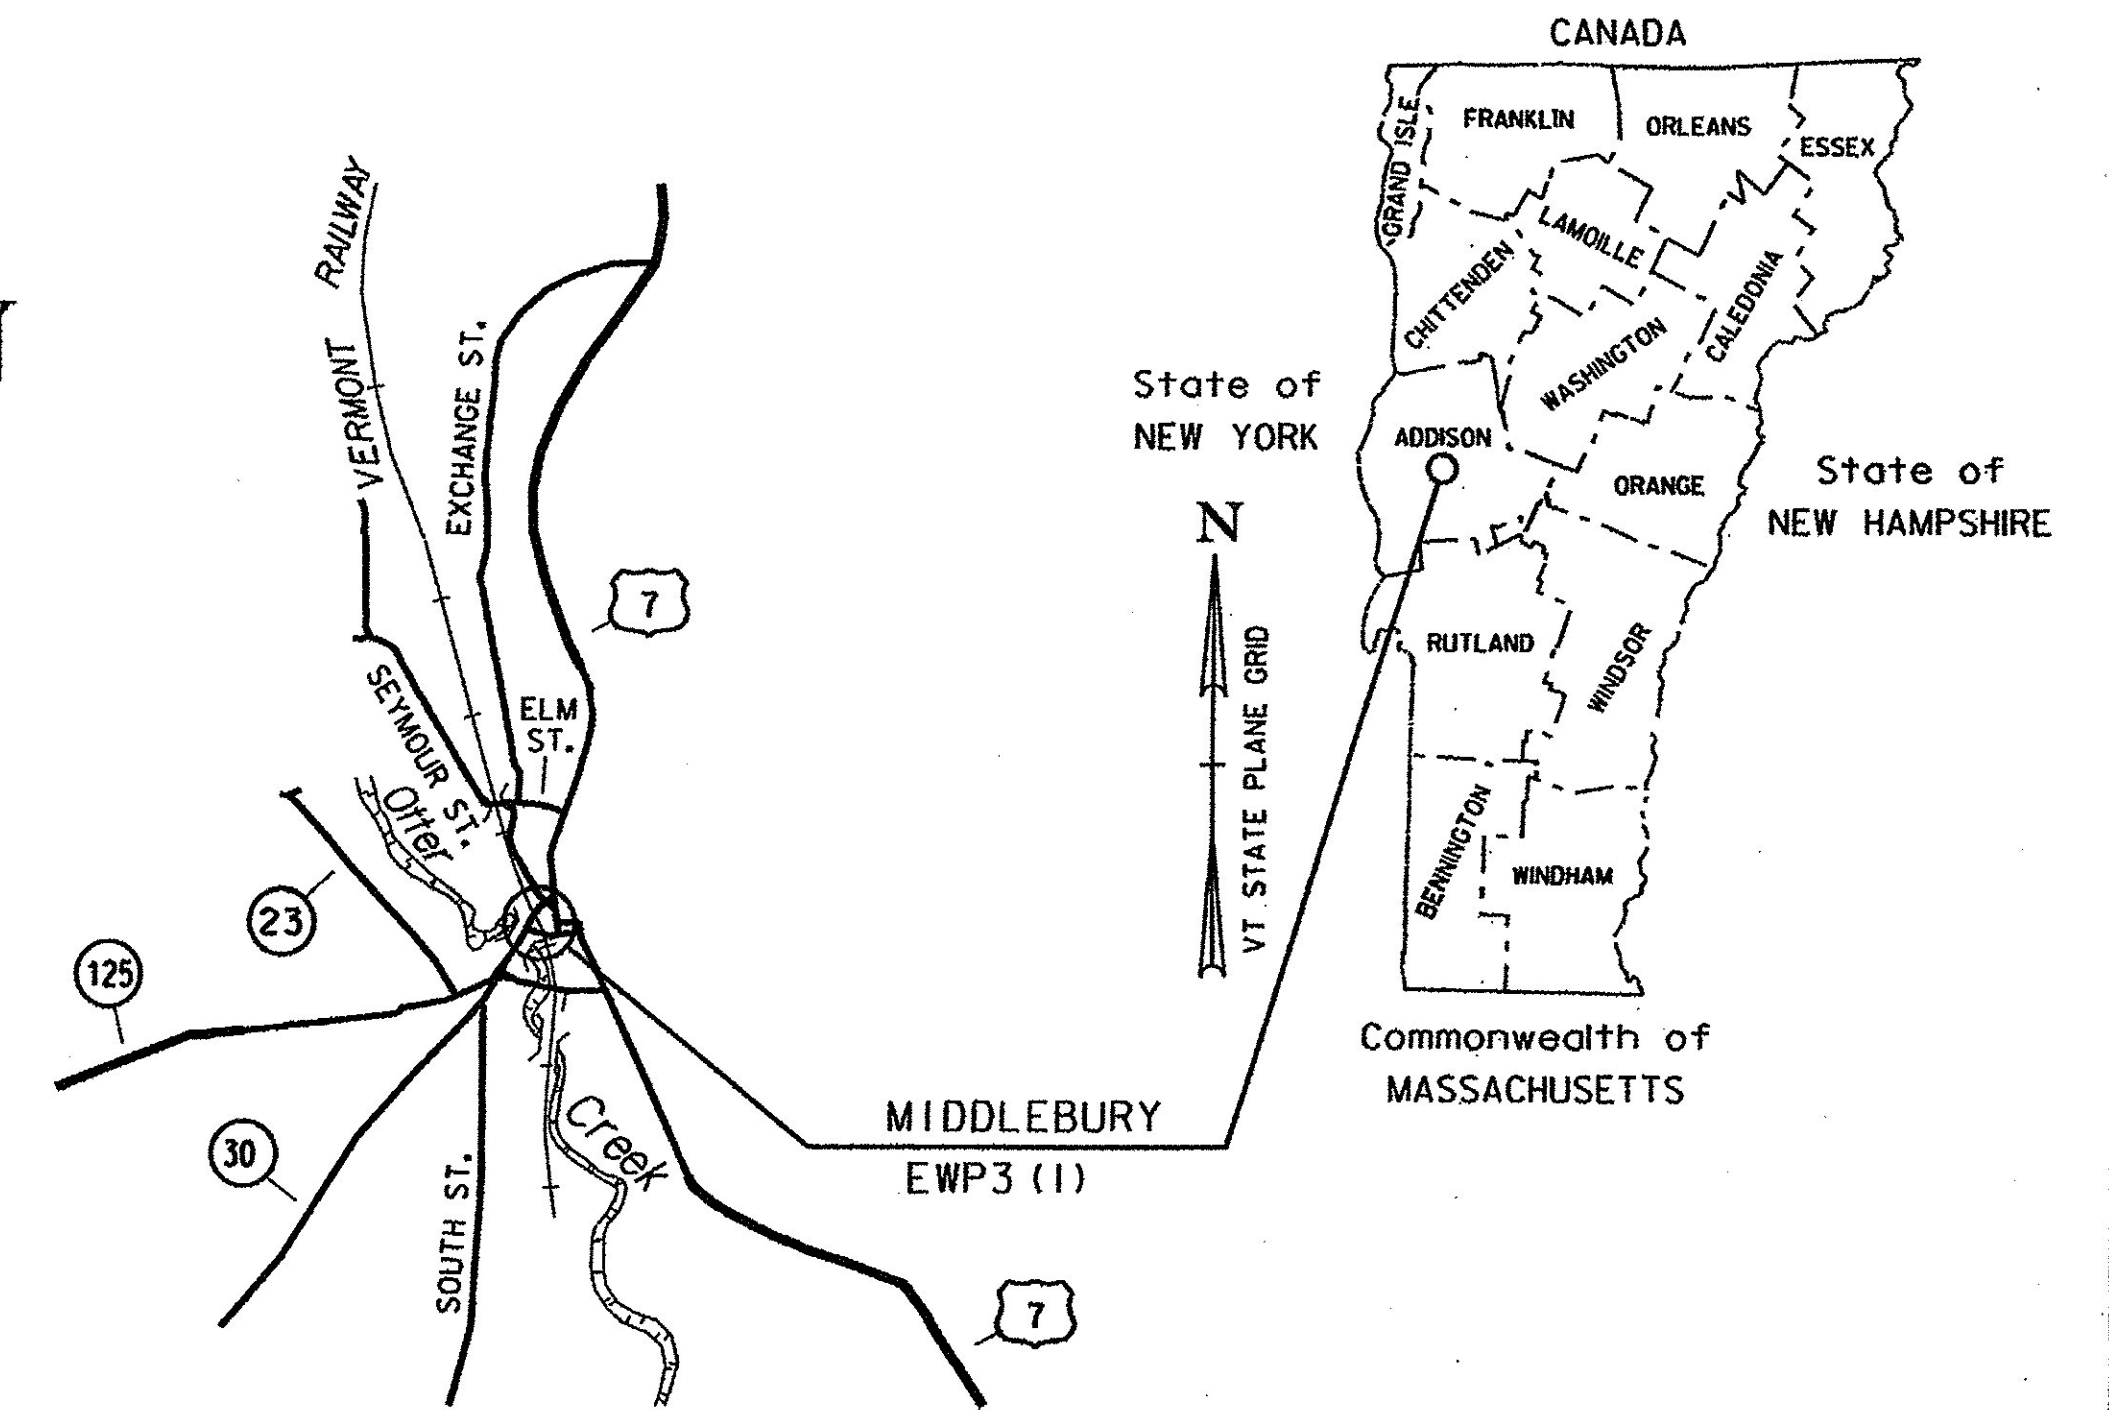


- PROJECT LOCATION:** LOCATED IN THE COUNTY OF ADDISON, TOWN OF MIDDLEBURY, ON MAIN STREET (TH 2); BRIDGE NO. 102 OVER VERMONT RAILWAY, APPROXIMATELY 400 FT SOUTHWEST OF THE INTERSECTION OF MAIN STREET AND US ROUTE 7, AND ON MERCHANTS ROW (TH 8); BRIDGE NO. 2 OVER VERMONT RAILWAY, APPROXIMATELY 230 FT WEST OF THE INTERSECTION OF MERCHANTS ROW AND SOUTH PLEASANT STREET (TH 47).
- PROJECT DESCRIPTION:** WORK TO BE PERFORMED UNDER THIS PROJECT INCLUDES THE REMOVAL AND REPLACEMENT OF BRIDGE NO. 102 AND BRIDGE NO. 2 WITH TEMPORARY BRIDGES, CONSTRUCTION OF A PEDESTRIAN BRIDGE ALONG MAIN STREET, CONSTRUCTION OF APPROACH RETAINING WALLS, ROADWAY APPROACHES TO NEW BRIDGES, NEW SIDEWALK, NEW DRAINAGE, SIGNAGE, STRIPING, AND OTHER ROADWAY RELATED ITEMS.
- LENGTH OF PROJECT:** MAIN STREET (TH #2): 325.00 FT
MERCHANTS ROW (TH#8): 260.00 FT

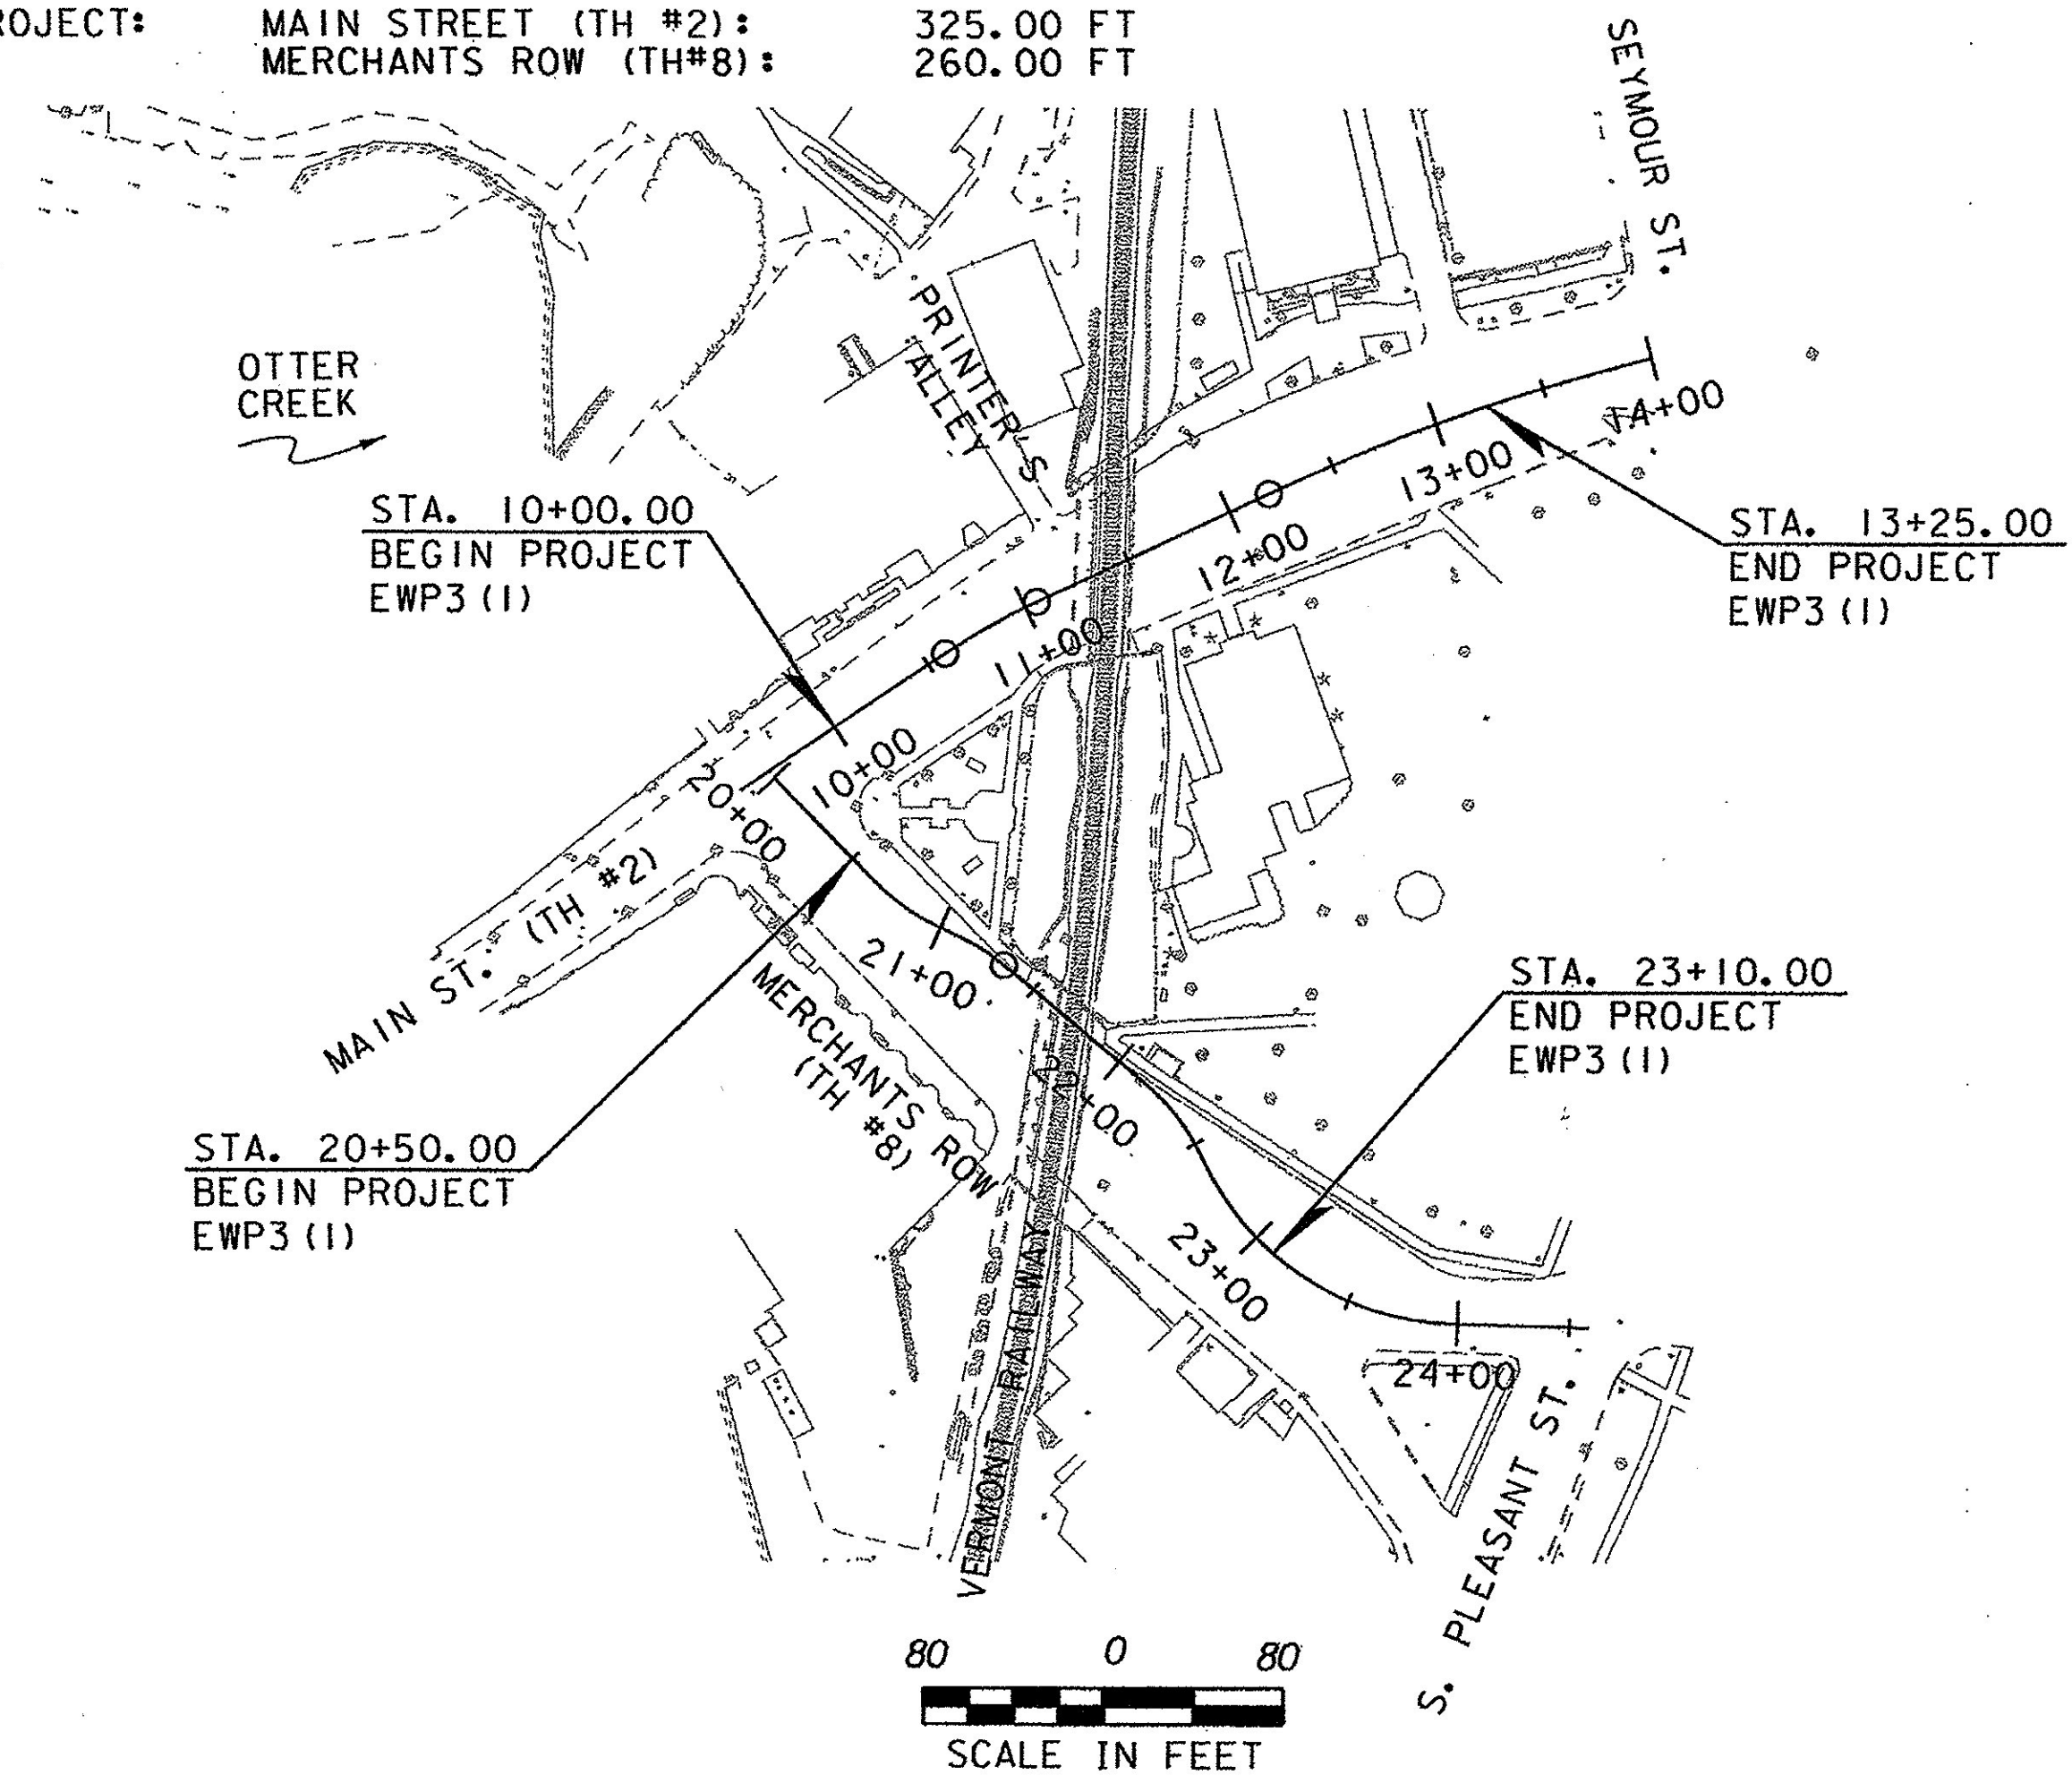

CONSTRUCTION IS TO BE CARRIED ON IN ACCORDANCE WITH THESE PLANS AND THE STANDARD SPECIFICATIONS FOR CONSTRUCTION DATED 2011, AS APPROVED BY THE FEDERAL HIGHWAY ADMINISTRATION ON JULY 20, 2011 FOR USE ON THIS PROJECT, INCLUDING ALL SUBSEQUENT REVISIONS AND SUCH REVISED SPECIFICATIONS AND SPECIAL PROVISIONS AS ARE INCORPORATED IN THESE PLANS.

QUALITY ASSURANCE PROGRAM : LEVEL I	
SURVEYED BY :	VHB
SURVEYED DATE :	MAY 2013
DATUM	
VERTICAL	NAVD 88
HORIZONTAL	NAD 83

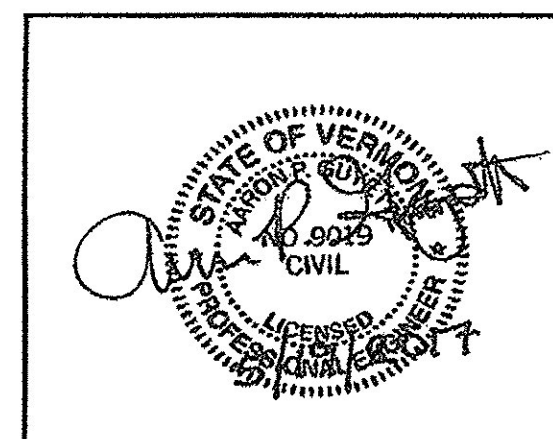

DEPARTMENT OF TRANSPORTATION FEDERAL HIGHWAY ADMINISTRATOR	
APPROVED	DATE May 25, 2017
DIRECTOR OF PROJECT DELIVERY	
APPROVED	DATE 5/22/17
PROJECT MANAGER : JOEL PERRIGO	
PROJECT NAME : MIDDLEBURY	
PROJECT NUMBER : EWP3 (1)	
SHEET 1 OF 54 SHEETS	