


TEMPORARY WATERMAIN PROFILE



NOTES:

- I. PROVIDE THRUST RESTRAINT/THRUST BLOCKS AT ALL PIPE BENDS, 22.5 DEGREE AND GREATER.

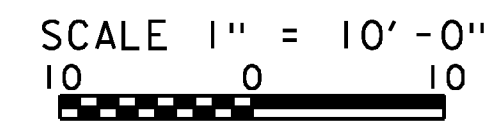

| | |
|--------------------------------------|--------------------------|
| PROJECT NAME: MIDDLEBURY | PLOT DATE: 5/19/2017 |
| PROJECT NUMBER: EWP3(1) | DRAWN BY: K.C. BARRY |
| FILE NAME: z17b016_WATERLINE PRO.dgn | CHECKED BY: A.P. GUYETTE |
| DESIGNED BY: R. MARVIN | WATERLINE PROFILE |
| | SHEET 23 OF 54 |