
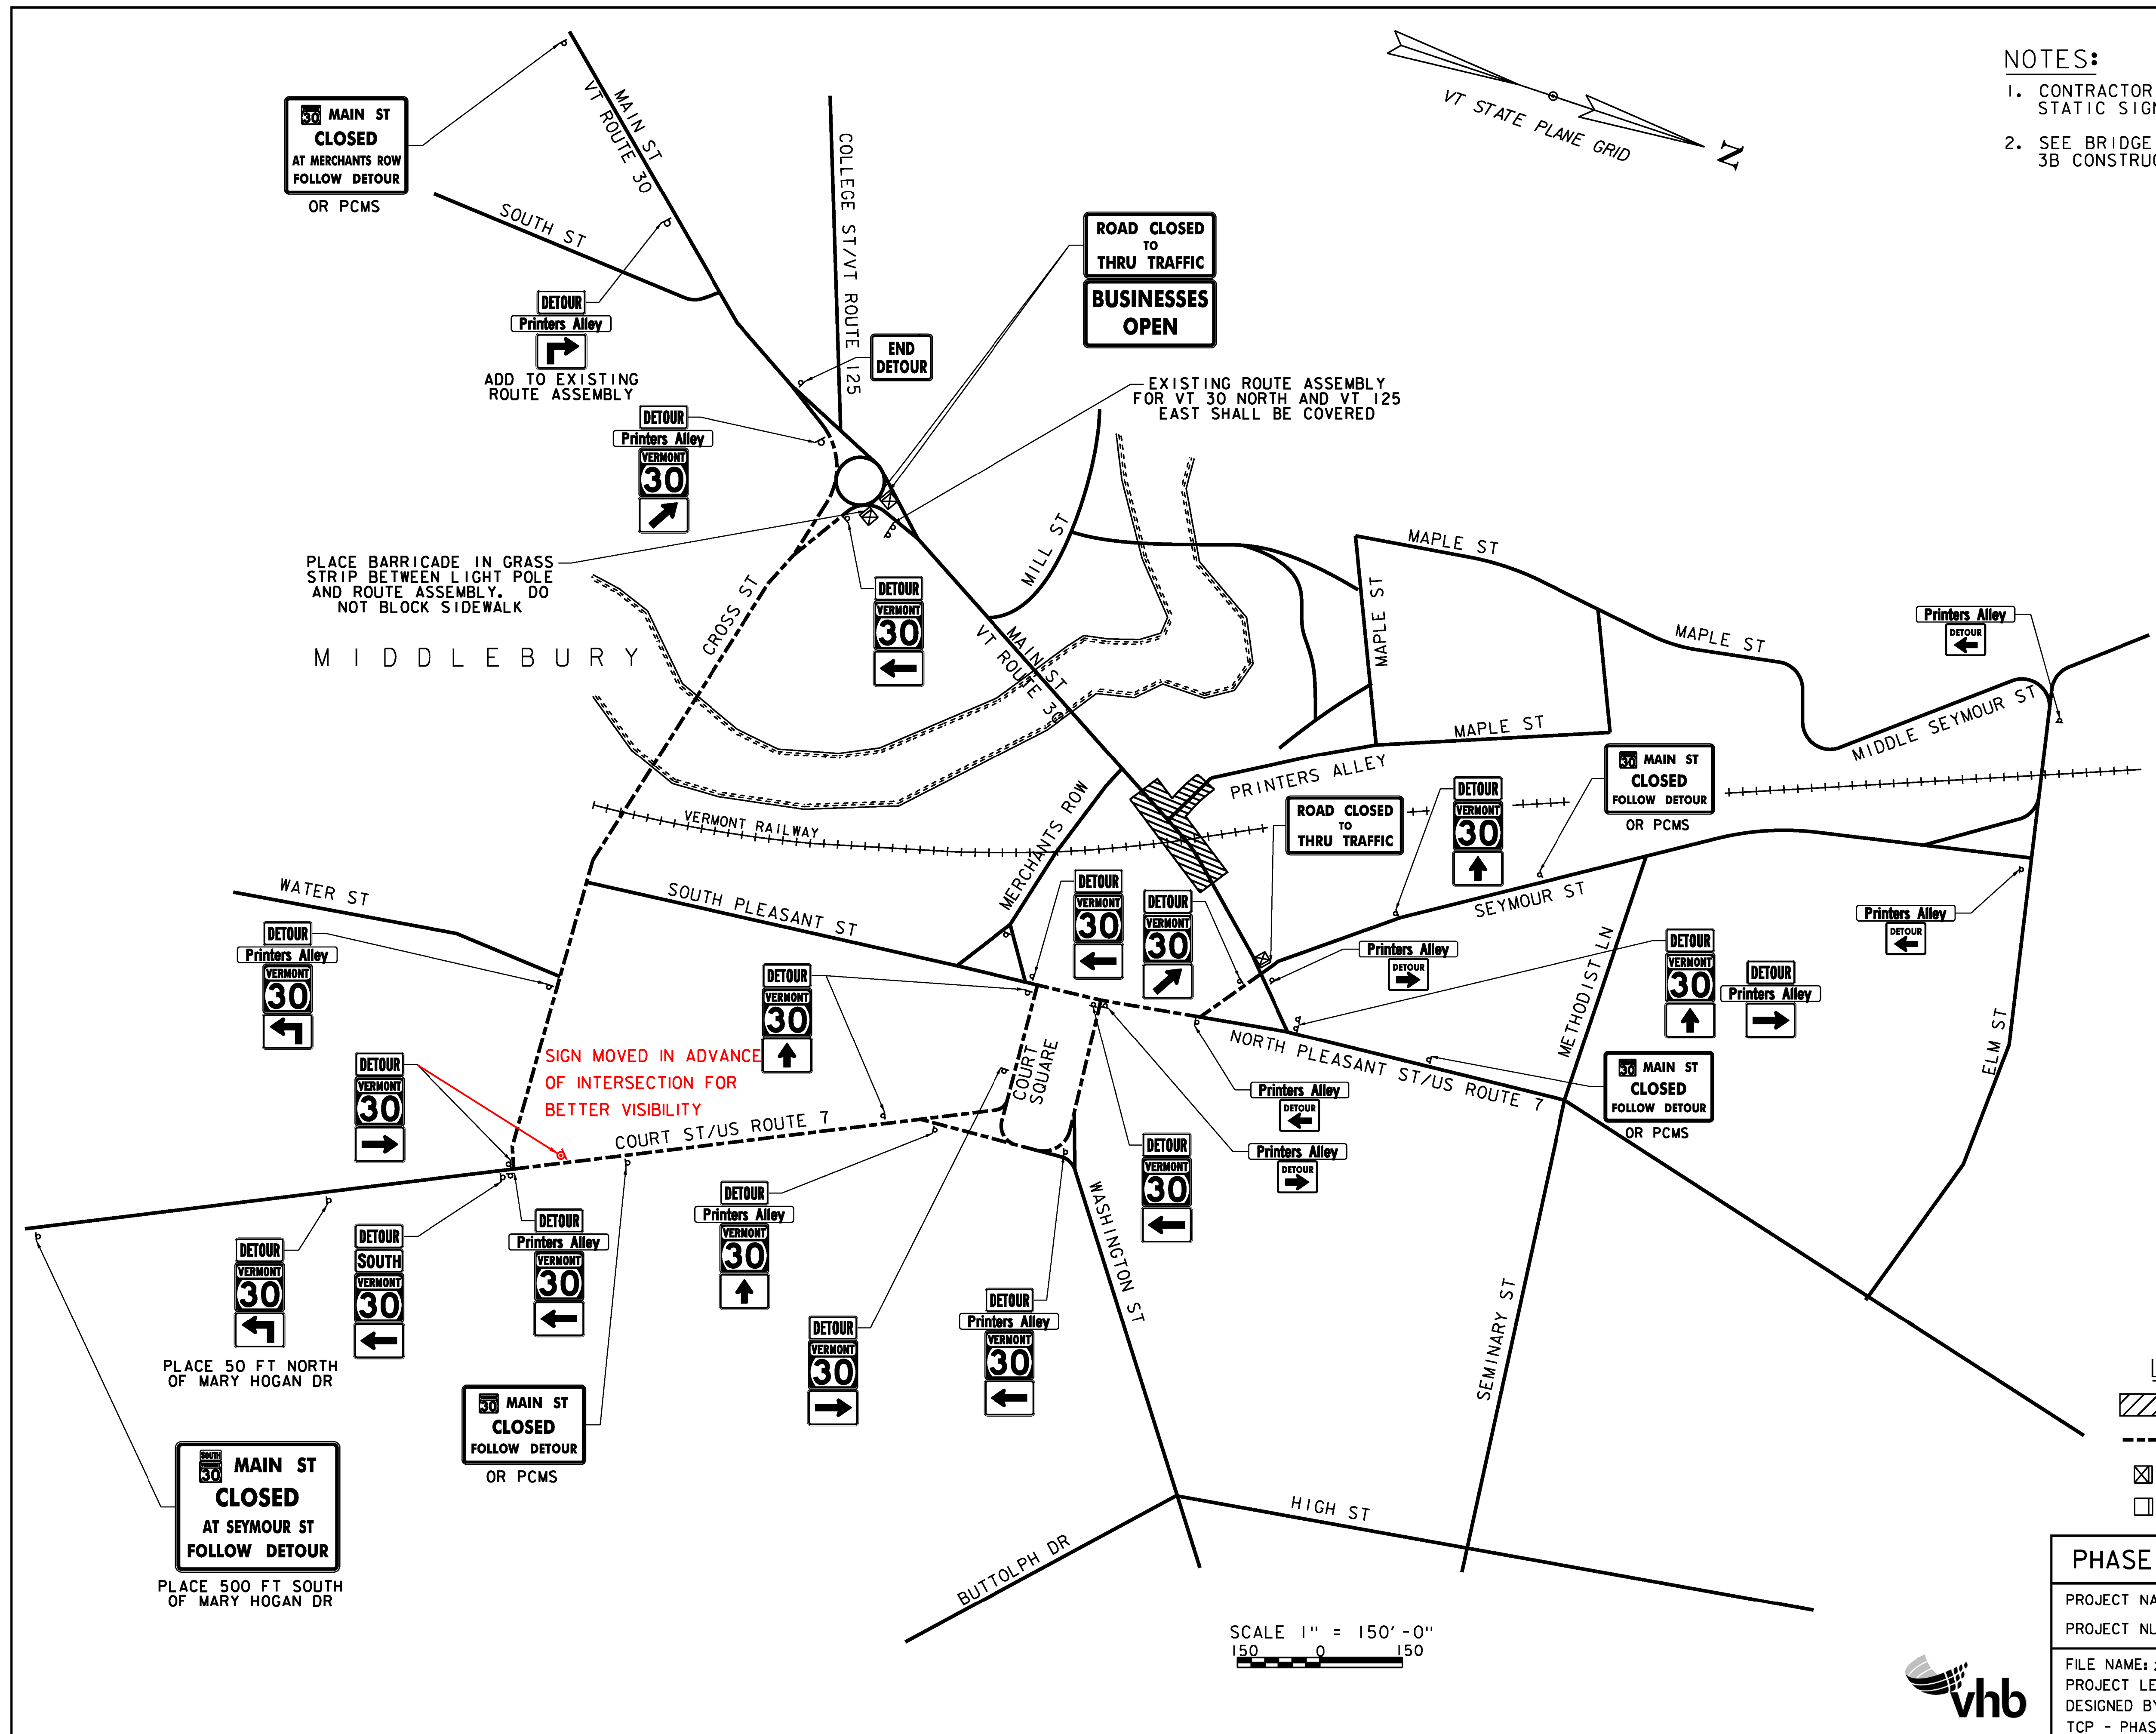


NOTES:

1. CONTRACTOR MAY ELECT TO USE PCMS IN PLACE OF STATIC SIGNS WHERE SHOWN.
2. SEE BRIDGE WORK ZONE PLANS FOR PHASE 3A AND PHASE 3B CONSTRUCTION AREA DETAILS.

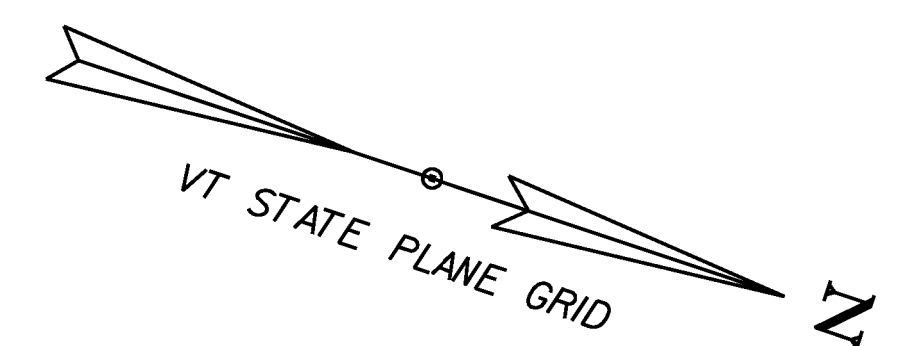

LEGEND

- CONSTRUCTION AREA
- DESIGNATED DETOUR ROUTE
- TYPE III (MOD) BARRICADE (WITH SIGN)
- TYPE III BARRICADE

PHASE 3 - MAIN STREET VEHICLE DETOUR

PROJECT NAME:	MIDDLEBURY
PROJECT NUMBER:	EWP3(I)
FILE NAME:	z17b016_TCP_3MainSt.dgn
PROJECT LEADER:	A.P. GUYETTE
DESIGNED BY:	D.M. PECK
TCP - PHASE 3 - MAIN ST VEHICLE DETOUR	SHEET 40 OF 54
PLOT DATE:	5/19/2017
DRAWN BY:	D.M. PECK
CHECKED BY:	E.P. DETRICK

SCALE 1" = 150'-0"
150 0 150

