
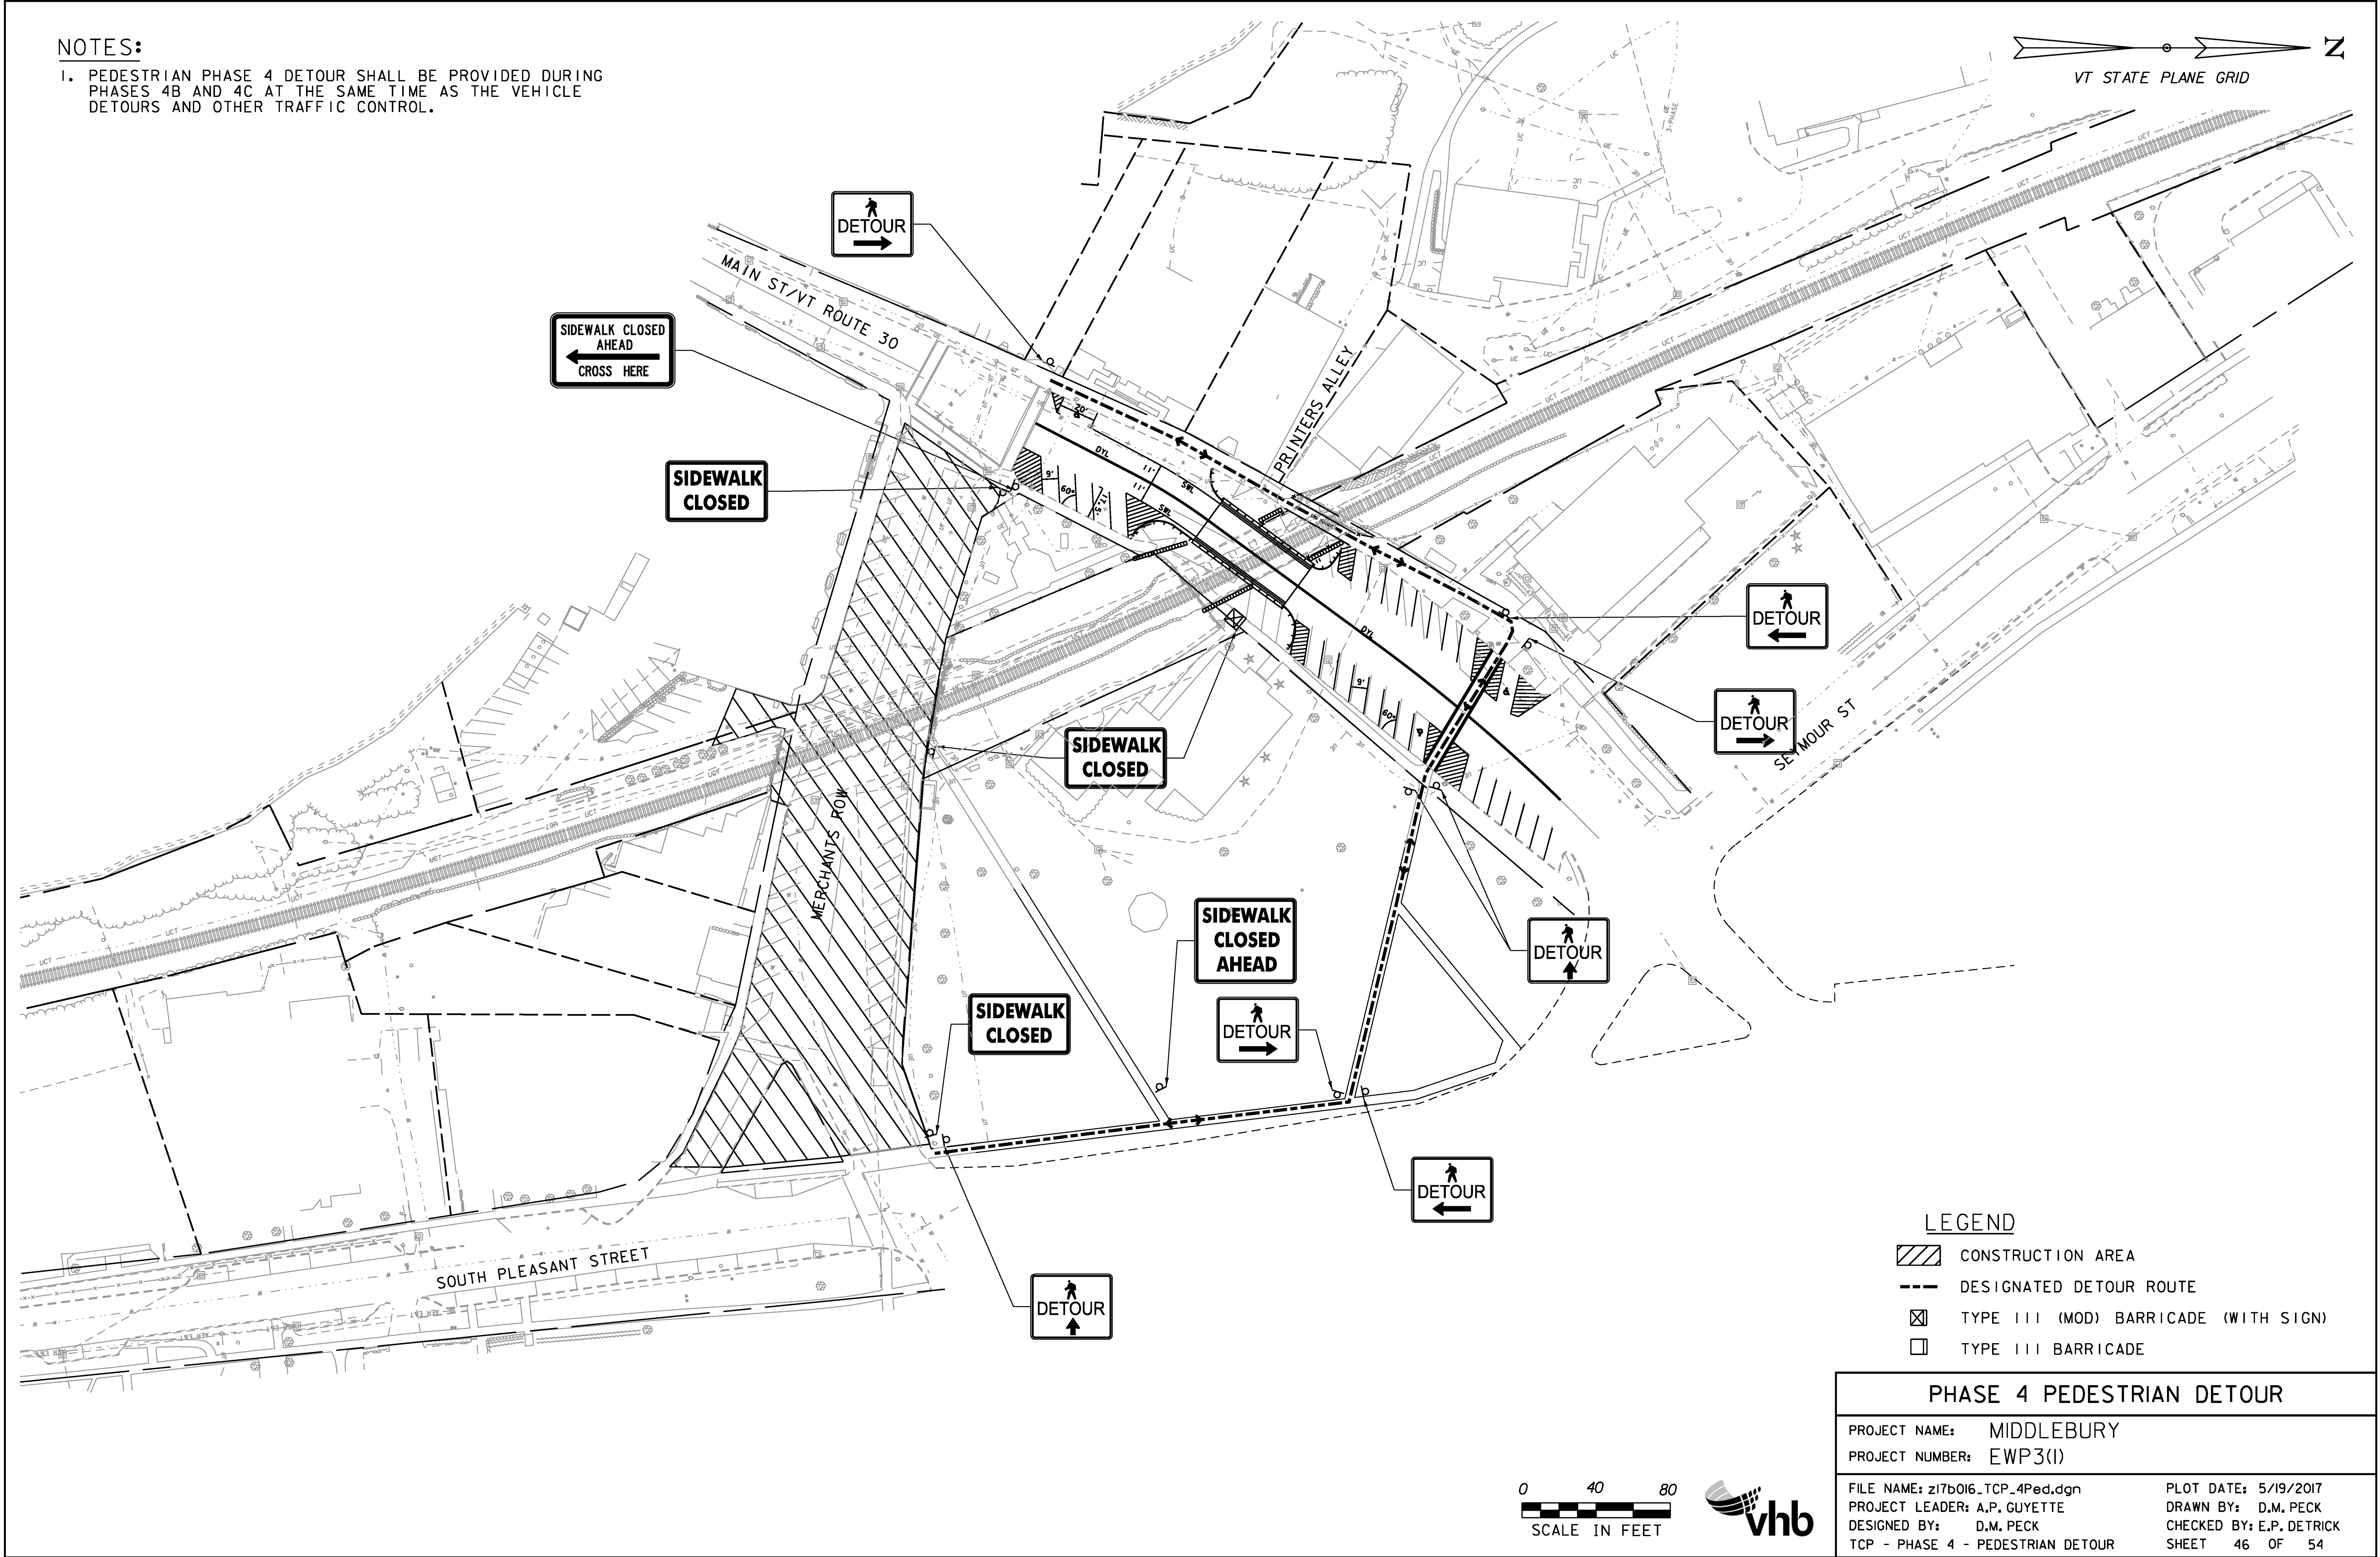


NOTES:

1. PEDESTRIAN PHASE 4 DETOUR SHALL BE PROVIDED DURING PHASES 4B AND 4C AT THE SAME TIME AS THE VEHICLE DETOURS AND OTHER TRAFFIC CONTROL.

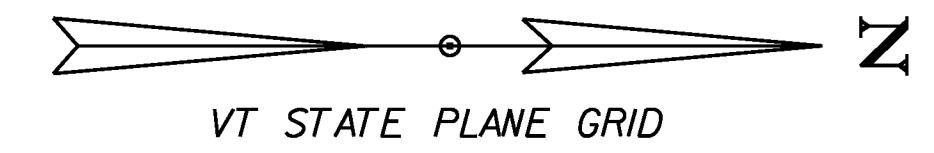

LEGEND

- CONSTRUCTION AREA
- DESIGNATED DETOUR ROUTE
- TYPE III (MOD) BARRICADE (WITH SIGN)
- TYPE III BARRICADE

PHASE 4 PEDESTRIAN DETOUR

PROJECT NAME:	MIDDLEBURY	PLOT DATE:	5/19/2017
PROJECT NUMBER:	EWP3(1)	DRAWN BY:	D.M. PECK
FILE NAME:	z17b016_TCP_4Ped.dgn	CHECKED BY:	E.P. DETRICK
PROJECT LEADER:	A.P. GUYETTE	TCP - PHASE 4 - PEDESTRIAN DETOUR	SHEET 46 OF 54

