




11+25

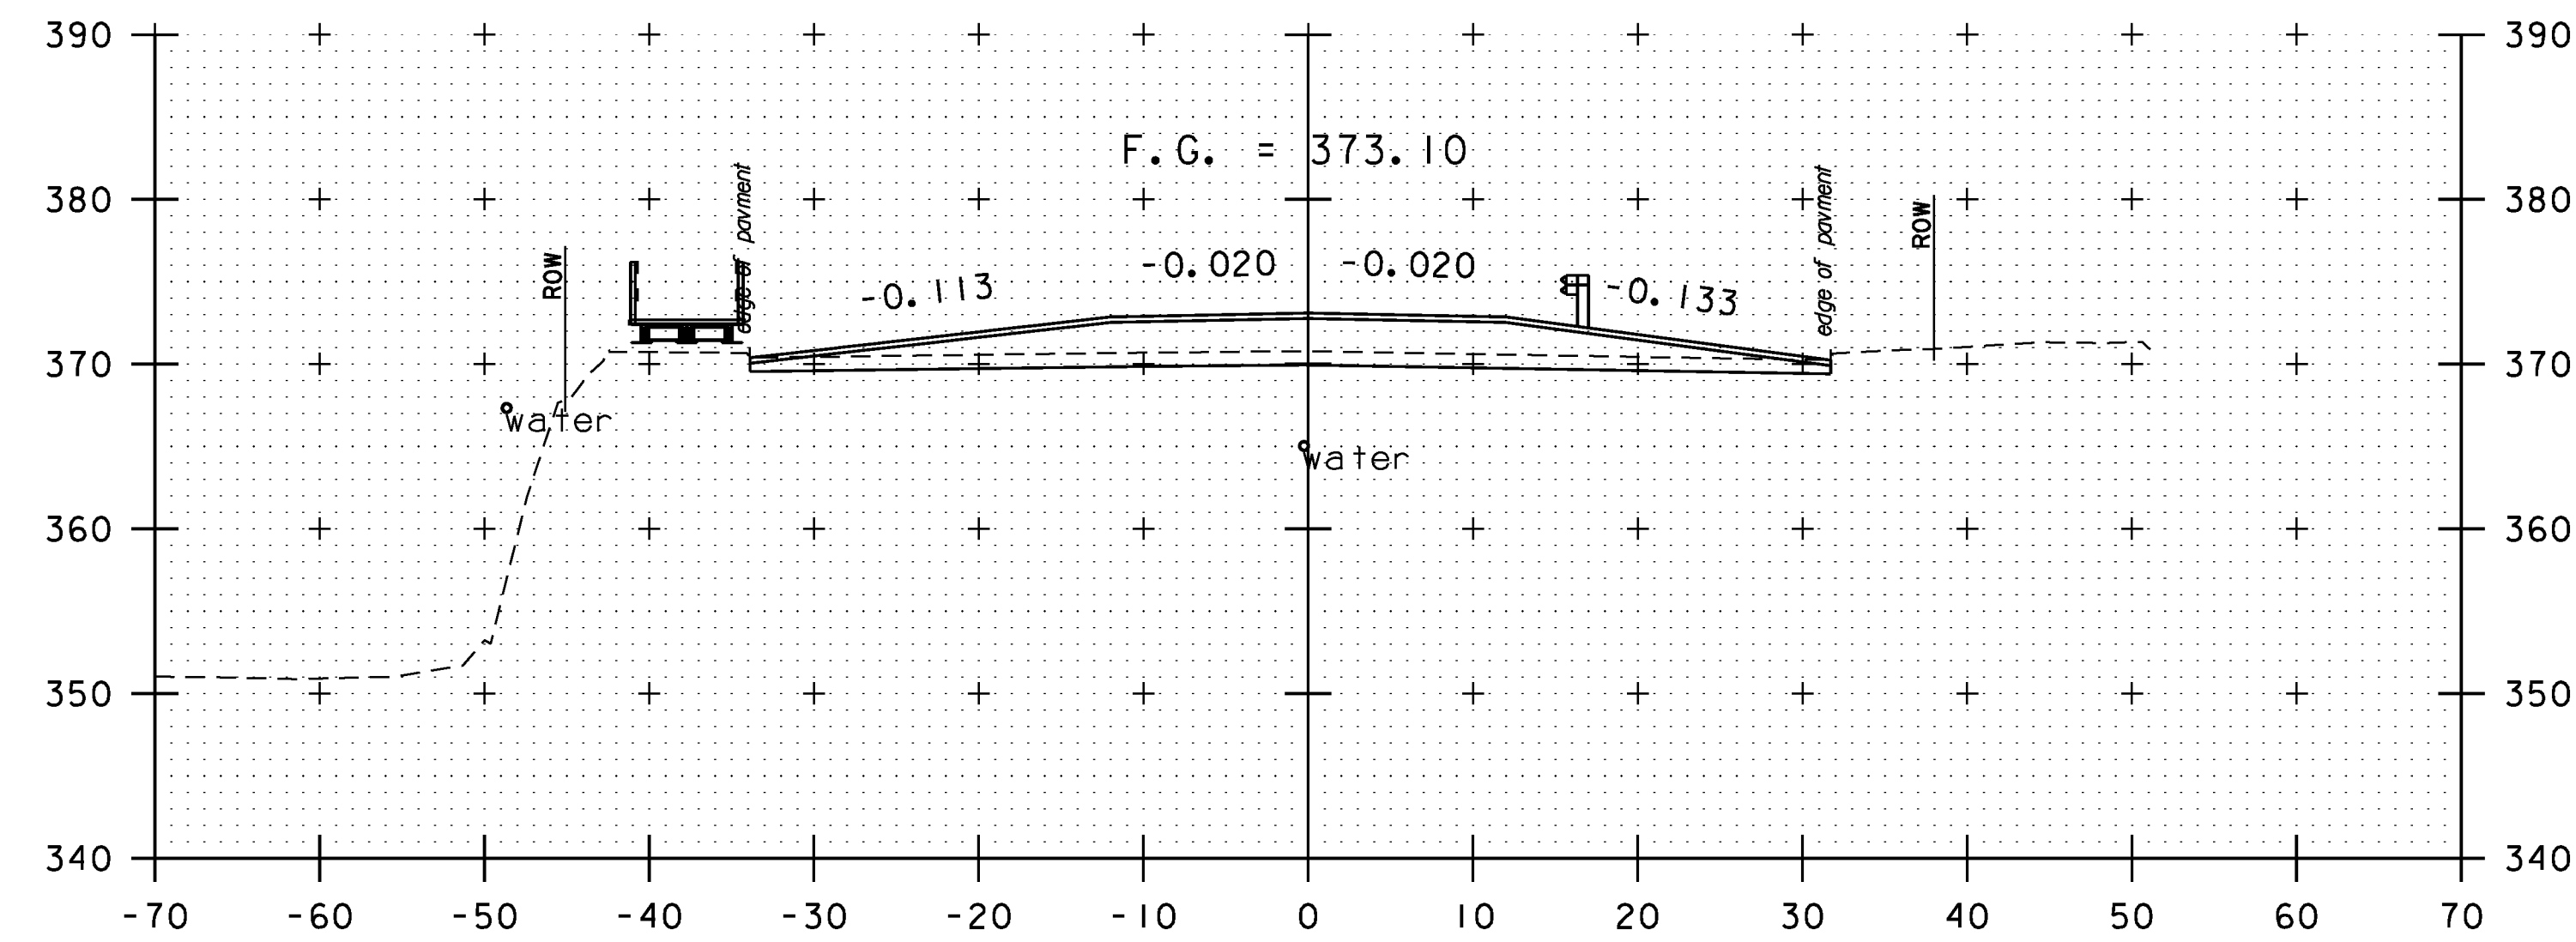

11+75

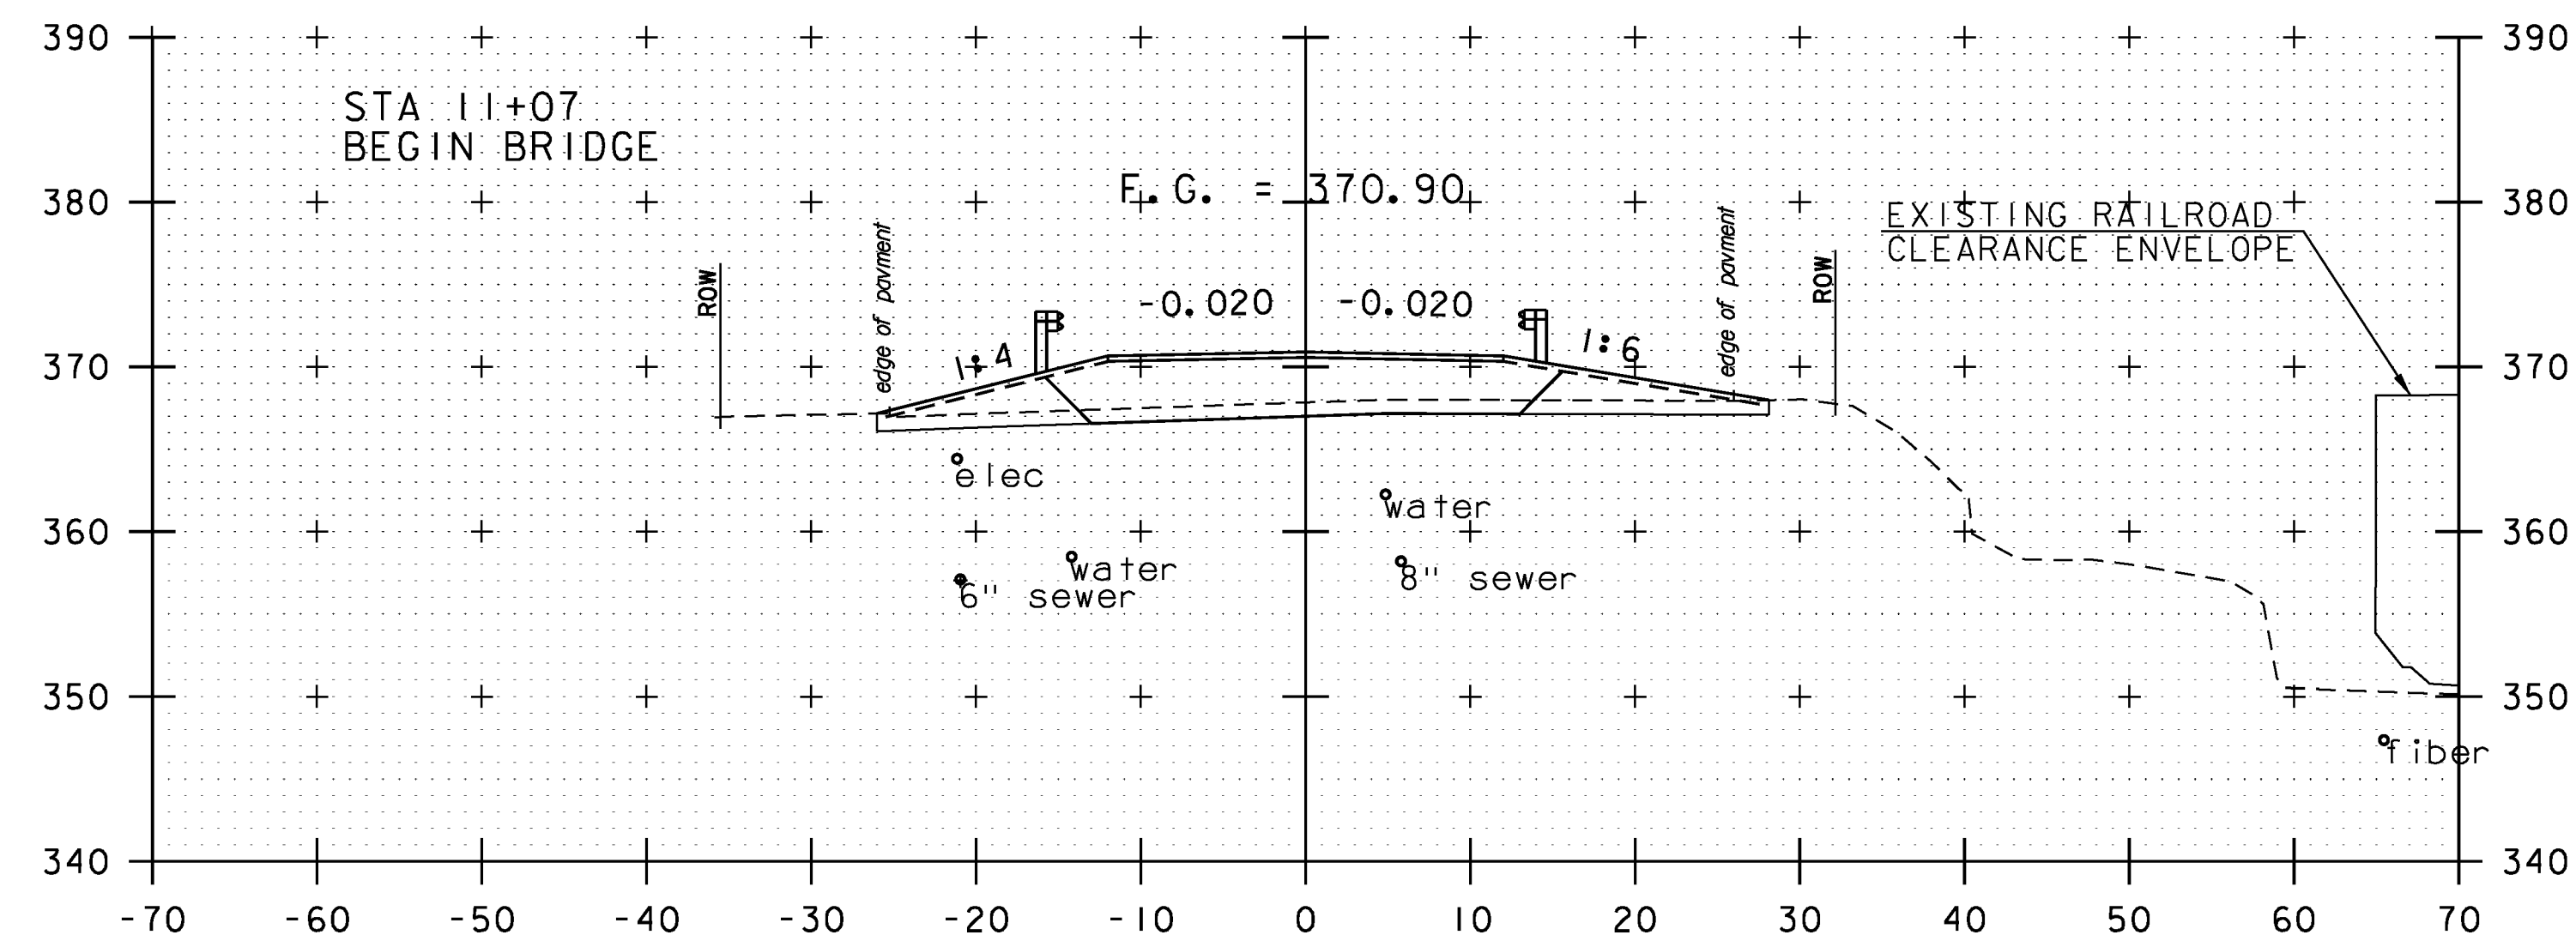

11+00

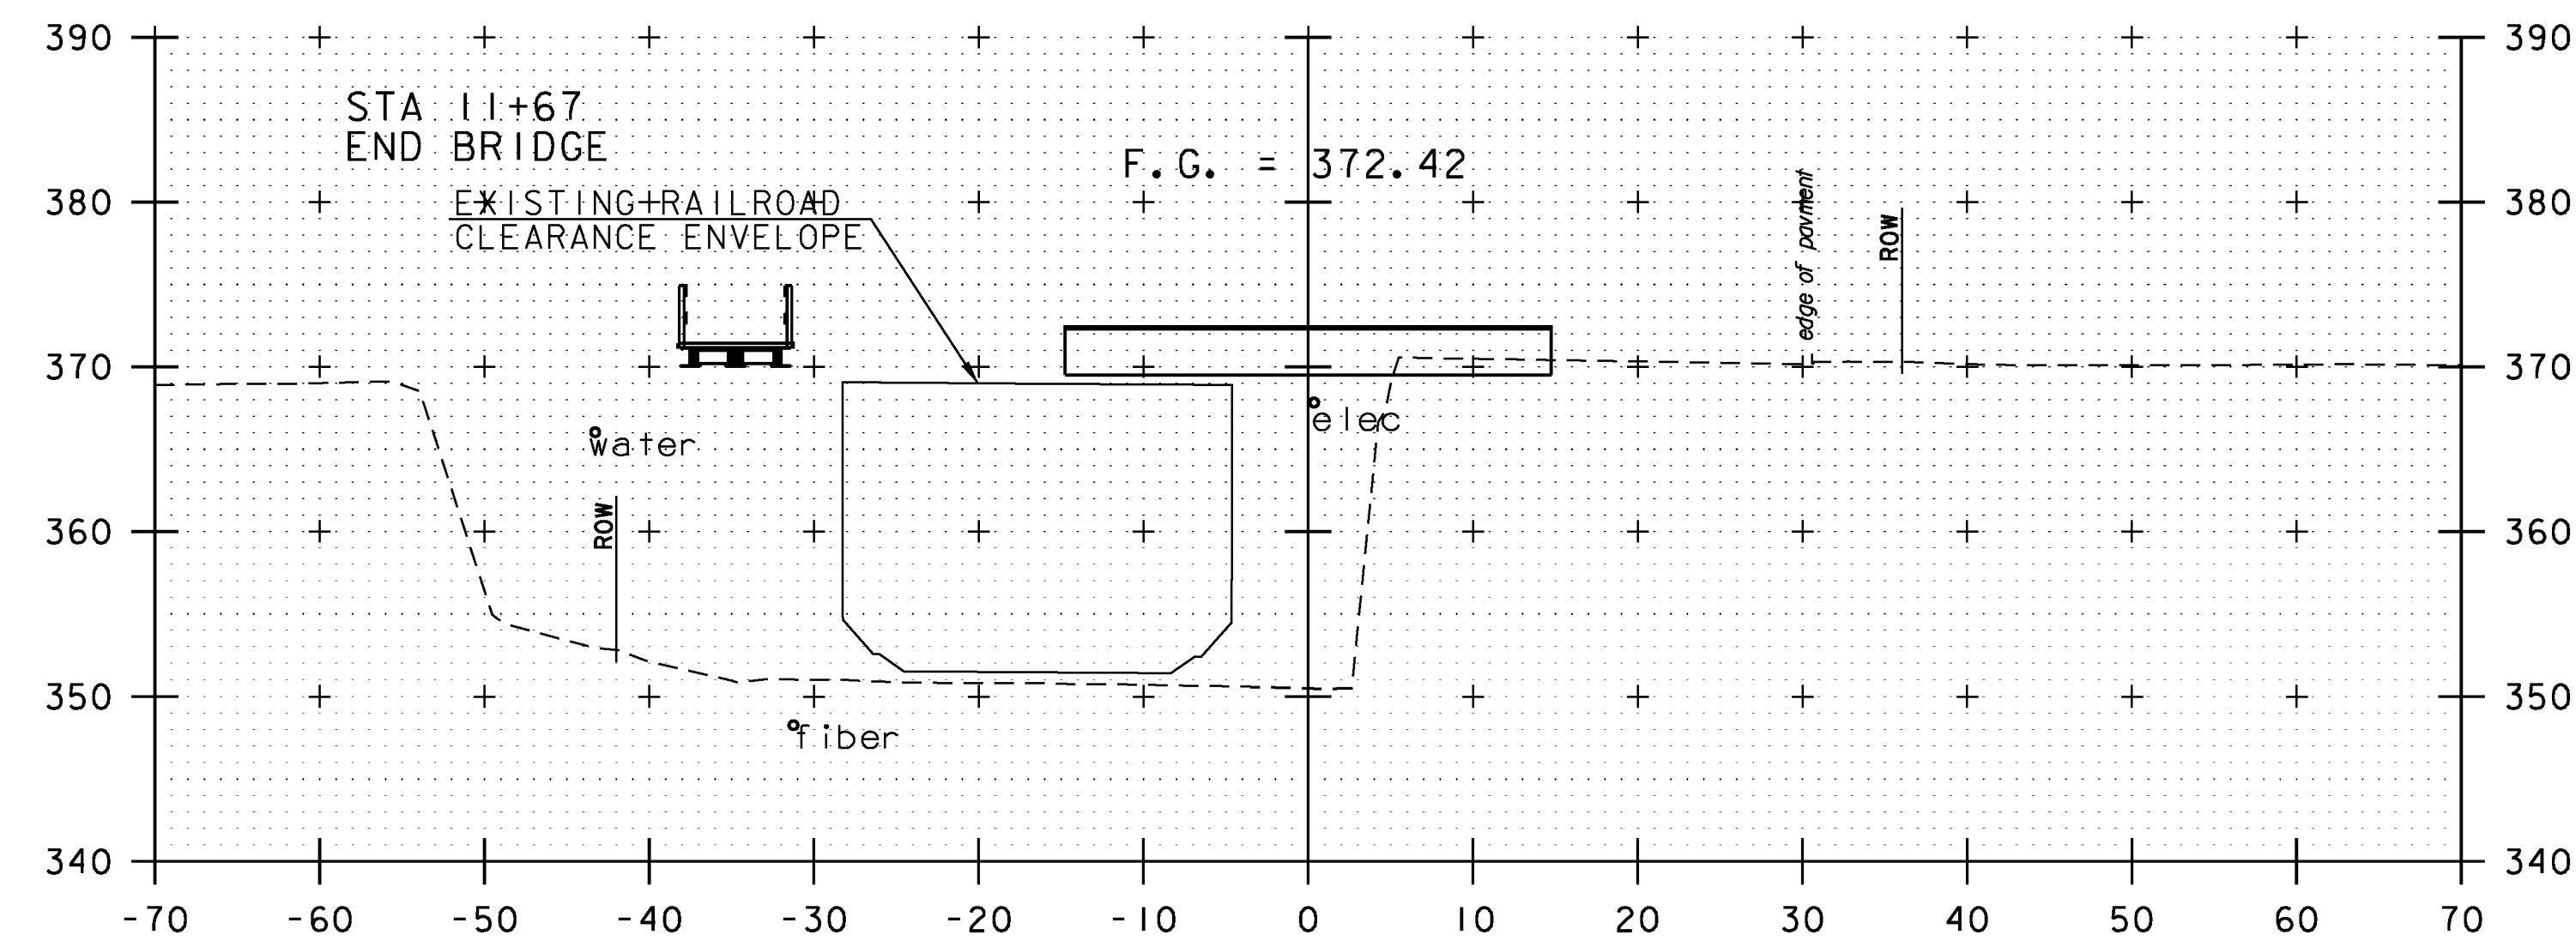

11+50

MAIN STREET

PROJECT NAME:	MIDDLEBURY	FILE NAME:	z17b016_MAIN XS.dgn	PLOT DATE:	5/19/2017
PROJECT NUMBER:	EWP3(I)	PROJECT LEADER:	A.P. GUYETTE	DRAWN BY:	B.M. ROBERTS
		DESIGNED BY:	B.M. ROBERTS	CHECKED BY:	E.P. DETRICK
		CROSS SECTION (SHEET 2 OF 7)			SHEET 49 OF 54

