



1 PLAN VIEW IN FORM
3/4" = 1'-0"

Space as necessary to avoid 3" dia corrugated steel pipe.

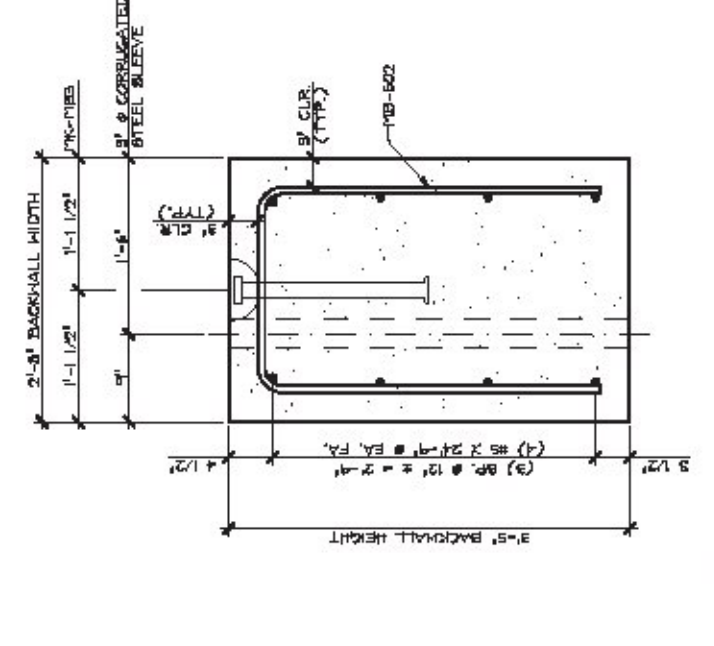

3 BACKWALL SECTION
1" = 1'-0"

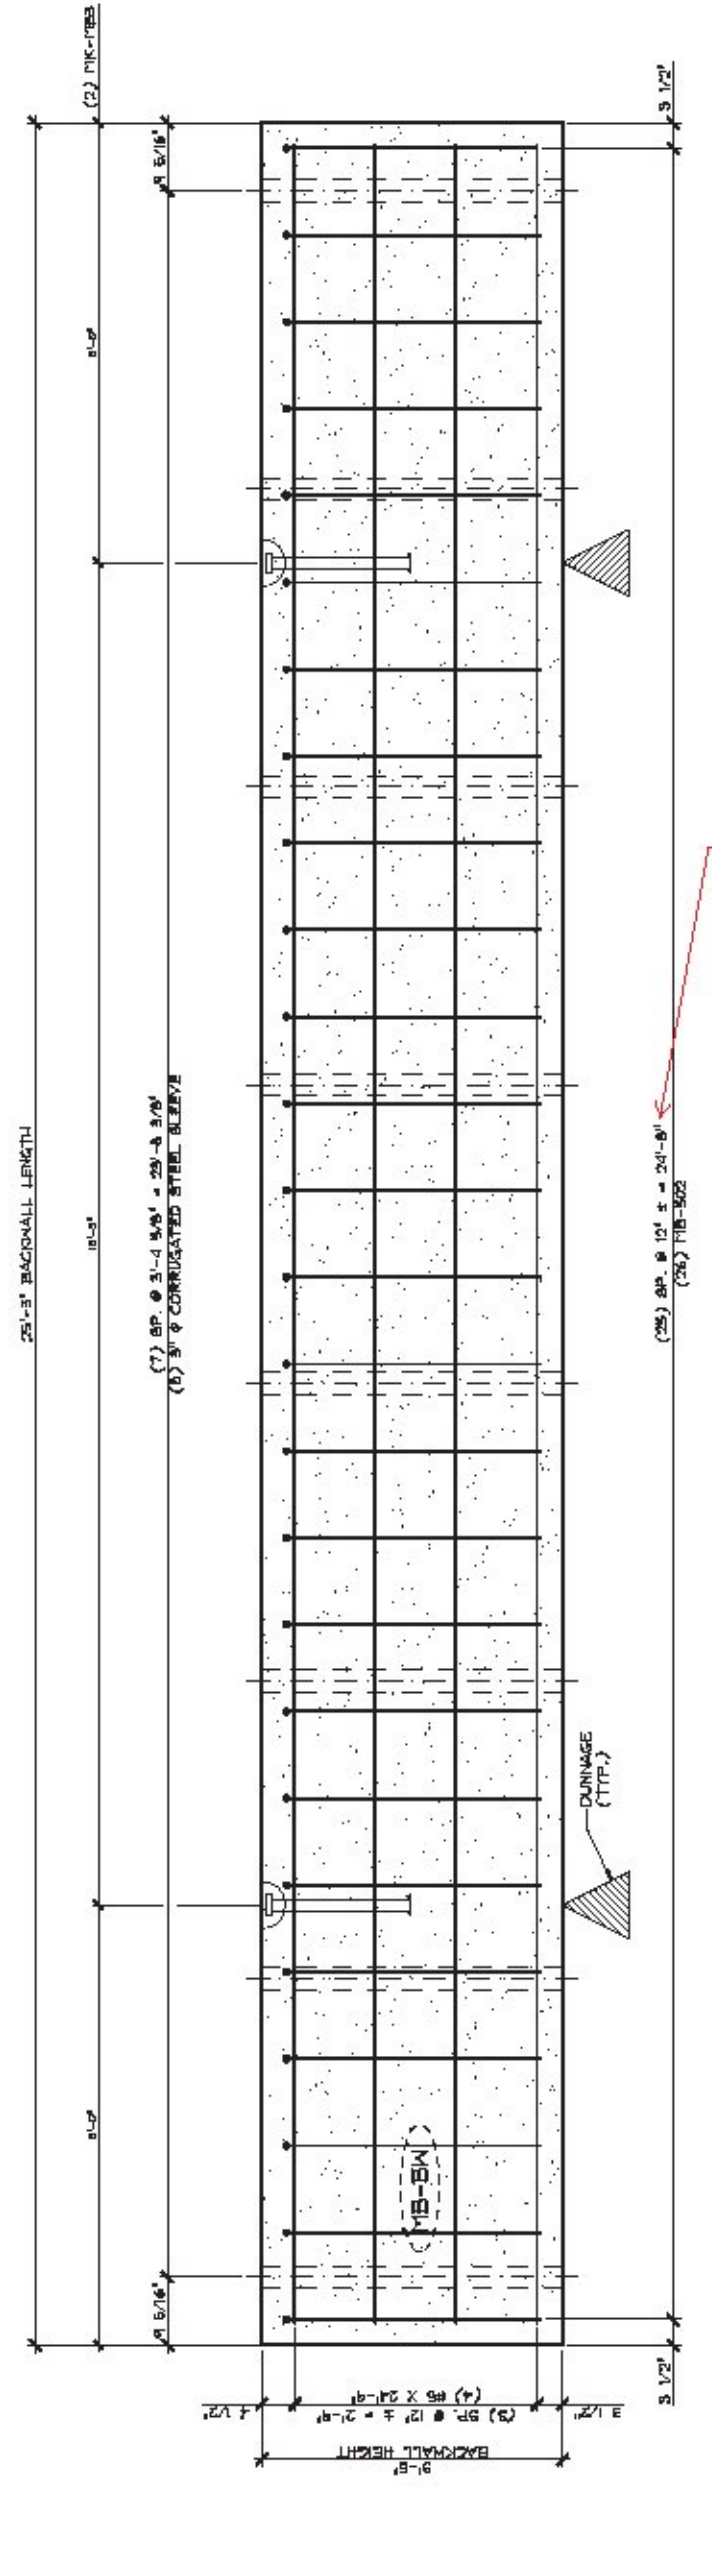

2 BACKWALL ELEVATION
3/4" = 1'-0"

Space as necessary to avoid 3" dia corrugated steel pipe.

- △ denotes form finish
- △ denotes smooth finish

SCALE NOTE:
SECTION HEIGHTS = 3'-00" MIN.
SECTION WIDTHS = 3'-00" MIN.
CHECK FOR INTERFERENCE

ITEM	QUANTITY	UNIT	DESCRIPTION	QTY.
1	1	EA	FORMWORK	1
2	1	EA	FORMWORK	1
3	1	EA	FORMWORK	1
4	1	EA	FORMWORK	1
5	1	EA	FORMWORK	1
6	1	EA	FORMWORK	1
7	1	EA	FORMWORK	1
8	1	EA	FORMWORK	1
9	1	EA	FORMWORK	1
10	1	EA	FORMWORK	1

APPROVAL STAMP

J.P. CARRARA & SONS INC.
Precast & Prestress Manufacturer
1000 S. 10th Street, Independence, Missouri 64050

KURBECKY CONSTRUCTION CORPORATION
1000 S. 10th Street, Independence, Missouri 64050

STATE OF VERMONT AGENCY OF TRANSPORTATION
COUNTY OF ADDISON

TOWN OF MIDDLEBURY
HIGHWAY PROJECT NO. 2017-001
PROJECT NO. 2017-001

DATE: MAY 23, 2017
SCALE: NOTED
JOB NO. 2017-001
DWG. NO. BW1