


CON. ROAD D.W. NO.	STATE	FED. AID PROJ. NO.	FISCAL YEAR	SHEET NO.	TOTAL SHEETS
8	VT.				

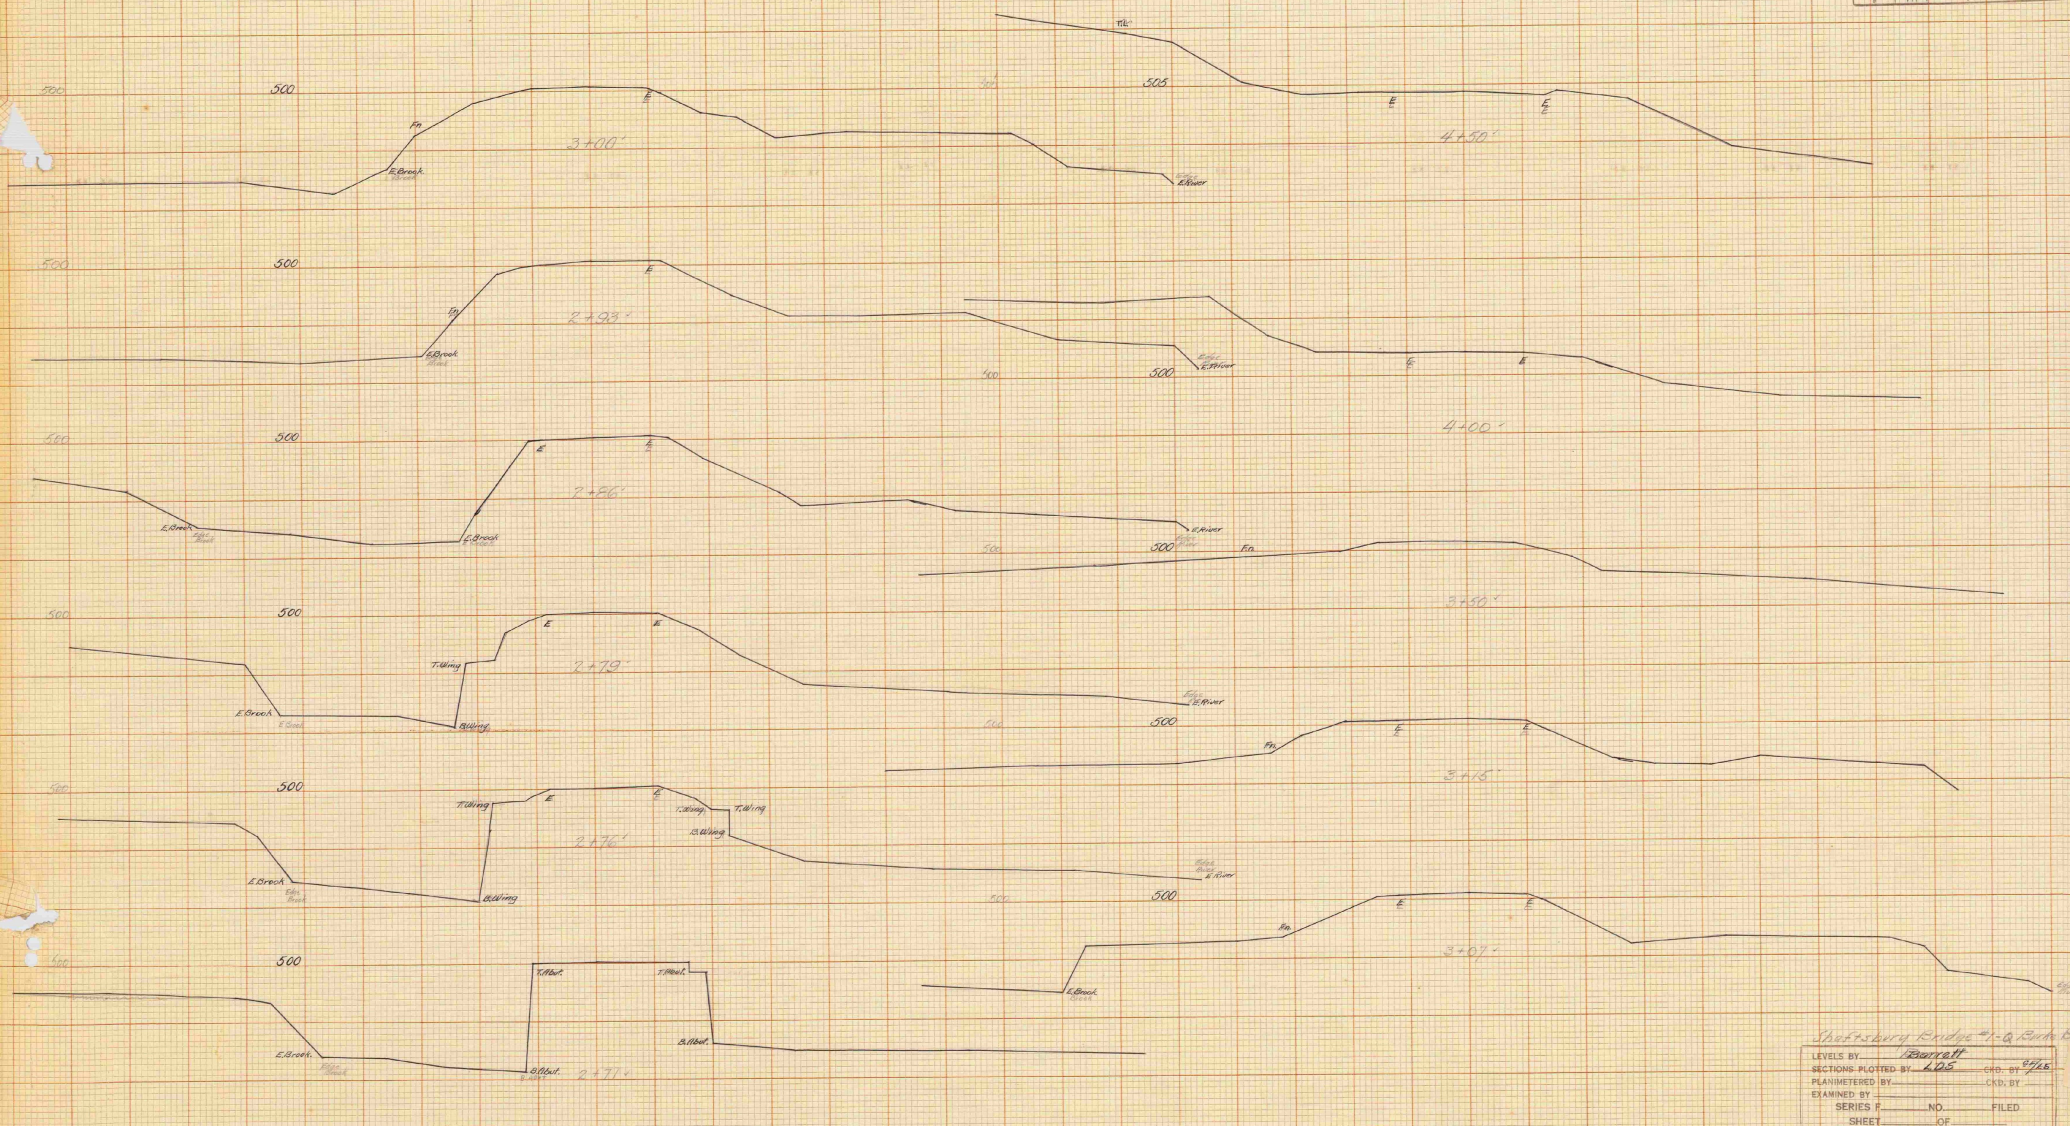

Shuttsbury Bridge 4-1-a Route 10
 LEVELS BY Barrett
 SECTIONS PLOTTED BY KDS CHD. BY gfl
 PLANIMETERED BY _____ CHD. BY _____
 EXAMINED BY _____
 SERIES F. NO. _____ FILED _____
 SHEET _____ OF _____

Bridge
1939

Shaftsbury
#1-Q 1939

Vermont Agency of
Transportation
Phase III- Interstate
#090303-01
INITIALS
Hanger 3703

1939