



9/30/53
7/11/54
Fogarty, Barn
PLAN
SCALE: AS SHOWN
DATE: 9/30/53

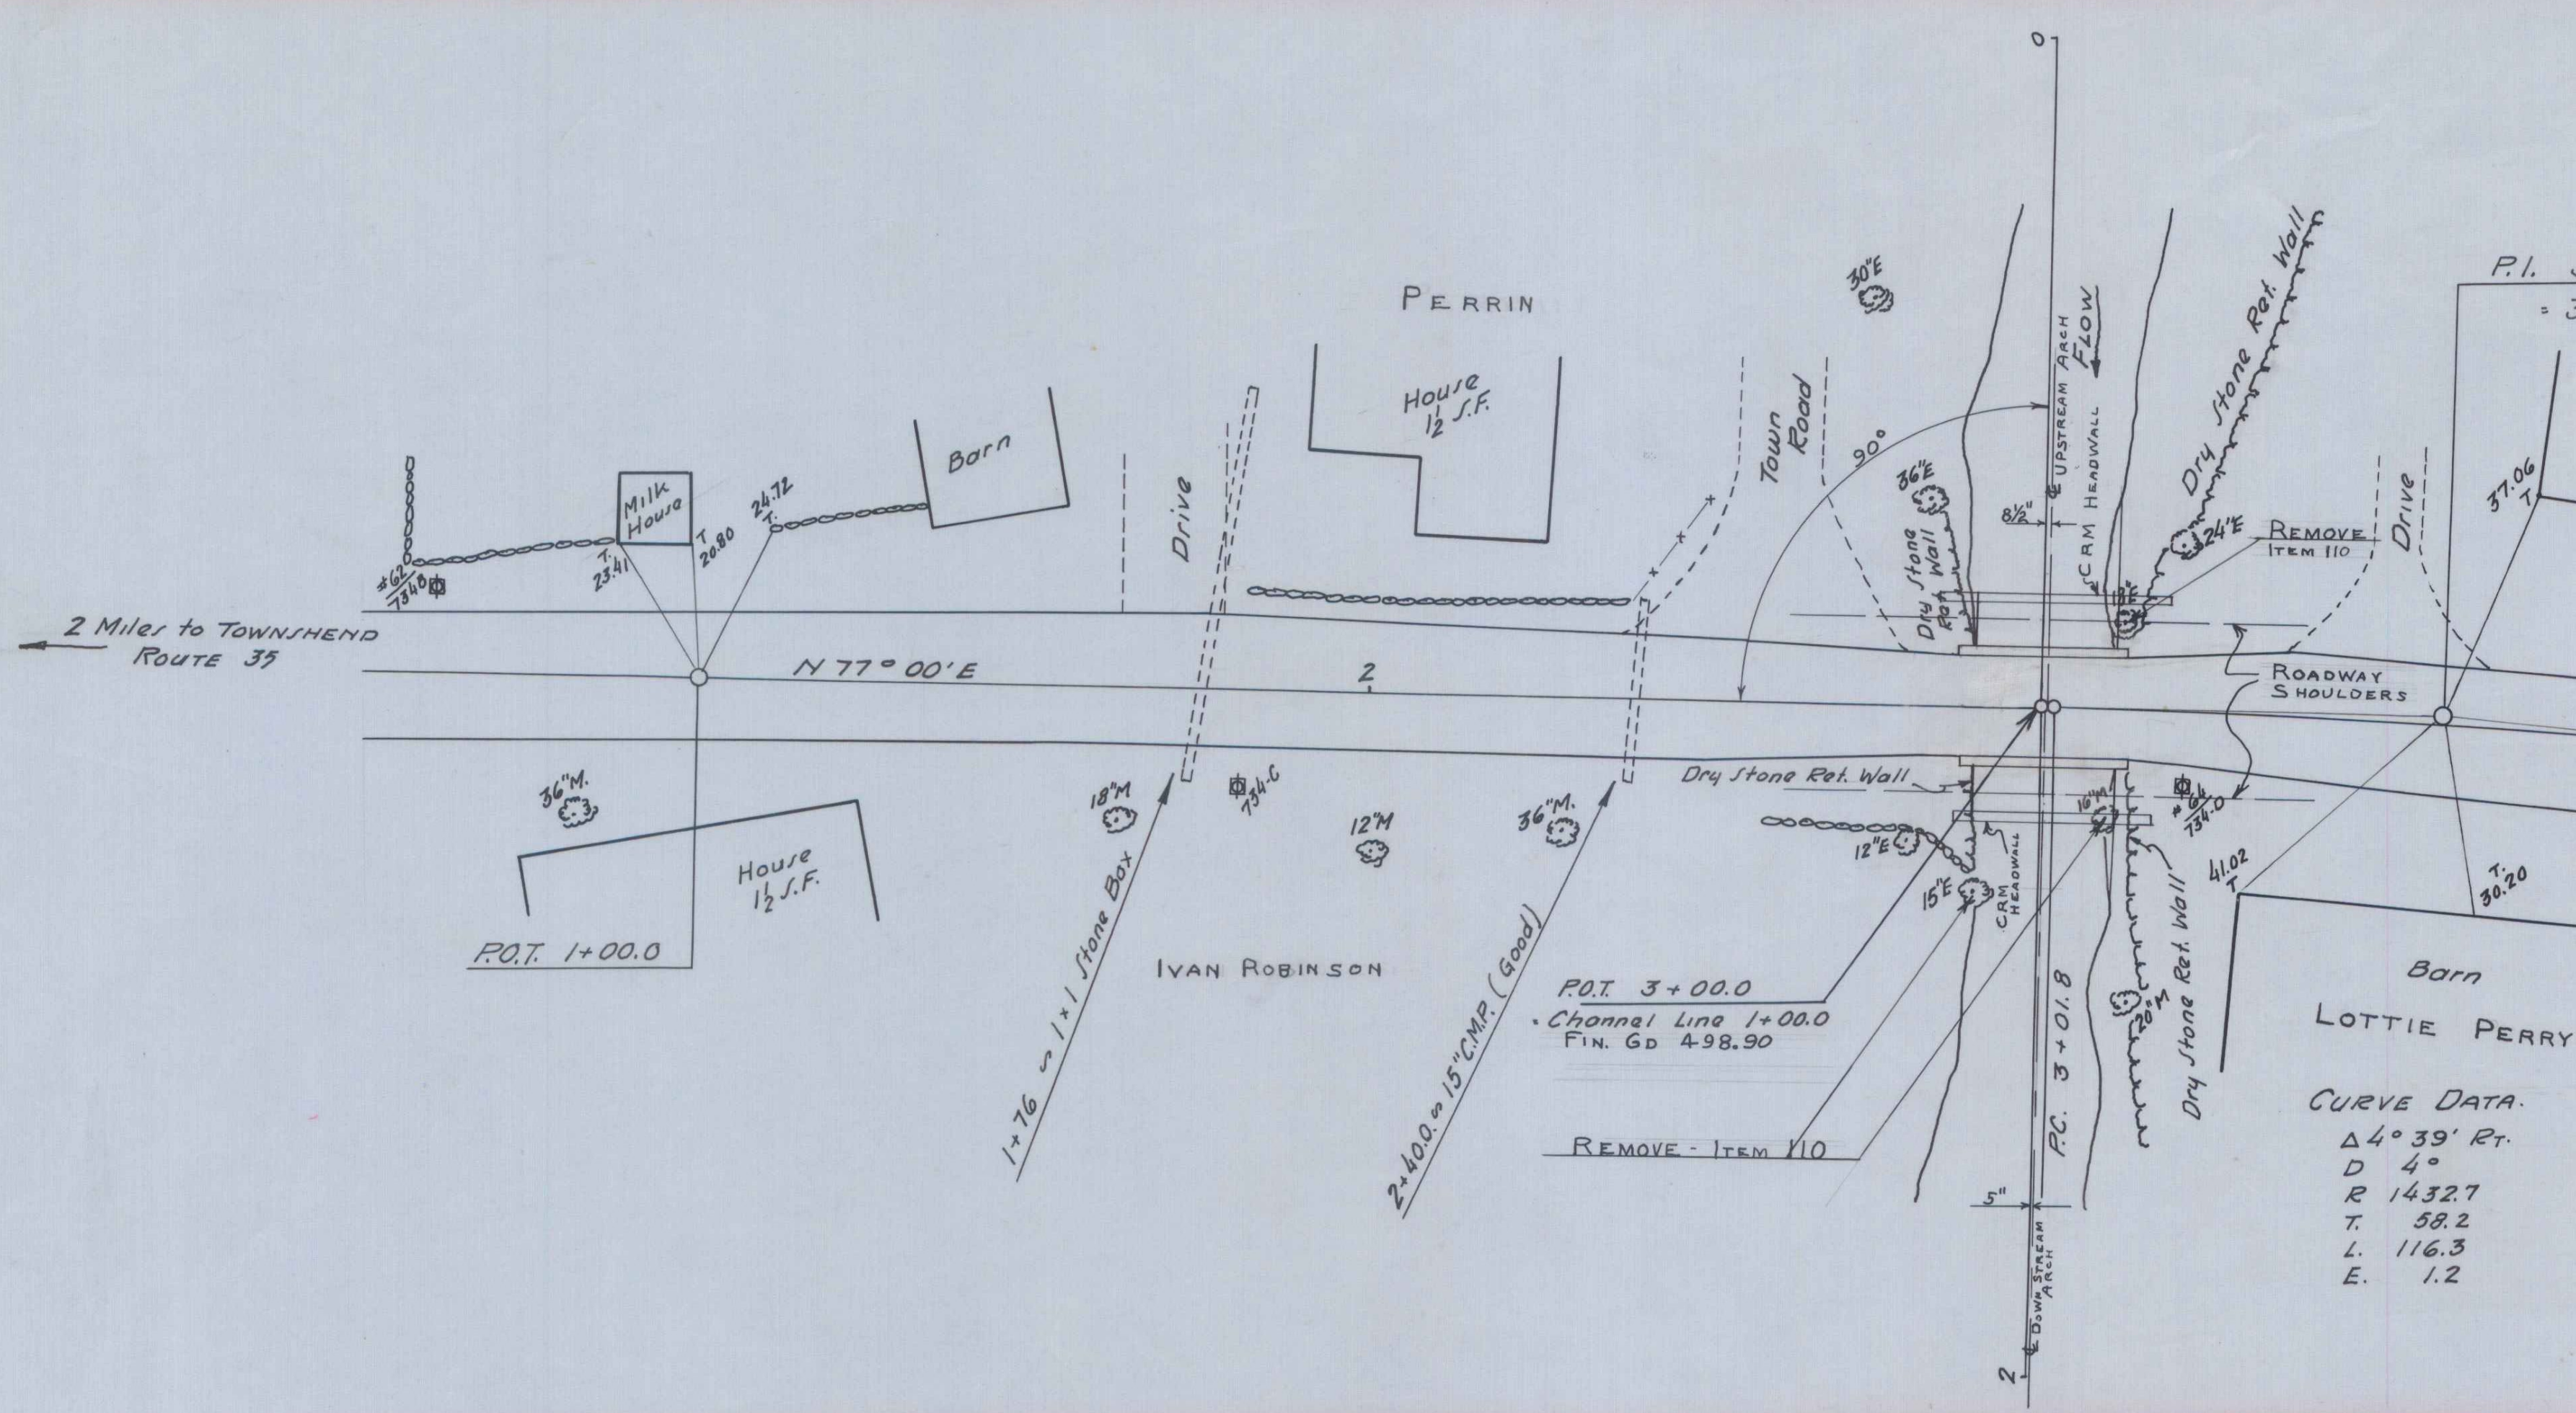

500
490
480

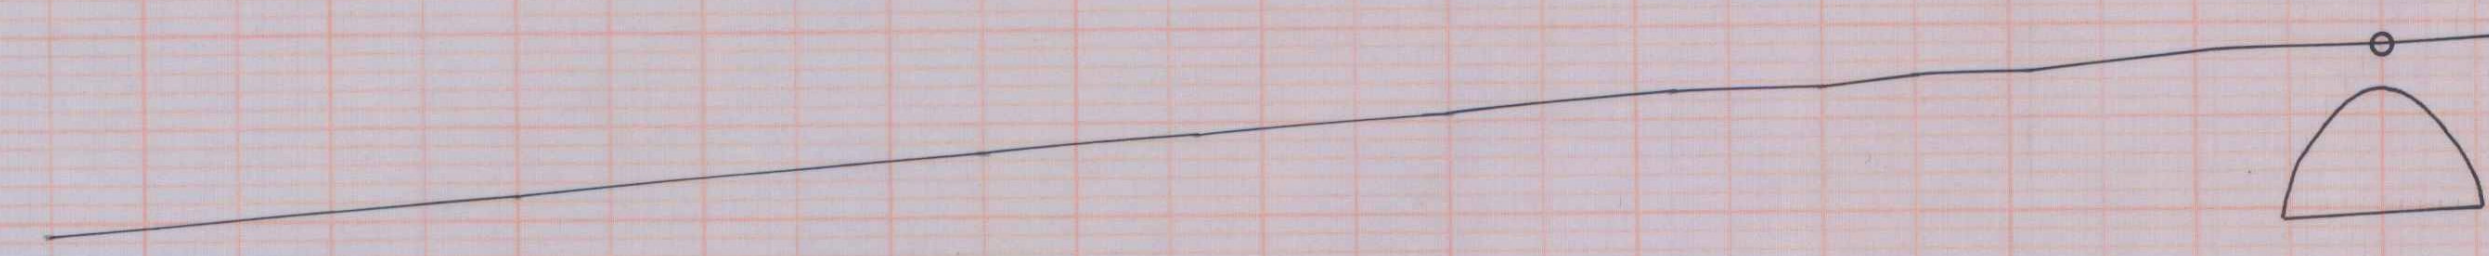

LIST OF SHEETS (BR. ONLY)	
SHEET 1 OF 10	PLAN AND PROFILE
2 & 3 OF 10	DETAILS OF CORR. GALV. METAL PLATE PIPE ARCHES
4 OF 10	REINFORCING STEEL QUANTITIES AND DETAILS
5 OF 10	EARTHWORK SHEET
6 OF 10	BARRICADES SIGNS AND LIGHTS STANDARD SB-11
7 OF 10	CABLE GUARD RAIL STANDARD S-30 ITEM 80-A
8 & 9 OF 10	ROADWAY SECTIONS
10 OF 10	CHANNEL SECTIONS

APPROVED
DISTRICT E
CORRECT
BRIDGE EN
APPROVED
CHIEF EN

PROJECT Townshend
NUMBER SA-17-1953 LENGTH MI.
TYPE C.G.M.P.P.A. Extension
CONTRACTOR _____ YEAR 19 ____
LOCATION SA-Rd. #1 ~
Bridge # 4

