
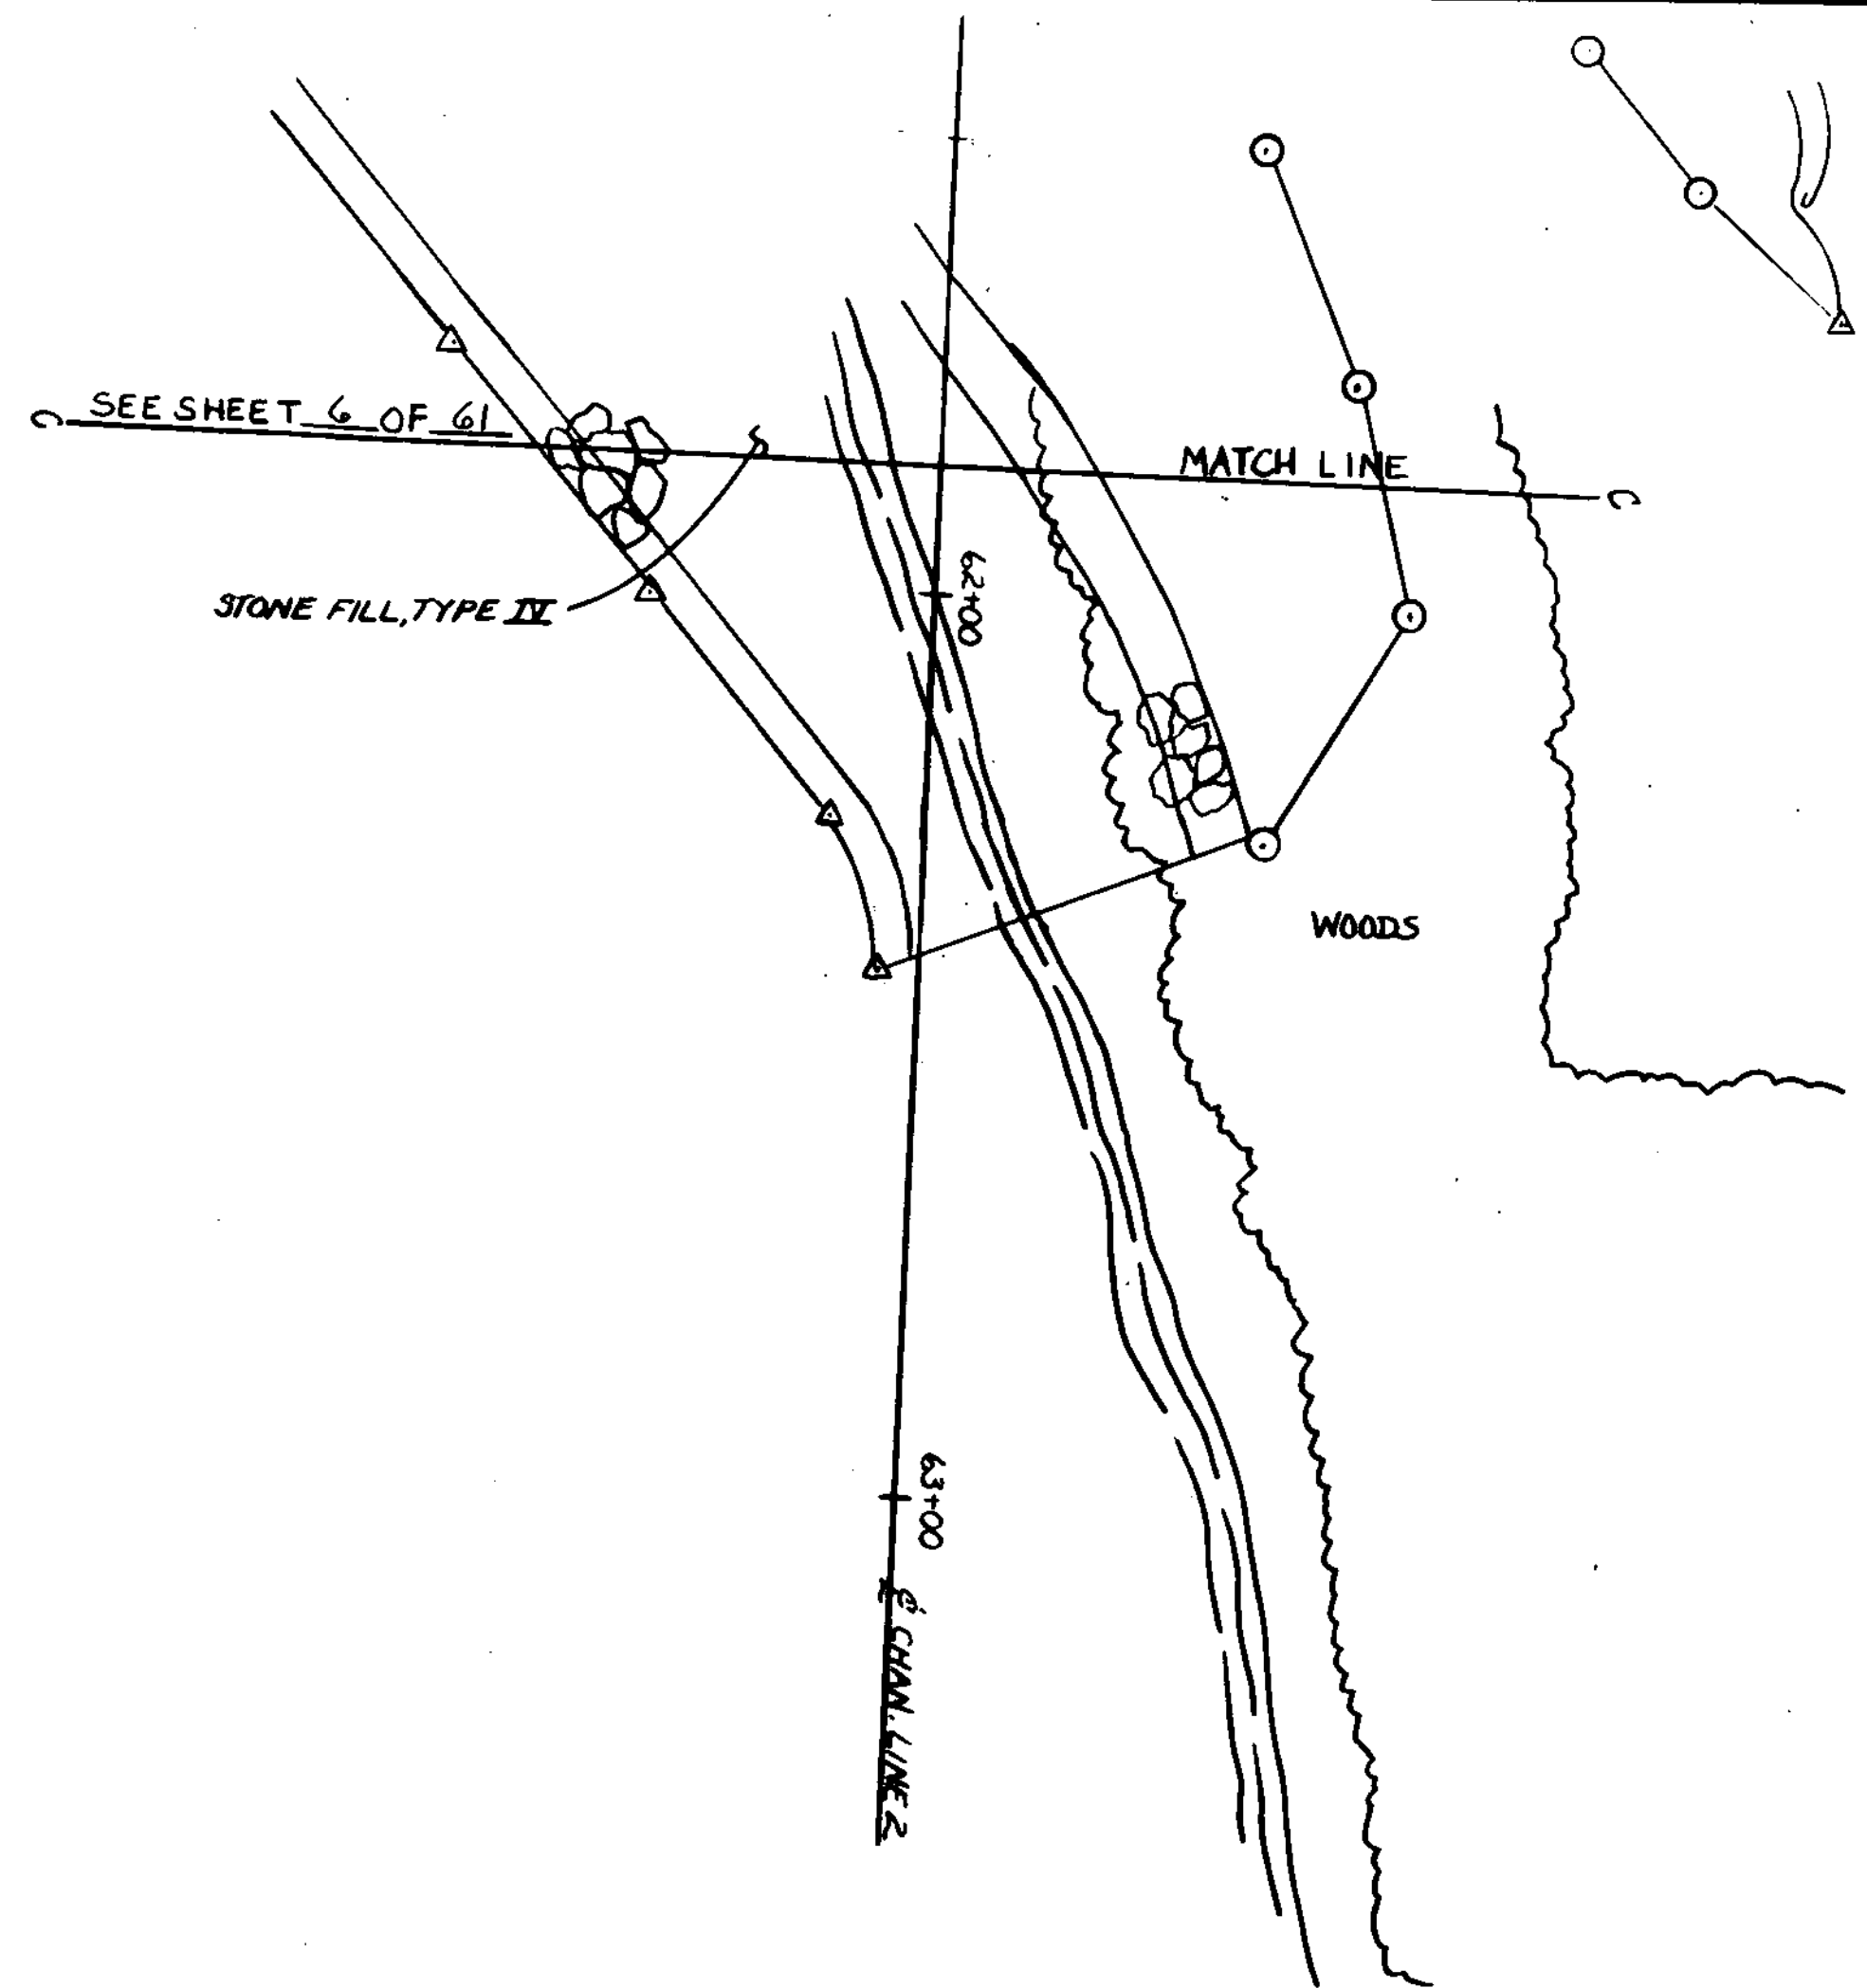


GUARD RAIL, STANDARD STEEL BEAM W/WOOD POSTS, TYPE II  
 STA. (TH#36) 12+00 → 12+90 LT.

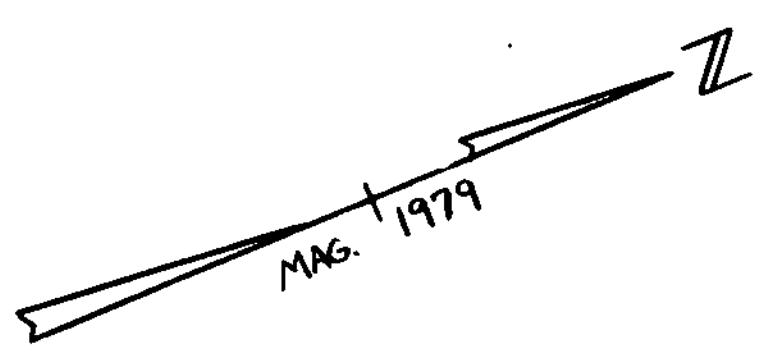

|   |   |
|---|---|
| <b>STATE OF VERMONT</b>                           |   |
| <b>AGENCY OF TRANSPORTATION</b>                   |   |
| TOWN OF <b>GEORGIA</b>                            | Bridge No. <b>10</b>  |
| HIGHWAY NO. <b>TH#1</b>                           | Log Sta. _____  |
| <b>TH#1 OVER LAMOILLE RIVER</b>                   |   |
| Designed by <b>C.P. WILLIAMS</b>                  | Drawn by <b>E.C. HOUSTON</b>                                  |
| Checked by <b>C.P. WILLIAMS</b> date <b>11/84</b> | Bridge Design Supervisor <b>F. W. Bolkum</b> date <b>2/85</b> |
| PROJECT <b>GEORGIA</b>                            | PROJECT NO. <b>BRZ 1448(3)</b>                                |
| Bridge Sheet No. _____                            | Sheet <b>7</b> of <b>61</b>                                   |