


NOTE BOOK GRADES CHECKED  
 STRUCTURE NOTATION CHKD  
 NO. 1  
 DATE 11/21/51

NOTE BOOK GRADES CHECKED  
 STRUCTURE NOTATION CHKD  
 NO. 1  
 DATE 11/21/51

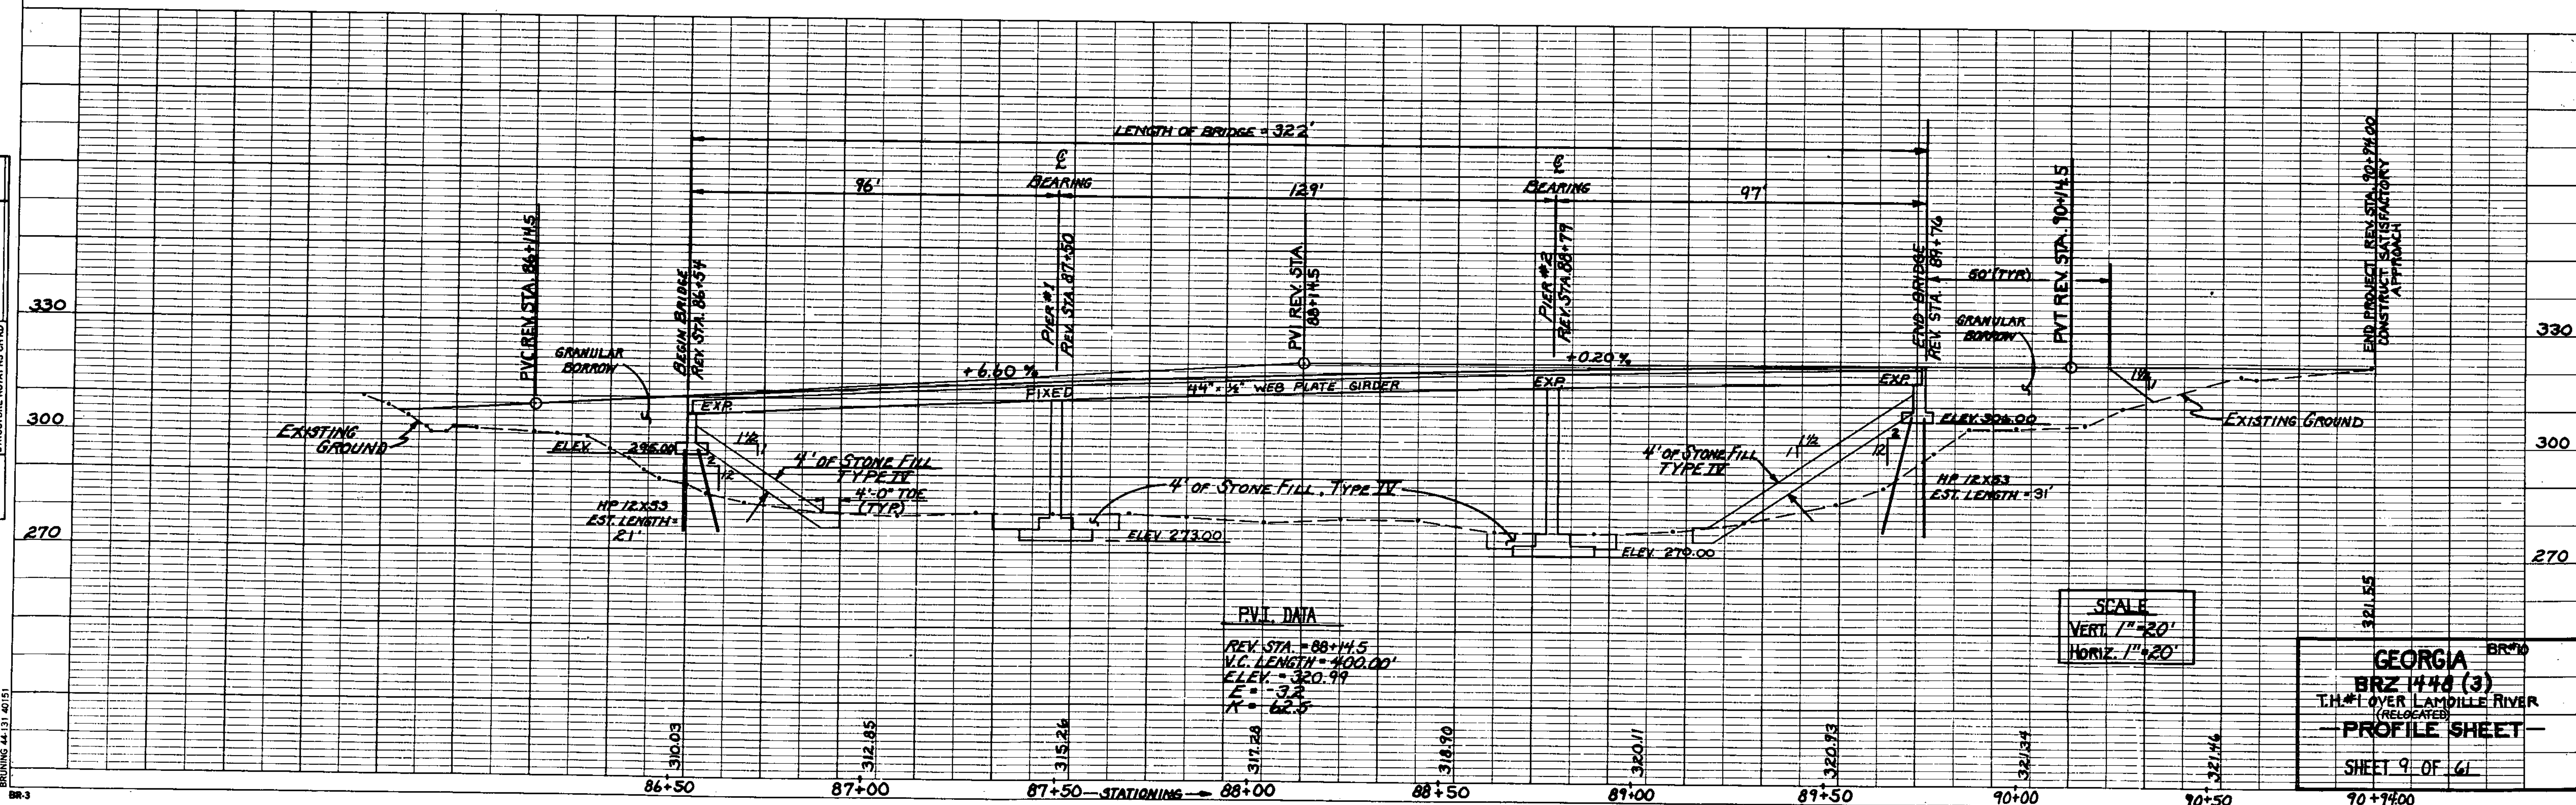

BR 14  
 GEORGIA  
 BRZ 1448 (3)  
 T.H.#1 OVER LAMPILLE RIVER  
 (RELOCATED)  
 PROFILE SHEET  
 SHEET 9 OF 61