


GUARD RAIL, STANDARD STEEL BEAM w/ WOOD POSTS, TYPE II  
 STA. (TH-36) 12+00 → 12+90 RT.

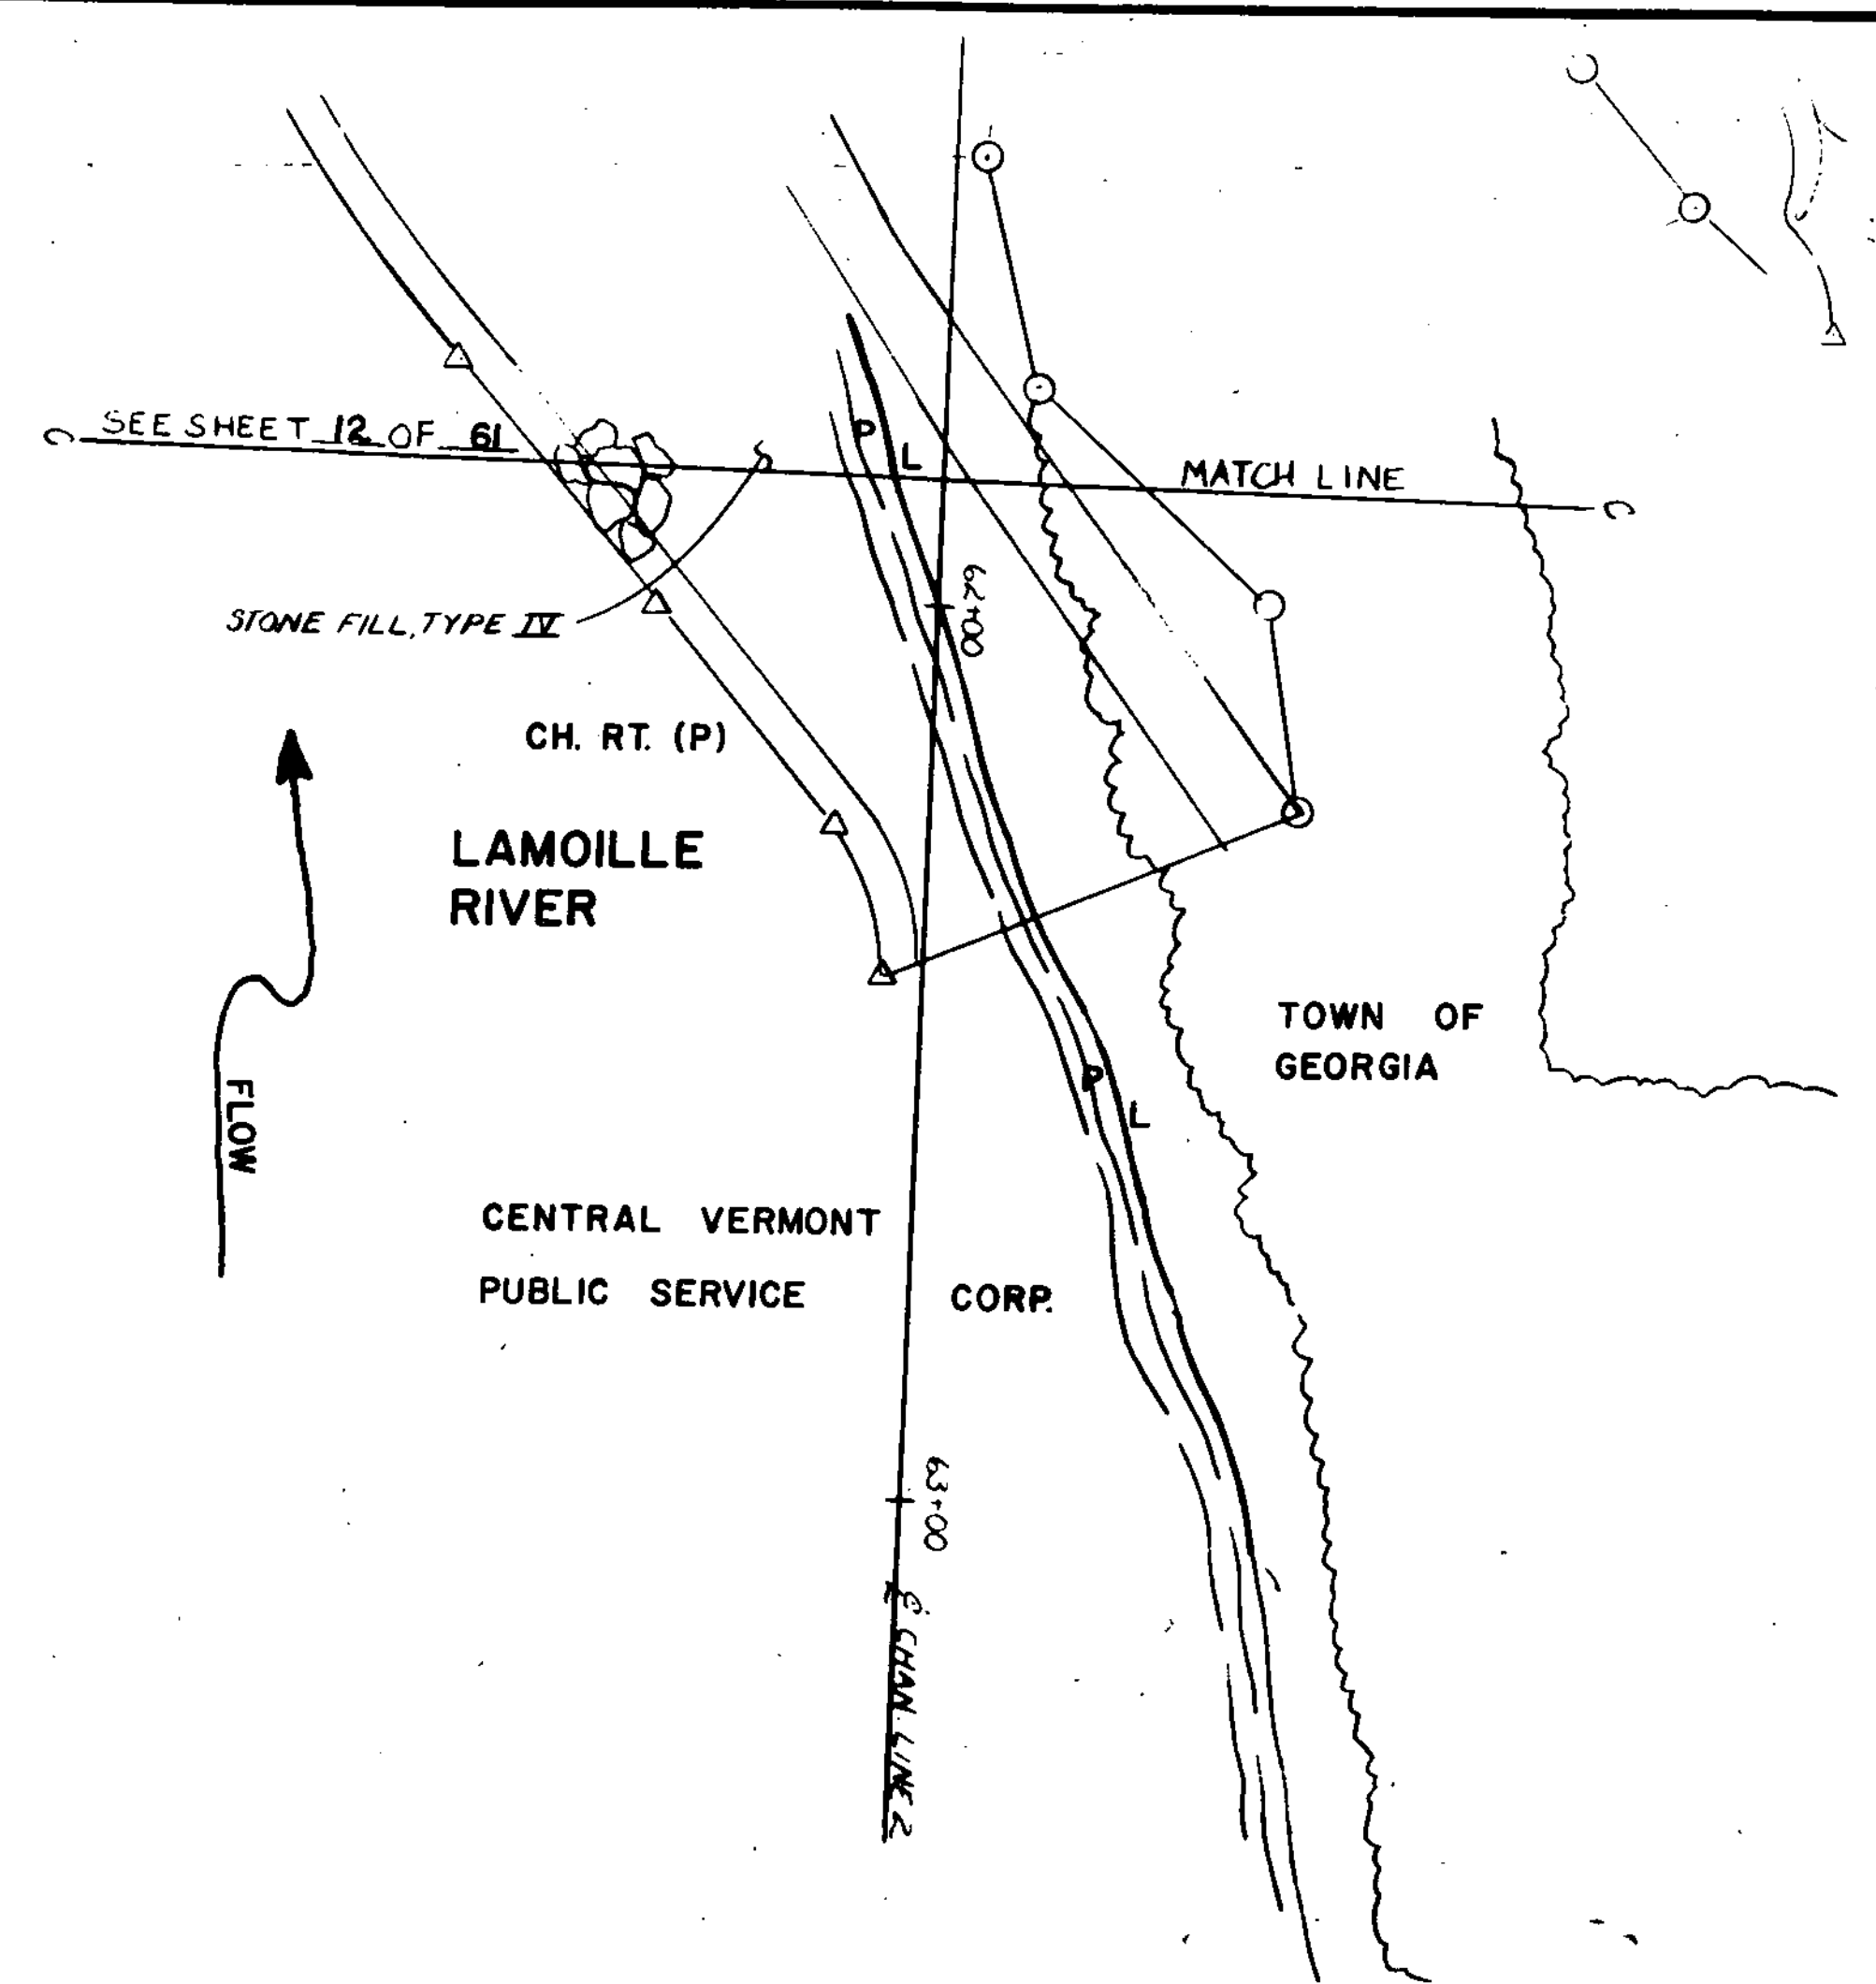

END APPROACH  
 STA. 13+50

NOTE: THIS INFORMATION IS FOR R.O.W. INFORMATION ONLY -  
 SEE OTHER PLAN SHEETS FOR CONSTRUCTION DETAILS.

<b>STATE OF VERMONT</b>	
<b>AGENCY OF TRANSPORTATION</b>	
TOWN OF <b>GEORGIA</b>	Bridge No. <b>10</b>
HIGHWAY NO. <b>TH.#1</b>	Log Sta. <b>REV. Sta. 88+14.5</b>
<b>TH.#1 OVER LAMOILLE RIVER</b>	
Designed by <b>G.S. ROGERS</b>	Drawn by <b>E.C. HOUSTON</b>
Checked by _____	Bridge Design Supervisor
date _____	date _____
PROJECT <b>GEORGIA</b>	PROJECT NO. <b>BRZ 1448 (3)</b>
Bridge Sheet No. _____	Sheet <b>13</b> of <b>61</b>