


STA 90+87.67  
 END GUARD RAIL, STANDARD STEEL BEAM  
 W/WOOD POSTS TYPE II

END PROJECT  
 REVIS STA 90+94.00  
 CONSTRUCT SATISFACTORY APPROACH

STA 90+94.00  
 END GUARD RAIL, STANDARD STEEL BEAM  
 W/WOOD POSTS TYPE II

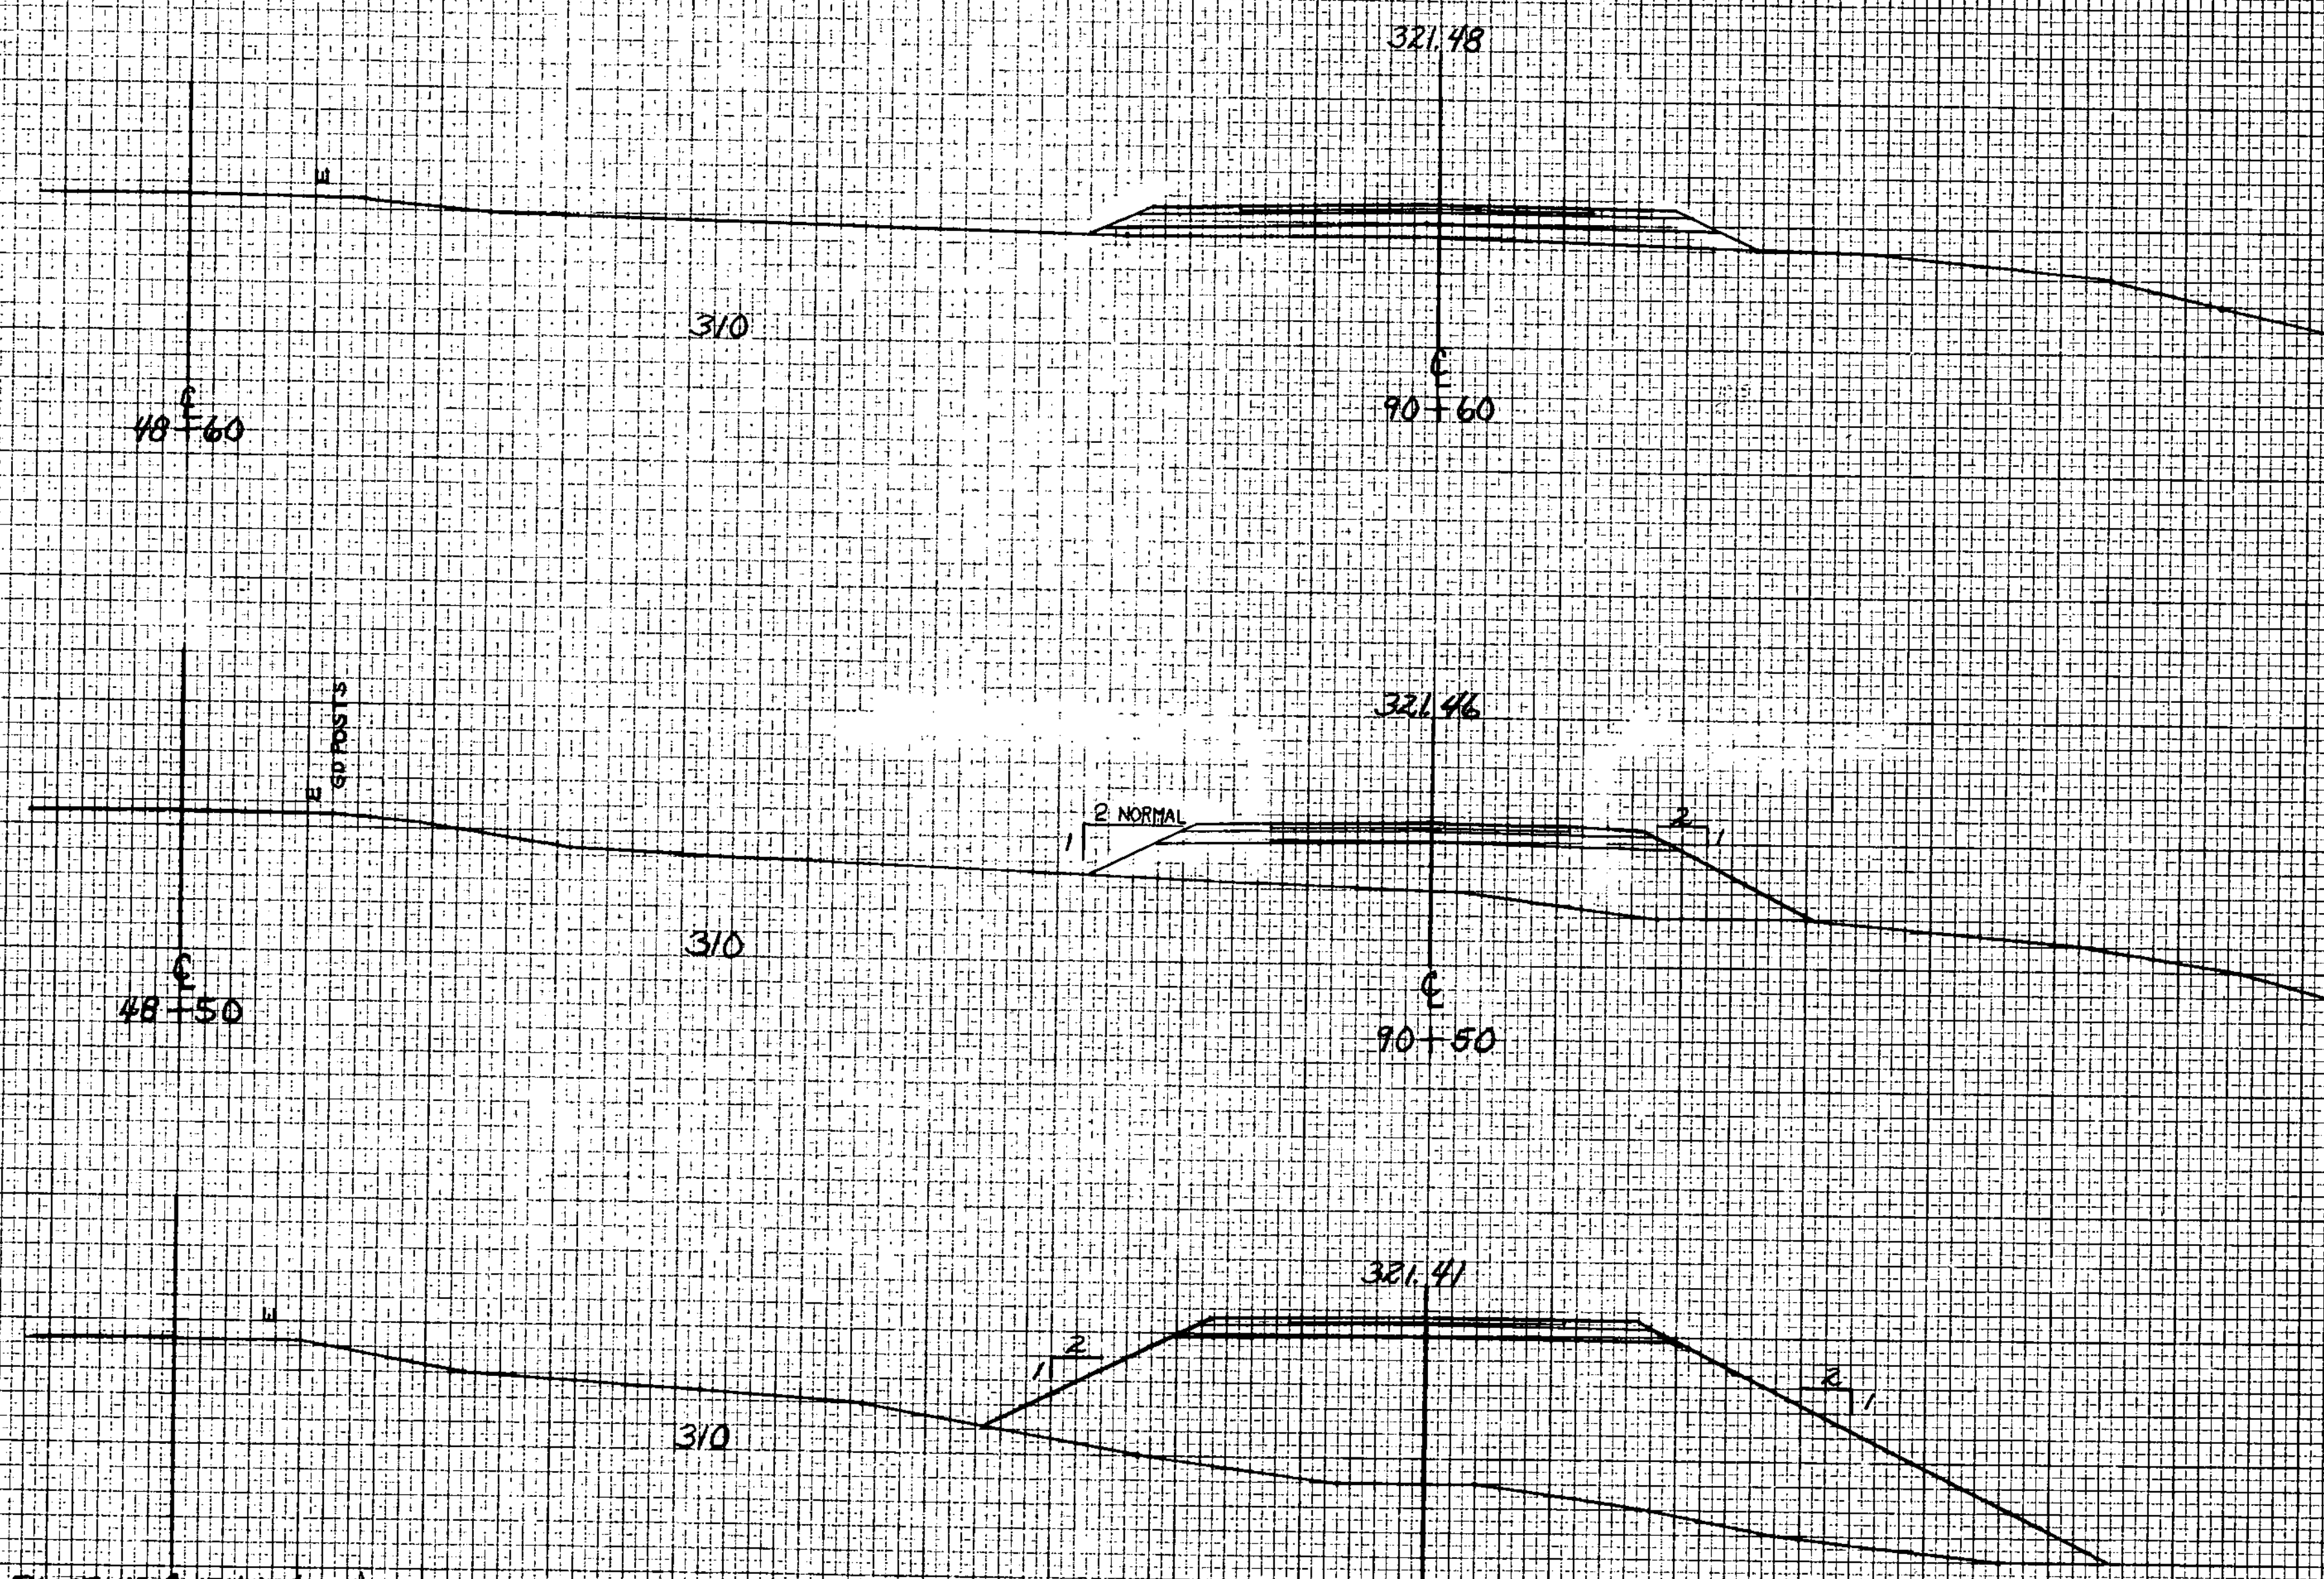

EXISTING E. TH. (TYP)  
 48+25

REVISED E. TH. (TYP)  
 90+25

FROM STA 48+25 TO STA 48+100  
 PROJECT NAME: GEORGIA MAIN  
 NO. BRZ 1410(3)  
 INTERPOLATED SECTIONS SHEET 35 OF 61 SHEETS

ORIGINAL SURVEY NOTE BOOK NO.	REVISIONS	BY	DATE

FINAL SURVEY NOTE BOOK NO.	REVISIONS	BY	DATE