

TH #1 REV STA 87+00
= TH #36 STA 11+97.41

REV STA 86+00 (TH #1)
= 10+97.41 (TH #36)

TH #1 REV STA 86+03.73
= TH #36 STA 11+01.14

REV STA 85+00

PI REV STA 85+00.49

REV STA 84+75

REV STA 84+50

+0.021%


RIGHT

-0.021%

LEFT

BANKING DIAGRAM

RIGHT LEFT
-0.021%

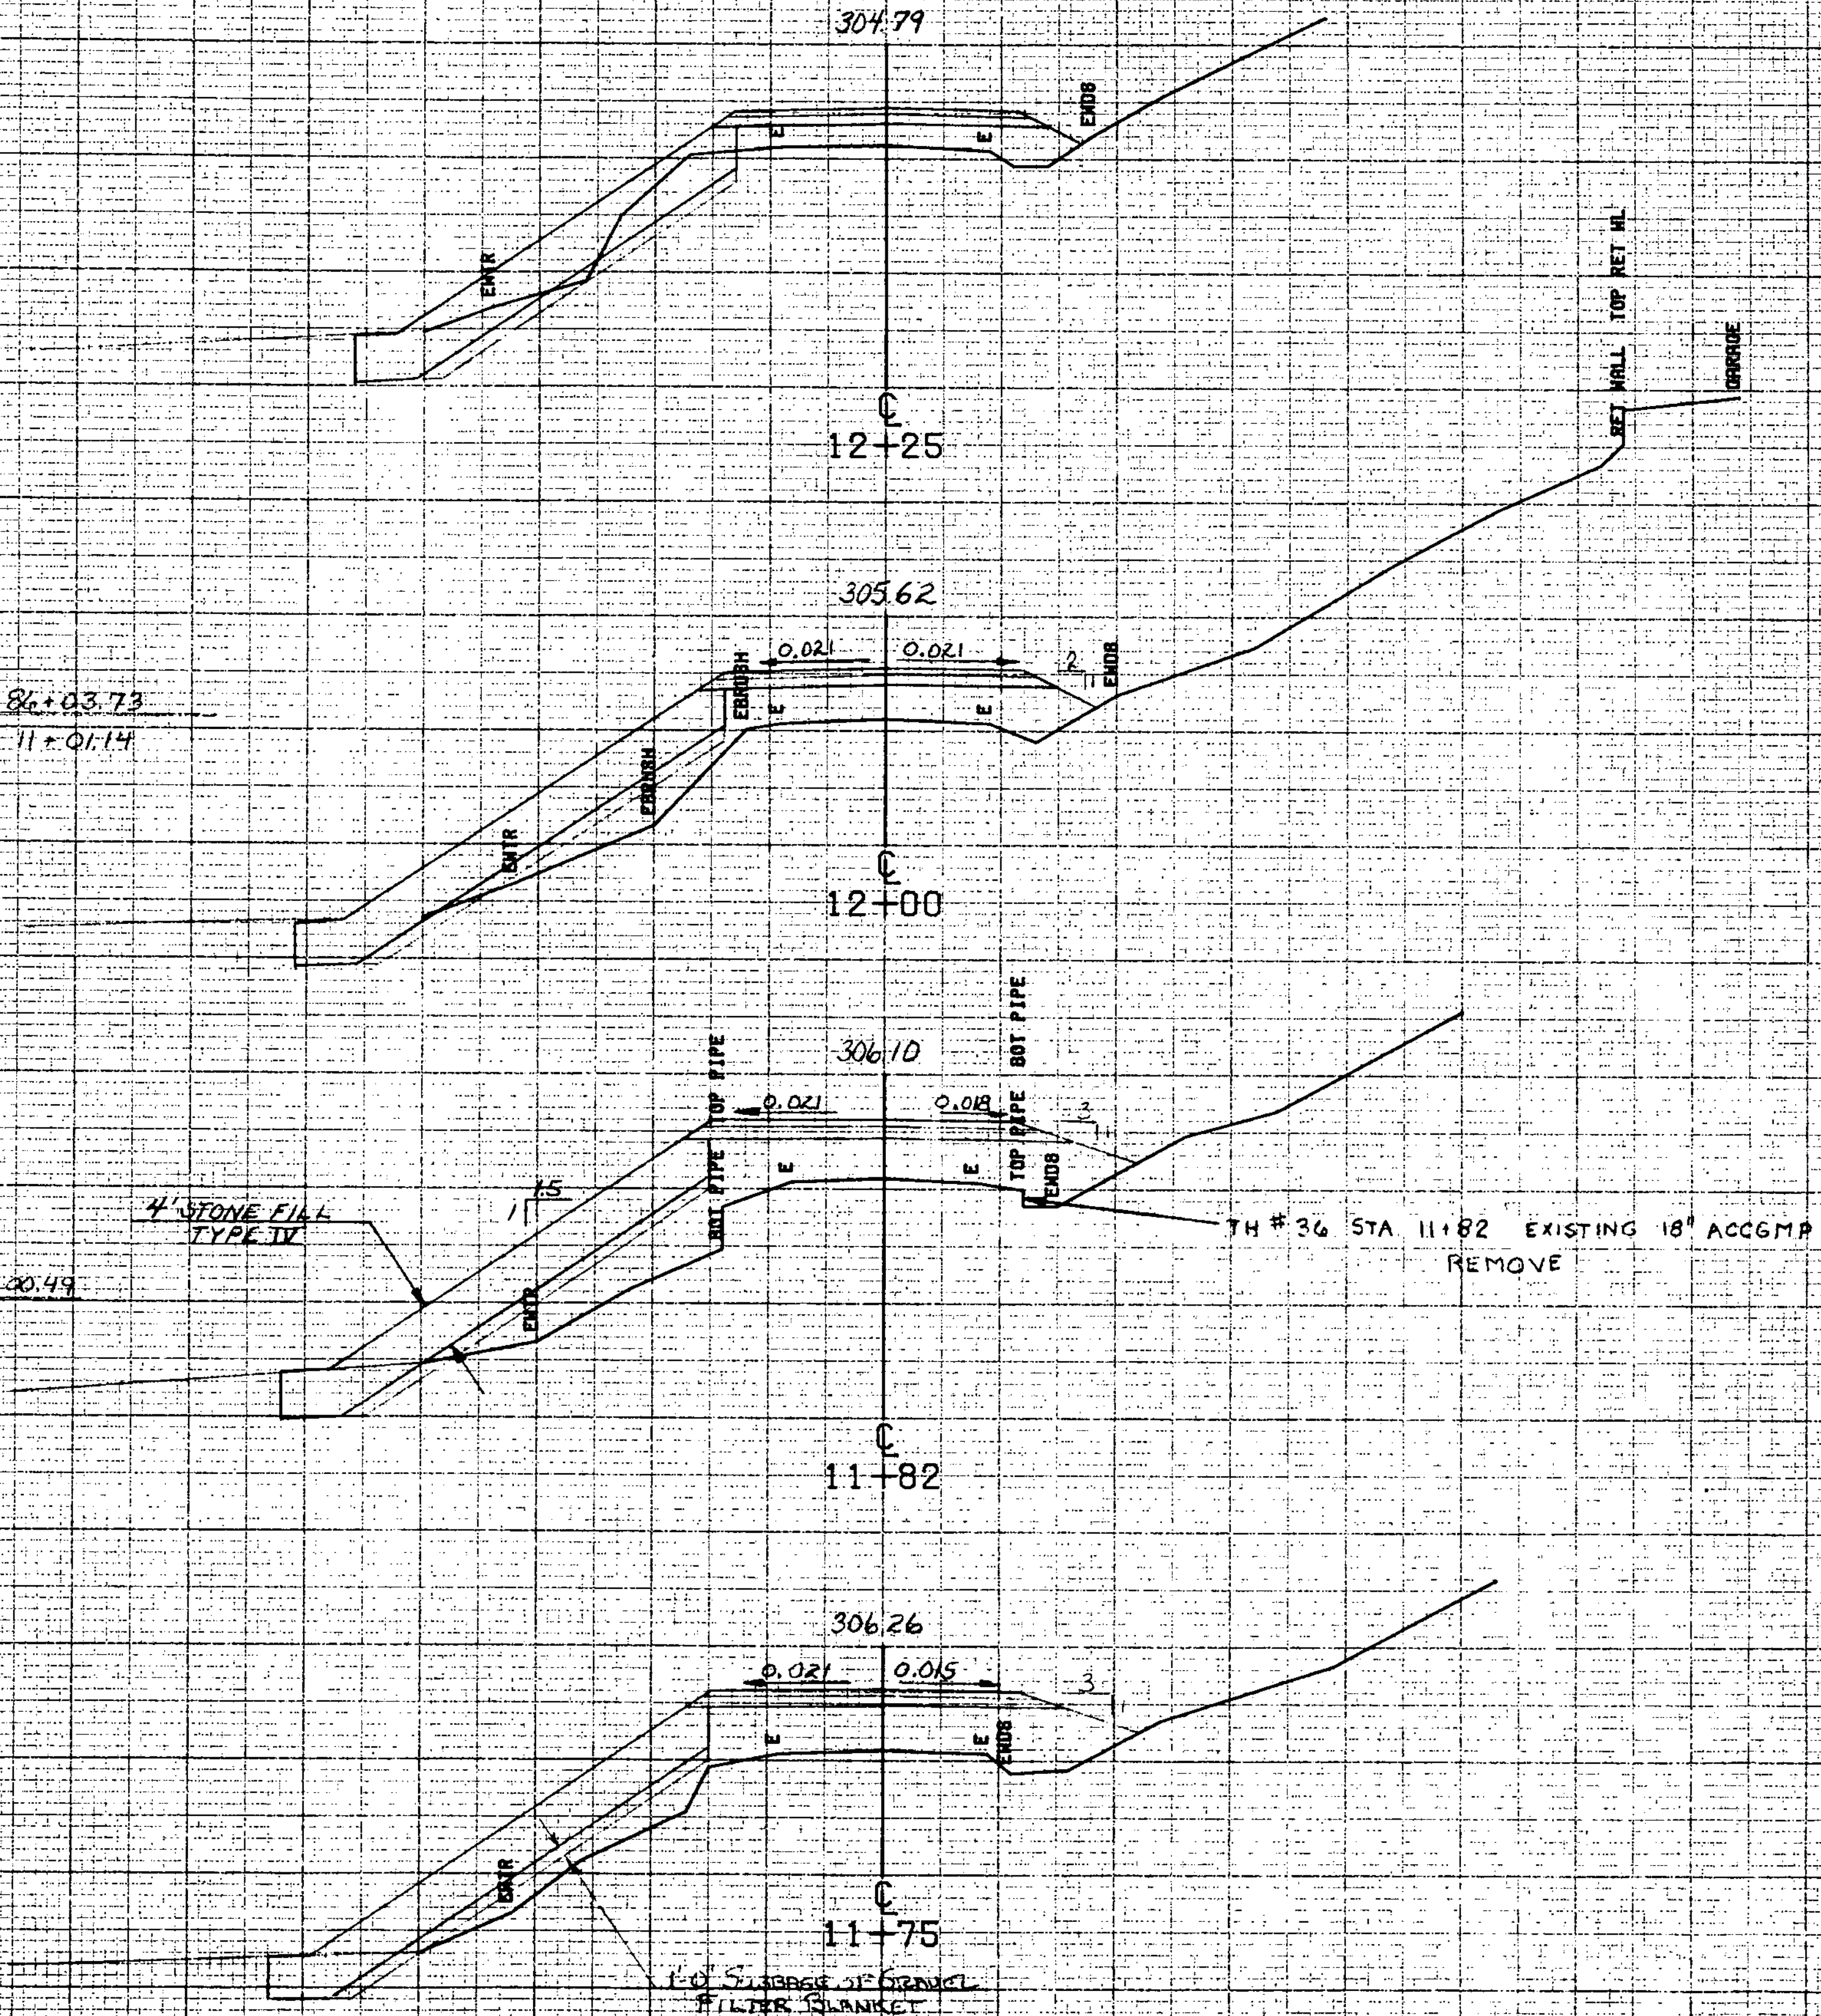

290

290

290

290

SCALE 1" = 40 FEET

FROM STA. 11+75	TO STA. 12+25
PROJECT NAME	GEORGIA TMS6
NO.	BR214401B
SURVEYED BY	BRADY
SHEET 38 OF 61	SHEET 8
	PLOTTED 01/02/80
	DEC. 1978