


ORIGINAL SURVEY	PROJECTED	BY
NOTE BOOK	TEMP. DATE	DATE
AREA CHECKED	AREA CHECKED	

FINAL SURVEY	PROJECTED	BY
NOTE BOOK	TEMP. DATE	DATE
AREA CHECKED	AREA CHECKED	

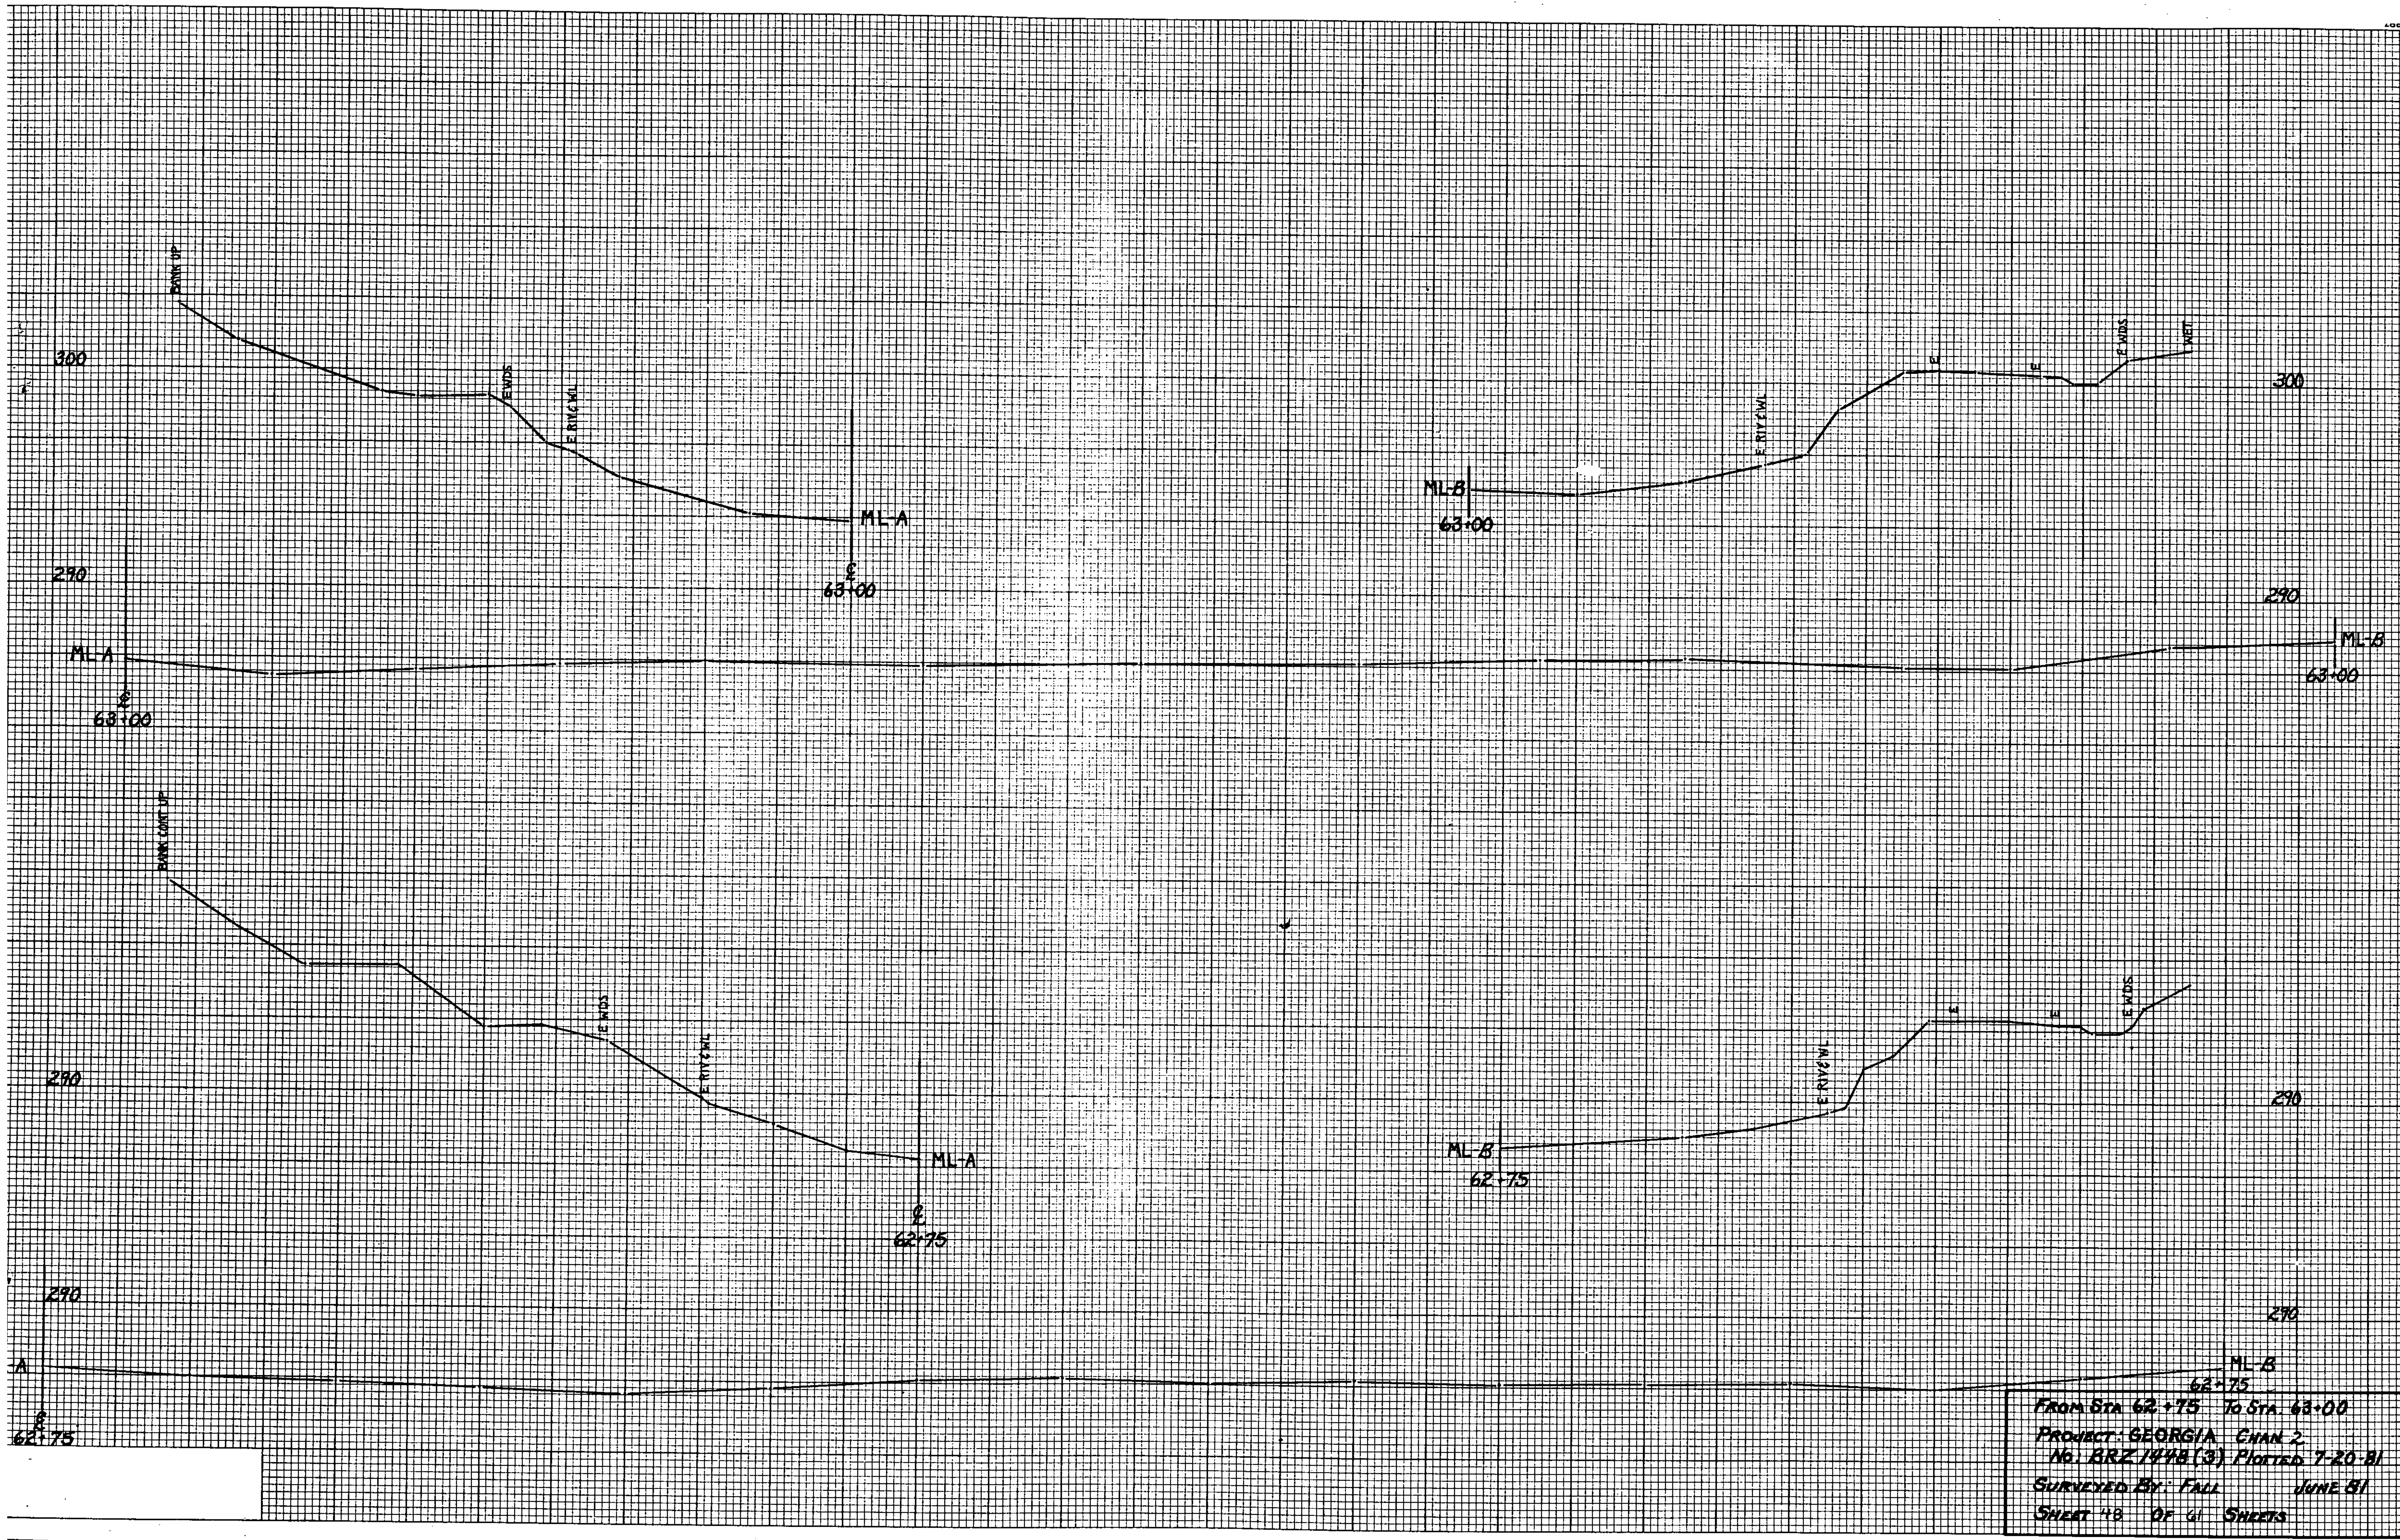

FROM STA 62+75 To STA 63+00
 PROJECT: GEORGIA CHAN 2
 No. BRZ 1248 (3) PLOTTED 7-20-81
 SURVEYED BY: FALL JUNE 81
 SHEET 48 OF 61 SHEETS