

BRIDGE RAILING, H.D. STEEL BEAM, TYPE D
 T.H.57 STA. 10+35 TO STA. 10+81 RT. & LT.


GUARD RAIL, H.D. STEEL BEAM WITH WOOD POST,
 TYPE II (A532 STEEL) (6' POST SPACING TYPICAL)
 VT. 11 STA. 4+14 RT. TO T.H.57 STA. 10+35 RT.
 T.H.57 STA. 10+35 LT. TO VT. 11 STA. 5+62 FT.
 T.H.57 STA. 10+81 TO STA. 11+08 RT. & LT.

STONE FILL, TYPE II
 CHAN. STA. 4+72 TO 5+25 RT.

TEMPORARY BRIDGE NOTES:

1. TEMPORARY BRIDGE IS TO BE LOCATED IN APPROXIMATE LOCATION AS PREVIOUS TEMPORARY CROSSINGS AND APPROXIMATELY AS SHOWN ON THIS DRAWING.
2. EVERY EFFORT SHALL BE MADE TO SAVE AS MANY TREES AS POSSIBLE.
3. FINAL LOCATION OF TEMPORARY BRIDGE, ACCESS ROAD, AND CONST. EASEMENTS SHALL MEET THE APPROVAL OF THE PROPERTY OWNER.

VT. TEL. CO.
 6 87-1
 95-1

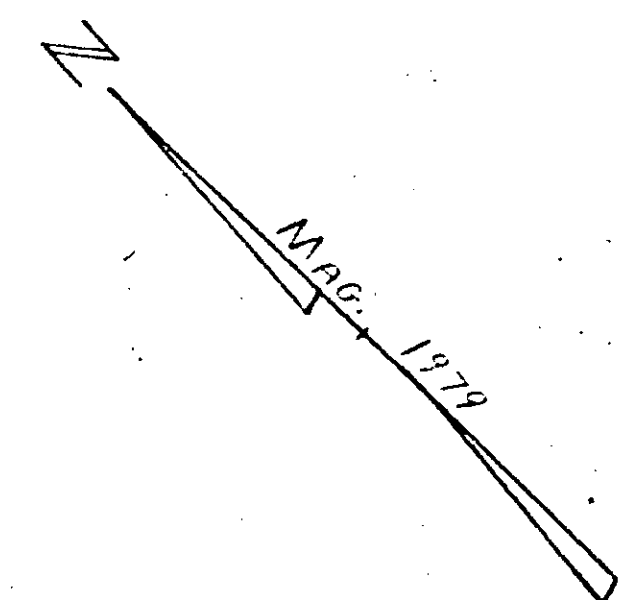

BEGIN R.O.W. PROJECT
 BRZ 1442 (2) STA. 10+00 @

END SIDELINE STA. 6+00
 CONSTRUCT SATISFACTORY APPROACH

BEGIN PROJECT
 M/L 10+00.00 CHAN. 5+00.00
 Δ = 90° 19' 15" LT.


BEGIN SIDELINE STA. 4+00
 CONSTRUCT SATISFACTORY APPROACH

END PROJECT STA. 12+00
 CONSTRUCT SATISFACTORY APPROACH

END APPROACH STA. 13+00

END R.O.W. PROJECT
 BRZ 1442 (2) STA. 12+00 @

NOTE
 THIS SHEET IS FOR R.O.W. LIMIT
 DETAILS ONLY. REFER TO THE
 REMAINING PLAN SHEETS FOR
 ALL OTHER CONTRACT DETAILS.

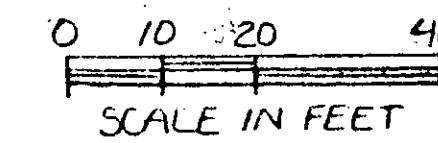

SURVEYED BY	TESSIER	DATE	12/79
DRAWN BY	ORVIS	DATE	2/80
TRACED BY	PAGE	DATE	2/80
PROJ. CHESTER			
NO. BRZ 1442 (2)			
SHEET 5 OF 32			

4431 40002