



STA. 10+81
END BRIDGE - RESUME ROADWAY

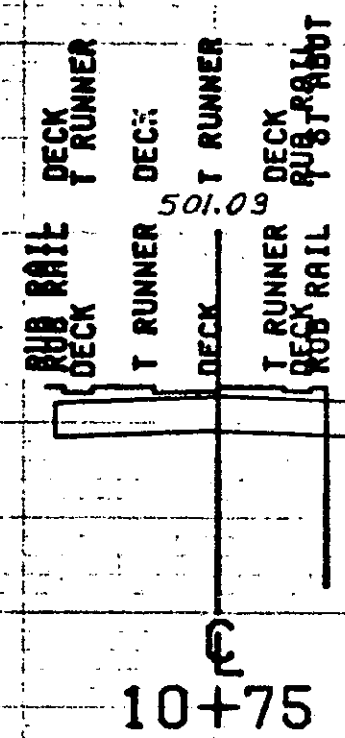

490

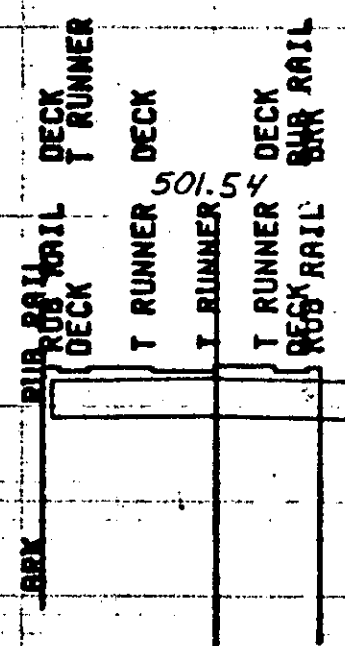

490

STA. 10+35
STOP ROADWAY - BEGIN BRIDGE

10+50

6" GRAVEL SURFACE COURSE

502.05

12' SUBBASE OF GRAVEL

490

10+25

CL. VTL

10+00

BEGIN PROJECT, STA. 10+00
CONSTRUCT SATISFACTORY APPROACH

490

SCALE 1" = 10 FEET

FROM STA. 10+00	TO STA. 10+75
PROJECT NAME	CHESTER HAIN T.H. 57
NO.	BRZ1442(2)
SURVEYED BY	TESSIER
SHEET	OF 12 SHEETS 32
	PLOTTED 02/25/80
	DEC. 1979