



DECK REINFORCING PLAN
SCALE: 3/16" = 1'-0"

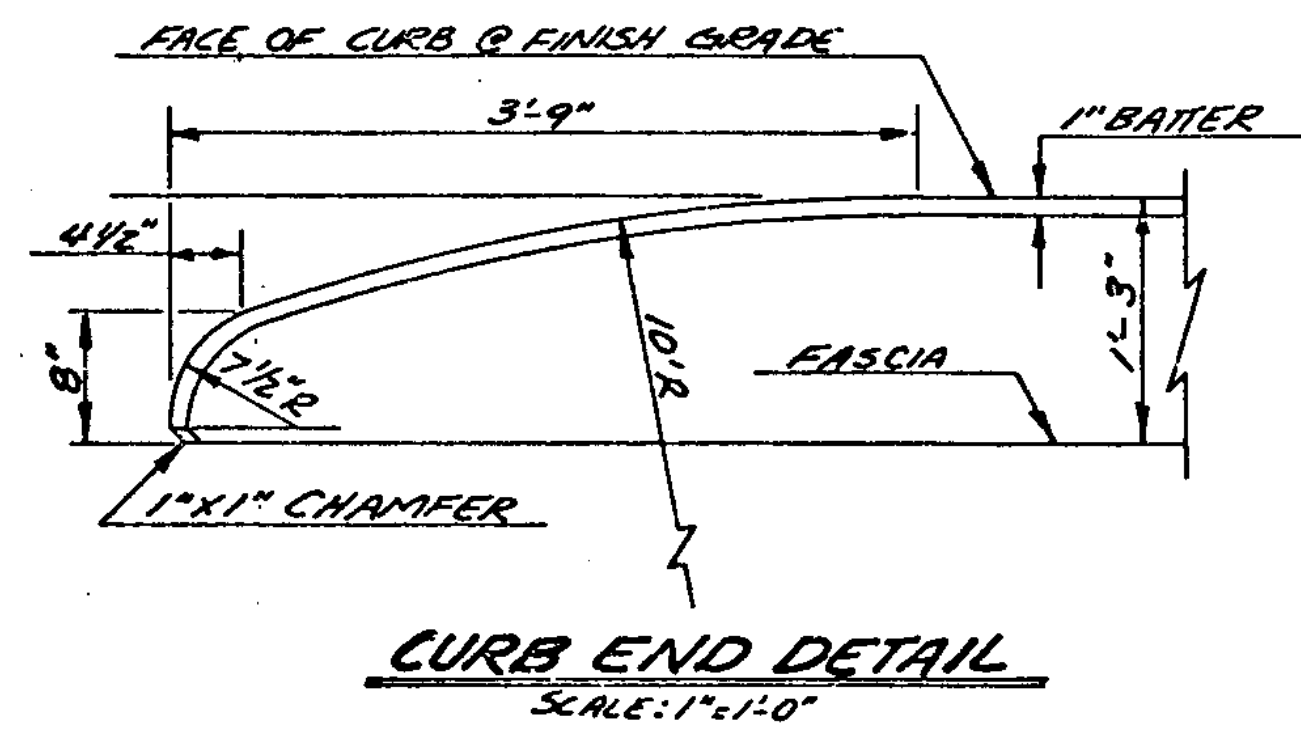

CURB END DETAIL
SCALE: 1" = 1'-0"

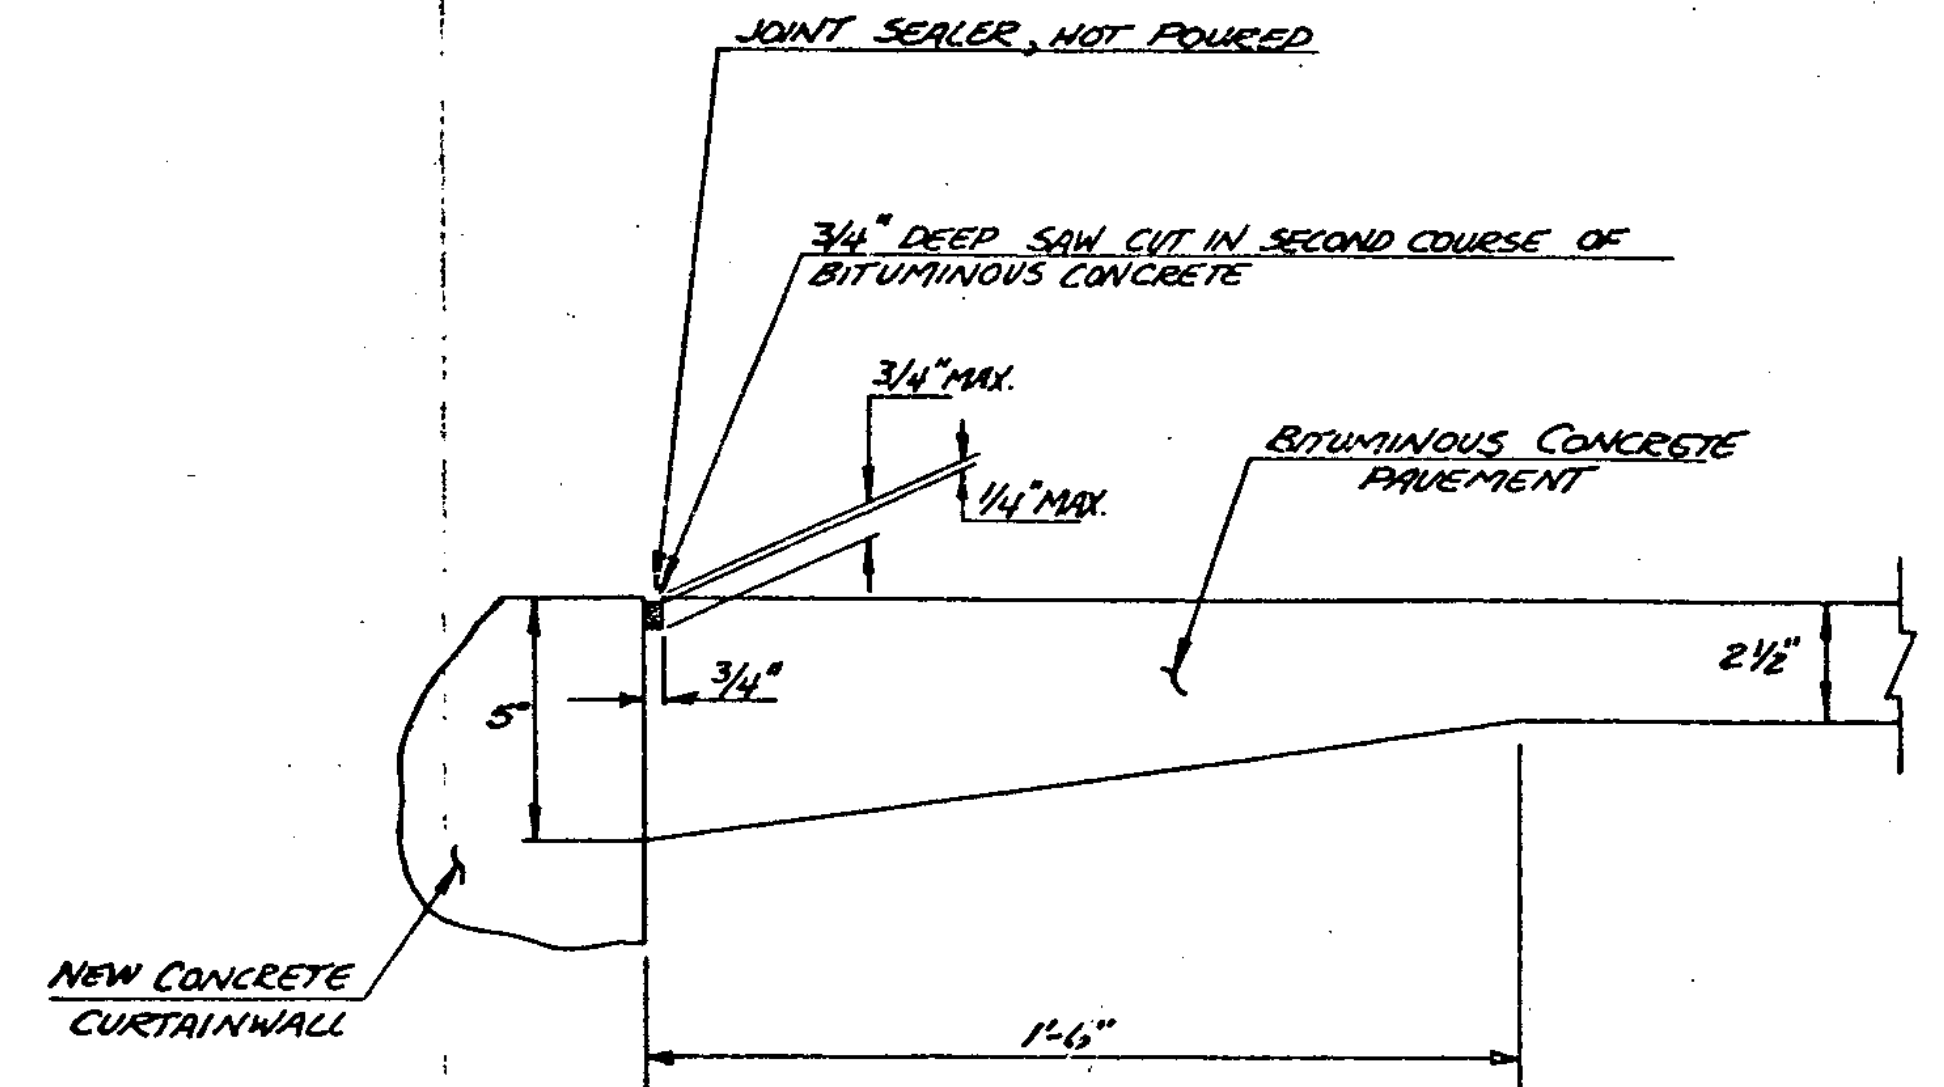

JOINT SEALER DETAIL
SCALE: 3" = 1'-0"

STATE OF VERMONT	
AGENCY OF TRANSPORTATION	
TOWN OF GRANVILLE	Bridge No. 23
HIGHWAY NO. T.H. # 26	Log Sta. _____
	Surv. Sta. 13+18
T.H. 26 OVER THE WHITE RIVER	
SUPERSTRUCTURE DETAILS (CONT.)	
Designed by G.S. ROBERS	Drawn by L.C. GAYES
Checked by G.S. ROBERS	Bridge Design Supervisor
date 3/84	F.W. Bolcum date 4/82
PROJECT GRANVILLE	PROJECT NO. BRZ-1444(9)
Bridge Sheet No. _____	Sheet 11 of 41

BR-6-83