



PLAN  
SCALE 1" = 10'-0"

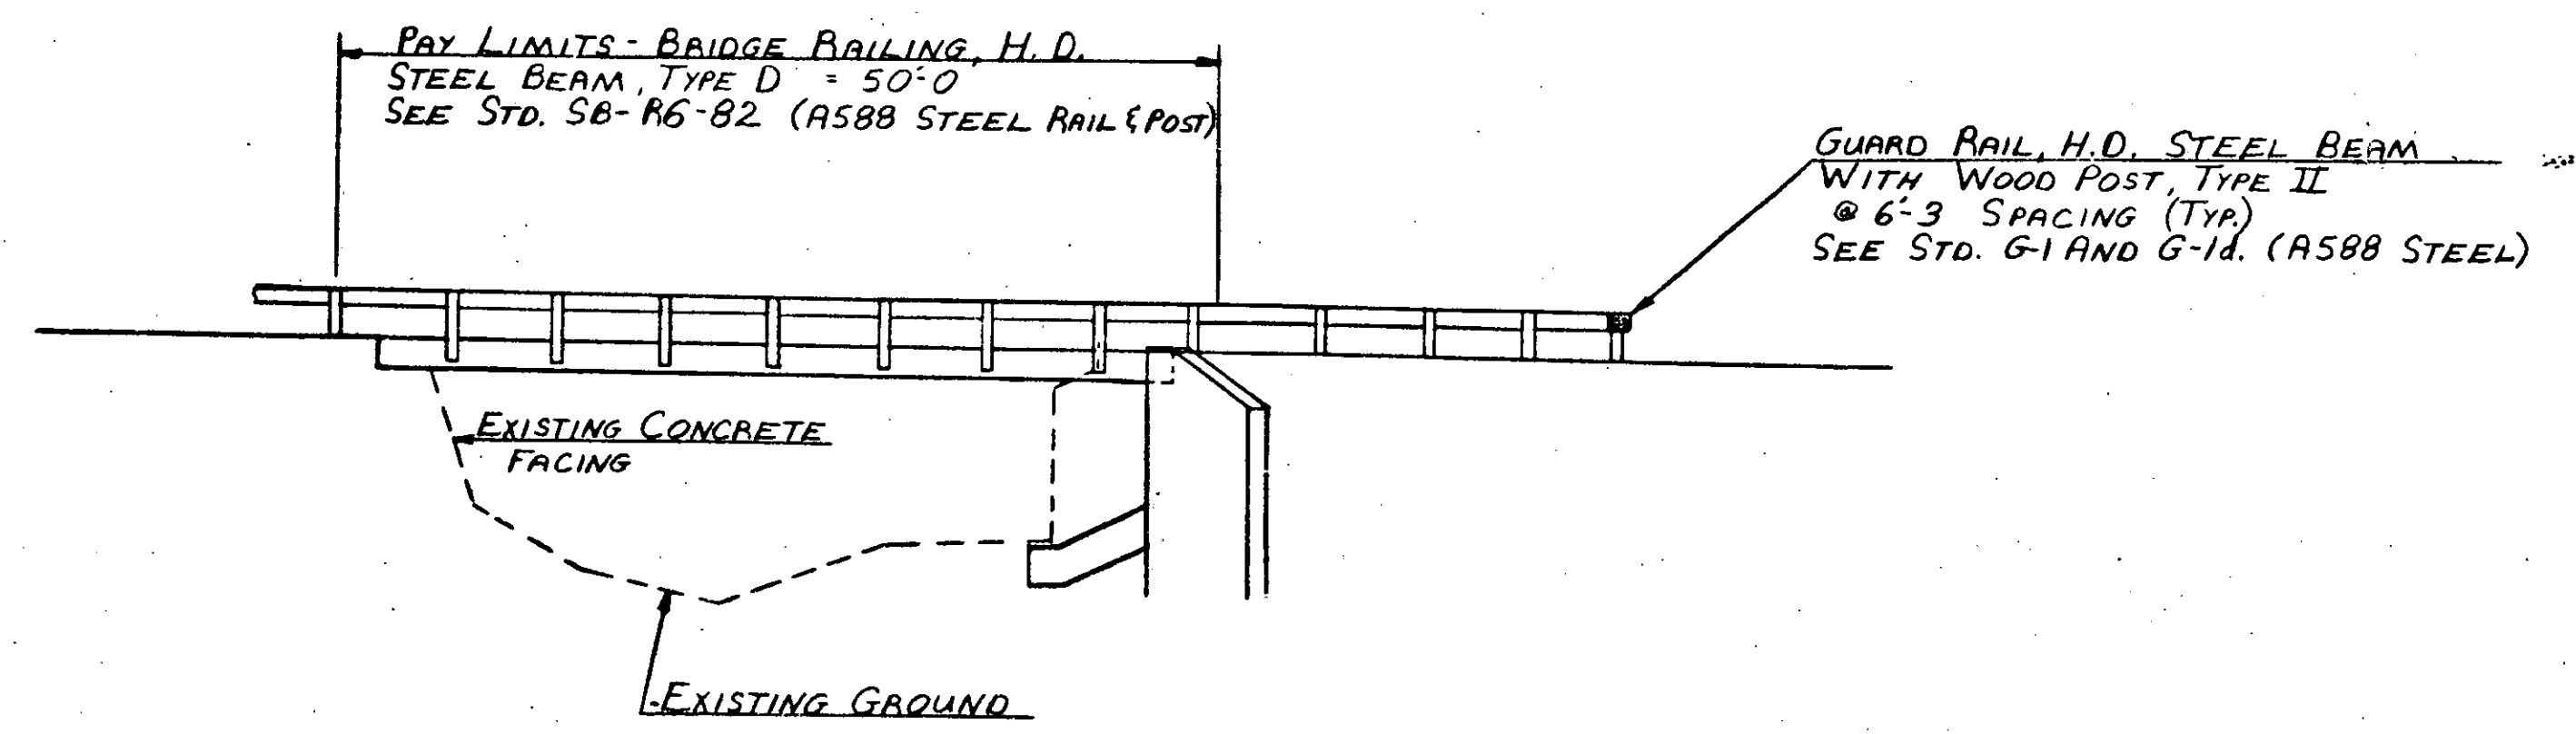

ELEVATION  
SCALE 1" = 10'

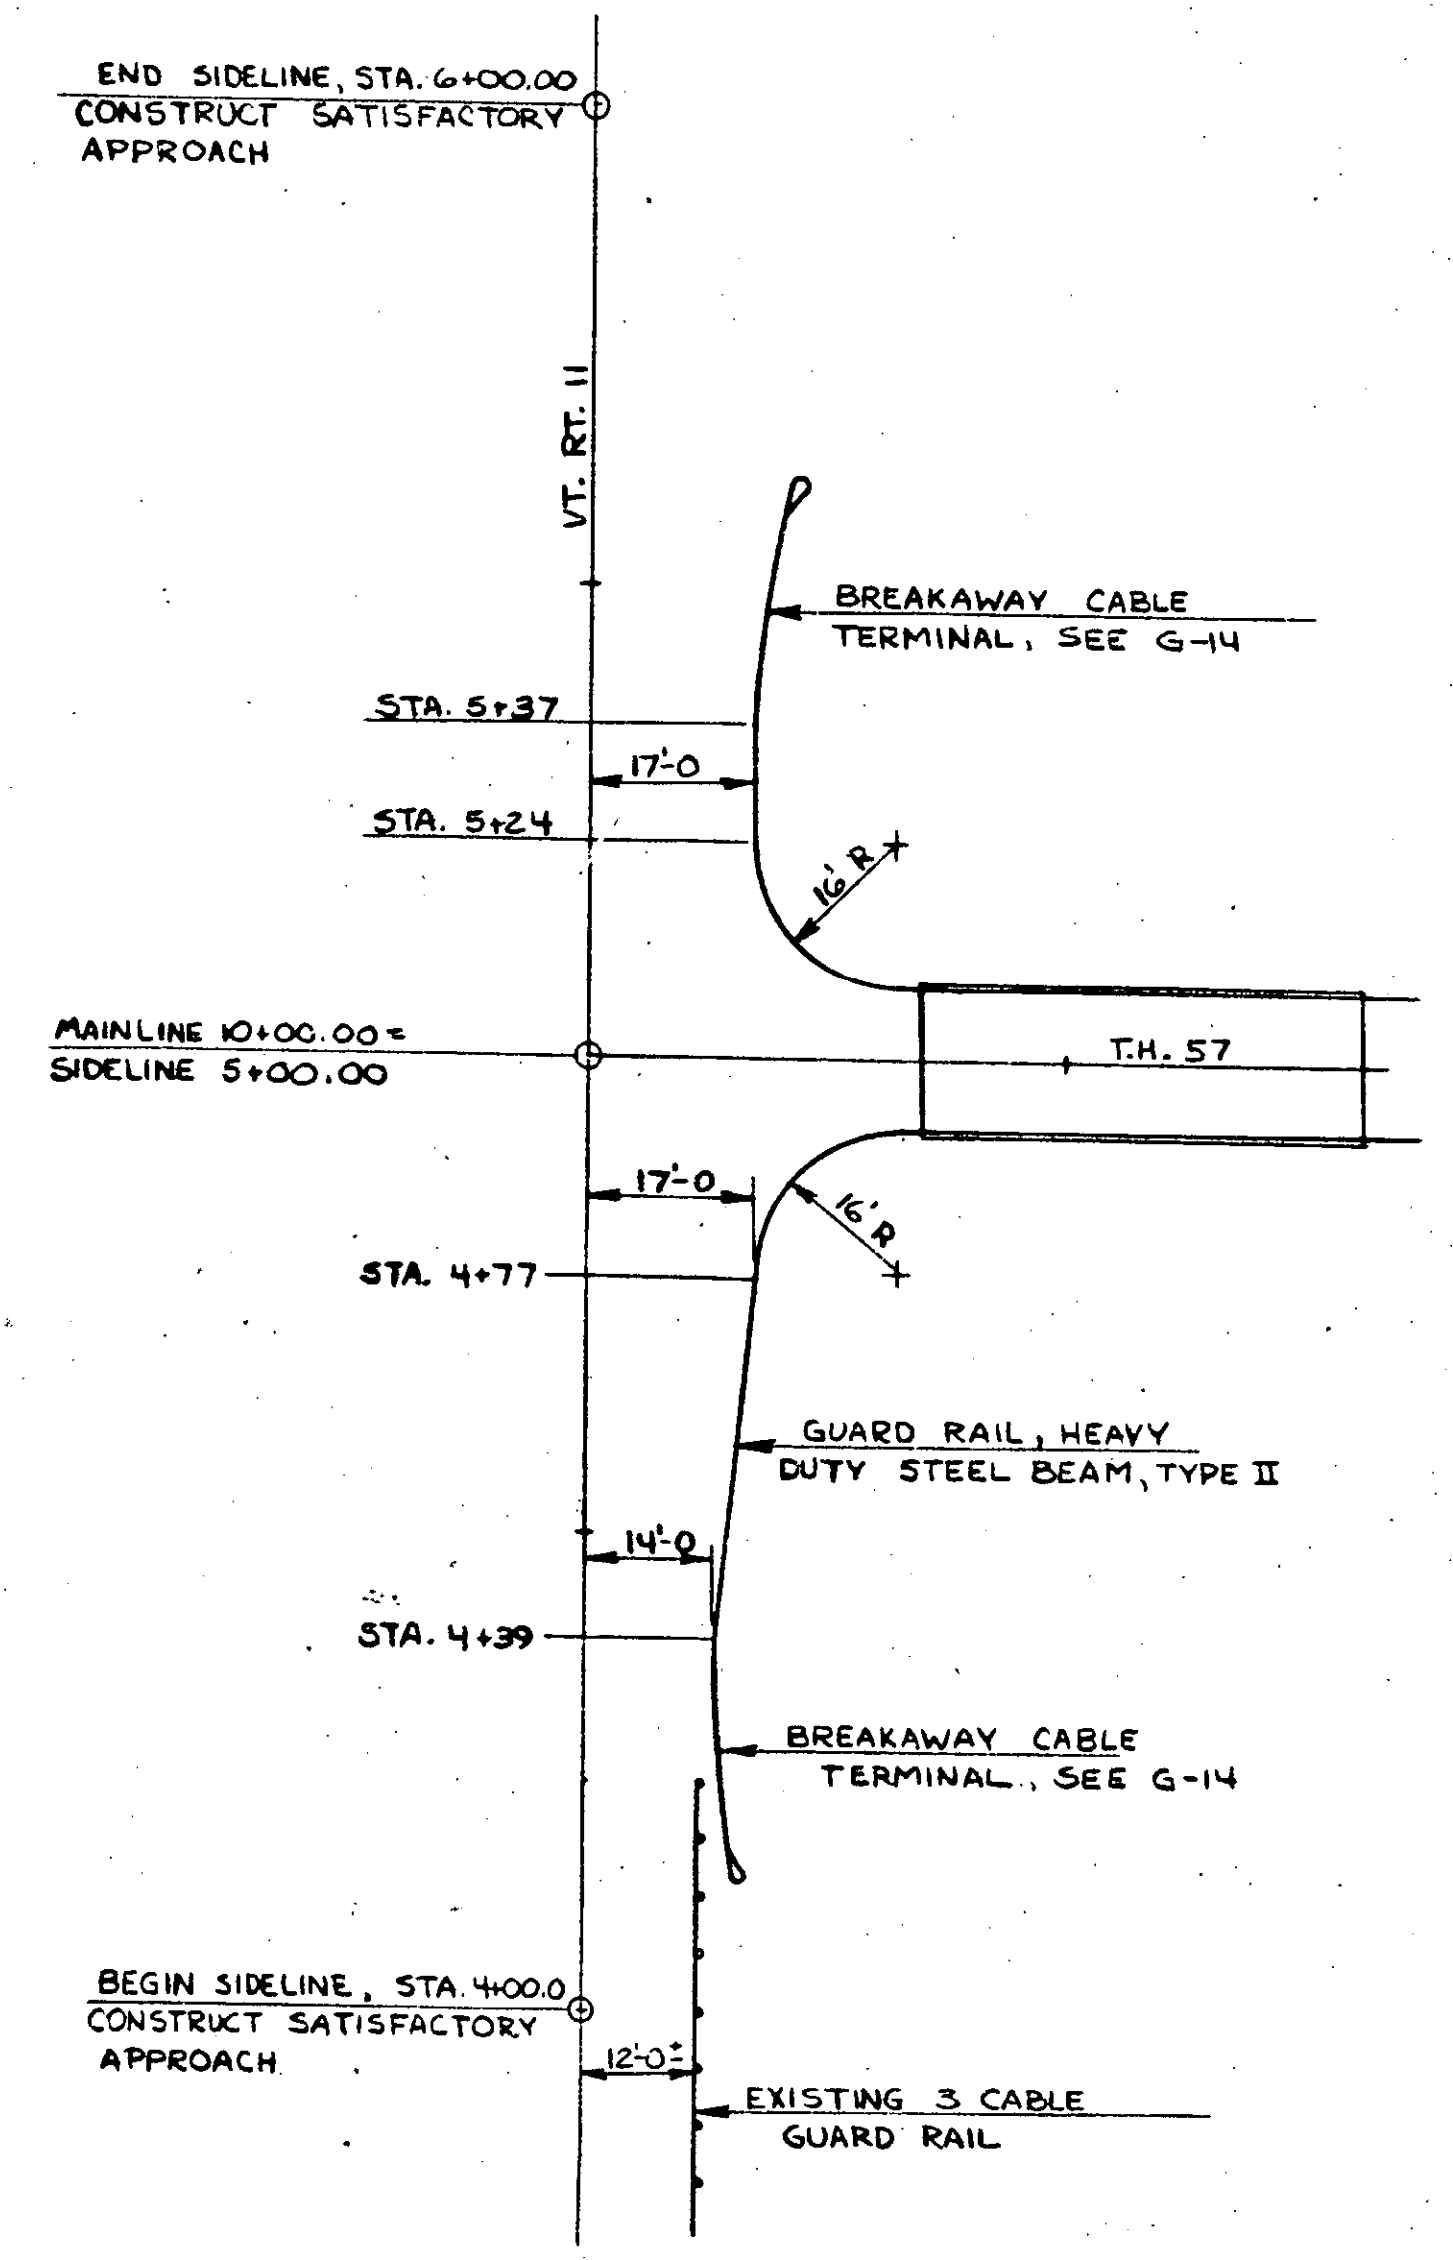

GUARD RAIL DETAIL  
SCALE 1" = 20'

<b>STATE OF VERMONT</b>	
<b>AGENCY OF TRANSPORTATION</b>	
TOWN OF <b>CHESTER</b>	Bridge No. <b>69</b>
HIGHWAY NO. <b>T.H. 57</b>	Log Sta. <b>10+50</b>
<b>PLAN AND ELEVATION</b>	
<b>T.H. 57 OVER MIDDLE BRANCH WILLIAMS RIVER</b>	
Designed by <b>C. BENDA</b>	Drawn by <b>D. WILLEY</b>
Checked by <b>G. SCHELLEY</b> date <b>8/93</b>	Bridge Design Supervisor <b>R.L. Coffey</b> date <b>11-83</b>
PROJECT <b>CHESTER</b>	PROJECT NO. <b>BRZ 1442 (2)</b>
Bridge Sheet No. <b>8</b>	Sheet <b>8</b> of <b>32</b>