
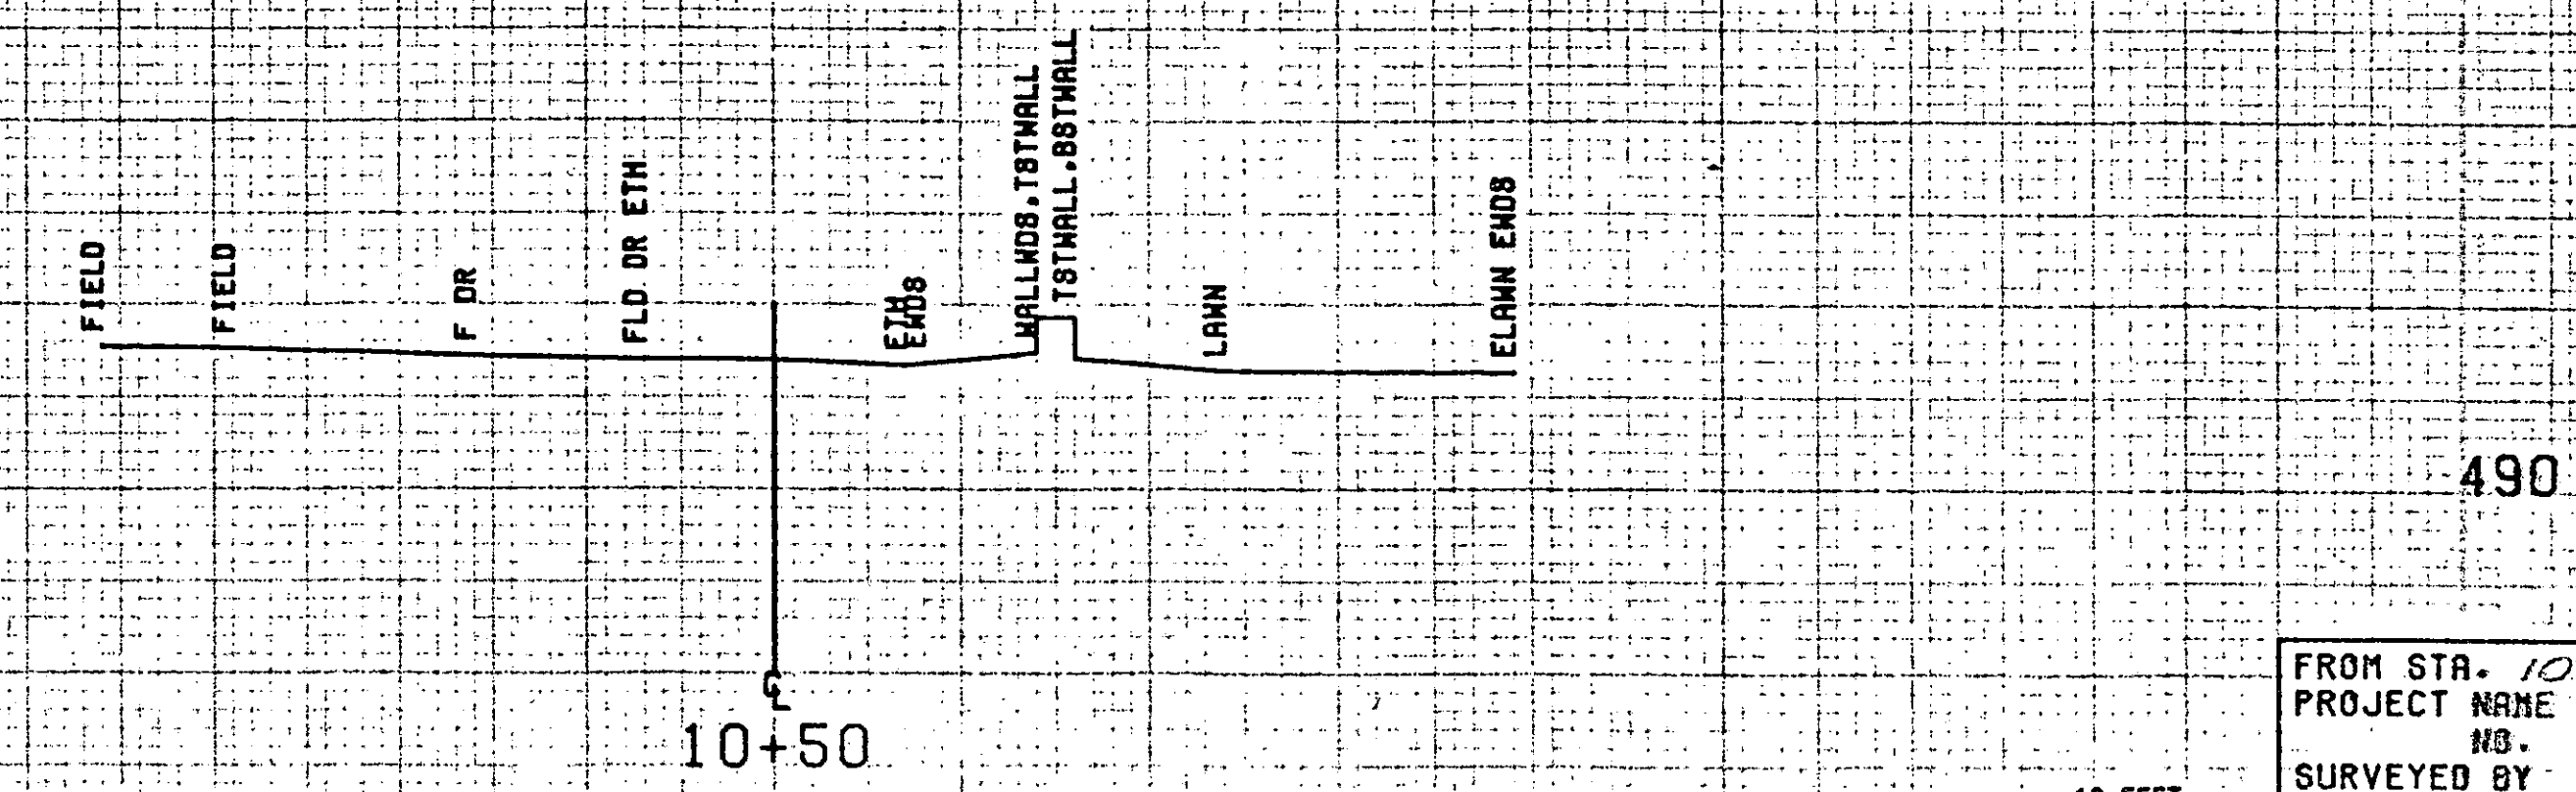
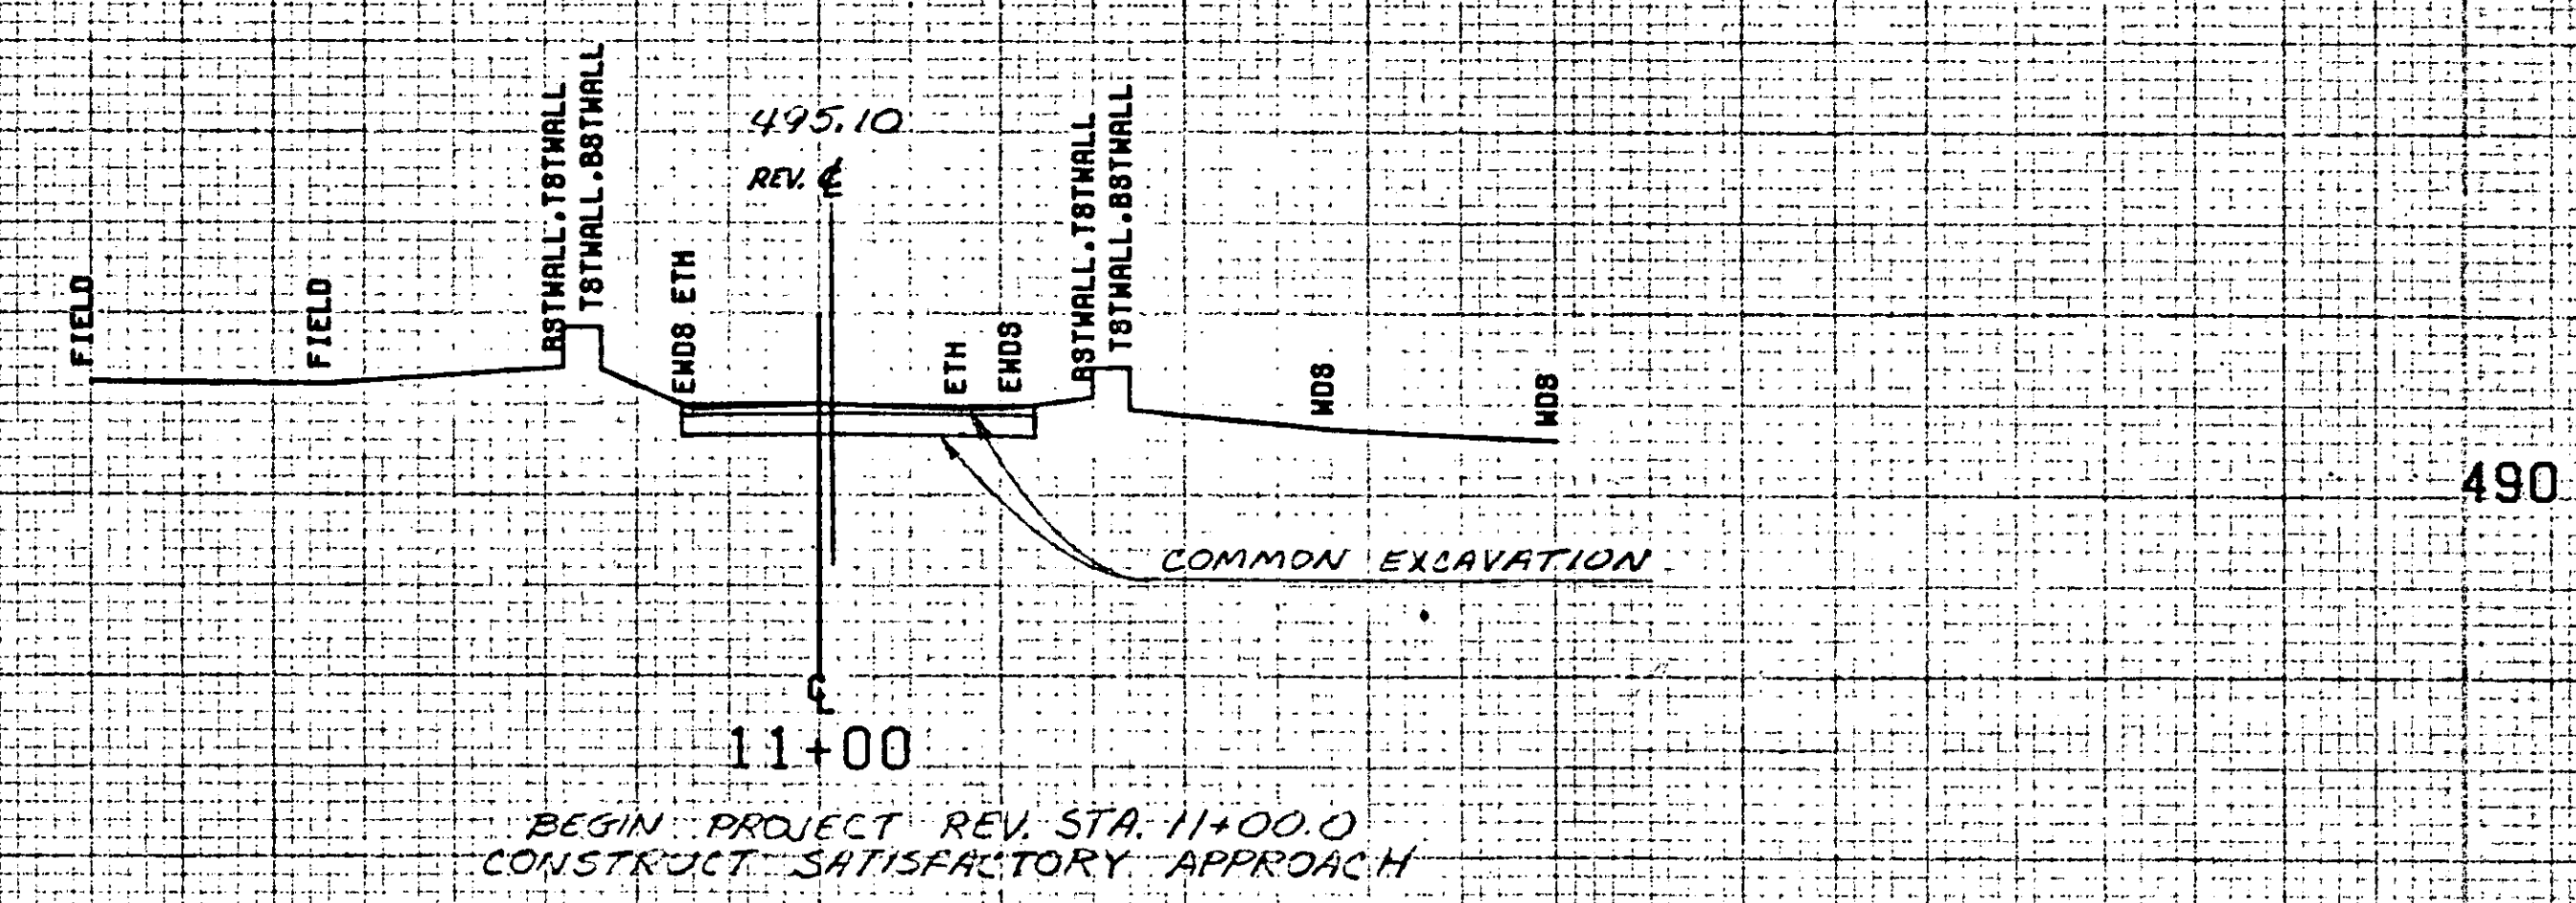


REV. Sta. 11+66 RT. to Sta. 11+83 LF.  
BEGIN GUARD RAIL, HEAVY DUTY  
STEEL BEAM WITH WOOD POSTS

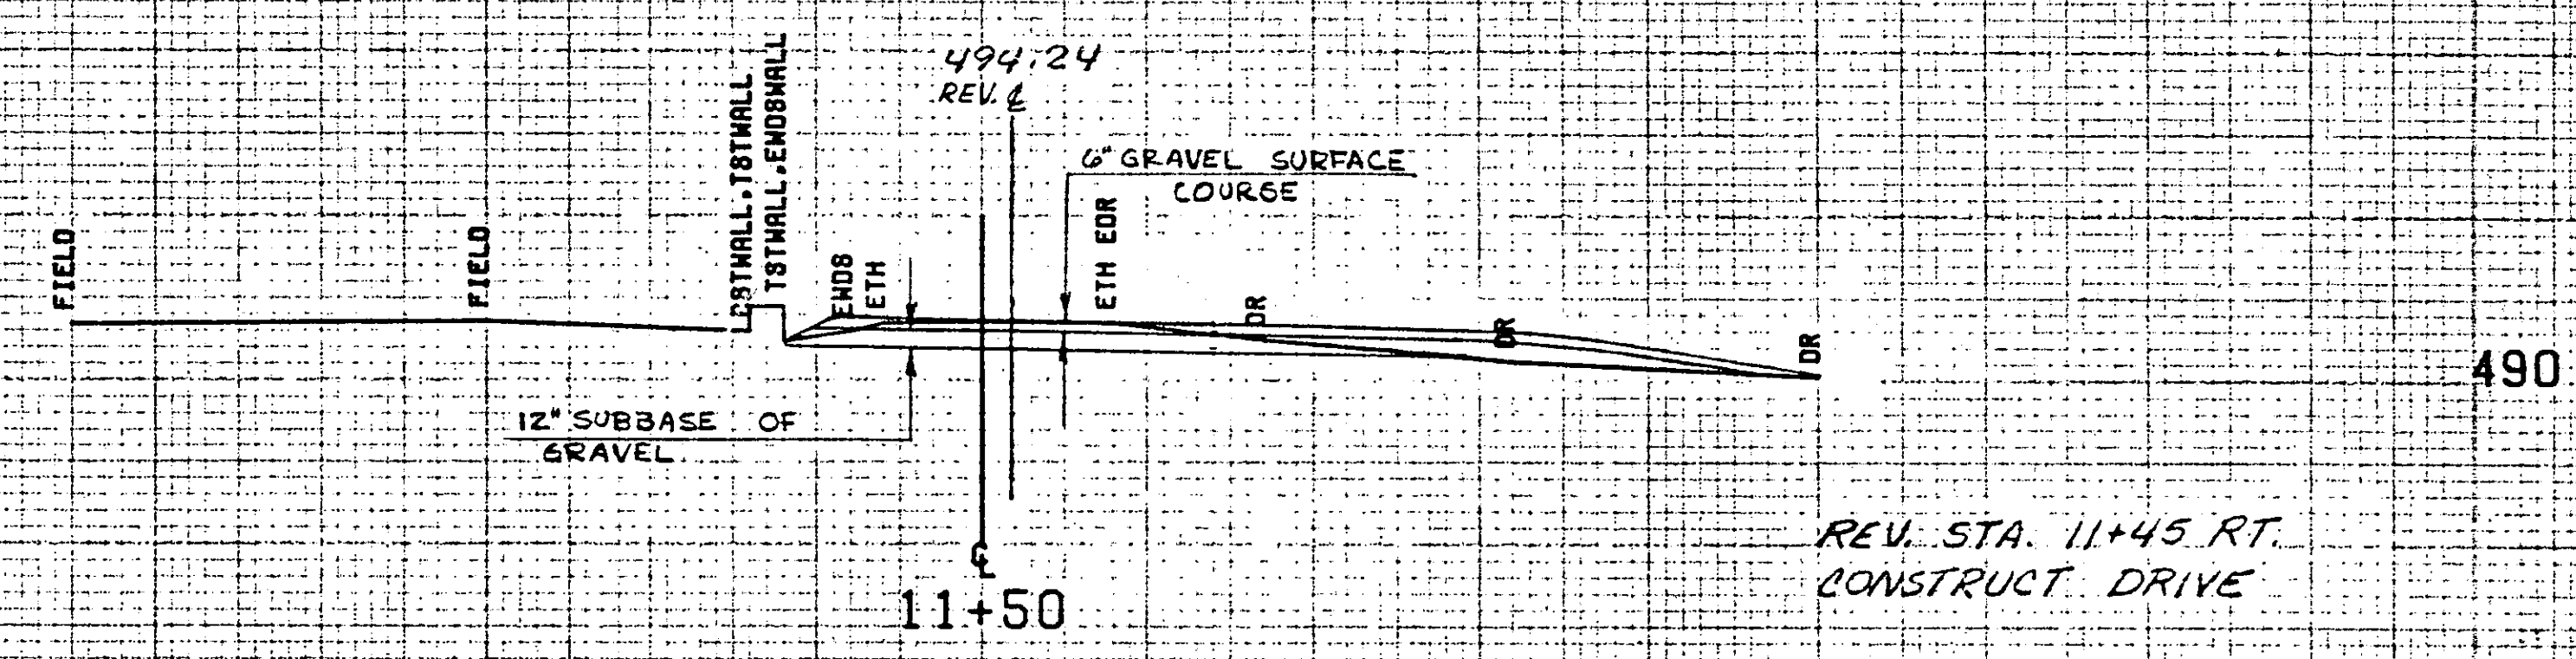

SCALE 1" = 10 FEET

FROM STA. 10+50	TO STA. 11+50
PROJECT NAME	CHESTER MAIN
NO.	BRZ1442(8)
SURVEYED BY	O COLBY
SHEET 27	OF 32 SHEETS
	PLOTTED 01/29/82
	12/04/81