



End Stone Fill Sta. 5+42
End Channel Excav. Sta. 5+43

End Structure Excav. Sta. 5+27
END GRANULAR BACKFILL FOR STRUCTURES, STA. 5+24

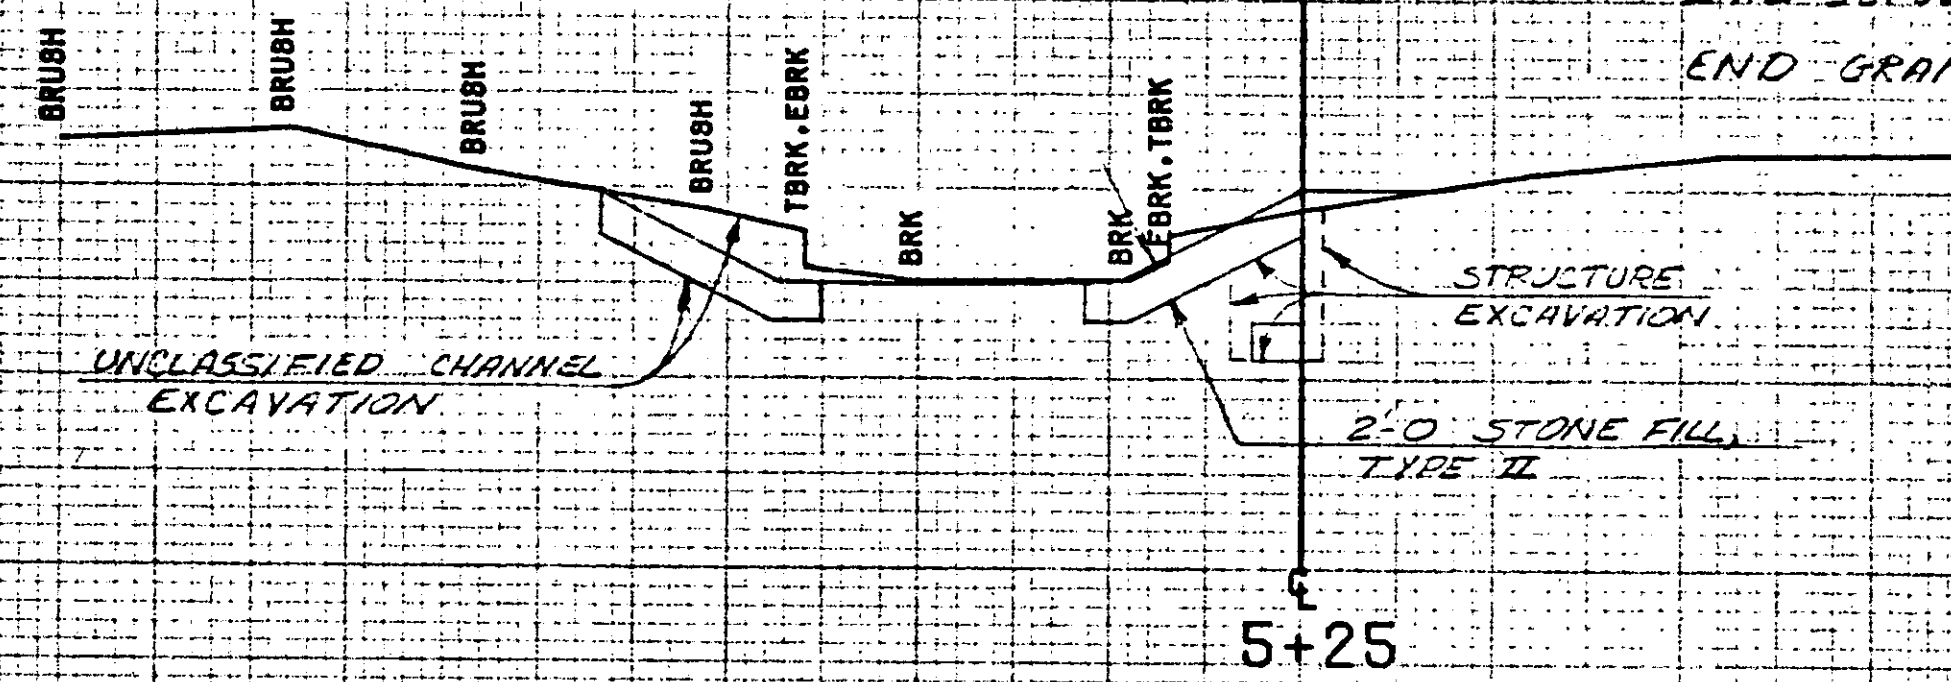


480

5+25

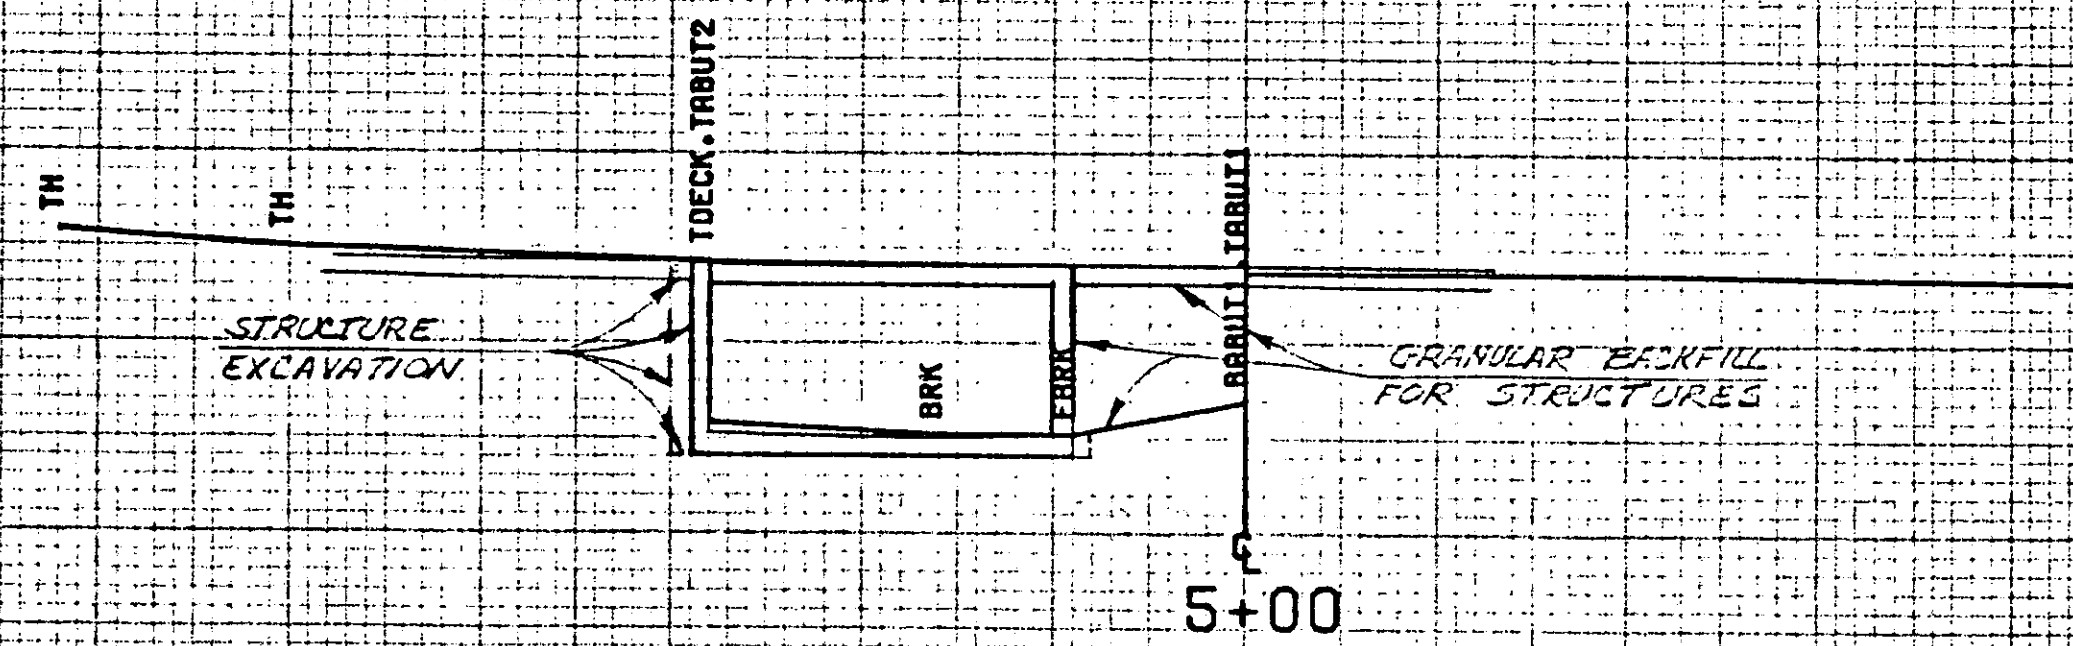

480

5+00

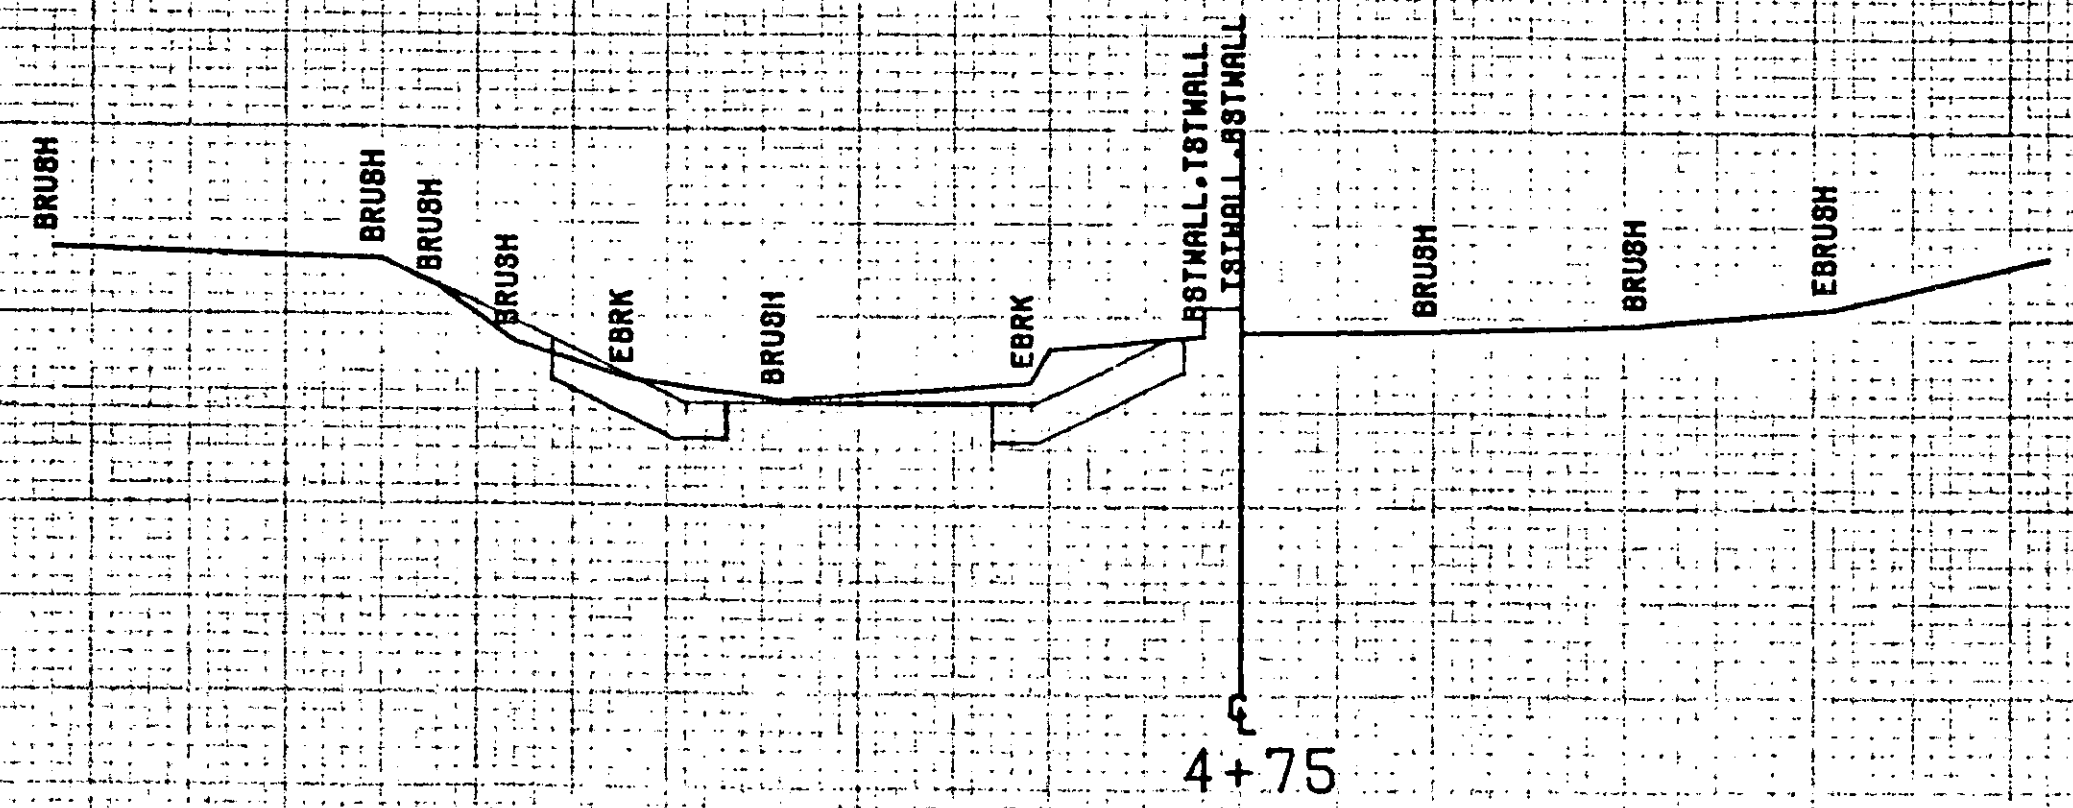

480

4+75

SCALE 10 FEET

FROM STA. 4+75 TO STA. 5+85
PROJECT NAME CHESTER CHAN
NO. BR21442(8) PLOTTED 01/29/82
SURVEYED BY G COLBY 12/04/81
SHEET 31 OF 32 SHEETS