




ABUTMENT NO. 2 PLAN
SCALE 1/4" = 1'-0"

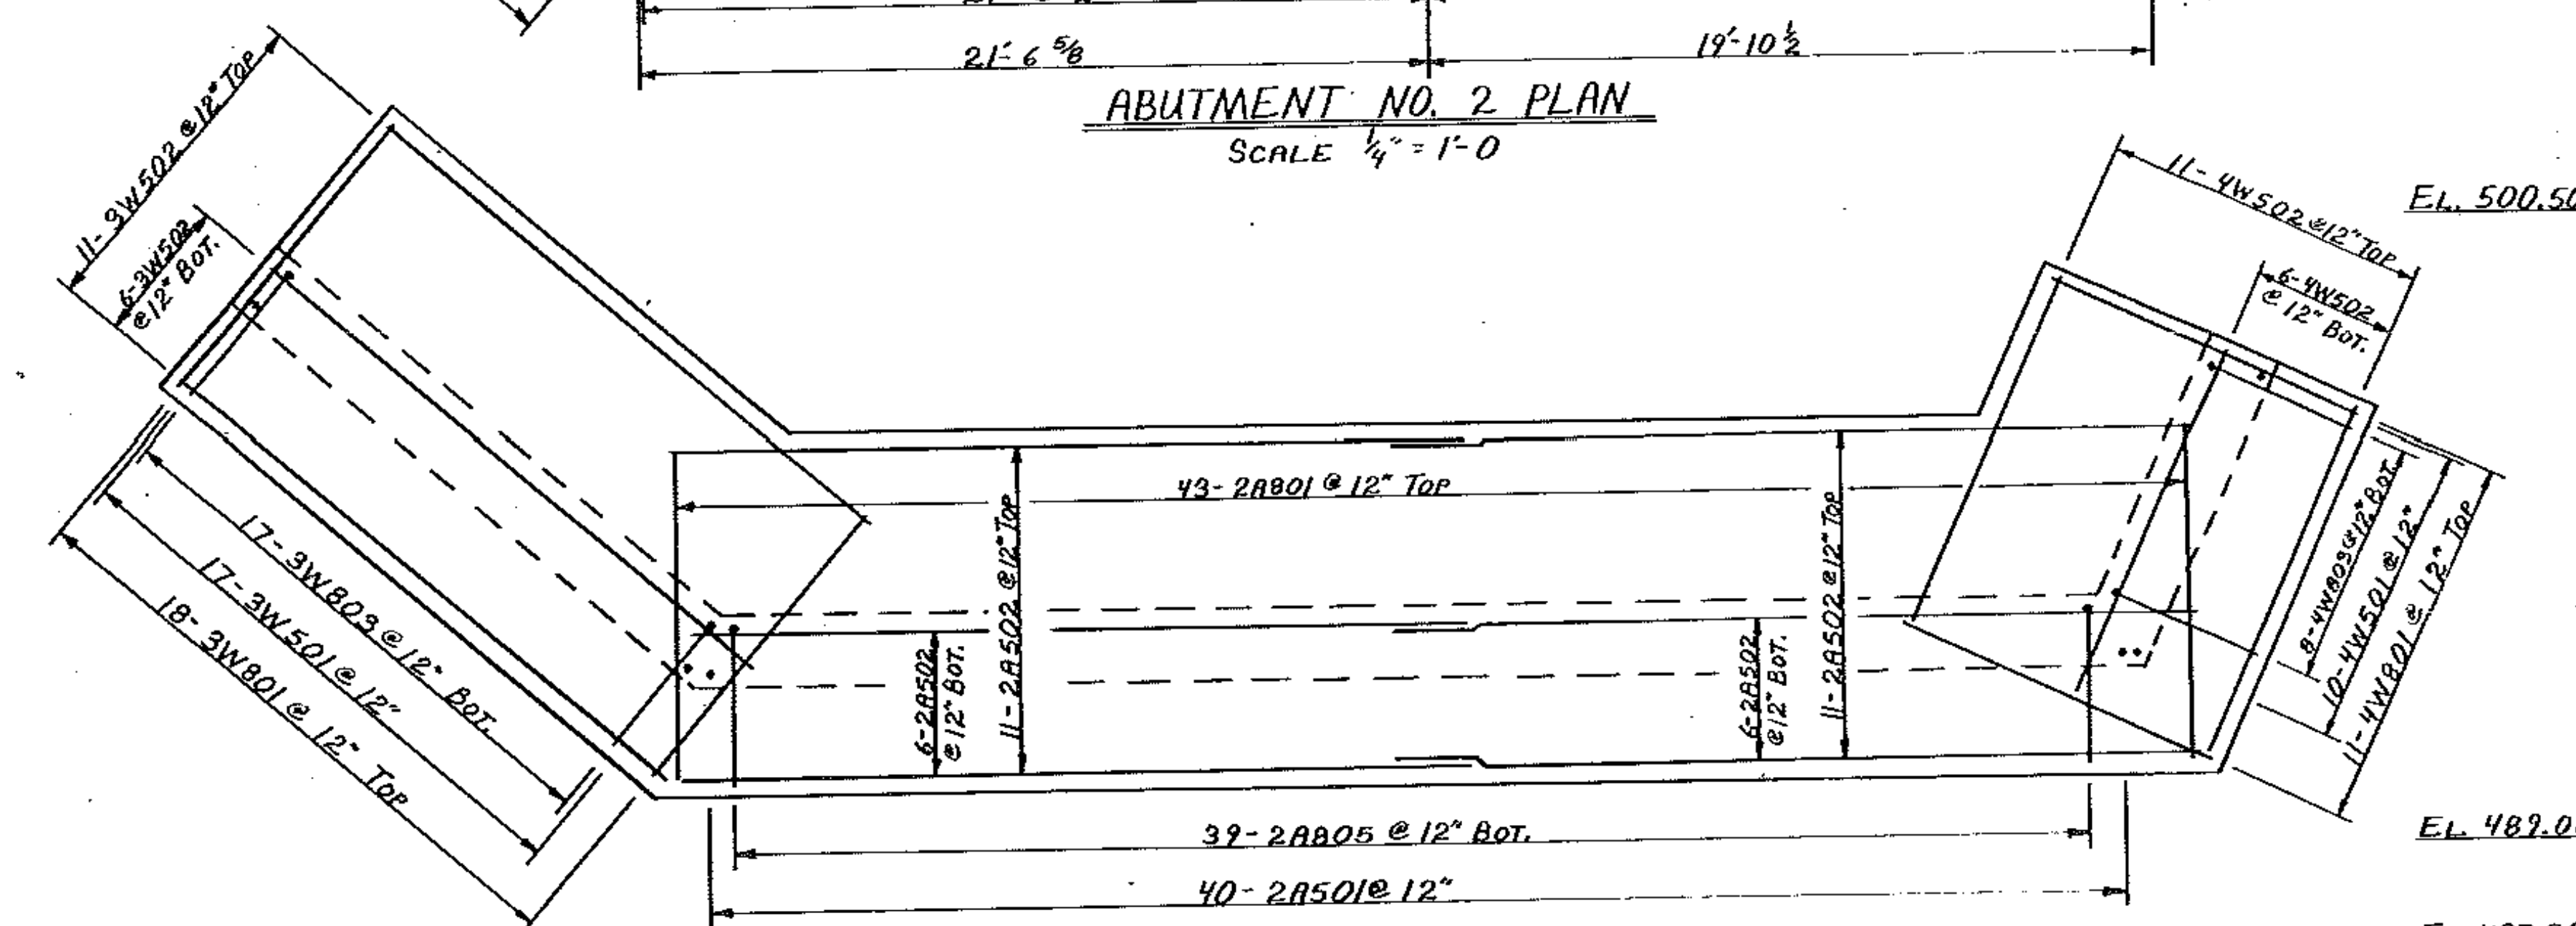


FOOTING REINFORCING PLAN
SCALE 1/4" = 1'-0"

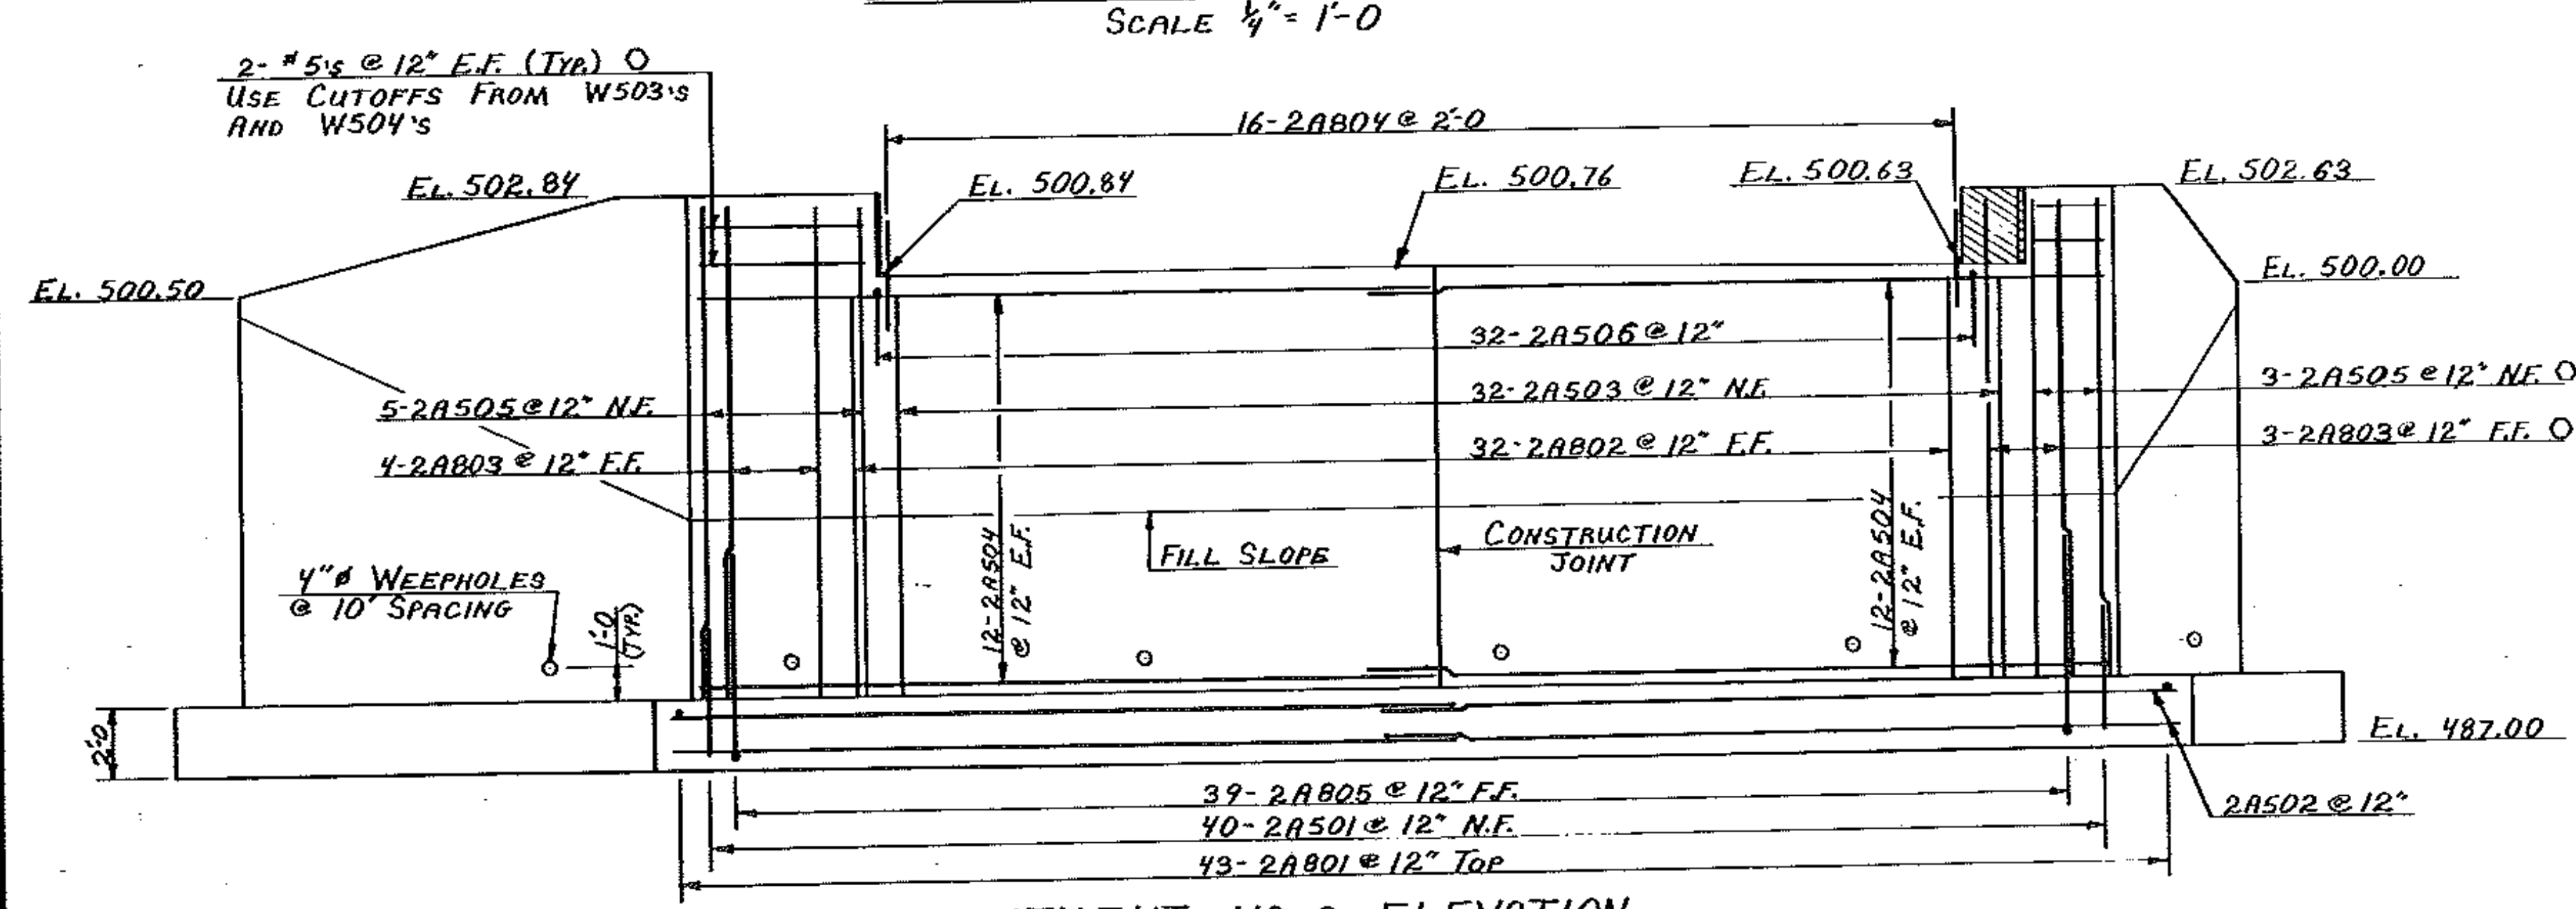

ABUTMENT NO. 2 ELEVATION
SCALE 1/4" = 1'-0"

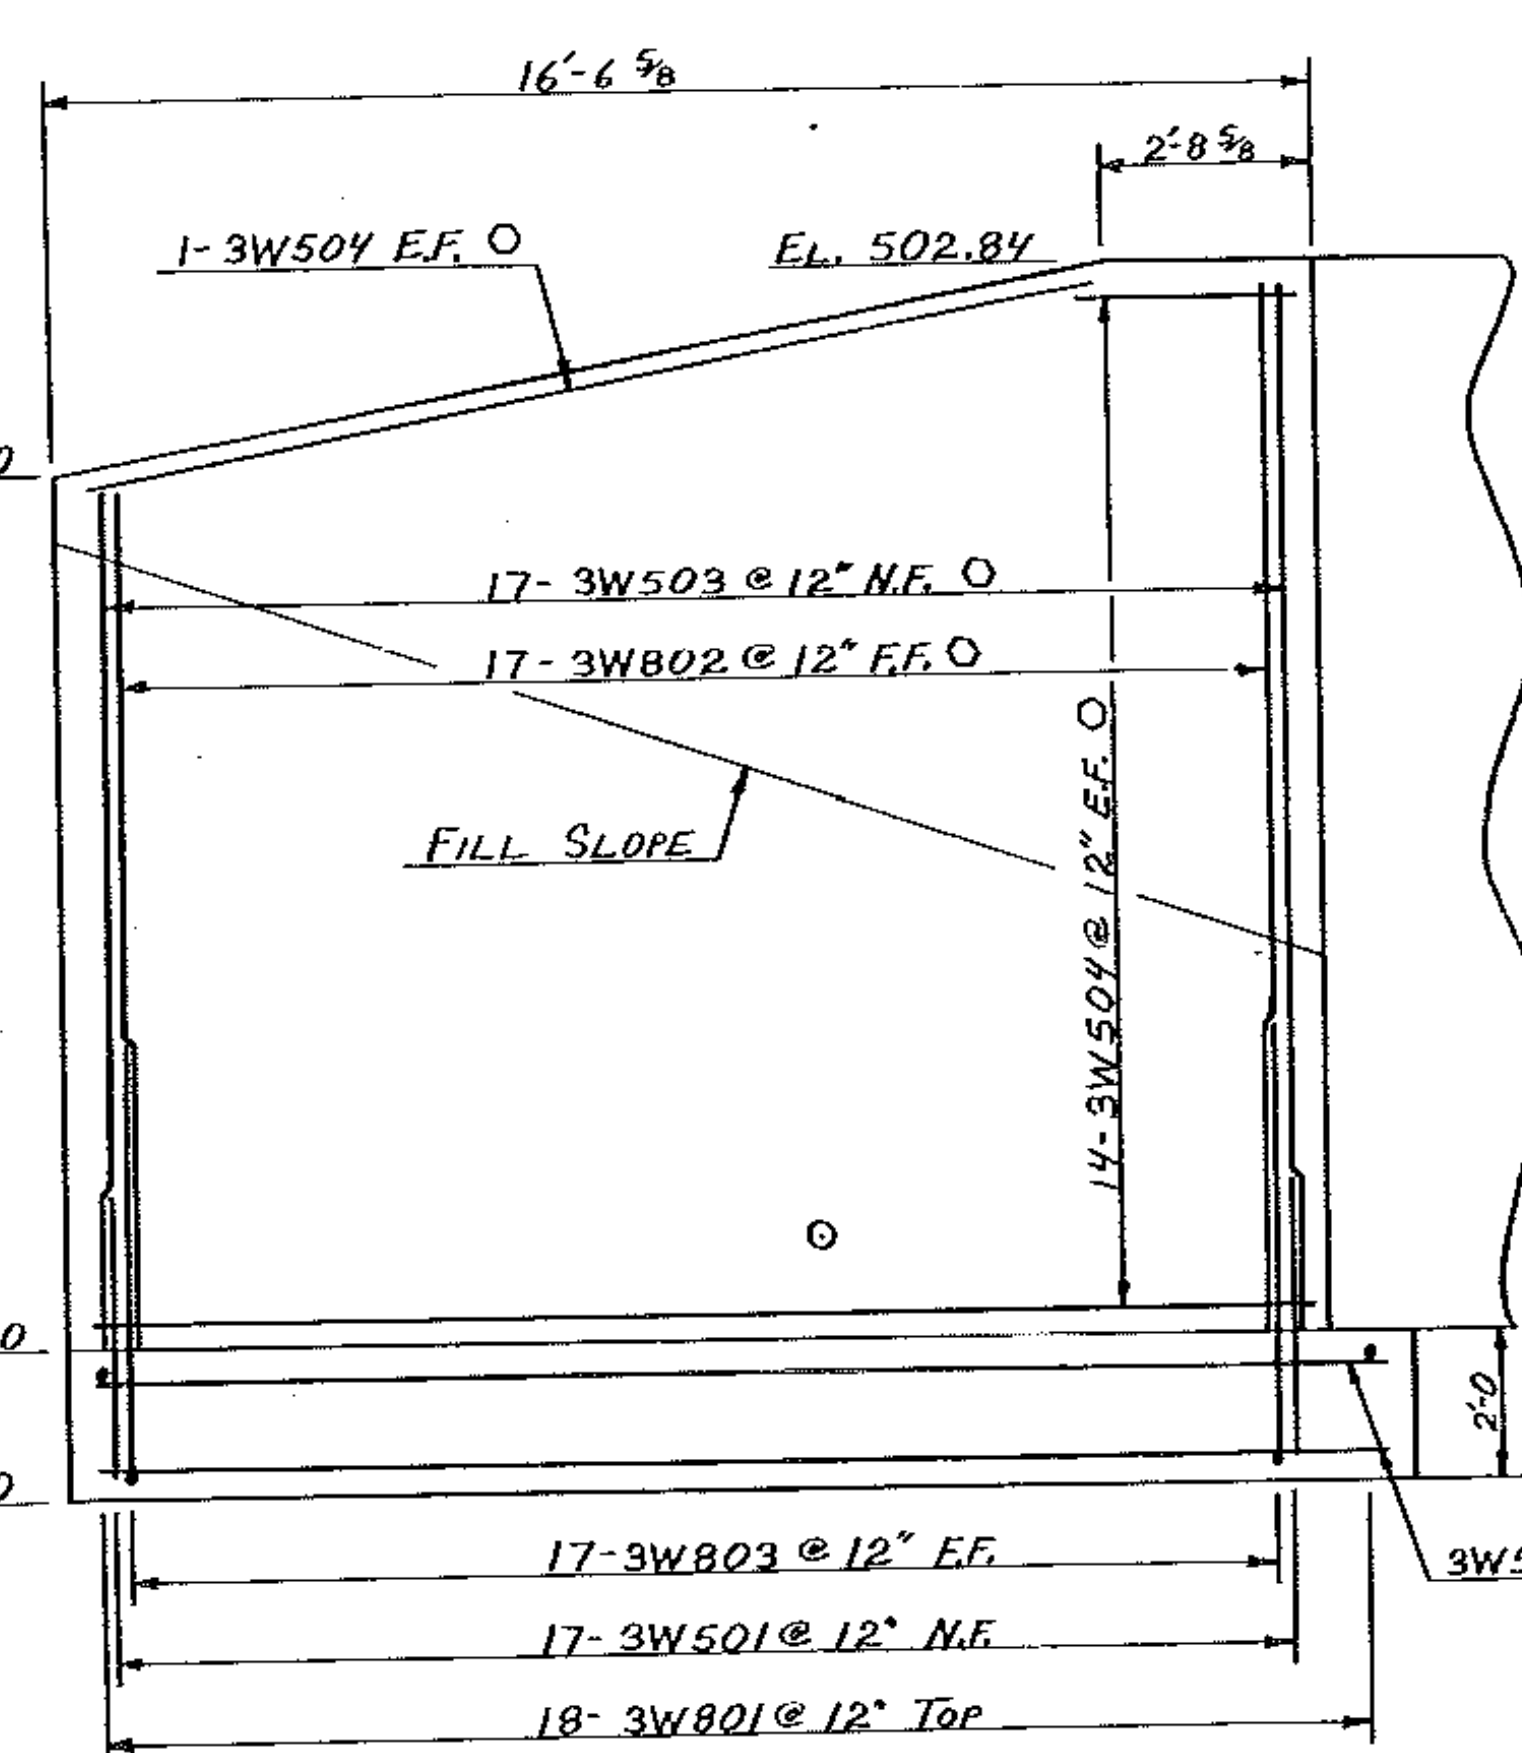

WINGWALL NO. 3 ELEVATION
SCALE 3/8" = 1'-0"

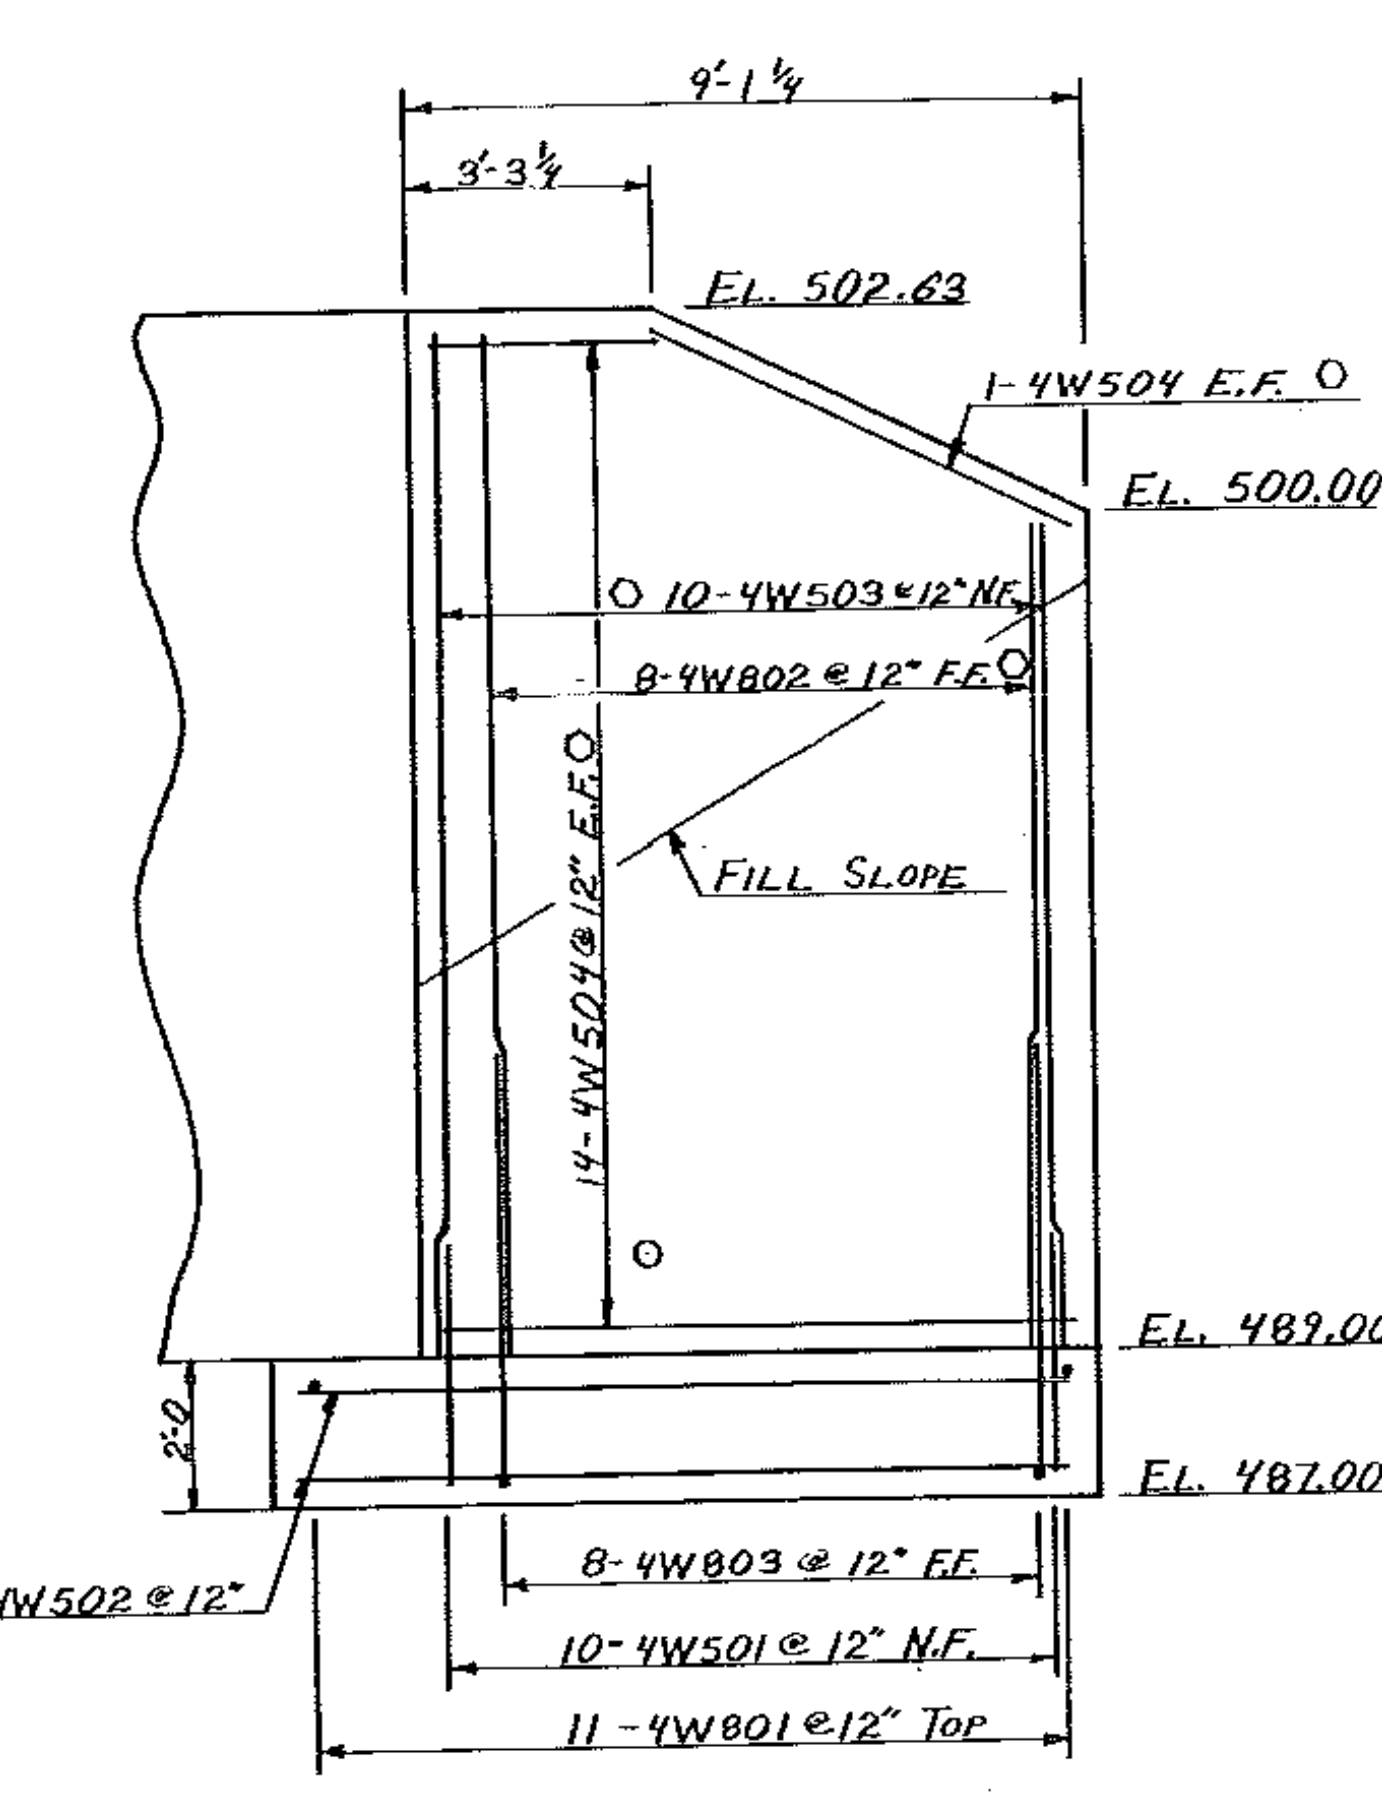

WINGWALL NO. 4 ELEVATION
SCALE 3/8" = 1'-0"

NOTES

1. FOR ABUTMENT TYPICAL SECTION, SEE SHEET 10.
2. FOR WINGWALL TYPICAL SECTION, SEE SHEET 11.

N.F. = NEAR FACE
 F.F. = FAR FACE
 E.F. = EACH FACE
 O INDICATES CUT TO FIT IN FIELD.

STATE OF VERMONT
AGENCY OF TRANSPORTATION

Town Of	CONCORD	Bridge No.	20
Highway No.	T.H. #11	Log Sta.	
		Surv. Sta.	
ABUTMENT NO. 2 DETAILS			
T.H. #11 OVER MILES STREAM			
Designed By	M.J. POLDRUTO	Drawn By	D.C. WILLEY
Checked By	G.V. SPILAK	Date	4-85
		Bridge Design Supervisor	R.S. HAUPT
		Date	3-85
PROJECT	CONCORD	PROJECT NO.	BRZ 1447 (10)
L.G.C. Info.			
Bridge Sheet No.		Sheet 12 of 29	